

STA 111+00
MATCHLINE - SHEET 28

89

89

STA 14+00
MATCHLINE - SHEET 23

US ROUTE 2

CALVIN MORSE TAVERN

MATCHLINE - SHEET 27
STA 107+00

MATCHLINE - SHEET 25
STA 18+50

DURABLE 24" STOP BAR
15+38 - 15+40 LT. & RT.
15+49 - 15+51 RT.
15+59 - 15+61 RT.
16+73 - 16+75 LT.
16+89 - 16+91 LT. & RT.
16+99 - 17+01 RT.
107+96 - 108+06 RT.
108+22 - 108+31 RT.
107+61 - 107+63 LT. & RT.
109+23 - 109+25 LT.
109+41 - 109+49 LT.
109+45 - 109+47 LT.

DURABLE 4" YELLOW LINE
14+00 - 15+40 LT. (DBL.)
16+99 - 18+50 LT. (DBL.)
107+00 - 107+63 LT. (DBL.)
109+45 - 111+00 LT. (DBL.)

107+63 - 108+00 LT. (DBL., DOTTED)
108+00 - 108+93 LT. (DBL., DOTTED, R=145')
107+88 - 108+75 RT. (DBL., DOTTED, R=145')
108+75 - 109+45 RT. (DBL., DOTTED)

DURABLE LETTER OR SYMBOL
14+08 - 14+16 RT. (1 ARROW)
15+24 - 15+32 RT. (ONLY)
15+24 - 15+32 LT. (ONLY)
15+37 - 15+45 RT. (1 ARROW)
15+37 - 15+45 LT. (1 ARROW)
17+06 - 17+14 LT. (1 ARROW)
17+06 - 17+14 RT. (1 ARROW)
17+18 - 17+26 LT. (ONLY)
17+18 - 17+26 RT. (ONLY)
107+38 - 107+46 LT. & RT. (ONLY)
107+51 - 107+59 LT. & RT. (1 ARROW)
109+51 - 109+59 LT. (1 ARROW)
109+63 - 109+71 LT. (ONLY)



DURABLE 4" WHITE LINE
14+00 - 14+50 LT.
14+00 - 15+51 RT.
14+00 - 15+61 RT.
14+00 - 16+90 RT.
14+85 - 18+50 LT.
15+18 - 15+42 LT.
15+18 - 15+72 LT.
15+42 - 15+72 LT.
16+51 - 17+36 RT.
16+89 - 18+00 RT.
16+73 - 18+50 LT.
17+15 - 17+36 RT.
17+38 - 18+50 RT.
107+00 - 107+61 RT. (DASHED)
107+00 - 107+67 LT. (DASHED)
107+00 - 108+01 RT.
109+25 - 111+00 LT. (DASHED)
109+25 - 111+00 LT.

DURABLE CROSSWALK WITH DIAGONAL LINES
15+20 - 15+41 LT.
15+45 - 15+88 LT. & RT.
16+86 - 16+95 LT. & RT.
17+08 - 17+46 RT.
107+67 - 107+75 LT. & RT.
109+09 - 109+18 LT. & RT.

DURABLE 8" WHITE LINE
107+19 - 107+40 RT.
107+19 - 107+43 RT.
107+88 - 108+01 RT.
107+93 - 108+01 RT.
108+90 - 108+97 LT.
108+90 - 109+02 LT.
109+27 - 109+41 LT.
109+31 - 109+41 LT.

REMOVING SIGNS
45 - AS SHOWN

NOTE: SIGNS SHOWN AS RETAINED OR SALVAGED MAY NEED TO BE REPLACED AT THE DISCRETION OF THE ENGINEER.

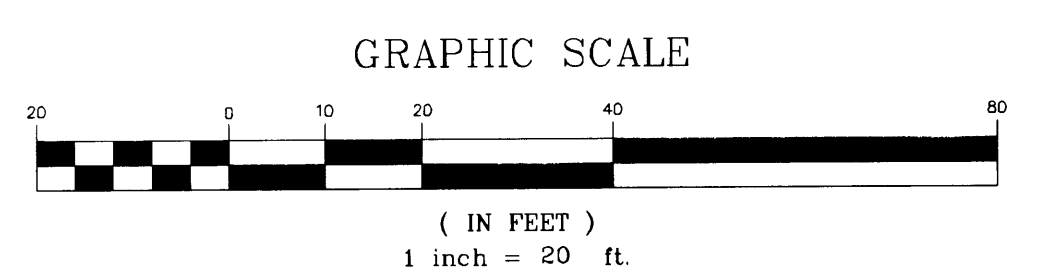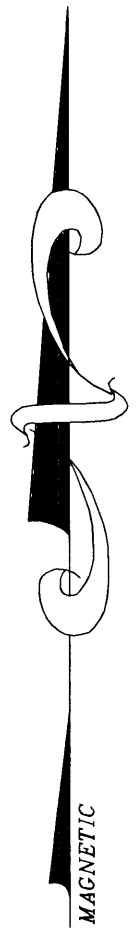

RECORD DRAWINGS
THIS RECORD DRAWING HAS BEEN PREPARED BY GRIFFIN INTERNATIONAL, INC. BASED ON BASE PLAN DESIGN DRAWINGS PROVIDED BY LAMOUREUX & DICKINSON, INC. CHANGES MADE TO THE DESIGN PLANS ARE INDICATED. THE INFORMATION PROVIDED REGARDING ANY DEVIATION FROM THE DESIGN PLANS ARE BASED ON RESIDENT ENGINEER NOTES AND MEASUREMENT OF ABOVEGROUND FEATURES.

CONTRACT PLANS

REVISED	8/21/01	REVISED SB GUIDELINES	JLC
REVISED	8/14/01	PAVEMENT MARKINGS	JLC

VERMONT AGENCY OF TRANSPORTATION

WILLISTON NHG 5500 (10)S
"TAFT CORNERS"
(US ROUTE 2 & VT ROUTE 2A)

WILLISTON VERMONT

PAVEMENT MARKING & SIGN LAYOUT SHEET

LAMOUREUX & DICKINSON
Consulting Engineers Inc.
14 Morse Drive
Essex Junction, VT 05452
(802) 878-4450
Engineers-Planners-Surveyors

design
RJD/JLC
drawn
DWE/JLC
checked
RJD
scale
1"=20'
sht. no.
24