

STA 18+50
MATCHLINE - SHEET 24

PROJECT LIMIT
STA 23+00

DURABLE 4" WHITE LINE

- 18+50 - 19+05 RT.
- 18+50 - 19+06 LT.
- 18+50 - 19+10 LT.
- 19+08 - 19+26 RT. (DOTTED)
- 19+28 - 19+90 RT.
- 19+45 - 19+90 RT.
- 19+50 - 19+90 LT.
- 19+52 - 19+90 RT.

DURABLE 4" YELLOW LINE

- 18+50 - 18+60 RT. (DBL.)
- 18+60 - 19+10 RT.
- 18+60 - 19+10 RT. (DASHED)
- 18+60 - 19+10 RT.
- 18+60 - 19+10 RT. (DASHED)
- 19+50 - 19+90 RT. (DBL.)

DURABLE LETTER OR SYMBOL

- 18+70 - 18+78 RT. (1 ARROW)
- 18+75 - 18+83 LT. (1 ARROW)
- 18+87 - 18+95 LT. (ONLY)
- 19+00 - 19+08 RT. (1 ARROW)
- 19+60 - 19+68 RT. (1 ARROW)
- 18+72 - 18+80 RT. (ONLY)

TEMPORARY 4" YELLOW LINE

- 19+23 RT. (DBL.)

TEMPORARY 4" WHITE LINE

- 19+34 RT.

TEMPORARY 24" STOP BAR


- 19+23 - 19+50 RT.
- 19+06 - 19+33 LT.

TEMPORARY LETTER OR SYMBOL

- 19+13 - 19+16 RT. (1 ARROW)
- 19+25 - 19+31 RT. (1 ARROW)
- 19+40 - 19+46 RT. (1 ARROW)

REMOVING SIGNS

- 7 - AS SHOWN

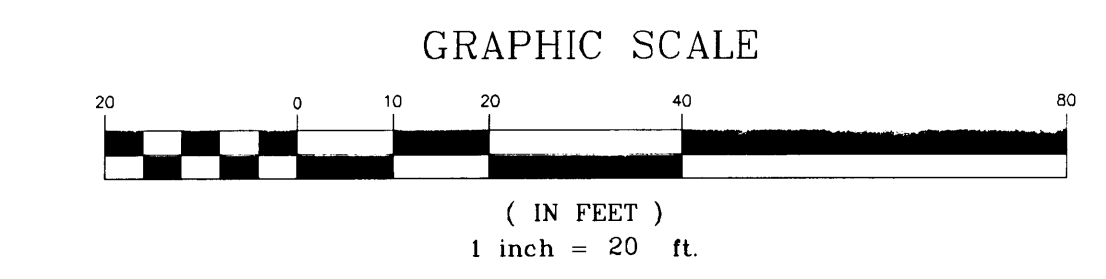

NOTES: 1) SIGNS SHOWN AS RETAINED OR SALVAGED MAY NEED TO BE REPLACED AT THE DISCRETION OF THE ENGINEER.

CONTRACT PLANS

REVISED	8/14/01	PAVEMENT MARKINGS	JLC
VERMONT AGENCY OF TRANSPORTATION			
WILLISTON NHG 5500 (10)S			
"TAFT CORNERS"			
(US ROUTE 2 & VT ROUTE 2A)			
WILLISTON			VERMONT
PAVEMENT MARKING & SIGN LAYOUT SHEET			design RJD/JLC
			drawn DNE/JLC
			checked RJD
			scale 1"=20'
			sht. no. 25
LAMOUREUX & DICKINSON Consulting Engineers Inc. 14 Morse Drive Essex Junction, VT 05452 (802) 878-4450 Engineers-Planners-Surveyors			

RECORD DRAWINGS
 THIS RECORD DRAWING HAS BEEN PREPARED BY GRIFFIN INTERNATIONAL, INC. BASED ON BASE PLAN DESIGN DRAWINGS PROVIDED BY LAMOUREUX & DICKINSON, INC. CHANGES MADE TO THE DESIGN PLANS ARE INDICATED. THE INFORMATION PROVIDED REGARDING ANY DEVIATION FROM THE DESIGN PLANS ARE BASED ON RESIDENT ENGINEER NOTES AND MEASUREMENT OF ABOVEGROUND FEATURES.