


NOTE:
NEW PAVEMENT MARKINGS SHOWN SOUTH OF STA. 105+12
BASED ON REVISED PROJECT LIMIT OF STA. 102+50.

STA 103+00
MATCHLINE - SHEET 26

MATCHLINE - SHEET 24
STA 107+00

- DURABLE 4" WHITE LINE**
103+00 - 103+97 LT.
103+97 - 105+12 LT. (DOTTED)
105+16 - 106+87 LT. (DASHED)
105+12 - 107+00 LT.
106+62 - 107+00 RT.
106+62 - 107+00 RT.
- DURABLE LETTER OR SYMBOL**
106+72 - 106+80 RT. (ONLY)
106+84 - 106+92 RT. (1 ARROW)
- DURABLE 4" YELLOW LINE**
106+62 - 107+00 LT. (DBL.)
- REMOVING SIGNS**
10 - AS SHOWN

NOTE: SIGNS SHOWN AS RETAINED OR SALVAGED MAY NEED
TO BE REPLACED AT THE DISCRETION OF THE ENGINEER.

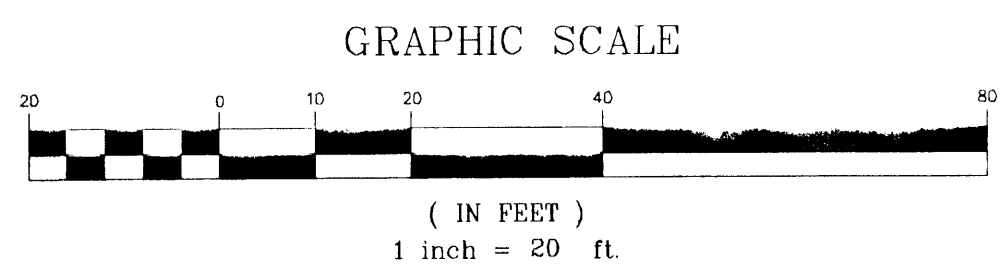

RECORD DRAWINGS
THIS RECORD DRAWING HAS BEEN PREPARED BY GRIFFIN INTERNATIONAL, INC. BASED ON BASE PLAN DESIGN DRAWINGS PROVIDED BY LAMOUREUX & DICKINSON, INC.. CHANGES MADE TO THE DESIGN PLANS ARE INDICATED. THE INFORMATION PROVIDED REGARDING ANY DEVIATION FROM THE DESIGN PLANS ARE BASED ON RESIDENT ENGINEER NOTES AND MEASUREMENT OF ABOVEGROUND FEATURES.

CONTRACT PLANS

**VERMONT AGENCY OF
TRANSPORTATION**

**WILLISTON NHG 5500 (10)S
"TAFT CORNERS"
(US ROUTE 2 & VT ROUTE 2A)**

WILLISTON VERMONT

**PAVEMENT MARKING &
SIGN LAYOUT SHEET**

design RJD/JLC
drawn DWE/JLC
checked RJD

scale 1" = 20'
sh. no. 27

LAMOUREUX & DICKINSON
Consulting Engineers Inc.
14 Morse Drive
Essex Junction, VT 05452
(802) 878-4450
Engineers-Planners-Surveyors

DATE PLOTTED: 08/14/2018 10:00:00 AM