
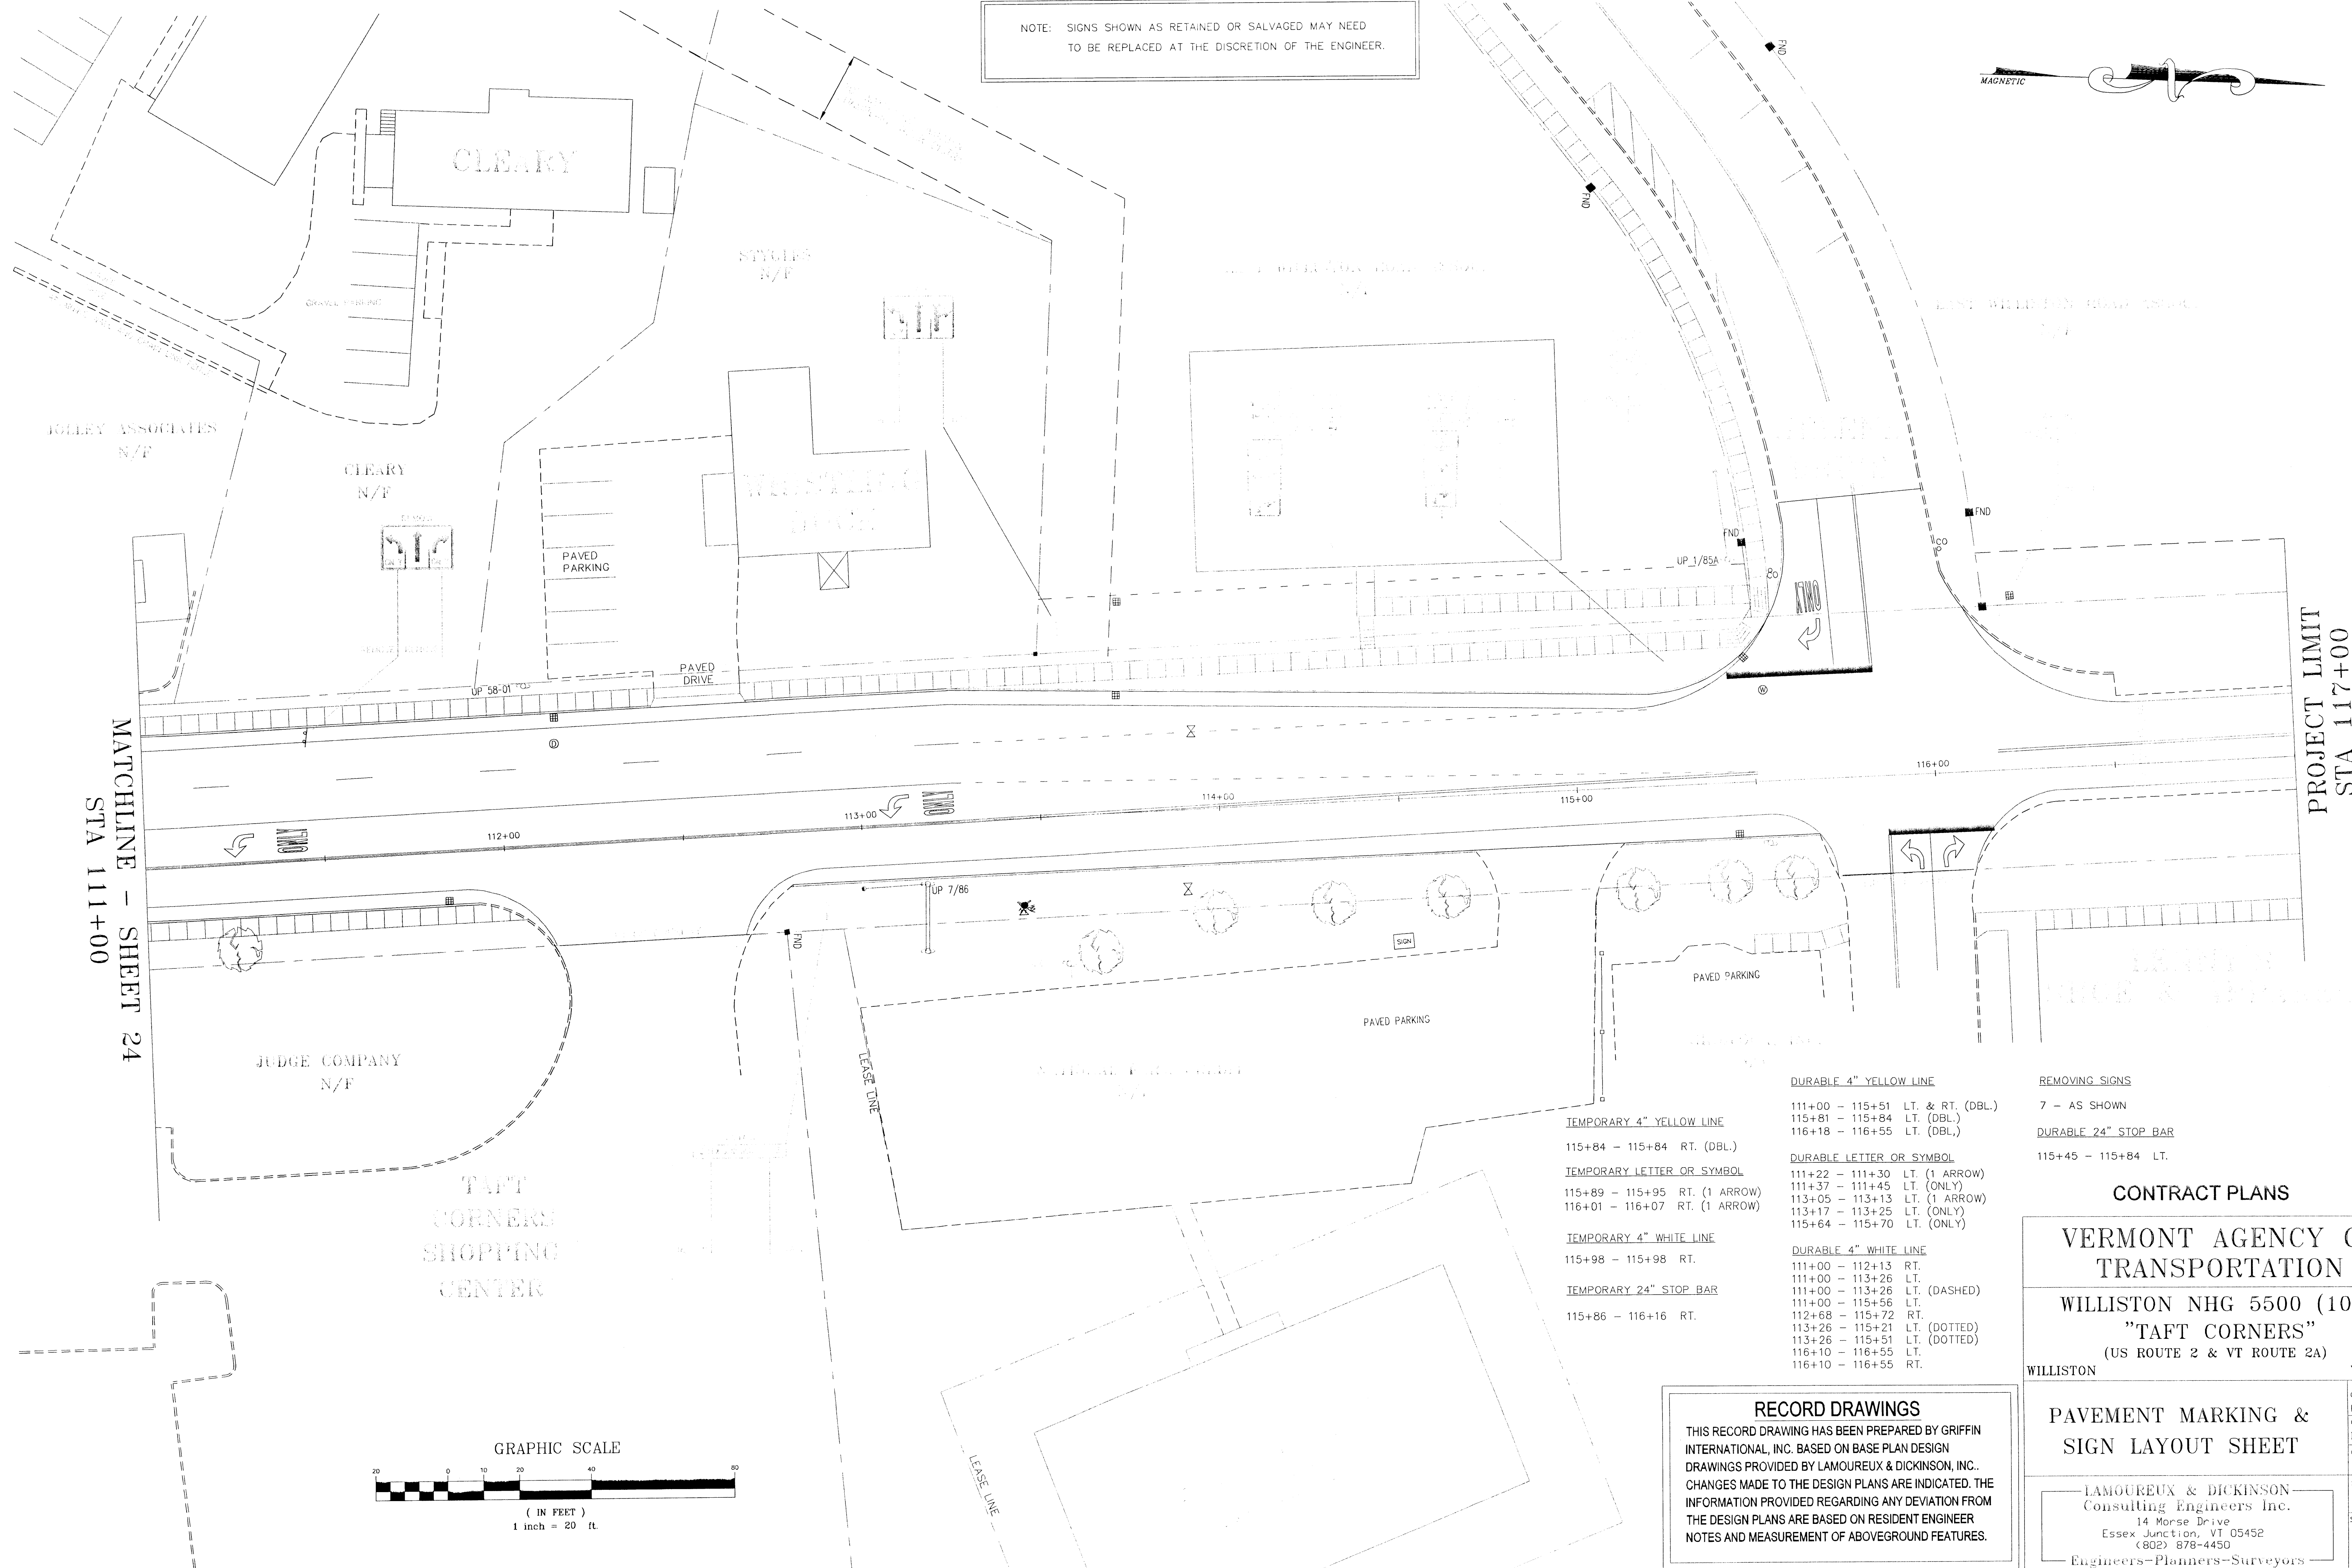


NOTE: SIGNS SHOWN AS RETAINED OR SALVAGED MAY NEED TO BE REPLACED AT THE DISCRETION OF THE ENGINEER.

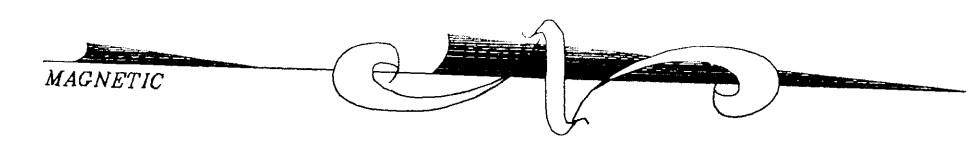


MATCHLINE - SHEET 24
STA 111+00

PROJECT LIMIT
STA 117+00

- TEMPORARY 4" YELLOW LINE**
115+84 - 115+84 RT. (DBL.)
- TEMPORARY LETTER OR SYMBOL**
115+89 - 115+95 RT. (1 ARROW)
116+01 - 116+07 RT. (1 ARROW)
- TEMPORARY 4" WHITE LINE**
115+98 - 115+98 RT.
- TEMPORARY 24" STOP BAR**
115+86 - 116+16 RT.
- DURABLE 4" YELLOW LINE**
111+00 - 115+51 LT. & RT. (DBL.)
115+81 - 115+84 LT. (DBL.)
116+18 - 116+55 LT. (DBL.)
- DURABLE LETTER OR SYMBOL**
111+22 - 111+30 LT. (1 ARROW)
111+37 - 111+45 LT. (ONLY)
113+05 - 113+13 LT. (1 ARROW)
113+17 - 113+25 LT. (ONLY)
115+64 - 115+70 LT. (ONLY)
- DURABLE 4" WHITE LINE**
111+00 - 112+13 RT.
111+00 - 113+26 LT.
111+00 - 113+26 LT. (DASHED)
111+00 - 115+56 LT.
112+68 - 115+72 RT.
113+26 - 115+21 LT. (DOTTED)
113+26 - 115+51 LT. (DOTTED)
116+10 - 116+55 LT.
116+10 - 116+55 RT.

- REMOVING SIGNS**
7 - AS SHOWN
- DURABLE 24" STOP BAR**
115+45 - 115+84 LT.

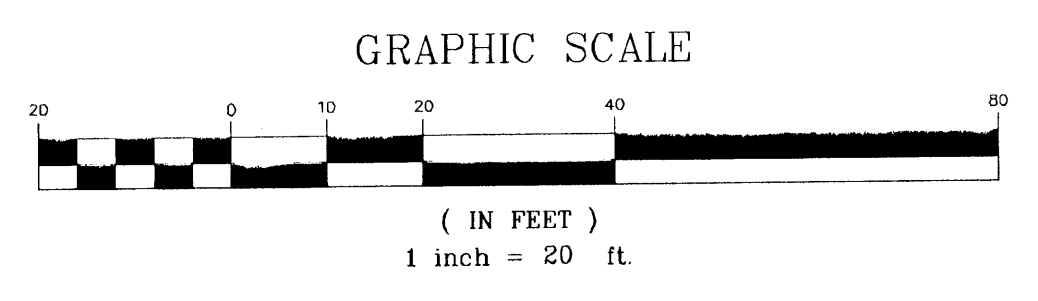

RECORD DRAWINGS
THIS RECORD DRAWING HAS BEEN PREPARED BY GRIFFIN INTERNATIONAL, INC. BASED ON BASE PLAN DESIGN DRAWINGS PROVIDED BY LAMOUREUX & DICKINSON, INC. CHANGES MADE TO THE DESIGN PLANS ARE INDICATED. THE INFORMATION PROVIDED REGARDING ANY DEVIATION FROM THE DESIGN PLANS ARE BASED ON RESIDENT ENGINEER NOTES AND MEASUREMENT OF ABOVEGROUND FEATURES.

CONTRACT PLANS

VERMONT AGENCY OF TRANSPORTATION

WILLISTON NHG 5500 (10)S "TAFT CORNERS"
(US ROUTE 2 & VT ROUTE 2A)

WILLISTON VERMONT

PAVEMENT MARKING & SIGN LAYOUT SHEET

design RJD/JLC
drawn DWE/JLC
checked RJD

scale 1" = 20'
sht. no. 28

LAMOUREUX & DICKINSON
Consulting Engineers Inc.
14 Morse Drive
Essex Junction, VT 05452
(802) 878-4450
Engineers-Planners-Surveyors