


MATCHLINE - SHEET 3  
STA 111+00

MATCHLINE - SHEET 8  
STA 117+00

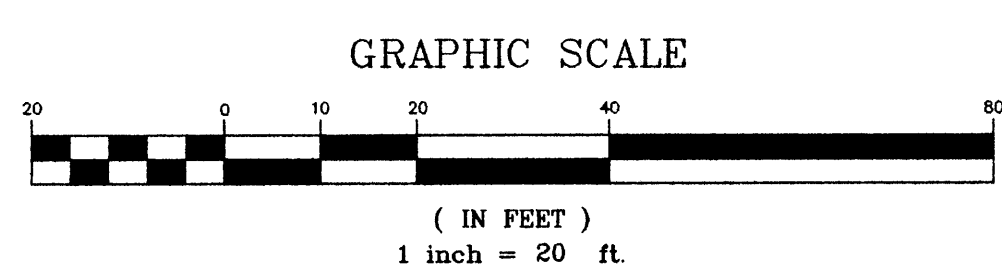

**THIS SHEET FOR  
R.O.W. USE ONLY**

VERMONT AGENCY OF  
TRANSPORTATION  
WILLISTON NHG 5500 (10)S  
"TAFT CORNERS"  
(US ROUTE 2 & VT ROUTE 2A)

WILLISTON VERMONT  
**R.O.W. PLANS**  
HORIZONTAL LAYOUT &  
CONSTRUCTION PLANS

LAMOUREUX & DICKINSON  
Consulting Engineers Inc.  
14 Morse Drive  
Essex Junction, VT 05452  
(802) 878-4450  
Engineers-Planners-Surveyors

design  
RJD  
drawn  
JLC  
checked  
RJD  
scale  
1"=20'  
sh. no.  
7

X:\cadd\1998\08\03\02\02\000