


**INDEX OF SHEETS**  
SEE SHEET 2 OF 105

# STATE OF VERMONT AGENCY OF TRANSPORTATION



## PROPOSED IMPROVEMENT CLASS I TOWN HIGHWAY CITY OF ST. ALBANS COUNTY OF FRANKLIN

**PROJECT LOCATION**  
STP 9804(1)S  
STP 2129(1)S  
STP 2204(1)S

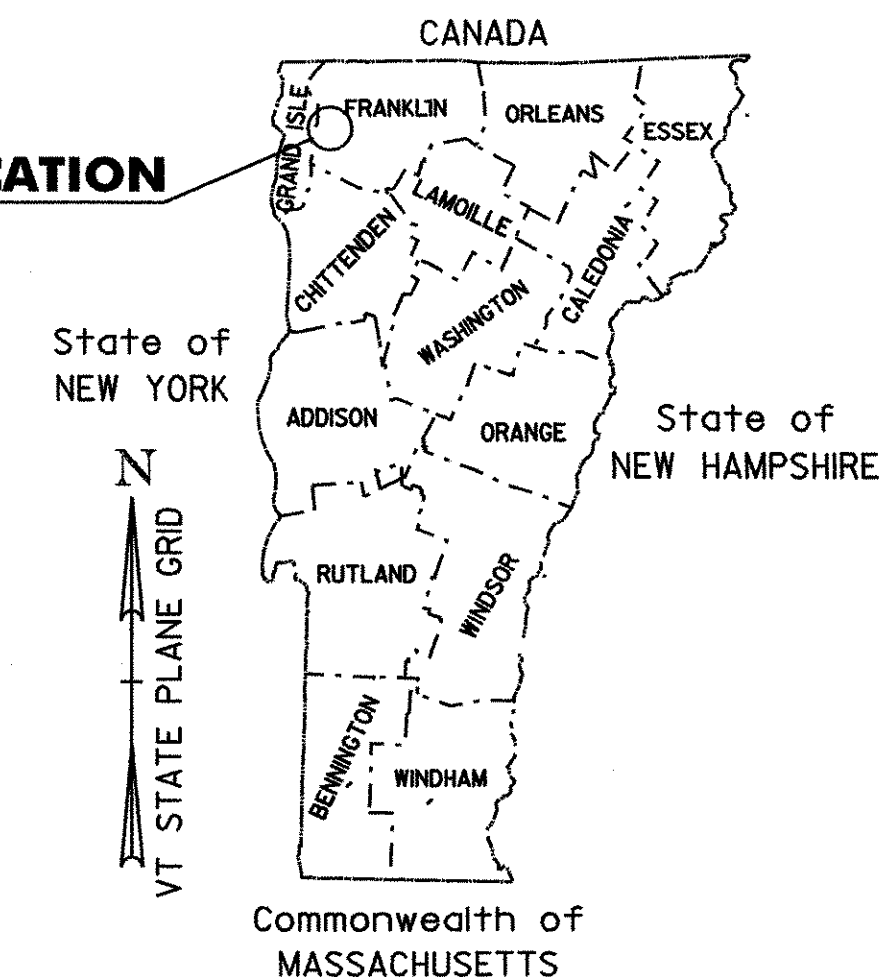

RECORD PLANS	
CONTRACTOR:	PIKE INDUSTRIES
RESIDENT ENGINEER:	DELVIN WARNER
CONSTRUCTION BEGAN:	JULY 21, 2003
CONSTRUCTION COMPLETE:	OCTOBER 31, 2003
RECORD PLANS BY:	N. GARBACIK & K. NORTH
I HEREBY CERTIFY THAT ALL THE CONSTRUCTION REQUIRED BY THIS SET OF DRAWINGS HAS BEEN ACCOMPLISHED AS INDICATED HEREIN.	
BY <i>Delvin Warner</i>	RESIDENT ENGINEER
DATE <i>01/26/05</i>	
NOTE: Any further information concerning final quantities, amounts or other details relative to this project may be found at Central Files in the electronic archives.	

**ST. ALBANS CITY**  
STP 9804(1)S  
U.S. ROUTE 7  
SEE SHEET 12 OF 105

**ST. ALBANS CITY**  
STP 2129(1)S  
VT ROUTE 36  
SEE SHEET 70 OF 105

**ST. ALBANS CITY-ST. ALBANS**  
STP 2204(1)S  
ST ALBANS STATE HIGHWAY  
SEE SHEET 90 OF 105

**BEGIN STP 9804(1)S**  
U.S. ROUTE 7 - MAIN STREET  
ST. ALBANS CITY  
STA. 0+000.00 (MM 0.000)

**BEGIN STP 2204(1)S**  
ST. ALBANS STATE HIGHWAY  
ST. ALBANS CITY  
STA. 0+008.00 (MM 0.005)

**END STP 9804(1)S**  
U.S. ROUTE 7 - MAIN STREET  
ST. ALBANS CITY  
STA. 3+640.40 (MM 2.262)

**BEGIN STP 2129(1)S**  
VT ROUTE 36 - FAIRFIELD STREET  
ST. ALBANS CITY  
STA. 1+406.57 (MM 0.874)

**END STP 2129(1)S**  
VT ROUTE 36 - FAIRFIELD STREET  
ST. ALBANS CITY  
STA. 2+397.92 (MM 1.490)

**END STP 2204(1)S**  
ST. ALBANS STATE HIGHWAY  
ST. ALBANS TOWN  
STA. 1+039.64 (MM 0.646)

**UTILITY LEGEND**

- ⊙ = EXISTING HYDRANT
- ⊕ = EXISTING DI
- = EXISTING MANHOLE
- ⊙TEL = EXISTING TELEPHONE MANHOLE
- ⊙ELEC = EXISTING ELECTRIC MANHOLE
- ⊙SMH = EXISTING SEWER MANHOLE
- WSO = EXISTING WATER SHUTOFF
- GSO = EXISTING GAS SHUTOFF
- ☐ = EXISTING MAILBOX

**SIGN LEGEND**

- N = NEW
- R = REMOVE
- R&S = REMOVE & SALVAGE
- S = SALVAGE SIGN
- RET = RETAIN
- B-B = BACK TO BACK
- ⊕ = RETURN TO CITY OF ST. ALBANS

**CONVENTIONAL SYMBOLS**

<p>COUNTY LINE</p> <p>TOWN LINE</p> <p>LIMITS OF ACCESS</p> <p>POINT OF ACCESS</p> <p>FENCE LINE</p> <p>STONE WALL</p> <p>TRAVELED WAY</p> <p>GUARD RAIL</p> <p>RAILROAD</p> <p>SURVEY LINE</p> <p>CULVERT</p> <p>POWER POLE</p> <p>TELEPHONE POLE</p> <p>TREES</p> <p>CONTROL OF ACCESS</p> <p>PROPERTY LINE</p> <p>R.O.W. TAKING LINE</p> <p>SLOPE RIGHTS</p> <p>TOP OF CUT</p> <p>TOE OF SLOPE</p>	
---	--


SURVEYED BY : D-H

SURVEYED DATE : 06-07-00

DATUM

VERTICAL N/A

HORIZONTAL N/A

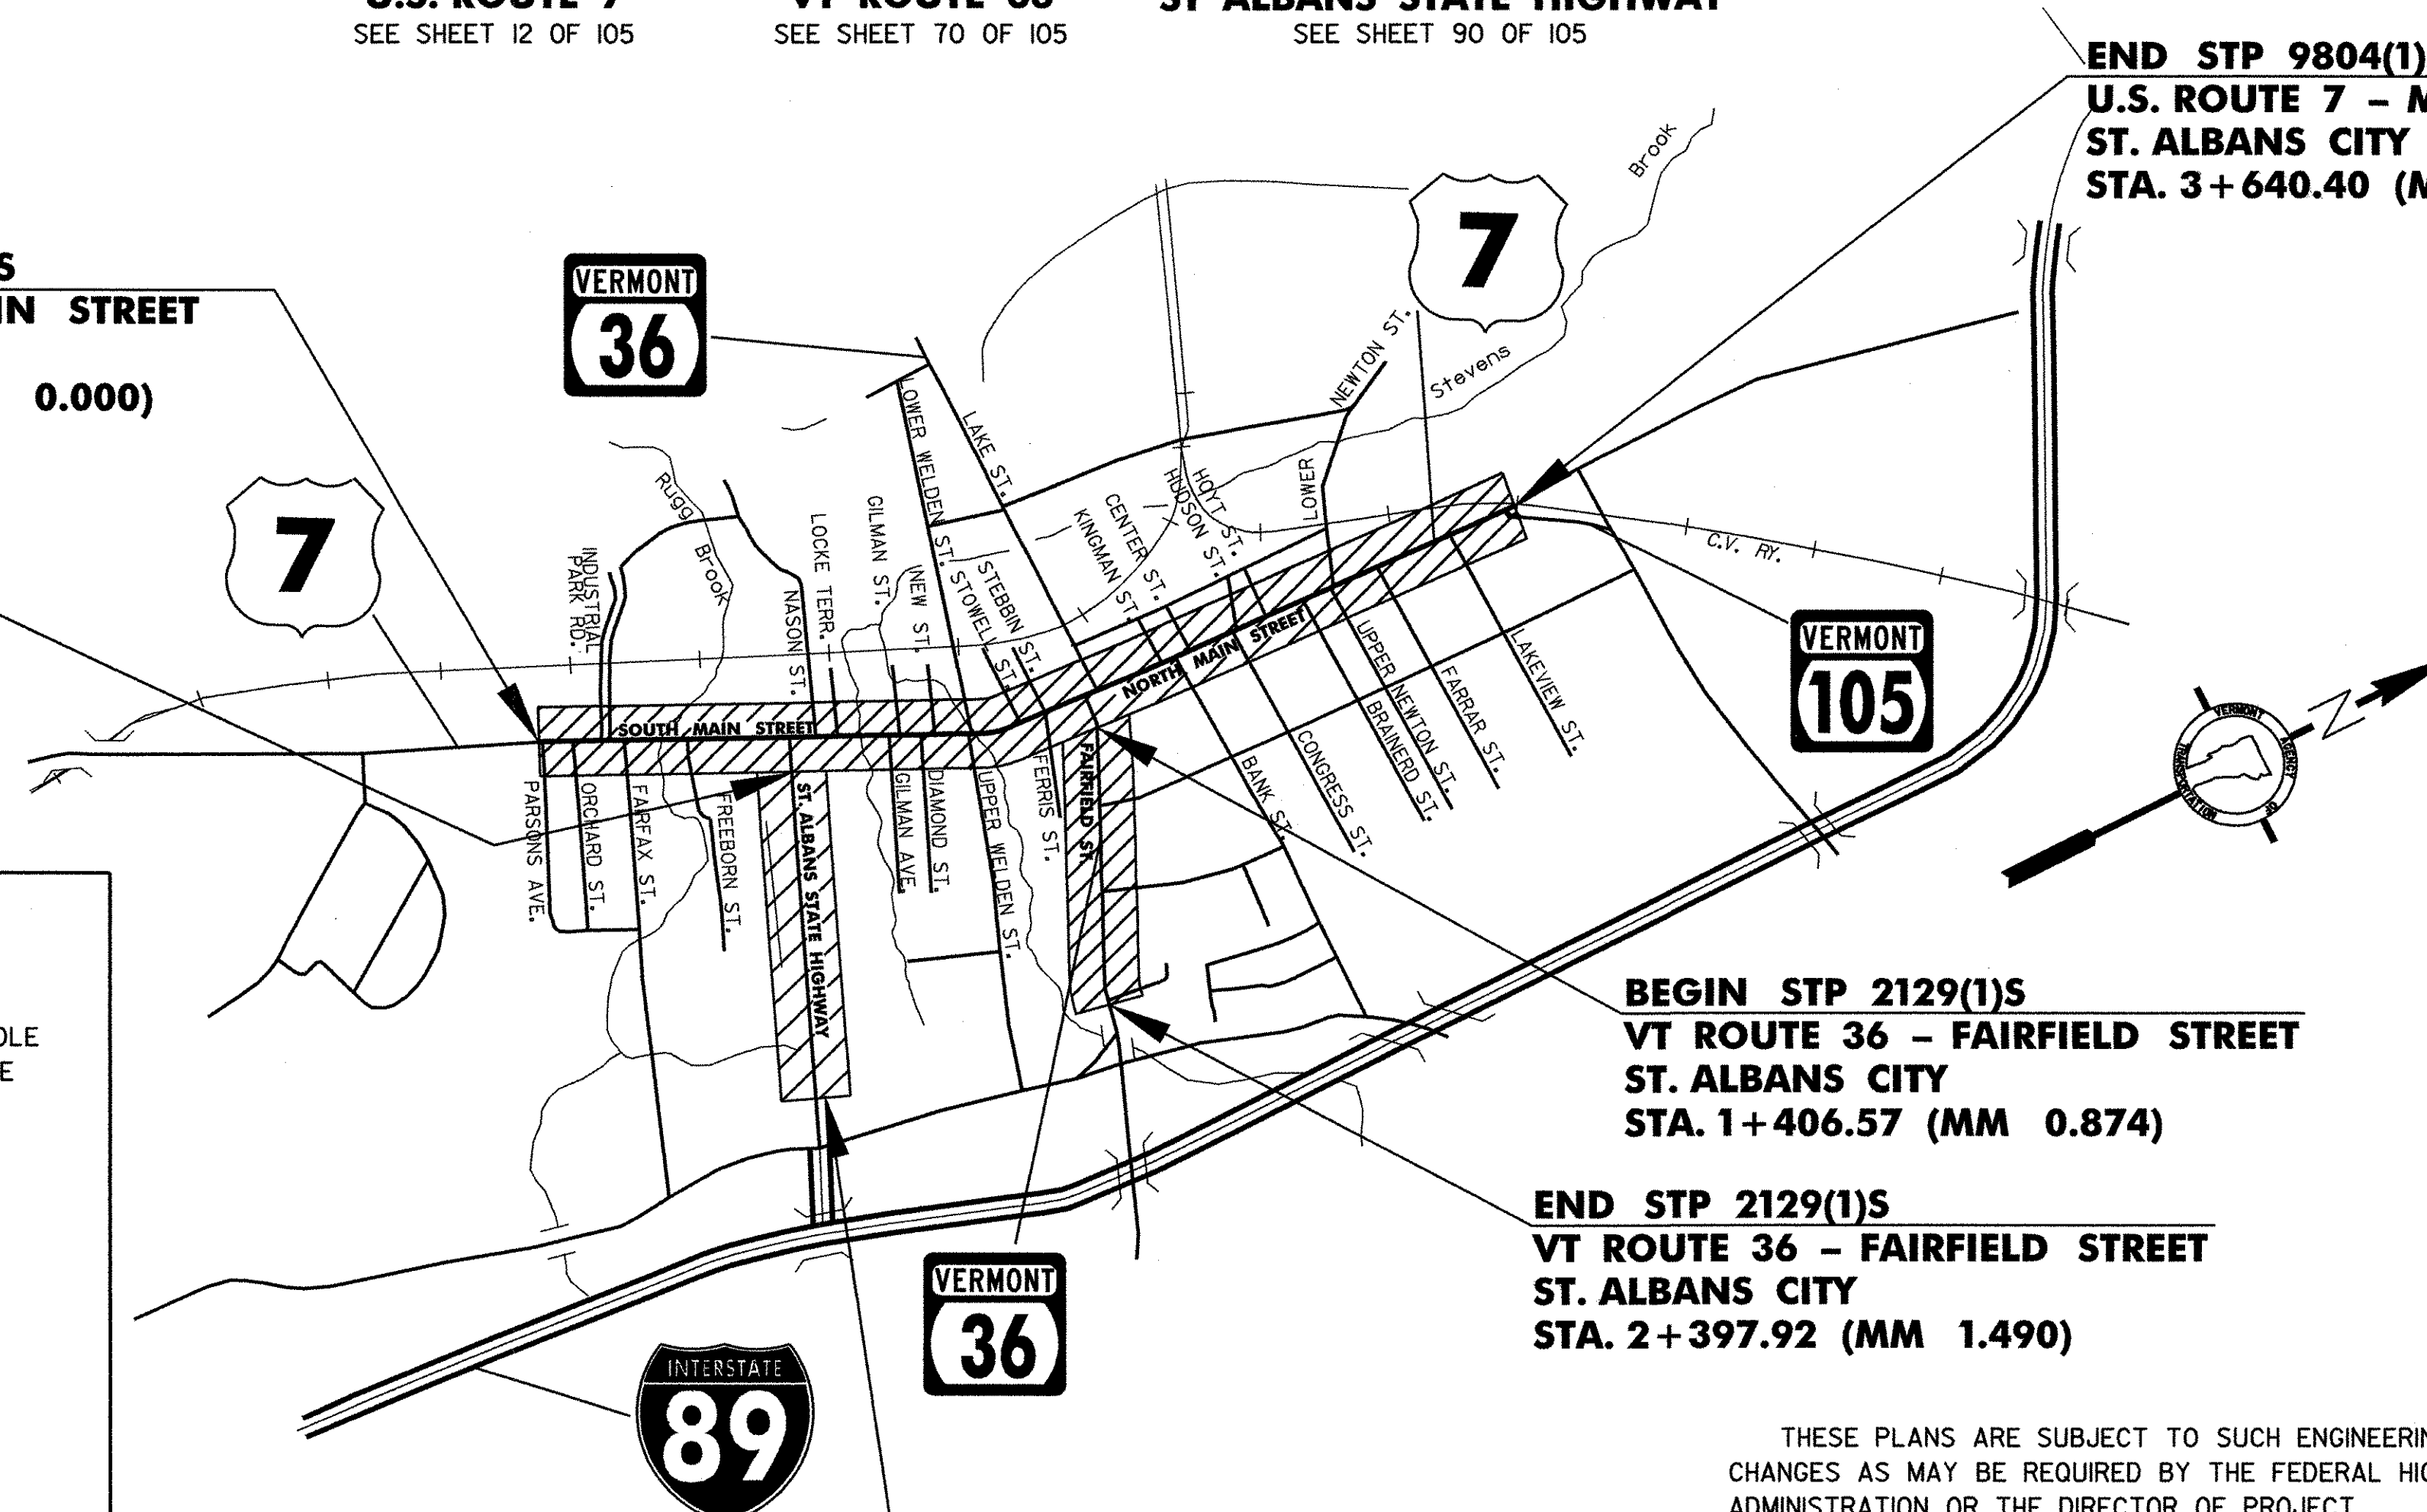

NOTE:  
RIGHT-OF-WAY LIMITS, IF APPLICABLE, ARE PROVIDED SOLELY FOR THE CONVENIENCE OF THE STATE AND ITS CONTRACTOR DURING THE COURSE OF THIS PAVING PROJECT. ANY REFERENCES TO OFFSETS ON THESE PLANS ARE APPROXIMATE AND SHOULD NOT BE RELIED UPON FOR ANY PURPOSES.  
UNLESS OTHERWISE NOTED, ALL DRAWINGS AND DETAILS ON THESE PLANS ARE DRAWN "NOT TO SCALE".

**Metric**  
UNLESS NOTED OTHERWISE  
STATIONS ARE IN KILOMETERS  
ELEVATIONS ARE IN METERS  
DIMENSIONS ARE IN MILLIMETERS

THESE PLANS ARE SUBJECT TO SUCH ENGINEERING CHANGES AS MAY BE REQUIRED BY THE FEDERAL HIGHWAY ADMINISTRATION OR THE DIRECTOR OF PROJECT DEVELOPMENT.  
CONSTRUCTION IS TO BE CARRIED ON IN ACCORDANCE WITH THESE PLANS AND THE STANDARD SPECIFICATIONS FOR CONSTRUCTION DATED 2001, AS APPROVED BY THE FEDERAL HIGHWAY ADMINISTRATION ON JANUARY 4, 2001 FOR USE ON THIS PROJECT, INCLUDING ALL SUBSEQUENT REVISIONS AND SUCH REVISED SPECIFICATIONS AND SPECIAL PROVISIONS AS ARE INCORPORATED IN THESE PLANS.

DEPARTMENT OF TRANSPORTATION FEDERAL HIGHWAY ADMINISTRATOR	
APPROVED _____	DATE _____
DIRECTOR OF PROJECT DEVELOPMENT	
APPROVED <i>[Signature]</i>	DATE <i>4/6/03</i>
PROJECT MANAGER :	
PROJECT NAME : ST. ALBANS CITY ST. ALBANS CITY-ST. ALBANS	
PROJECT NUMBER : STP 9804(1)S / STP 2129(1)S STP 2204(1)S	
SHEET 1 OF 105 SHEETS	