


NOTE: FOR NEW SIGNS AND ALL CONSTRUCTION NOTES, SEE NEXT SHEET.

REMOVING SIGNS AS SHOWN - 16

REMOVAL AND DISPOSAL OF GUARD RAIL
 STA. 0+847.0 TO 0+873.5, LT.
 STA. 0+881.5 TO 0+905.5, LT.
 STA. 0+908.0 TO 0+915.5, RT.
 STA. 0+917.5 TO 0+929.0, LT.

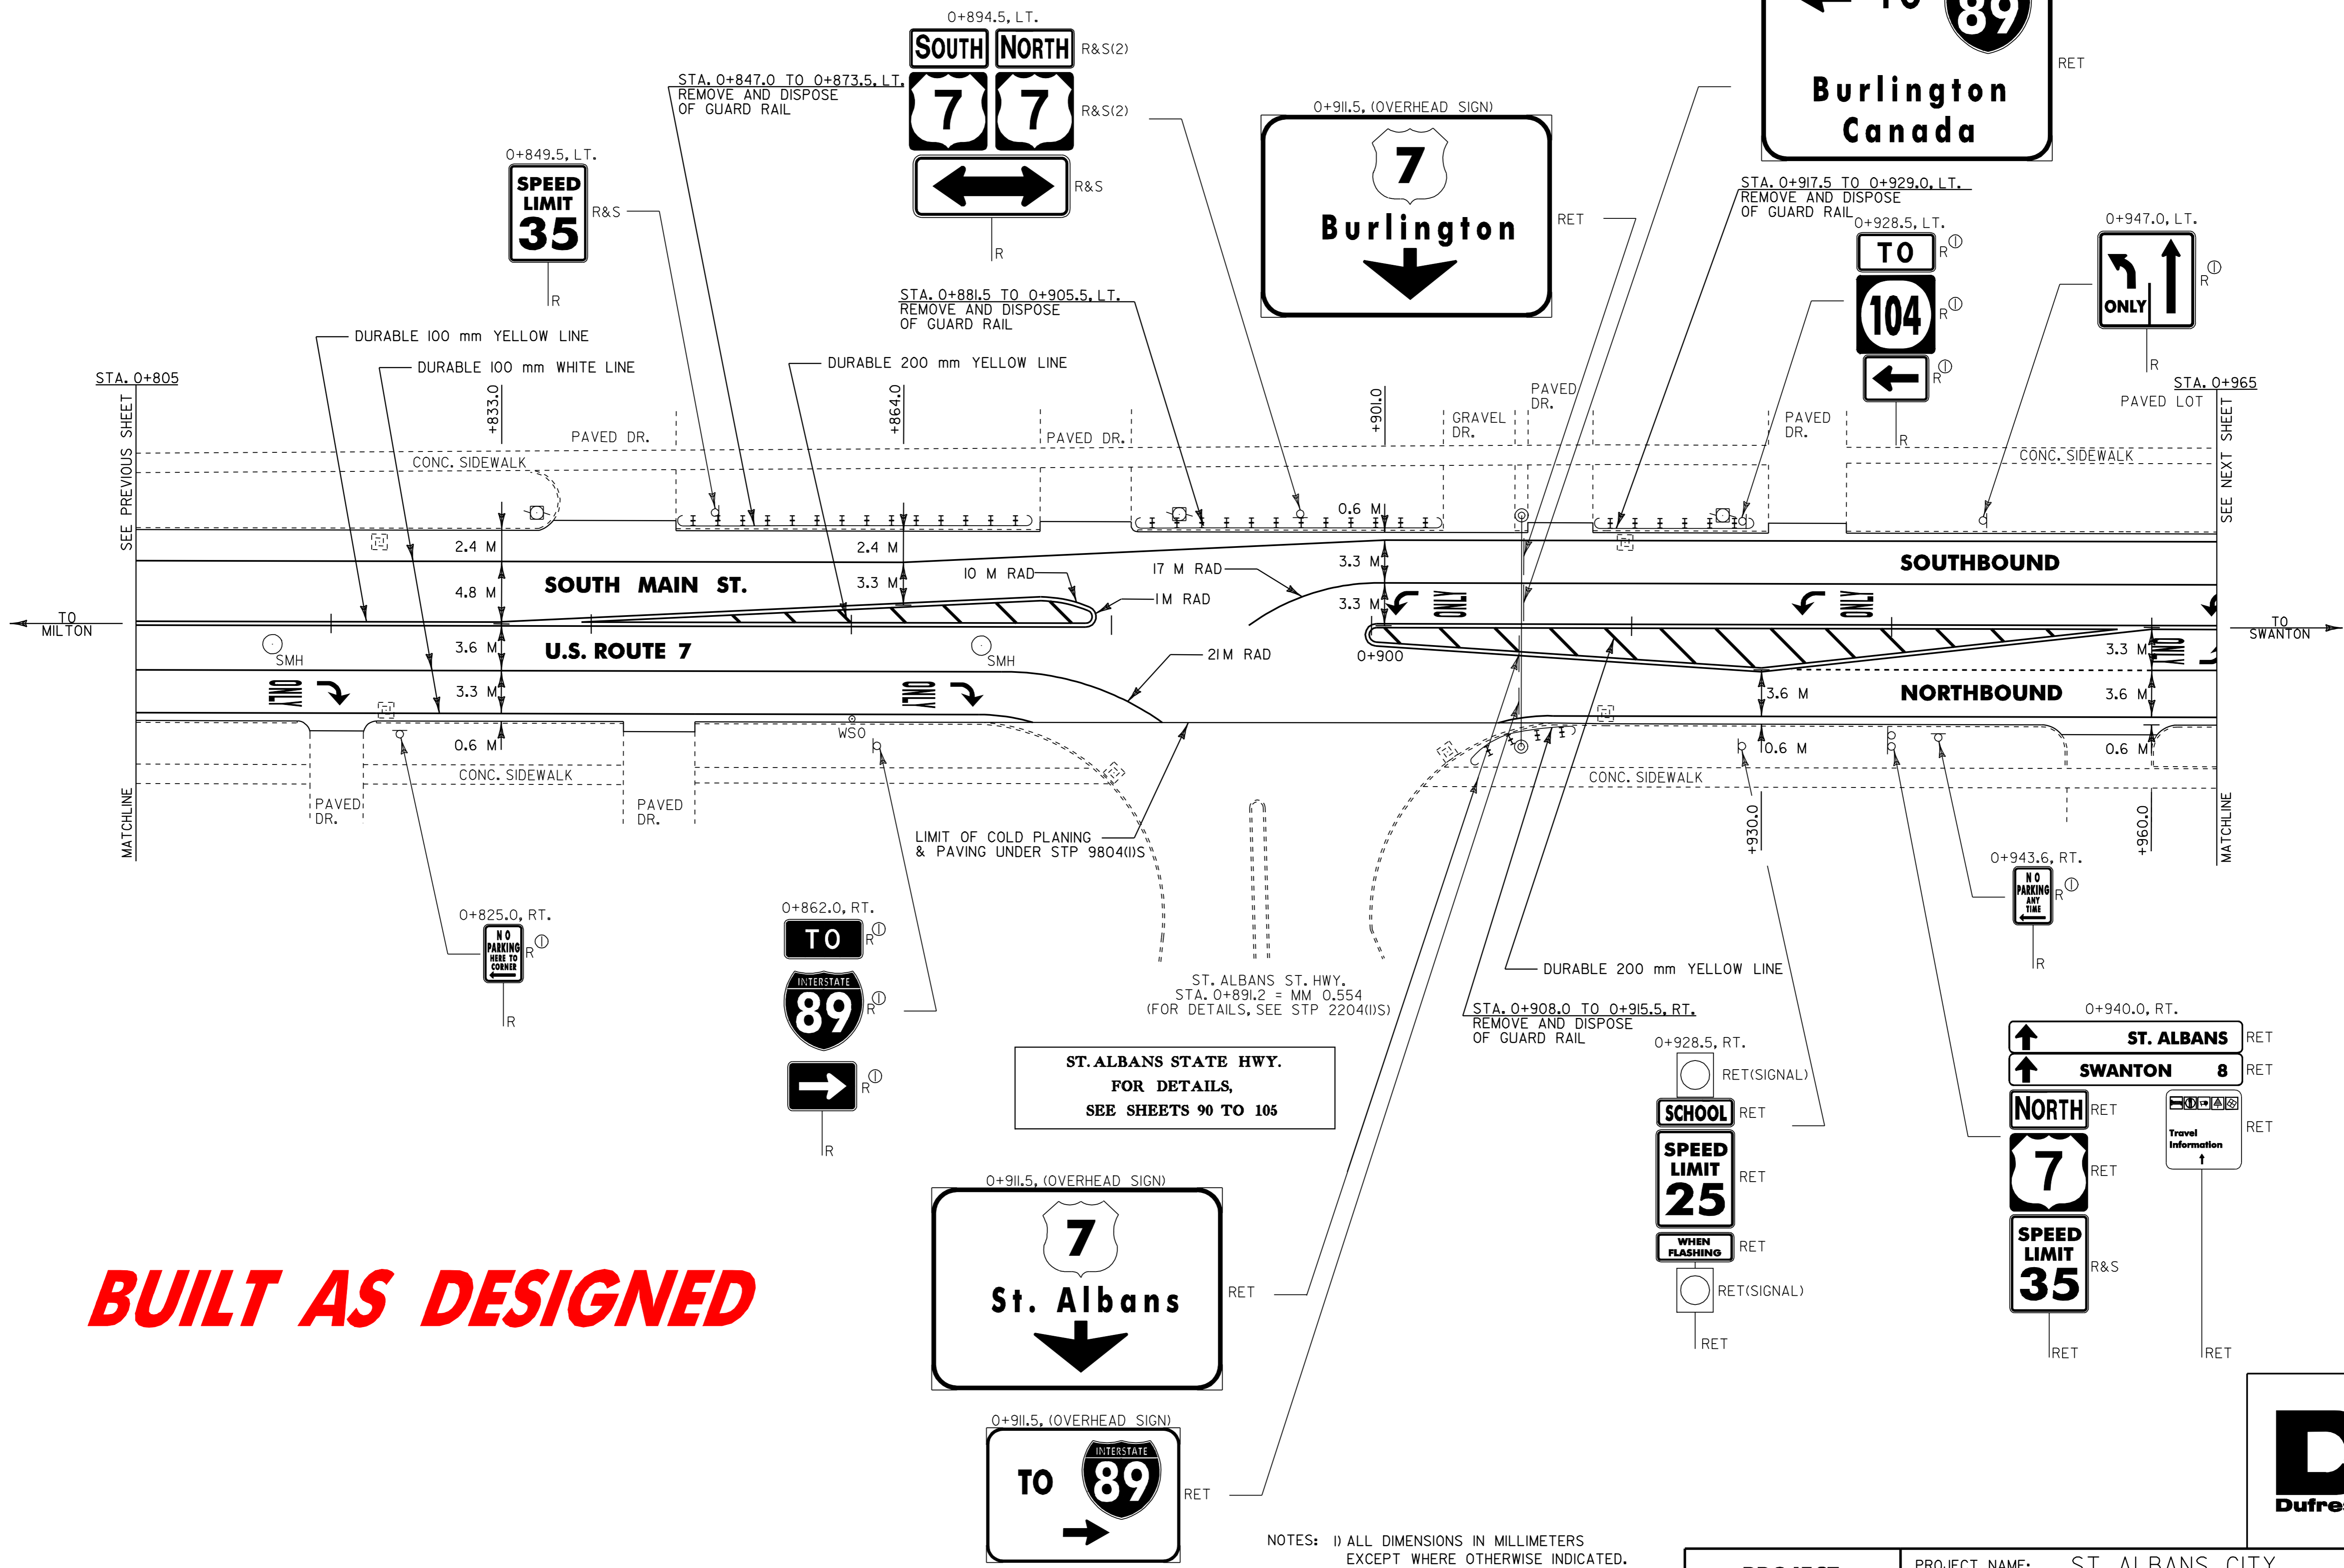

BUILT AS DESIGNED

**ST. ALBANS STATE HWY.
 FOR DETAILS,
 SEE SHEETS 90 TO 105**

- NOTES: 1) ALL DIMENSIONS IN MILLIMETERS EXCEPT WHERE OTHERWISE INDICATED.
 2) ALL EXISTING SIGNS NOT SHOWN SHALL BE RETAINED AS DIRECTED BY THE RESIDENT ENGINEER.
 3) FOR ANY TOWN HIGHWAY OR STREET DETAILS, SEE VTRANS STANDARD E-193M.

**PROJECT LAYOUT #6A
 EXISTING SIGNS AND
 GUARD RAIL**

PROJECT NAME:	ST. ALBANS CITY	PLOT DATE:	01-FEB-2006 07:4
PROJECT NUMBER:	STP_9804(I)S	DRAWN BY:	D-H
FILE NAME:	zpqve297d150zpd150.dgn	CHECKED BY:	
DESIGNED BY:	D-H	SHEET	_24_ OF 105
IPARM FILE NAME:	pd150p6a.i		

