

**TEMPORARY & DURABLE 100 mm WHITE LINE**  
 STA. 0+965.0 TO I+120.0, SOLID LT.  
 (PARKING SPACES & DIAGONALS)  
 STA. 0+965.0 TO I+120.0, SOLID LT. & RT.  
 (WITH EDGELINE BREAKS FOR NASON ST.  
 & LOCKE TERR.)  
 STA. 0+983.0, SOLID LT. (NASON ST. EDGLINES)  
 STA. 0+965.0 TO 0+970.0, SOLID LT. (LANE LINE)  
 STA. 0+965.0 TO 0+983.0, SOLID RT. (LANE LINE)  
 STA. 0+993.0 TO I+060.0, SOLID LT. (LANE LINE)  
 STA. I+060.0 TO I+100.0, DOTTED LT.  
 STA. I+104.9, SOLID LT. (LOCKE TERR. EDGLINES)

**TEMPORARY & DURABLE 100 mm YELLOW LINE**  
 STA. 0+965.0 TO I+120.0, SOLID LT. & RT.  
 (WITH CENTERLINE BREAKS FOR NASON ST.,  
 LOCKE TERR. & CROSSWALK)  
 STA. 0+983.0, DOUBLE SOLID LT. (NASON ST.)  
 STA. I+104.9, DOUBLE SOLID LT. (LOCKE TERR.)

**DURABLE LETTER OR SYMBOL (TYPE I TAPE)**  
 0+966 STA. 0+965.2, LT. - "ONLY"  
 0+970 STA. 0+968.8, LT. - "ONLY"  
 STA. 0+983.0, LT. - "STOP"  
 I+005 STA. I+004.2, RT. - "ONLY"  
 I+007 STA. I+004.8, RT. - "ONLY"  
 I+060 STA. I+055.2, RT. - "ONLY"  
 I+063 STA. I+058.8, RT. - "ONLY"  
 STA. I+104.9, LT. - "STOP"

**TEMPORARY LETTER OR SYMBOL**  
 STA. 0+965.2, LT. - "STOP"  
 STA. 0+983.0, LT. - "STOP"  
 STA. I+001.2, RT. - "STOP"  
 STA. I+055.2, RT. - "STOP"  
 STA. I+104.9, LT. - "STOP"

**REMOVING SIGNS**  
 AS SHOWN - 16

**RECTING SALVAGED SIGNS**  
 AS SHOWN - 4


**REHABILITATION OF DI'S, CB'S OR MH'S - CLASS I**  
 STA. I+013.5, LT. & RT. - DI'S  
 STA. I+090.0, LT. & RT. - DI'S

**CHANGING ELEVATION OF DI'S, CB'S OR MH'S**  
 STA. 0+982.0, LT. - MH

**CHANGING ELEVATION OF SMH'S**  
 STA. I+028.0, LT.

**ADJUST ELEVATION OF VALVE BOX**  
 STA. 0+979.0, RT. - WSO  
 STA. 0+980.0, LT. - WSO  
 STA. 0+982.0, LT. - WSO  
 STA. I+102.0, LT. - WSO

**PAINTED CURB**  
 IN NO-PARKING AREAS AS  
 DIRECTED BY RESIDENT ENGINEER

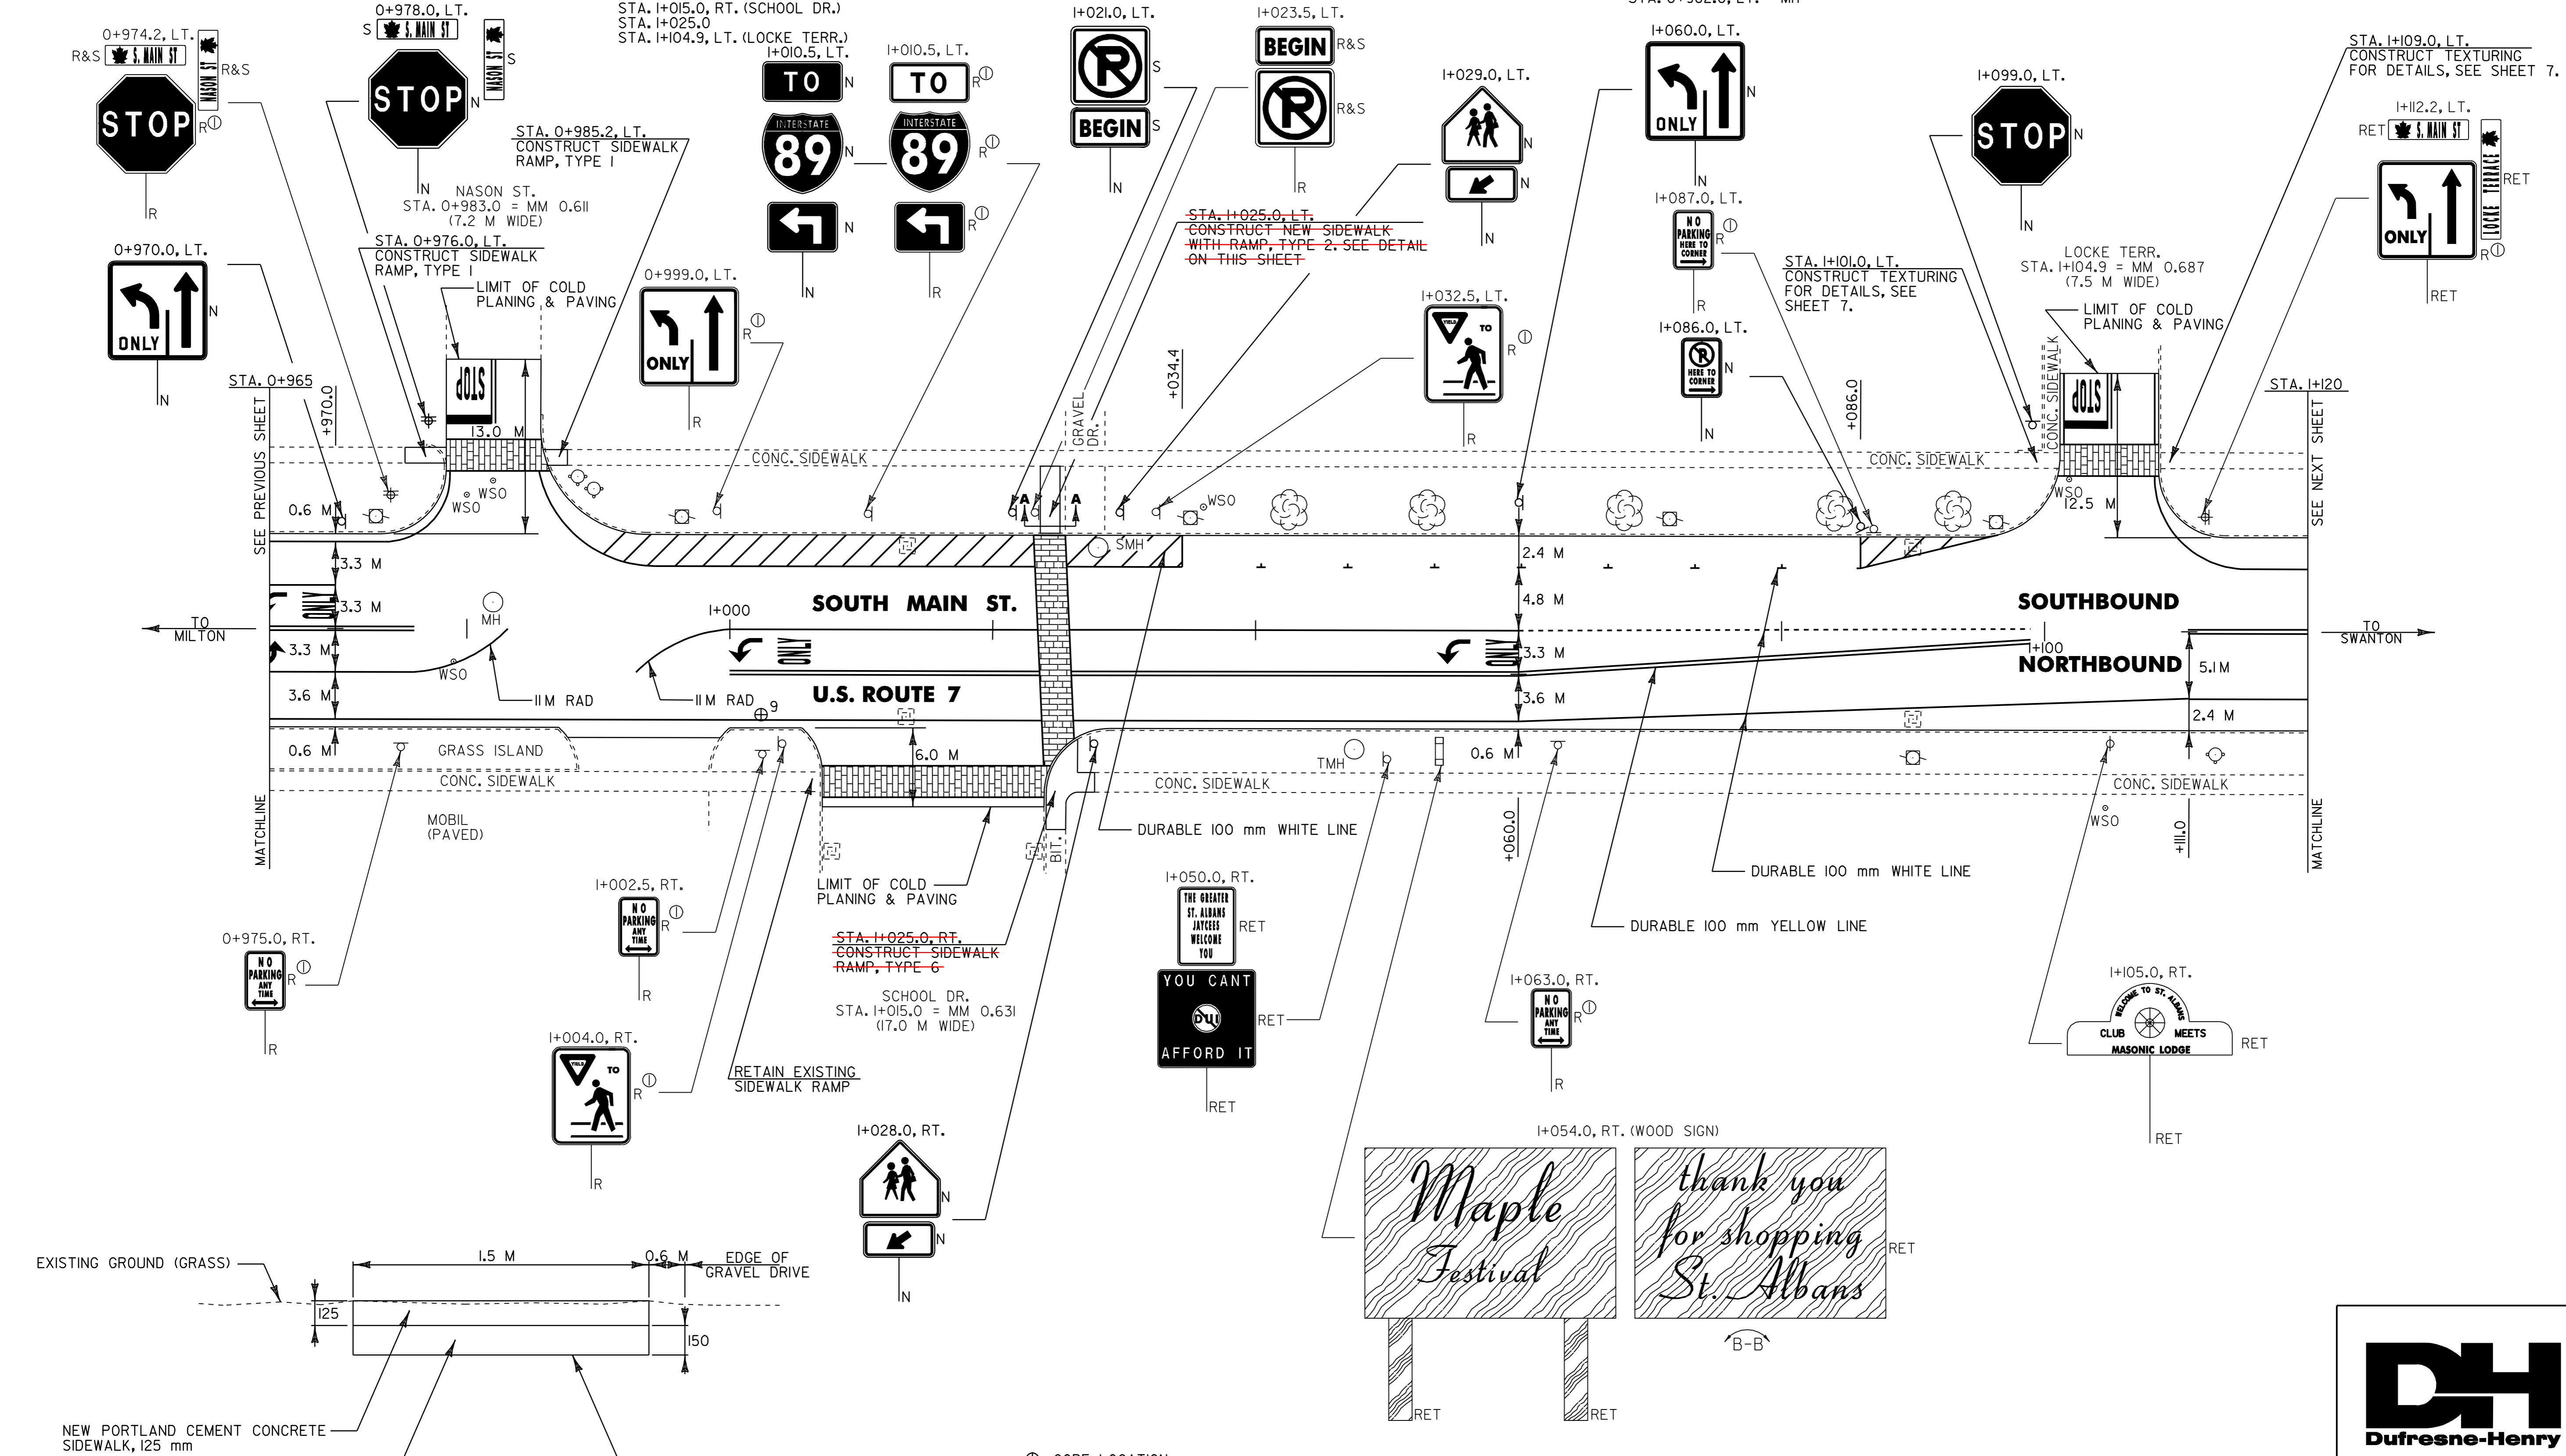

⊕ CORE LOCATION

PAVEMENT CORE DATA			
CORE #	LOCATION	DEPTH (mm)	PCC
9	I+102.4, RT.	152	NO

NOTES: 1) ALL DIMENSIONS IN MILLIMETERS EXCEPT WHERE OTHERWISE INDICATED.  
 2) ALL EXISTING SIGNS NOT SHOWN SHALL BE RETAINED AS DIRECTED BY THE RESIDENT ENGINEER.  
 3) FOR ANY TOWN HIGHWAY OR STREET DETAILS, SEE VTRANS STANDARD E-193M.

**LAYOUT SHEET #7**

PROJECT NAME: ST. ALBANS CITY  
 PROJECT NUMBER: STP\_9804(1)S  
 FILE NAME: Z:\pave\297d150\pd150.dgn  
 PROJECT LEADER: JLL  
 DESIGNED BY: D-H  
 IPARM FILE NAME: pd150p07.i  
 PLOT DATE: 01-FEB-2006 07:48  
 DRAWN BY: D-H  
 CHECKED BY:  
 SHEET 26 OF 105