

TEMPORARY & DURABLE 100 mm WHITE LINE
 STA. I+590.0 TO I+740.0, SOLID LT. & RT.
 (PARKING SPACES & DIAGONALS WITH EDGE LINE
 BREAKS FOR STOWELL ST. & CROSSWALK)
 STA. I+590.0 TO I+600.0, DOTTED LT.

TEMPORARY & DURABLE 100 mm YELLOW LINE
 STA. I+590.0 TO I+618.6, DOUBLE SOLID LT. & RT.
 STA. I+618.6 TO I+740.0, SOLID LT. & RT. (WITH
 CENTERLINE BREAKS FOR STOWELL ST. &
 CROSSWALK)
 STA. I+705.4, DOUBLE SOLID LT. (STOWELL ST.)

TEMPORARY & DURABLE 200 mm YELLOW LINE
 STA. I+590.0 TO I+618.6, SOLID LT. (DIAGONALS)

TEMPORARY & DURABLE LETTER OR SYMBOL (TYPE I TAPE)
 STA. I+634.0, LT. - STOP
 STA. I+646.8, LT. - STOP
 STA. I+705.4, LT. - STOP

TEMPORARY & DURABLE CROSSWALK WITH DIAGONAL LINES (MOD.)
 STA. I+705.4, LT. (STOWELL ST.)
 STA. I+721.0

REHABILITATION OF D'S, CB'S OR MH'S - CLASS J
 STA. I+603.0, LT. & RT. - D'S
 STA. I+680.5, RT. - DI
 STA. I+726.0, RT. - DI


ADJUST ELEVATION OF VALVE BOX
 STA. I+683.0, LT. - WSO
 STA. I+702.5, LT. - WSO
 STA. I+712.0, LT. - WSO
 STA. I+707.8, LT. - WSO

CHANGING ELEVATION OF D'S, CB'S OR MH'S
 STA. I+622.5, RT. - MH
 STA. I+661.0, RT. - MH

REMOVING SIGNS AS SHOWN - IO


PAINTED CURB - IN NO-PARKING AREAS AS DIRECTED BY RESIDENT ENGINEER

TEMPORARY & DURABLE 600 mm STOP BAR (TYPE I TAPE)
 STA. I+705.4, LT. (STOWELL ST.)

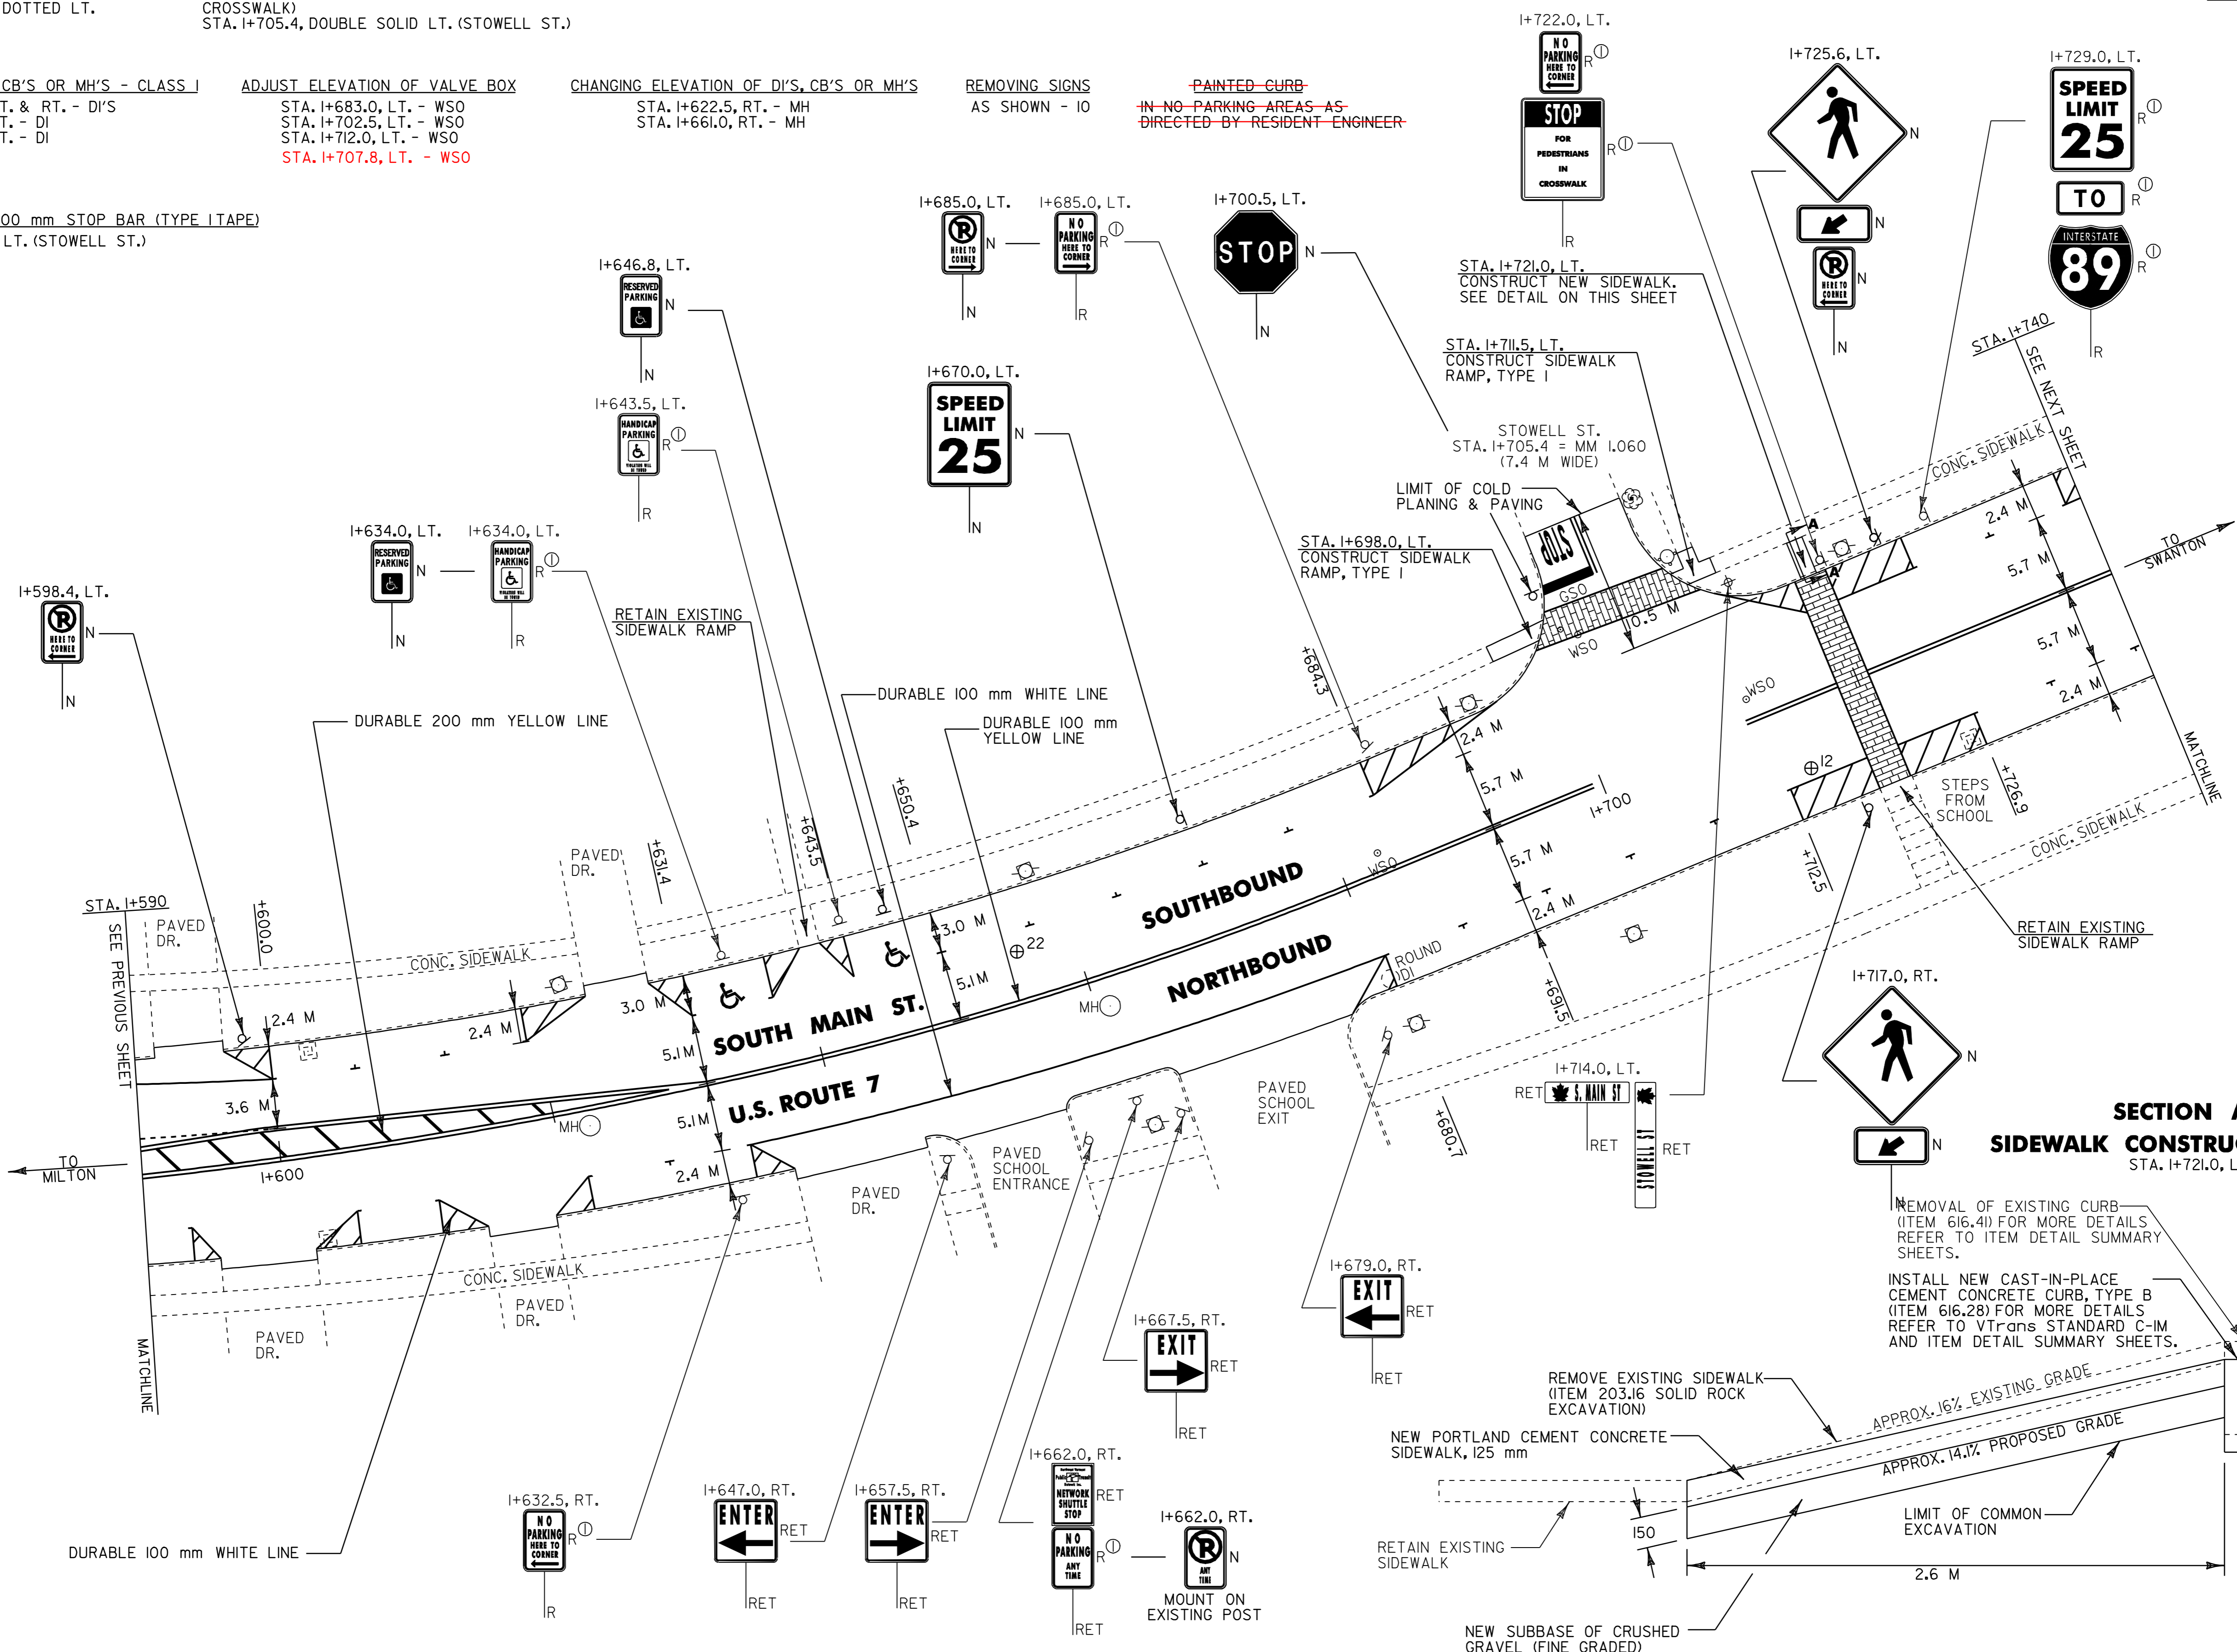

**SECTION A-A
 SIDEWALK CONSTRUCTION DETAIL
 STA. I+721.0, LT.**

REMOVAL OF EXISTING CURB (ITEM 616.4) FOR MORE DETAILS REFER TO ITEM DETAIL SUMMARY SHEETS.
 INSTALL NEW CAST-IN-PLACE CEMENT CONCRETE CURB, TYPE B (ITEM 616.28) FOR MORE DETAILS REFER TO VTRANS STANDARD C-1M AND ITEM DETAIL SUMMARY SHEETS.
 APPROXIMATE 50 mm EXISTING CURB REVEAL

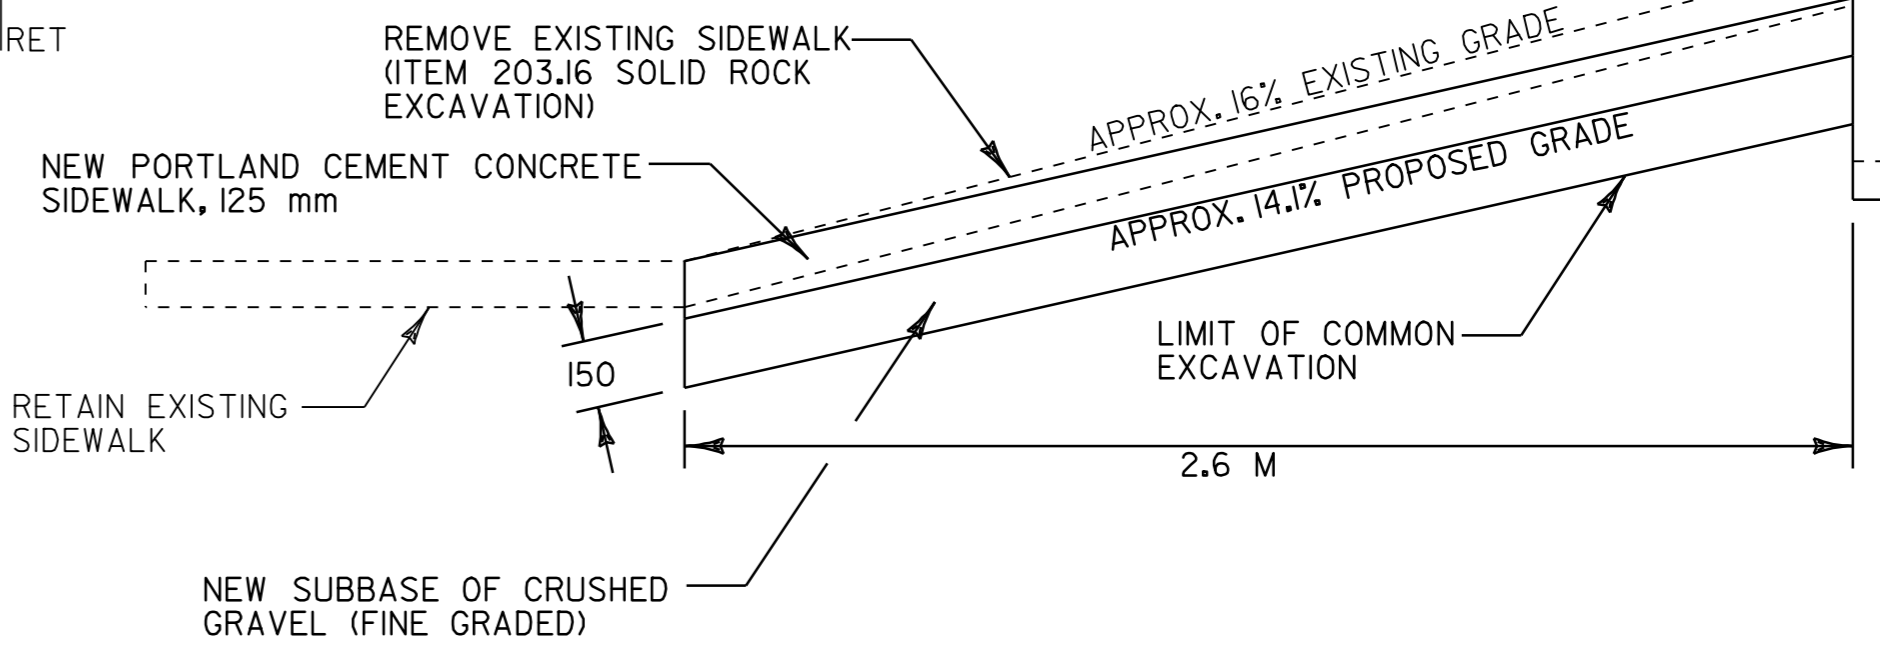

⊕ CORE LOCATION

PAVEMENT CORE DATA			
CORE #	LOCATION	DEPTH (mm)	PCC
12	I+714.0, RT.	191	NO
22	I+654.4, LT.	165	NO

NOTES:
 1) ALL DIMENSIONS IN MILLIMETERS EXCEPT WHERE OTHERWISE INDICATED.
 2) ALL EXISTING SIGNS NOT SHOWN SHALL BE RETAINED AS DIRECTED BY THE RESIDENT ENGINEER.
 3) FOR ANY TOWN HIGHWAY OR STREET DETAILS, SEE VTRANS STANDARD E-193M.

LAYOUT SHEET #11

PROJECT NAME: ST. ALBANS CITY
 PROJECT NUMBER: STP_9804(1)S
 FILE NAME: Z:\pave\97\dl50\pd150.dgn
 PROJECT LEADER: JLL
 DESIGNED BY: D-H
 IPARM FILE NAME: pd150pl11
 PLOT DATE: 01-FEB-2006 07:4
 DRAWN BY: D-H
 CHECKED BY:
 SHEET 30 OF 105

