

TEMPORARY & DURABLE 100 mm WHITE LINE
 STA. 2+820.0 TO 2+940.0, SOLID LT. & RT. (WITH EDGELINE BREAKS FOR UPPER NEWTON ST. & LOWER NEWTON ST.)
 STA. 2+820.0 TO 2+849.0, DOTTED RT.
 STA. 2+849.0 TO 2+880.5, SOLID RT. (LANE LINE)
 STA. 2+890.0, SOLID RT. (UPPER NEWTON ST. EDGELINES)
 STA. 2+898.0, SOLID LT. (LOWER NEWTON ST. EDGELINES & LANE LINE)
 STA. 2+918.0 TO 2+940.0, SOLID LT. (LANE LINE)

TEMPORARY & DURABLE 100 mm YELLOW LINE
 STA. 2+820.0 TO 2+849.0, DOUBLE SOLID LT. & RT.
 STA. 2+849.0 TO 2+940.0, SOLID LT. & RT. (WITH CENTERLINE BREAK FOR UPPER NEWTON ST. & LOWER NEWTON ST.)
 STA. 2+898.0, DOUBLE SOLID LT. (LOWER NEWTON ST.)

TEMPORARY & DURABLE 200 mm YELLOW LINE
 STA. 2+820.0 TO 2+849.0, SOLID LT. & RT. (DIAGONALS)


TEMPORARY & DURABLE CROSSWALK WITH DIAGONAL LINES (MOD.)
 STA. 2+890.0, RT. (UPPER NEWTON ST.)
 STA. 2+895.0
 STA. 2+898.0, LT. (LOWER NEWTON ST.)

TEMPORARY & DURABLE 600 mm STOP BAR (TYPE ITAPE)
 STA. 2+880.5, RT.
 STA. 2+898.0, LT. (LOWER NEWTON ST.)
 STA. 2+918.0, LT.
 STA. 2+922.0, LT.

DURABLE LETTER OR SYMBOL (TYPE ITAPE)
 STA. 2+850.2, RT. - "ONLY" 861.0
 STA. 2+851.0, RT. - "861.0
 STA. 2+853.8, RT. - "866.0, CL
 STA. 2+874.2, RT. - "ONLY" 867.0, CL
 STA. 2+877.0, RT. - "891.0, RT.
 STA. 2+877.8, RT. - "891.0, RT.
 STA. 2+898.0, LT. - "ONLY" (LOWER NEWTON ST.)
 STA. 2+898.0, LT. - " (LOWER NEWTON ST.)
 STA. 2+898.0, LT. - " (LOWER NEWTON ST.)
 STA. 2+920.7, LT. - "940.0, LT.
 STA. 2+924.3, LT. - "ONLY" 943.0, LT.

TEMPORARY LETTER OR SYMBOL
 STA. 2+851.0, RT. - " (LOWER NEWTON ST.)
 STA. 2+853.8, RT. - " (LOWER NEWTON ST.)
 STA. 2+877.0, RT. - " (LOWER NEWTON ST.)
 STA. 2+877.8, RT. - " (LOWER NEWTON ST.)
 STA. 2+898.0, LT. - " (LOWER NEWTON ST.)
 STA. 2+898.0, LT. - " (LOWER NEWTON ST.)
 STA. 2+920.7, LT. - " (LOWER NEWTON ST.)
 STA. 2+924.3, LT. - " (LOWER NEWTON ST.)

REMOVING SIGNS AS SHOWN - 3

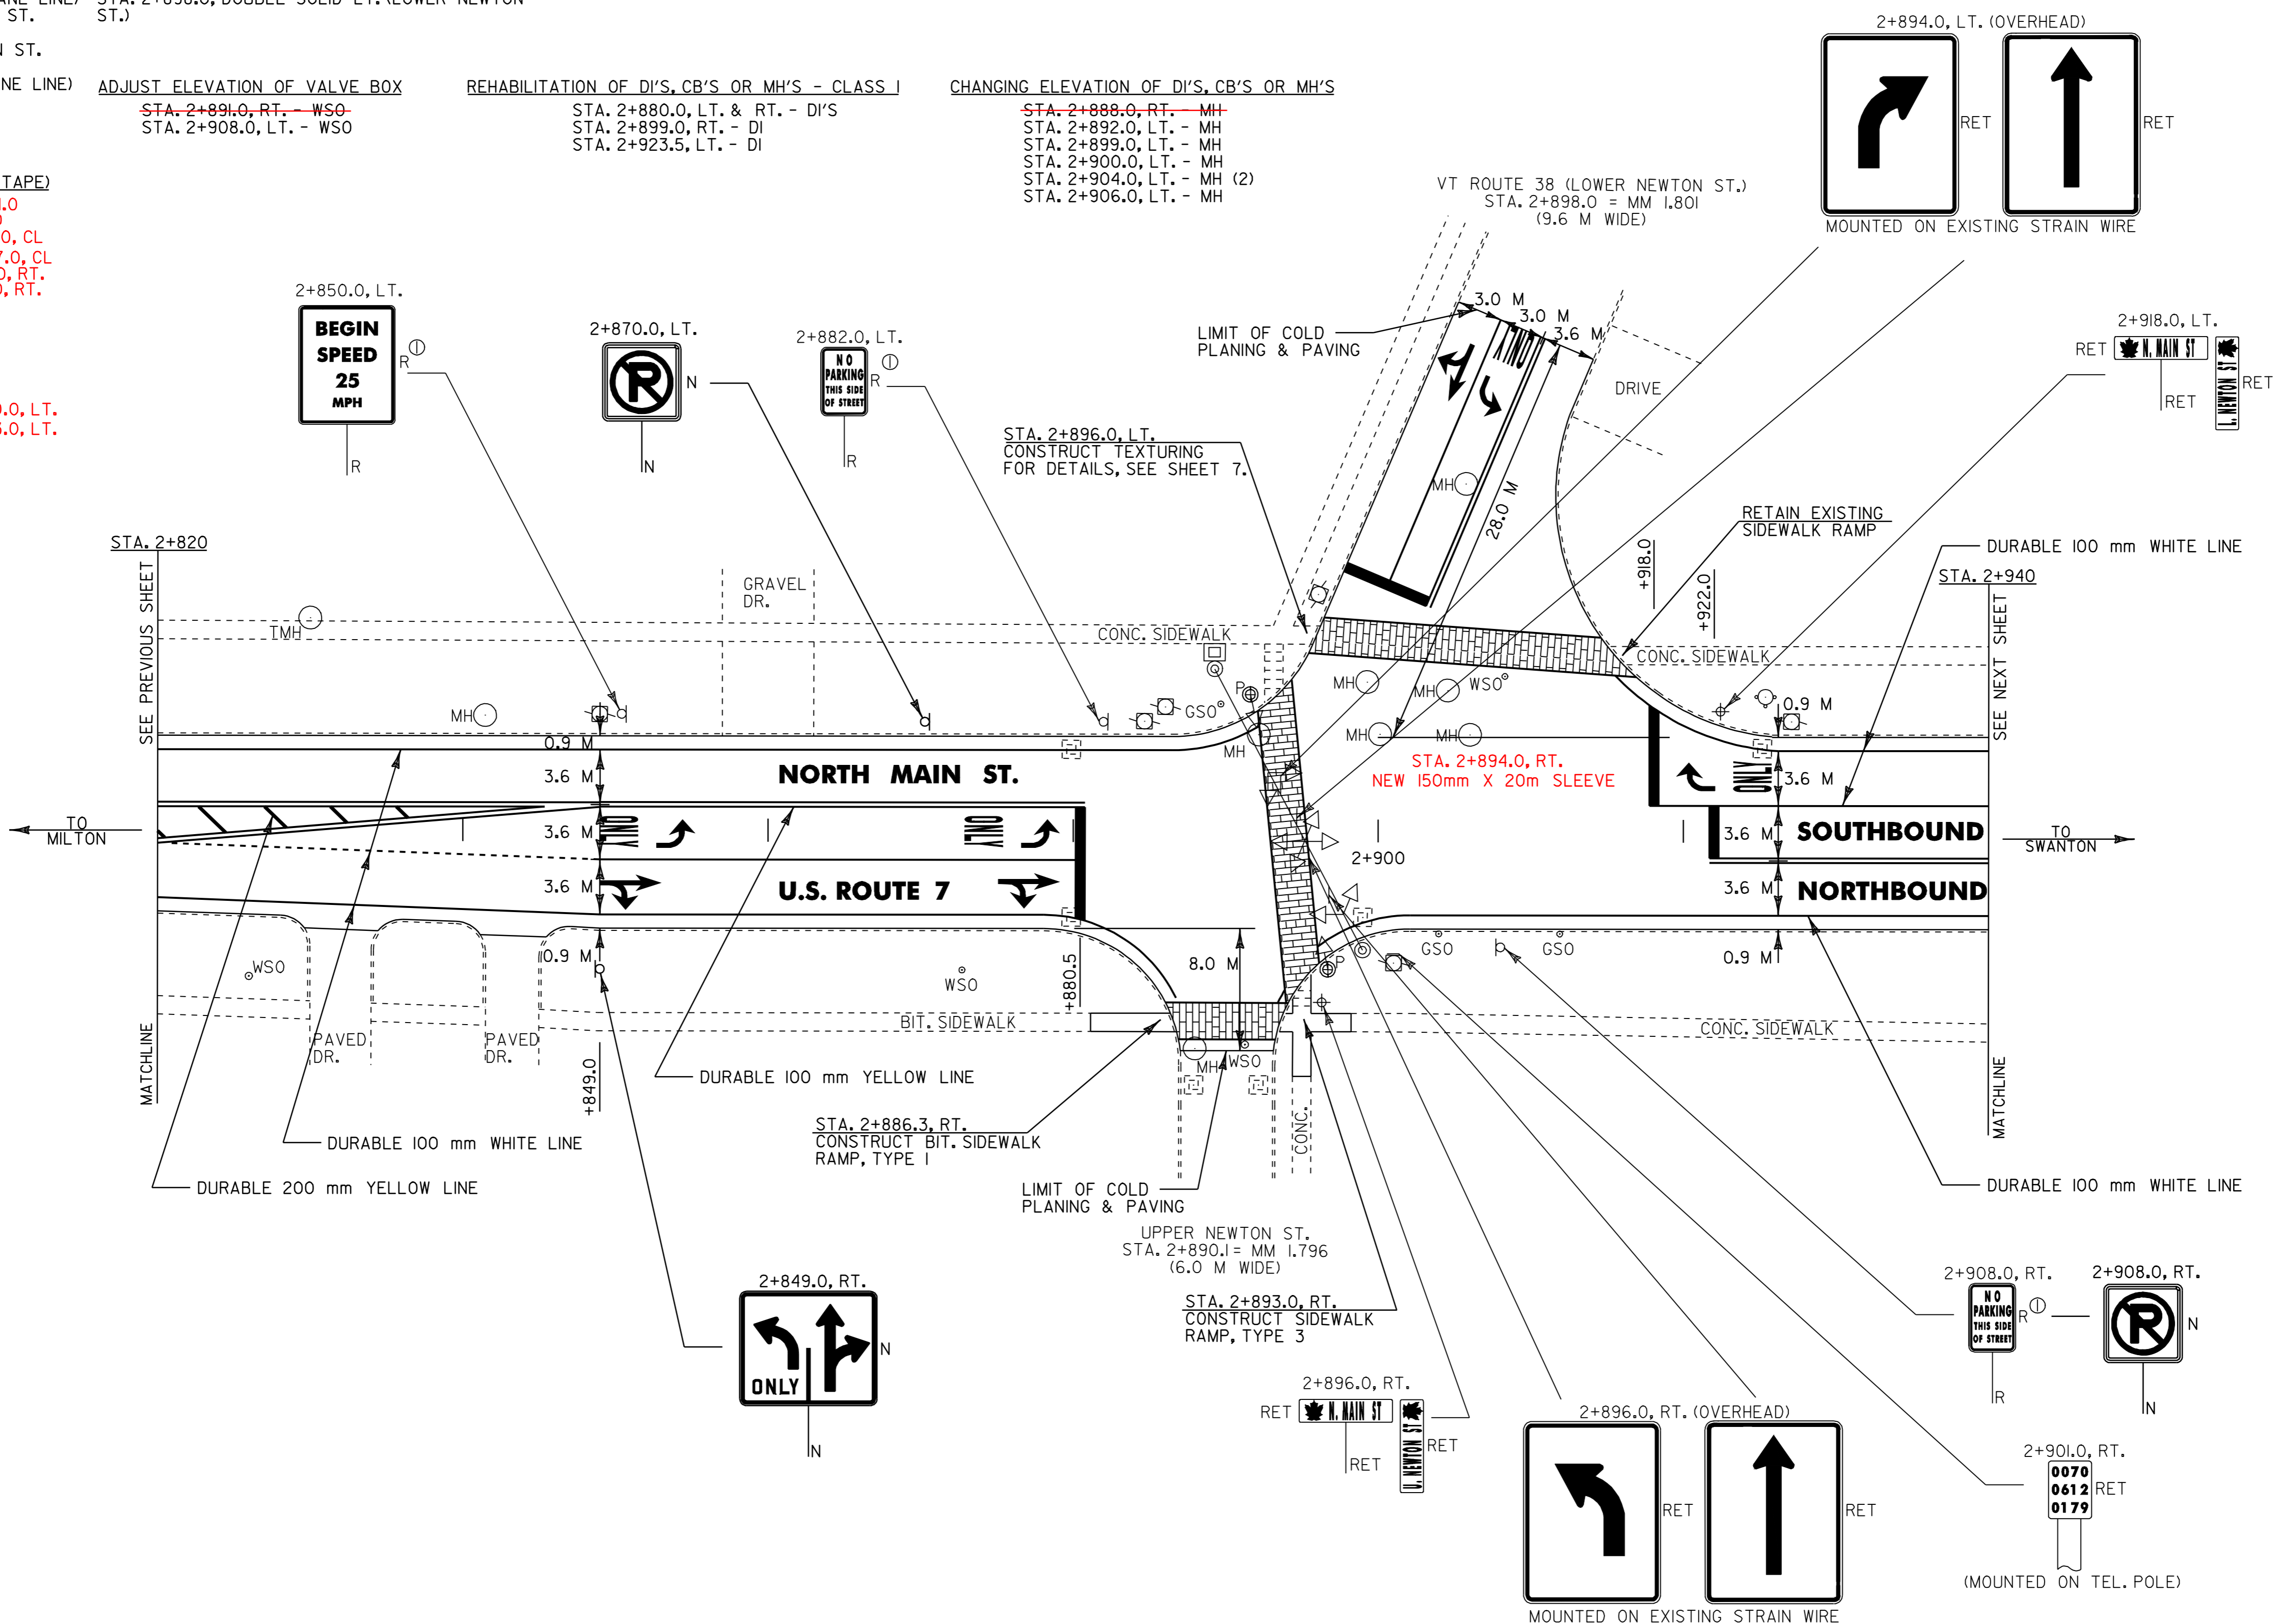

NOTES: 1) ALL DIMENSIONS IN MILLIMETERS EXCEPT WHERE OTHERWISE INDICATED.
 2) ALL EXISTING SIGNS NOT SHOWN SHALL BE RETAINED AS DIRECTED BY THE RESIDENT ENGINEER.
 3) FOR ANY TOWN HIGHWAY OR STREET DETAILS, SEE VTrans STANDARD E-193M.

LAYOUT SHEET #21

PROJECT NAME: ST. ALBANS CITY
 PROJECT NUMBER: STP_9804(I)S
 FILE NAME: Zpqve297d15QZpd15Q.dgn
 PROJECT LEADER: JLL
 DESIGNED BY: D-H
 IPARM FILE NAME: pd15Qp21.i
 PLOT DATE: 01-FEB-2006 07:4
 DRAWN BY: D-H
 CHECKED BY:
 SHEET 42 OF 105