

~~TEMPORARY & DURABLE 100 mm WHITE LINE~~
 STA. 2+940.0 TO 3+038.0, SOLID RT.
 (WITH EDGELINE BREAK FOR FARRAR ST.)
 STA. 2+940.0 TO 3+020.0, SOLID LT.
 STA. 2+940.0 TO 2+952.0, SOLID LT. (LANE LINE)
 STA. 2+952.0 TO 3+020.0, DOTTED LT.

TEMPORARY & DURABLE 100 mm YELLOW LINE
 STA. 2+940.0 TO 3+060.0, SOLID LT. & RT.
 (WITH CENTERLINE BREAK FOR FARRAR ST.)
 STA. 3+029.7, DOUBLE SOLID RT. (FARRAR ST.)

~~TEMPORARY & DURABLE CROSSWALK WITH DIAGONAL LINES (MOD.)~~
 STA. 3+029.7, RT. (FARRAR ST.)

~~TEMPORARY & DURABLE 600 mm STOP BAR (TYPE I) TAPE~~
 STA. 3+029.7, RT. (FARRAR ST.)

DURABLE LETTER OR SYMBOL (TYPE I) TAPE
 STA. 2+947.2, LT. - "P" *964.0
 STA. 2+950.5, LT. - "P" *967.0
 STA. 2+950.8, LT. - "ONLY" *967.0
 STA. 3+029.7, RT. - "STOP"

REMOVING SIGNS
 AS SHOWN - 8

REHABILITATION OF DI'S, CB'S OR MH'S - CLASS I
 STA. 2+944.0, RT. - DI
 STA. 2+972.5, RT. - DI
 STA. 2+992.0, LT. - DI
 STA. 3+020.0, RT. - DI
~~STA. 3+033.5, RT. - ROUND DI~~
 STA. 3+034.0, RT. - DI


~~TEMPORARY LETTER OR SYMBOL~~
 STA. 2+947.2, LT. - "P"
 STA. 2+950.5, LT. - "P"
 STA. 3+029.7, RT. - "STOP"

LETTER OR SYMBOL (MOD.)
 STA. 3+040.8, RT. - "P" *055.0
 STA. 3+044.4, RT. - "P" *059.0

TEMPORARY LETTER OR SYMBOL (MOD.)
 STA. 3+040.8, RT. - "P" *055.0
 STA. 3+044.4, RT. - "P" *059.0

~~TEMPORARY & DURABLE 150 mm WHITE LINE~~
 STA. 3+020.0 TO 3+060.0, SOLID LT.
 STA. 3+038.0 TO 3+060.0, SOLID RT.

ADJUST ELEVATION OF VALVE BOX
 STA. 3+040.0, C - VALVE (PAVED OVER)

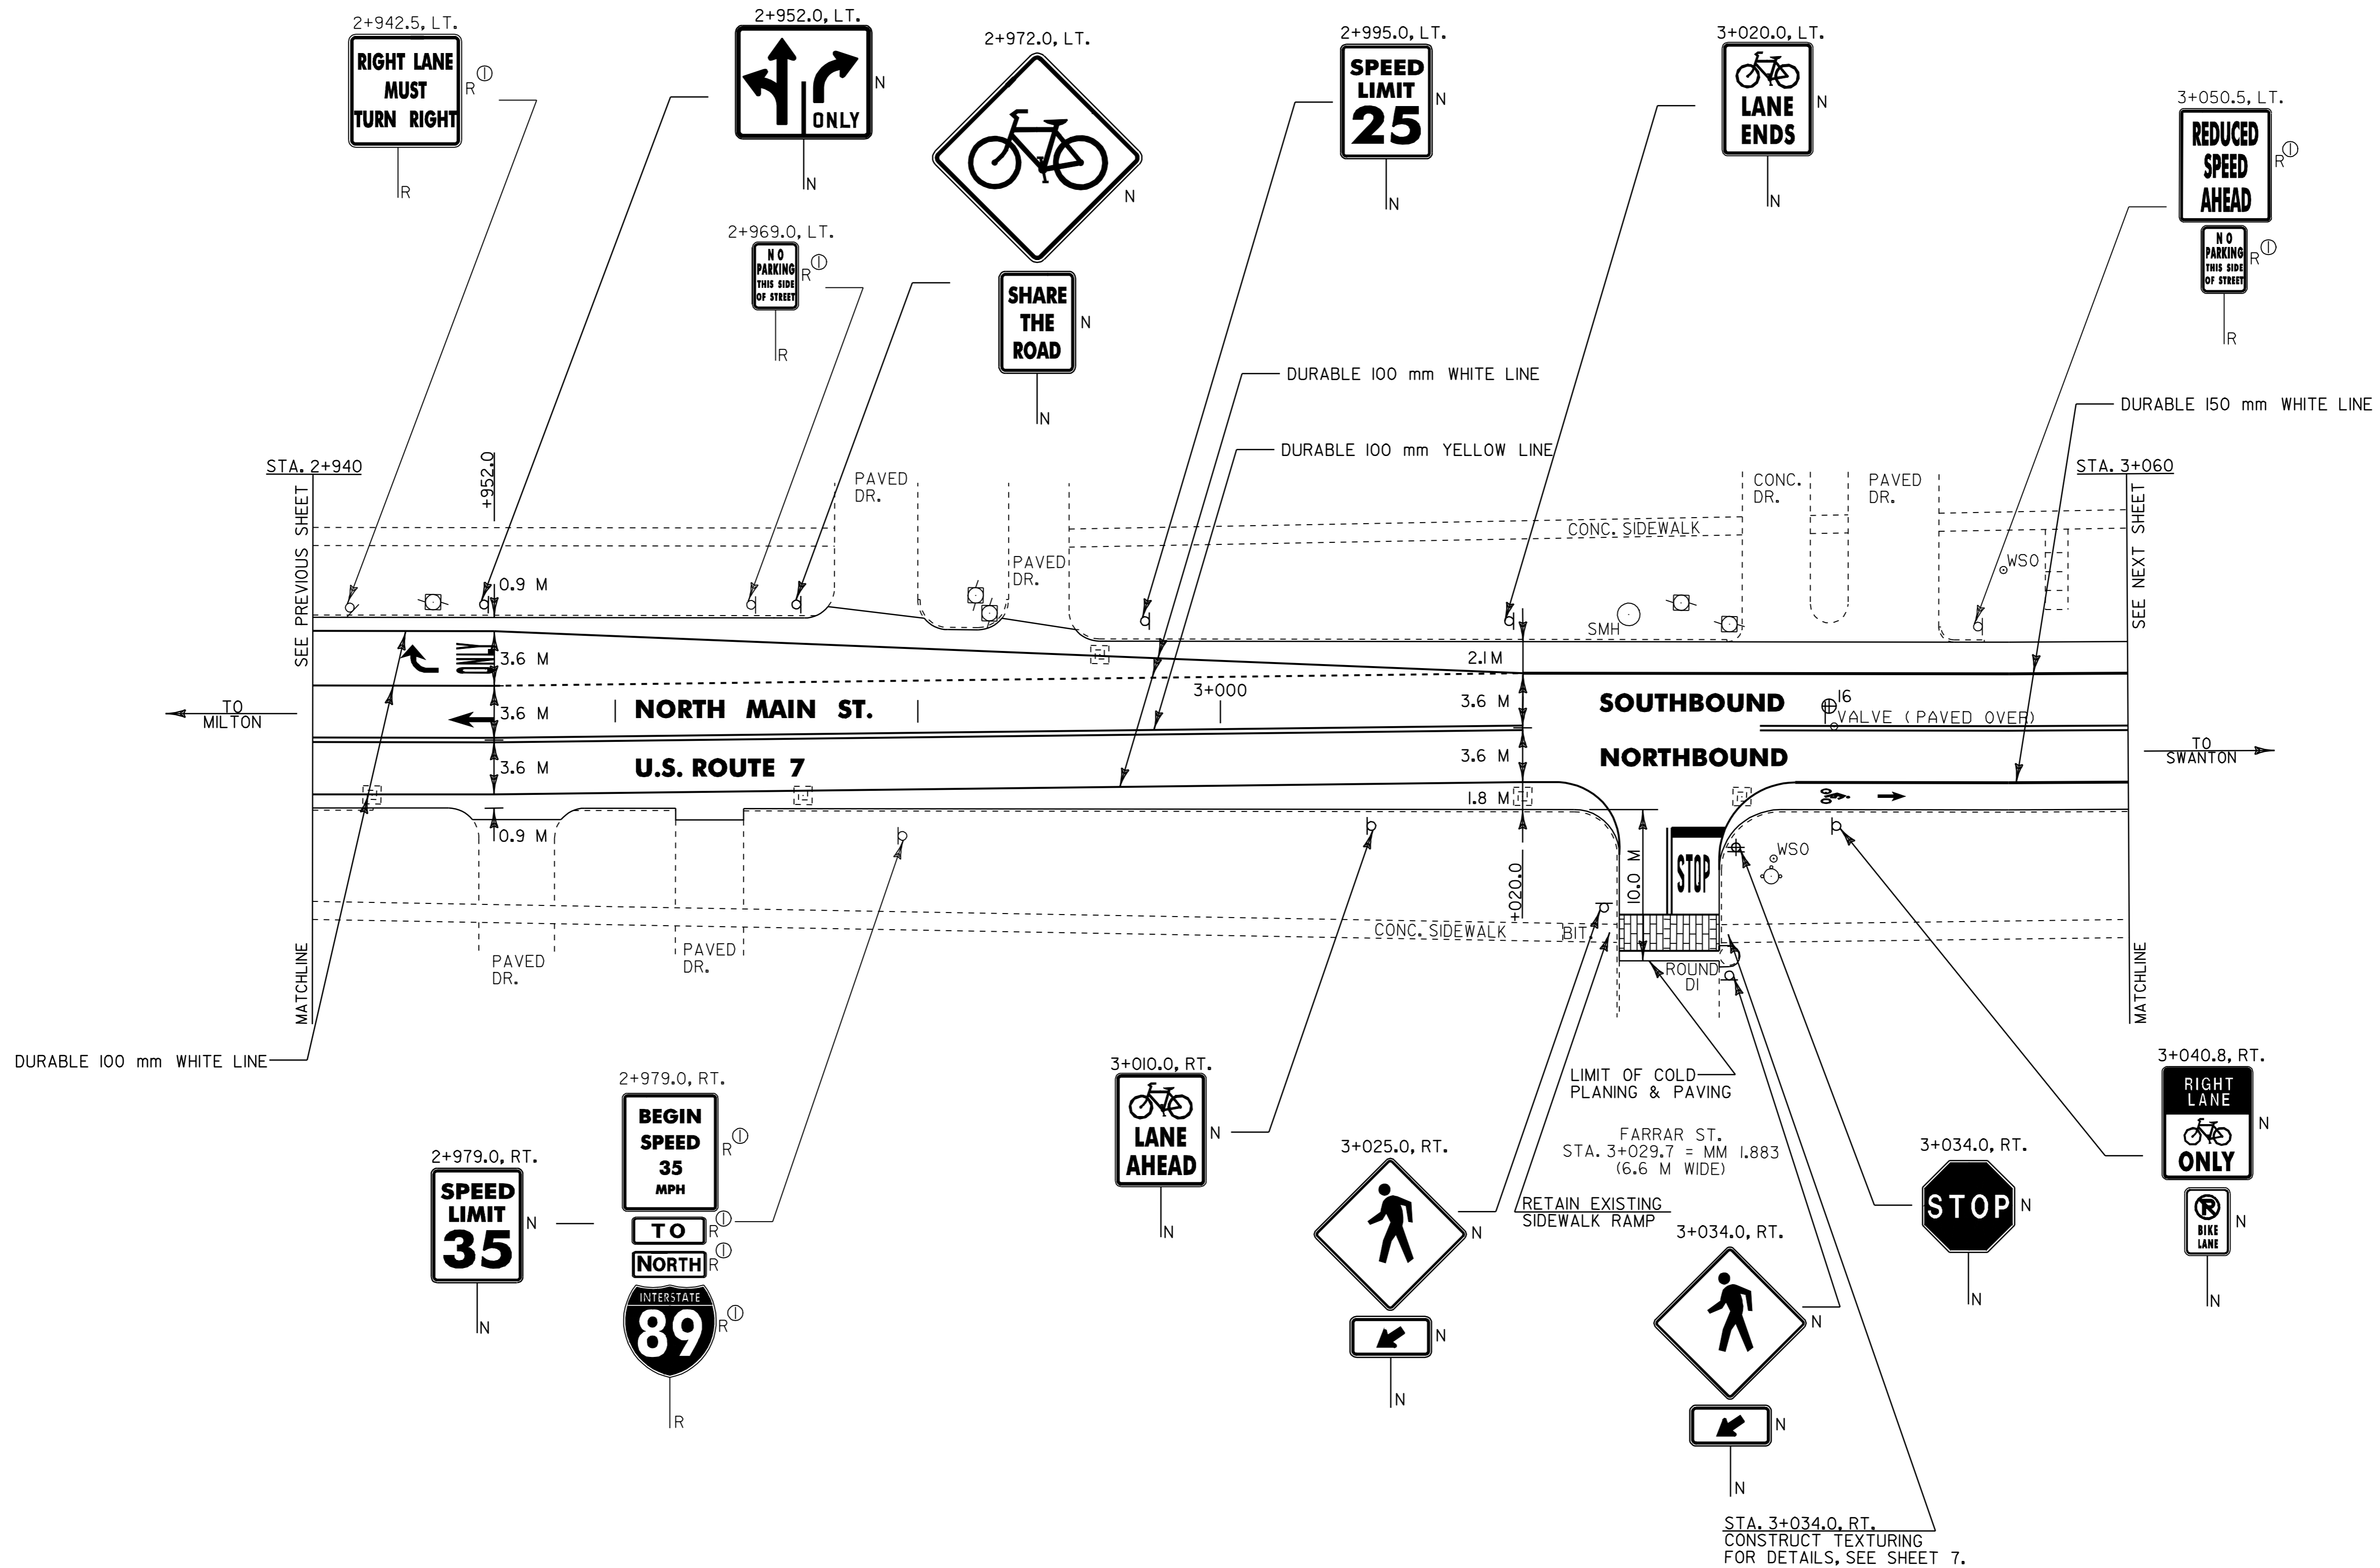

⊕ CORE LOCATION

PAVEMENT CORE DATA			
CORE #	LOCATION	DEPTH (mm)	PCC
16	3+040.1, LT.	152	YES

- NOTES:
- 1) ALL DIMENSIONS IN MILLIMETERS EXCEPT WHERE OTHERWISE INDICATED.
 - 2) ALL EXISTING SIGNS NOT SHOWN SHALL BE RETAINED AS DIRECTED BY THE RESIDENT ENGINEER.
 - 3) FOR ANY TOWN HIGHWAY OR STREET DETAILS, SEE VTrans STANDARD E-193M.

LAYOUT SHEET #22

PROJECT NAME: ST. ALBANS CITY
 PROJECT NUMBER: STP_9804(I)S
 FILE NAME: 2pave297d1502pd150.dgn PLOT DATE: 01-FEB-2006 07:5
 PROJECT LEADER: JLL DRAWN BY: D-H
 DESIGNED BY: D-H CHECKED BY:
 IPARM FILE NAME: pd150p22.i SHEET 43 OF 105