

TEMPORARY & DURABLE 150 mm WHITE LINE  
 STA. 3+060.0 TO 3+200.0, SOLID LT. & RT.


TEMPORARY & DURABLE 100 mm YELLOW LINE  
 STA. 3+060.0 TO 3+200.0, SOLID LT. & RT.

REMOVING SIGNS  
 AS SHOWN - 3

REHABILITATION OF DI'S, CB'S OR MH'S - CLASS I  
 STA. 3+082.0, RT. - DI  
 STA. 3+111.5, RT. - DI  
 STA. 3+115.0, LT. - DI  
 STA. 3+156.5, RT. - DI

LETTER OR SYMBOL (MOD.)  
 STA. 3+106.4, LT. - " 120.0  
 STA. 3+110.0, LT. - " 123.0  
 STA. 3+120.0, RT. - " 138.0  
 STA. 3+123.6, RT. - " 142.0

TEMPORARY LETTER OR SYMBOL (MOD.)  
 STA. 3+106.4, LT. - " 120.0  
 STA. 3+110.0, LT. - " 123.0  
 STA. 3+120.0, RT. - " 138.0  
 STA. 3+123.6, RT. - " 142.0

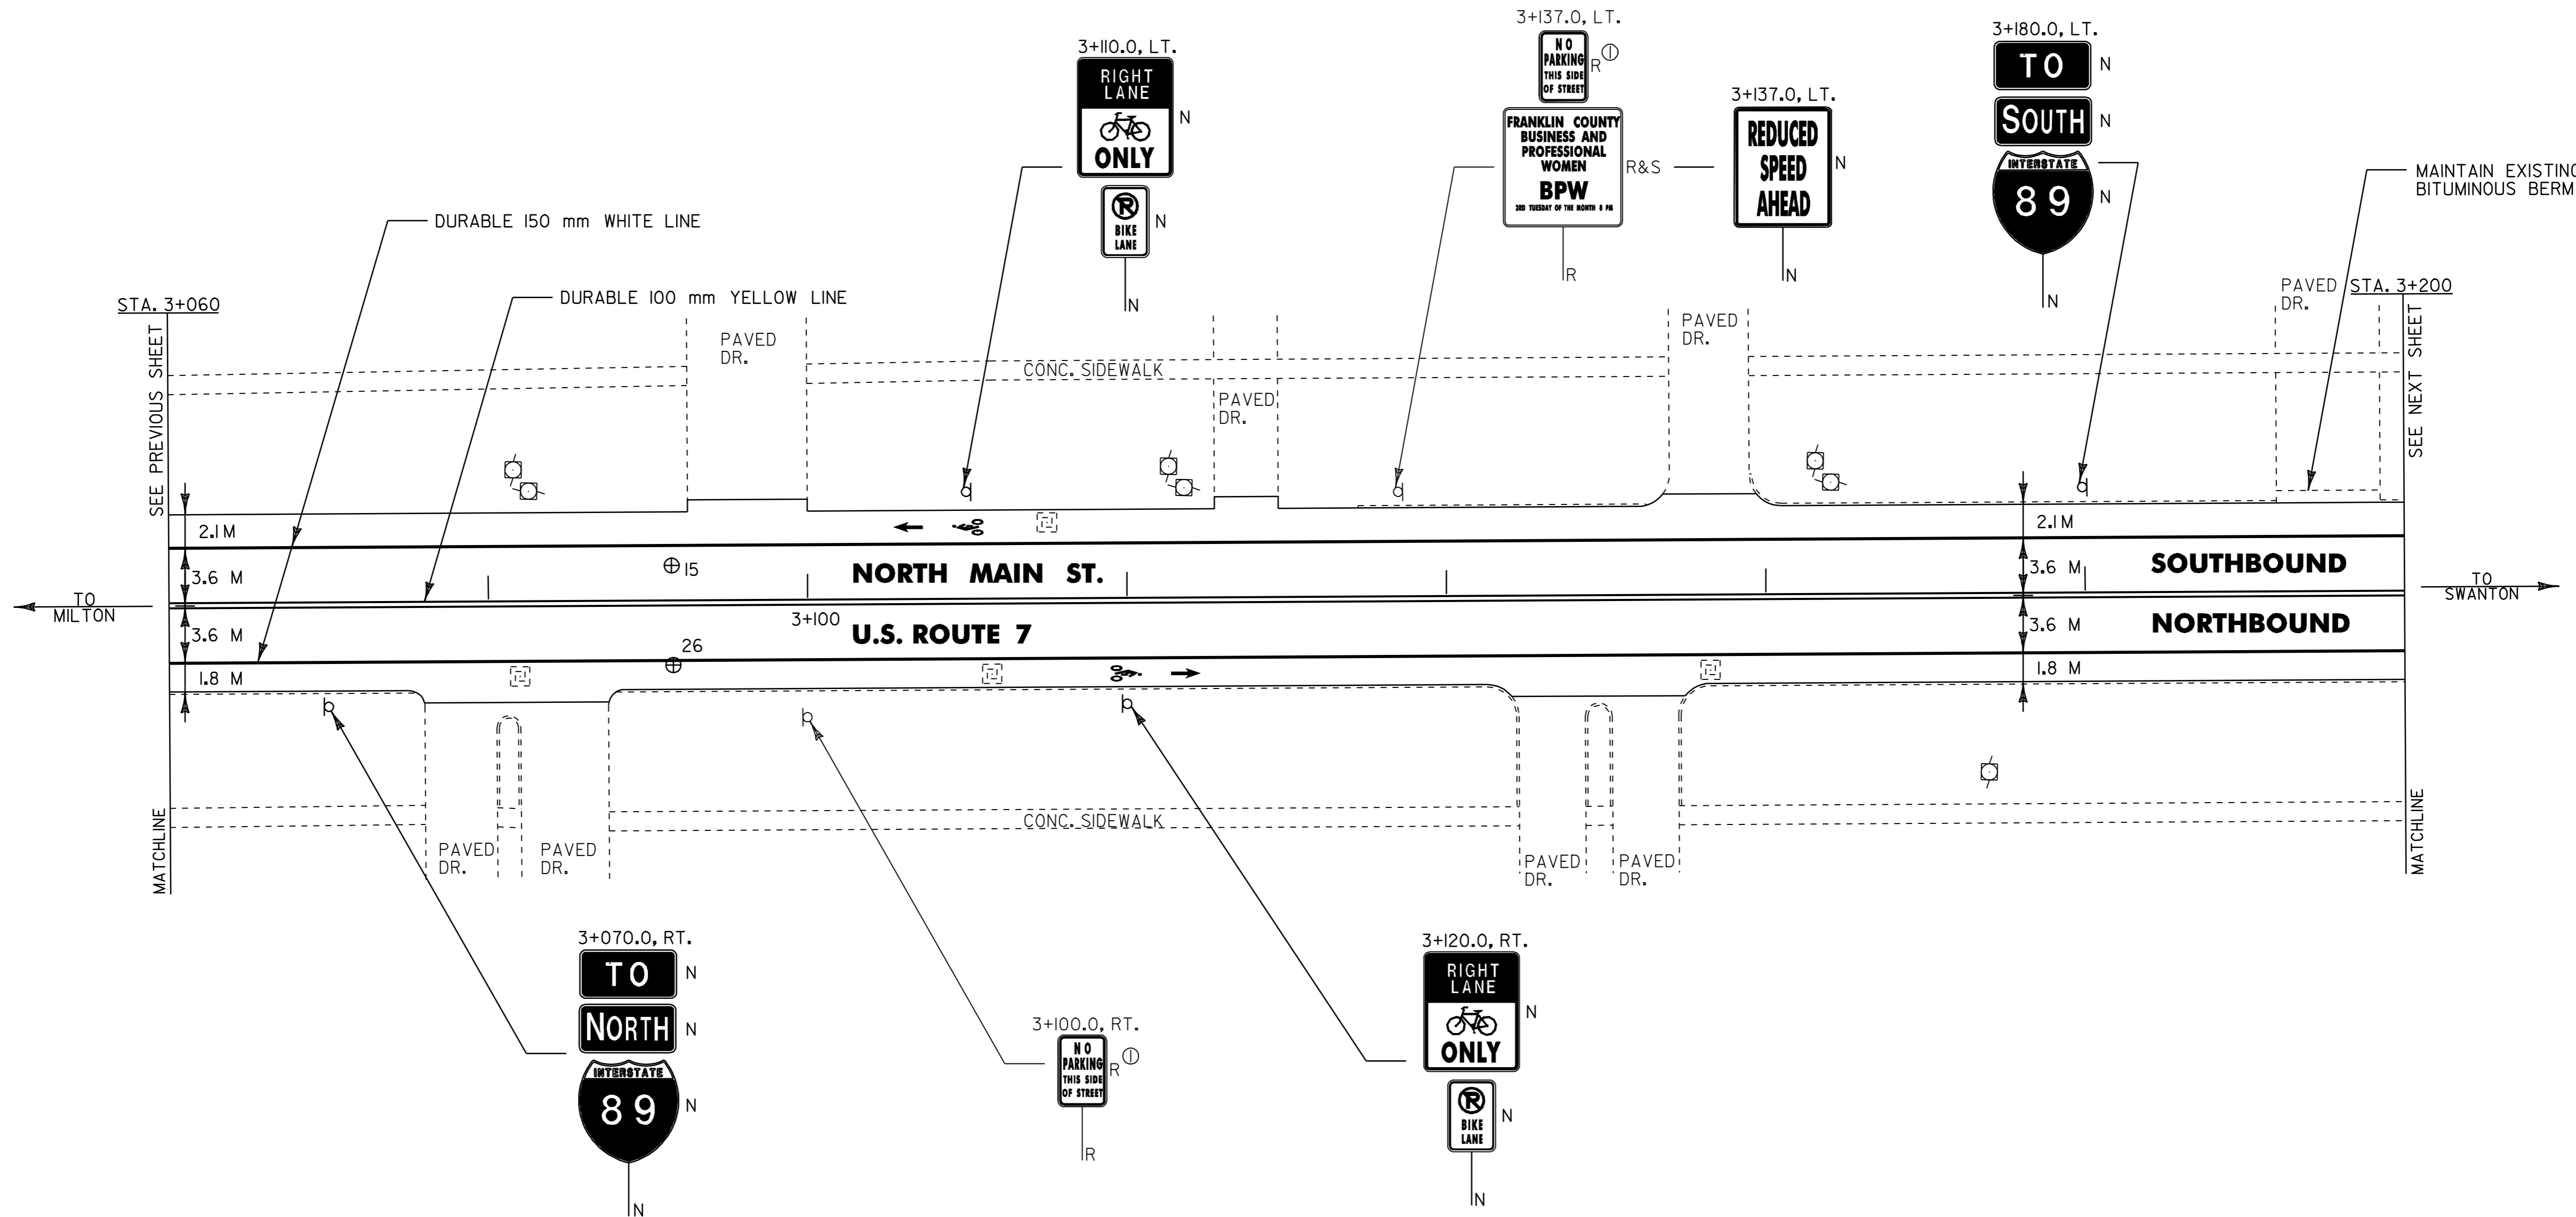

⊕ CORE LOCATION

PAVEMENT CORE DATA			
CORE #	LOCATION	DEPTH (mm)	PCC
15	3+091.5, LT.	178	NO
26	3+091.5, RT.	178	YES

- NOTES: 1) ALL DIMENSIONS IN MILLIMETERS EXCEPT WHERE OTHERWISE INDICATED.  
 2) ALL EXISTING SIGNS NOT SHOWN SHALL BE RETAINED AS DIRECTED BY THE RESIDENT ENGINEER.  
 3) FOR ANY TOWN HIGHWAY OR STREET DETAILS, SEE VTrans STANDARD E-193M.

LAYOUT SHEET #23

PROJECT NAME: ST. ALBANS CITY  
 PROJECT NUMBER: STP\_9804(I)S  
 FILE NAME: Zpqve297d150Zpd150.dgn  
 PROJECT LEADER: JLL  
 DESIGNED BY: D-H  
 IPARM FILE NAME: pd150p23.1  
 PLOT DATE: 01-FEB-2006 07:5  
 DRAWN BY: D-H  
 CHECKED BY:  
 SHEET 44 OF 105

