

TEMPORARY & DURABLE 150 mm WHITE LINE  
STA. 3+200.0 TO 3+360.0, SOLID LT. & RT.

TEMPORARY & DURABLE 100 mm YELLOW LINE  
STA. 3+200.0 TO 3+360.0, SOLID LT. & RT.

REMOVING SIGNS  
AS SHOWN - 10

ERECTING SALVAGED SIGNS  
AS SHOWN - 4


REHABILITATION OF DI'S, CB'S OR MH'S - CLASS I  
STA. 3+238.0, LT. - DI  
STA. 3+254.0, RT. - DI  
STA. 3+307.0, RT. - DI  
STA. 3+323.0, RT. - DI  
STA. 3+314.0, LT. - DI

ADJUST ELEVATION OF VALVE BOX  
STA. 3+303.0, RT. - WSO  
STA. 3+314.0, RT. - WSO  
STA. 3+354.5, RT. - WSO

CHANGING ELEVATION OF DI'S, CB'S OR MH'S  
~~STA. 3+314.0, LT. - MH~~  
STA. 3+317.5, RT. - MH (CONCRETE COLLAR)



LETTER OR SYMBOL (MOD.)	TEMPORARY LETTER OR SYMBOL (MOD.)
STA. 3+230.0, RT. -	STA. 3+230.0, RT. -
STA. 3+233.6, RT. -	STA. 3+233.6, RT. -
STA. 3+296.4, LT. -	STA. 3+296.4, LT. -
STA. 3+300.0, LT. -	STA. 3+300.0, LT. -

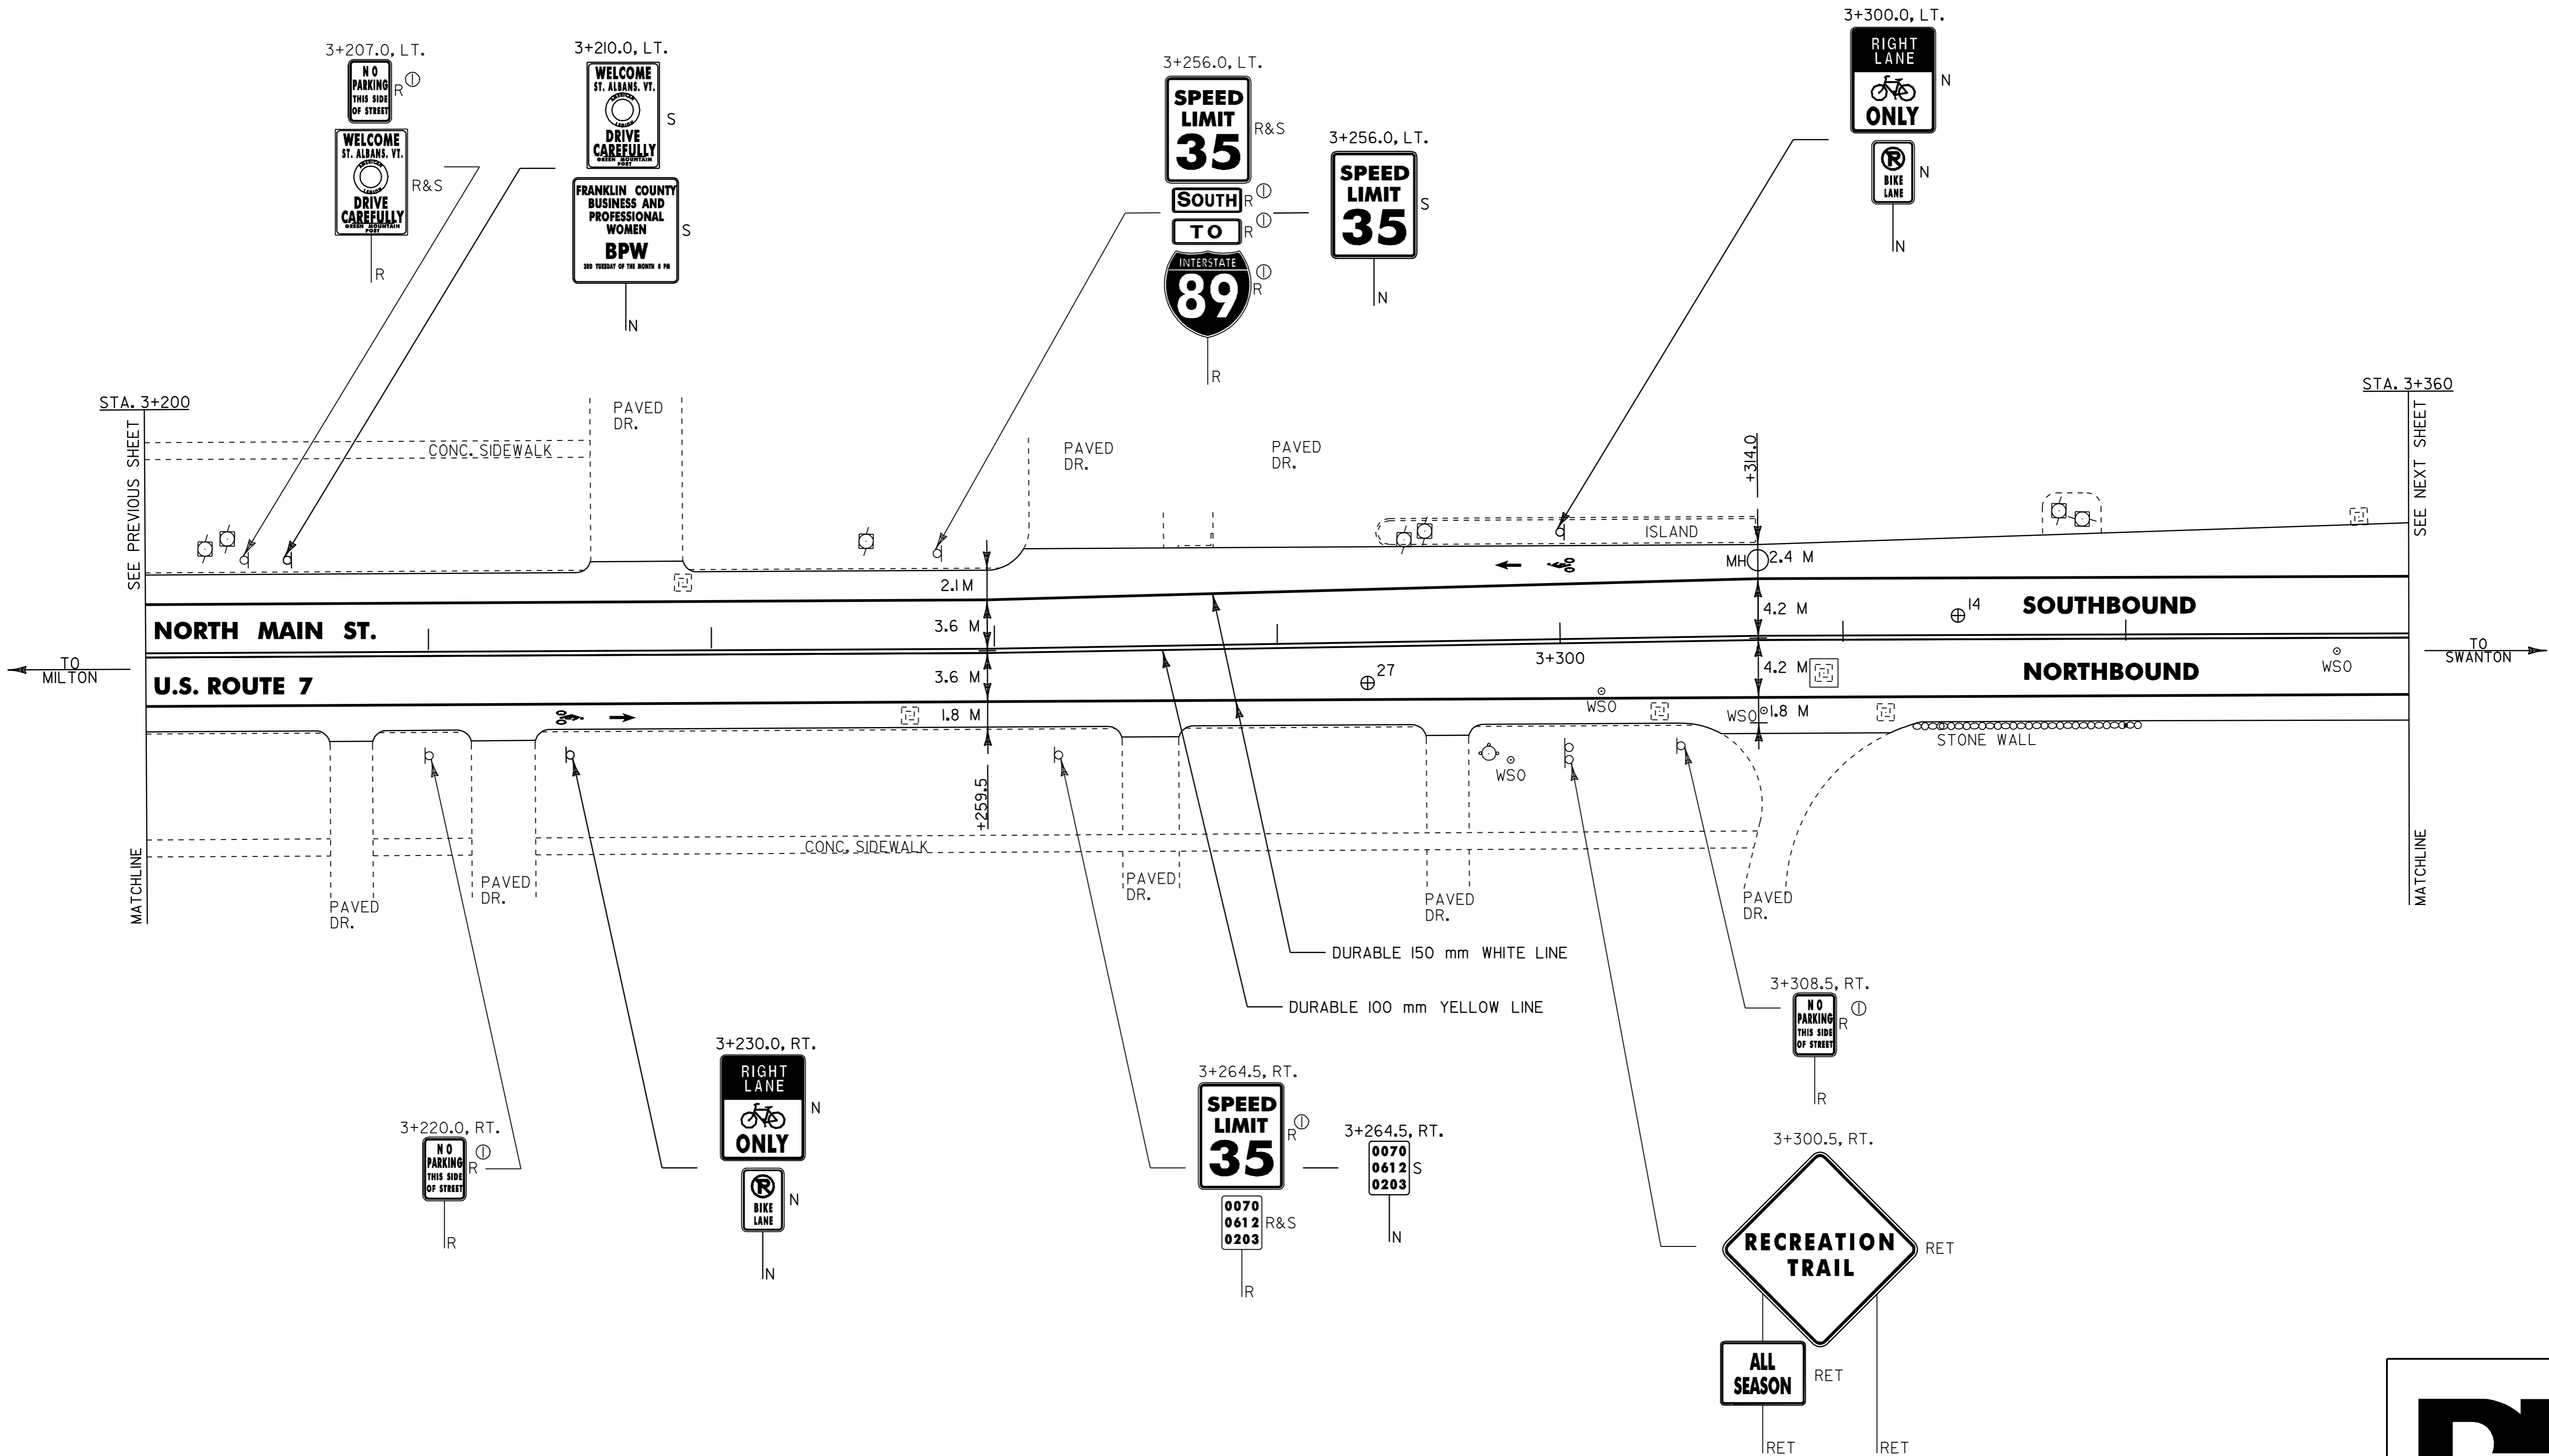

⊕ CORE LOCATION

PAVEMENT CORE DATA			
CORE #	LOCATION	DEPTH (mm)	PCC
14	3+328.1, LT.	152	YES
27	3+286.3, RT.	127	YES

- NOTES:
- 1) ALL DIMENSIONS IN MILLIMETERS EXCEPT WHERE OTHERWISE INDICATED.
  - 2) ALL EXISTING SIGNS NOT SHOWN SHALL BE RETAINED AS DIRECTED BY THE RESIDENT ENGINEER.
  - 3) FOR ANY TOWN HIGHWAY OR STREET DETAILS, SEE VTrans STANDARD E-193M.

<b>LAYOUT SHEET #24</b>	PROJECT NAME: ST. ALBANS CITY	FILE NAME: <u>2pave297d150pdl50.dgn</u>	PLOT DATE: 01-FEB-2006 07:5	
	PROJECT NUMBER: STP_9804(I)S	PROJECT LEADER: JLL	DRAWN BY: D-H	
	DESIGNED BY: D-H	CHECKED BY:	IPARM FILE NAME: <u>pdl50p241</u>	SHEET <u>45</u> OF 105

