

~~TEMPORARY & DURABLE 100 mm WHITE LINE~~
 STA. 3+447.0, RT. (LAKEVIEW TERR. EDGELINES)

TEMPORARY & DURABLE 100 mm YELLOW LINE
 STA. 3+360.0 TO 3+510.0, SOLID LT. & RT.
 (WITH CENTERLINE BREAK FOR LAKEVIEW TERR.)
 STA. 3+447.0, DOUBLE SOLID RT. (LAKEVIEW TERR.)

~~TEMPORARY & DURABLE 600 mm STOP BAR (TYPE ITAPE)~~
 STA. 3+447.0, RT. (LAKEVIEW TERR.)

~~TEMPORARY & DURABLE LETTER OR SYMBOL (TYPE ITAPE)~~
 STA. 3+447.0, RT. - 'STOP'

REMOVING SIGNS
 AS SHOWN - 4

ERECTING SALVAGED SIGNS
 AS SHOWN - 3



REHABILITATION OF DI'S, CB'S OR MH'S - CLASS I
 STA. 3+393.0, RT. - DI
 STA. 3+438.0, RT. - DI
 STA. 3+452.0, RT. - DI
 STA. 3+454.0, LT. - DI
 STA. 3+431.0, LT.


ADJUST ELEVATION OF VALVE BOX
 STA. 3+435.0, RT. - TEST CP
 STA. 3+440.0, RT. - TEST CP
 STA. 3+450.0, RT. - WSO
 STA. 3+453.0, RT.

CHANGING ELEVATION OF DI'S, CB'S OR MH'S
 STA. 3+431.0, LT. - MH
 STA. 3+443.0, RT. - MH
 STA. 3+446.0, RT. - DRAIN MH
 STA. 3+452.0, LT. - DRAIN MH

LETTER OR SYMBOL (MOD.)
 STA. 3+463.0, RT. - '475.0'
 STA. 3+466.6, RT. - '480.0'

TEMPORARY LETTER OR SYMBOL (MOD.)
 STA. 3+463.0, RT. - '475.0'
 STA. 3+466.6, RT. - '480.0'

~~TEMPORARY & DURABLE 150 mm WHITE LINE~~
 STA. 3+360.0 TO 3+510.0, SOLID LT. & RT.
 (WITH EDGELINE BREAK FOR LAKEVIEW TERR.)

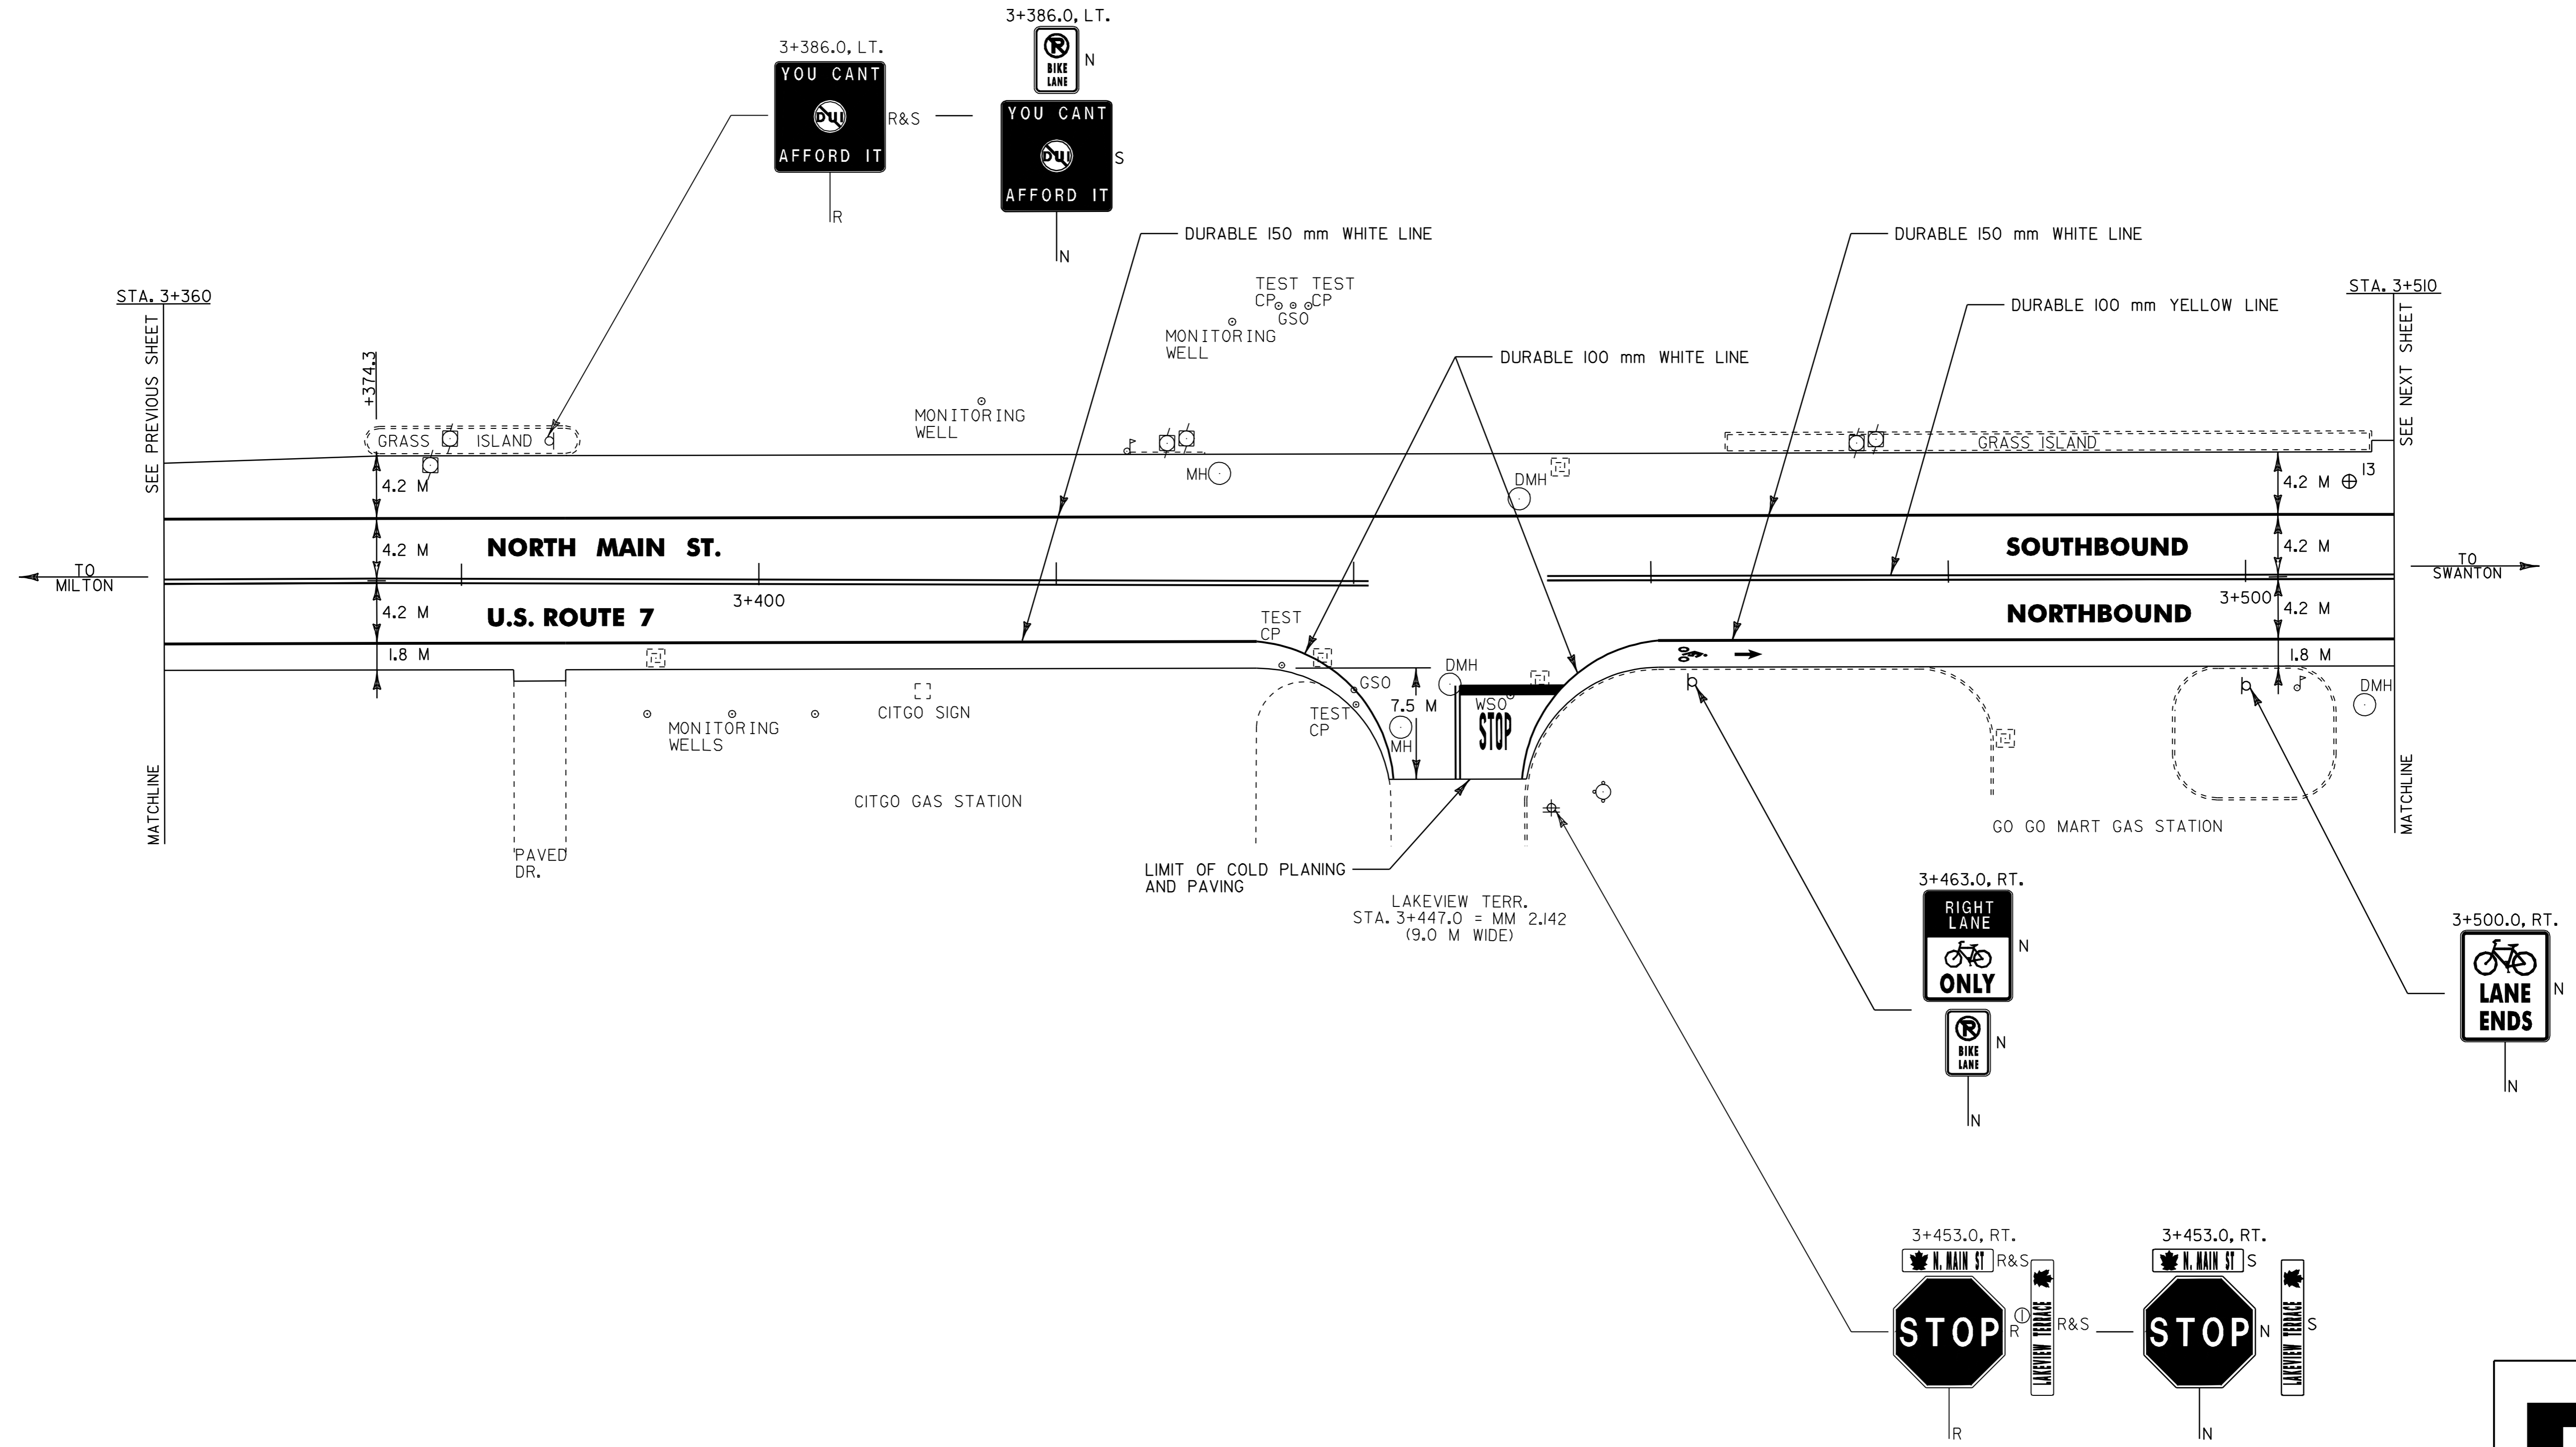

⊕ CORE LOCATION

PAVEMENT CORE DATA			
CORE #	LOCATION	DEPTH (mm)	PCC
13	3+506.8, LT.	127	NO

- NOTES:
- 1) ALL DIMENSIONS IN MILLIMETERS EXCEPT WHERE OTHERWISE INDICATED.
 - 2) ALL EXISTING SIGNS NOT SHOWN SHALL BE RETAINED AS DIRECTED BY THE RESIDENT ENGINEER.
 - 3) FOR ANY TOWN HIGHWAY OR STREET DETAILS, SEE VTrans STANDARD E-193M.

LAYOUT SHEET #25

PROJECT NAME: ST. ALBANS CITY
 PROJECT NUMBER: STP_9804(I)
 FILE NAME: Z:\pave\97\d150\pd150.dgn
 PROJECT LEADER: JLL
 DESIGNED BY: D-H
 IPARM FILE NAME: pd150p25.i
 PLOT DATE: 01-FEB-2006 07:5
 DRAWN BY: D-H
 CHECKED BY:
 SHEET 46 OF 105

