

~~TEMPORARY & DURABLE 100 mm WHITE LINE~~
 STA. 3+560.0 TO 3+640.40, SOLID RT.
 (WITH EDGELINE BREAK FOR VT ROUTE 105
 STA. 3+568.0, DOUBLE SOLID RT. (VT ROUTE
 105 EDGELINES)
 STA. 3+568.0 TO 3+640.40, SOLID LT.

~~TEMPORARY & DURABLE 100 mm YELLOW LINE~~
 STA. 3+510.0 TO 3+640.40, SOLID LT. & RT.
 (WITH CENTERLINE BREAK FOR VT ROUTE 105
 STA. 3+568.0, DOUBLE SOLID RT. (VT ROUTE
 105 CENTERLINE)

~~TEMPORARY & DURABLE 600 mm STOP BAR (TYPE ITAPE)~~
 STA. 3+568.0, RT. (VT ROUTE 105)

~~TEMPORARY & DURABLE LETTER OR SYMBOL (TYPE ITAPE)~~
 STA. 3+568.0, RT. - "STOP"

~~REHABILITATION OF D'S, CB'S OR MH'S - CLASS I~~
 STA. 3+585.0, RT. - DI




BITUMINOUS CONCRETE GUTTER
 STA. 3+566.0, LT.
~~STA. 3+568.0 TO 3+608.0, RT.~~
 (FOR DETAILS SEE SHEET 13)

ADJUST ELEVATION OF VALVE BOX
 STA. 3+563.0, RT. - WSO

REMOVING SIGNS AS SHOWN - 3
 LETTER OR SYMBOL (MOD.)
 STA. 3+536.4, LT. - 548.0
 STA. 3+540.0, LT. - 552.0
 STA. 3+536.4, RT. - 552.0
 STA. 3+540.0, RT. - 555.0
 TEMPORARY LETTER OR SYMBOL (MOD.)
 STA. 3+536.4, LT. - 548.0
 STA. 3+540.0, LT. - 552.0
 STA. 3+536.4, RT. - 552.0
 STA. 3+540.0, RT. - 555.0

~~TEMPORARY & DURABLE 150 mm WHITE LINE~~
 STA. 3+510.0 TO 3+557.6, SOLID RT.
 STA. 3+510.0 TO 3+568.0, SOLID LT.

~~CHANGING ELEVATION OF D'S, CB'S OR MH'S~~
~~STA. 3+512.0, RT. - DRAIN MH~~

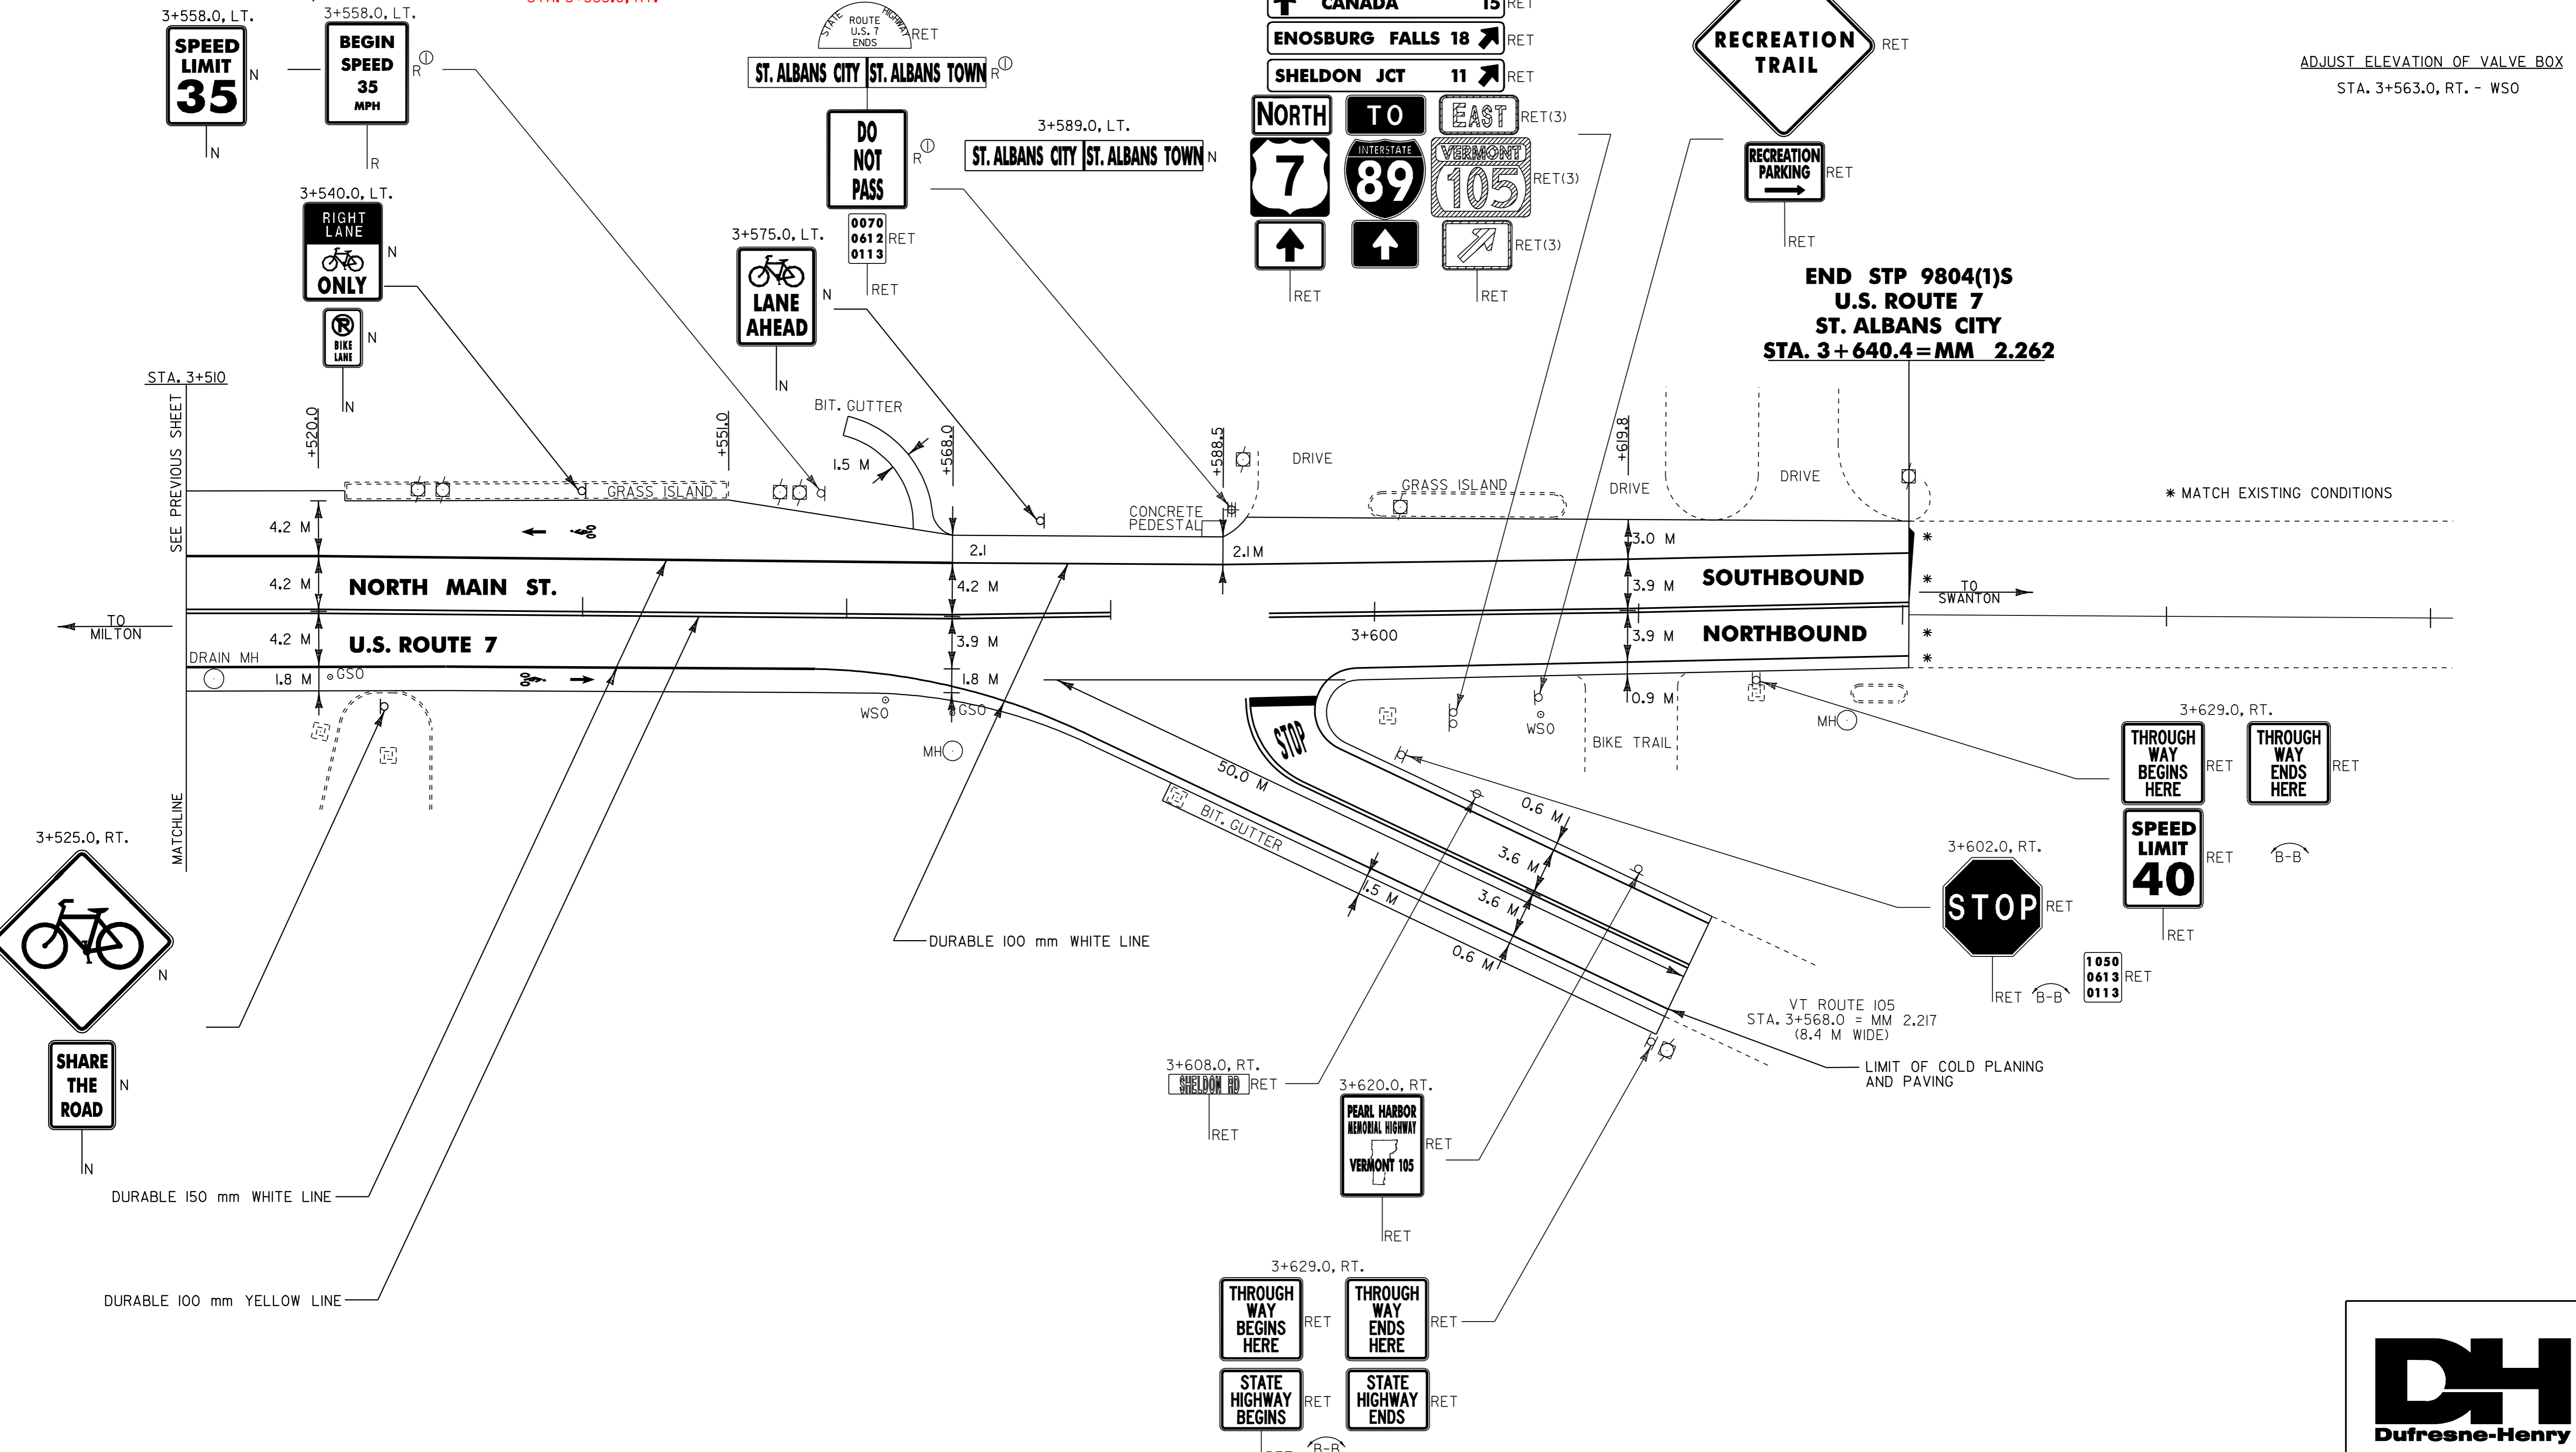

THROUGH WAY BEGINS HERE
 THROUGH WAY ENDS HERE
 STATE HIGHWAY BEGINS
 STATE HIGHWAY ENDS

NOTES: 1) ALL DIMENSIONS IN MILLIMETERS EXCEPT WHERE OTHERWISE INDICATED.
 2) ALL EXISTING SIGNS NOT SHOWN SHALL BE RETAINED AS DIRECTED BY THE RESIDENT ENGINEER.
 3) FOR ANY TOWN HIGHWAY OR STREET DETAILS, SEE VTrans STANDARD E-193M.

LAYOUT SHEET #26

PROJECT NAME: ST. ALBANS CITY
 PROJECT NUMBER: STP_9804(1)S
 FILE NAME: Z:\pave\297\d150\d150.dgn
 PROJECT LEADER: JLL
 DESIGNED BY: D-H
 IPARM FILE NAME: pd150p26.i
 PLOT DATE: 01-FEB-2006 07:5
 DRAWN BY: D-H
 CHECKED BY:
 SHEET 47 OF 105

