

~~TEMPORARY AND DURABLE 100 mm WHITE LINE~~
 STA. I+620.0 TO I+651.4, SOLID LT. & RT.
 (PARKING SPACES & DIAGONALS)
 STA. I+665.0 TO I+760.0, SOLID LT. & RT.

TEMPORARY AND DURABLE 100 mm YELLOW LINE
 STA. I+620.0 TO I+760.0, SOLID LT. & RT.
 (WITH CENTERLINE BREAK FOR LINCOLN AVE.)
 STA. I+657.9, RT. DOUBLE SOLID (LINCOLN AVE.)

~~TEMPORARY AND DURABLE CROSSWALK MARKING W/DIAGONAL LINES (MOD.)~~
 STA. I+657.9, LT.
 STA. I+657.9, RT.
 STA. I+663.5

TEMPORARY AND DURABLE LETTER OR SYMBOL (TYPE I TAPE)
~~STA. I+630.0, LT.~~
 STA. I+657.9, RT. - *STOP*

CHANGING ELEVATION OF SMH'S
~~STA. I+657.9, C~~

TEMPORARY AND DURABLE 600 mm STOP BAR (TYPE I TAPE)
~~STA. I+657.9, RT. (LINCOLN AVE.)~~

CHANGING ELEVATION OF DI'S, CB'S OR MH'S
~~STA. I+649.0, LT. - DI~~
 STA. I+657.0, RT. - MH
 STA. I+662.5, LT. - MH RT.
 STA. I+664.3, LT. - DI
 STA. I+667.2, RT. - DI

REMOVING SIGNS
 AS SHOWN - I3

ADJUST ELEVATION OF VALVE BOX
 STA. I+661.5, RT. - (4) WSO


ERECTING SALVAGED SIGNS
 AS SHOWN - I

PAINTED CURB
 IN NO PARKING AREAS AS
 DIRECTED BY RESIDENT ENGINEER

CONCRETE SIDEWALK
 STA. I+651, RT.
 STA. I+655, RT.
 STA. I+666, RT.

REMOVAL OF EXISTING CURB
 STA. I+651.8, LT.
 STA. I+655, RT.
 STA. I+666, RT.

CAST IN PLACE CONCRETE CURB
 STA. I+651, RT.
 STA. I+655, RT.
 STA. I+666, RT.

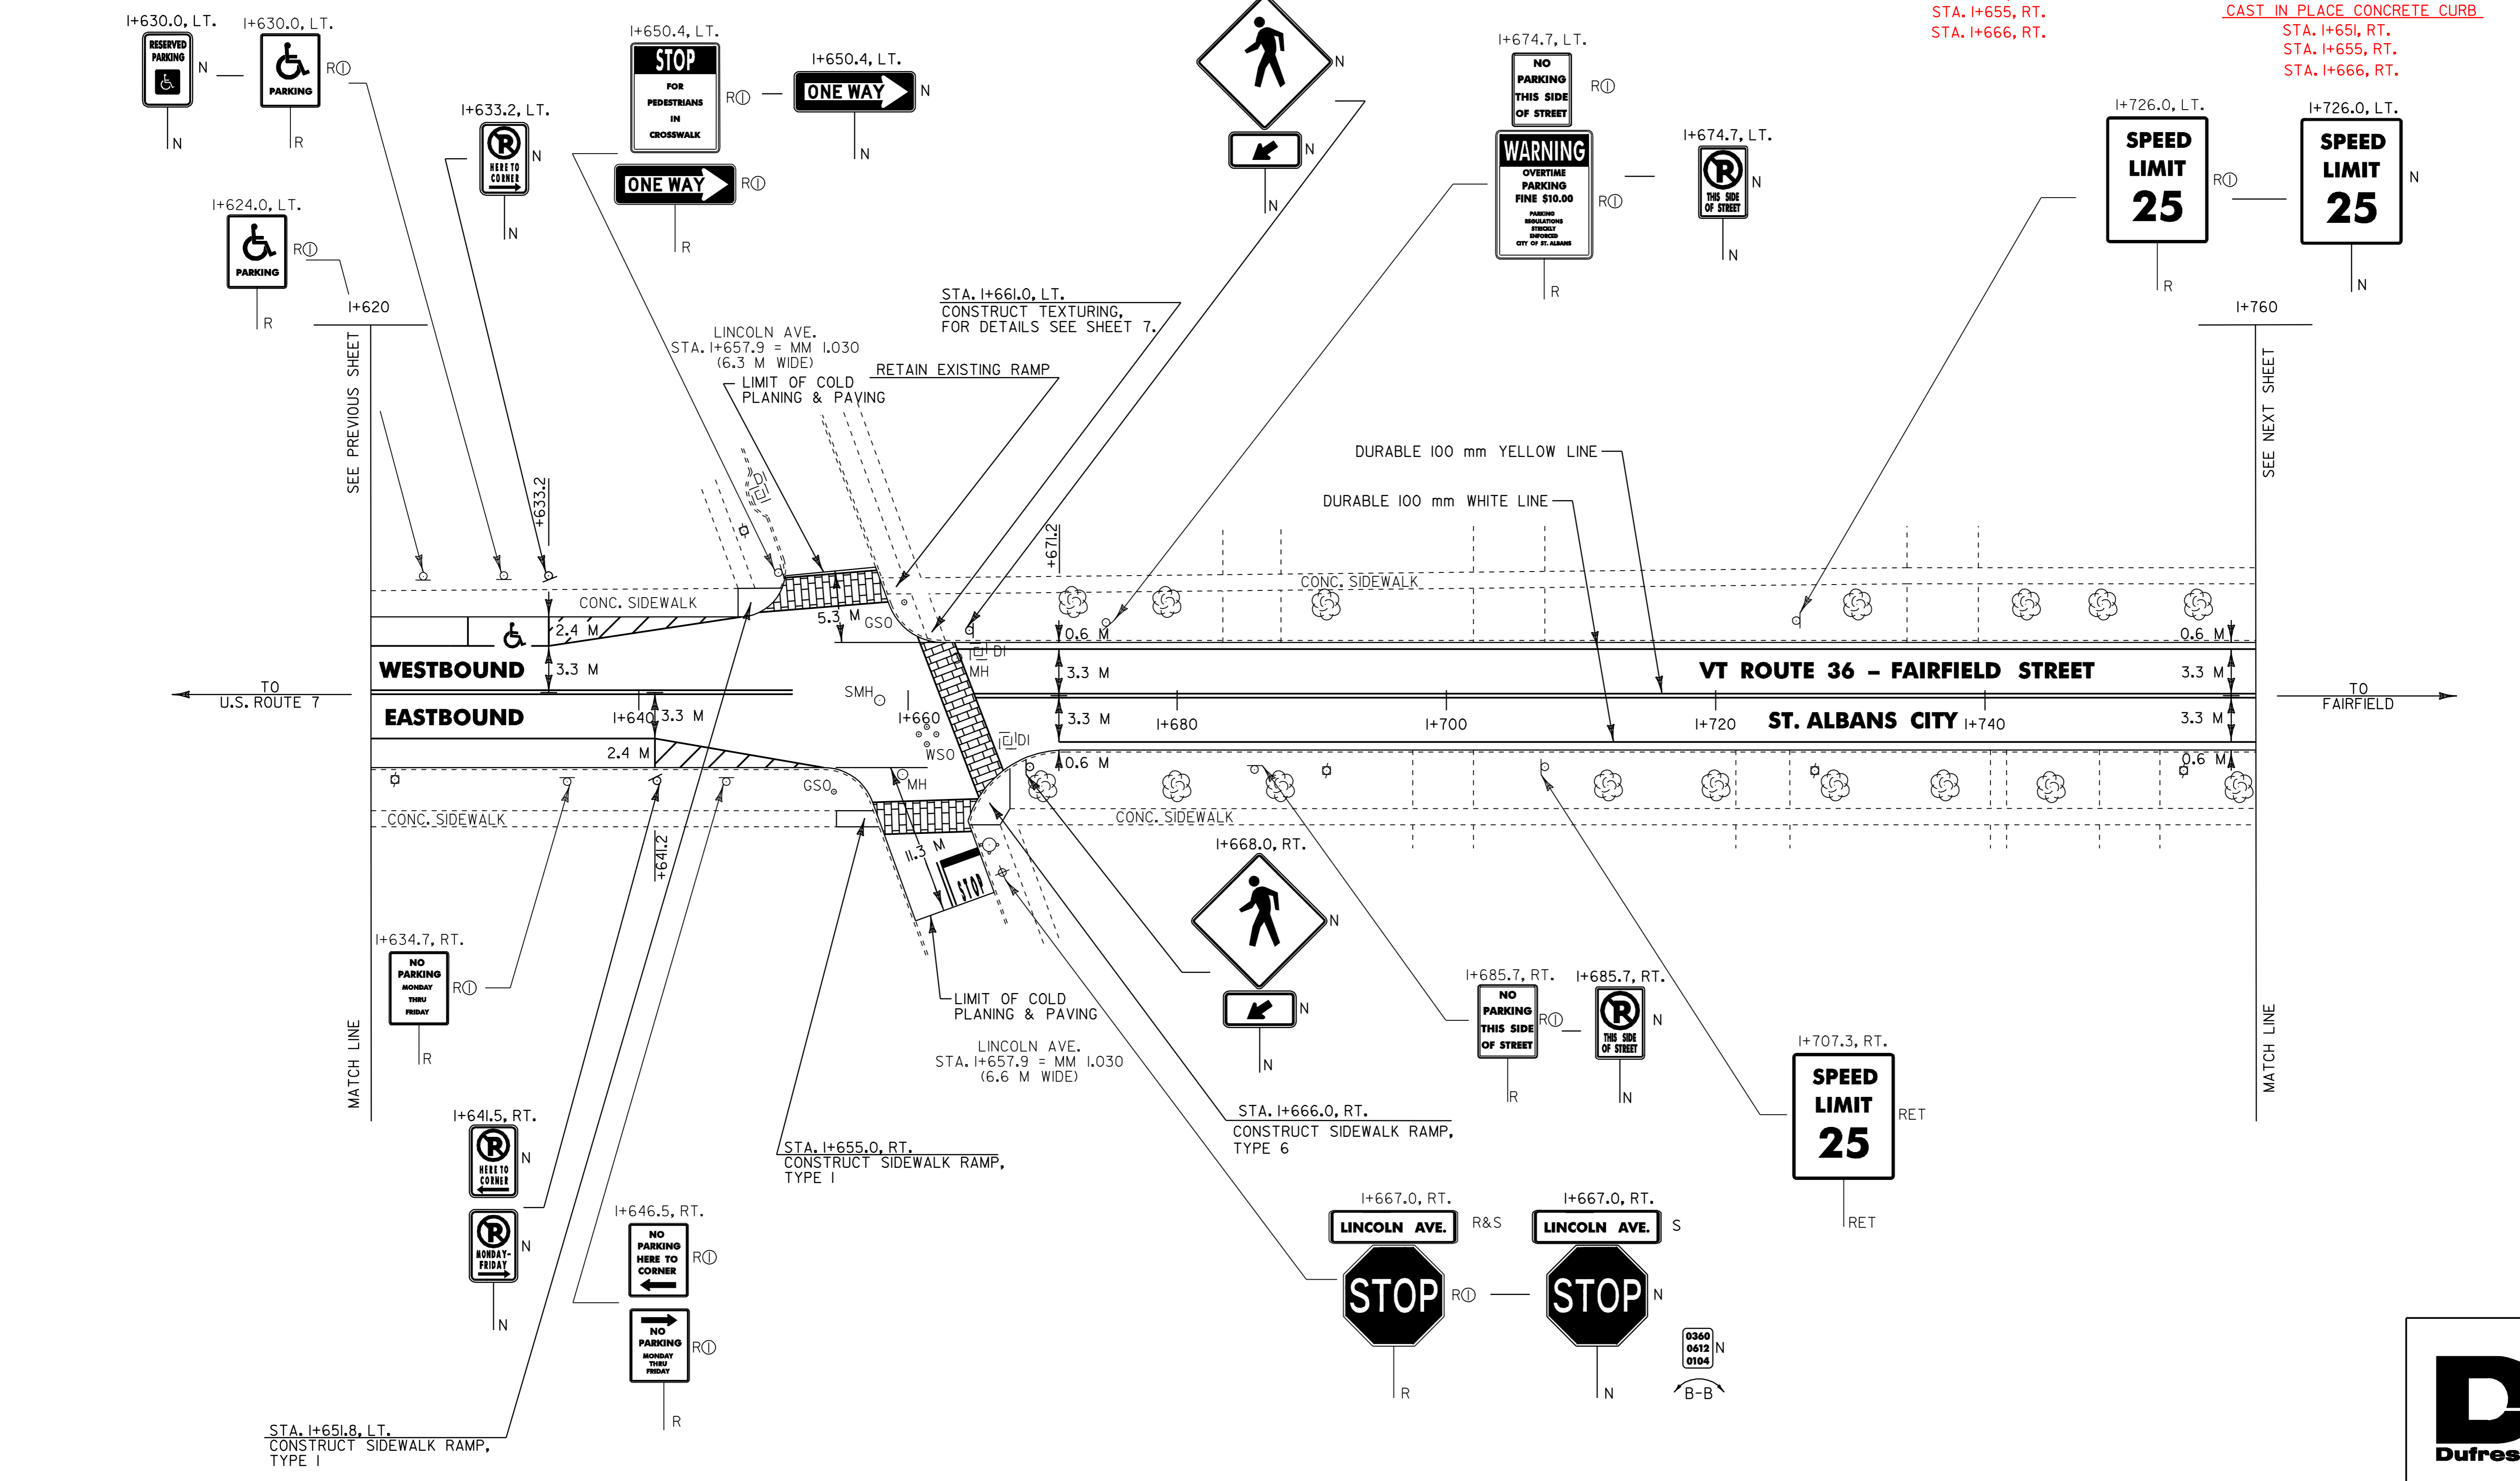

- NOTES:
- 1) ALL DIMENSIONS IN MILLIMETERS EXCEPT WHERE OTHERWISE INDICATED.
 - 2) ALL EXISTING SIGNS NOT SHOWN SHALL BE RETAINED AS DIRECTED BY THE RESIDENT ENGINEER.
 - 3) FOR ANY TOWN HIGHWAY OR STREET DETAILS, SEE VTrans STANDARD E-193M.

PROJECT LAYOUT #3	PROJECT NAME: ST. ALBANS CITY
	PROJECT NUMBER: STP 2129(1)S
	FILE NAME: /pave/99d070/pd070.dgn
	PROJECT LEADER: JLL
DESIGNED BY: D-H	PLOT DATE: 01-FEB-2006 07:5
IPARM FILE NAME: pd070p03.i	DRAWN BY: D-H
	CHECKED BY:
	SHEET 77 OF 105

