

~~TEMPORARY AND DURABLE~~ 100 mm WHITE LINE
 STA. I+760.0 TO I+920.0, SOLID LT. & RT.
 (WITH EDGELINE BREAK FOR HIGH ST.)

TEMPORARY AND DURABLE 100 mm YELLOW LINE
 STA. I+760.0 TO I+920.0, SOLID LT. & RT.
 (WITH CENTERLINE BREAK FOR HIGH ST.)
 STA. I+786.3, LT. DOUBLE SOLID (HIGH ST.)

~~TEMPORARY AND DURABLE~~ CROSSWALK MARKING W/DIAGONAL LINES (MOD.)
 STA. I+786.3, LT.

TEMPORARY AND DURABLE LETTER OR SYMBOL (TYPE ITAPE)
 STA. I+786.3, LT. - 'STOP'

REMOVING SIGNS
 AS SHOWN - 6




~~TEMPORARY AND DURABLE~~ 600 mm STOP BAR (TYPE ITAPE)
 STA. I+786.3, LT. (HIGH ST.)

CHANGING ELEVATION OF DI'S, CB'S OR MH'S
 STA. I+778.7, LT. - DI
 STA. I+778.7, RT. - DI
 STA. I+788.0, LT. - MH
 STA. I+788, LT. - DI

ADJUST ELEVATION OF VALVE BOX
 STA. I+785.8, RT. - (3) WSO
 2
CAST IN PLACE CONCRETE CURB
 STA. I+788, LT.

ERECTING SALVAGED SIGNS
 AS SHOWN - 1
CONCRETE SIDEWALK
 STA. I+788, LT.

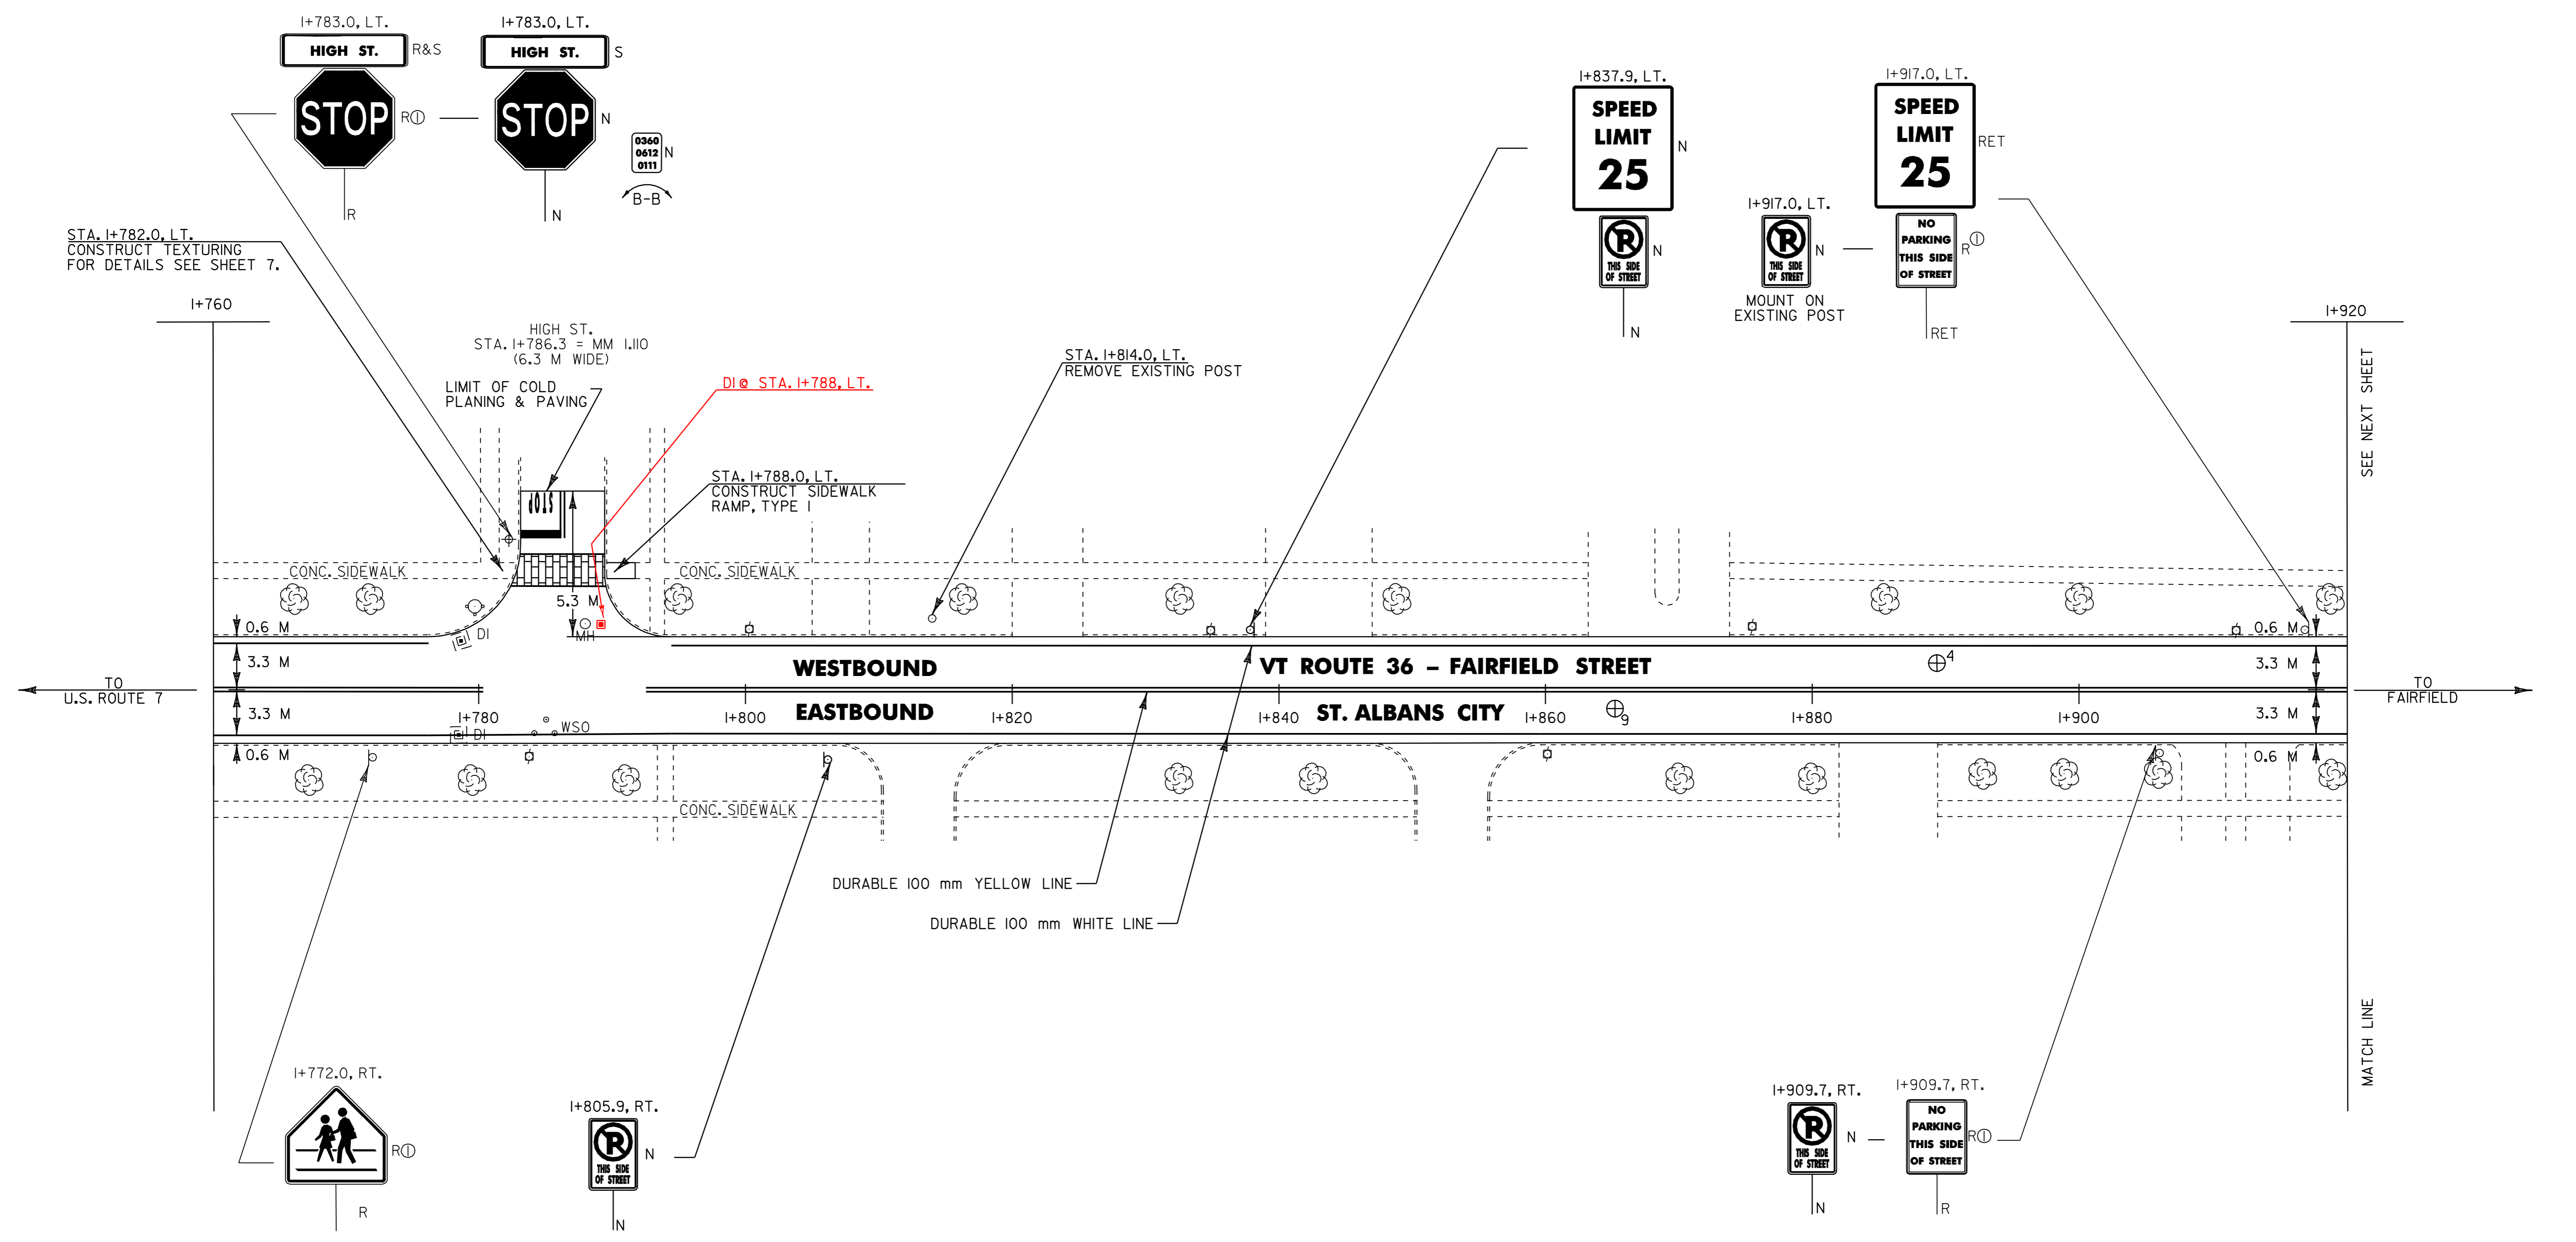

⊕ CORE LOCATION

PAVEMENT CORE DATA			
CORE #	LOCATION	DEPTH (mm)	PCC
9	I+865.2, RT.	127	YES
4	I+889.4, LT.	114	YES

NOTES: 1) ALL DIMENSIONS IN MILLIMETERS EXCEPT WHERE OTHERWISE INDICATED.
 2) ALL EXISTING SIGNS NOT SHOWN SHALL BE RETAINED AS DIRECTED BY THE RESIDENT ENGINEER.
 3) FOR ANY TOWN HIGHWAY OR STREET DETAILS, SEE VTrans STANDARD E-193M.

PROJECT LAYOUT #4	PROJECT NAME: ST. ALBANS CITY	PLOT DATE: 01-FEB-2006 07:5
	PROJECT NUMBER: STP 2129(1)S	DRAWN BY: D-H
	FILE NAME: /pave/99d070/pd070.dgn	CHECKED BY:
	DESIGNED BY: D-H	SHEET 78 OF 105

