

TEMPORARY AND DURABLE 150 mm WHITE LINE
ST. ALBANS CITY STA. 0+008.1 TO
ST. ALBANS TOWN STA. 0+060.0, SOLID LT. & RT.
ST. ALBANS CITY STA. 0+015.2 TO
ST. ALBANS TOWN STA. 0+000.5, SOLID LT.

TEMPORARY LETTER OR SYMBOL
ST. ALBANS CITY STA. 0+017.6, LT. - "STOP" (2)
~~ST. ALBANS CITY STA. 0+021.2, LT. - "STOP" (2)~~
~~ST. ALBANS CITY STA. 0+056.0, LT. - "STOP" (2)~~
ST. ALBANS CITY STA. 0+090.7, LT. - "STOP" (2)
040.0

DURABLE LETTER OR SYMBOL (TYPE ITAPE)
ST. ALBANS CITY STA. 0+017.6, LT. - "STOP" (2)
ST. ALBANS CITY STA. 0+021.2, LT. - "STOP" (2)
ST. ALBANS CITY STA. 0+024.8, LT. - "ONLY" (2)
ST. ALBANS CITY STA. 0+056.0, LT. - "ONLY" (2) 072
ST. ALBANS CITY STA. 0+059.6, LT. - "ONLY" (2) 076
ST. ALBANS CITY STA. 0+090.7, LT. - "STOP" (2) 109
ST. ALBANS CITY STA. 0+094.3, LT. - "ONLY" (2) 000

DURABLE 600 mm STOP BAR (TYPE ITAPE)
ST. ALBANS CITY STA. 0+014.9, LT.

TEMPORARY 600 mm STOP BAR
ST. ALBANS CITY STA. 0+014.9, LT.

TEMPORARY AND DURABLE CROSSWALK MARKING W/DIAGONAL LINES
ST. ALBANS CITY STA. 0+010.2, RT. TO 0+012.2, LT.

REHABILITATION OF D'S, CB'S OR MH'S - CLASS I
ST. ALBANS CITY STA. 0+010.2, RT.
ST. ALBANS CITY STA. 0+012.2, LT.
ST. ALBANS CITY STA. 0+039.5, LT.

BEGIN STP 2204(1)S
ST. ALBANS STATE HIGHWAY
ST. ALBANS CITY
STA. 0+008.05 = MM 0.005


ST. ALBANS CITY STA. 0+094.95 = MM 0.059
ST. ALBANS TOWN STA. 0+000.00 = MM 0.000
CITY OF ST. ALBANS - TOWN OF ST. ALBANS TOWN LINE

FLASHING BEACON-GROUND MOUNTED (MOD.)
ST. ALBANS CITY STA. 0+019.0, LT

~~PAINTED ISLAND~~
~~ST. ALBANS CITY STA. 0+013.0 TO~~
~~ST. ALBANS TOWN STA. 0+000.5~~

DITCH CLEANING
ST. ALBANS TOWN STA. 0+032.0 TO 0+060.0, RT. (SITE 1)
ST. ALBANS TOWN STA. 0+032.0 TO 0+060.0, LT. (SITE 2)
(FOR DETAILS, SEE SHEET 92)

~~PAINTED CURB~~
~~ST. ALBANS TOWN STA. 0+000.5 TO 0+009.5, LT. & RT.~~
~~ST. ALBANS TOWN STA. 0+041.1 TO 0+060.0, LT.~~

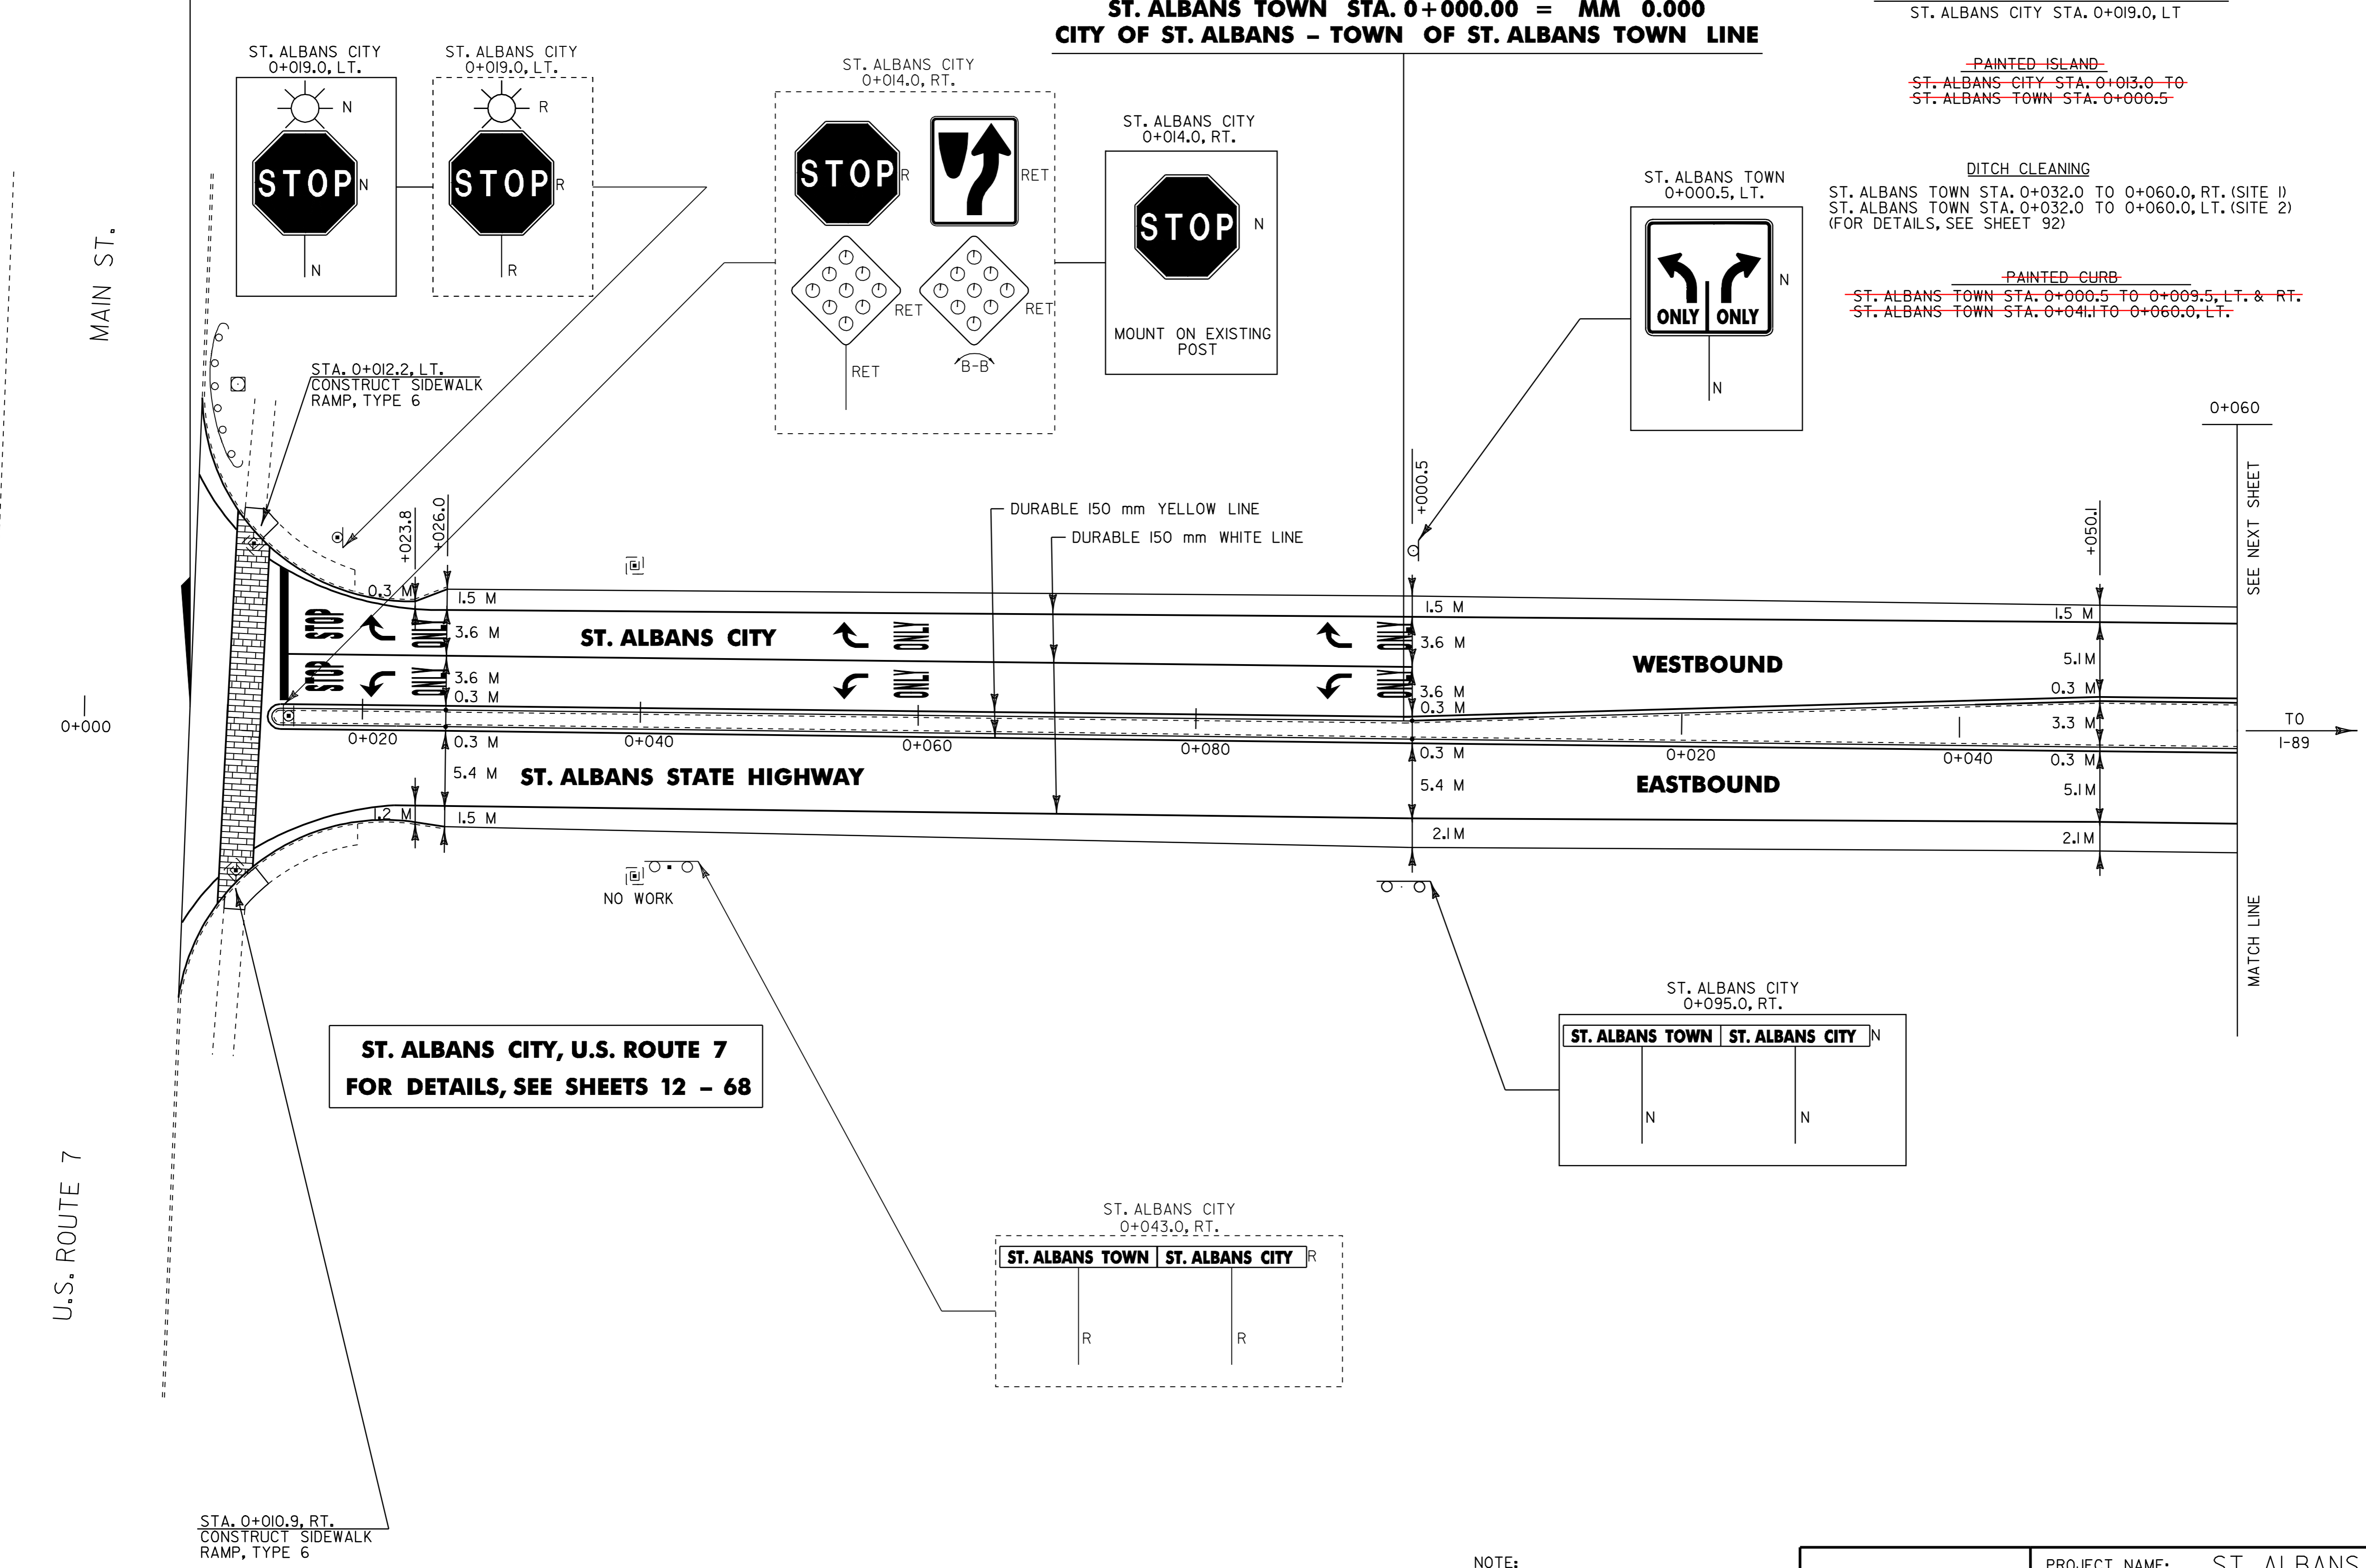

ST. ALBANS CITY, U.S. ROUTE 7
FOR DETAILS, SEE SHEETS 12 - 68

NOTE:
1) ALL DIMENSIONS IN MILLIMETERS EXCEPT WHERE OTHERWISE INDICATED
2) ALL EXISTING SIGNS NOT SHOWN SHALL BE RETAINED AS DIRECTED BY THE RESIDENT ENGINEER.

PROJECT LAYOUT #1

PROJECT NAME: ST. ALBANS CITY-ST. ALBANS
PROJECT NUMBER: STP_2204(1)S
FILE NAME: Z:\pave\299b160\pbl60.dgn PLOT DATE: 01-FEB-2006 07:5
PROJECT LEADER: JLL DRAWN BY: D-H
DESIGNED BY: D-H CHECKED BY:
IPARM FILE NAME: pbl60.dwg SHEET 96 OF 105

