


TEMPORARY AND DURABLE 150 mm WHITE LINE
STA. 0+220.0 TO 0+380.0, SOLID LT. & RT.

TEMPORARY AND DURABLE 150 mm YELLOW LINE
STA. 0+220.0 TO 0+380.0, SOLID LT. & RT.

~~DURABLE LETTERS OR SYMBOLS (TYPE I TAPE)~~
~~STA. 0+224.5, LT - STOP~~

~~TEMPORARY LETTERS OR SYMBOLS~~
~~STA. 0+224.5, LT - STOP~~

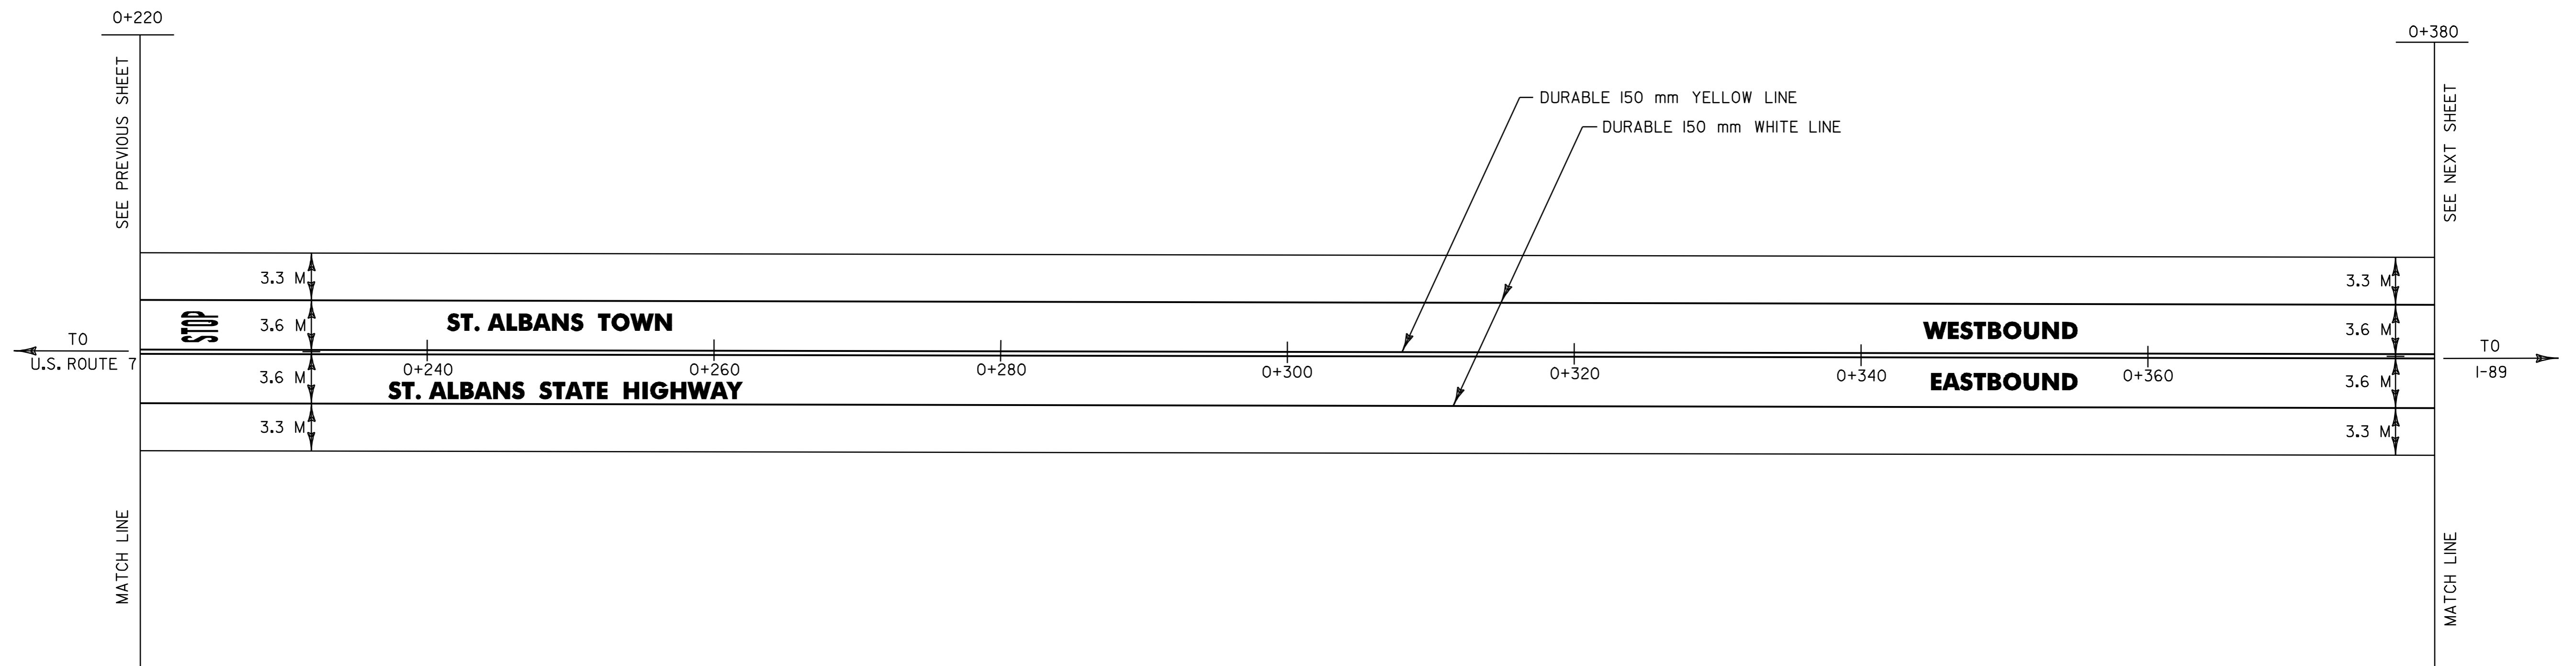

NOTE: _____
 1) ALL DIMENSIONS IN MILLIMETERS
 EXCEPT WHERE OTHERWISE INDICATED _____
 2) ALL EXISTING SIGNS NOT SHOWN
 SHALL BE RETAINED AS DIRECTED
 BY THE RESIDENT ENGINEER. _____

PROJECT LAYOUT #3

PROJECT NAME: ST. ALBANS CITY-ST. ALBANS
 PROJECT NUMBER: STP 2204(I)S
 FILE NAME: Z:\gve\99\bl60\bl60.dgn PLOT DATE: 01-FEB-2006 07:59
 PROJECT LEADER: JLL DRAWN BY: D-H
 DESIGNED BY: D-H CHECKED BY:
 IPARM FILE NAME: bl603.l SHEET 98 OF 105