

TEMPORARY AND DURABLE 150 mm WHITE LINE
STA. 0+860.0 TO 1+020.0, SOLID LT. & RT.

TEMPORARY AND DURABLE 150 mm YELLOW LINE
STA. 0+860.0 TO 0+937.6, SOLID LT. & RT.
STA. 0+937.6 TO 1+020.0, DOUBLE SOLID LT. & RT.

~~TEMPORARY AND DURABLE 300 mm YELLOW LINE~~
STA. 0+953.7 TO 1+020.0 (DIAGONALS)


DURABLE LETTERS OR SYMBOLS (TYPE I TAPE)
STA. 0+969.0, RT - *SIGNAL* 957
STA. 0+981.0, RT - *AHEAD* 963

DITCH CLEANING
STA. 0+860.0 TO 1+020.0, LT. (SITE 5)
(FOR DETAILS, SEE SHEET 92)



~~TEMPORARY LETTERS OR SYMBOLS~~
STA. 0+969.0, RT - *SIGNAL*
STA. 0+981.0, RT - *AHEAD*

REMOVING SIGNS
AS SHOWN - 1

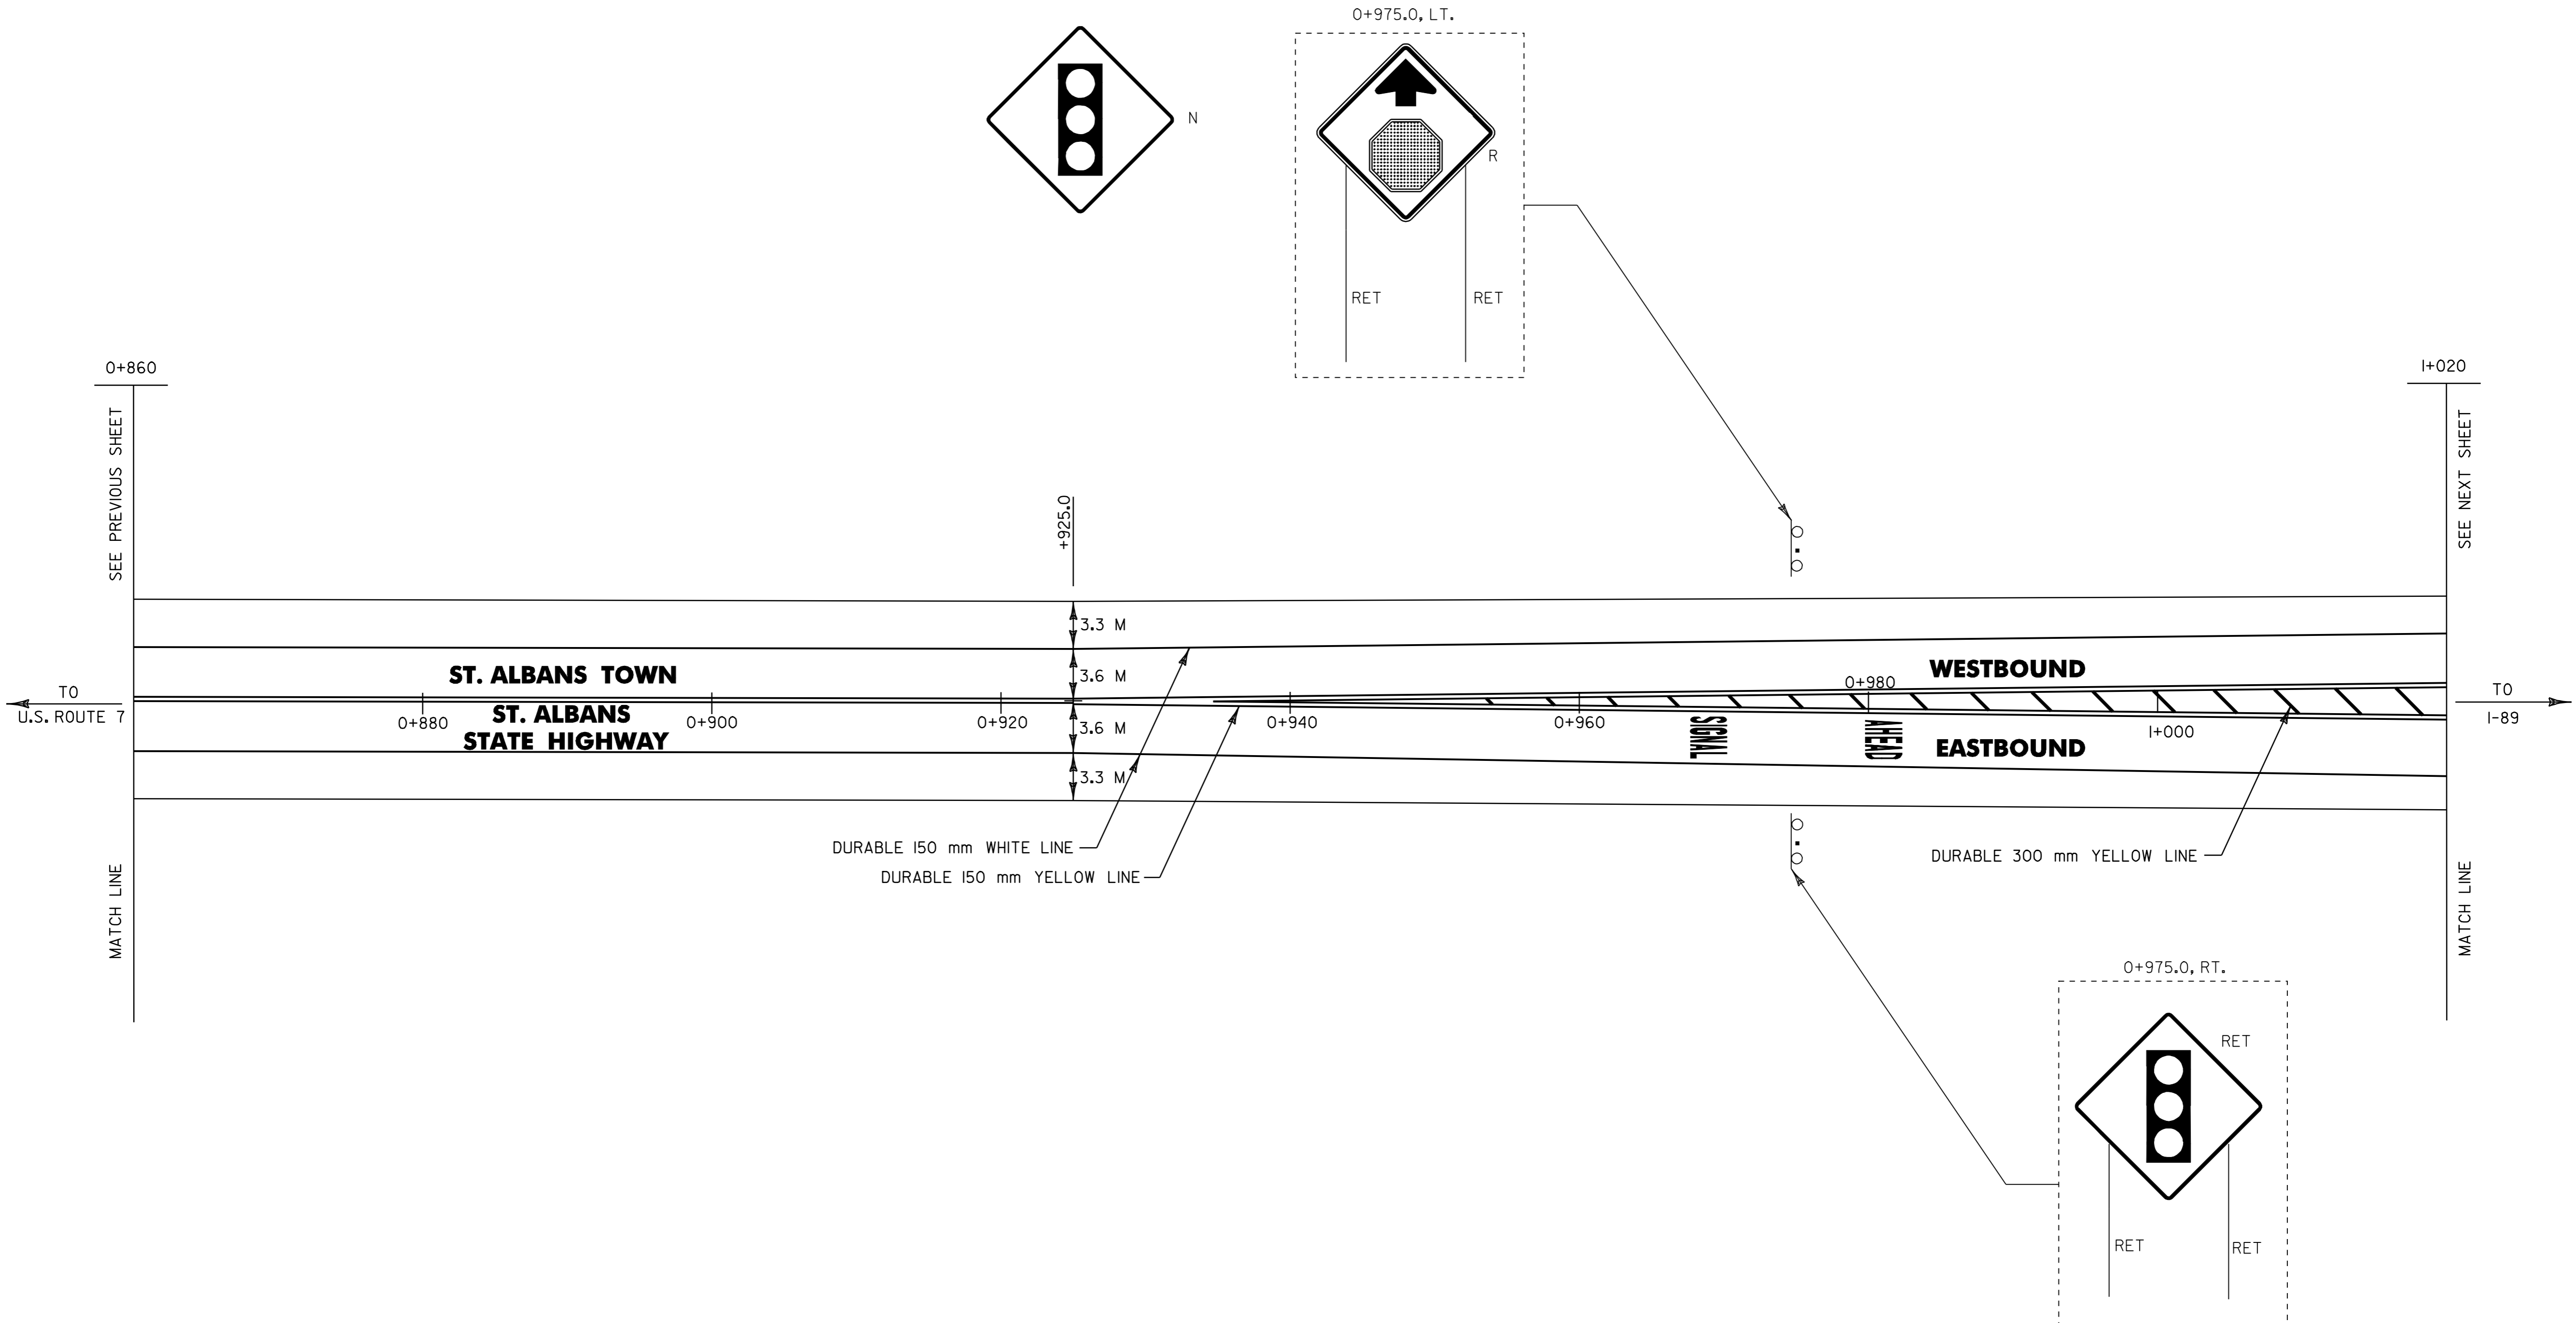

SEE PREVIOUS SHEET
TO U.S. ROUTE 7
MATCH LINE

SEE NEXT SHEET
TO I-89
MATCH LINE

NOTE:
1) ALL DIMENSIONS IN MILLIMETERS EXCEPT WHERE OTHERWISE INDICATED
2) ALL EXISTING SIGNS NOT SHOWN SHALL BE RETAINED AS DIRECTED BY THE RESIDENT ENGINEER.

PROJECT LAYOUT #7

PROJECT NAME:	ST. ALBANS CITY-ST. ALBANS	FILE NAME:	/pave/99bl60/pbl60.dgn	PLOT DATE:	01-FEB-2006 07:5
PROJECT NUMBER:	STP 2204(I)S	PROJECT LEADER:	JLL	DRAWN BY:	D-H
		DESIGNED BY:	D-H	CHECKED BY:	
		IPARM FILE NAME:	pbl6017.i	SHEET	102 OF 105

