


INDEX OF SHEETS
SEE SHEET 2 OF 105

STATE OF VERMONT
AGENCY OF TRANSPORTATION



PROPOSED IMPROVEMENT
CLASS I TOWN HIGHWAY
CITY OF ST. ALBANS
COUNTY OF FRANKLIN

PROJECT LOCATION
STP 9804(1)S
STP 2129(1)S
STP 2204(1)S

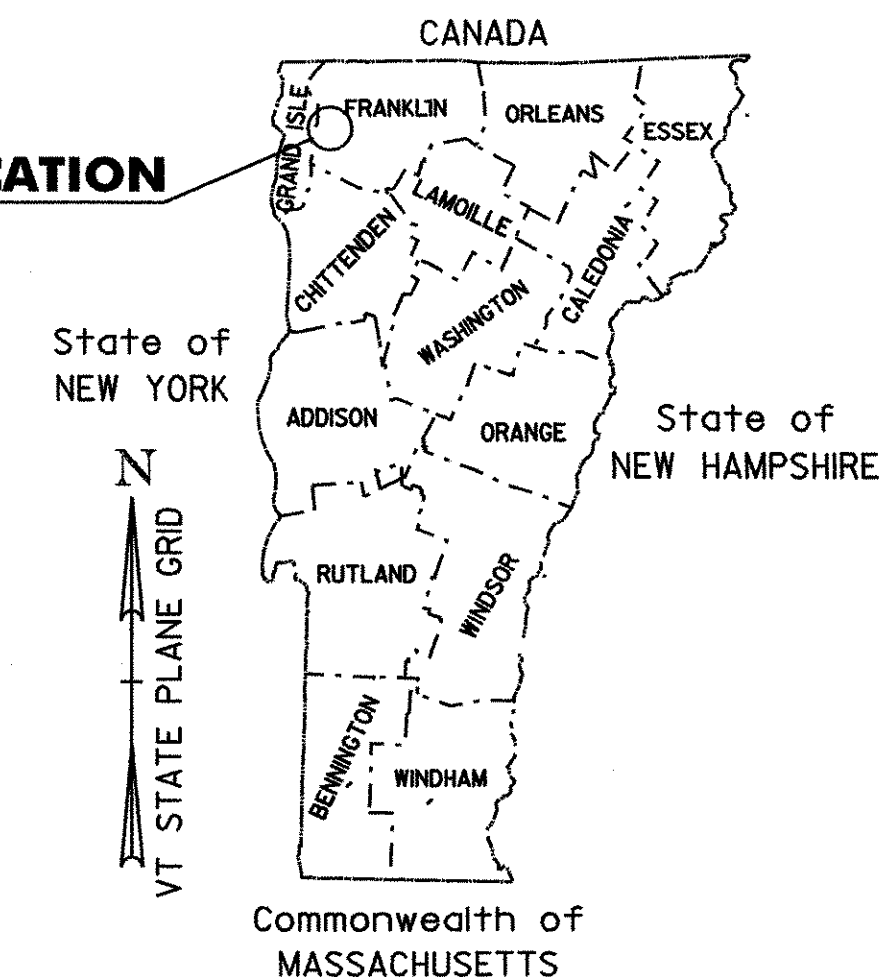

RECORD PLANS	
CONTRACTOR:	PIKE INDUSTRIES
RESIDENT ENGINEER:	DELVIN WARNER
CONSTRUCTION BEGAN:	JULY 21, 2003
CONSTRUCTION COMPLETE:	OCTOBER 31, 2003
RECORD PLANS BY:	N. GARBACIK & K. NORTH
I HEREBY CERTIFY THAT ALL THE CONSTRUCTION REQUIRED BY THIS SET OF DRAWINGS HAS BEEN ACCOMPLISHED AS INDICATED HEREIN.	
BY <i>Delvin Warner</i>	RESIDENT ENGINEER
DATE <i>01/26/05</i>	
NOTE: Any further information concerning final quantities, amounts or other details relative to this project may be found at Central Files in the electronic archives.	

ST. ALBANS CITY
STP 9804(1)S
U.S. ROUTE 7
SEE SHEET 12 OF 105

ST. ALBANS CITY
STP 2129(1)S
VT ROUTE 36
SEE SHEET 70 OF 105

ST. ALBANS CITY-ST. ALBANS
STP 2204(1)S
ST ALBANS STATE HIGHWAY
SEE SHEET 90 OF 105

BEGIN STP 9804(1)S
U.S. ROUTE 7 - MAIN STREET
ST. ALBANS CITY
STA. 0+000.00 (MM 0.000)

BEGIN STP 2204(1)S
ST. ALBANS STATE HIGHWAY
ST. ALBANS CITY
STA. 0+008.00 (MM 0.005)

END STP 9804(1)S
U.S. ROUTE 7 - MAIN STREET
ST. ALBANS CITY
STA. 3+640.40 (MM 2.262)

BEGIN STP 2129(1)S
VT ROUTE 36 - FAIRFIELD STREET
ST. ALBANS CITY
STA. 1+406.57 (MM 0.874)

END STP 2129(1)S
VT ROUTE 36 - FAIRFIELD STREET
ST. ALBANS CITY
STA. 2+397.92 (MM 1.490)

END STP 2204(1)S
ST. ALBANS STATE HIGHWAY
ST. ALBANS TOWN
STA. 1+039.64 (MM 0.646)

CONVENTIONAL SYMBOLS

COUNTY LINE	
TOWN LINE	
LIMITS OF ACCESS	
POINT OF ACCESS	
FENCE LINE	
STONE WALL	
TRAVELED WAY	
GUARD RAIL	
RAILROAD	
SURVEY LINE	
CULVERT	
POWER POLE	
TELEPHONE POLE	
TREES	
CONTROL OF ACCESS	
PROPERTY LINE	
R.O.W. TAKING LINE	
SLOPE RIGHTS	
TOP OF CUT	
TOE OF SLOPE	

UTILITY LEGEND

- = EXISTING HYDRANT
- = EXISTING DI
- = EXISTING MANHOLE
- = EXISTING TELEPHONE MANHOLE
- = EXISTING ELECTRIC MANHOLE
- = EXISTING SEWER MANHOLE
- = EXISTING WATER SHUTOFF
- = EXISTING GAS SHUTOFF
- = EXISTING MAILBOX


SIGN LEGEND

- N = NEW
- R = REMOVE
- R&S = REMOVE & SALVAGE
- S = SALVAGE SIGN
- RET = RETAIN
- B-B = BACK TO BACK
- ⊕ = RETURN TO CITY OF ST. ALBANS

SURVEYED BY : D-H
SURVEYED DATE : 06-07-00

DATUM

VERTICAL N/A
HORIZONTAL N/A

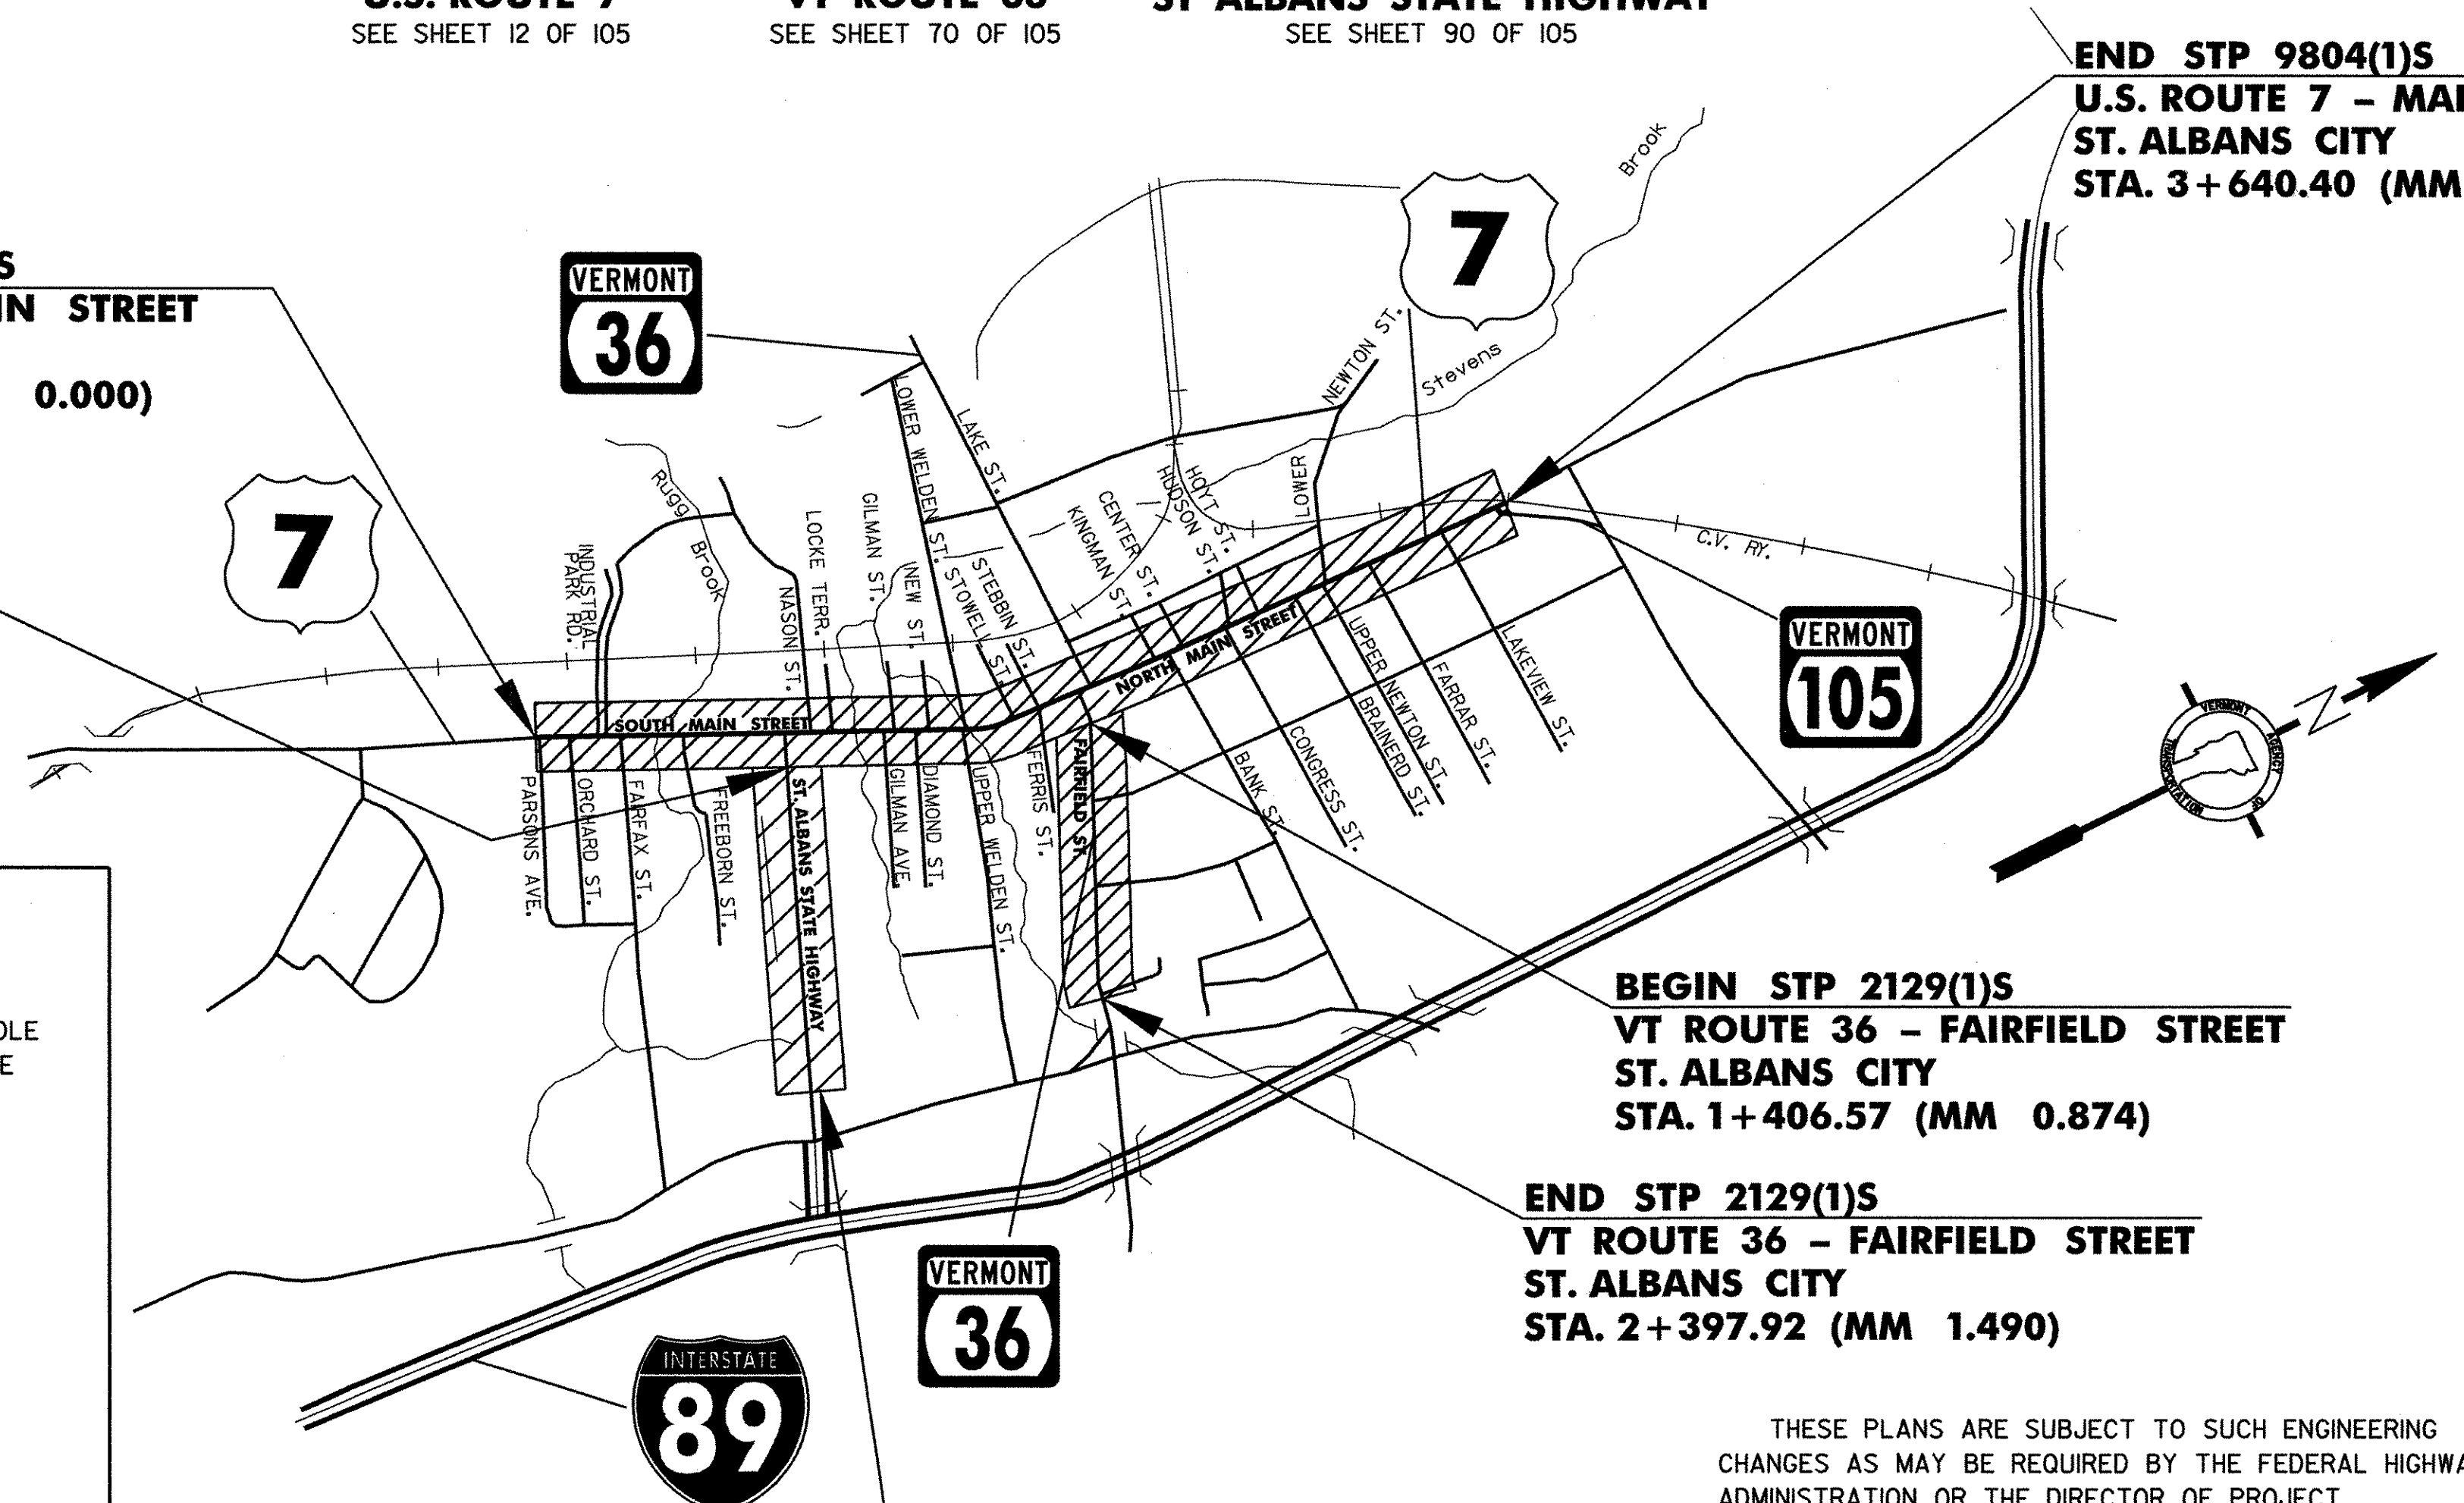

NOTE:
RIGHT-OF-WAY LIMITS, IF APPLICABLE, ARE PROVIDED SOLELY FOR THE CONVENIENCE OF THE STATE AND ITS CONTRACTOR DURING THE COURSE OF THIS PAVING PROJECT. ANY REFERENCES TO OFFSETS ON THESE PLANS ARE APPROXIMATE AND SHOULD NOT BE RELIED UPON FOR ANY PURPOSES.
UNLESS OTHERWISE NOTED, ALL DRAWINGS AND DETAILS ON THESE PLANS ARE DRAWN "NOT TO SCALE".

Metric
UNLESS NOTED OTHERWISE
STATIONS ARE IN KILOMETERS
ELEVATIONS ARE IN METERS
DIMENSIONS ARE IN MILLIMETERS

THESE PLANS ARE SUBJECT TO SUCH ENGINEERING CHANGES AS MAY BE REQUIRED BY THE FEDERAL HIGHWAY ADMINISTRATION OR THE DIRECTOR OF PROJECT DEVELOPMENT.
CONSTRUCTION IS TO BE CARRIED ON IN ACCORDANCE WITH THESE PLANS AND THE STANDARD SPECIFICATIONS FOR CONSTRUCTION DATED 2001, AS APPROVED BY THE FEDERAL HIGHWAY ADMINISTRATION ON JANUARY 4, 2001 FOR USE ON THIS PROJECT, INCLUDING ALL SUBSEQUENT REVISIONS AND SUCH REVISED SPECIFICATIONS AND SPECIAL PROVISIONS AS ARE INCORPORATED IN THESE PLANS.

DEPARTMENT OF TRANSPORTATION FEDERAL HIGHWAY ADMINISTRATOR	
APPROVED _____	DATE _____
DIRECTOR OF PROJECT DEVELOPMENT	
APPROVED <i>[Signature]</i>	DATE <i>4/6/03</i>
PROJECT MANAGER :	
PROJECT NAME :	ST. ALBANS CITY ST. ALBANS CITY-ST. ALBANS
PROJECT NUMBER :	STP 9804(1)S / STP 2129(1)S STP 2204(1)S
SHEET 1 OF 105 SHEETS	

INDEX

1	COMPOSITE TITLE SHEET
2	COMPOSITE INDEX OF SHEETS & VTrans STANDARDS
3-5	COMPOSITE QUANTITY SHEETS
6	COMPOSITE CONSTRUCTION APPROACH SIGNING SHEET
7	COMPOSITE SIDEWALK RAMP TEXTURING & CROSSWALK DETAILS SHEET
8	COMPOSITE PAVEMENT MARKING DETAILS SHEET
9-10	COMPOSITE VEHICLE DETECTOR LOOP DETAIL SHEETS
11	BLANK

ST. ALBANS CITY STP 9804(1)S

12	TITLE SHEET
13	PROJECT TYPICAL SHEET
14-16	QUANTITY SHEETS
17-18	ITEM DETAIL SUMMARY SHEETS
19-47	LAYOUT SHEETS
48-63	TRAFFIC SIGN SUMMARY SHEETS
64-65	TRAFFIC SIGN DETAIL SHEET
66	BICYCLE LANE SIGNS & PAVEMENT MARKING DETAILS
67-68	UTILITY AND STRUCTURE LOCATION SHEETS
69	BLANK

ST. ALBANS CITY STP 2129(1)S

70	TITLE SHEET
71	PROJECT TYPICAL SHEET
72-73	QUANTITY SHEETS
74	ITEM DETAIL SUMMARY SHEET
75-82	LAYOUT SHEETS
83-87	TRAFFIC SIGN SUMMARY SHEETS
88	TRAFFIC SIGN DETAIL SHEET
89	UTILITY AND STRUCTURE LOCATION SHEET

ST. ALBANS CITY-ST. ALBANS STP 2204(1)S

90	TITLE SHEET
91	PROJECT TYPICAL SHEET
92	DITCH CLEANING SHEET
93-94	QUANTITY SHEETS
95	ITEM DETAIL SUMMARY SHEET
96-103	LAYOUT SHEETS
104	TRAFFIC SIGN SUMMARY SHEET
105	UTILITY AND STRUCTURE LOCATION SHEET


VTrans STANDARDS

C-1M	CURB DETAILS	01-03-00
C-2AM	PORTLAND CEMENT CONCRETE SIDEWALK	01-03-00
C-3M	SIDEWALK RAMPS	01-03-00
D-3M	TREATED GUTTERS	06-13-97
D-15M	CAST IRON GRATE, TYPES D & E	06-13-97
E-100M	CONSTRUCTION APPROACH SIGNS	06-13-97
E-100AM	SIDE ROAD CONSTRUCTION APPROACH SIGNS	02-02-98
E-101M	CONSTRUCTION SIGN DETAILS	06-13-97
E-102M	CONSTRUCTION SIGN DETAILS	06-13-97
E-102AM	CONSTRUCTION SIGN DETAILS	06-13-97
E-103M	MAINLINE TRAFFIC CONTROL DIVIDED HIGHWAY ONE LANE CLOSED	09-24-98
E-106M	TRAFFIC CONTROL MISCELLANEOUS DETAILS	06-13-97
E-107M	CONSTRUCTION AREA BARRICADES AND DELINEATION	06-13-97
E-107AM	BREAKAWAY BARRICADE DETAILS	06-13-97
E-108M	CONSTRUCTION ZONE LONGITUDINAL DROP OFFS	06-13-97
E-110M	MAJOR MAINTENANCE OPERATION LANE CLOSURE	06-13-97
E-120M	STANDARD SIGN PLACEMENT EXPRESSWAY	06-13-97
E-121M	STANDARD SIGN PLACEMENT CONVENTIONAL ROAD	06-13-97
E-123M	GUIDE SIGN PLACEMENT MISCELLANEOUS DETAILS	06-13-97
E-124M	TOWN LINE SIGNS	06-13-97
E-135M	INTERSTATE ROUTE MARKER SIGN DETAIL	06-13-97
E-136AM	U.S. ROUTE MARKER SIGN DETAILS	06-13-97
E-136BM	STATE ROUTE MARKER SIGN DETAILS	06-13-97
E-138M	MILEMARKER DETAILS - STATE & TOWN HIGHWAYS	06-13-97
E-140M	REGULATORY SIGN DETAILS	06-13-97
E-141M	REGULATORY SIGN DETAILS	06-13-97
E-142M	REGULATORY SIGN DETAILS	06-13-97
E-143M	REGULATORY SIGN DETAILS	06-13-97
E-144M	REGULATORY SIGN DETAILS	03-29-99
E-145AM	REGULATORY SIGN DETAILS	06-13-97
E-145BM	REGULATORY SIGN DETAILS	06-13-97
E-146M	REGULATORY SIGN DETAILS	06-13-97
E-150M	WARNING SIGN DETAILS	06-13-97
E-151M	WARNING SIGN DETAILS	06-13-97
E-152M	WARNING SIGN DETAILS	06-13-97
E-153M	WARNING SIGN DETAILS	06-13-97
E-160M	FLANGED CHANNEL STEEL SIGN POST	06-13-97
E-161M	W-SHAPED STEEL SIGN POST	06-13-97
E-162M	TUBULAR ALUMINUM SIGN POST	06-13-97
E-163M	TUBULAR STEEL SIGN POST	06-13-97
E-164M	SQUARE STEEL SIGN POST	06-13-97
E-172M	VEHICLE DETECTOR LOOP DETAILS	06-13-97
E-173M	PULL BOXES AND JUNCTION BOXES DETAILS	06-13-97
E-175M	POWER DROP STANCHIONS	11-04-99
E-191M	PAVEMENT MARKING DETAILS	02-01-99
E-192M	PAVEMENT MARKING DETAILS	12-28-98
E-193M	PAVEMENT MARKING DETAILS	06-13-97
G-1M	STEEL BEAM GUARD RAIL	01-03-00
G-1dM	STEEL BEAM GUARD RAIL	01-03-00
T-1M	TEMPORARY EROSION CONTROL DETAILS	06-13-97
T-2M	TEMPORARY EROSION CONTROL DETAILS	06-13-97



INDEX OF SHEETS	PROJECT NAME: ST. ALBANS CITY-ST. ALBANS CITY-ST. ALBANS
	PROJECT NUMBER: SIP_9804(1)S, SIP_2129(1)S, SIP_2204(1)S
	FILE NAME: Zpqve297d150Zpd150.dgn
	DESIGNED BY: D-H
	PLOT DATE: 01-FEB-2006 07:4
	DRAWN BY: D-H
	CHECKED BY:
	SHEET 2 OF 105

CONSTRUCTION APPROACH SIGNING
SEE VTrans STANDARDS E-100M & E-100AM FOR SIGN PLACEMENT.

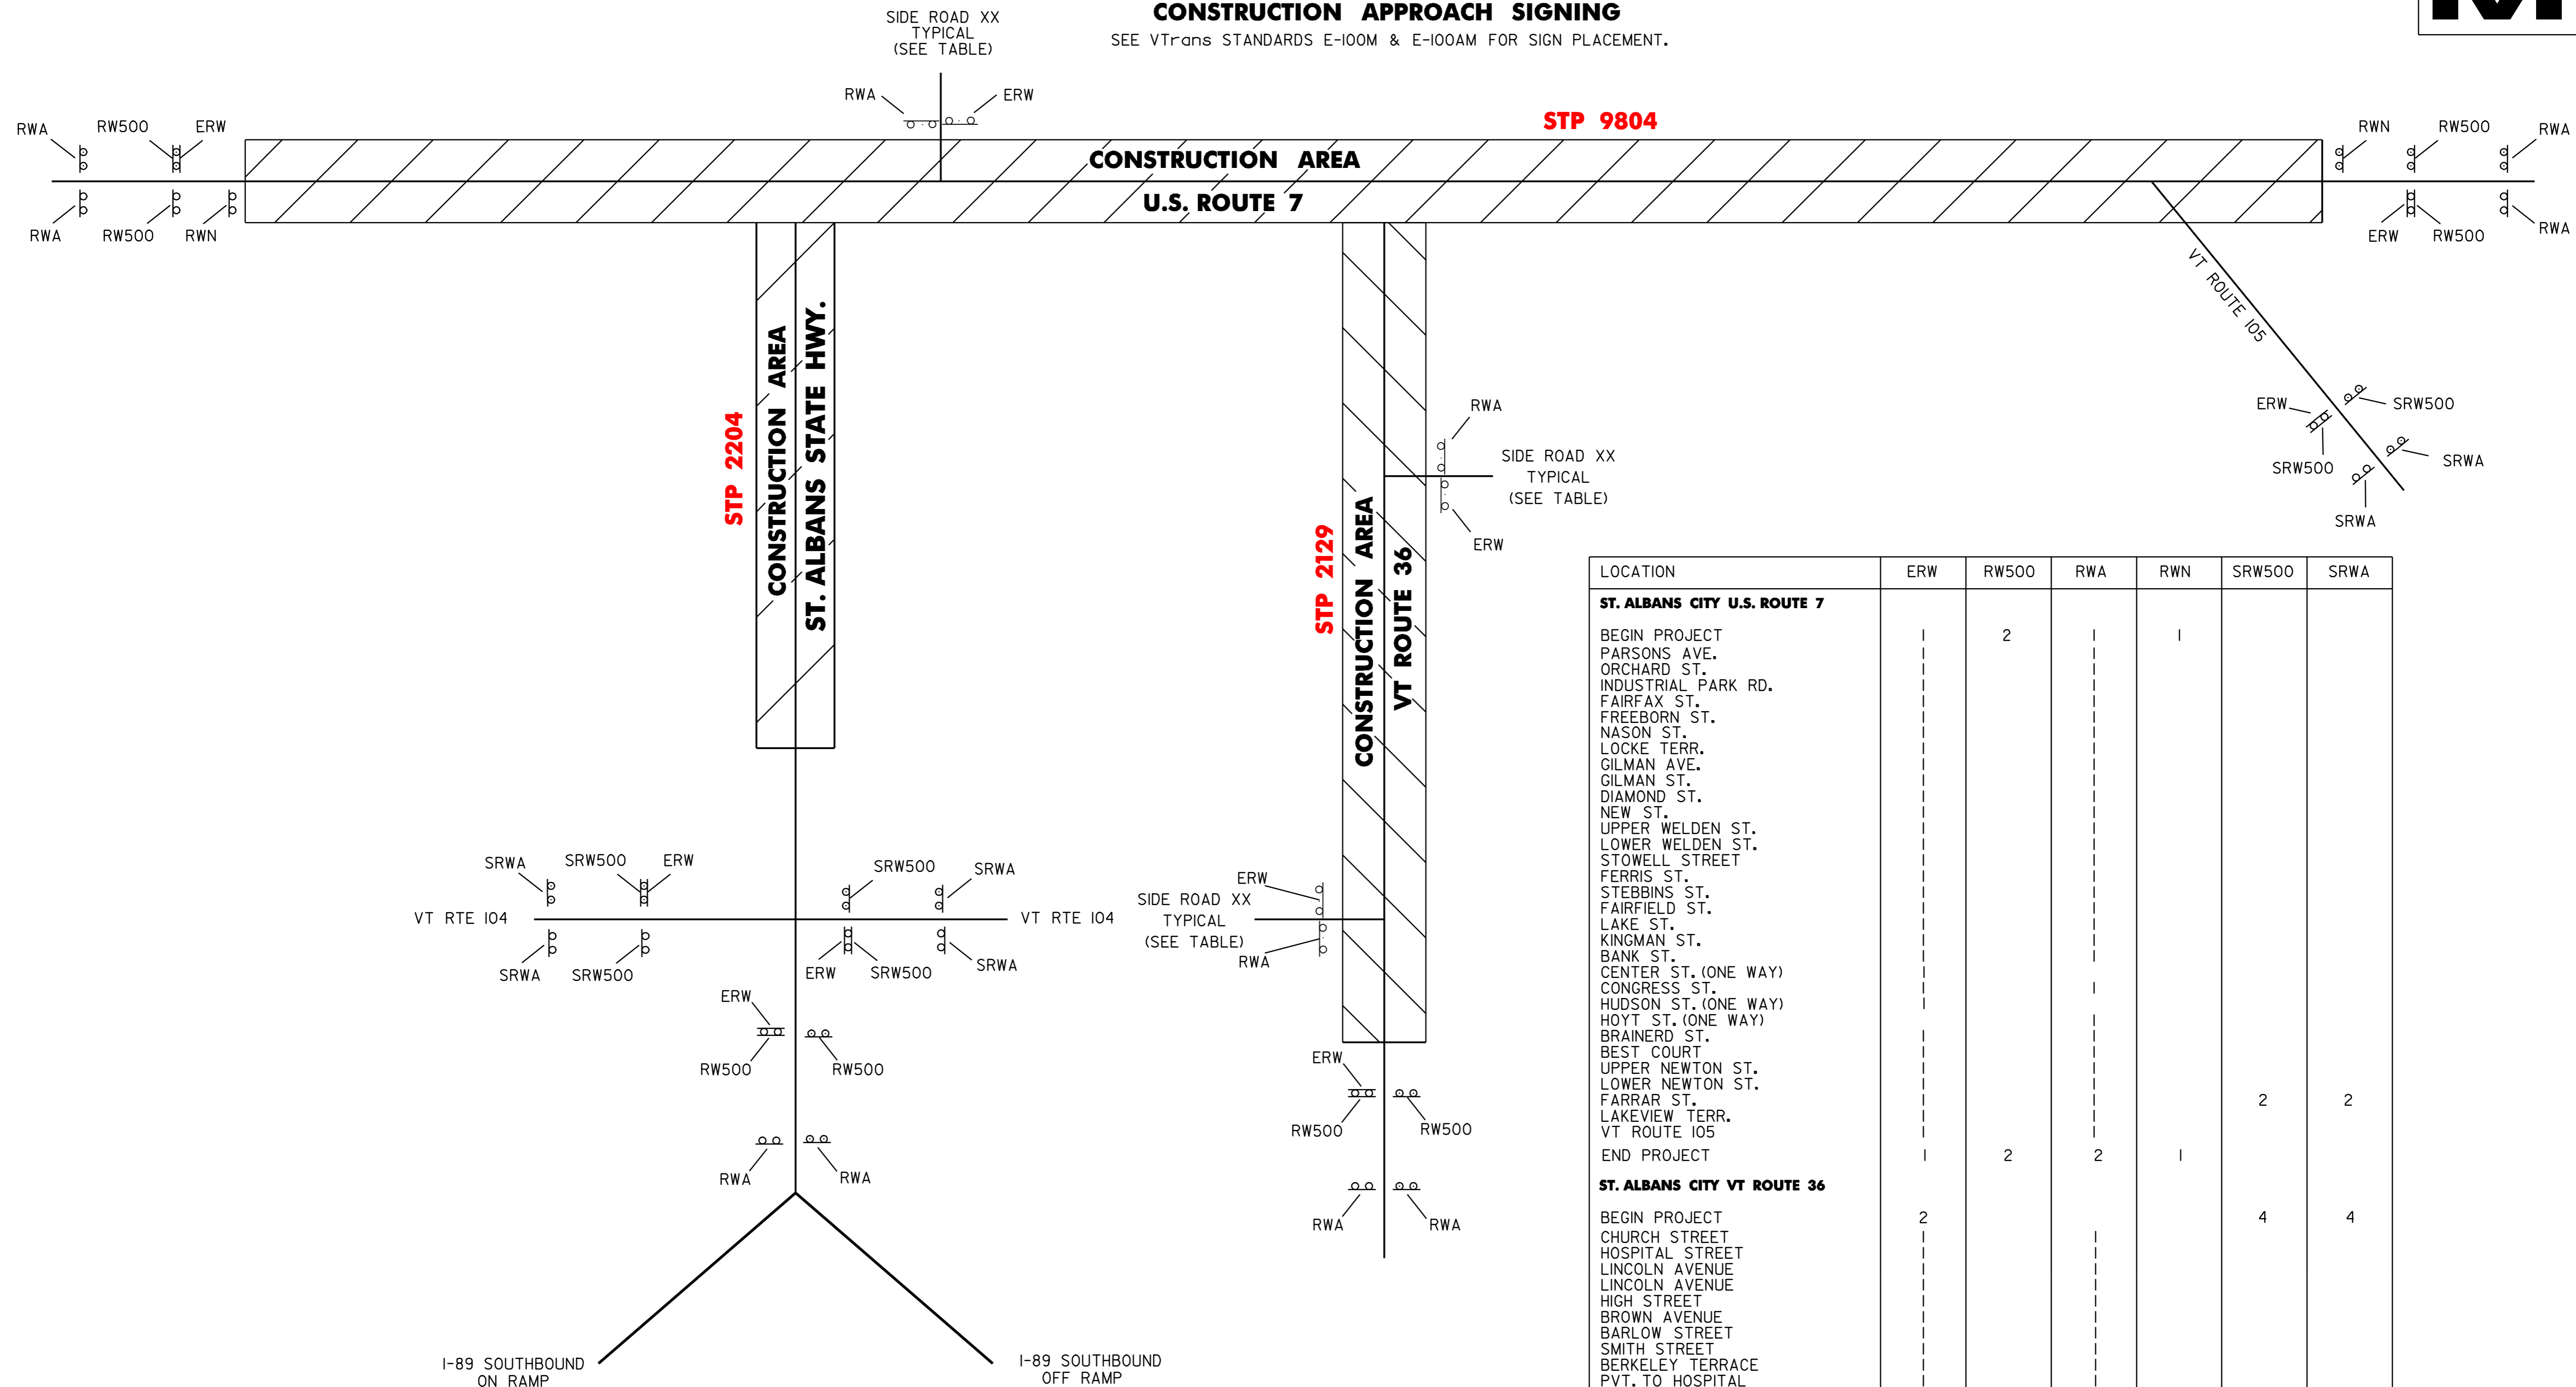

LOCATION	ERW	RW500	RWA	RWN	SRW500	SRWA
ST. ALBANS CITY U.S. ROUTE 7						
BEGIN PROJECT		2		1		
PARSONS AVE.						
ORCHARD ST.						
INDUSTRIAL PARK RD.						
FAIRFAX ST.						
FREEBORN ST.						
NASON ST.						
LOCKE TERR.						
GILMAN AVE.						
GILMAN ST.						
DIAMOND ST.						
NEW ST.						
UPPER WELDEN ST.						
LOWER WELDEN ST.						
STOWELL STREET						
FERRIS ST.						
STEBBINS ST.						
FAIRFIELD ST.						
LAKE ST.						
KINGMAN ST.						
BANK ST.						
CENTER ST. (ONE WAY)						
CONGRESS ST.						
HUDSON ST. (ONE WAY)						
HOYT ST. (ONE WAY)						
BRAINERD ST.						
BEST COURT						
UPPER NEWTON ST.						
LOWER NEWTON ST.						
FARRAR ST.					2	2
LAKEVIEW TERR.						
VT ROUTE 105						
END PROJECT	1	2	2	1		
ST. ALBANS CITY VT ROUTE 36						
BEGIN PROJECT	2				4	4
CHURCH STREET						
HOSPITAL STREET						
LINCOLN AVENUE						
LINCOLN AVENUE						
HIGH STREET						
BROWN AVENUE						
BARLOW STREET						
SMITH STREET						
BERKELEY TERRACE						
PVT. TO HOSPITAL						
CREST ROAD		2	2			
END PROJECT		2	2			
ST. ALBANS STATE HIGHWAY						
VT RTE 104 (NORTH)					2	2
VT RTE 104 (SOUTH)					2	2
ST. ALBANS S. H.		2	2			
TOTALS	50	8	47	2	10	10


LEGEND

- ERW = END ROAD WORK
- RW500 = ROAD WORK 500 FT
- RWA = ROAD WORK AHEAD
- RWN = ROAD WORK NEXT 2/4MILES
- SRW500 = SIDE ROAD WORK 500 FT
- SRWA = SIDE ROAD WORK AHEAD


CONSTRUCTION APPROACH SIGNING

PROJECT NAME: ST. ALBANS CITY/ST. ALBANS CITY-ST. ALBANS
 PROJECT NUMBER: STP_9804(1)S, STP_2129(1)S, STP_2204(1)S
 FILE NAME: \pave\97\d150\pd150.dgn PLOT DATE: 01-FEB-2006 07:4
 PROJECT LEADER: JLL DRAWN BY: D-H
 DESIGNED BY: D-H CHECKED BY:
 IPARM FILE NAME: pd150cas.i SHEET 6 OF 105




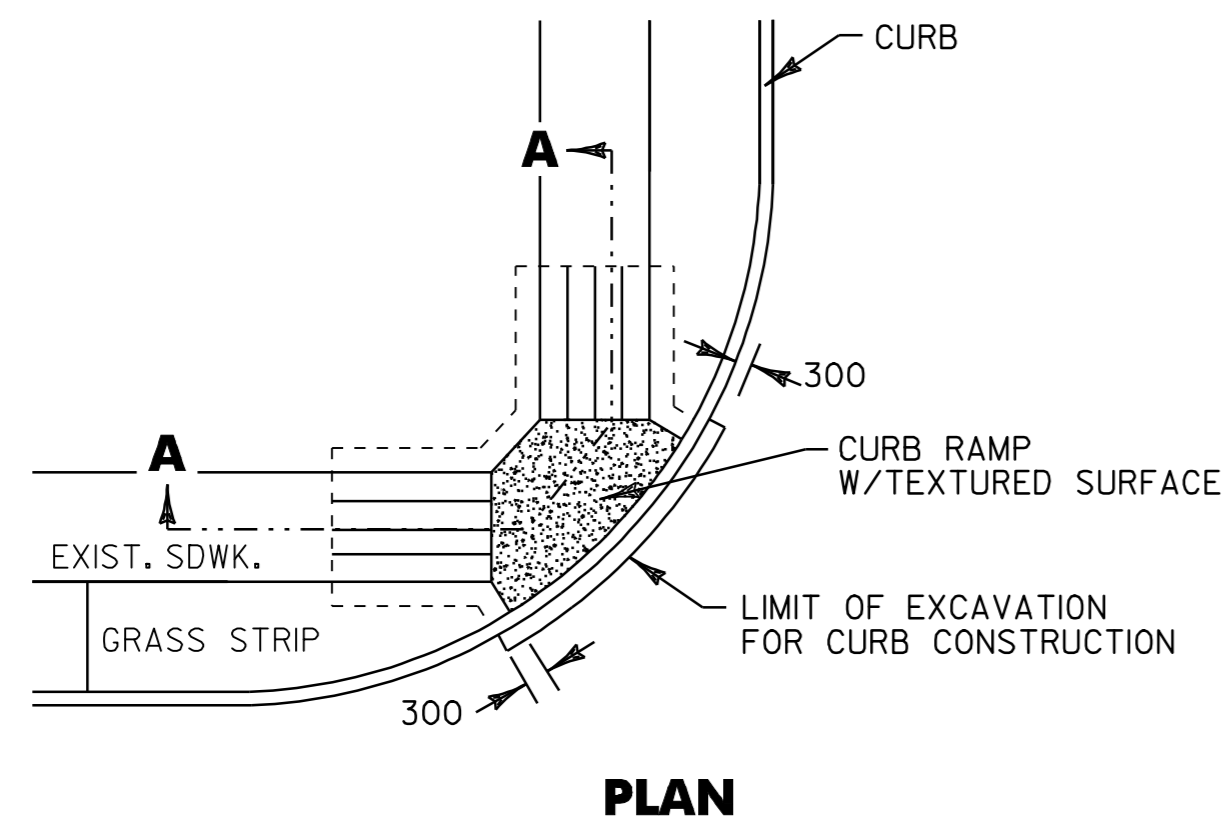


ITEM 618.10 - PORTLAND CEMENT CONCRETE SIDEWALK, 125 mm

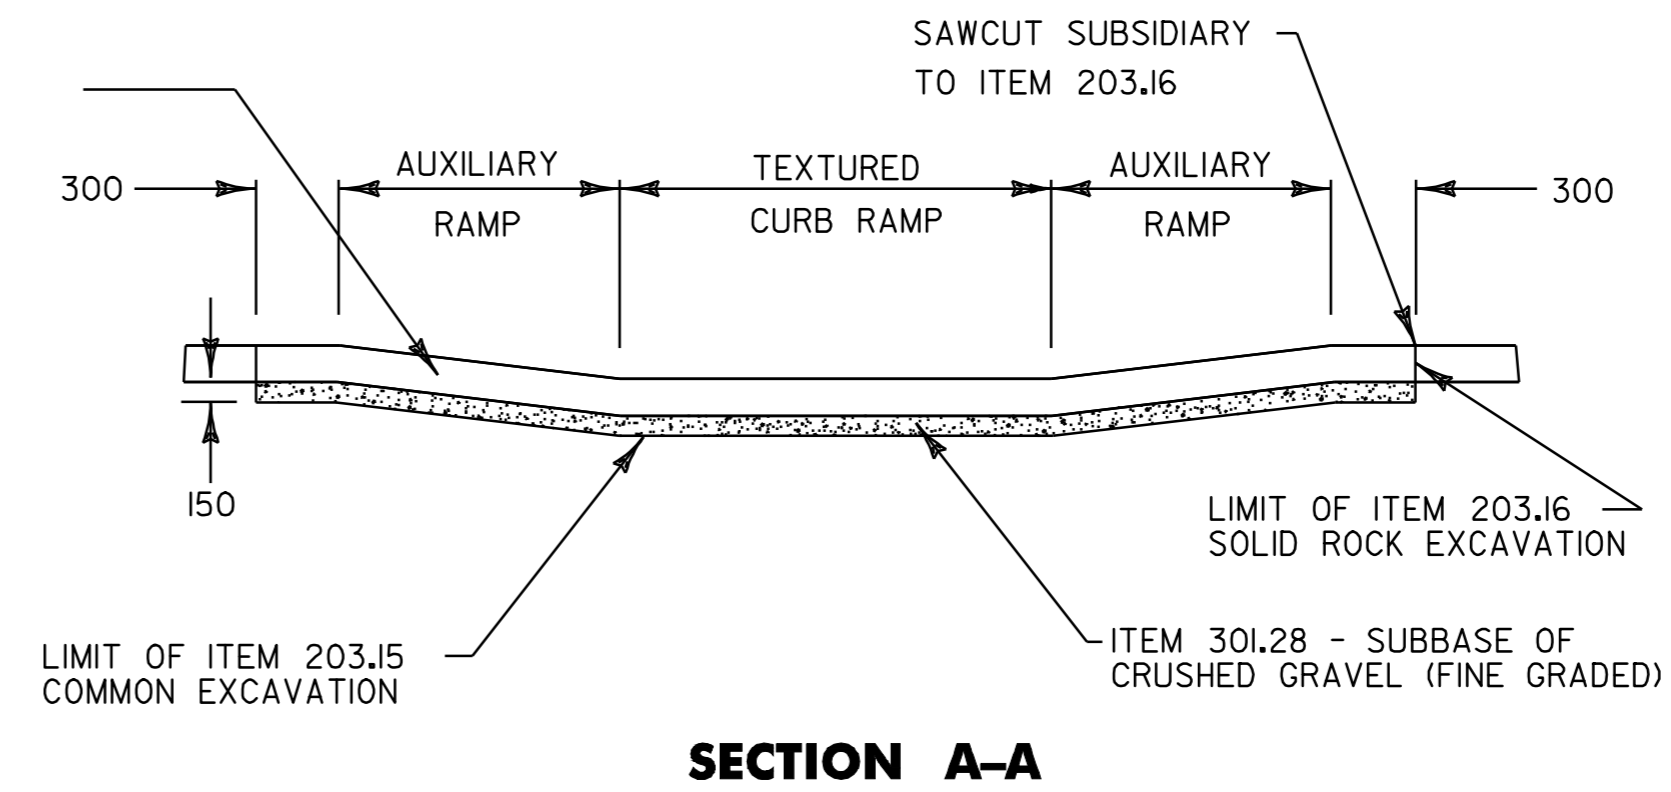

CONCRETE SIDEWALK RAMP PAY LIMIT DETAIL
NOT TO SCALE

NOTE:
THIS DETAIL IS FOR PAY LIMITS ONLY. FOR INDIVIDUAL RAMP CONFIGURATIONS, SLOPES, DIMENSIONS, ETC., SEE VTrans STANDARD C-3M.

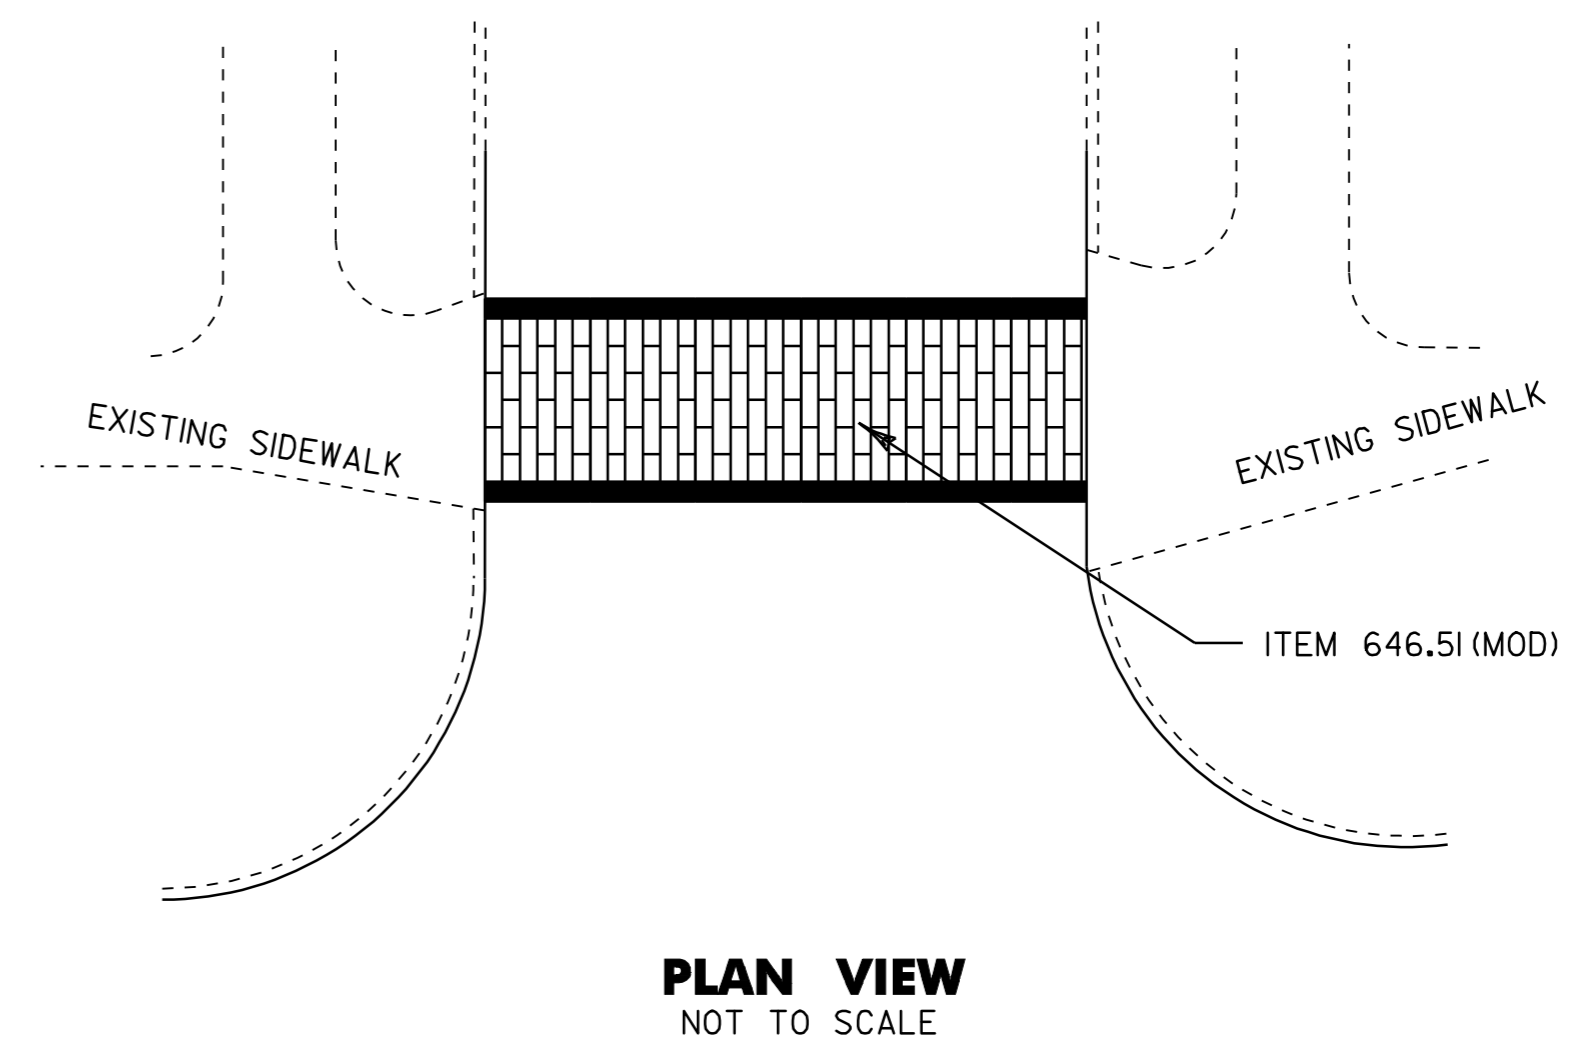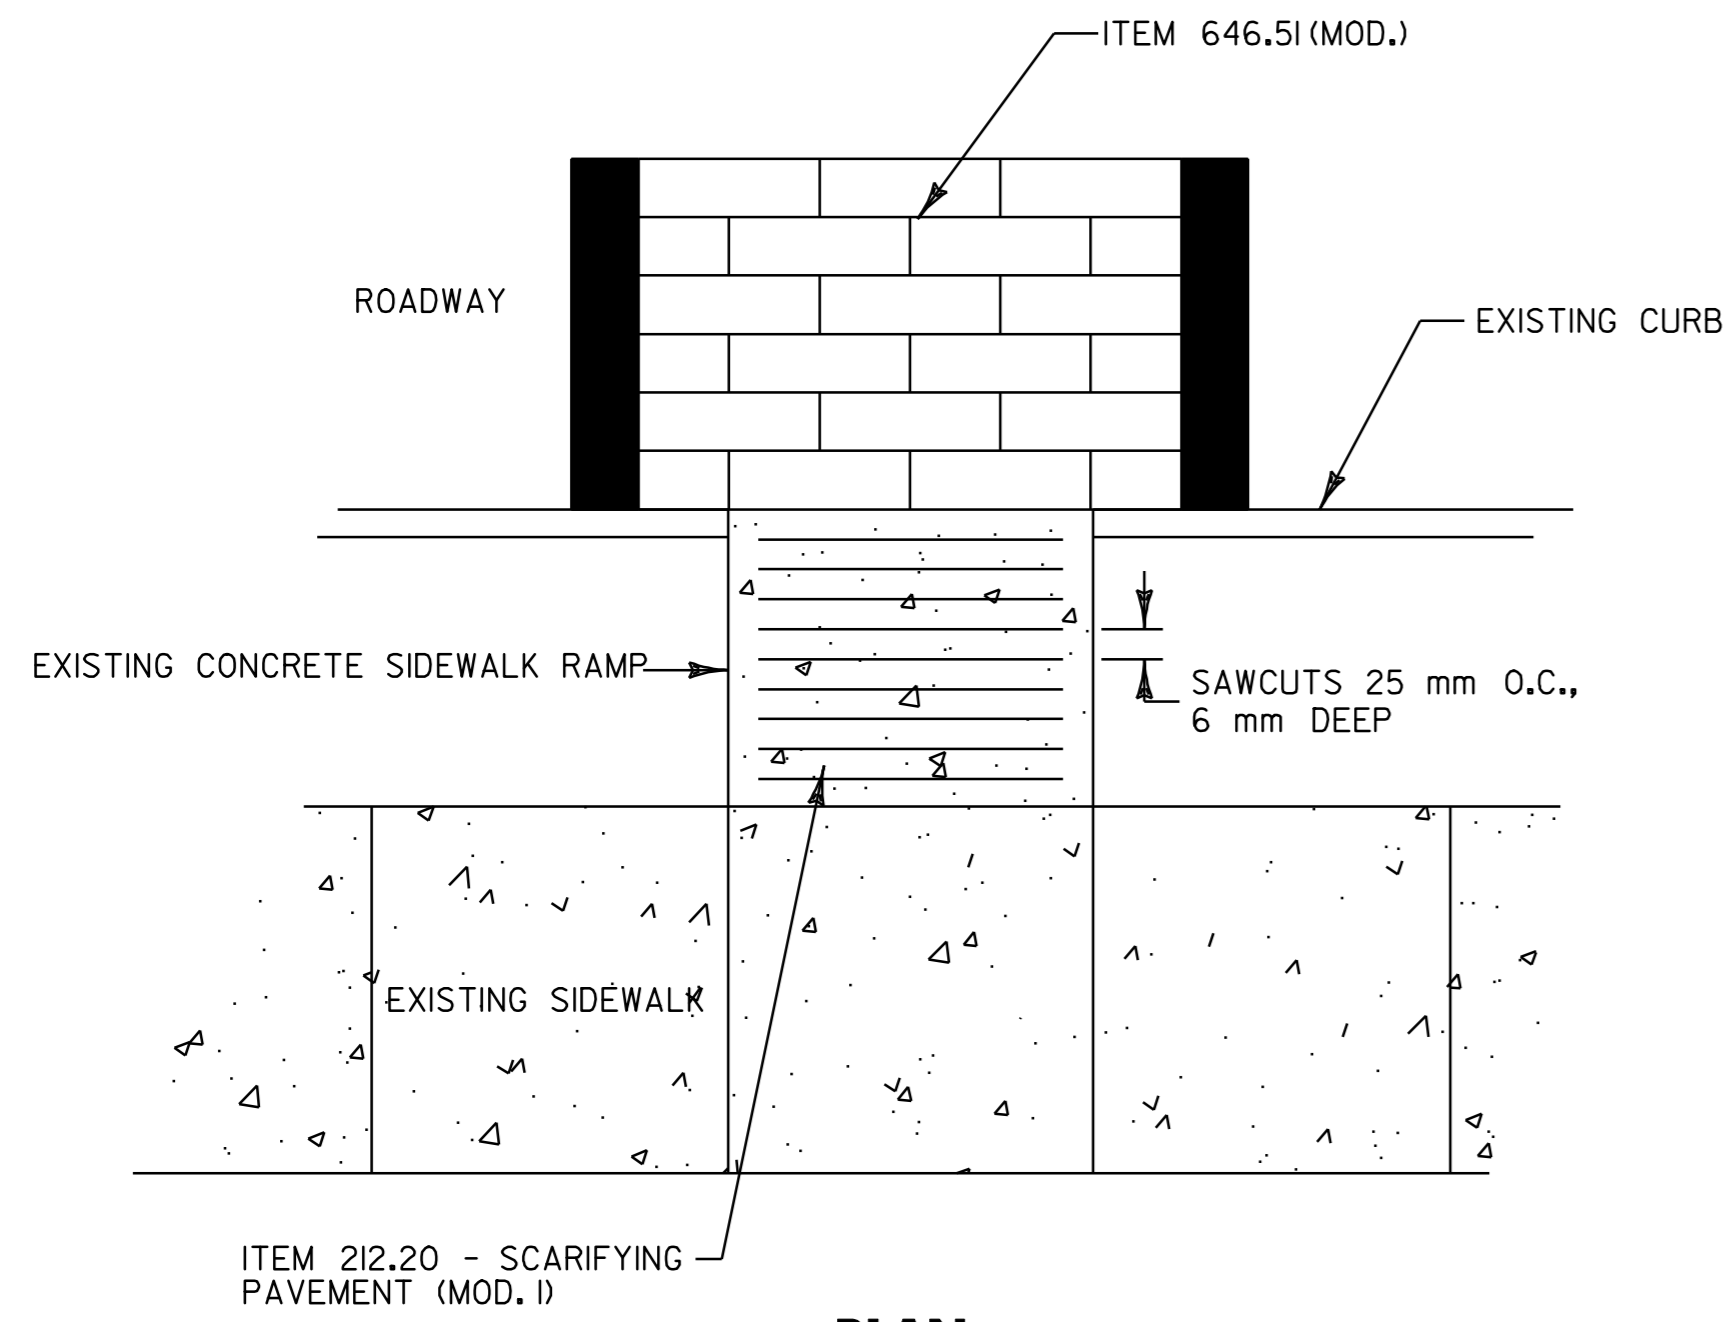

SIDEWALK RAMP TEXTURING DETAIL
NOT TO SCALE

PLAN VIEW
NOT TO SCALE


CONCRETE TEXTURING LOCATIONS

BITUMINOUS TEXTURING LOCATIONS

- U.S. ROUTE 7 STA. 0+225.5, LT.
- U.S. ROUTE 7 STA. 0+258.0, LT.
- U.S. ROUTE 7 STA. 1+101.0, LT.
- U.S. ROUTE 7 STA. 1+109.0, LT.
- U.S. ROUTE 7 STA. 1+227.5, RT.
- U.S. ROUTE 7 STA. 1+278.0, LT.
- U.S. ROUTE 7 STA. 1+524.3, LT.
- U.S. ROUTE 7 STA. 1+539.8, LT.
- U.S. ROUTE 7 STA. 1+545.0, LT.
- U.S. ROUTE 7 STA. 1+804.5, LT.
- U.S. ROUTE 7 STA. 1+822.5, LT.
- U.S. ROUTE 7 STA. 1+992.0, LT.
- U.S. ROUTE 7 STA. 2+008.0, LT.
- U.S. ROUTE 7 STA. 2+144.6, LT.
- U.S. ROUTE 7 STA. 2+146.6, LT.
- U.S. ROUTE 7 STA. 2+161.8, LT.
- U.S. ROUTE 7 STA. 2+189.7, LT.
- U.S. ROUTE 7 STA. 2+206.0, LT.
- U.S. ROUTE 7 STA. 2+216.0, LT.
- U.S. ROUTE 7 STA. 2+293.0, RT.
- U.S. ROUTE 7 STA. 2+302.9, RT.
- U.S. ROUTE 7 STA. 2+305.9, RT.
- U.S. ROUTE 7 STA. 2+313.0, LT.
- U.S. ROUTE 7 STA. 2+379.0, LT.
- U.S. ROUTE 7 STA. 2+386.5, LT.
- U.S. ROUTE 7 STA. 2+486.0, LT. & RT.
- U.S. ROUTE 7 STA. 2+626.7, RT.
- U.S. ROUTE 7 STA. 2+896.0, LT.
- U.S. ROUTE 7 STA. 3+034.0, RT.
- VT ROUTE 36 STA. 1+406.0, RT.
- VT ROUTE 36 STA. 1+413.0, RT.
- VT ROUTE 36 STA. 1+498.9, RT.
- VT ROUTE 36 STA. 1+511.3, RT.
- VT ROUTE 36 STA. 1+594.0, LT.
- VT ROUTE 36 STA. 1+661.0, LT.
- VT ROUTE 36 STA. 1+782.0, LT.
- VT ROUTE 36 STA. 2+048.0, RT.

NOTE: THE METHOD SHOWN IN THE PERMANENT CROSSWALK MARKING DETAIL ON THIS SHEET, WILL BE USED AT THE FOLLOWING LOCATIONS. PAID FOR AS ITEM 212.20 (MOD. 2)

- U.S. ROUTE 7 STA. 2+177.4, RT.
- U.S. ROUTE 7 STA. 2+633.8, RT.
- VT ROUTE 36 STA. 1+409.0, LT.
- VT ROUTE 36 STA. 1+417.0, LT.

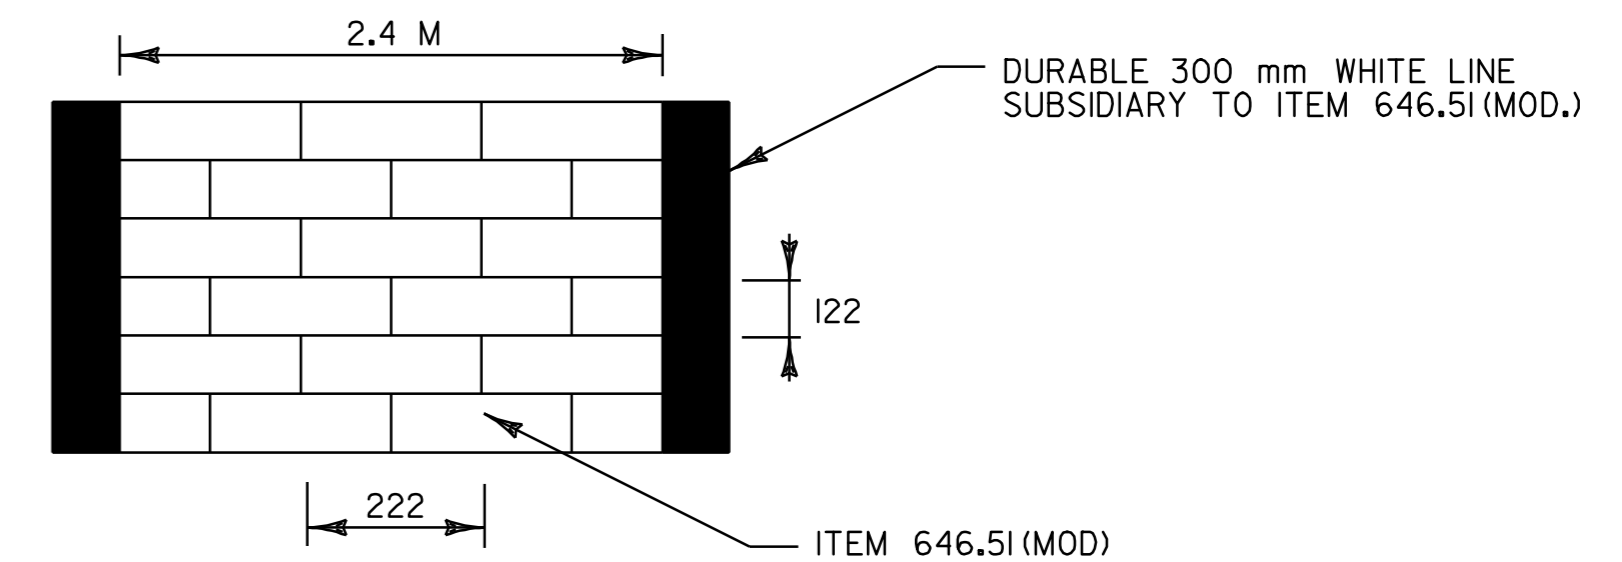

PERMANENT CROSSWALK MARKING DETAIL


SEE LAYOUT SHEETS FOR LOCATIONS
FOR ADDITIONAL DETAILS, SEE THE SPECIAL PROVISIONS

NOTES: 1) ALL DIMENSIONS IN MILLIMETERS EXCEPT WHERE OTHERWISE INDICATED.

SIDEWALK RAMP TEXTURING & CROSSWALK DETAILS


PROJECT NAME: SI, ALBANS CITY/ST, ALBANS CITY-ST, ALBANS...	PLOT DATE: 01-FEB-2006 07:4
PROJECT NUMBER: SIP_9804(I)S, SIP_2129(I)S, SIP_2204(I)S	DRAWN BY: D-H
FILE NAME: Zpqve297d150Zpd150.dgn	CHECKED BY:
DESIGNED BY: D-H	SHEET 7 OF 105
IPARM FILE NAME: pd150cd1.i	



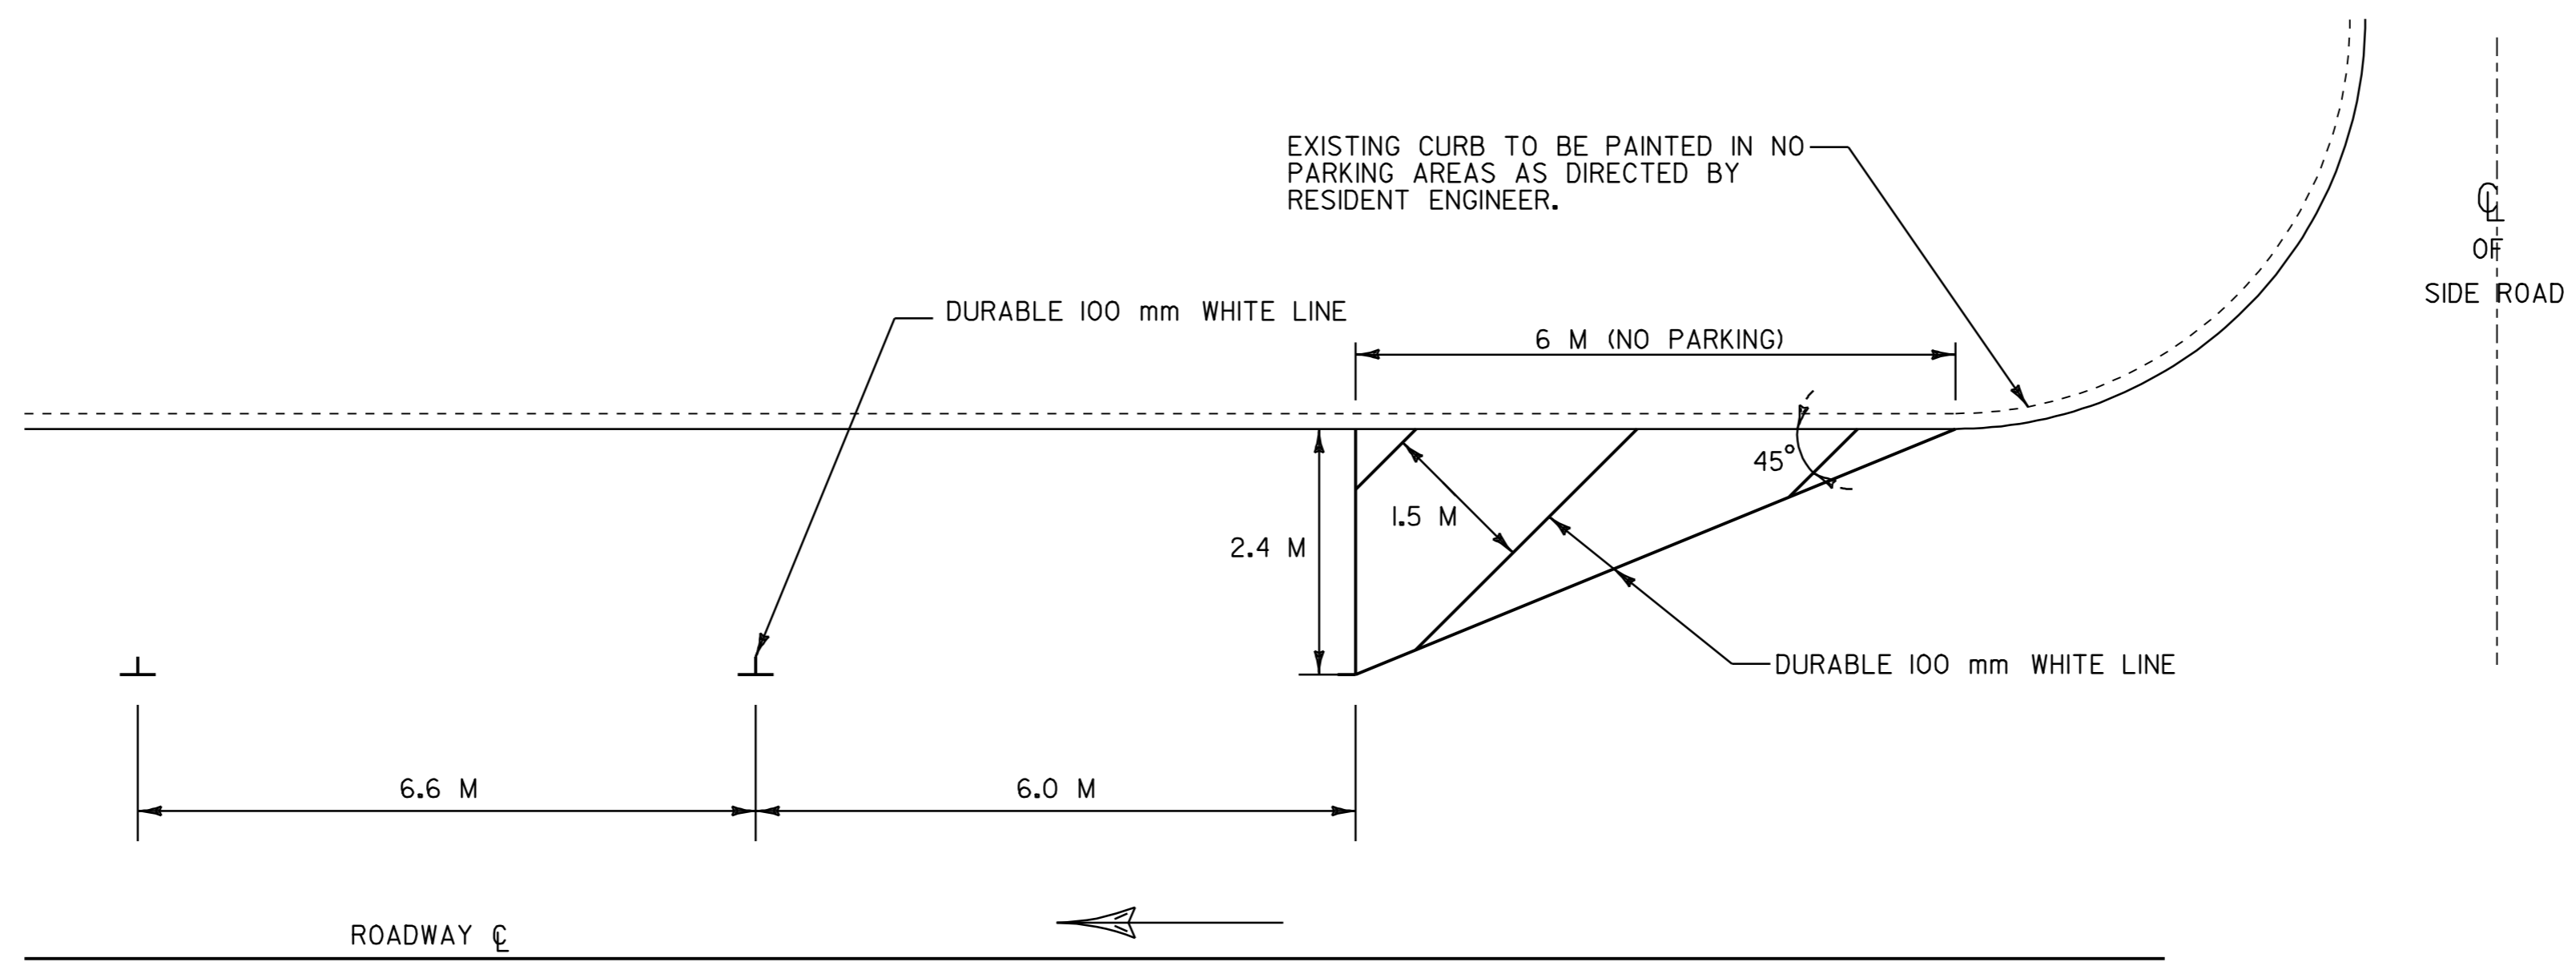

PARALLEL PARKING DETAIL

- NOTES:
- NOT TO SCALE
- 1) ALL EXTERNAL PARKING SPACES ARE 6.0 M UNLESS OTHERWISE NOTED, & ALL INTERNAL PARKING SPACES ARE 6.6 M UNLESS OTHERWISE NOTED.
 - 2) FOR ACTUAL LOCATIONS, SEE LAYOUT SHEETS.
 - 3) FOR HANDICAP SYMBOL LAYOUT, SEE VTrans STANDARD E-191M.

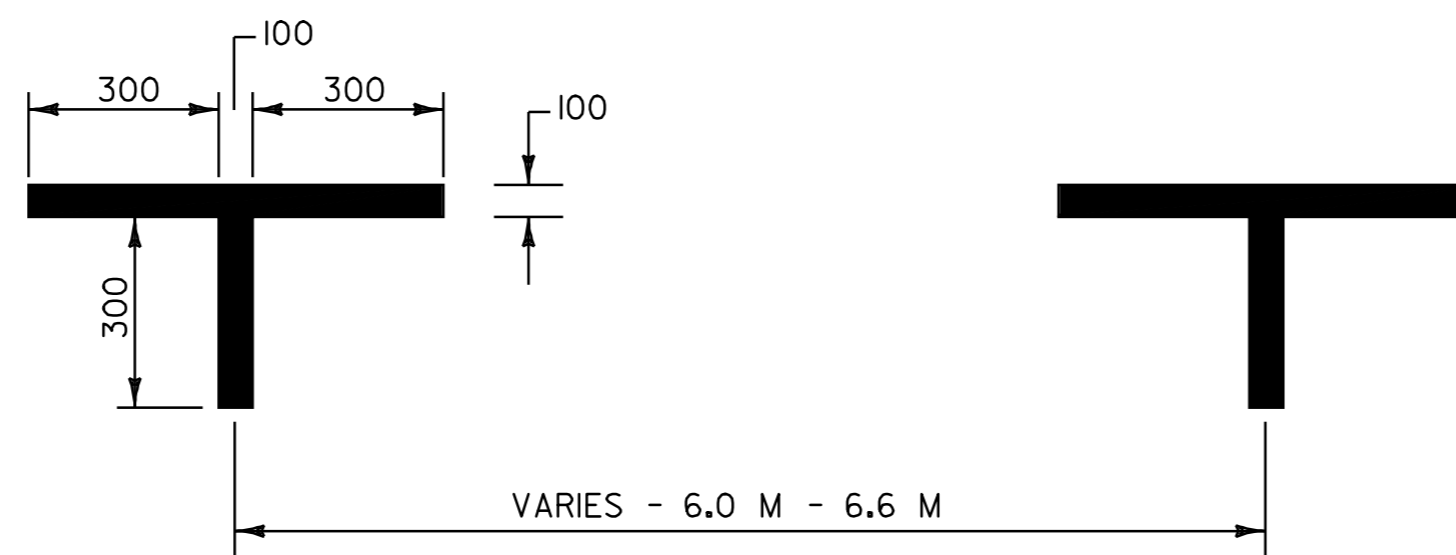

PARKING SPACE DETAIL


NOT TO SCALE

NOTES: 1) ALL DIMENSIONS IN MILLIMETERS EXCEPT WHERE OTHERWISE INDICATED.

PAVEMENT MARKING DETAILS

PROJECT NAME:	ST. ALBANS CITY	PLOT DATE:	01-FEB-2006 07:4
PROJECT NUMBER:	SIP_9804(I)S, SIP_2129(I)S	DRAWN BY:	D-H
FILE NAME:	zpqve297d150zpd150.dgn	CHECKED BY:	
DESIGNED BY:	D-H	SHEET	8 OF 105
IPARM FILE NAME:	pd150cd2.1		

U.S. ROUTE 7 / WELDEN STREET INTERSECTION

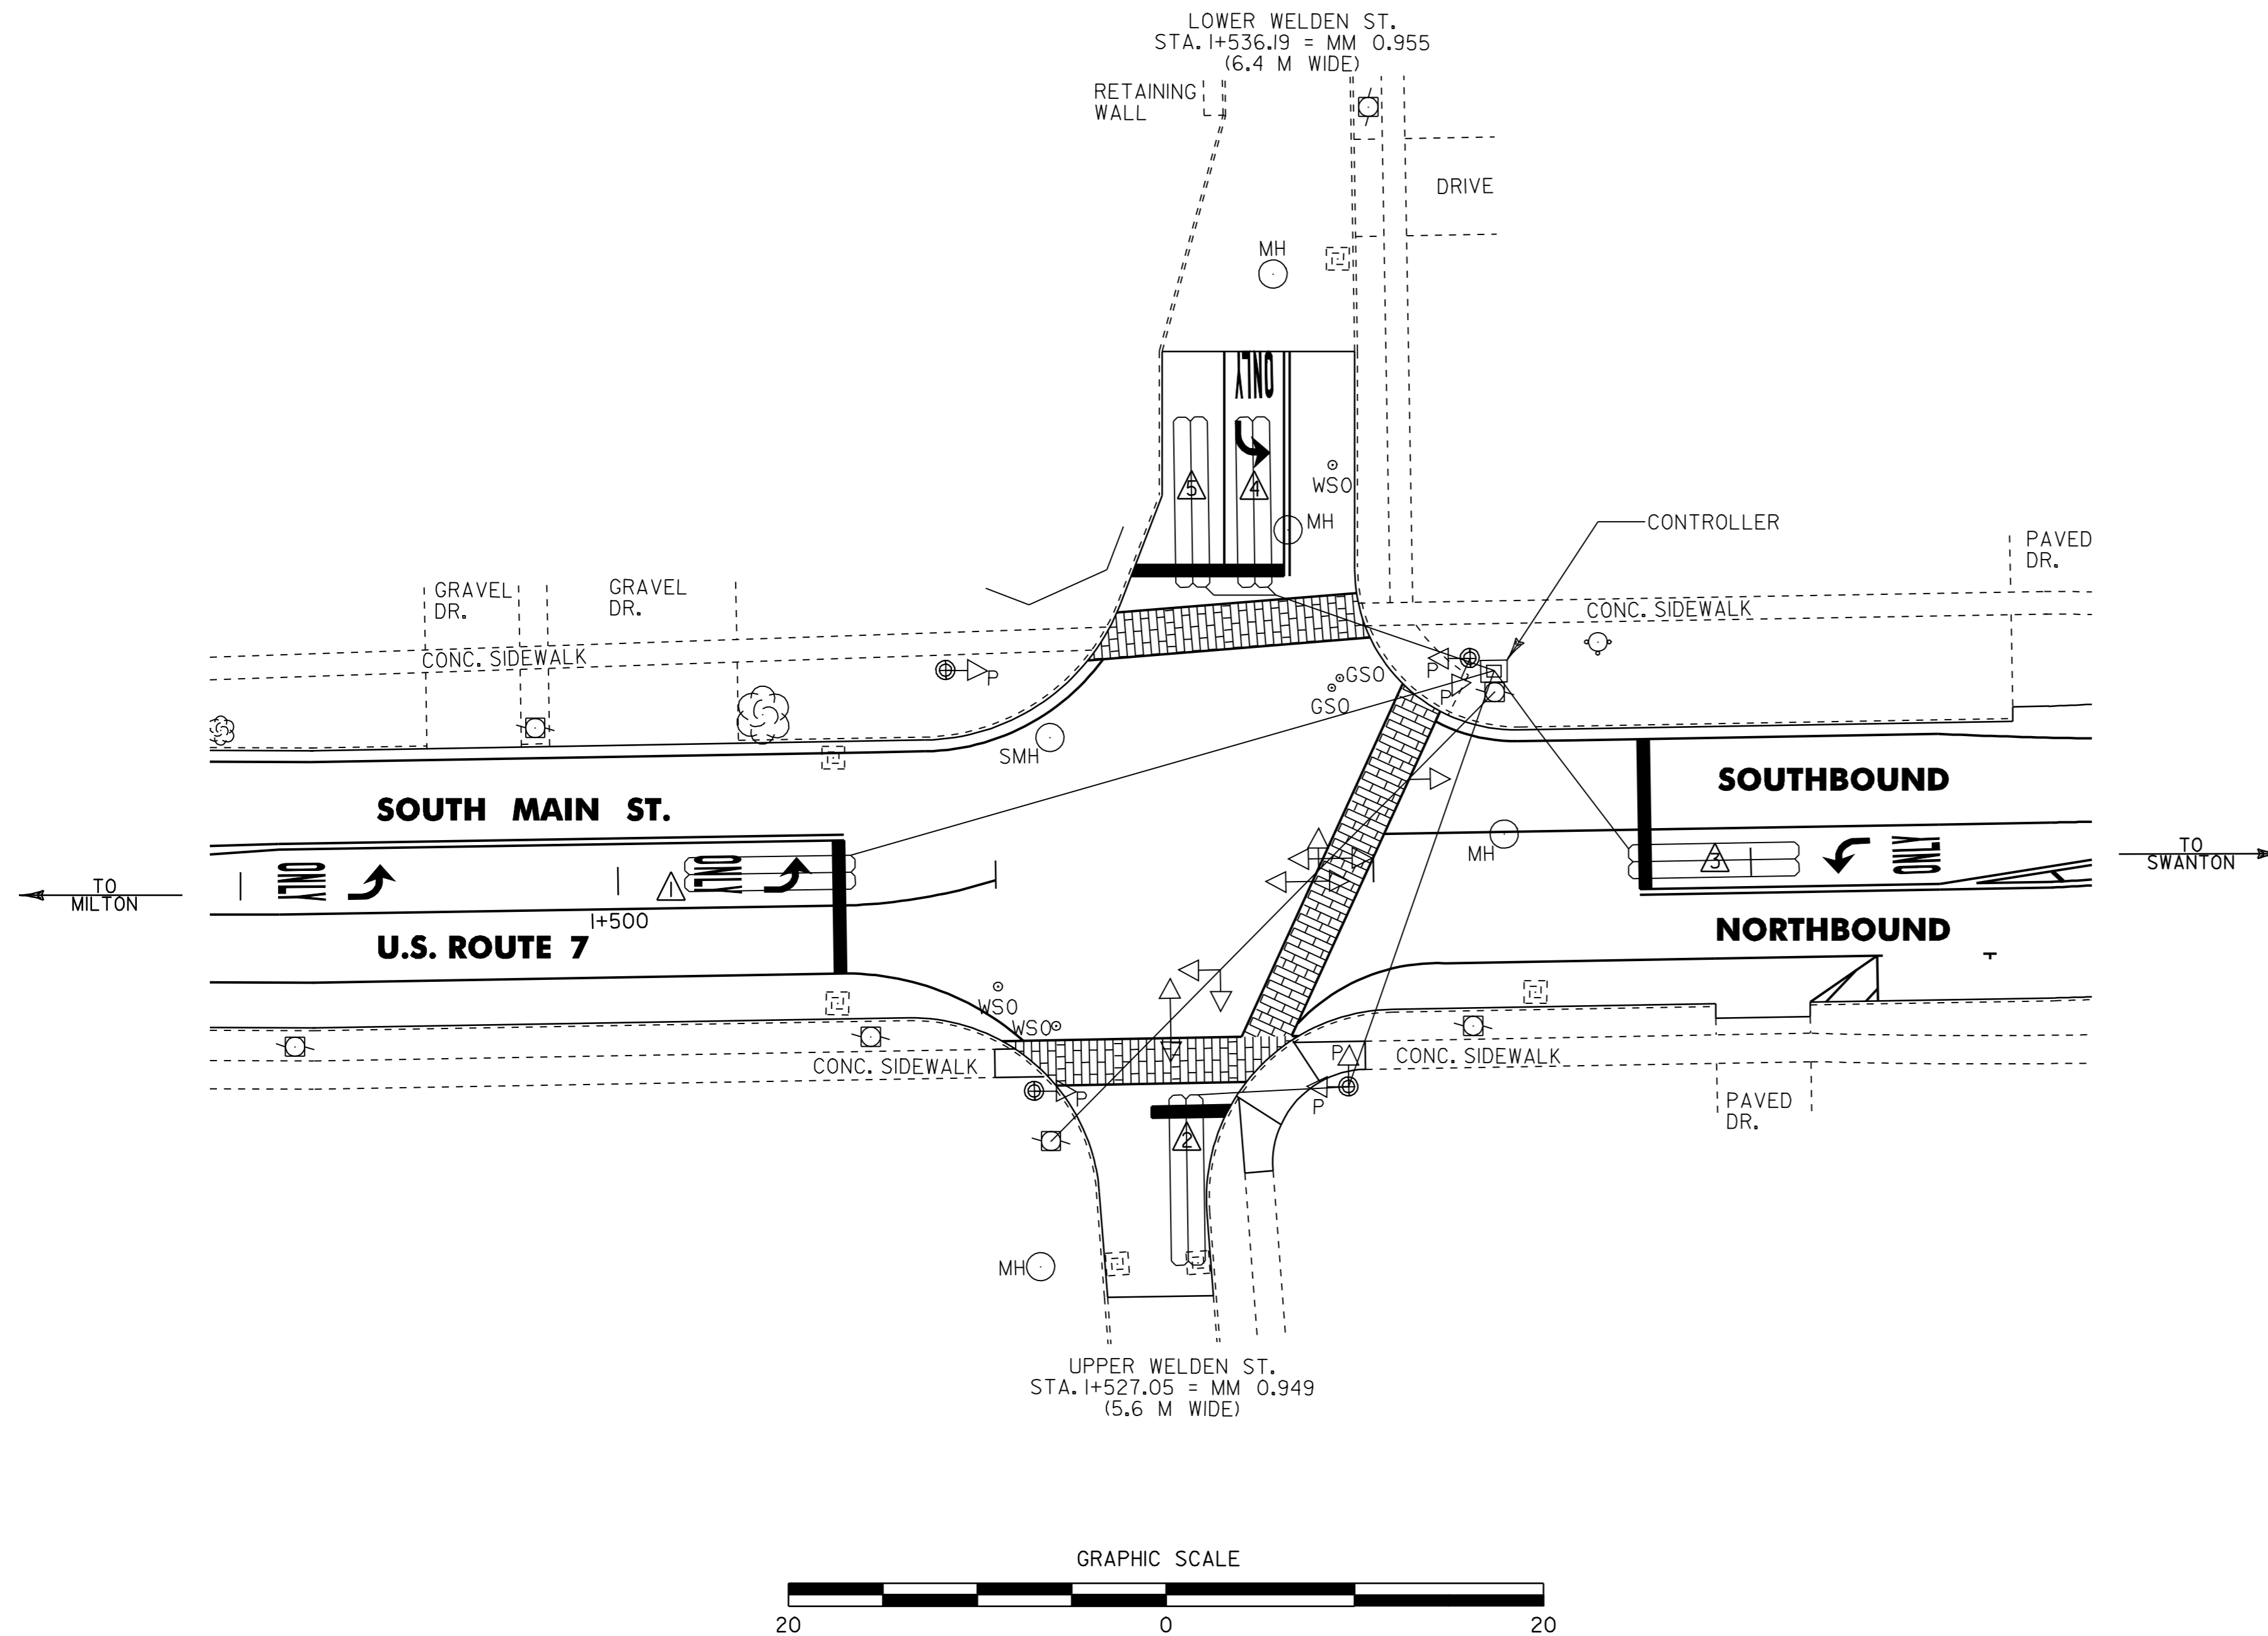

NOTES:

PRIOR TO COLD PLANING, ANY EXISTING VEHICLE DETECTOR LOOPS SHALL BE DISCONNECTED IN THE CONTROLLER CABINET AND CUT AT THE CURB.

ONCE A LOOP IS DISCONNECTED, THE SIGNAL PHASE THAT IT WAS CALLING SHALL BE PUT ON MAX RECALL OR THE SIGNAL PUT ON FLASH AND TRAFFIC CONTROLLED BY A UNIFORMED TRAFFIC OFFICER.

ALL BITUMINOUS AREAS TO RECEIVE NEW VEHICLE DETECTOR LOOPS SHALL BE LEVELED WITH TYPE IV BITUMINOUS CONCRETE PAVEMENT AS DIRECTED BY THE RESIDENT ENGINEER PRIOR TO THE INSTALLATION OF THE NEW DETECTOR LOOPS. LOOPS SHALL BE INSTALLED PRIOR TO THE PLACEMENT OF THE WEARING COURSE.

IF WATER VALVES, DROP INLETS OR OTHER OBSTRUCTIONS ARE ENCOUNTERED WITHIN THE AREA OF A PROPOSED LOOP, THE CONTRACTOR SHALL TAKE SPECIAL CARE TO AVOID THE OBSTRUCTION DURING LOOP INSTALLATION. IF LOOP SIZES OR SHAPES ARE TO BE MODIFIED DUE TO OBSTRUCTIONS THE RESIDENT ENGINEER MUST APPROVE LAYOUT PRIOR TO INSTALLATION.

AFTER THE NEW LOOPS ARE INSTALLED, THE INDUCTANCE RESISTANCE AND LEAKAGE TO GROUND SHALL BE TESTED USING PROPERLY CALIBRATED EQUIPMENT. THE TEST RESULTS SHALL BE COMPARED WITH THE CALCULATED VALUES AND RECORDED ON THE PLANS. ALL LOAD TESTING SHALL BE PERFORMED AS PER VTrans STANDARD E-172M.

CALCULATED VALUES AT CONTROLLER ARE BASED ON DIRECT CONDUIT ROUTING TO THE NEAREST SIGNAL POLE AND CROSSING THE SPAN WIRE OR EXISTING CONDUIT AS NECESSARY TO THE EXISTING CONTROLLER LOCATION. ANY SIGNAL MODIFICATION AND OR CONTROLLER RELOCATION PRIOR TO LOOP CONNECTION WILL REQUIRE RECALCULATION OF THESE VALUES.

AFTER ACCEPTANCE OF THE LOOP INSTALLATION BY THE RESIDENT ENGINEER, RETURN THE SIGNAL TO NORMAL OPERATION. ALL WORK REQUIRED SHALL BE SUBSIDIARY TO ITEM 678.22, VEHICLE DETECTOR LOOP.

FOR ADDITIONAL DETAILS, SEE VTrans STANDARD E-172M.

ALL DIMENSIONS IN MILLIMETERS EXCEPT WHERE OTHERWISE INDICATED.

EXISTING	NEW	LEGEND
		UTILITY POLE
		LUMINAIRE
		LIGHT OR WOOD POLE
		STRAIN POLE
		CONTROLLER CABINET
		PULLBOX/JUNCTION BOX
		SIGNAL HEAD
		CONDUIT
		VEHICLE LOOPS
		PEDESTAL POST
		STANCHION
		SWEEP
		LOOP NUMBER



LAYOUT SHEET	LOOP NO.	LANE	CALL	SIZE (M)	TYPE & NO. TURNS	DELAY OR PRESENCE	INDUCTANCE (uH)		RESISTANCE (OHMS)		LEAKAGE TO GROUND (MEGOHMS)	LOCKING MEMORY
							CALC.	ACT.	CALC.	ACT.		
U.S. ROUTE 7 - 10	1	NORTHBOUND LEFT ONLY		1.8 X 9.0	QUAD - 2	PRESENCE	286		0.824			YES
U.S. ROUTE 7 - 10	2	UPPER WELDEN ST.		1.8 X 9.0	QUAD - 2	PRESENCE	284		0.803			NO
U.S. ROUTE 7 - 10	3	SOUTHBOUND LEFT ONLY		1.8 X 9.0	QUAD - 2	PRESENCE	266		0.569			YES
U.S. ROUTE 7 - 10	4	LOWER WELDEN ST. LEFT ONLY		1.8 X 9.0	QUAD - 2	PRESENCE	266		0.571			YES
U.S. ROUTE 7 - 10	5	LOWER WELDEN ST. RIGHT & THRU		1.8 X 9.0	QUAD - 2	PRESENCE	269		0.614			NO

VEHICLE DETECTOR LOOP LAYOUT DETAIL #1	PROJECT NAME: <u>ST. ALBANS CITY</u>	PLOT DATE: 01-FEB-2006 07:4
	PROJECT NUMBER: <u>SIP_9804(I)S</u>	DRAWN BY: <u>D-H</u>
	FILE NAME: <u>zpqve297d150zpd150.dgn</u>	CHECKED BY: _____
	PROJECT LEADER: <u>JLL</u>	SHEET <u>9</u> OF <u>105</u>
	DESIGNED BY: <u>D-H</u>	
	IPARM FILE NAME: <u>pd150cd3,1</u>	



U.S. ROUTE 7 / FAIRFIELD STREET / LAKE STREET INTERSECTION

~~WIRED CONDUIT~~
~~U.S. ROUTE 7 LOOP 6 TO JBI - 3.6 M~~
~~U.S. ROUTE 7 JBI TO JB2 - 34.8 M~~
~~U.S. ROUTE 7 LOOP 8 TO JB2 - 2.8 M~~
~~U.S. ROUTE 7 LOOP 8 TO JB2 - 1.6 M~~
~~U.S. ROUTE 7 LOOP 9 TO JB3 - 1.8 M~~
~~VT ROUTE 36 LOOP 13 TO JB4 - 3.0 M~~

JUNCTION BOX
 JBI - U.S. ROUTE 7 STA. 1+943.6, RT.
 JB2 - U.S. ROUTE 7 STA. 1+978.4, RT.
 JB3 - U.S. ROUTE 7 STA. 2+017.5, RT.
 JB4 - VT ROUTE 36 STA. 1+433.2, LT.
 412

CAST-IN-PLACE CEMENT CONCRETE CURB, TYPE B
 CURB ITEM FOR USE IN CONJUNCTION WITH WIRED CONDUIT
 INSTALLATION AS DIRECTED BY THE RESIDENT ENGINEER

REMOVAL OF EXISTING CURB
 CURB ITEM FOR USE IN CONJUNCTION WITH WIRED CONDUIT
 INSTALLATION AS DIRECTED BY THE RESIDENT ENGINEER

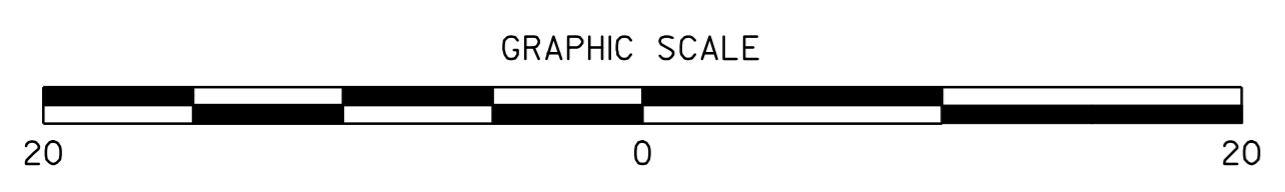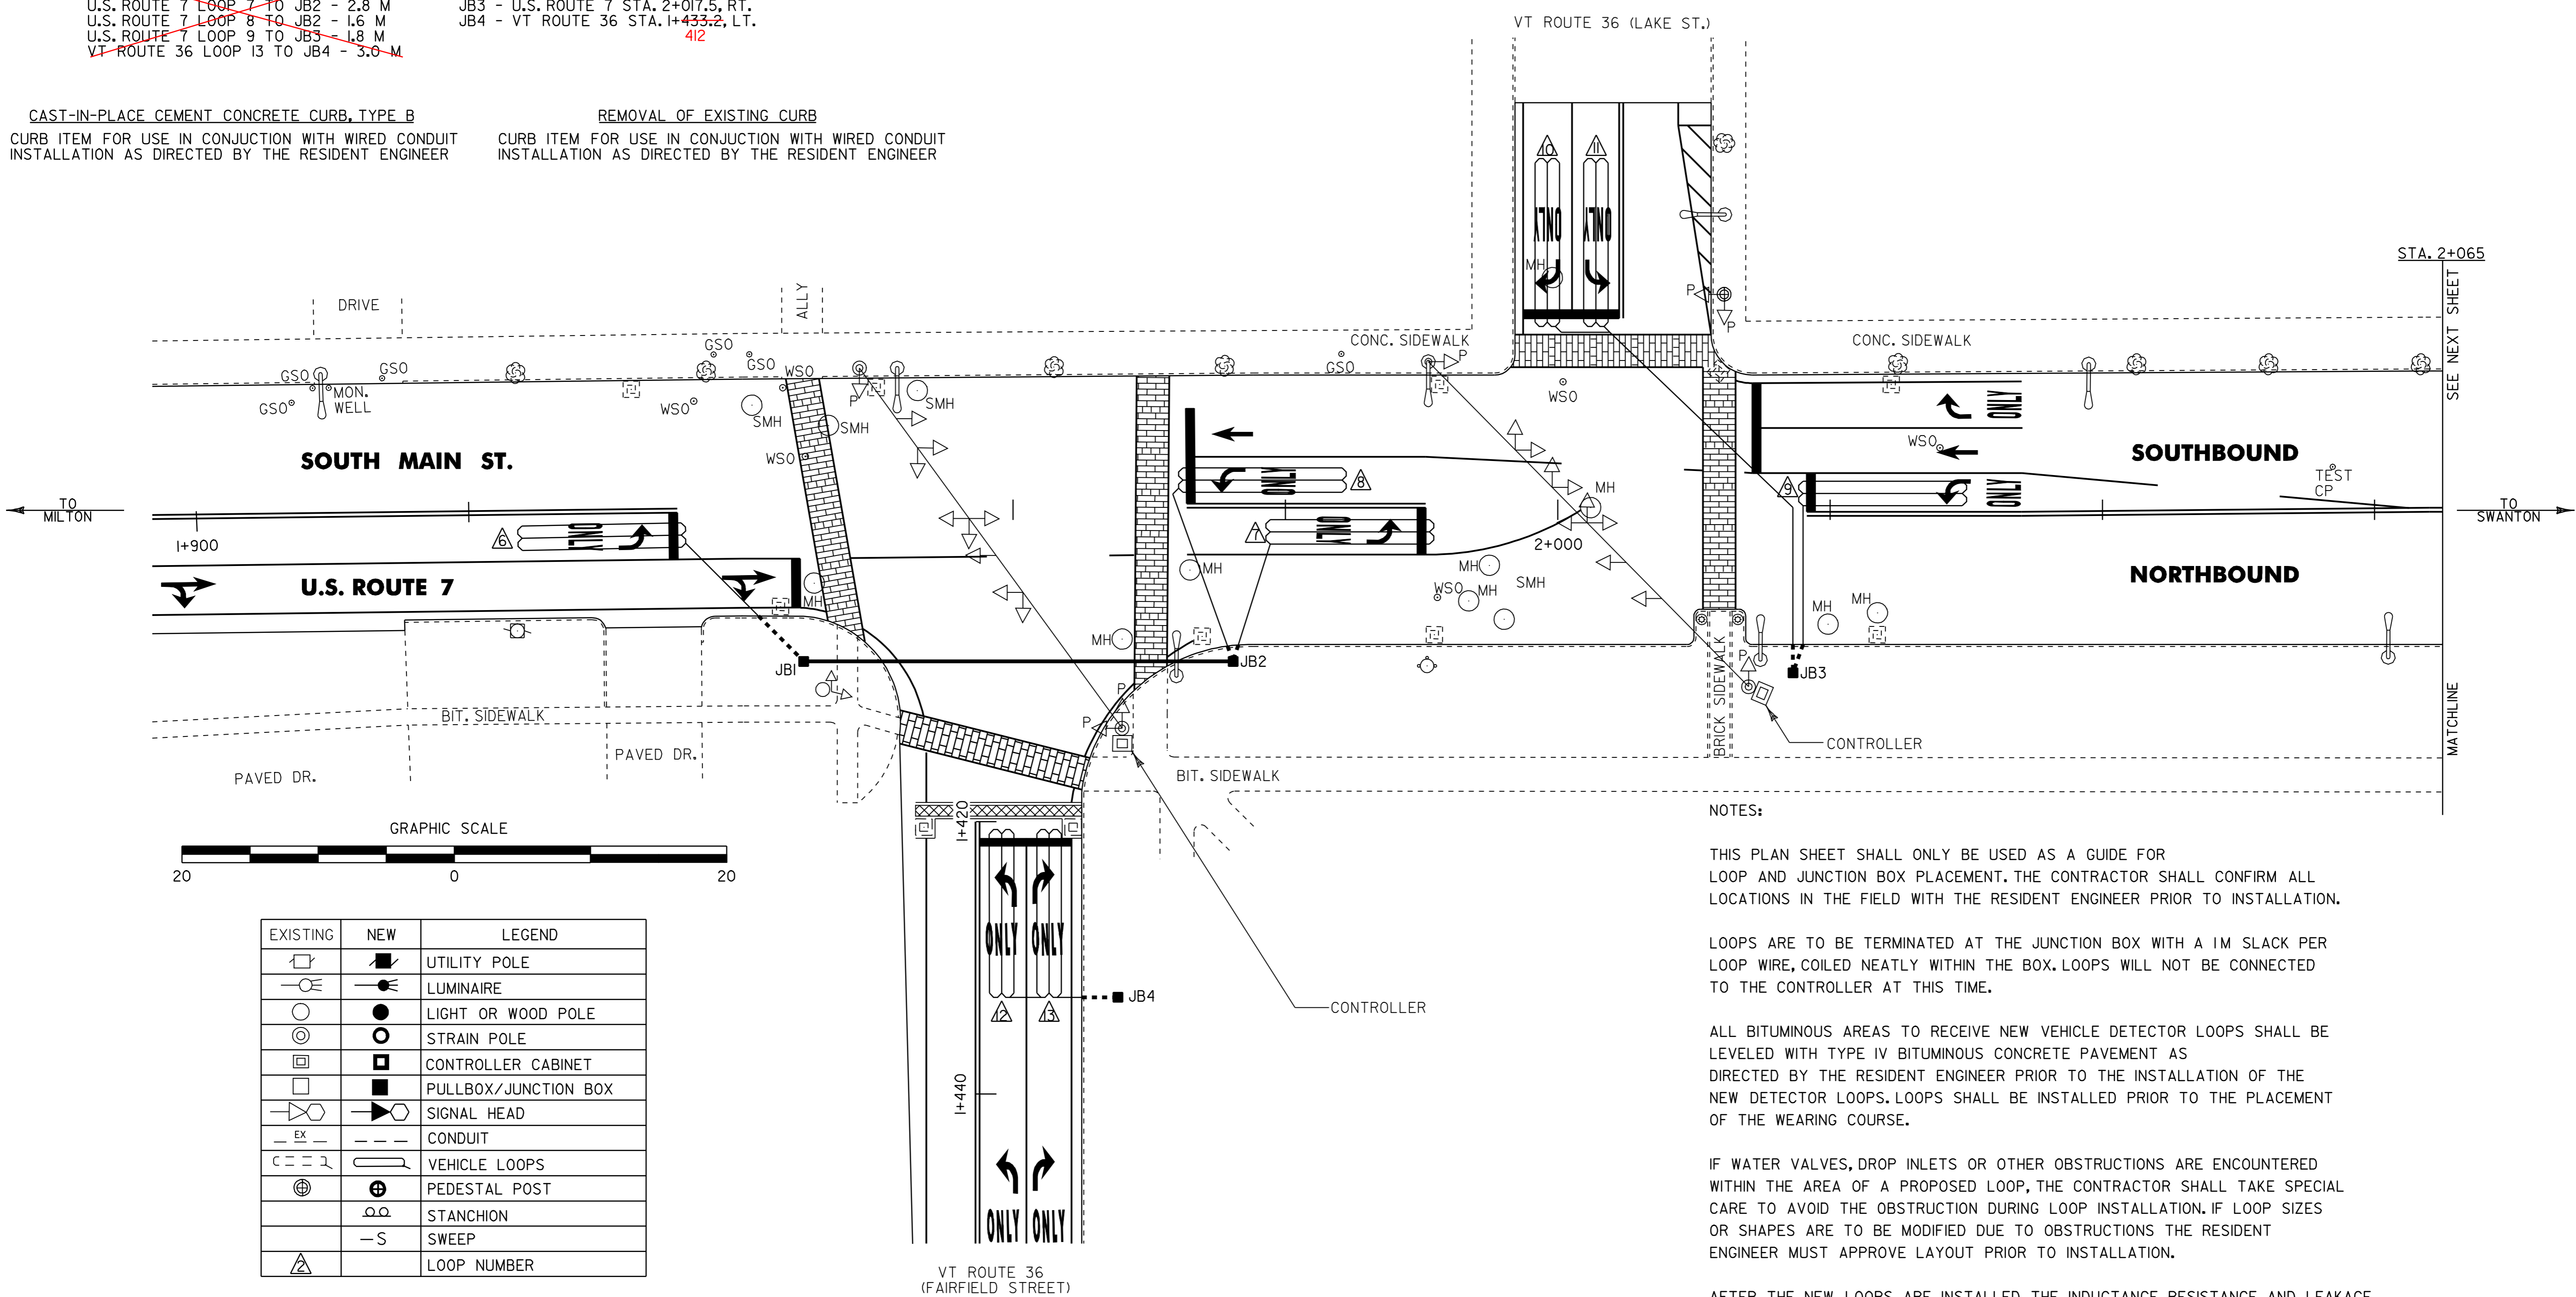

EXISTING	NEW	LEGEND
		UTILITY POLE
		LUMINAIRE
		LIGHT OR WOOD POLE
		STRAIN POLE
		CONTROLLER CABINET
		PULLBOX/JUNCTION BOX
		SIGNAL HEAD
		CONDUIT
		VEHICLE LOOPS
		PEDESTAL POST
		STANCHION
		SWEEP
		LOOP NUMBER

NOTES:

THIS PLAN SHEET SHALL ONLY BE USED AS A GUIDE FOR LOOP AND JUNCTION BOX PLACEMENT. THE CONTRACTOR SHALL CONFIRM ALL LOCATIONS IN THE FIELD WITH THE RESIDENT ENGINEER PRIOR TO INSTALLATION.

LOOPS ARE TO BE TERMINATED AT THE JUNCTION BOX WITH A 1M SLACK PER LOOP WIRE, COILED NEATLY WITHIN THE BOX. LOOPS WILL NOT BE CONNECTED TO THE CONTROLLER AT THIS TIME.

ALL BITUMINOUS AREAS TO RECEIVE NEW VEHICLE DETECTOR LOOPS SHALL BE LEVELED WITH TYPE IV BITUMINOUS CONCRETE PAVEMENT AS DIRECTED BY THE RESIDENT ENGINEER PRIOR TO THE INSTALLATION OF THE NEW DETECTOR LOOPS. LOOPS SHALL BE INSTALLED PRIOR TO THE PLACEMENT OF THE WEARING COURSE.

IF WATER VALVES, DROP INLETS OR OTHER OBSTRUCTIONS ARE ENCOUNTERED WITHIN THE AREA OF A PROPOSED LOOP, THE CONTRACTOR SHALL TAKE SPECIAL CARE TO AVOID THE OBSTRUCTION DURING LOOP INSTALLATION. IF LOOP SIZES OR SHAPES ARE TO BE MODIFIED DUE TO OBSTRUCTIONS THE RESIDENT ENGINEER MUST APPROVE LAYOUT PRIOR TO INSTALLATION.

AFTER THE NEW LOOPS ARE INSTALLED, THE INDUCTANCE RESISTANCE AND LEAKAGE TO GROUND SHALL BE TESTED USING PROPERLY CALIBRATED EQUIPMENT. THE TEST RESULTS SHALL BE COMPARED WITH THE CALCULATED VALUES AND RECORDED ON THE PLANS. ALL LOAD TESTING SHALL BE PERFORMED AS PER VTrans STANDARD E-172M.

CALCULATED VALUES AT THE JUNCTION BOXES ARE BASED ON DIRECT CONDUIT ROUTING AS SHOWN ON THIS SHEET. ANY JUNCTION BOX MODIFICATION AND/OR RELOCATION PRIOR TO LOOP CONNECTION WILL REQUIRE RECALCULATION OF THESE VALUES.

ALL WORK NOT COVERED BY ITEMS, 678.23 & 678.26 SHALL BE SUBSIDIARY TO ITEM 678.22, VEHICLE DETECTOR LOOP. FOR ADDITIONAL DETAILS SEE VTrans STANDARDS E-172M & E-173M.

ALL DIMENSIONS IN MILLIMETERS EXCEPT WHERE OTHERWISE INDICATED.

VEHICLE DETECTOR LOOPS												
LAYOUT SHEET	LOOP NO.	LANE	CALL Ø	SIZE (M)	TYPE & NO. TURNS	DELAY OR PRESENCE	INDUCTANCE (µH)		RESISTANCE (OHMS)		LEAKAGE TO GROUND (MEGOHMS)	LOCKING MEMORY
							CALC.	ACT.	CALC.	ACT.		
U.S. ROUTE 7 - 13	6	NORTHBOUND LEFT ONLY (U.S. ROUTE 7)		1.8 X 12.0	QUAD - 1	PRESENCE	145		0.799			YES
U.S. ROUTE 7 - 14	7	NORTHBOUND LEFT ONLY (U.S. ROUTE 7)		1.8 X 12.0	QUAD - 1	PRESENCE	112		0.382			YES
U.S. ROUTE 7 - 14	8	SOUTHBOUND LEFT ONLY (U.S. ROUTE 7)		1.8 X 12.0	QUAD - 1	PRESENCE	118		0.448			YES
U.S. ROUTE 7 - 14	9	SOUTHBOUND LEFT ONLY (U.S. ROUTE 7)		1.8 X 12.0	QUAD - 1	PRESENCE	115		0.414			YES
U.S. ROUTE 7 - 14	10	EASTBOUND RIGHT ONLY (LAKE STREET)		1.8 X 12.0	QUAD - 1	DELAYED	135		0.667			NO
U.S. ROUTE 7 - 14	11	EASTBOUND LEFT ONLY (LAKE STREET)		1.8 X 12.0	QUAD - 1	PRESENCE	132		0.627			YES
VT ROUTE 36 - 1	12	WESTBOUND LEFT ONLY (FAIRFIELD STREET)		1.8 X 12.0	QUAD - 1	PRESENCE	113		0.387			YES
VT ROUTE 36 - 1	13	WESTBOUND RIGHT ONLY (FAIRFIELD STREET)		1.8 X 12.0	QUAD - 1	DELAYED	110		0.346			NO

VEHICLE DETECTOR LOOP LAYOUT DETAIL #2	PROJECT NAME: ST. ALBANS CITY	PLOT DATE: 01-FEB-2006 07:4
	PROJECT NUMBER: STP_9804(1)S	DRAWN BY: D-H
	FILE NAME: Zpqve297d1502pd150.dgn	CHECKED BY:
	DESIGNED BY: D-H	SHEET 10 OF 105




STATE OF VERMONT AGENCY OF TRANSPORTATION



PROPOSED IMPROVEMENT CLASS I TOWN HIGHWAY CITY OF ST. ALBANS COUNTY OF FRANKLIN U.S. ROUTE 7

**PROJECT LOCATION
STP 9804(1)S**

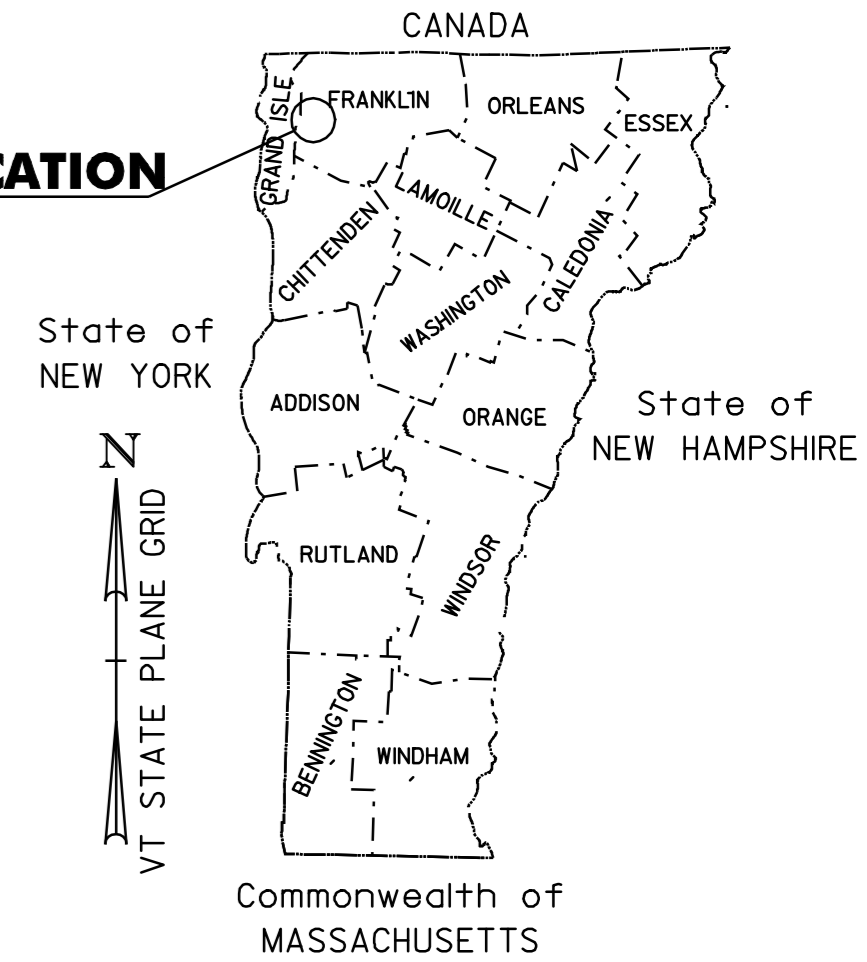

TRAFFIC DATA

U.S. ROUTE 7 (MM 0.000 TO MM 2.250)

LOCATION	ADT		DHV		ESALS
	2002	2012	2002	2012	2002-2012
MM 0.00 TO MM 0.55	9,100	10,800	1,100	1,200	1,303,000
MM 0.55 TO MM 1.25	14,600	17,500	1,500	1,800	1,811,000
MM 1.25 TO MM 1.80	16,400	19,500	1,600	2,000	1,654,000
MM 1.80 TO MM 2.25	17,800	21,300	1,800	2,100	1,817,000


BEGINNING AT THE ST. ALBANS CITY/ST. ALBANS TOWN TOWNLIN ON U.S. ROUTE 7 AT STA. 0+000.00 (MM 0.000) AND EXTENDING NORTHERLY ALONG ROUTE 7 FOR A DISTANCE OF 3640.40 M (2.262 MILES) TO STA. 3+640.40 (MM 2.262) IN THE CITY OF ST. ALBANS.

PROJECT DATA	LENGTH	LENGTH
CITY OF ST. ALBANS	(METERS)	(MILES)
ROUTE 7		
STA. 0+000.00 TO 3+640.40	3640.40	
MM 0.000 TO MM 2.262		2.262
TOTAL LENGTH OF PROJECT	3640.40	2.262
TOTAL LENGTH OF ROADWAY	3640.40	2.262

WORK TO BE PERFORMED UNDER THIS PROJECT INCLUDES COLD PLANING AND RESURFACING OF THE EXISTING HIGHWAY, NEW PAVEMENT MARKINGS AND INCIDENTAL ITEMS.

**BEGIN STP 9804(1)S
U.S. ROUTE 7 - MAIN STREET
ST. ALBANS CITY
STA. 0+000.00 (MM 0.000)**

**END STP 9804(1)S
U.S. ROUTE 7 - MAIN STREET
ST. ALBANS CITY
STA. 3+640.40 (MM 2.262)**

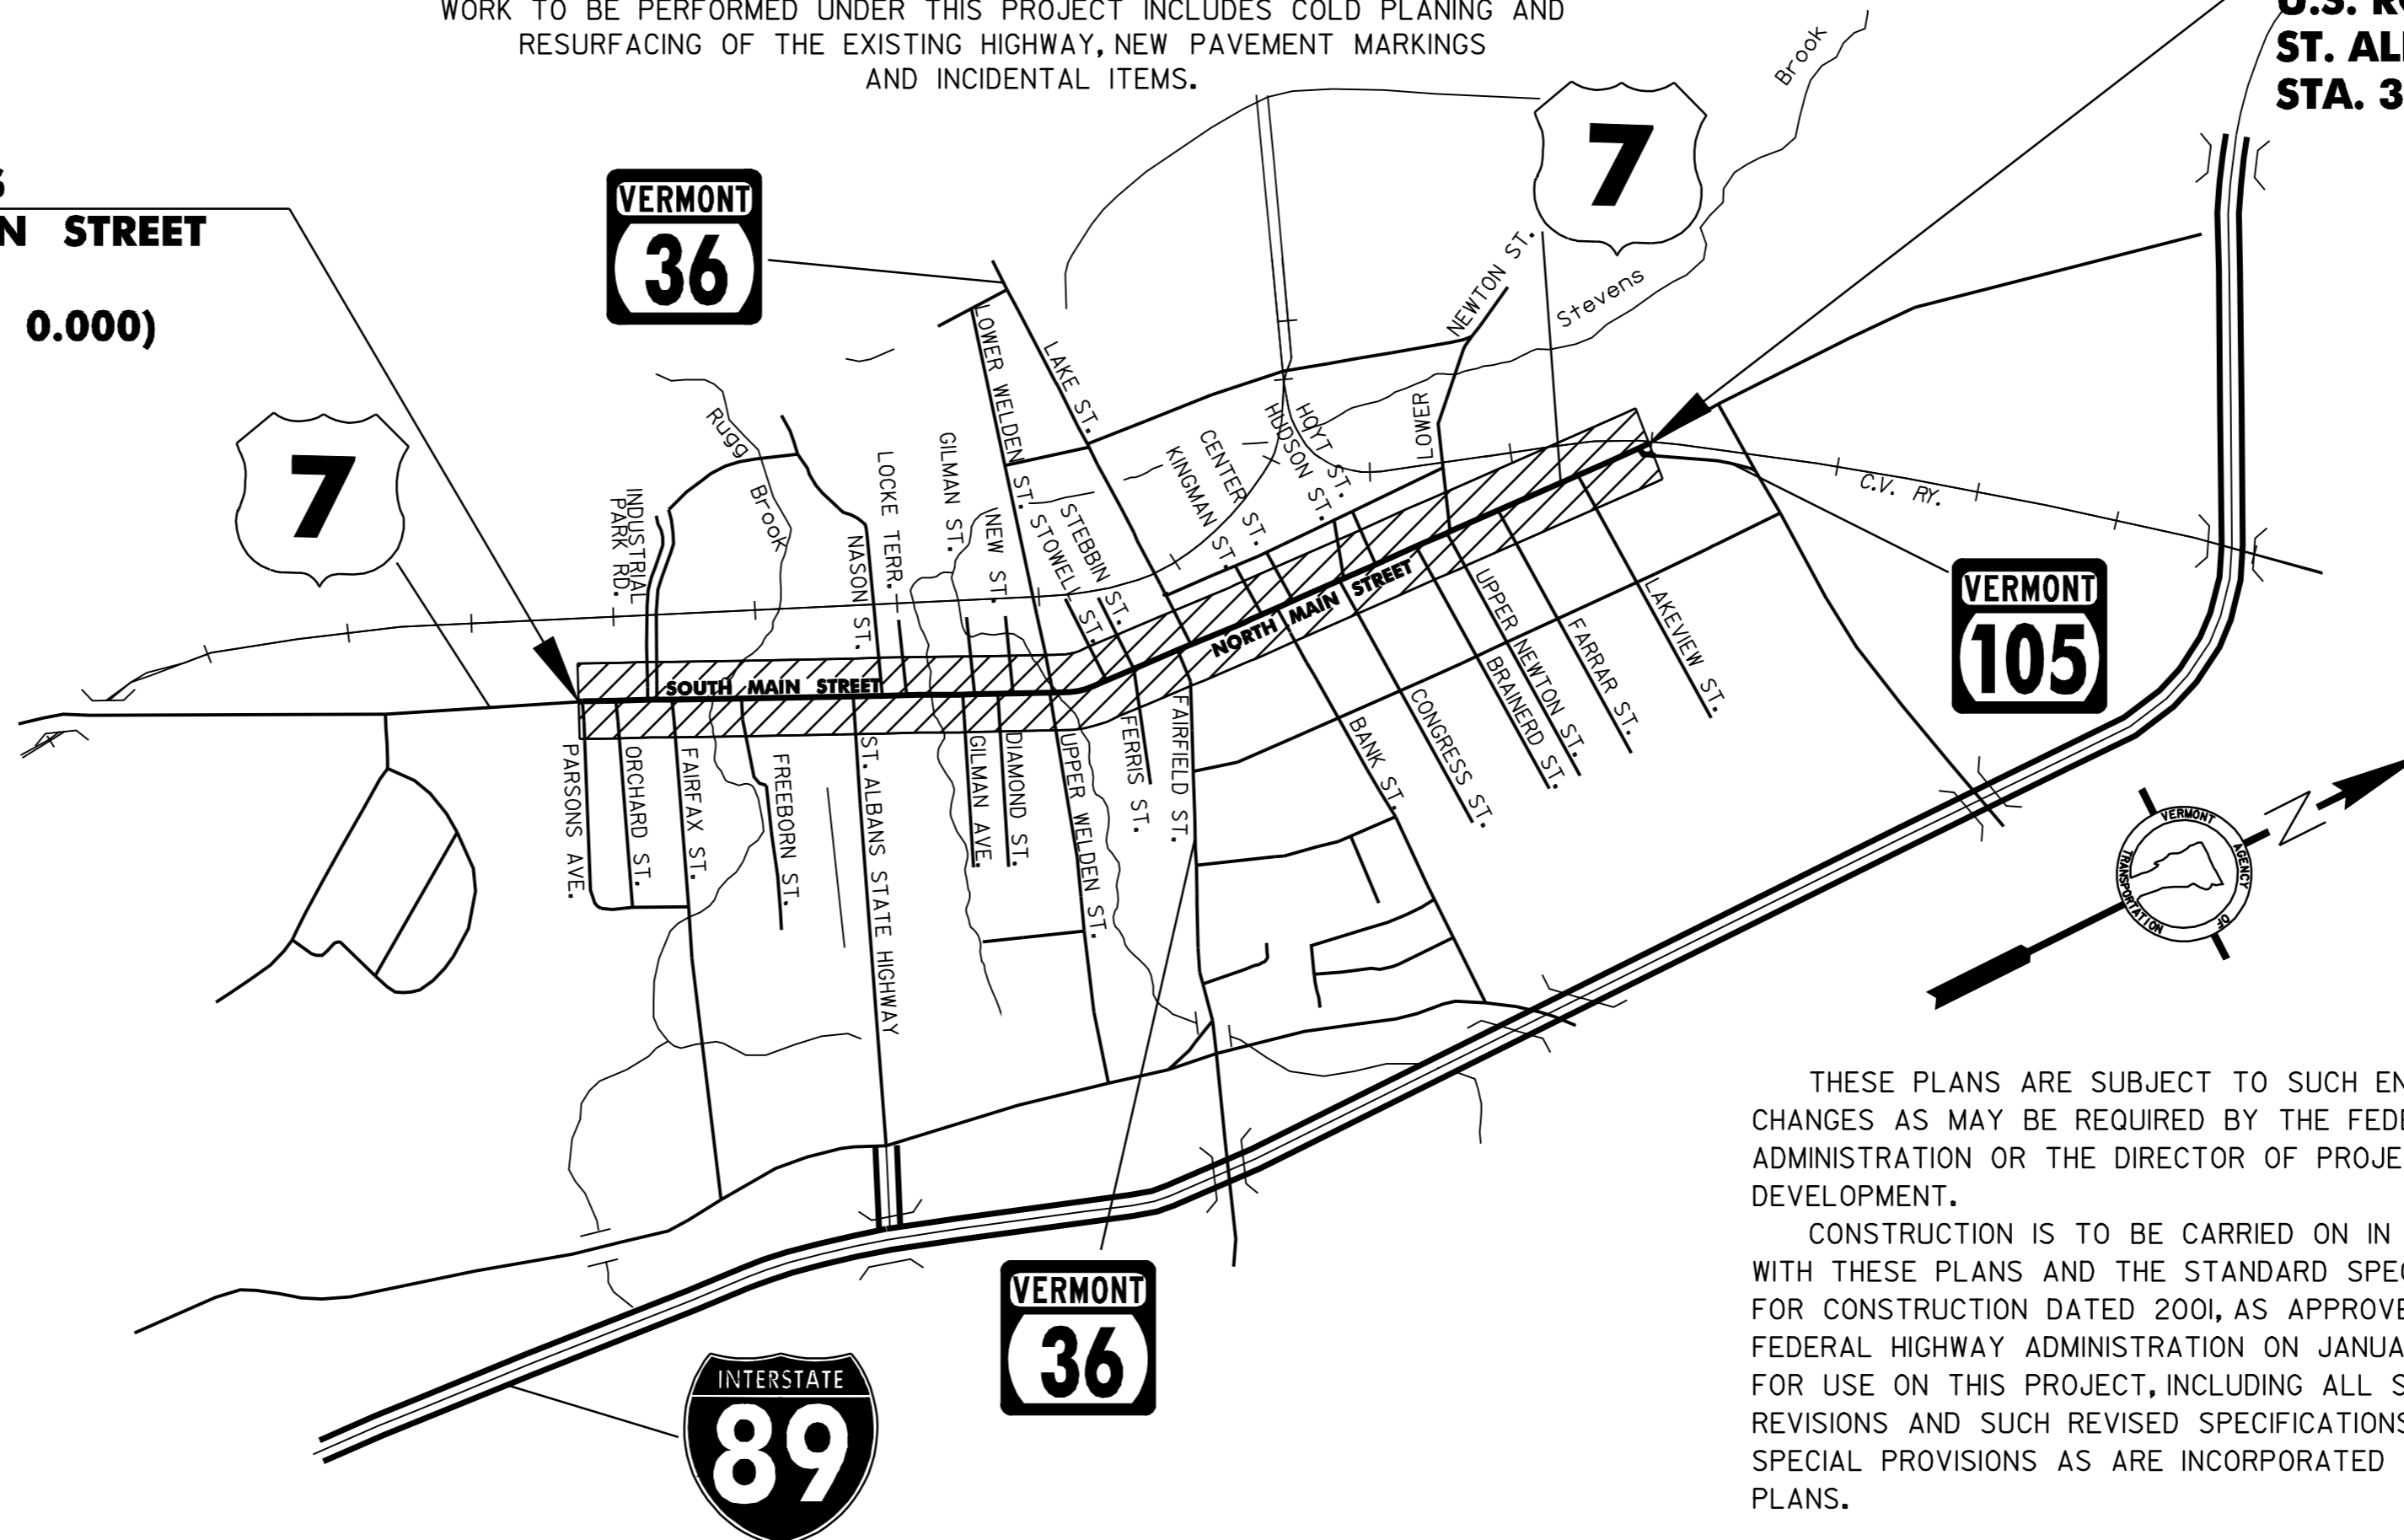

NOTE:

RIGHT-OF-WAY LIMITS, IF APPLICABLE, ARE PROVIDED SOLELY FOR THE CONVENIENCE OF THE STATE AND ITS CONTRACTOR DURING THE COURSE OF THIS PAVING PROJECT. ANY REFERENCES TO OFFSETS ON THESE PLANS ARE APPROXIMATE AND SHOULD NOT BE RELIED UPON FOR ANY PURPOSES.

UNLESS OTHERWISE NOTED, ALL DRAWINGS AND DETAILS ON THESE PLANS ARE DRAWN "NOT TO SCALE".



UNLESS NOTED OTHERWISE
STATIONS ARE IN KILOMETERS
ELEVATIONS ARE IN METERS
DIMENSIONS ARE IN MILLIMETERS

THESE PLANS ARE SUBJECT TO SUCH ENGINEERING CHANGES AS MAY BE REQUIRED BY THE FEDERAL HIGHWAY ADMINISTRATION OR THE DIRECTOR OF PROJECT DEVELOPMENT.

CONSTRUCTION IS TO BE CARRIED ON IN ACCORDANCE WITH THESE PLANS AND THE STANDARD SPECIFICATIONS FOR CONSTRUCTION DATED 2001, AS APPROVED BY THE FEDERAL HIGHWAY ADMINISTRATION ON JANUARY 4, 2001 FOR USE ON THIS PROJECT, INCLUDING ALL SUBSEQUENT REVISIONS AND SUCH REVISED SPECIFICATIONS AND SPECIAL PROVISIONS AS ARE INCORPORATED IN THESE PLANS.

DEPARTMENT OF TRANSPORTATION
FEDERAL HIGHWAY ADMINISTRATOR

APPROVED _____ DATE _____

DIRECTOR OF PROJECT DEVELOPMENT

APPROVED _____ DATE _____

PROJECT MANAGER :

PROJECT NAME : **ST. ALBANS CITY**

PROJECT NUMBER : **STP 9804(1)S**

SHEET 12 OF 105 SHEETS



CONVENTIONAL SYMBOLS


- UTILITY LEGEND**
- ⊕ = EXISTING HYDRANT
 - ⊖ = EXISTING DI
 - = EXISTING MANHOLE
 - TEL = EXISTING TELEPHONE MANHOLE
 - ELEC = EXISTING ELECTRIC MANHOLE
 - SMH = EXISTING SEWER MANHOLE
 - WSO = EXISTING WATER SHUTOFF
 - GSO = EXISTING GAS SHUTOFF
 - ♂ = EXISTING MAILBOX

- SIGN LEGEND**
- N = NEW
 - R = REMOVE
 - R&S = REMOVE & SALVAGE
 - S = SALVAGE SIGN
 - RET = RETAIN
 - B-B = BACK TO BACK
 - Ⓢ = RETURN TO CITY OF ST. ALBANS

SURVEYED BY : D-H
SURVEYED DATE : 06-07-00


DATUM
VERTICAL N/A
HORIZONTAL N/A

- COUNTY LINE
- TOWN LINE
- LIMITS OF ACCESS
- POINT OF ACCESS
- FENCE LINE
- STONE WALL
- TRAVELED WAY
- GUARD RAIL
- RAILROAD
- SURVEY LINE
- CULVERT
- POWER POLE
- TELEPHONE POLE
- TREES
- CONTROL OF ACCESS
- PROPERTY LINE
- R.O.W. TAKING LINE
- SLOPE RIGHTS
- TOP OF CUT
- TOE OF SLOPE

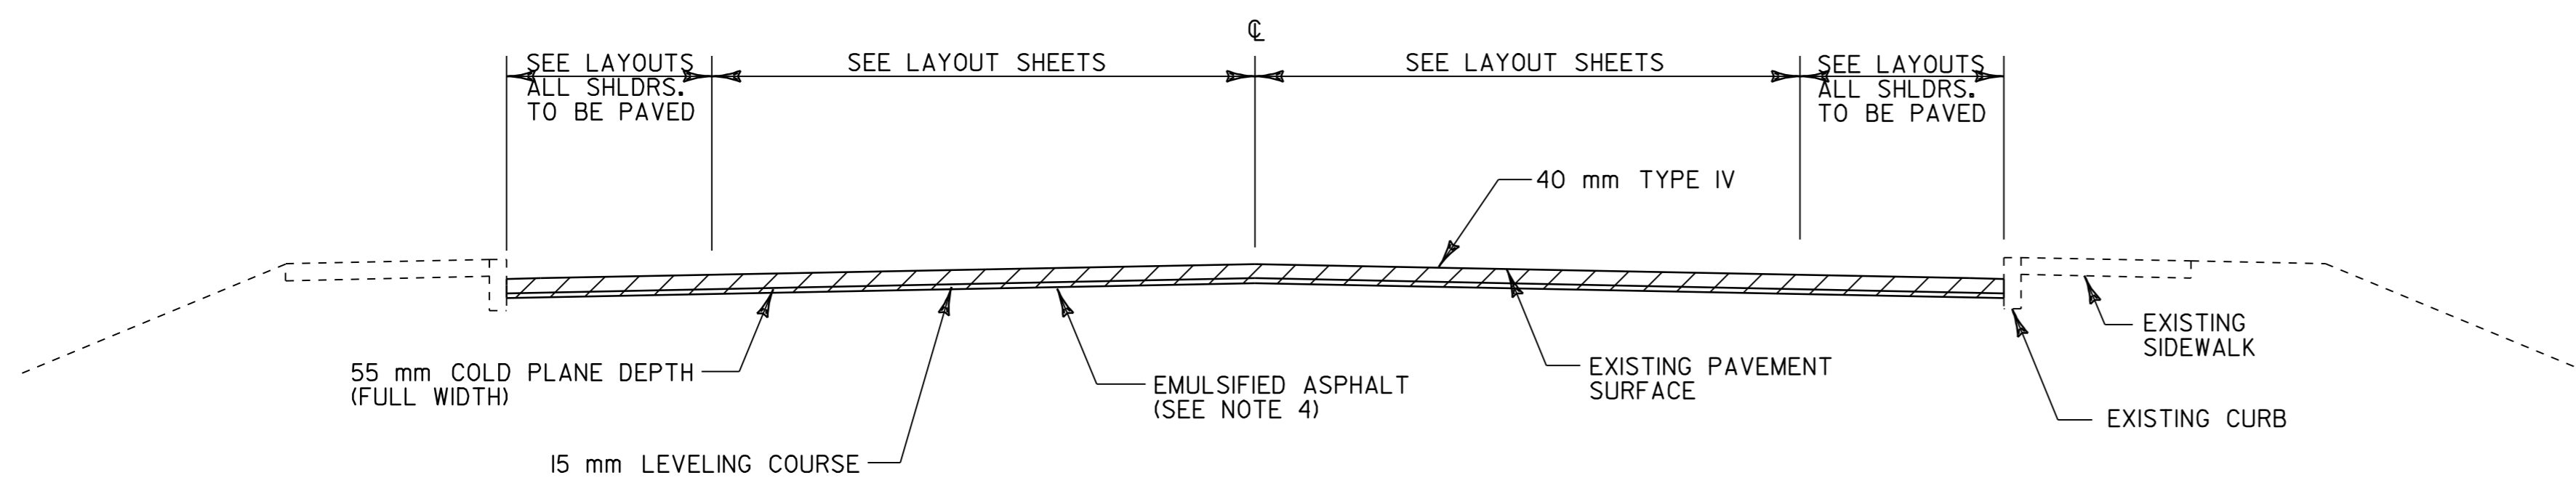


COLD PLANE TYPICAL SECTION - CURBED

U.S. ROUTE 7 STA. 0+000.00 TO 3+640.40

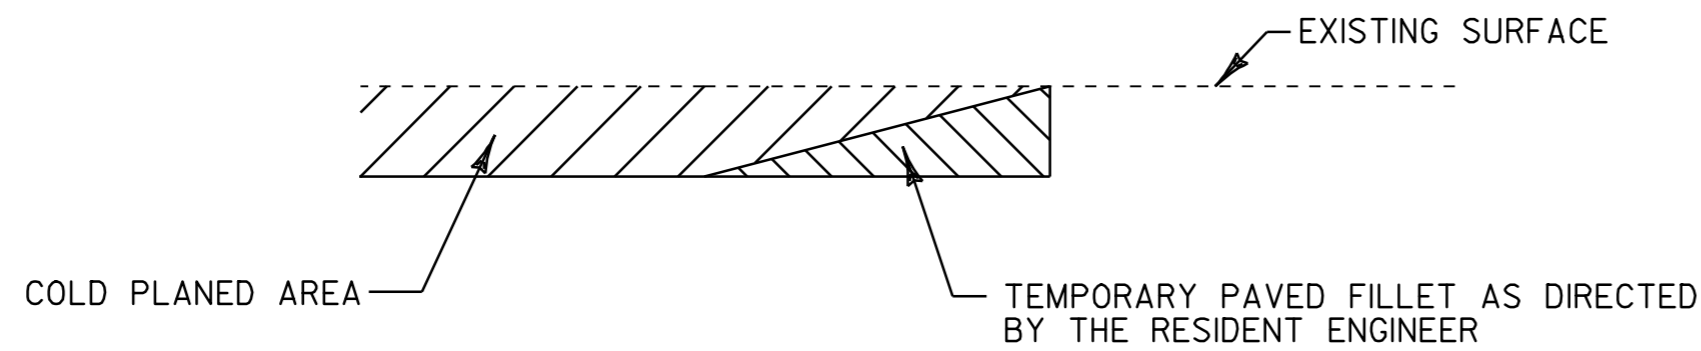

DETAIL AT VERTICAL COLD PLANE JOINTS

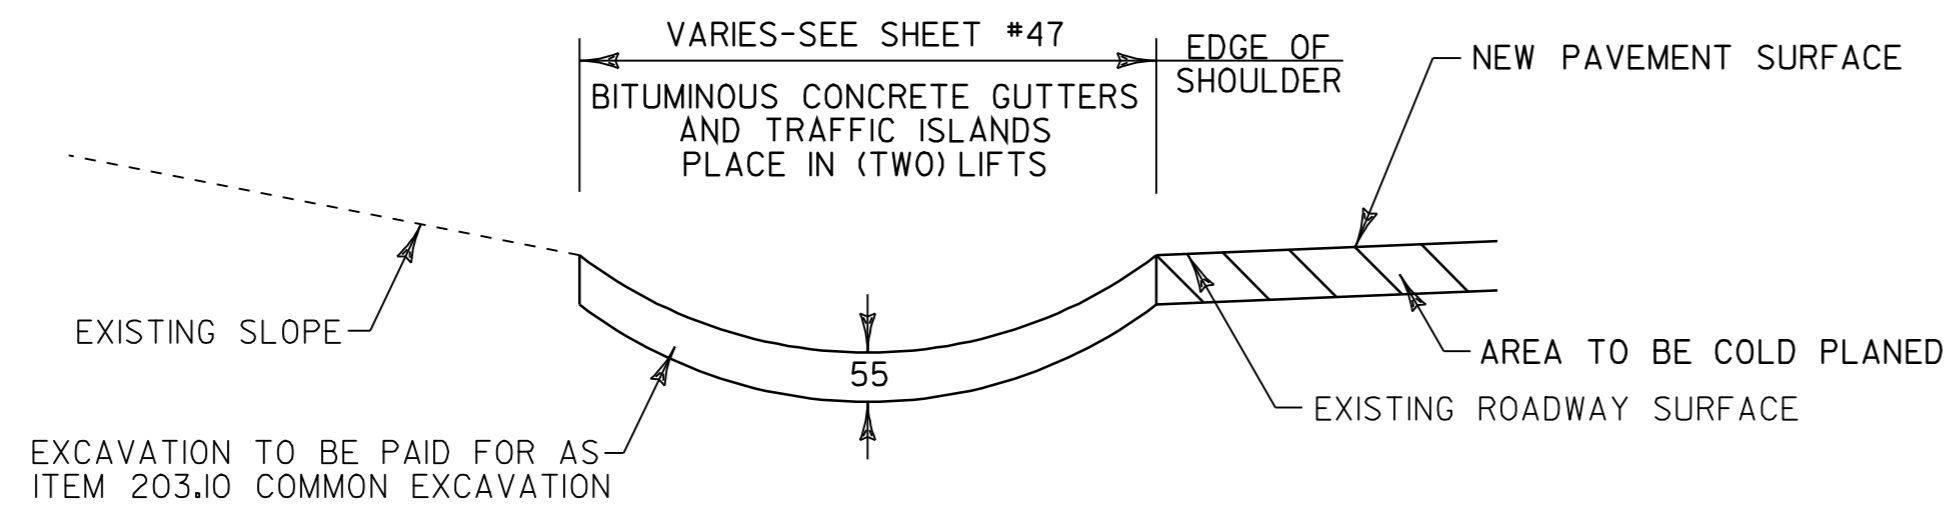

BITUMINOUS CONCRETE GUTTER DETAIL

U.S. ROUTE 7 STA. 3+566, LT.
U.S. ROUTE 7 STA. 3+568 TO 3+608, RT.

PROJECT PAVING LIMITS

TOWN & ROUTE	BEGIN STATION	END STATION	LANE TYPICAL	WEARING DEPTH	LEVELING TONS	NOTES
ST. ALBANS CITY U.S. ROUTE 7	0+000.00	3+640.40	VARIES - SEE LAYOUT SHEETS	40 mm	2055	COLD PLANE 55 mm, LEVEL, THEN PAVE WITH 40 mm TYPE IV

NOTES

- THE PAVEMENT WEARING COURSE SHALL BE TYPE IV. THE ESTIMATED 15 mm LEVELING COURSE SHALL BE TYPE IV UNLESS OTHERWISE DIRECTED BY THE ENGINEER. ALL ASPHALT CEMENT USED IN THE BITUMINOUS CONCRETE PAVEMENT SHALL BE PG 58-34.
- GRASS GROWING ADJACENT TO PAVEMENT OR THROUGH CRACKS IN THE PAVEMENT WHICH MAY HAMPER THE PLACEMENT OF NEW BITUMINOUS CONCRETE SHALL BE REMOVED BY THE CONTRACTOR AS DIRECTED BY THE ENGINEER. PAYMENT FOR THIS WORK WILL NOT BE MADE DIRECTLY, BUT WILL BE CONSIDERED SUBSIDIARY TO ITEM 406.25 BITUMINOUS CONCRETE PAVEMENT.
- BITUMINOUS CONCRETE PAVEMENT TOLERANCE = ± 5 mm. (TOTAL THICKNESS EXCLUDING LEVELING)
- EMULSIFIED ASPHALT SHALL BE APPLIED ON EXISTING PAVEMENT SURFACES, BETWEEN ALL COURSES OF PAVEMENT AND ON COLD PLANED SURFACES, AT THE RATE OF 0.12 L/m² OR AS DIRECTED BY THE ENGINEER.
- COLD PLANING TO BE COMPLETED ACCORDING TO TYPICAL OR AS NOTED OTHERWISE ON THE PLANS. THE COLD PLANING AND PAVING SHALL MATCH THE EXISTING CONDITIONS AT THE BEGINNING AND END OF CONSTRUCTION AREAS BY THE USE OF A VERTICAL BUTT JOINT. SEE DETAIL ON THIS SHEET.
- ALL DRIVES SHALL RECEIVE A PAVED APRON AS DIRECTED BY THE RESIDENT ENGINEER. ANY AND ALL REQUIRED EXCAVATION IN DRIVE AREAS SHALL BE AS DIRECTED AND WILL BE PAID FOR UNDER ITEM 210.10. IF REQUIRED, A NEW DRIVEWAY SUBBASE SHALL BE CONSTRUCTED AND WILL BE PAID FOR UNDER ITEM 301.28. A NEW BITUMINOUS SURFACE SHALL BE CONSTRUCTED AS DIRECTED AND WILL BE PAID FOR UNDER ITEM 406.25. ESTIMATED QUANTITIES OF THE ABOVE ITEMS HAVE BEEN INCLUDED TO PAY FOR THIS WORK.
- ITEM 616.47 BITUMINOUS CONCRETE GUTTERS AND TRAFFIC ISLANDS WILL BE PAID ONLY WHERE SPECIFIED IN THE ITEM DETAIL SUMMARY SHEET. ALL OTHER BITUMINOUS CONCRETE PAVEMENT WORK, WHICH COULD INVOLVE SOME HAND-WORK (SUCH AS DRIVEWAYS AND AROUND DRAINAGE/UTILITY STRUCTURES) SHALL BE PAID FOR AT THE CONTRACT PRICE FOR ITEM 406.25 BITUMINOUS CONCRETE PAVEMENT.
- EXTRA CARE SHALL BE TAKEN WHEN WORKING IN THE VICINITY OF MONITORING WELLS, ANY QUESTIONS OR CONCERNS SHOULD BE ADDRESSED TO THE CITY OF ST. ALBANS. THE ELEVATION ADJUSTMENTS OF TEST CP'S AND MONITORING WELLS HAS BEEN INCLUDED IN ITEM 629.20, ADJUST ELEVATION OF VALVE BOX.
- ALL TELEPHONE MH'S AND GSO'S WILL BE ADJUSTED BY OTHERS AND SHOULD NOT BE INCLUDED IN OTHER PAY ITEMS.
- FOR VEHICLE DETECTOR LOOP NOTES, SEE SHEETS 9 & 10.

URBAN AREAS - SEED MIXTURE

% WT	KG/HA	NAME	PUR %	GERM %
42.2	38	CREeping RED FESCUE	98	85
10.0	9	PERENNIAL RYE GRASS	95	90
42.2	38	KENTUCKY BLUE GRASS	85	85
5.6	5	ANNUAL RYE GRASS	95	85
100	90			

SEED MIXTURE:
SHALL NOT HAVE A WEED CONTENT EXCEEDING 0.40% BY WEIGHT AND SHALL BE FREE OF ALL NOXIOUS SEED.

SEED:
TO BE APPLIED PER SEEDING FORMULAS OR AS DIRECTED BY THE ENGINEER.

FERTILIZER:
FORMULA 10-20-10, TO BE USED WITH SEED, APPLIED AT THE RATE OF 560 KG/HA. (HYDRO SEEDERS MAY USE 19-19-19 FORMULA.)

AGRICULTURAL LIMESTONE:
TO BE APPLIED AT THE RATE OF 4500 KG/HA, OR AS DIRECTED BY THE ENGINEER.

HAY MULCH:
TO BE PLACED ON EARTH SLOPES AT THE RATE OF 4500 KG/HA, OR AS DIRECTED BY THE ENGINEER.

TOPSOIL:
TO BE USED AS INDICATED ON THE PLANS, OR AS DIRECTED BY THE ENGINEER.



NOTES: 1) ALL DIMENSIONS IN MILLIMETERS EXCEPT WHERE OTHERWISE INDICATED.

PROJECT TYPICALS & PAVING LIMITS

PROJECT NAME: ST. ALBANS CITY	PLOT DATE: 01-FEB-2006 07:4
PROJECT NUMBER: STP 9804(I)S	DRAWN BY: D-H
FILE NAME: /pave/97d150/pd150.dgn	CHECKED BY:
PROJECT LEADER: JLL	SHEET 13 OF 105
DESIGNED BY: D-H	
IPARM FILE NAME: pd150+yl.l	

QUANTITY SHEET



SUMMARY OF ESTIMATED QUANTITIES

DETAILED SUMMARY OF QUANTITIES

DETAILED SUMMARY OF QUANTITIES

EMPLOYEE TRAINEE-SHIP	BRIDGE	ROADWAY	QUANTITIES GRAND TOTAL	UNIT	ITEMS	ITEM NUMBER	RND	QUANTITIES	UNIT	ITEMS	QUANTITIES	UNIT	ITEMS
		12	12	EA	ANCHOR FOR STEEL BEAM RAIL	621.60	-						
		141	141	M	REMOVAL AND DISPOSAL OF GUARD RAIL	621.80	2.1						
		75	75	EA	ADJUST ELEVATION OF VALVE BOX	629.20	EST.						
		2700	2700	HR	UNIFORMED TRAFFIC OFFICERS	630.10	EST.						
		4000	4000	HR	FLAGGERS	630.15	EST.						
		1	1	LS	FIELD OFFICE-ENGINEERS	631.10	-						
		1	1	LS	TESTING EQUIPMENT - CONCRETE	631.16	-						
		1	1	LU	TESTING EQUIPMENT - BITUMINOUS	631.17	-						
		1	1	LS	FIELD OFFICE - TELEPHONE (NOT A BID ITEM)	631.25	-						
		1	1	LS	MOBILIZATION	635.10	-						
		1	1	LS	TRAFFIC CONTROL (MOD.)	641.10	-						
		2	2	EA	PORTABLE CHANGEABLE MESSAGE SIGN	641.15	-						
		19	19	EA	LETTER OR SYMBOL (MOD.)	646.30	-						
		6270	6270	M	DURABLE 100 mm WHITE LINE	646.40	125						
		7890	7890	M	DURABLE 100 mm YELLOW LINE	646.41	157						
		1090	1090	M	DURABLE 150 mm WHITE LINE	646.414	20						
		90	90	M	DURABLE 200 mm WHITE LINE	646.42	7						
		180	180	M	DURABLE 200 mm YELLOW LINE	646.43	7						
		210	210	M	DURABLE 600 mm STOP BAR (TYPE I TAPE)	646.46	8.6						
		295	295	EA	DURABLE LETTER OR SYMBOL (TYPE I TAPE)	646.50	-						
		585	585	M	DURABLE CROSSWALK MARKING W/DIAGONAL LINES (MOD.)	646.51	13.1						
		12500	12500	M	TEMPORARY 100 mm WHITE LINE	646.60	209						
		15800	15800	M	TEMPORARY 100 mm YELLOW LINE	646.61	333						
		2200	2200	M	TEMPORARY 150 mm WHITE LINE	646.614	60						
		200	200	M	TEMPORARY 200 mm WHITE LINE	646.62	34						
		400	400	M	TEMPORARY 200 mm YELLOW LINE	646.63	54						
		420	420	M	TEMPORARY 600 mm STOP BAR	646.66	17						
		310	310	EA	TEMPORARY LETTER OR SYMBOL	646.70	-						
		30	30	EA	TEMPORARY LETTER OR SYMBOL (MOD.)	646.70	-						

PROJECT NAME :	PROJECT NO. :
ST. ALBANS CITY	STP_9804(II)_
DESIGN FILE NAME: Z:\pave\97dl50\pdl50.dgn	PLOT DATE: 01-FEB-2006 0
IPARM FILE NAME: pdl50qs2.1	SURVEY DATE: 06/07/00
SURVEYED BY: D-H	DRAWN BY: D-H
SQUAD LEADER: JLL	SHEET: 15 OF 105



STATION		POS.	203.15	203.16	203.30	212.20	212.20	301.28		604.40	604.42	604.42	604.47	616.28	616.41	616.47	618.10	618.15	621.20	621.60	621.80	629.20	REMARKS	
BEGIN	END		COMMON EXCAV. m³	SOLID ROCK EXCAV. m³	EARTH BORROW m³	SCARIFYING PAVEMENT (MOD.1) m²	SCARIFYING PAVEMENT (MOD.2) m²	SUBBASE OF C.R. GRAVEL T	GRATE TYPE EA	CHAN ELEV EA	REHAB DI CLASS I EA	CHAN ELEV SEWER MANHOLE EA	CAST IRON GRATE W/FRA M TYPE D EA	CAST-IN-PLACE CEM. CONC. CURB TYPE B M	REMOVAL OF EXISTING CURB M	BIT. CONC. GUTTERS & TRAFFIC ISLANDS T	P.C. CONCRETE SIDEWALK 125 mm m²	BIT. CONCRETE SIDEWALK T	STEEL BEAM G.R. M	ANCHOR FOR STEEL BEAM RAIL EA	REMOVAL AND DISPOSAL OF GUARD RAIL M	ADJUST ELEV VALVE BOX EA		
U. S. ROUTE 7																								
0+000.00	3+640.40	LT&RT								49	119	31	1	357									75	QUANTITIES FOR USE AS DIRECTED BY THE ENGINEER. FOR STRUCTURE LOCATIONS, SEE SHEETS 67 & 68.
0+009.0		RT	0.7	0.6				1.7					3.2	3.2		4.8							CONSTRUCT SIDEWALK RAMP, TYPE I	
0+020.3		RT	0.5	0.4				1.1					3.5	3.5		3.2							CONSTRUCT SIDEWALK RAMP, TYPE I	
0+118.8		RT	0.6	0.5				1.3					4.5	4.5		3.8							CONSTRUCT SIDEWALK RAMP, TYPE I	
0+128.9		RT	0.6	0.5				1.3					3.6	3.6		3.8							CONSTRUCT SIDEWALK RAMP, TYPE I	
0+225.5		LT				3.9																	CONSTRUCT TEXTURING. FOR DETAILS SEE SHEET 7.	
0+226.0	0+255.0	LT																35.44 53.2	6	49.4				INSTALL NEW RAIL W/ANCHORS ALONG BOTH EDGES OF SIDEROAD (19 M EACH) AND ALONG BOTH SIDES OF CENTER ISLAND (7.6 M EACH)
0+258.0		LT				2.4																		CONSTRUCT TEXTURING. FOR DETAILS SEE SHEET 7.
0+300.4		RT	0.7	0.6				1.6					3.7	3.7		4.5							CONSTRUCT SIDEWALK RAMP, TYPE I	
0+313.0		RT	0.6	0.5				1.4					7.2	7.2		4.1							CONSTRUCT SIDEWALK RAMP, TYPE I	
0+426.2	0+452.8	LT																						INSTALL NEW STEEL BEAM G.R. WITH ANCHORS
0+523.0		RT	0.6	0.5				1.3					4.5	4.5		3.8							CONSTRUCT SIDEWALK RAMP, TYPE I	
0+537.9		RT	0.8	0.7				1.8					4.4	4.4		5.3							CONSTRUCT SIDEWALK RAMP, TYPE I	
0+847.0	0+873.5	LT																						REMOVE EXISTING STEEL BEAM G.R.
0+882.0	0+904.8	LT																						USE PAY FACTOR 1.40 FROM STA. 0+882.0 TO 0+893.4
0+908.0	0+915.6	RT																						USE PAY FACTOR 1.40
0+918.4	0+929.8	LT																						USE PAY FACTOR 1.40
0+976.0		LT	0.5	0.5				1.2					5.7	5.7		3.6							CONSTRUCT SIDEWALK RAMP, TYPE I	
0+985.2		LT	0.3	0.3				0.7					7.2	7.2		2							CONSTRUCT SIDEWALK RAMP, TYPE I	
1+025.0		RT	1.5	1.5				3.3					6	6		9.7							CONSTRUCT SIDEWALK RAMP, TYPE 6	
1+025.0		LT	1.5					3.5					2	2		7.6							CONSTRUCT NEW SIDEWALK W/RAMP, TYPE 2	
1+101.0		LT				2.2																	CONSTRUCT TEXTURING. FOR DETAILS SEE SHEET 7.	
1+109.0		LT				1.9																	CONSTRUCT TEXTURING. FOR DETAILS SEE SHEET 7.	
1+227.5		RT				2.7																	CONSTRUCT TEXTURING. FOR DETAILS SEE SHEET 7.	
1+242.2		RT	1.3	1.1				2.9					7.0	7.0		8.4							CONSTRUCT SIDEWALK RAMP, TYPE 6	
1+271.4		LT	0.3	0.2				0.6								1.8							CONSTRUCT SIDEWALK RAMP, TYPE I	
1+278.0		LT				1.9																	CONSTRUCT TEXTURING. FOR DETAILS SEE SHEET 7.	
1+361.0		RT	0.5	0.4				1.1					4.0	4.0		3.3							CONSTRUCT SIDEWALK RAMP, TYPE I	
1+374.9		RT	1.5	1.2				3.4					7.5	7.5		10.0							CONSTRUCT SIDEWALK RAMP, TYPE 6	
1+437.0		LT	0.6	0.5				1.4								4.1							CONSTRUCT SIDEWALK RAMP, TYPE I	
1+444.7		LT	0.4	0.3				0.8								2.4							CONSTRUCT SIDEWALK RAMP, TYPE I	
1+517.5		RT	0.6	0.5				1.3					4.0	4.0		3.9							CONSTRUCT SIDEWALK RAMP, TYPE I	
1+524.3		LT				2.2																	CONSTRUCT TEXTURING. FOR DETAILS SEE SHEET 7.	
1+533.5		RT	1.5	1.2				3.4					7.7	7.7		9.8							CONSTRUCT SIDEWALK RAMP, TYPE 6	
1+539.8		LT				1.8																	CONSTRUCT TEXTURING. FOR DETAILS SEE SHEET 7.	

SUBTOTALS			15.6	12		19.0		35.1		49	119	31	1	442.7	85.7		99.9					75	
-----------	--	--	------	----	--	------	--	------	--	----	-----	----	---	-------	------	--	------	--	--	--	--	----	--

PROJECT NAME :		PROJECT NO. :	
ST. ALBANS CITY		STP_9804(1)S	
DESIGN FILE NAME: \pave\97\d150\d150.dgn			
IPARM FILE NAME: pd150\d150.....		PLOT DATE: 01-FEB-2006 0	
SURVEYED BY: D-H.....		SURVEY DATE: 06/07/00	
DESIGNED BY: JLL.....		DRAWN BY: D-H.....	
SHEET: 17 OF 105			

STATION		POS.	203.15	203.16	203.30	212.20	212.20	301.28		604.40	604.42	604.42	604.47	616.28	616.41	616.47	618.10	618.15	621.20	621.60	621.80	629.20	REMARKS
BEGIN	END		COMMON EXCAV. m ³	SOLID ROCK EXCAV. m ³	EARTH BORROW m ³	SCARIFYING PAVEMENT (MOD.1) m ²	SCARIFYING PAVEMENT (MOD.2) m ²	SUBBASE OF C.R. GRAVEL T	GRATE TYPE EA	CHAN ELEV EA	REHAB DI CLASS I EA	CHAN ELEV SEWER MANHOLE EA	CAST IRON GRATE W/FRAME TYPE D EA	CAST-IN-PLACE CEM. CONC. CURB TYPE B M	REMOVAL OF EXISTING CURB M	BIT. CONC. GUTTERS & TRAFFIC ISLANDS T	P.C. CONCRETE SIDEWALK 125 mm m ²	BIT. CONCRETE SIDEWALK T	STEEL BEAM G.R. M	ANCHOR FOR STEEL BEAM RAIL EA	REMOVAL AND DISPOSAL OF GUARD RAIL M	ADJUST ELEV VALVE BOX EA	
U. S. ROUTE 7																							
I+545.0		LT				2.9																	CONSTRUCT TEXTURING. FOR DETAILS SEE SHEET 7.
I+698.0		LT	0.6	0.5				1.4						8.4	8.4		4.2						CONSTRUCT SIDEWALK RAMP, TYPE 1
I+711.5		LT	0.5	0.5				1.2						3.5	3.5		3.6						CONSTRUCT SIDEWALK RAMP, TYPE 1
I+721.0		LT	0.6	0.5				1.5						4.5	6		4.3						CONSTRUCT NEW SIDEWALK WITH TYPE 2 RAMP, FOR DETAILS SEE SHEET 30.
I+804.5		LT				1.4																	CONSTRUCT TEXTURING. FOR DETAILS SEE SHEET 7.
I+817.0		RT	0.5	0.4				1.0						9	9		3						CONSTRUCT SIDEWALK RAMP, TYPE 6
I+822.5		LT				4.3																	CONSTRUCT TEXTURING. FOR DETAILS SEE SHEET 7.
I+992.0		LT				1.4																	CONSTRUCT TEXTURING. FOR DETAILS SEE SHEET 7.
2+008.0		LT				3.8																	CONSTRUCT TEXTURING. FOR DETAILS SEE SHEET 7.
2+144.6		LT				1.4																	CONSTRUCT TEXTURING. FOR DETAILS SEE SHEET 7.
2+146.6		LT				1.7																	CONSTRUCT TEXTURING. FOR DETAILS SEE SHEET 7.
2+161.8		LT				1.7																	CONSTRUCT TEXTURING. FOR DETAILS SEE SHEET 7.
2+177.4		RT					1.4																CONSTRUCT BITUMINOUS TEXTURING. FOR DETAILS SEE SHEET 7.
2+189.7		RT	3.8	3.1				8.6								25.0							CONSTRUCT SIDEWALK RAMP, TYPE 5
2+189.7		LT				1.4																	CONSTRUCT TEXTURING. FOR DETAILS SEE SHEET 7.
2+206.0		LT				3.6																	CONSTRUCT TEXTURING. FOR DETAILS SEE SHEET 7.
2+216.0		LT				3.6																	CONSTRUCT TEXTURING. FOR DETAILS SEE SHEET 7.
2+293.0		RT				1.4																	CONSTRUCT TEXTURING. FOR DETAILS SEE SHEET 7.
2+302.9		RT				1.4																	CONSTRUCT TEXTURING. FOR DETAILS SEE SHEET 7.
2+305.9		LT	1.4	1.1				3.1						6.5	6.5		9.0						CONSTRUCT SIDEWALK RAMP, TYPE 5
2+305.9		RT				2.1																	CONSTRUCT TEXTURING. FOR DETAILS SEE SHEET 7.
2+313.0		LT				2.4																	CONSTRUCT TEXTURING. FOR DETAILS SEE SHEET 7.
2+379.0		LT				2.6																	CONSTRUCT TEXTURING. FOR DETAILS SEE SHEET 7.
2+386.5		LT				2.2																	CONSTRUCT TEXTURING. FOR DETAILS SEE SHEET 7.
2+486.0		LT				1.4																	CONSTRUCT TEXTURING. FOR DETAILS SEE SHEET 7.
2+486.0		RT				1.2																	CONSTRUCT TEXTURING. FOR DETAILS SEE SHEET 7.
2+626.7		RT				0.9																	CONSTRUCT TEXTURING. FOR DETAILS SEE SHEET 7.
2+633.8		RT					1.0																CONSTRUCT BITUMINOUS TEXTURING. FOR DETAILS SEE SHEET 7.
2+886.3		RT	1.3					2.3						5.1	5.1			0.8					CONSTRUCT BITUMINOUS SIDEWALK RAMP, TYPE 1
2+893.0		RT	2.1	1.7				4.7						3.8	3.8		13.7						CONSTRUCT SIDEWALK RAMP, TYPE 3
2+896.0		LT				1.2																	CONSTRUCT TEXTURING. FOR DETAILS SEE SHEET 7.
3+034.0		RT				1.4																	CONSTRUCT TEXTURING. FOR DETAILS SEE SHEET 7.
3+566.0		LT	7.8												1.9								FOR BITUMINOUS CONCRETE GUTTER DETAILS, SEE SHEET 13
3+568.0	3+608.0	RT	34.7													8.2							FOR BITUMINOUS CONCRETE GUTTER DETAILS, SEE SHEET 13
SEE REMARKS														18.0	18.0								CURB ITEMS FOR USE IN CONJUNCTION WITH WIRED CONDUIT INSTALLATION AS DIRECTED BY THE RESIDENT ENGINEER. FOR DETAILS, SEE SHEET 10.
SUBTOTALS			53.3	7.8		45.4	2.4	23.8						58.8	60.3	10.1	62.8	0.8					
SHEET 17 SUBTOTALS			15.6	12		19.0	-	35.1		49	119	31	1	442.7	85.7	-	99.9		133.9	12	138.9	75	
SHEET 18 SUBTOTALS			53.3	7.8		45.4	2.4	23.8		-	-	-	-	58.8	60.3	10.1	62.8	0.8	-	-	-	-	
SUBTOTALS			68.9	19.8		64.4	2.4	58.9		49	119	31	1	501.5	146	10.1	162.7	0.8	133.9	12	138.9	75	
ROUNDING			2.1	1.2		1.6	0.6	1.1		-	-	-	-	7.5	3	0.9	3.3	0.2	2.1	-	2.1	-	
PROJECT TOTALS			71	21		66	3	60		49	119	31	1	509	149	11	166	1	136	12	141	75	

PROJECT NAME : ST. ALBANS CITY	PROJECT NO. : STP_9804(I)S
DESIGN FILE NAME: <u>lpave297dl50/pdl50.dgn</u>	PLOT DATE: 01-FEB-2006 0
IPARM FILE NAME: <u>pdl50id2.i</u>	SURVEY DATE: 06/07/00
SURVEYED BY: <u>D-H</u>	DRAWN BY: <u>D-H</u>
DESIGNED BY: <u>JLL</u>	SHEET: <u>18</u> OF <u>105</u>

TEMPORARY & DURABLE 100 mm WHITE LINE
 STA. 0+000.0 TO 0+165.0, SOLID LT. & RT.
 (WITH EDGELINE BREAKS FOR PARSONS
 AVE. & ORCHARD ST.)
 STA. 0+123.4, RT. (ORCHARD ST. EDGELINES)

TEMPORARY & DURABLE 100 mm YELLOW LINE
 STA. 0+000.0 TO 0+165.0, SOLID LT. & RT.
 (WITH CENTERLINE BREAKS FOR PARSONS
 AVE. & ORCHARD ST.)
 STA. 0+014.0, DOUBLE SOLID RT. (PARSONS AVE.)
 STA. 0+123.4, DOUBLE SOLID RT. (ORCHARD ST.)

TEMPORARY & DURABLE CROSSWALK WITH DIAGONAL LINES (MOD.)
 STA. 0+014.0, RT. (PARSONS AVE.)
 STA. 0+123.4, RT. (ORCHARD ST.)

REMOVING SIGNS
 AS SHOWN - 6

CHANGING ELEVATION OF SMH'S
 STA. 0+013.0, LT.
 STA. 0+017.0, RT.
 STA. 0+122.5, LT.


REHABILITATION OF DI'S, CB'S OR MH'S - CLASS I
 STA. 0+000.0, RT. - DI
 STA. 0+028.7, LT. & RT. - DI'S
 STA. 0+112.0, LT. & RT. - DI'S
 STA. 0+121.0, RT. - DI

TEMPORARY & DURABLE 600 mm STOP BAR (TYPE I TAPE)
 STA. 0+014.0, RT. (PARSONS AVE.)
 STA. 0+123.4, RT. (ORCHARD ST.)

TEMPORARY & DURABLE LETTER OR SYMBOL (TYPE I TAPE)
 STA. 0+014.0, RT. - "STOP"
 STA. 0+123.4, RT. - "STOP"

ADJUST ELEVATION OF VALVE BOX
 STA. 0+005

BEGIN STP 9804(1)S U.S. ROUTE 7
ST. ALBANS CITY STA. 0+000.00 = MM 0.000
ST. ALBANS TOWN - ST. ALBANS CITY TOWN LINE

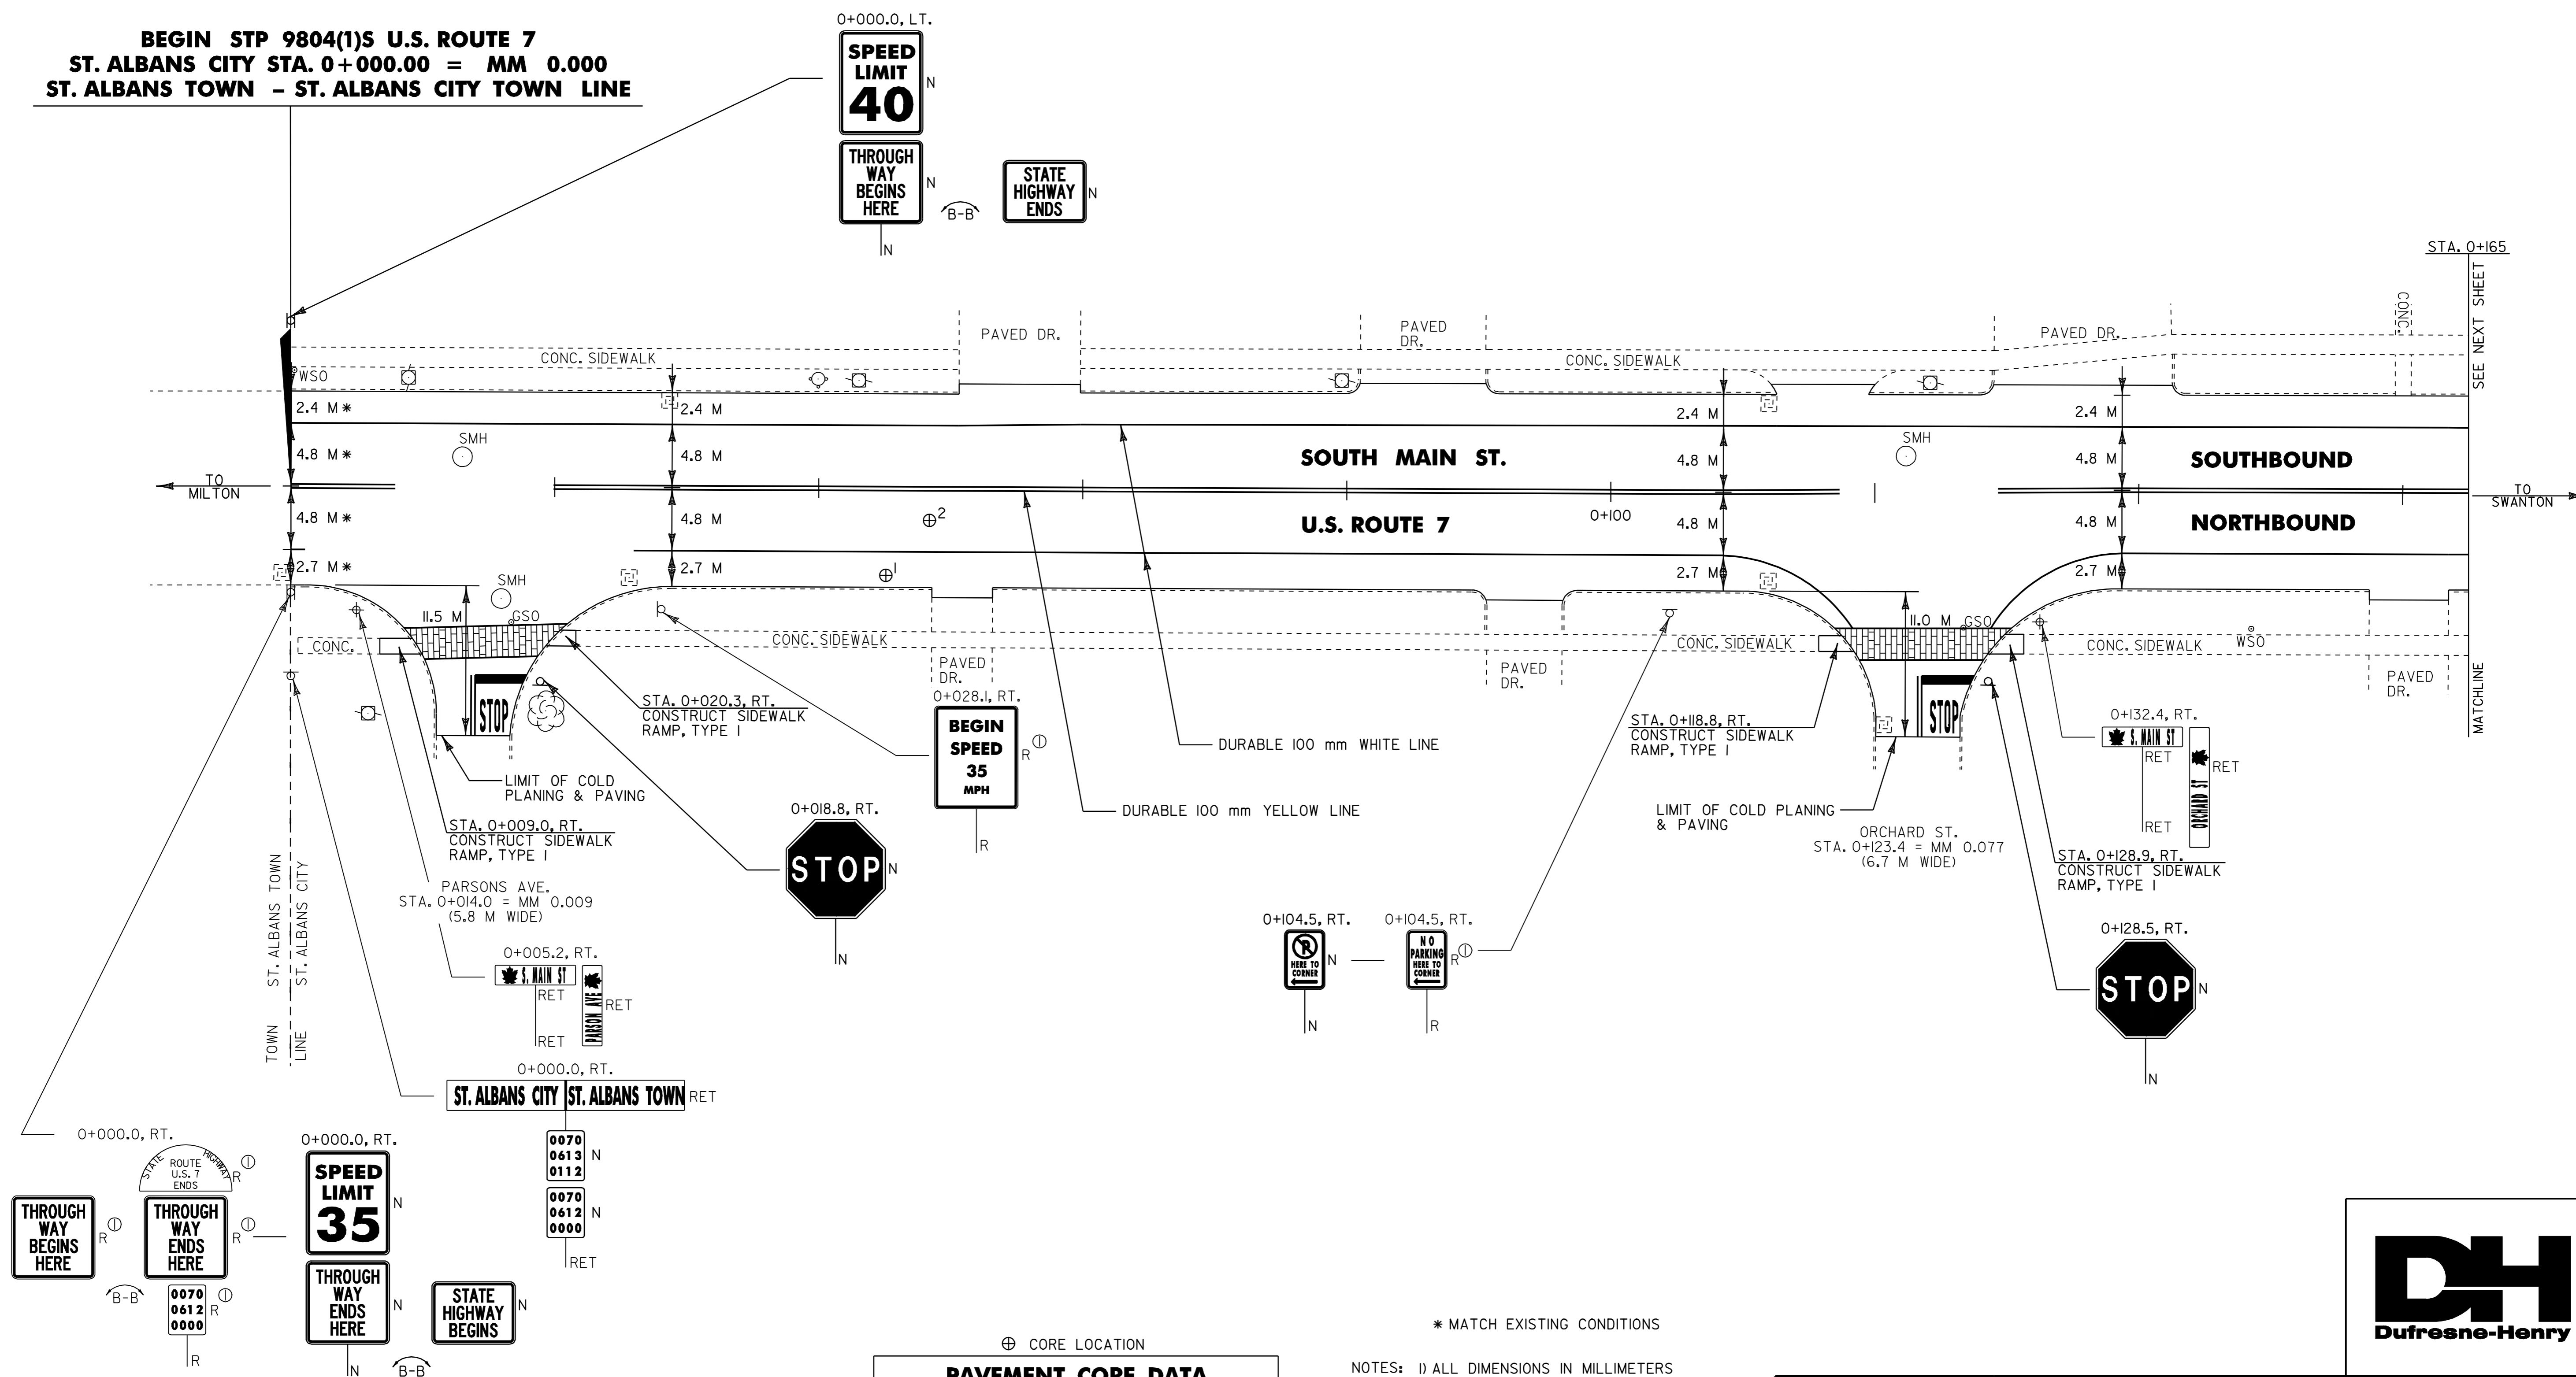

⊕ CORE LOCATION

CORE #	LOCATION	DEPTH (mm)	PCC
1	0+045.1, RT.	140	NO
2	0+048.3, RT.	159	NO

- * MATCH EXISTING CONDITIONS
- NOTES: 1) ALL DIMENSIONS IN MILLIMETERS EXCEPT WHERE OTHERWISE INDICATED.
 2) ALL EXISTING SIGNS NOT SHOWN SHALL BE RETAINED AS DIRECTED BY THE RESIDENT ENGINEER.
 3) FOR ANY TOWN HIGHWAY OR STREET DETAILS, SEE VTrans STANDARD E-193M.

LAYOUT SHEET #1

PROJECT NAME: ST. ALBANS CITY
 PROJECT NUMBER: STP_9804(1)S
 FILE NAME: zpxe297d1502pd150.dgn PLOT DATE: 01-FEB-2006 07:
 PROJECT LEADER: JLL DRAWN BY: D-H
 DESIGNED BY: D-H CHECKED BY:
 IPARM FILE NAME: pd150p01.i SHEET 19 OF 105



~~TEMPORARY & DURABLE 100 mm WHITE LINE~~ STA. 0+165.0 TO 0+325.0, SOLID LT. & RT. (WITH EDGELINE BREAKS FOR INDUSTRIAL PARK RD. & FAIRFAX ST.) STA. 0+242.0, LT. (INDUSTRIAL PARK RD. EDGELINES) STA. 0+306.3, RT. (FAIRFAX ST. EDGELINES)

~~TEMPORARY & DURABLE 100 mm YELLOW LINE~~ STA. 0+165.0 TO 0+325.0, SOLID LT. & RT. (WITH CENTERLINE BREAKS FOR INDUSTRIAL PARK RD. & FAIRFAX ST.) STA. 0+242.0, LT. (INDUSTRIAL PARK RD. EDGELINES AROUND ISLAND)

~~TEMPORARY & DURABLE CROSSWALK WITH DIAGONAL LINES (MOD.)~~ STA. 0+242.0, LT. (INDUSTRIAL PARK RD.) STA. 0+306.3, RT. (FAIRFAX ST.)

~~TEMPORARY & DURABLE 600 mm STOP BAR (TYPE ITAPE)~~ STA. 0+242.0, LT. (INDUSTRIAL PARK RD.) STA. 0+306.3, RT. (FAIRFAX ST.)

~~TEMPORARY & DURABLE LETTER OR SYMBOL (TYPE ITAPE)~~ STA. 0+242.0, LT. - "STOP" STA. 0+306.3, RT. - "STOP"

REMOVING SIGNS AS SHOWN - 2

ADJUST ELEVATION OF VALVE BOX
~~STA. 0+242.0, LT. - WSO'S (2)~~
 STA. 0+244.0, LT. - WSO
 STA. 0+307.0, Q - WSO

REHABILITATION OF DI'S, CB'S OR MH'S - CLASS I
 STA. 0+201.5, LT. & RT. - DI'S
 STA. 0+292.0, LT. & RT. - DI'S
 STA. 0+321.5, RT. - DI


CHANGING ELEVATION OF SMH'S
 STA. 0+304.5, LT.
 STA. 0+310.5, LT.

CHANGING ELEVATION OF DI'S, CB'S OR MH'S
 STA. 0+304.5, RT. - MH

STEEL BEAM GUARD RAIL
 STA. 0+226.0 TO 0+236.0, LT.
 STA. 0+242.0, LT. (BOTH SIDES OF ISLAND)
 STA. 0+250.0 TO 0+255.0, LT.

~~ANCHOR FOR STEEL BEAM RAIL~~
~~STA. 0+226.0, LT.~~
~~STA. 0+242.0, LT. (ALL 4 ENDS)~~
~~STA. 0+255.0, LT.~~

REMOVAL AND DISPOSAL OF GUARD RAIL
 STA. 0+226.0 TO 0+236.0, LT.
 STA. 0+242.0, LT. (BOTH SIDES OF ISLAND)
 STA. 0+250.0 TO 0+255.0, LT.

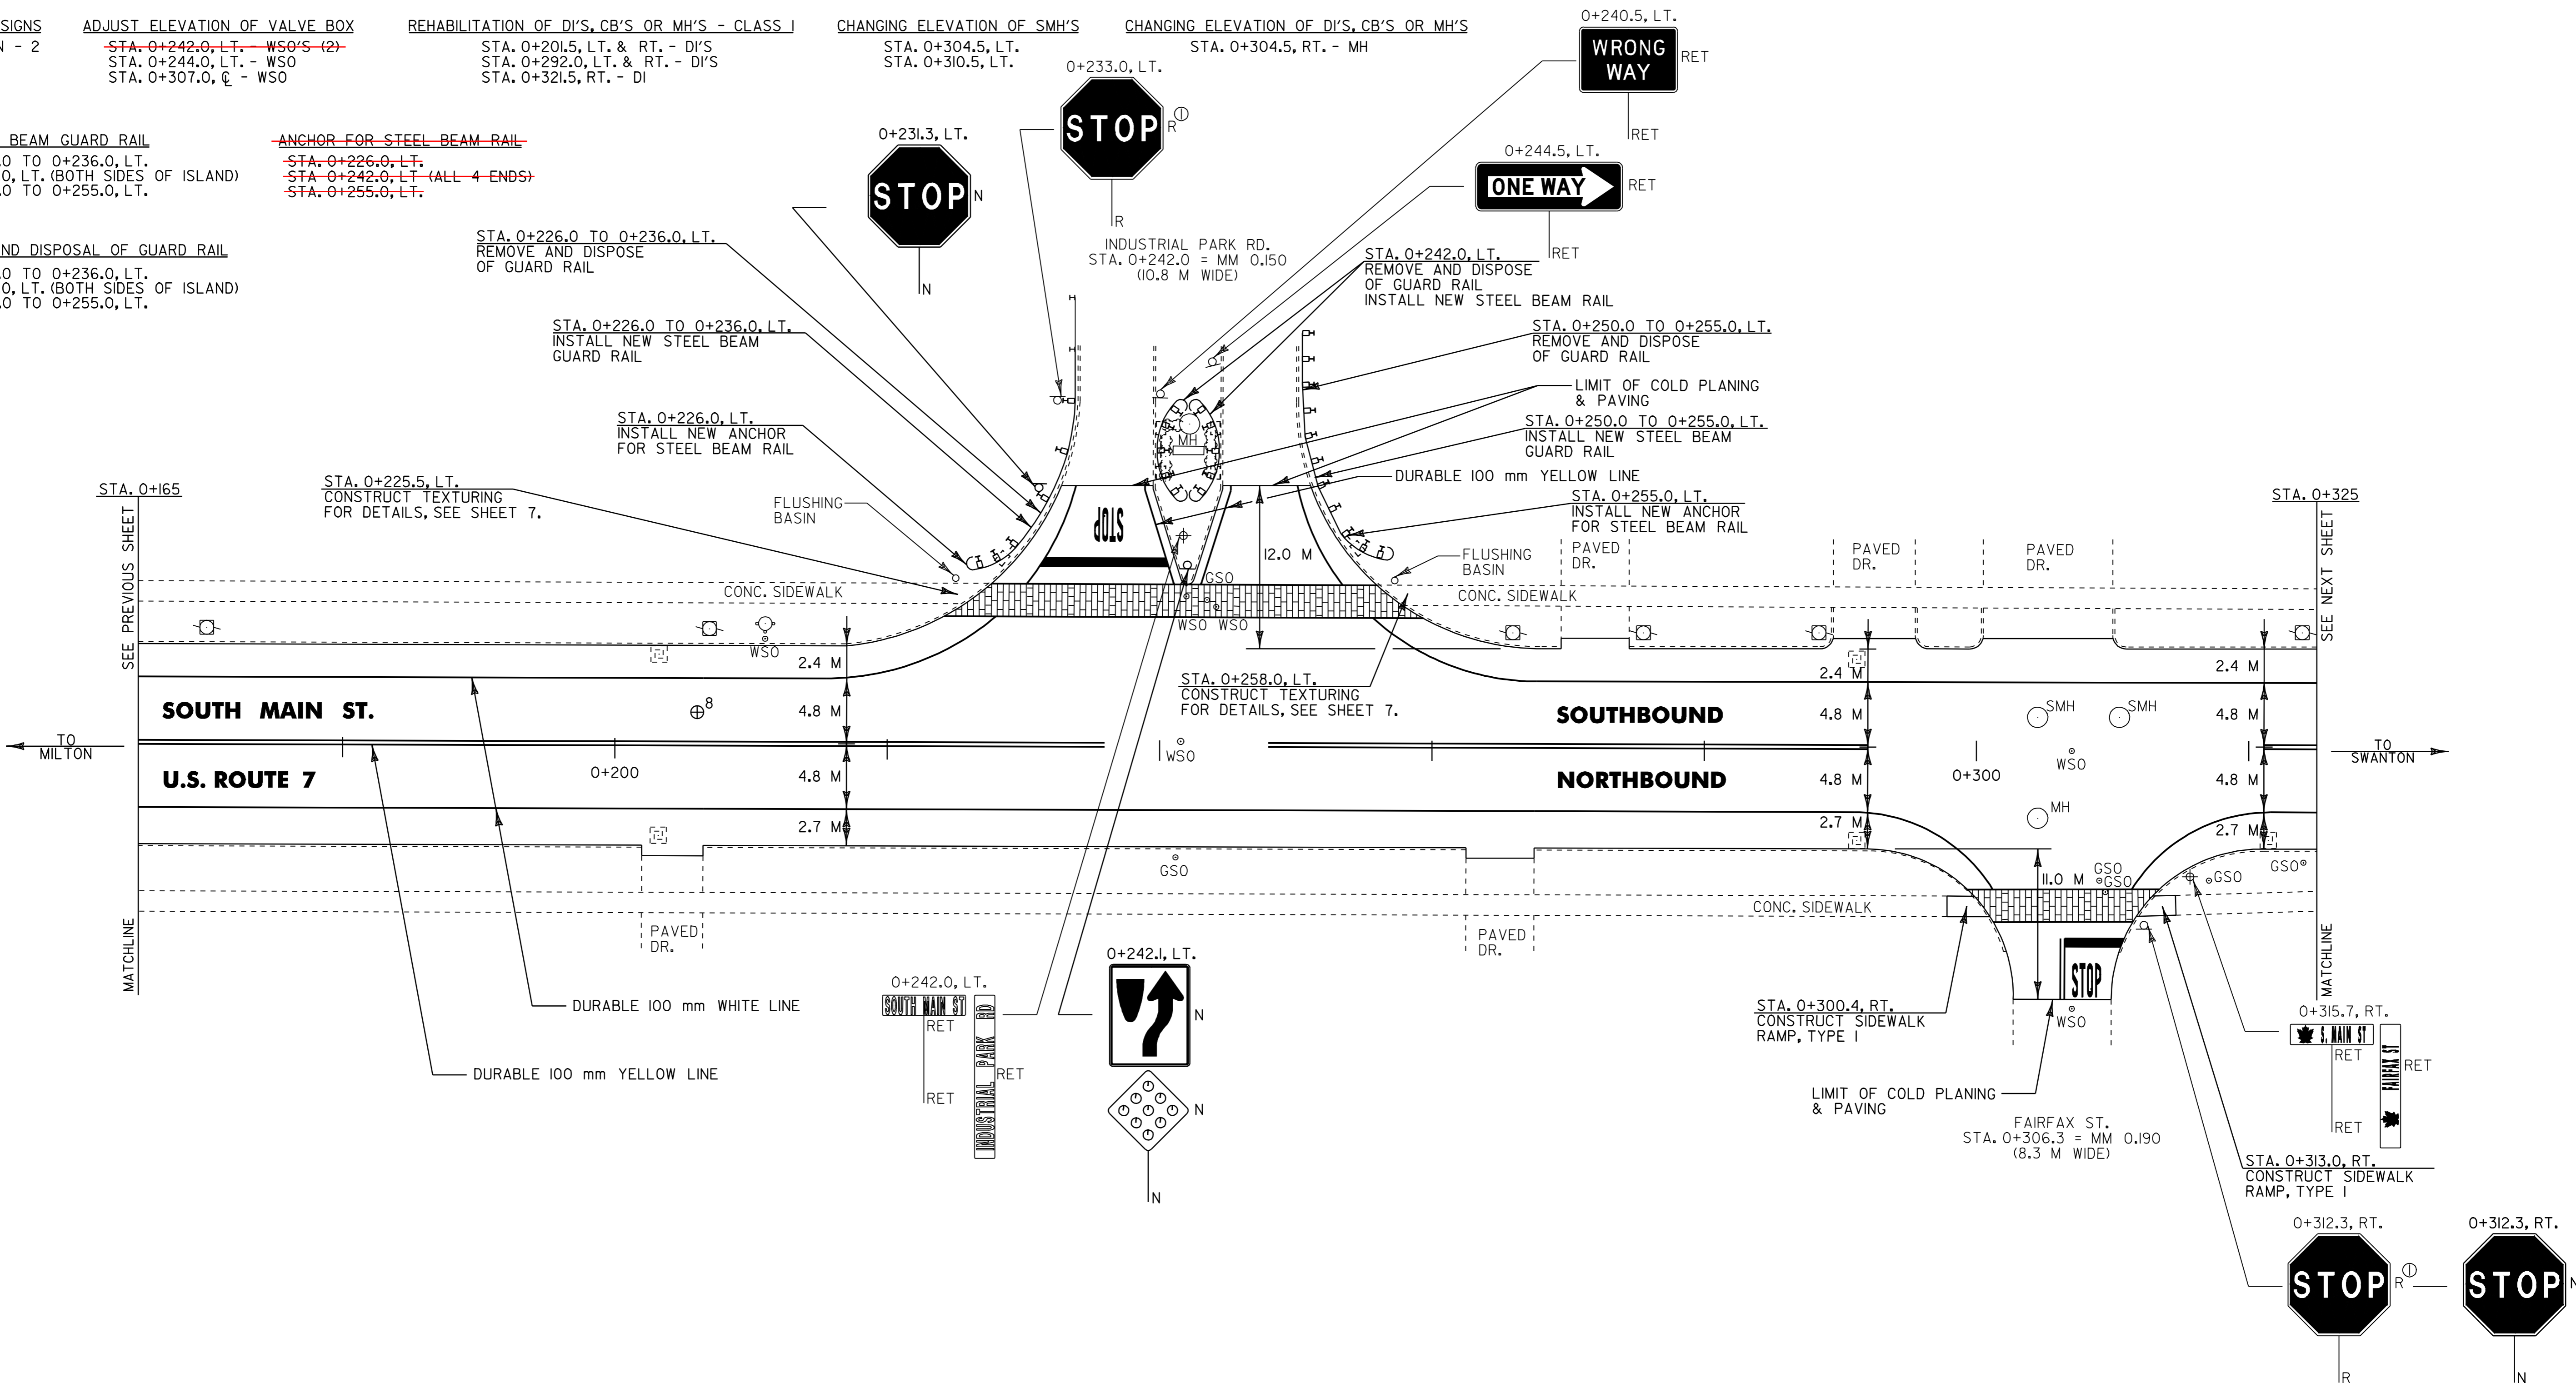

⊕ CORE LOCATION

PAVEMENT CORE DATA			
CORE #	LOCATION	DEPTH (mm)	PCC
8	0+206.0, LT.	127	NO

NOTES: 1) ALL DIMENSIONS IN MILLIMETERS EXCEPT WHERE OTHERWISE INDICATED.
 2) ALL EXISTING SIGNS NOT SHOWN SHALL BE RETAINED AS DIRECTED BY THE RESIDENT ENGINEER.
 3) FOR ANY TOWN HIGHWAY OR STREET DETAILS, SEE VTrans STANDARD E-193M.

LAYOUT SHEET #2

PROJECT NAME: ST. ALBANS CITY
 PROJECT NUMBER: STP_9804(I)S
 FILE NAME: Z:\pave\97\d150\pd150.dgn
 PROJECT LEADER: JLL
 DESIGNED BY: D-H
 IPARM FILE NAME: pd150p02.i
 PLOT DATE: 01-FEB-2006 07:4
 DRAWN BY: D-H
 CHECKED BY:
 SHEET 20 OF 105

TEMPORARY & DURABLE 100 mm WHITE LINE
 STA. 0+325.0 TO 0+485.0, SOLID LT. & RT.

TEMPORARY & DURABLE 100 mm YELLOW LINE
 STA. 0+325.0 TO 0+485.0, SOLID LT. & RT.

ADJUST ELEVATION OF VALVE BOX
 STA. 0+421.5, LT. - WSO

REHABILITATION OF DI'S, CB'S OR MH'S - CLASS I
 STA. 0+428.0, RT. - DI
 STA. 0+431.5, LT. - DI

CHANGING ELEVATION OF SMH'S
 STA. 0+441.0, LT.
 STA. 0+479.0, LT.

REMOVING SIGNS
 AS SHOWN - I


ERECTING SALVAGED SIGNS
 AS SHOWN - I



STEEL BEAM GUARD RAIL
 STA. 0+426.2 TO 0+452.8, LT.

ANCHOR FOR STEEL BEAM RAIL
 STA. 0+430.0, LT.
 STA. 0+449.0, LT.

REMOVAL AND DISPOSAL OF GUARD RAIL
 STA. 0+427.0 TO 0+447.0, LT.

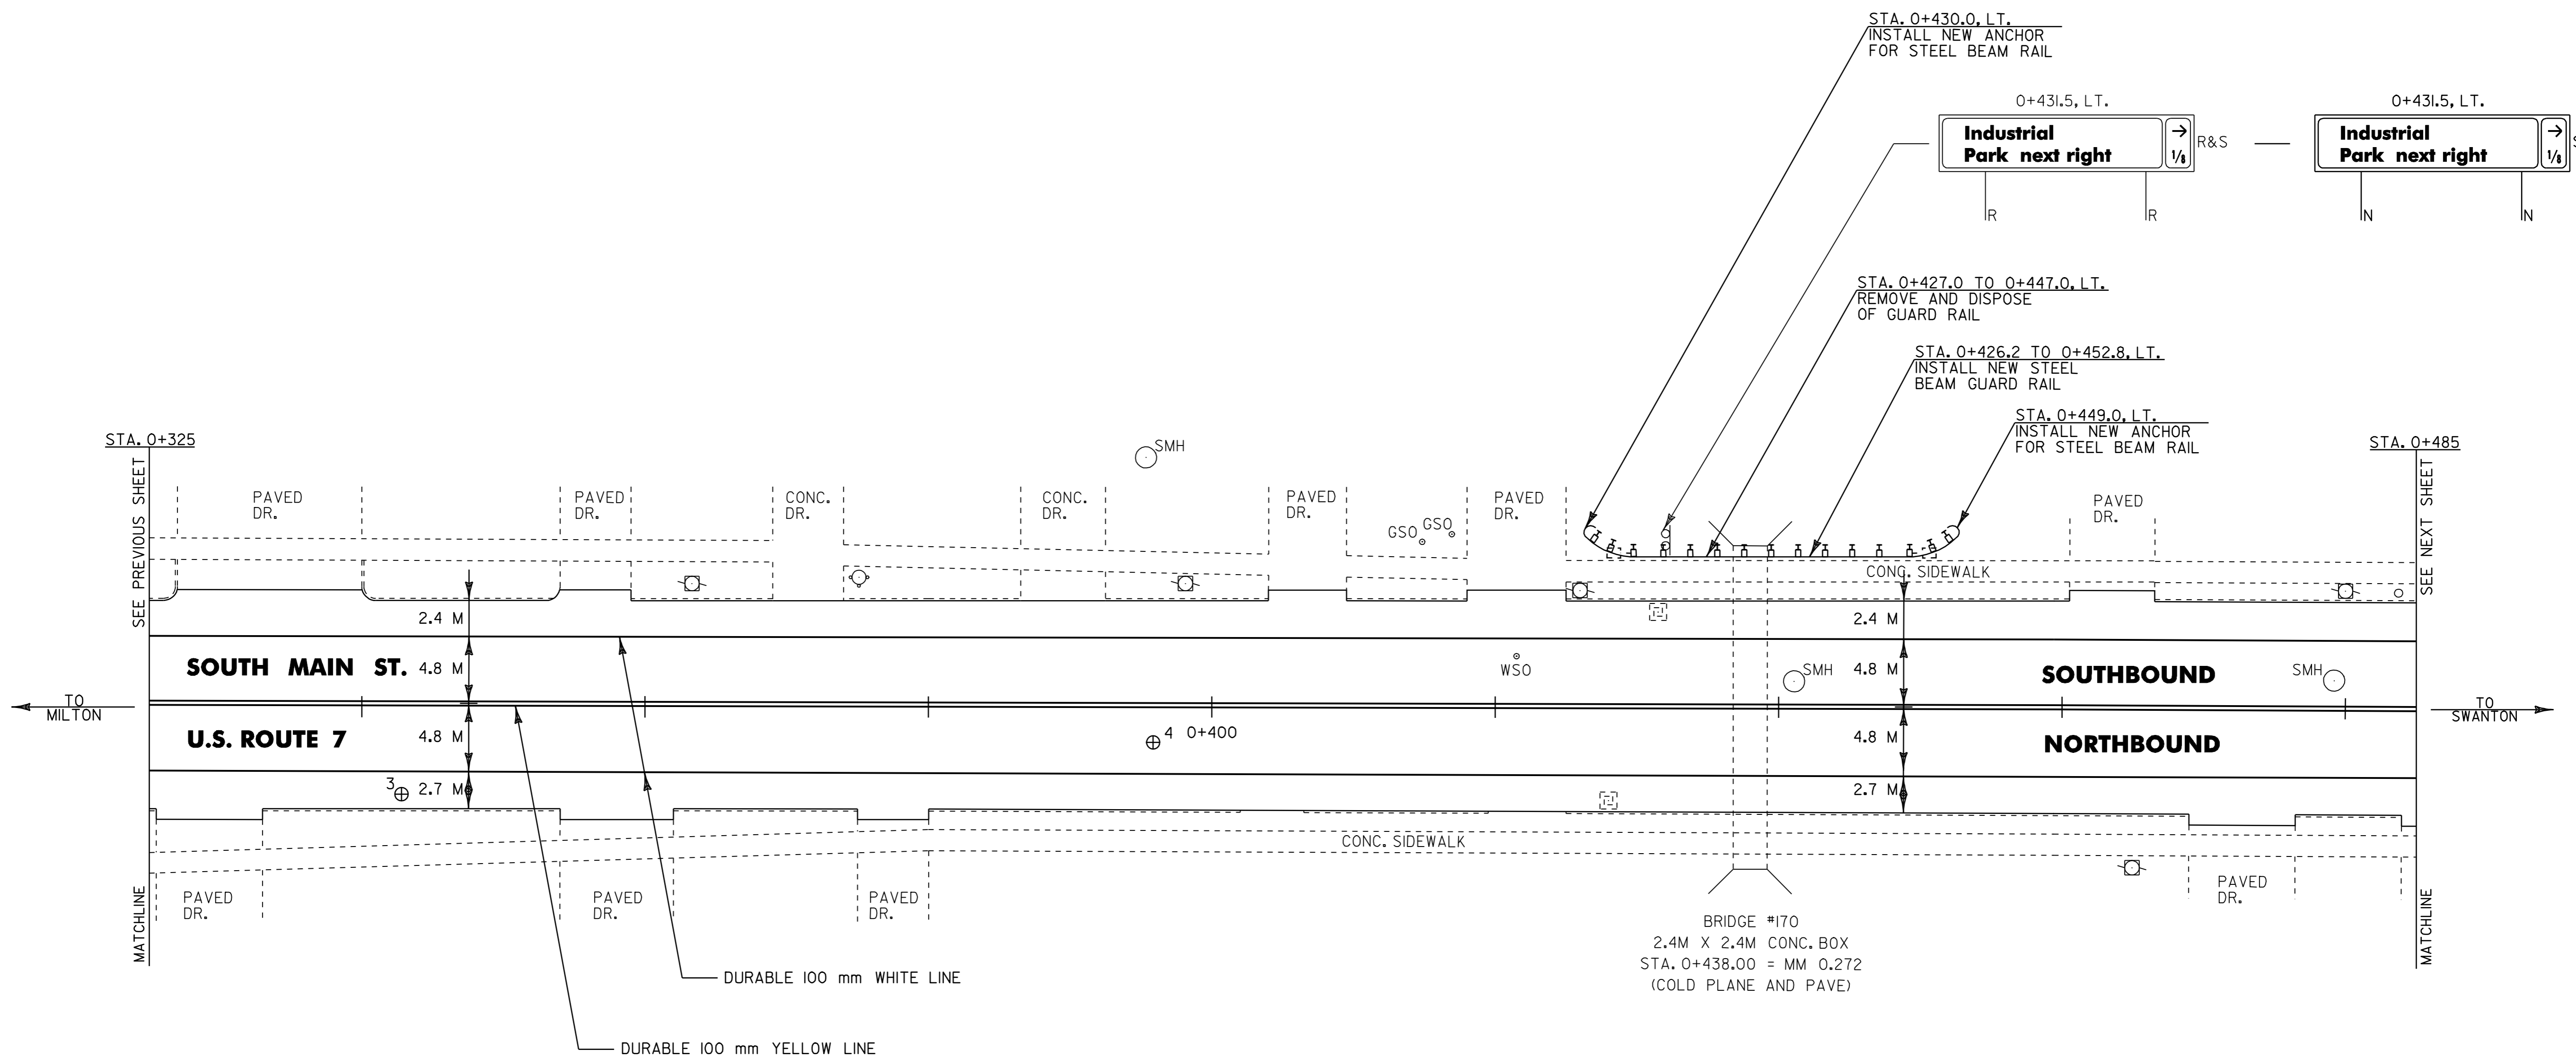

⊕ CORE LOCATION

PAVEMENT CORE DATA

CORE #	LOCATION	DEPTH (mm)	PCC
3	0+342.8, RT.	114	NO
4	0+395.9, RT.	108	NO

- NOTES: 1) ALL DIMENSIONS IN MILLIMETERS EXCEPT WHERE OTHERWISE INDICATED.
 2) ALL EXISTING SIGNS NOT SHOWN SHALL BE RETAINED AS DIRECTED BY THE RESIDENT ENGINEER.
 3) FOR ANY TOWN HIGHWAY OR STREET DETAILS, SEE VTrans STANDARD E-193M.

LAYOUT SHEET #3

PROJECT NAME: ST. ALBANS CITY
 PROJECT NUMBER: STP_9804(I)S
 FILE NAME: 2pave297d1502pd150.dgn PLOT DATE: 01-FEB-2006 07:4
 PROJECT LEADER: JLL DRAWN BY: D-H
 DESIGNED BY: D-H CHECKED BY:
 IPARM FILE NAME: pd150p03.i SHEET 21 OF 105



~~TEMPORARY & DURABLE 100 mm WHITE LINE~~
 STA. 0+485.0 TO 0+640.0, SOLID LT. & RT.
 (WITH EDGELINE BREAK FOR FREEBORN ST.)
 STA. 0+532.0, RT. (FREEBORN ST. EDGELINES)

~~TEMPORARY & DURABLE 100 mm YELLOW LINE~~
 STA. 0+485.0 TO 0+640.0, SOLID LT. & RT.
 (WITH CENTERLINE BREAK FOR FREEBORN ST.)
 STA. 0+532.0, DOUBLE SOLID RT. (FREEBORN ST.)

~~TEMPORARY & DURABLE CROSSWALK WITH DIAGONAL LINES (MOD.)~~
 STA. 0+532.0, RT. (FREEBORN ST.)

~~TEMPORARY & DURABLE 600 mm STOP BAR (TYPE ITAPE)~~
 STA. 0+532.0, RT. (FREEBORN ST.)

~~TEMPORARY & DURABLE LETTER OR SYMBOL (TYPE ITAPE)~~
 STA. 0+532.0, RT. - "STOP"




REMOVING SIGNS
 AS SHOWN - 2

REHABILITATION OF DI'S, CB'S OR MH'S - CLASS I
 STA. 0+503.0, LT. & RT. - DI'S
 STA. 0+546.0, LT. & RT. - DI'S
 STA. 0+623.1, RT. - DI
 STA. 0+628.0, LT. - DI
 STA. 0+503, CL

CHANGING ELEVATION OF SMH'S
 STA. 0+533.0, LT.
 STA. 0+620.0, LT.

CHANGING ELEV. OF DI'S
 STA. 0+503, LT.

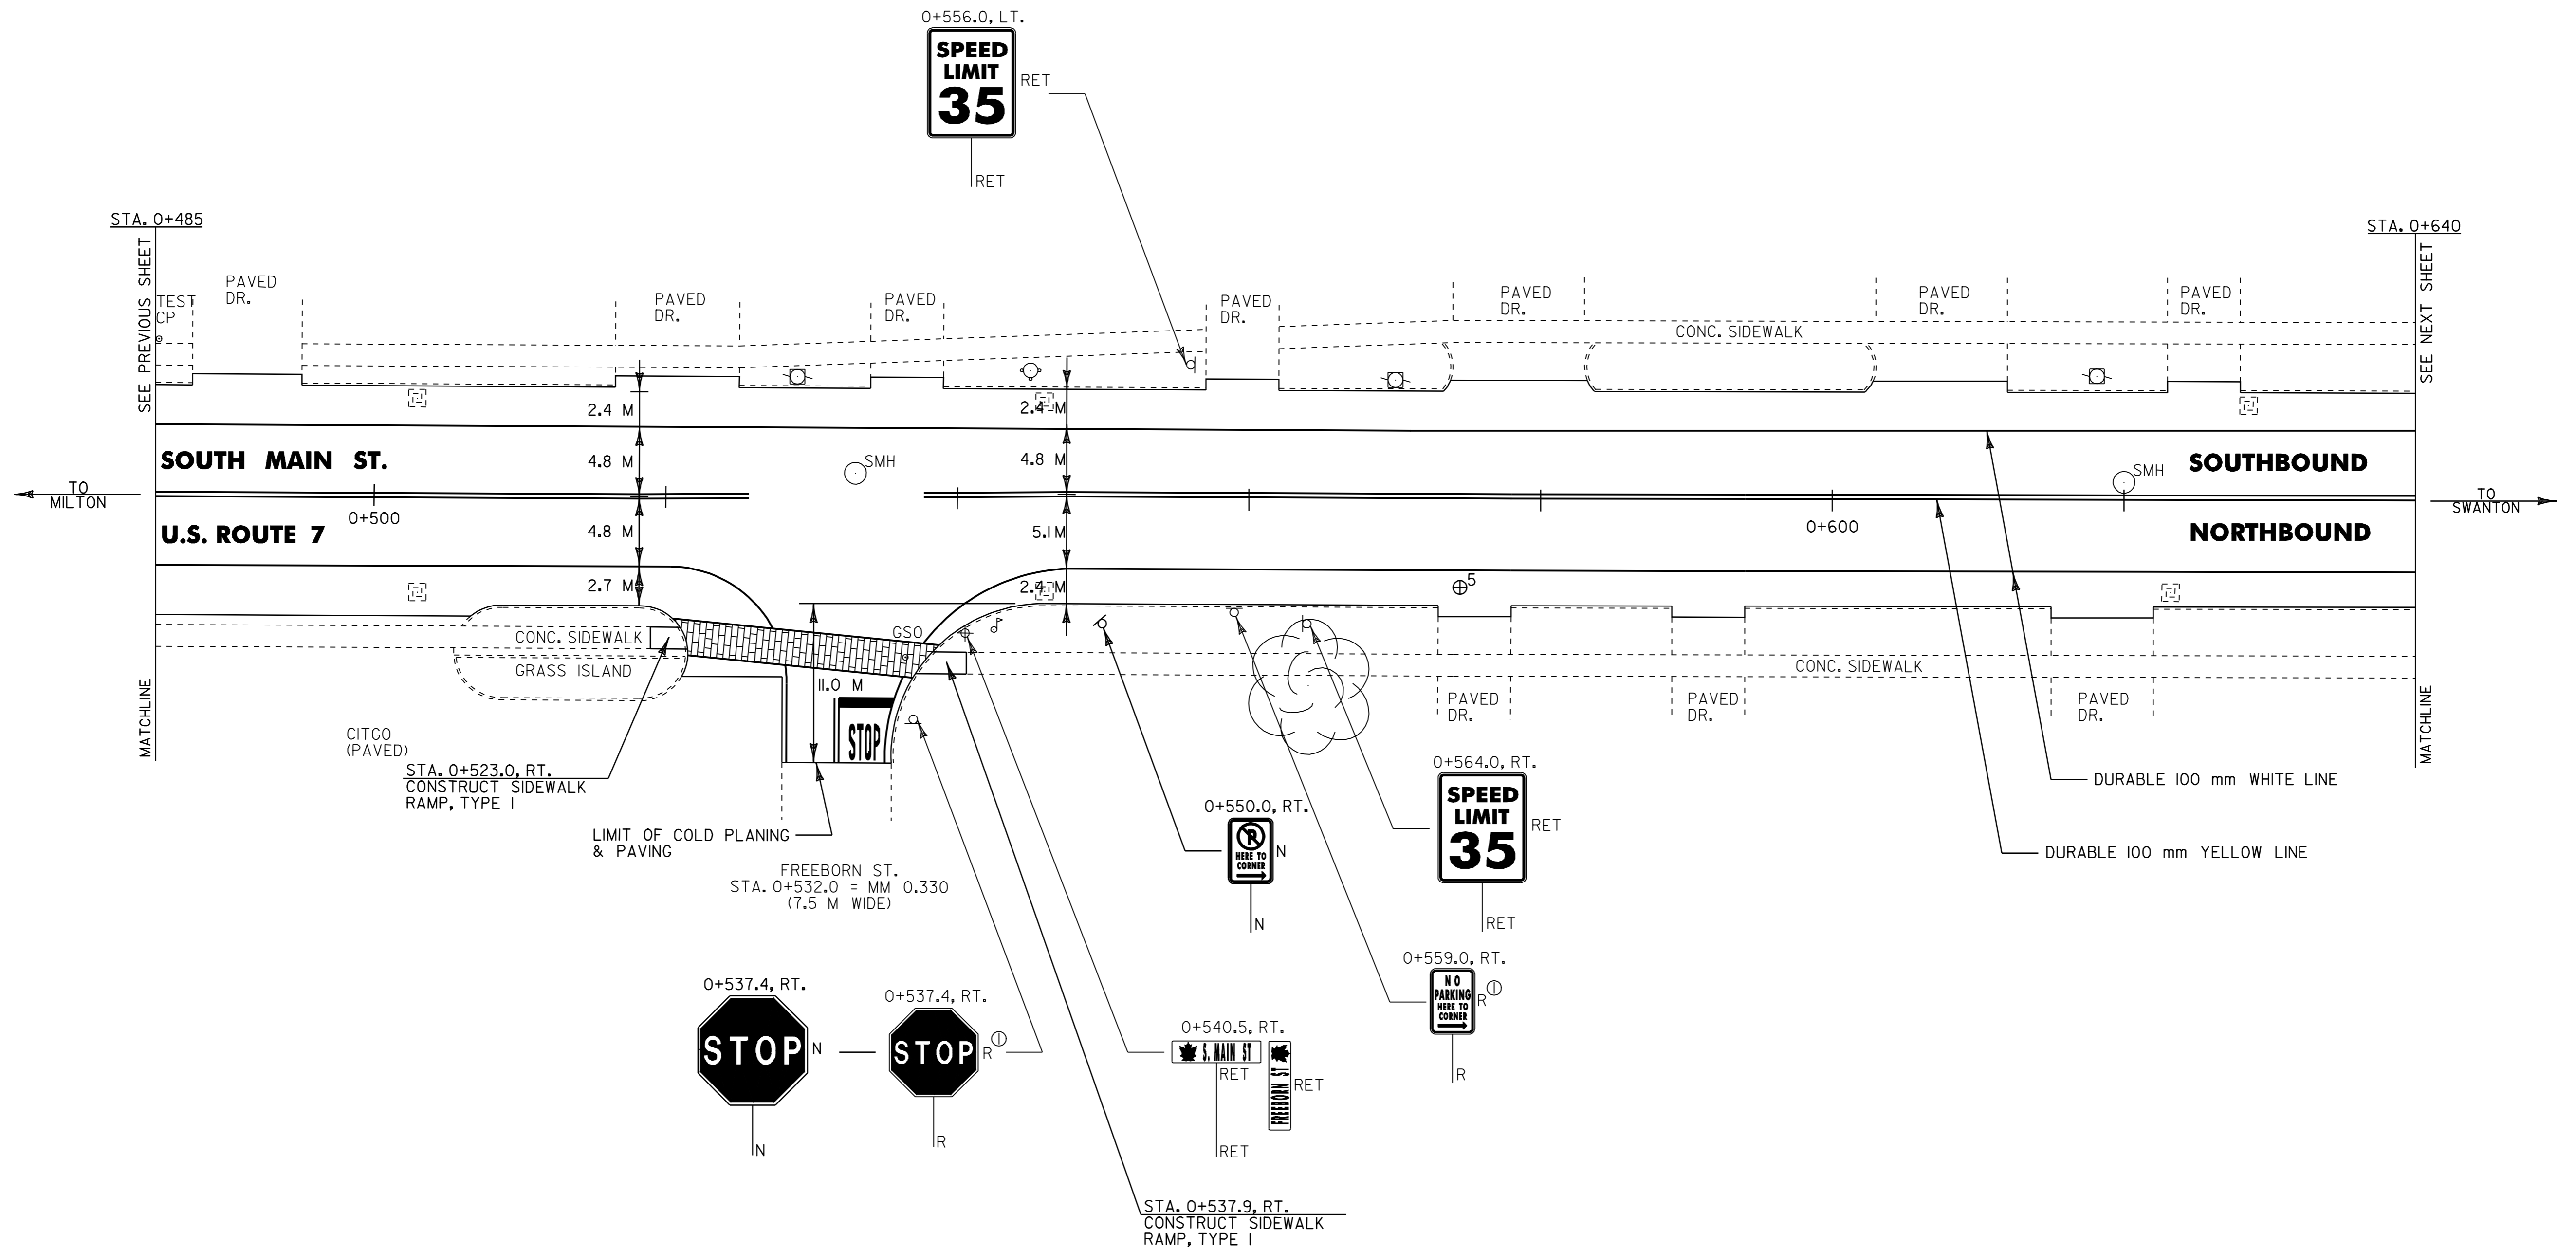

⊕ CORE LOCATION

PAVEMENT CORE DATA			
CORE #	LOCATION	DEPTH (mm)	PCC
5	0+574.5, RT.	191	NO

- NOTES: 1) ALL DIMENSIONS IN MILLIMETERS EXCEPT WHERE OTHERWISE INDICATED.
 2) ALL EXISTING SIGNS NOT SHOWN SHALL BE RETAINED AS DIRECTED BY THE RESIDENT ENGINEER.
 3) FOR ANY TOWN HIGHWAY OR STREET DETAILS, SEE VTrans STANDARD E-193M.

LAYOUT SHEET #4

PROJECT NAME: ST. ALBANS CITY
 PROJECT NUMBER: STP_9804(I)S
 FILE NAME: Zpqve297d150Zpd150.dgn
 PROJECT LEADER: JLL
 DESIGNED BY: D-H
 IPARM FILE NAME: pd150p04.i
 PLOT DATE: 01-FEB-2006 07:4
 DRAWN BY: D-H
 CHECKED BY:
 SHEET 22 OF 105



~~TEMPORARY & DURABLE 100 mm WHITE LINE~~
 STA. 0+640.0 TO 0+805.0, SOLID LT. & RT.
 STA. 0+720.0 TO 0+766.5, DOTTED RT.
 STA. 0+766.5 TO 0+805.0, SOLID RT. (LANE LINE)

TEMPORARY & DURABLE 100 mm YELLOW LINE
 STA. 0+640.0 TO 0+805.0, SOLID LT. & RT.


DURABLE LETTER OR SYMBOL (TYPE ITAPE)
 702 STA. 0+687.0, RT. - "SCHOOL"
 768 STA. 0+767.7, RT. - "ONLY"
 772 STA. 0+771.3, RT. - " "

~~TEMPORARY LETTER OR SYMBOL~~
~~STA. 0+687.0, RT. - "SCHOOL"~~
~~STA. 0+771.3, RT. - " "~~

REHABILITATION OF DI'S, CB'S OR MH'S - CLASS I
 STA. 0+686.0, LT. & RT. - DI'S

CHANGING ELEVATION OF SMH'S
 STA. 0+701.8, LT.
 STA. 0+754.0, LT.
~~STA. 0+757.0, RT.~~

TEMPORARY & DURABLE 200 mm WHITE LINE
 STA. 0+690.0 TO 0+740.0, SOLID RT. (DIAGONALS)
 REMOVING SIGNS
 AS SHOWN - 4

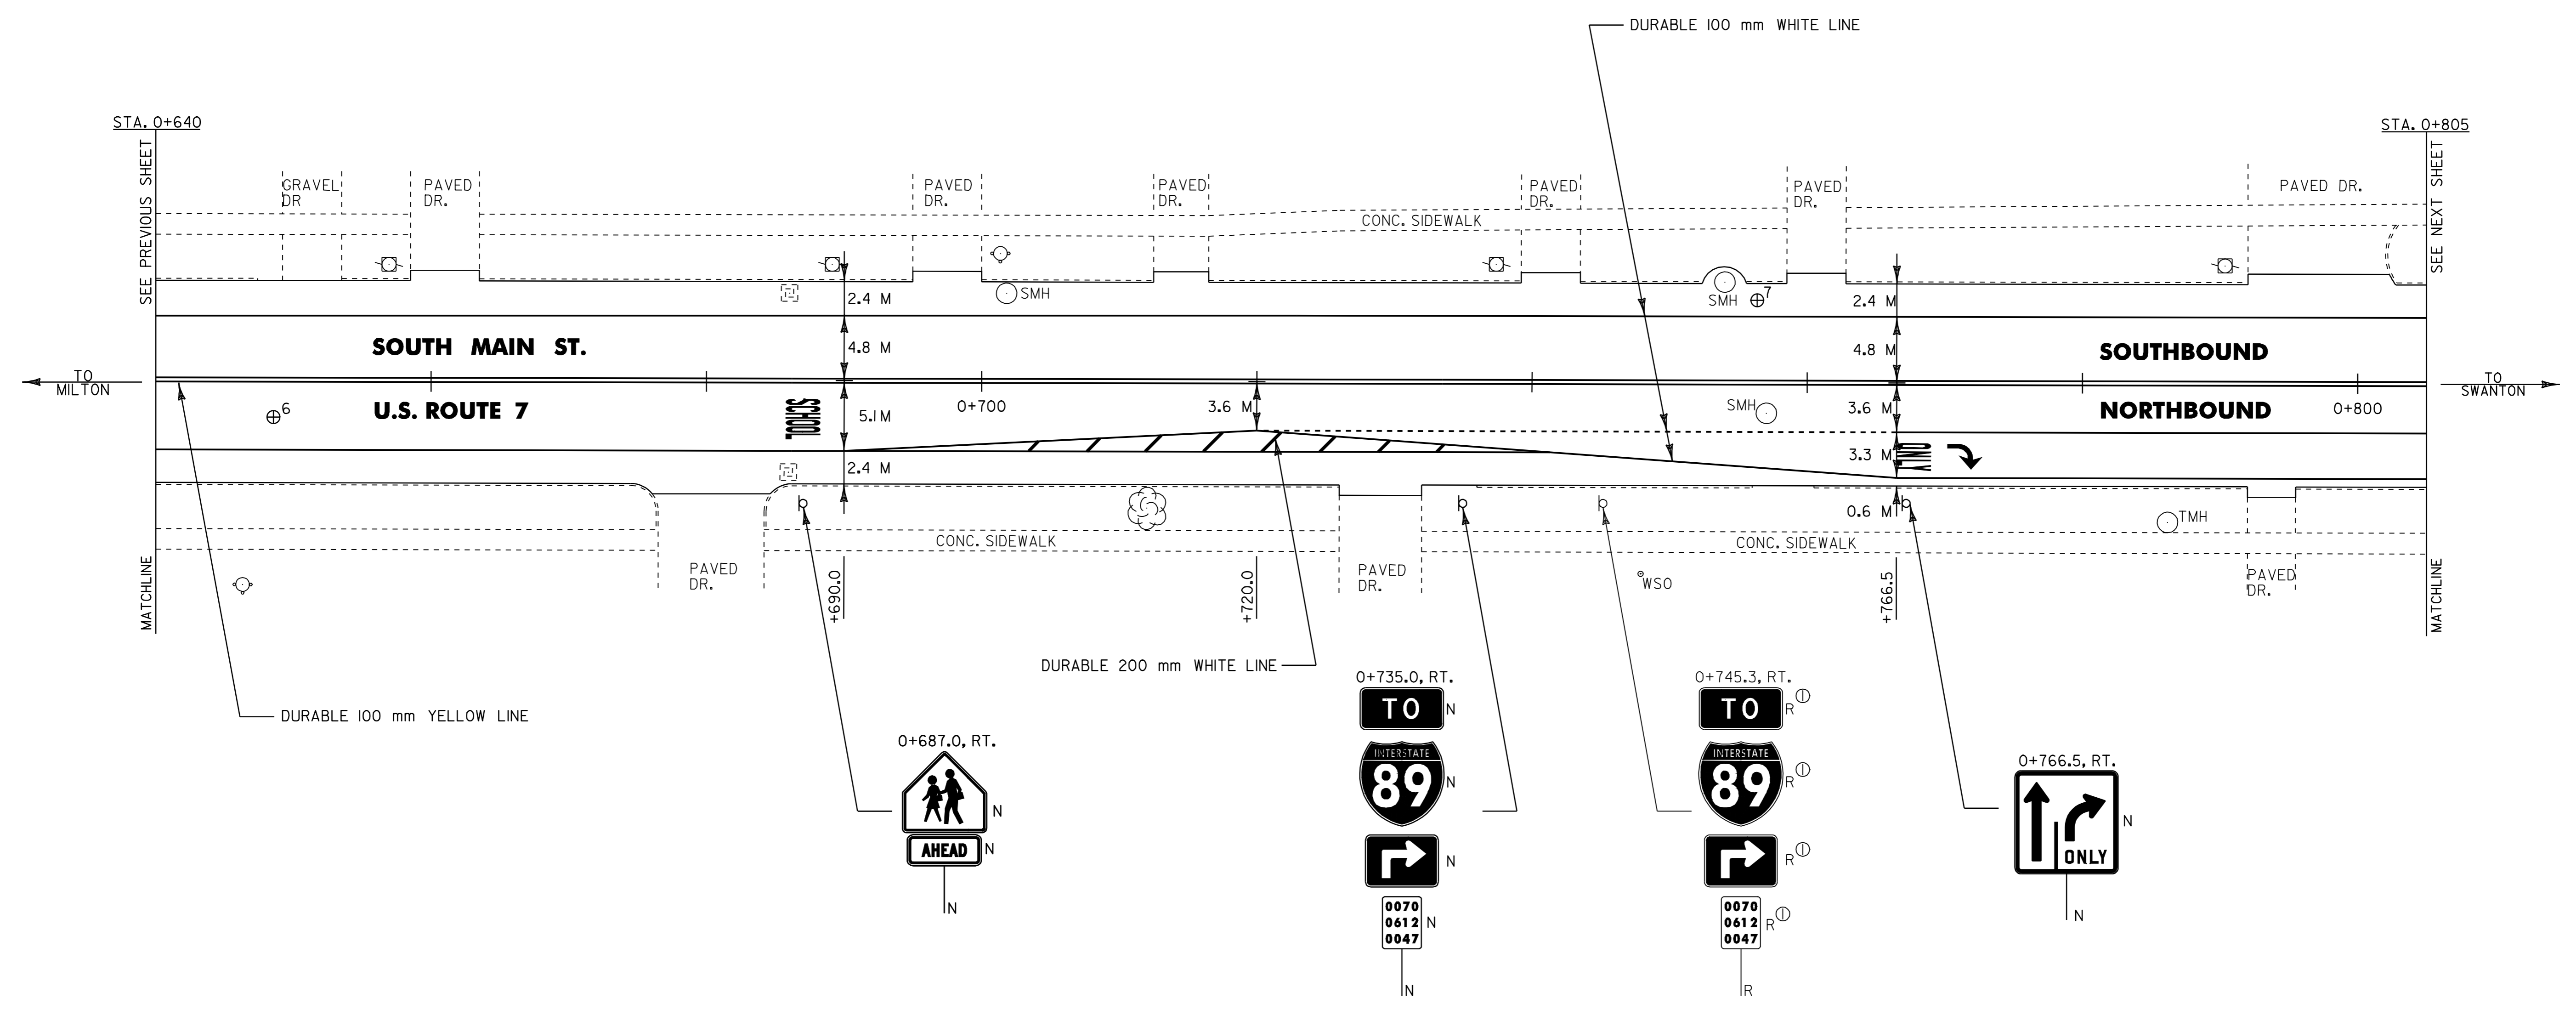

⊕ CORE LOCATION

PAVEMENT CORE DATA			
CORE #	LOCATION	DEPTH (mm)	PCC
6	0+648.6, RT.	178	NO
7	0+756.4, LT.	152	NO

NOTES: 1) ALL DIMENSIONS IN MILLIMETERS EXCEPT WHERE OTHERWISE INDICATED.
 2) ALL EXISTING SIGNS NOT SHOWN SHALL BE RETAINED AS DIRECTED BY THE RESIDENT ENGINEER.
 3) FOR ANY TOWN HIGHWAY OR STREET DETAILS, SEE VTrans STANDARD E-193M.

LAYOUT SHEET #5


PROJECT NAME: ST. ALBANS CITY
 PROJECT NUMBER: STP_9804(I)S
 FILE NAME: 2pave297d1502pd150.dgn PLOT DATE: 01-FEB-2006 07:
 PROJECT LEADER: JLL DRAWN BY: D-H
 DESIGNED BY: D-H CHECKED BY:
 IPARM FILE NAME: pd150p05.i SHEET 23 OF 105



NOTE: FOR NEW SIGNS AND ALL CONSTRUCTION NOTES, SEE NEXT SHEET.

REMOVING SIGNS AS SHOWN - 16

REMOVAL AND DISPOSAL OF GUARD RAIL
 STA. 0+847.0 TO 0+873.5, LT.
 STA. 0+881.5 TO 0+905.5, LT.
 STA. 0+908.0 TO 0+915.5, RT.
 STA. 0+917.5 TO 0+929.0, LT.

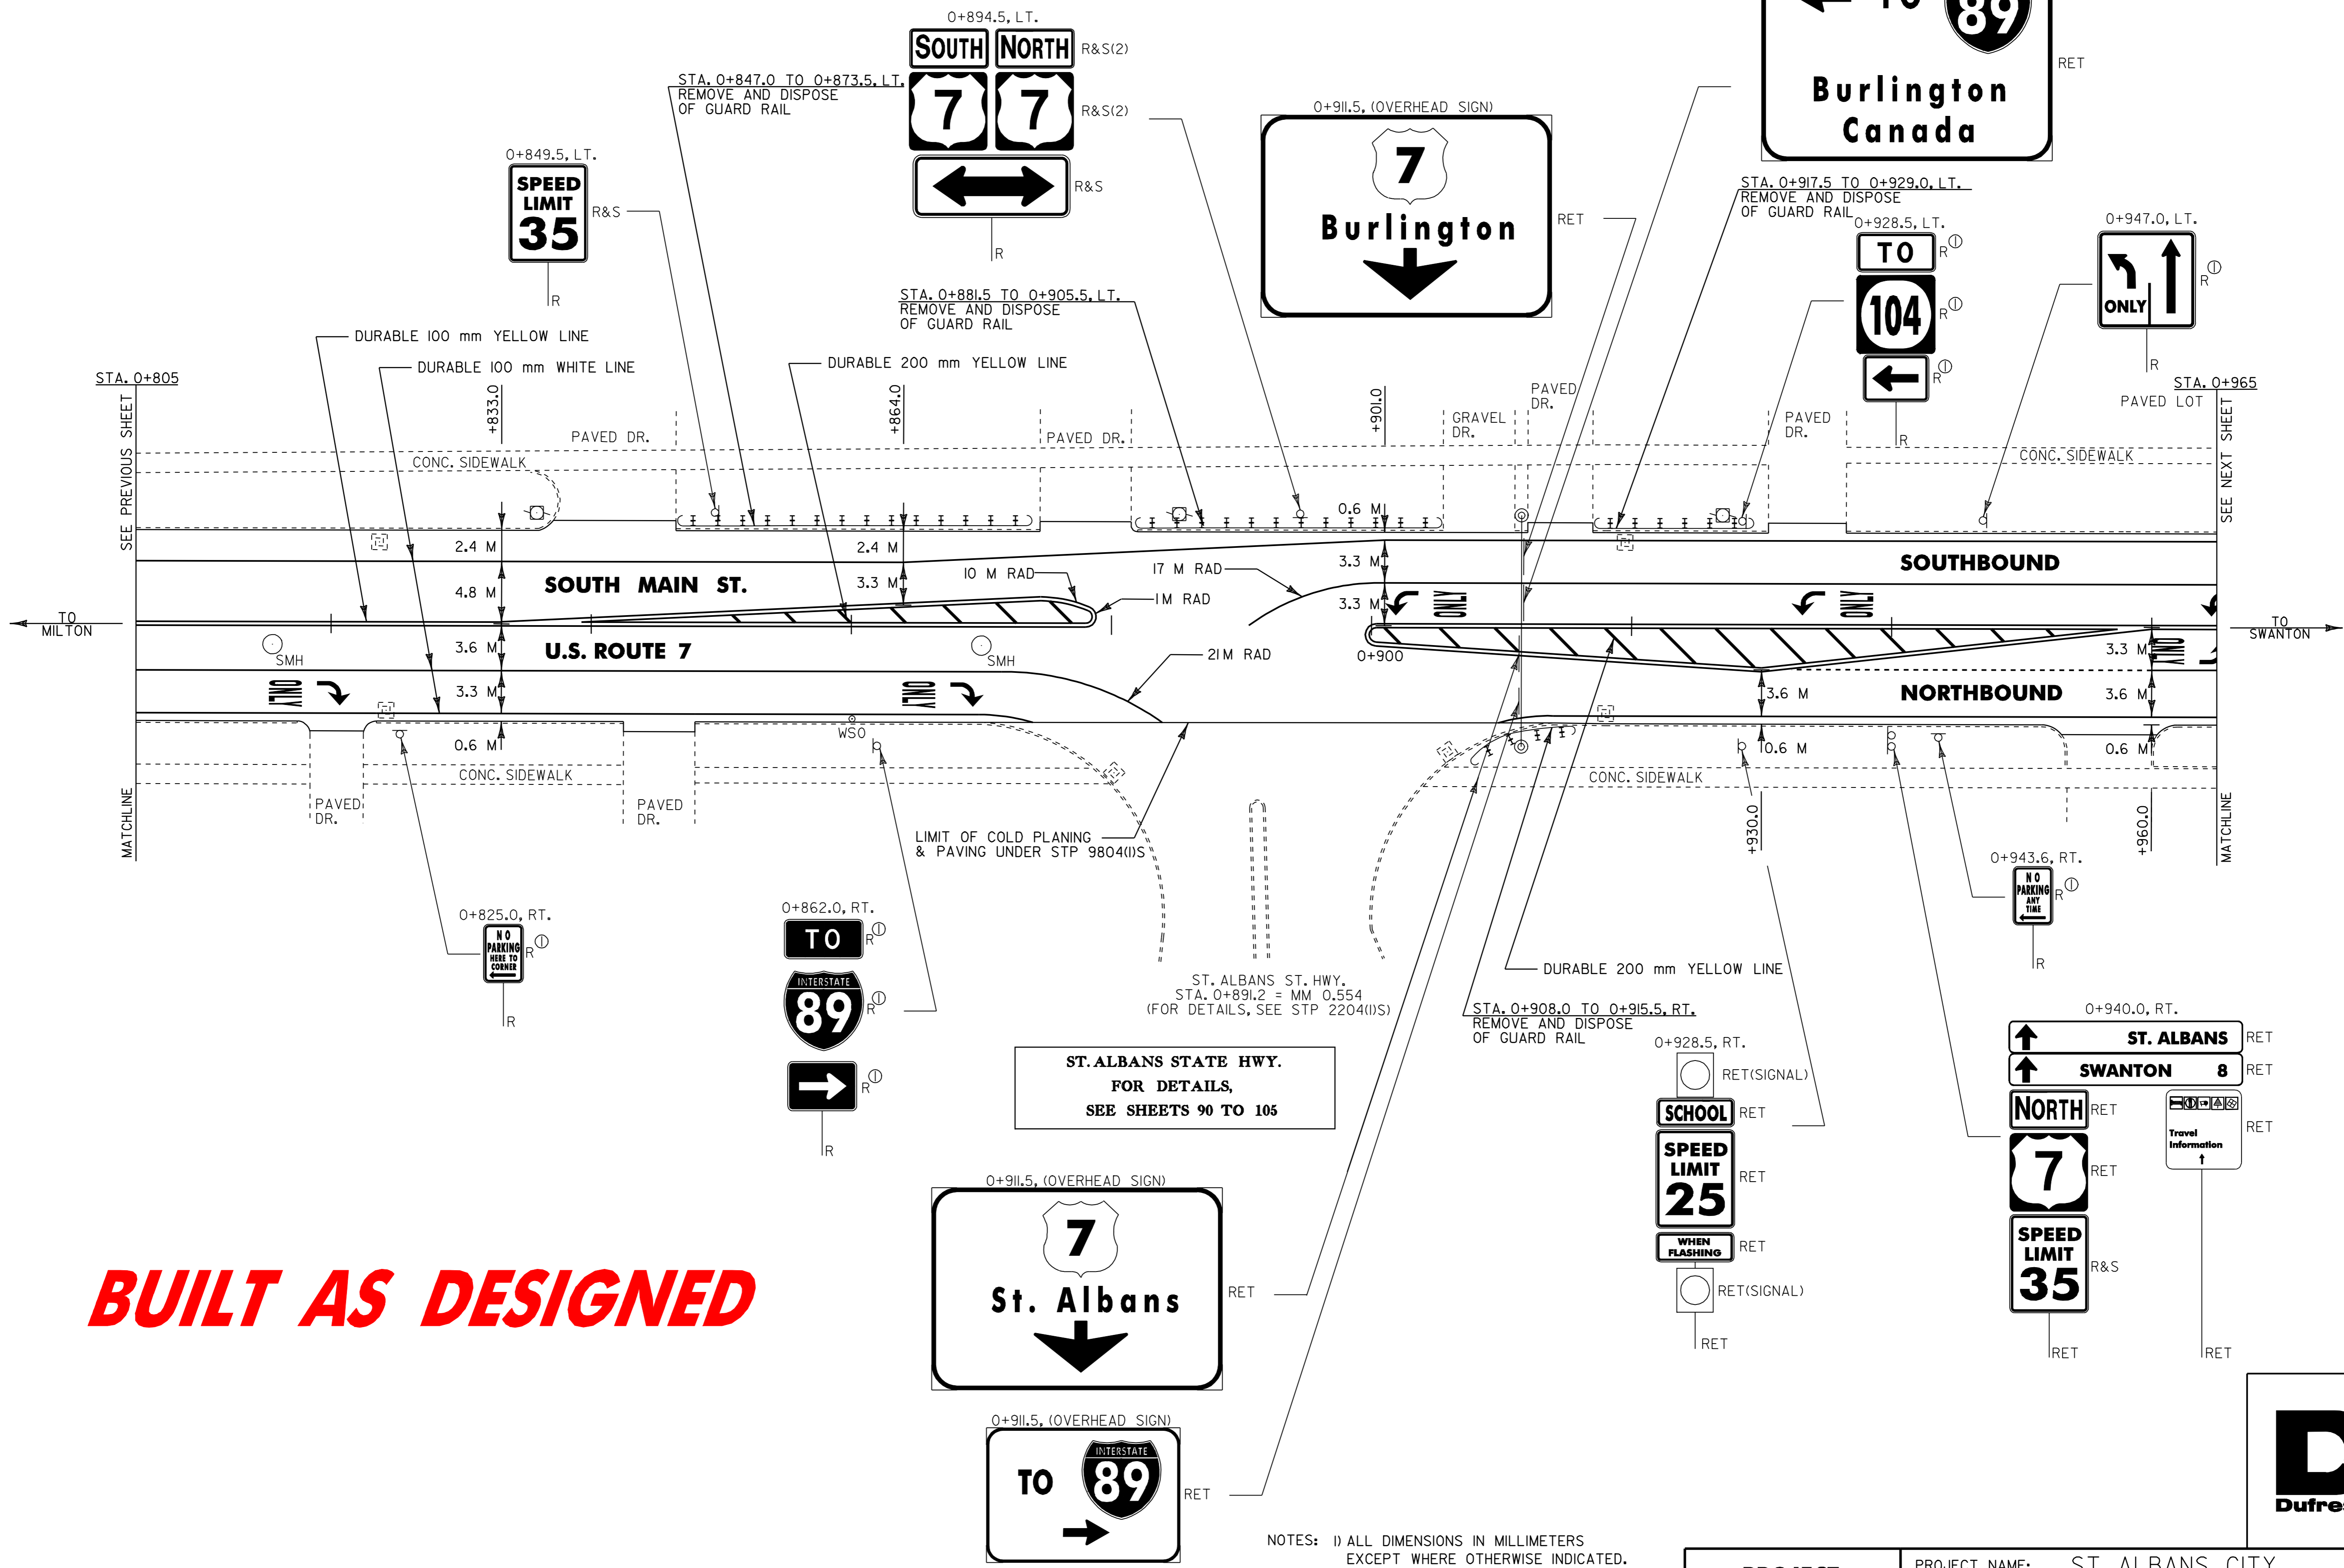

BUILT AS DESIGNED

ST. ALBANS STATE HWY. FOR DETAILS, SEE SHEETS 90 TO 105

- NOTES:
- 1) ALL DIMENSIONS IN MILLIMETERS EXCEPT WHERE OTHERWISE INDICATED.
 - 2) ALL EXISTING SIGNS NOT SHOWN SHALL BE RETAINED AS DIRECTED BY THE RESIDENT ENGINEER.
 - 3) FOR ANY TOWN HIGHWAY OR STREET DETAILS, SEE VTRANS STANDARD E-193M.

PROJECT LAYOUT #6A EXISTING SIGNS AND GUARD RAIL

PROJECT NAME:	ST. ALBANS CITY	PLOT DATE:	01-FEB-2006 07:4
PROJECT NUMBER:	STP_9804(I)S	DRAWN BY:	D-H
FILE NAME:	zpqve297d150zpd150.dgn	CHECKED BY:	
DESIGNED BY:	D-H	SHEET	_24_ OF 105
IPARM FILE NAME:	pd150p6a.i		



TEMPORARY & DURABLE 100 mm WHITE LINE
 STA. 0+805.0 TO 0+965.0, SOLID LT. & RT. (WITH EDGLINE BREAK FOR ST. ALBANS STATE HWY.)
 STA. 0+805.0 TO 0+884.0, SOLID RT. (LANE LINE)
 STA. 0+890.5 TO 0+965.0, SOLID LT. (LANE LINE)
 STA. 0+930.0 TO 0+960.0, DOTTED RT.
 STA. 0+960.0 TO 0+965.0, SOLID RT. (LANE LINE)

TEMPORARY & DURABLE 100 mm YELLOW LINE
 STA. 0+805.0 TO 0+833.0, SOLID LT. & RT.
 STA. 0+833.0 TO 0+880.0, DOUBLE SOLID LT. & RT.
 STA. 0+901.0 TO 0+960.0, DOUBLE SOLID LT. & RT.
 STA. 0+960.0 TO 0+965.0, SOLID LT. & RT.

TEMPORARY & DURABLE 200 mm YELLOW LINE
 STA. 0+833.0 TO 0+880.0, SOLID LT. (DIAGONALS)
 STA. 0+901.0 TO 0+960.0, SOLID RT. (DIAGONALS)

DURABLE LETTER OR SYMBOL (TYPE I TAPE)
 0+818 STA. 0+816.2, RT. - "ONLY"
 0+821 STA. 0+819.8, RT. - " " "
 0+867 STA. 0+865.2, RT. - "ONLY"
 0+870 STA. 0+868.8, RT. - " " "
 0+901 STA. 0+902.2, LT. - " " "
 0+912 STA. 0+905.8, LT. - "ONLY"
 0+937 STA. 0+933.2, LT. - " " "
 0+940 STA. 0+936.8, LT. - "ONLY"
 0+966 STA. 0+961.2, RT. - "ONLY"
 0+970 STA. 0+964.8, RT. - " " "

TEMPORARY LETTER OR SYMBOL
 0+820 STA. 0+819.8, RT. - " " "
 0+865 STA. 0+868.8, RT. - " " "
 0+900 STA. 0+902.2, LT. - " " "
 0+940 STA. 0+933.2, LT. - " " "
 STA. 0+964.8, RT. - " " "
 STA. 0+960, LT. & RT. - " " "


ERECTING SALVAGED SIGNS
 AS SHOWN - 7
 ADJUST ELEVATION OF VALVE BOX
 STA. 0+860.0, RT. - WSO
 CHANGING ELEVATION OF SMH'S
 STA. 0+815.5, RT.
 STA. 0+870.0, RT.

ANCHOR FOR STEEL BEAM RAIL
 STA. 0+885.8, LT.
 STA. 0+901.0, LT.
 STA. 0+922.2, LT.
 STA. 0+926.0, LT.

STEEL BEAM GUARD RAIL
 STA. 0+882.0 TO 0+904.8, LT.
 STA. 0+908.0 TO 0+915.6, RT.
 STA. 0+918.4 TO 0+929.8, LT.

REHABILITATION OF DI'S, CB'S OR MH'S - CLASS I
 STA. 0+824.0, LT. & RT. - DI'S
 STA. 0+918.0, RT. - DI
 STA. 0+919.5, LT. - DI

NOTE: FOR EXISTING SIGNS AND GUARD RAIL, SEE PREVIOUS SHEET.

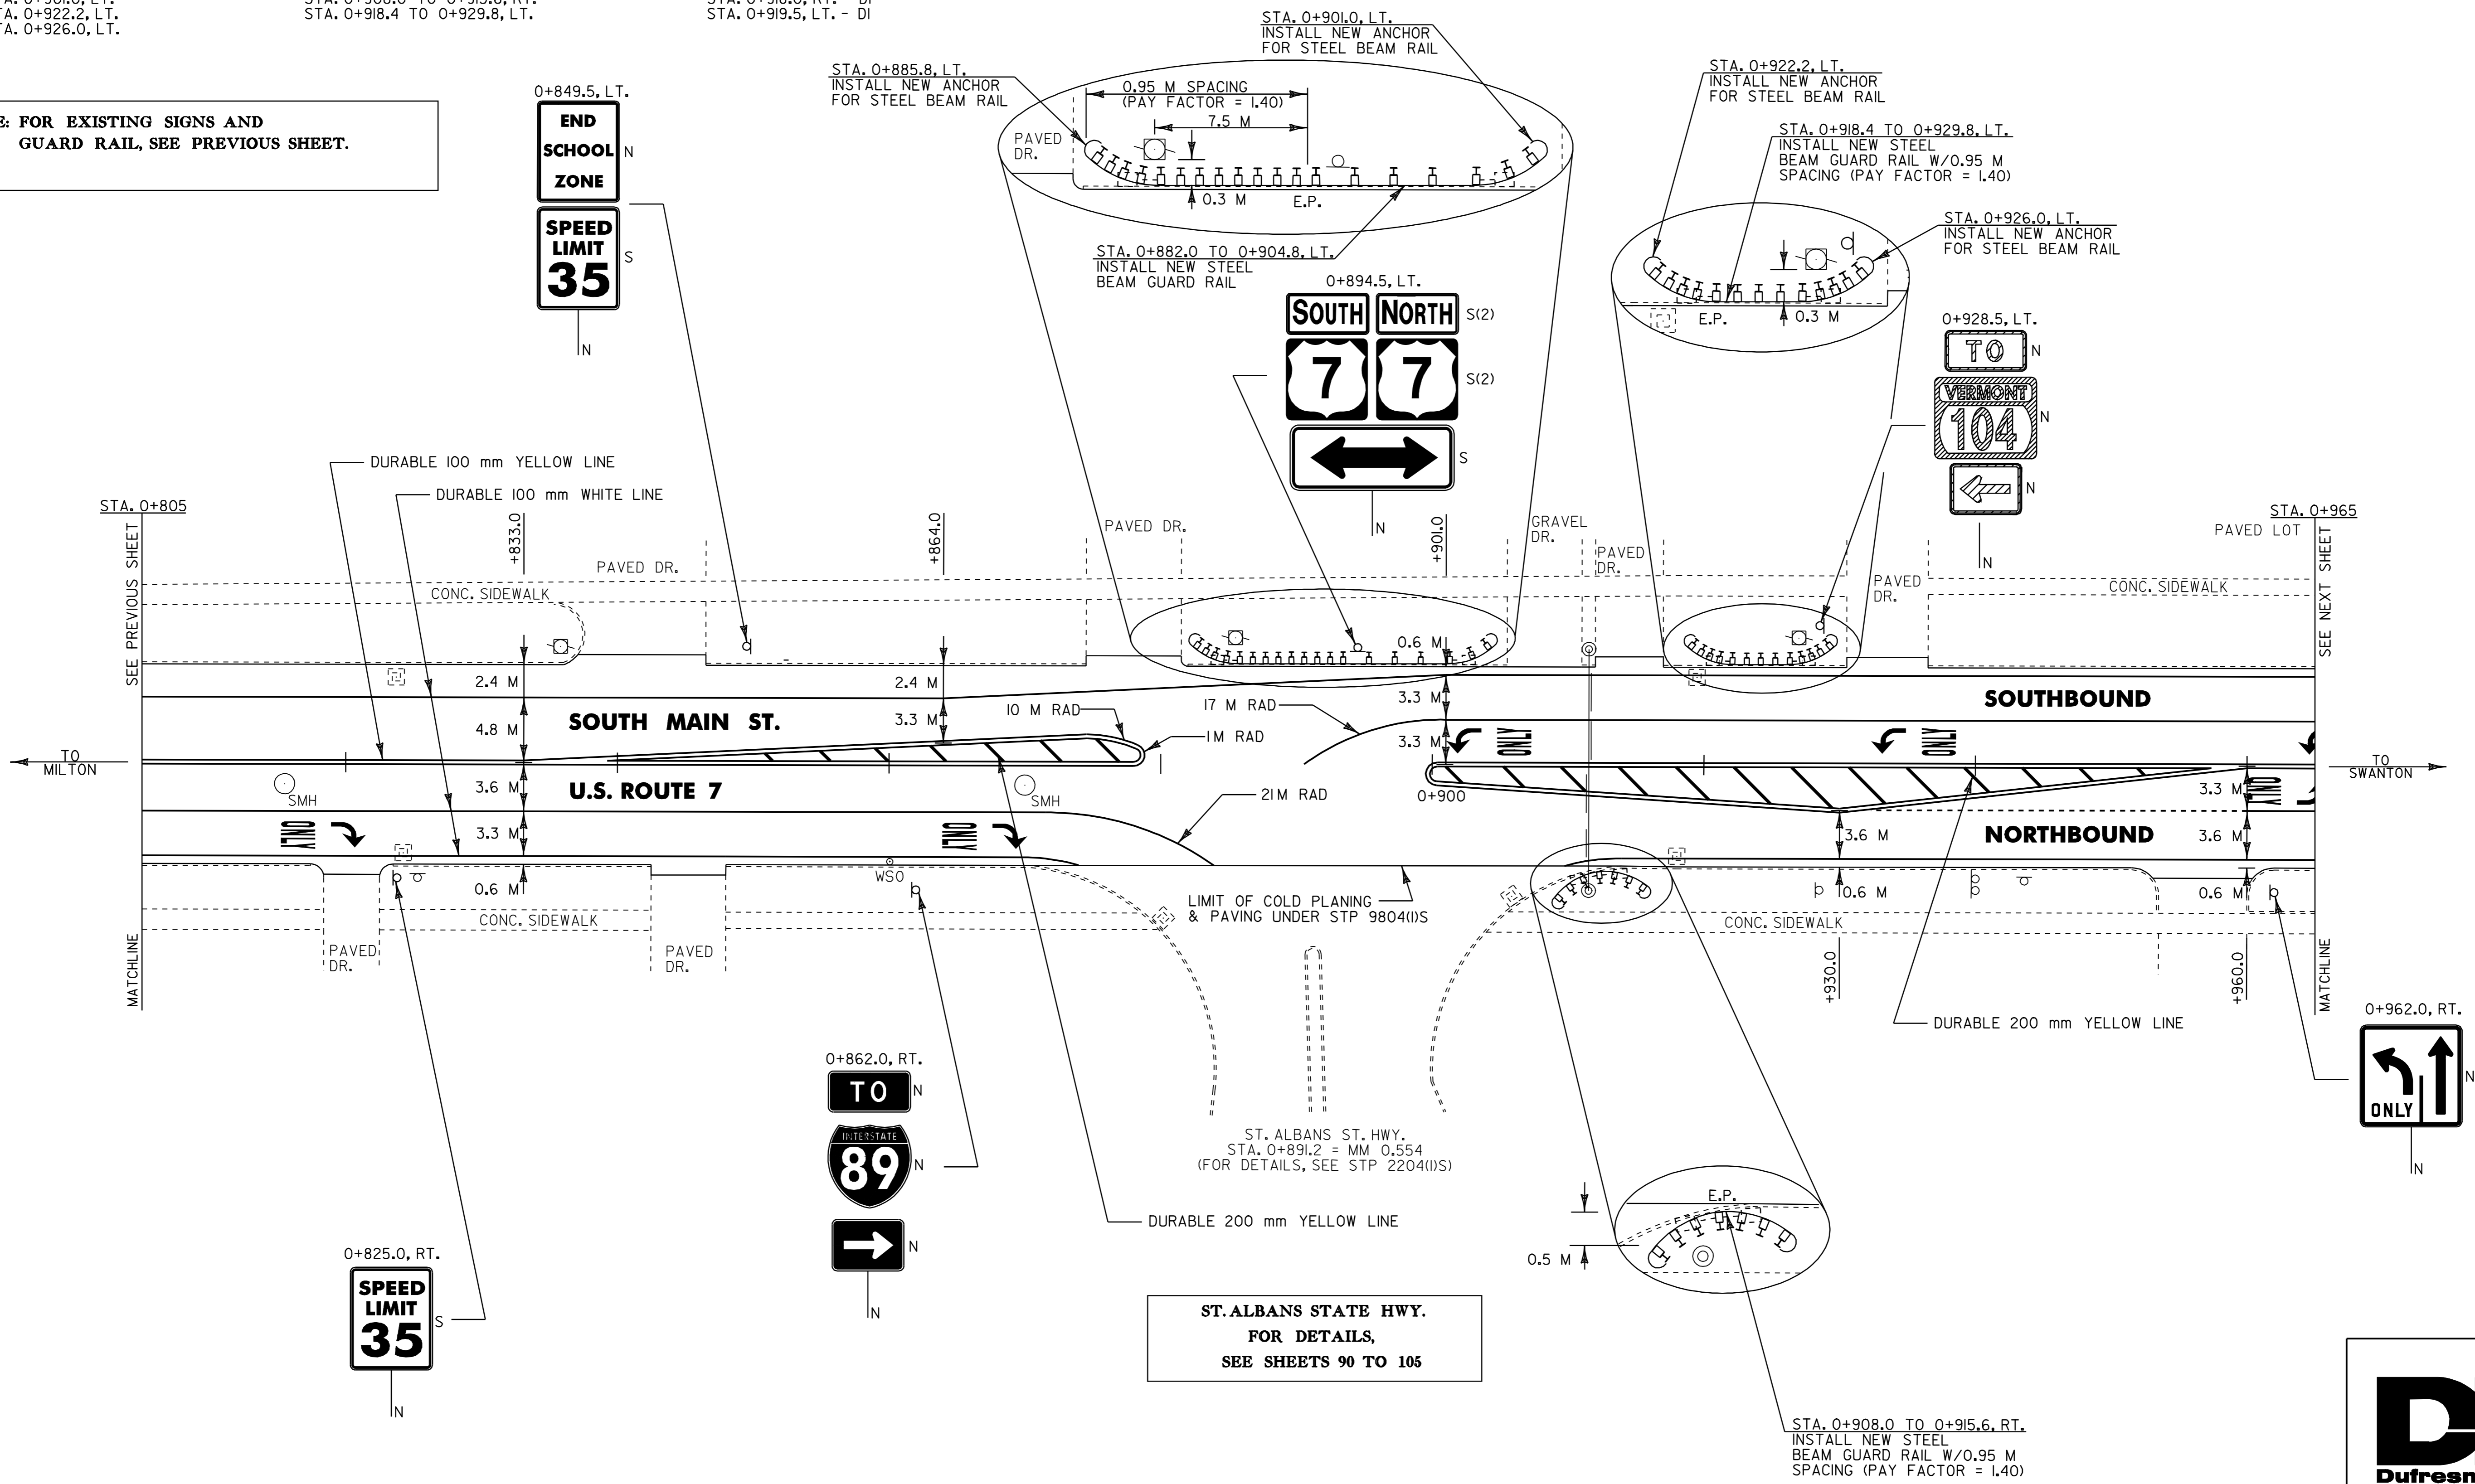

0+825.0, RT.
SPEED LIMIT 35

0+862.0, RT.
TO
89
→

ST. ALBANS STATE HWY.
FOR DETAILS,
SEE SHEETS 90 TO 105

0+962.0, RT.
ONLY
↑

- NOTES: 1) ALL DIMENSIONS IN MILLIMETERS EXCEPT WHERE OTHERWISE INDICATED.
 2) ALL EXISTING SIGNS NOT SHOWN SHALL BE RETAINED AS DIRECTED BY THE RESIDENT ENGINEER.
 3) FOR ANY TOWN HIGHWAY OR STREET DETAILS, SEE VTRANS STANDARD E-193M.

PROJECT LAYOUT #6B
PROPOSED SIGNS AND GUARD RAIL

PROJECT NAME: ST. ALBANS CITY	PLOT DATE: 01-FEB-2006 07:4
PROJECT NUMBER: STP_9804(I)S	DRAWN BY: D-H
FILE NAME: Z:\pave\97\d150\pd150.dgn	CHECKED BY:
PROJECT LEADER: JLL	SHEET 25 OF 105
DESIGNED BY: D-H	
IPARM FILE NAME: pd150p6b.i	

TEMPORARY & DURABLE 100 mm WHITE LINE
 STA. 0+965.0 TO I+120.0, SOLID LT.
 (PARKING SPACES & DIAGONALS)
 STA. 0+965.0 TO I+120.0, SOLID LT. & RT.
 (WITH EDGELINE BREAKS FOR NASON ST.
 & LOCKE TERR.)
 STA. 0+983.0, SOLID LT. (NASON ST. EDGLINES)
 STA. 0+965.0 TO 0+970.0, SOLID LT. (LANE LINE)
 STA. 0+965.0 TO 0+983.0, SOLID RT. (LANE LINE)
 STA. 0+993.0 TO I+060.0, SOLID LT. (LANE LINE)
 STA. I+060.0 TO I+100.0, DOTTED LT.
 STA. I+104.9, SOLID LT. (LOCKE TERR. EDGLINES)

TEMPORARY & DURABLE 100 mm YELLOW LINE
 STA. 0+965.0 TO I+120.0, SOLID LT. & RT.
 (WITH CENTERLINE BREAKS FOR NASON ST.,
 LOCKE TERR. & CROSSWALK)
 STA. 0+983.0, DOUBLE SOLID LT. (NASON ST.)
 STA. I+104.9, DOUBLE SOLID LT. (LOCKE TERR.)

DURABLE LETTER OR SYMBOL (TYPE I TAPE)
 0+966 STA. 0+965.2, LT. - "STOP"
 0+970 STA. 0+968.8, LT. - "ONLY"
 STA. 0+983.0, LT. - "STOP"
 I+005 STA. I+004.2, RT. - "ONLY"
 I+007 STA. I+004.8, RT. - "ONLY"
 I+060 STA. I+055.2, RT. - "STOP"
 I+063 STA. I+058.8, RT. - "ONLY"
 STA. I+104.9, LT. - "STOP"

TEMPORARY LETTER OR SYMBOL
 STA. 0+965.2, LT. - "STOP"
 STA. 0+983.0, LT. - "STOP"
 STA. I+001.2, RT. - "STOP"
 STA. I+055.2, RT. - "STOP"
 STA. I+104.9, LT. - "STOP"

REMOVING SIGNS
 AS SHOWN - 16

RECTING SALVAGED SIGNS
 AS SHOWN - 4



REHABILITATION OF DI'S, CB'S OR MH'S - CLASS I
 STA. I+013.5, LT. & RT. - DI'S
 STA. I+090.0, LT. & RT. - DI'S

CHANGING ELEVATION OF DI'S, CB'S OR MH'S
 STA. 0+982.0, LT. - MH

CHANGING ELEVATION OF SMH'S
 STA. I+028.0, LT.

ADJUST ELEVATION OF VALVE BOX
 STA. 0+979.0, RT. - WSO
 STA. 0+980.0, LT. - WSO
 STA. 0+982.0, LT. - WSO
 STA. I+102.0, LT. - WSO

PAINTED CURB
 IN NO-PARKING AREAS AS
 DIRECTED BY RESIDENT ENGINEER

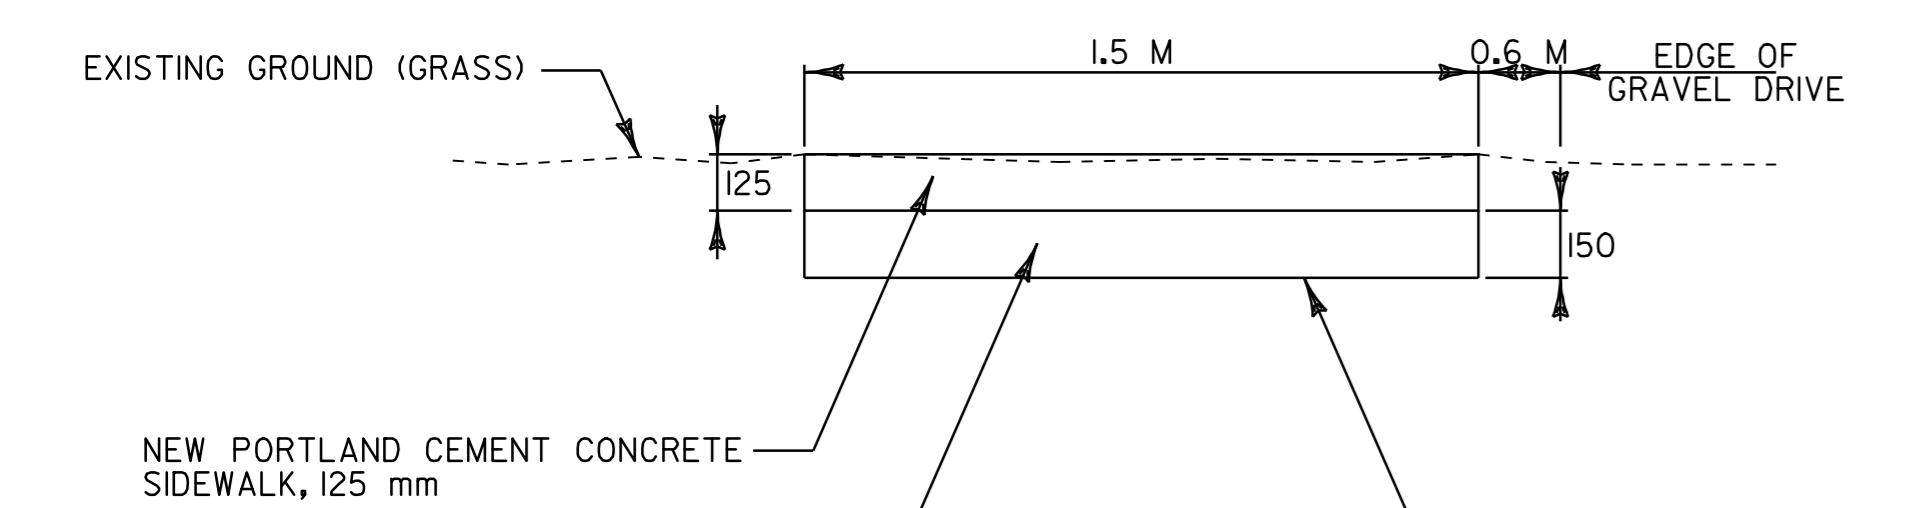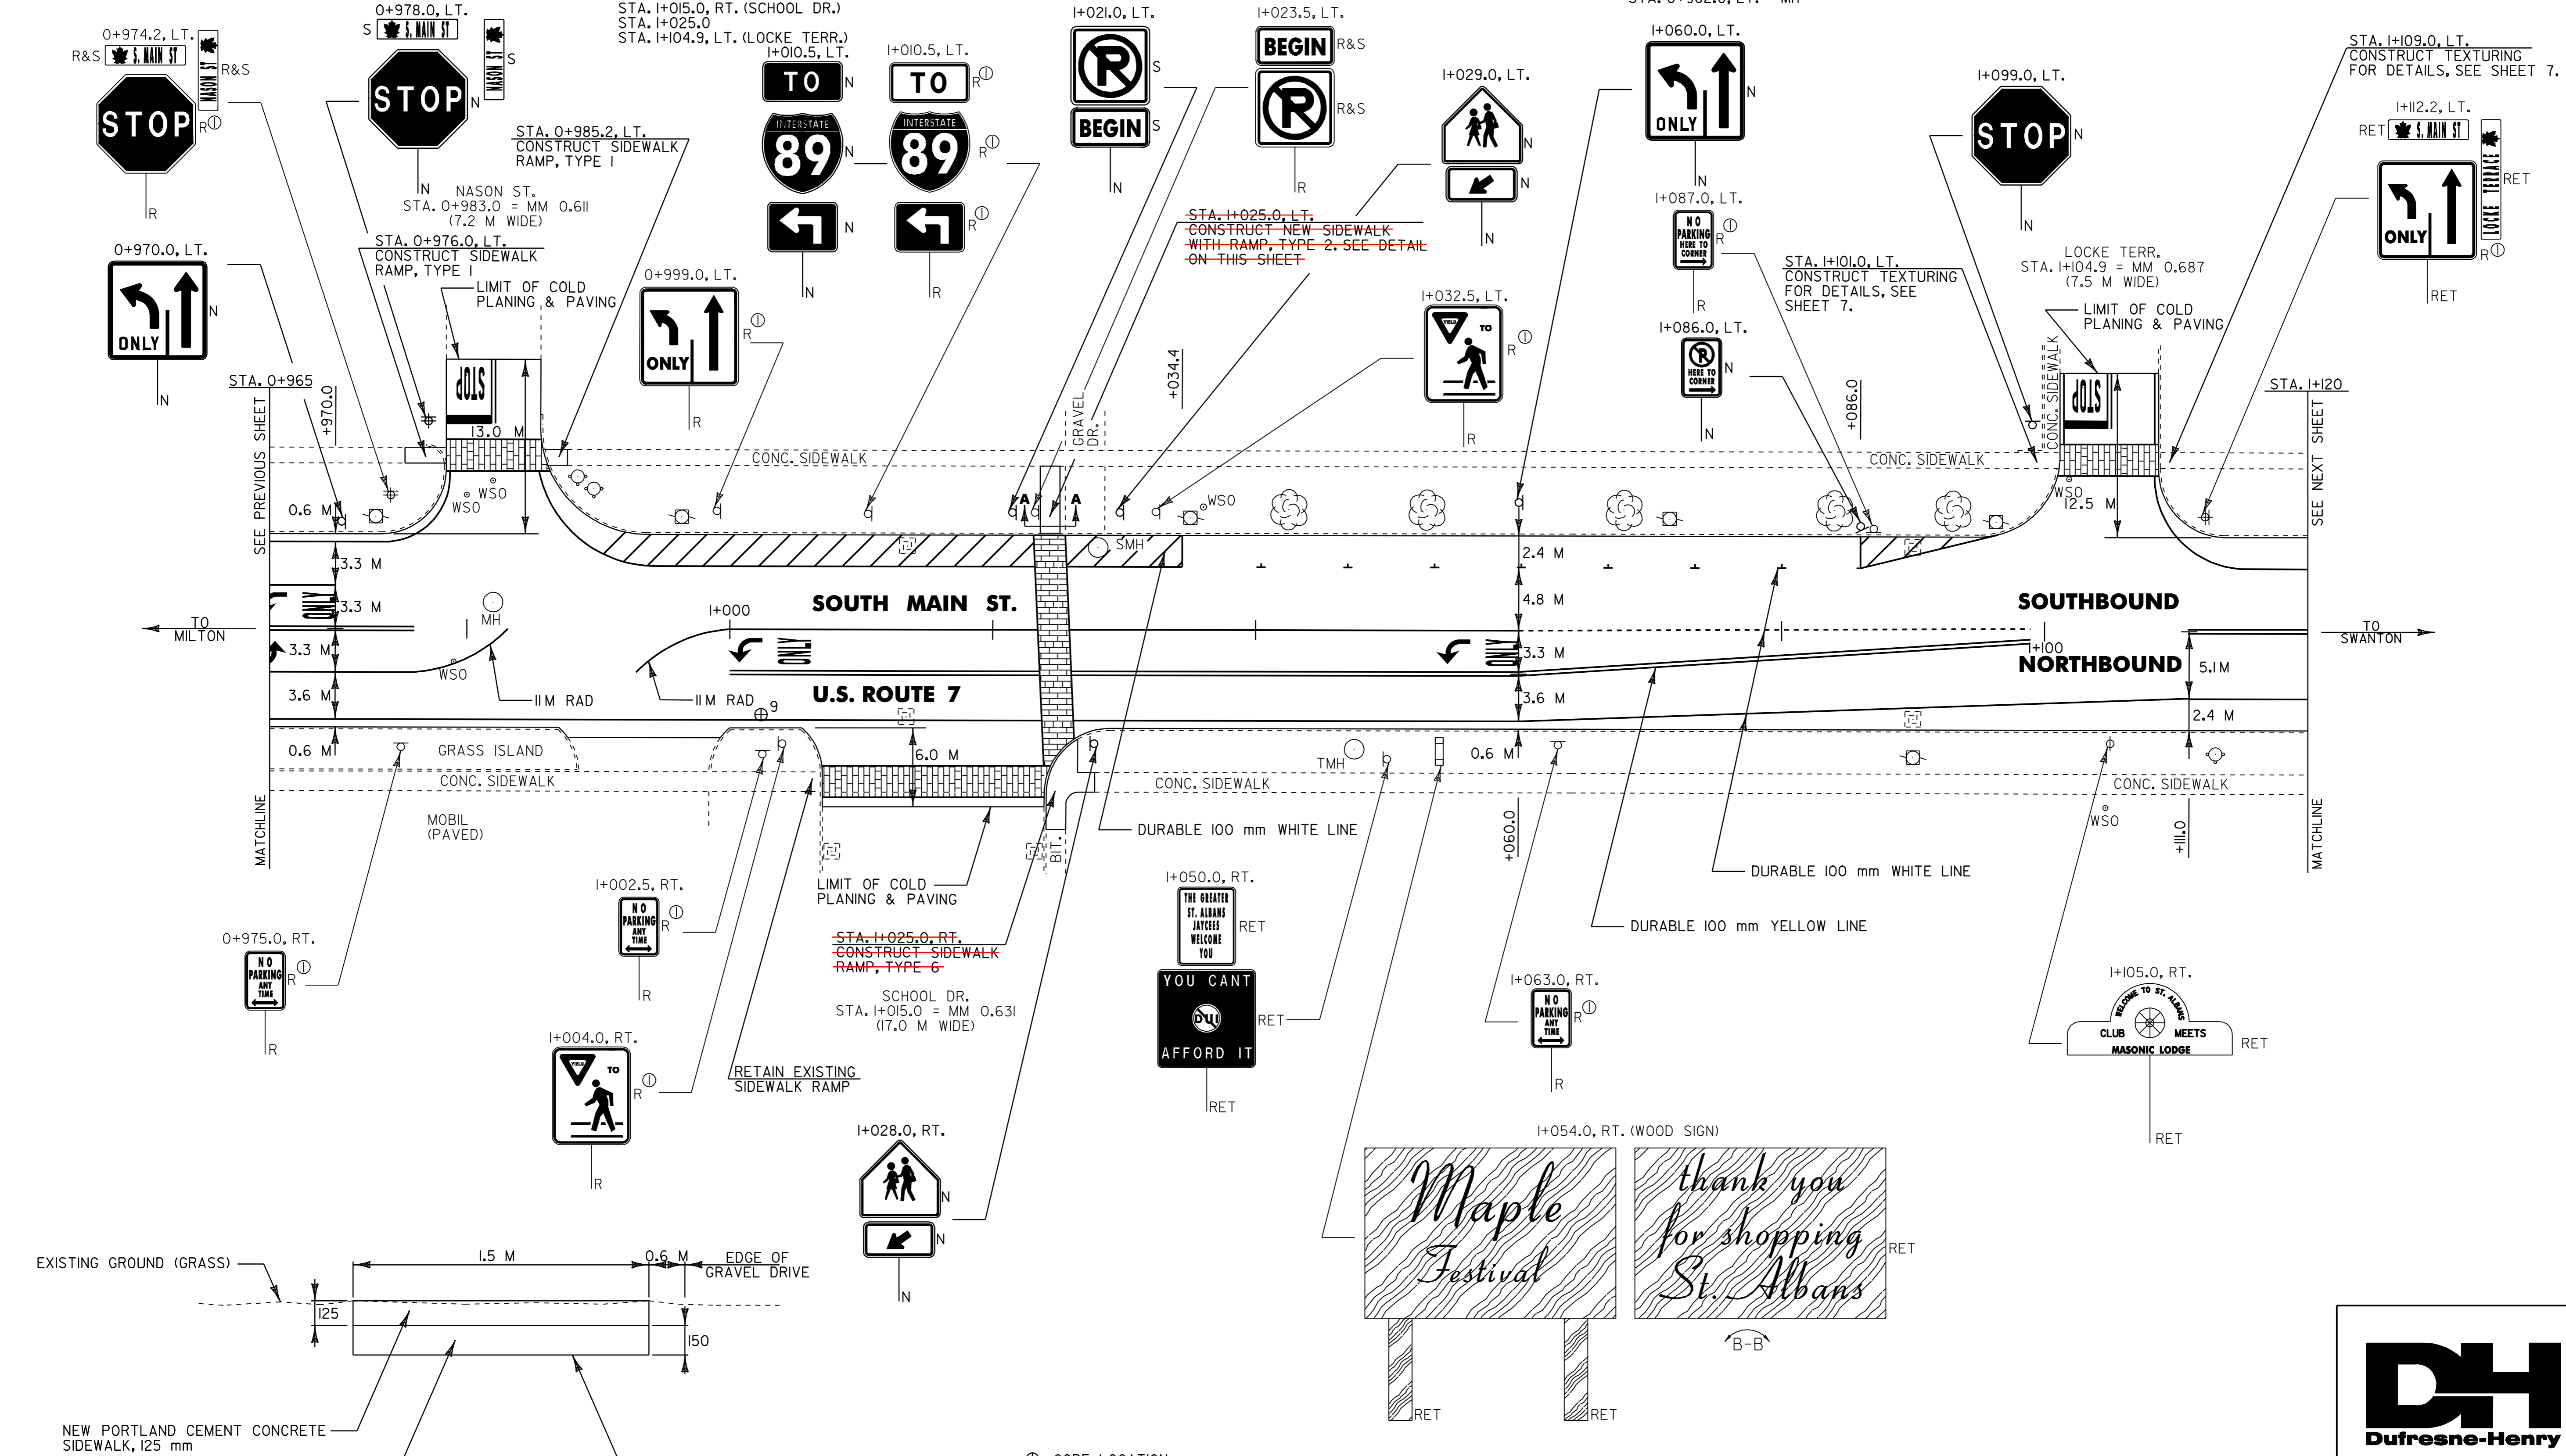

⊕ CORE LOCATION

PAVEMENT CORE DATA			
CORE #	LOCATION	DEPTH (mm)	PCC
9	I+102.4, RT.	152	NO

NOTES: 1) ALL DIMENSIONS IN MILLIMETERS EXCEPT WHERE OTHERWISE INDICATED.
 2) ALL EXISTING SIGNS NOT SHOWN SHALL BE RETAINED AS DIRECTED BY THE RESIDENT ENGINEER.
 3) FOR ANY TOWN HIGHWAY OR STREET DETAILS, SEE VTRANS STANDARD E-193M.

LAYOUT SHEET #7

PROJECT NAME: ST. ALBANS CITY
 PROJECT NUMBER: STP_9804(1)S
 FILE NAME: Z:\pave\297d150\pd150.dgn
 PROJECT LEADER: JLL
 DESIGNED BY: D-H
 IPARM FILE NAME: pd150p07.i
 PLOT DATE: 01-FEB-2006 07:48
 DRAWN BY: D-H
 CHECKED BY:
 SHEET 26 OF 105

~~TEMPORARY & DURABLE 100 mm WHITE LINE~~
 STA. I+240.0 TO I+260.0, RT. (PARKING SPACES & DIAGONALS)
 STA. I+120.0 TO I+260.0, SOLID LT. & RT. (WITH EDGELINE BREAKS FOR CROSSWALK & GILMAN AVE.)

~~TEMPORARY & DURABLE 100 mm YELLOW LINE~~
 STA. I+120.0 TO I+260.0, SOLID LT. & RT. (WITH CENTERLINE BREAKS FOR CROSSWALK & GILMAN AVE.)
 STA. I+236.0, DOUBLE SOLID RT. (GILMAN AVE.)

~~TEMPORARY & DURABLE CROSSWALK WITH DIAGONAL LINES (MOD.)~~
 STA. I+229.0
 STA. I+236.0, RT. (GILMAN AVE.)

~~REMOVING SIGNS~~
 AS SHOWN - 7

~~ERECTING SALVAGED SIGNS~~
 AS SHOWN - 2

~~ADJUST ELEVATION OF VALVE BOX~~
 STA. I+146.5, RT. - WSO
 STA. I+148.0, RT. - WSO
 STA. I+149.0, RT. - WSO
~~STA. I+181.0, RT. - WSO~~
 STA. I+182.0, RT. - WSO (2)
 STA. I+183.0, RT. - WSO
~~STA. I+233.0, RT. - WSO~~


~~REHABILITATION OF DI'S, CB'S OR MH'S - CLASS I~~
 STA. I+142.5, LT. - DI
 STA. I+157.5, RT. - DI
 STA. I+160.0, LT. - DI
 STA. I+212.0, LT. & RT. - DI'S
 STA. I+242.0, RT. - DI

~~CHANGING ELEVATION OF DI'S, CB'S OR MH'S~~
 STA. I+224.0, LT. - MH
 STA. I+231.0, RT. - DRAIN MH
 STA. I+235.0, RT. - MH

~~PAINTED CURB~~
~~IN NO-PARKING AREAS AS DIRECTED BY RESIDENT ENGINEER~~

~~TEMPORARY & DURABLE LETTER OR SYMBOL (TYPE ITAPE)~~
 STA. I+236.0, RT. - 'STOP'
 260 STA. I+255.5, LT. - 'SCHOOL'

~~TEMPORARY & DURABLE 600 mm STOP BAR (TYPE ITAPE)~~
 STA. I+236.0, RT. (GILMAN AVE.)

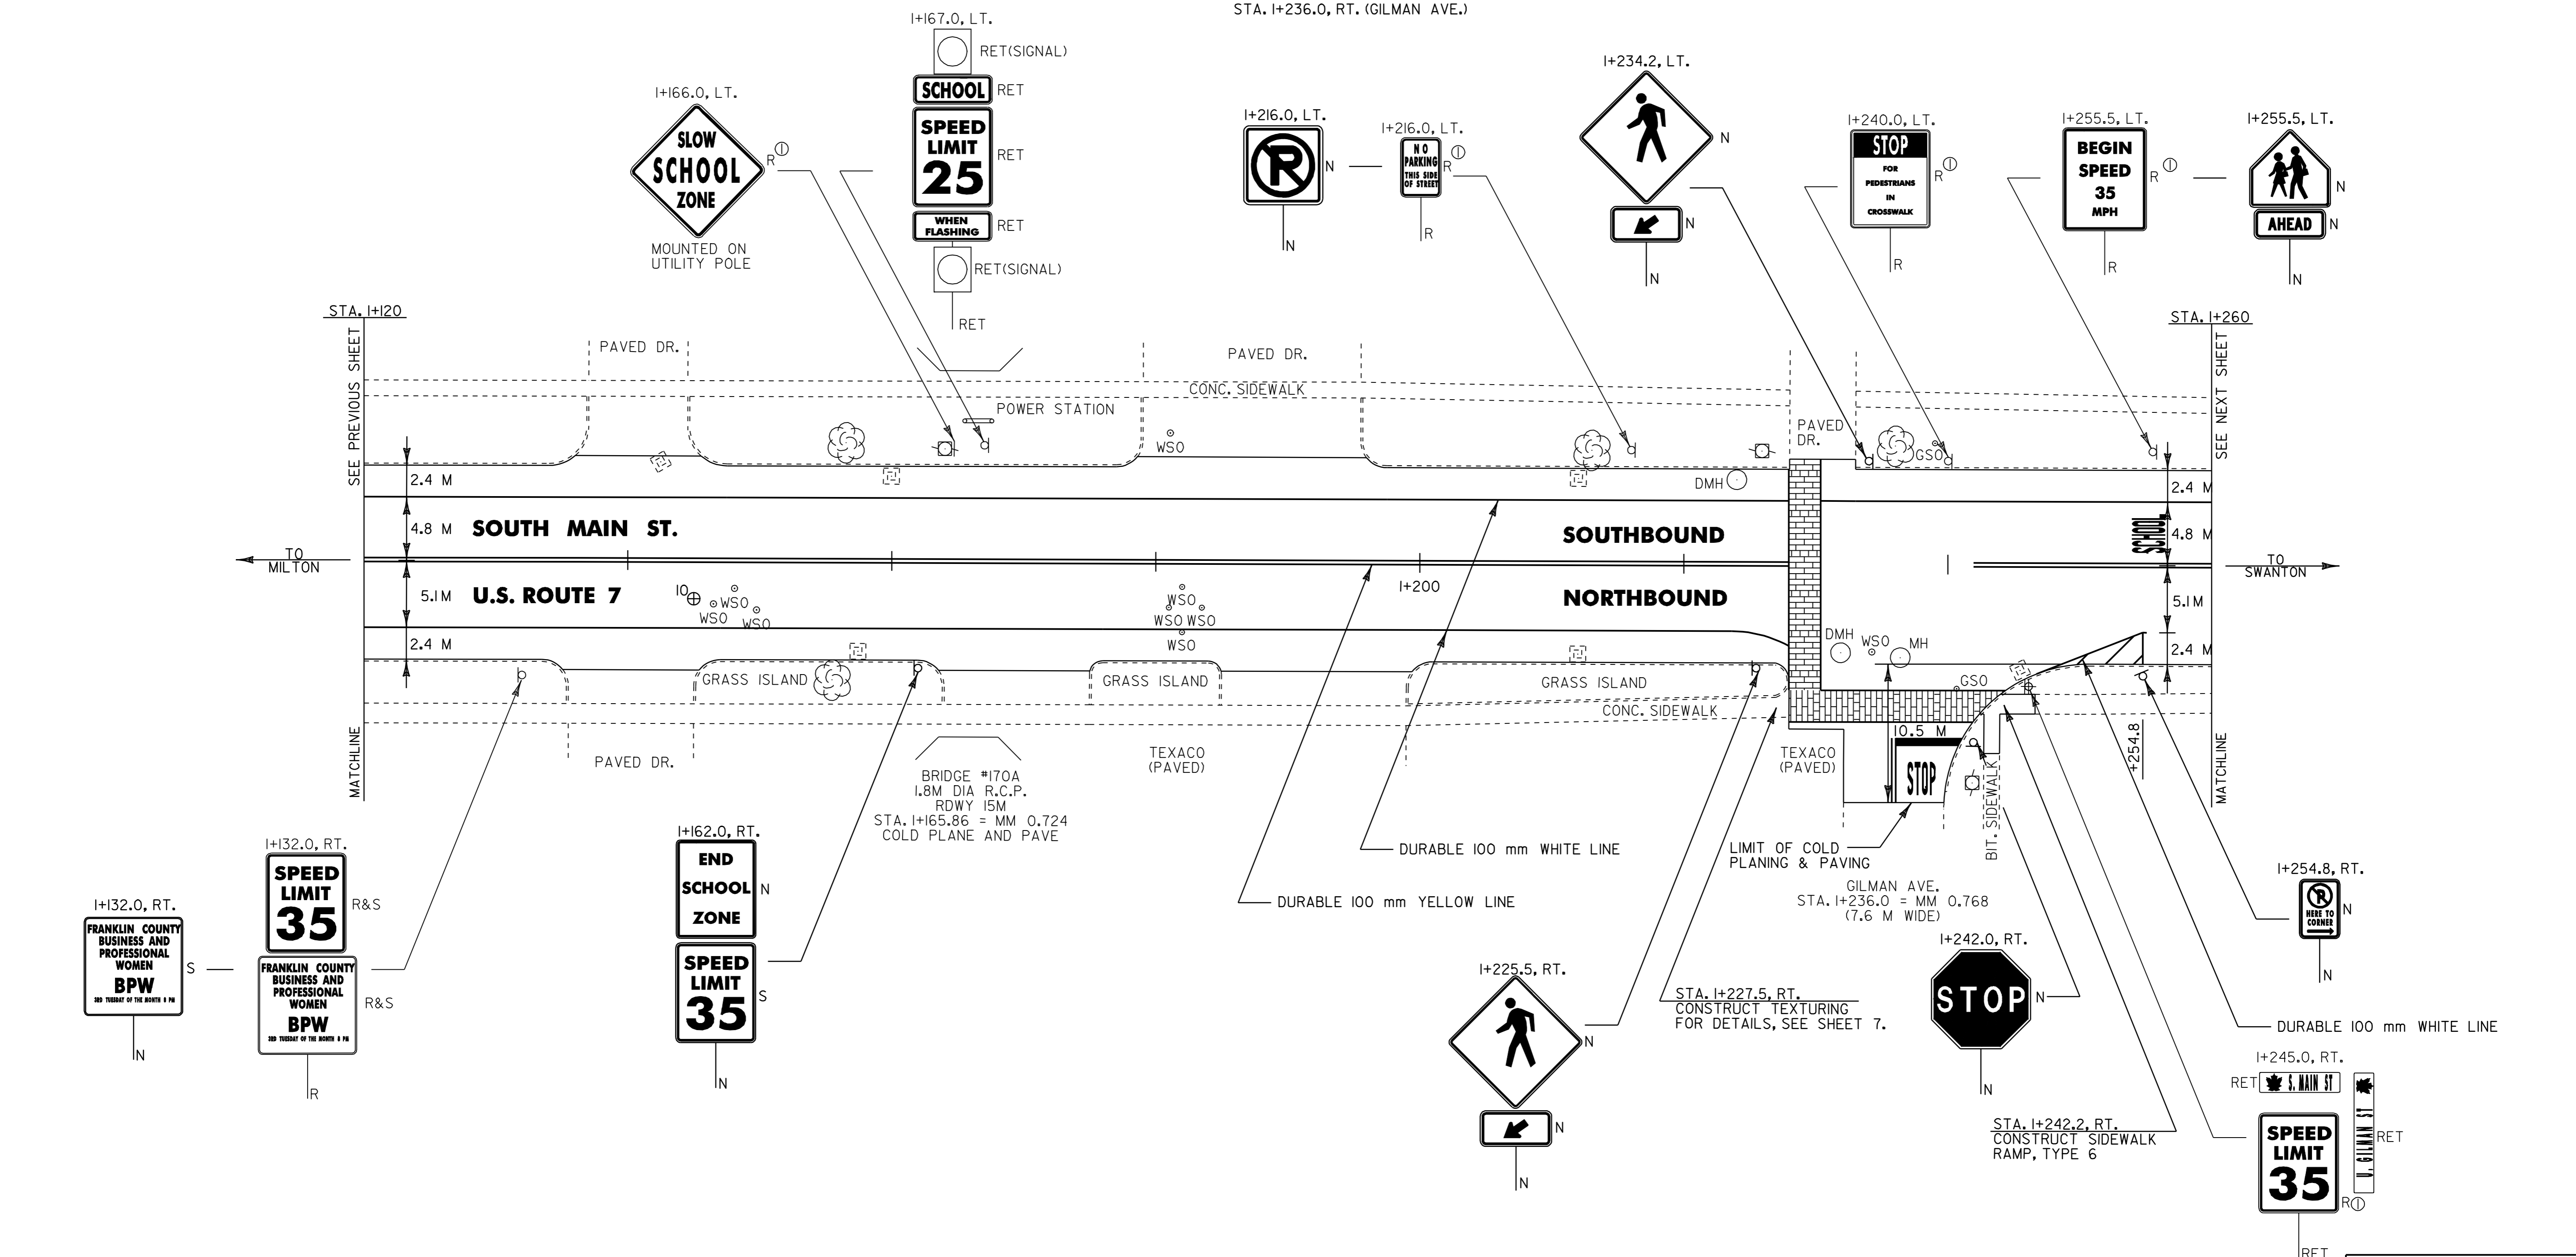

⊕ CORE LOCATION

PAVEMENT CORE DATA			
CORE #	LOCATION	DEPTH (mm)	PCC
10	I+145.9, RT.	140	NO

- NOTES:
- 1) ALL DIMENSIONS IN MILLIMETERS EXCEPT WHERE OTHERWISE INDICATED.
 - 2) ALL EXISTING SIGNS NOT SHOWN SHALL BE RETAINED AS DIRECTED BY THE RESIDENT ENGINEER.
 - 3) FOR ANY TOWN HIGHWAY OR STREET DETAILS, SEE VTRANS STANDARD E-193M.

LAYOUT SHEET #8

PROJECT NAME: ST. ALBANS CITY
 PROJECT NUMBER: STP_9804(I)S
 FILE NAME: 2pave297d1502pd150.dgn PLOT DATE: 01-FEB-2006 07:4
 PROJECT LEADER: JLL DRAWN BY: D-H
 DESIGNED BY: D-H CHECKED BY:
 IPARM FILE NAME: pd150p08.i SHEET 27 OF 105



~~TEMPORARY & DURABLE 100 mm WHITE LINE~~
 STA. I+260.0 TO I+420.0, LT. & RT. (PARKING SPACES & DIAGONALS WITH BREAKS FOR GILMAN ST. & DIAMOND ST.)

~~TEMPORARY & DURABLE 100 mm YELLOW LINE~~
 STA. I+260.0 TO I+420.0, SOLID LT. & RT. (WITH CENTERLINE BREAKS FOR GILMAN ST. & DIAMOND ST.)
 STA. I+276.0, DOUBLE SOLID LT. (GILMAN ST.)
 STA. I+370.0, DOUBLE SOLID RT. (DIAMOND ST.)

~~TEMPORARY & DURABLE CROSSWALK WITH DIAGONAL LINES (MOD.)~~
 STA. I+276.0, LT. (GILMAN ST.)
 STA. I+370.0, RT. (DIAMOND ST.)

~~TEMPORARY & DURABLE LETTER OR SYMBOL (TYPE I TAPE)~~
 STA. I+275.5, LT. - 'STOP'
 STA. I+296.5, LT. - 'NO PARKING HERE TO CORNER'
 STA. I+370.0, RT. - 'STOP'

~~REMOVING SIGNS~~
 AS SHOWN - 7

~~ADJUST ELEVATION OF VALVE BOX~~
 STA. I+365.0, RT. - WSO
 STA. I+370.0, RT. - WSO
 270.0




~~REHABILITATION OF DI'S, CB'S OR MH'S - CLASS I~~
 STA. I+287.0, LT. & RT. - DI'S
 STA. I+354.0, LT. & RT. - DI'S

~~CHANGING ELEVATION OF SMH'S~~
 STA. I+367.0, LT.

~~TEMPORARY & DURABLE 600 mm STOP BAR (TYPE I TAPE)~~
 STA. I+276.0, LT. (GILMAN ST.)
 STA. I+370.0, RT. (DIAMOND ST.)

~~PAINTED CURB~~
~~IN NO PARKING AREAS AS~~
~~DIRECTED BY RESIDENT ENGINEER~~

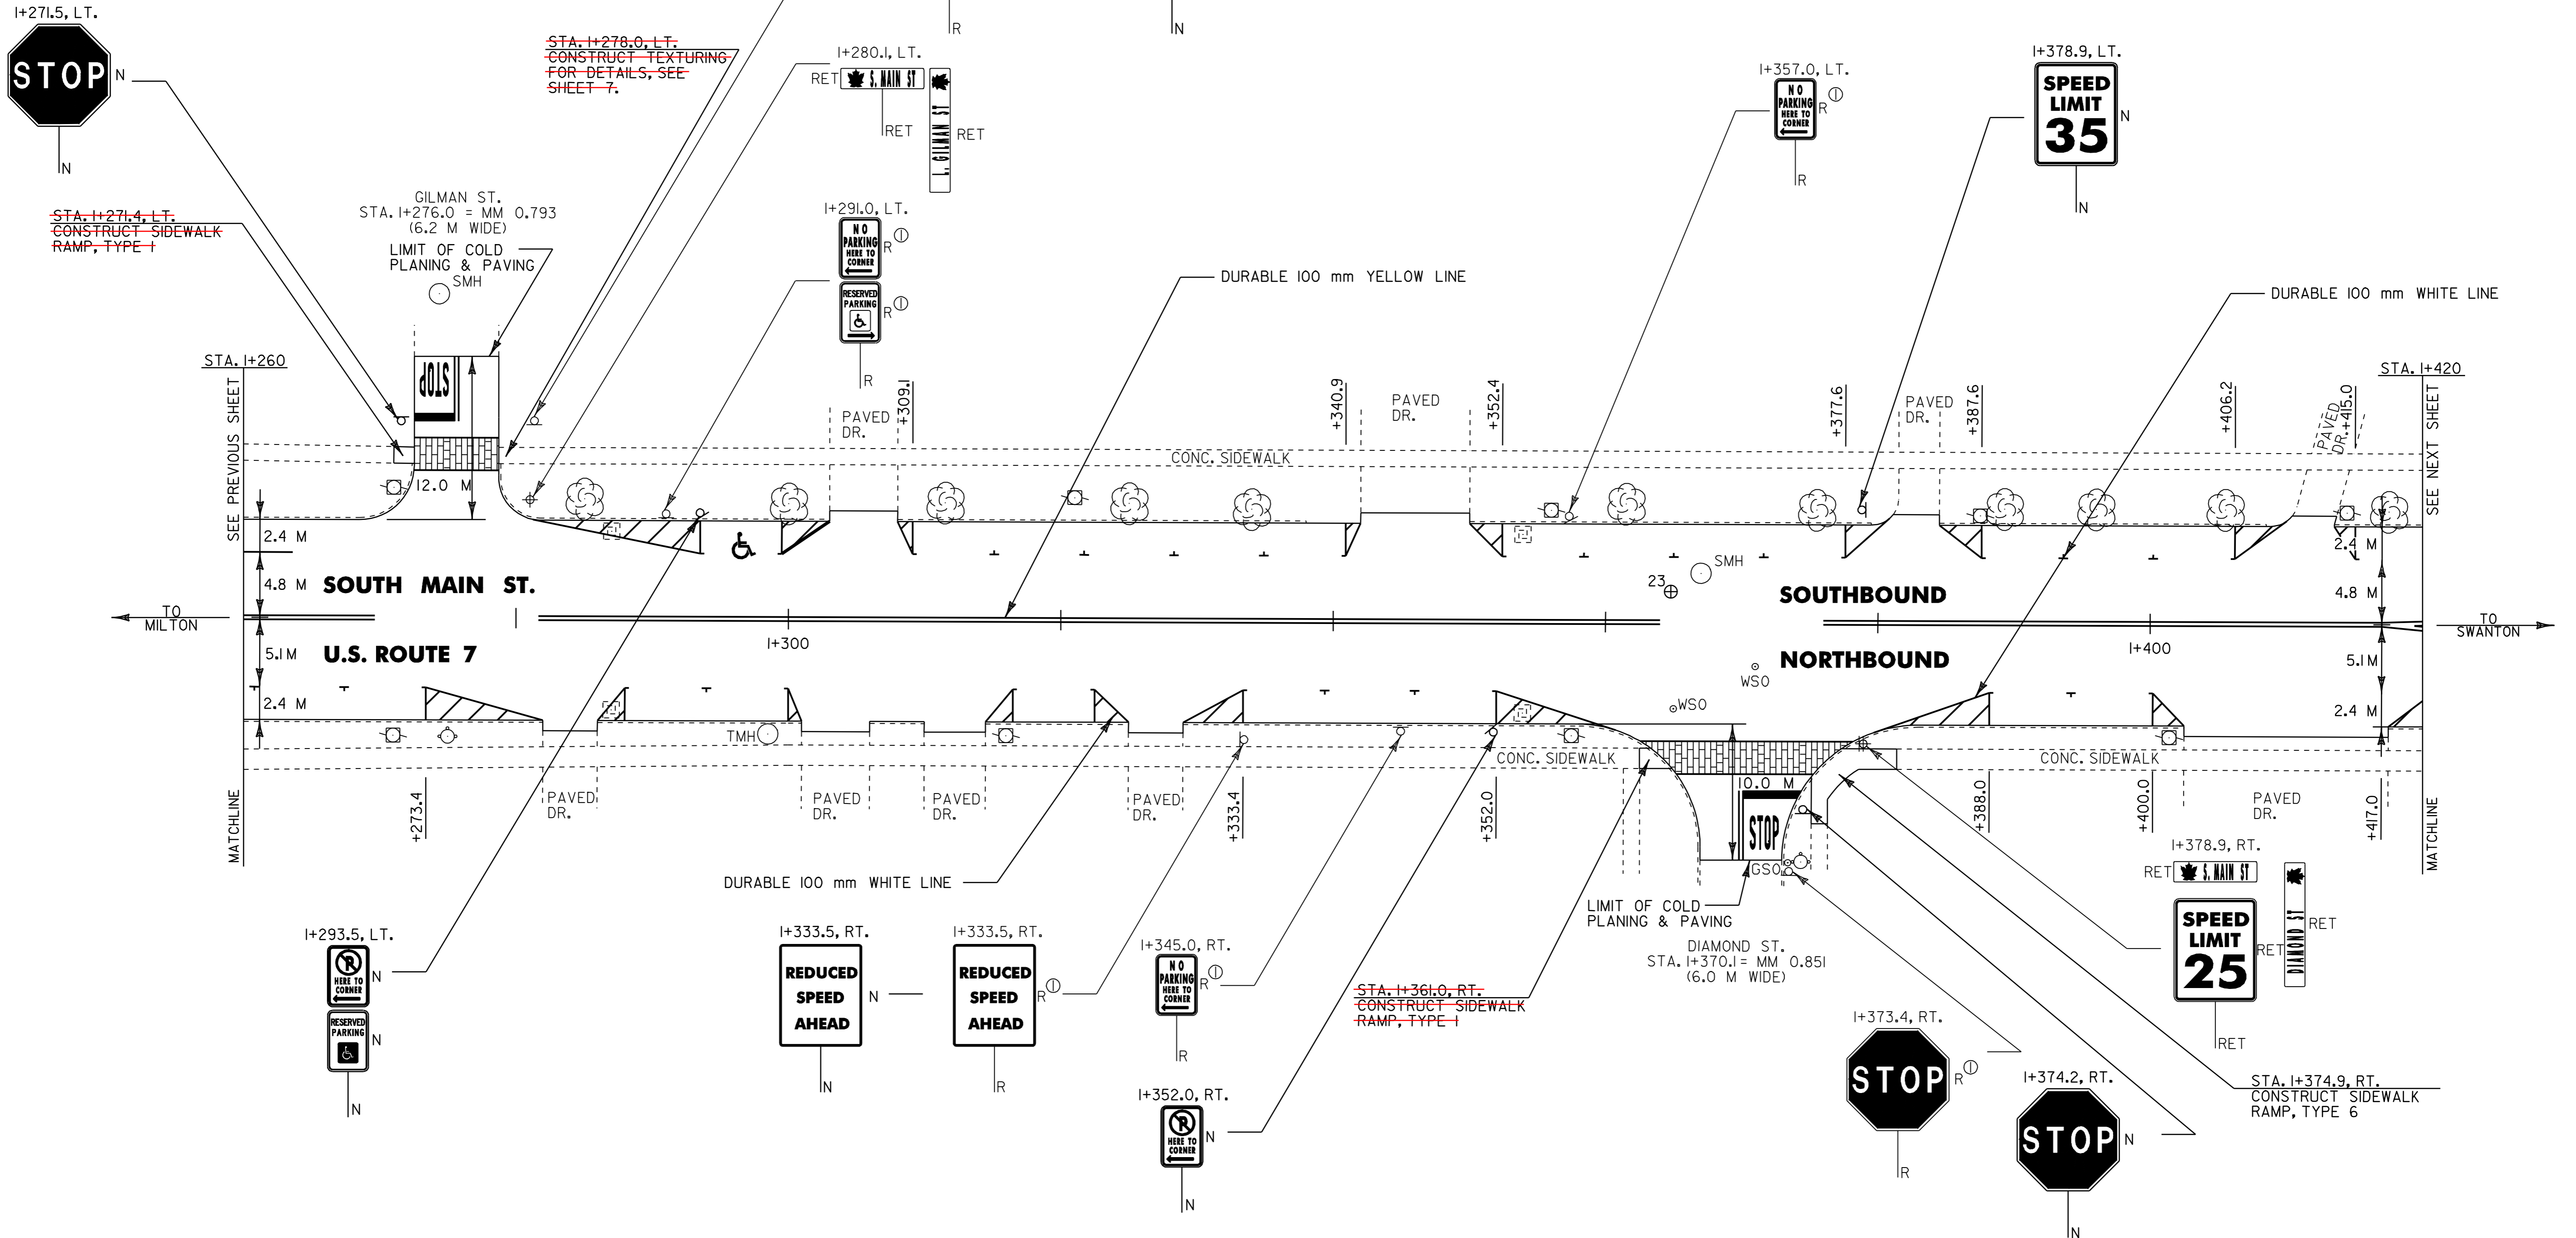

⊕ CORE LOCATION

PAVEMENT CORE DATA			
CORE #	LOCATION	DEPTH (mm)	PCC
23	I+364.7, LT.	165	NO

NOTES: 1) ALL DIMENSIONS IN MILLIMETERS EXCEPT WHERE OTHERWISE INDICATED.
 2) ALL EXISTING SIGNS NOT SHOWN SHALL BE RETAINED AS DIRECTED BY THE RESIDENT ENGINEER.
 3) FOR ANY TOWN HIGHWAY OR STREET DETAILS, SEE VTRANS STANDARD E-193M.

LAYOUT SHEET #9

PROJECT NAME: ST. ALBANS CITY
 PROJECT NUMBER: STP_9804(I)S
 FILE NAME: Z:\pave\297d150\pd150.dgn
 PROJECT LEADER: JLL
 DESIGNED BY: D-H
 IPARM FILE NAME: pd150p09.i
 PLOT DATE: 01-FEB-2006 07:4
 DRAWN BY: D-H
 CHECKED BY:
 SHEET 28 OF 105



TEMPORARY & DURABLE 100 mm WHITE LINE
 STA. I+420.0 TO I+590.0, SOLID LT. & RT.
 (PARKING SPACES & DIAGONALS WITH EDGELINE
 BREAKS FOR NEW ST., LOWER WELDEN ST. &
 UPPER WELDEN ST.)
 STA. I+433.0 TO I+482.0, DOTTED RT.
 STA. I+482.0 TO I+520.0, SOLID RT. (LANE LINE)
 STA. I+540.0 TO I+570.0, SOLID LT. (LANE LINE)
 STA. I+536.2, SOLID LT. (LANE LINE FOR
 LOWER WELDEN ST.)
 STA. I+570.0 TO I+590.0, DOTTED LT.

TEMPORARY & DURABLE 100 mm YELLOW LINE
 STA. I+420.0 TO I+482.0, DOUBLE SOLID LT. & RT.
 (WITH CENTERLINE BREAK FOR NEW ST.)
 STA. I+482.0 TO I+570.0, SOLID LT. & RT. (WITH
 CENTERLINE BREAK FOR LOWER WELDEN ST. &
 UPPER WELDEN ST.)
 STA. I+527.1, DOUBLE SOLID RT. (UPPER WELDEN ST.)
 STA. I+536.2, DOUBLE SOLID LT. (LOWER WELDEN ST.)
 STA. I+570.0 TO I+590.0, DOUBLE SOLID LT. & RT.

TEMPORARY & DURABLE 200 mm YELLOW LINE
 STA. I+420.0 TO I+482.0, SOLID LT. & RT. (DIAGONALS)
 (WITH CENTERLINE BREAK FOR NEW ST.)
 STA. I+570.0 TO I+590.0, SOLID LT. & RT. (DIAGONALS)

DURABLE LETTER OR SYMBOL (TYPE I TAPE)
 STA. I+483.2, RT. - "ONLY" 487.0
 STA. I+484.0, RT. - " " 488.0
 STA. I+486.8, RT. - " " 491.0 CL
 STA. I+505.7, RT. - "ONLY" 511.0
 STA. I+508.5, RT. - " " 514.0
 STA. I+509.3, RT. - " " 515.0 LT.
 STA. I+536.2, LT. - "ONLY"
 (LOWER WELDEN ST.)
 STA. I+536.2, RT. - " "
 (LOWER WELDEN ST.)
 STA. I+536.2, RT. - " "
 (LOWER WELDEN ST.)
 STA. I+565.2, LT. - " " 569.0 RT.
 STA. I+568.0, LT. - " " 573.0 RT.
 STA. I+568.8, LT. - "ONLY" 573.0 LT.

TEMPORARY LETTER OR SYMBOL
 STA. I+484.0, RT. -
 STA. I+486.8, RT. -
 STA. I+508.5, RT. -
 STA. I+509.3, RT. -
 STA. I+536.2, RT. -
 (LOWER WELDEN ST.)
 STA. I+536.2, RT. -
 (LOWER WELDEN ST.)
 STA. I+565.2, LT. -
 STA. I+568.0, LT. -


REMOVING SIGNS
 AS SHOWN - IO
CHANGING ELEVATION OF SMH'S
 STA. I+529.0, LT.
 STA. I+536.0, LT.
ADJUST ELEVATION OF VALVE BOX
 STA. I+523.0, RT. - WSO
 STA. I+538.0, LT. - WSO
 STA. I+480.0, RT. - WSO

PAINTED CURB
 IN NO PARKING AREAS AS
 DIRECTED BY RESIDENT ENGINEER

TEMPORARY & DURABLE CROSSWALK WITH DIAGONAL LINES (MOD.)
 STA. I+444.8, LT. (NEW ST.)
 STA. I+527.1, RT. (UPPER WELDEN ST.)
 STA. I+536.2, LT. (LOWER WELDEN ST.)
 STA. I+540.0

TEMPORARY & DURABLE 600 mm STOP BAR (TYPE I TAPE)
 STA. I+512.0, RT.
 STA. I+527.1, RT. (UPPER WELDEN ST.)
 STA. I+536.2, LT. (LOWER WELDEN ST.)
 STA. I+554.4, LT.

REHABILITATION OF DI'S, CB'S OR MH'S - CLASS I
 STA. I+444.0, RT. - DI STA. I+525, RT. - DI
 STA. I+448.0, LT. - DI STA. I+529, RT. - DI
 STA. I+511.5, LT. & RT. - DI'S
 STA. I+548.0, RT. - DI

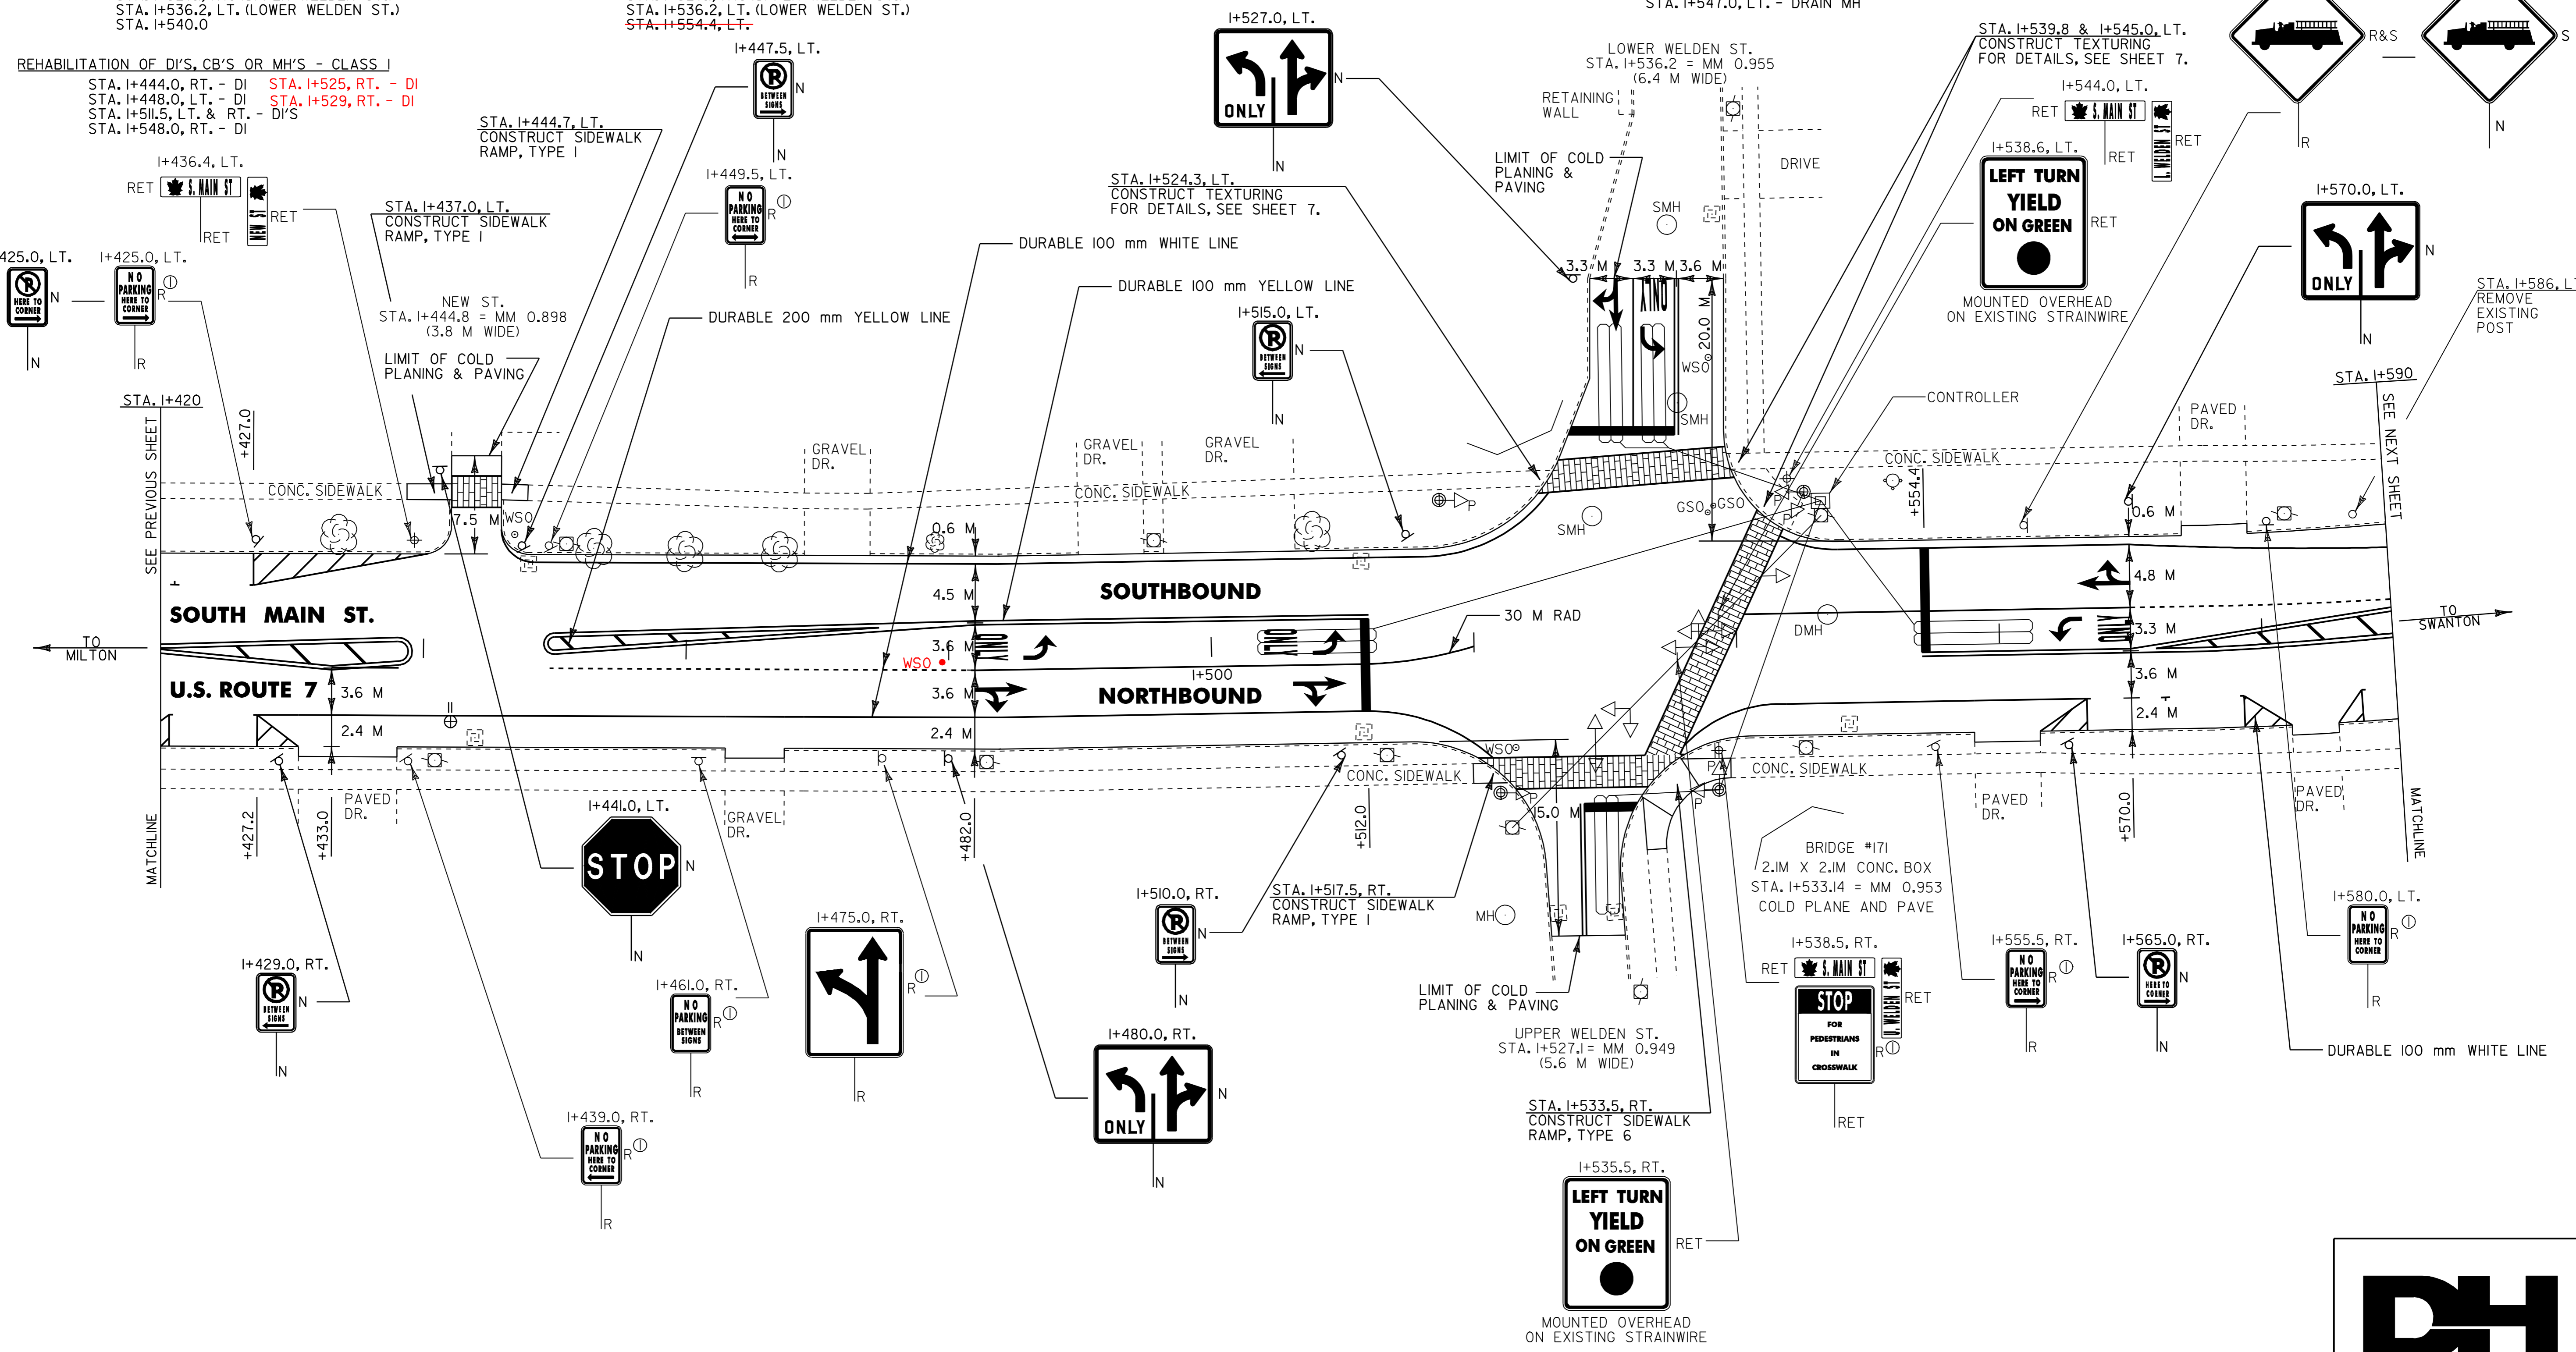

⊕ CORE LOCATION

PAVEMENT CORE DATA			
CORE #	LOCATION	DEPTH (mm)	PCC
II	I+442.0, RT.	203	NO

NOTES: 1) ALL DIMENSIONS IN MILLIMETERS EXCEPT WHERE OTHERWISE INDICATED.

2) ALL EXISTING SIGNS NOT SHOWN SHALL BE RETAINED AS DIRECTED BY THE RESIDENT ENGINEER.

3) FOR ANY TOWN HIGHWAY OR STREET DETAILS, SEE VTRANS STANDARD E-193M.

4) FOR VEHICLE DETECTOR LOOP DETAILS SEE SHEET 9.

LAYOUT SHEET #10

PROJECT NAME: ST. ALBANS CITY
 PROJECT NUMBER: STP_9804(I)S
 FILE NAME: Z:\pave\297\dl50\dl50.dgn
 PROJECT LEADER: JLL
 DESIGNED BY: D-H
 IPARM FILE NAME: dl50pl0.i
 PLOT DATE: 01-FEB-2006 07:4
 DRAWN BY: D-H
 CHECKED BY:
 SHEET 29 OF 105

TEMPORARY & DURABLE 100 mm WHITE LINE
 STA. I+590.0 TO I+740.0, SOLID LT. & RT.
 (PARKING SPACES & DIAGONALS WITH EDGE LINE
 BREAKS FOR STOWELL ST. & CROSSWALK)
 STA. I+590.0 TO I+600.0, DOTTED LT.

TEMPORARY & DURABLE 100 mm YELLOW LINE
 STA. I+590.0 TO I+618.6, DOUBLE SOLID LT. & RT.
 STA. I+618.6 TO I+740.0, SOLID LT. & RT. (WITH
 CENTERLINE BREAKS FOR STOWELL ST. &
 CROSSWALK)
 STA. I+705.4, DOUBLE SOLID LT. (STOWELL ST.)

TEMPORARY & DURABLE 200 mm YELLOW LINE
 STA. I+590.0 TO I+618.6, SOLID LT. (DIAGONALS)

TEMPORARY & DURABLE LETTER OR SYMBOL (TYPE I TAPE)
 STA. I+634.0, LT. - STOP
 STA. I+646.8, LT. - STOP
 STA. I+705.4, LT. - STOP

TEMPORARY & DURABLE CROSSWALK WITH DIAGONAL LINES (MOD.)
 STA. I+705.4, LT. (STOWELL ST.)
 STA. I+721.0

REHABILITATION OF DI'S, CB'S OR MH'S - CLASS J
 STA. I+603.0, LT. & RT. - DI'S
 STA. I+680.5, RT. - DI
 STA. I+726.0, RT. - DI


ADJUST ELEVATION OF VALVE BOX
 STA. I+683.0, LT. - WSO
 STA. I+702.5, LT. - WSO
 STA. I+712.0, LT. - WSO
 STA. I+707.8, LT. - WSO

CHANGING ELEVATION OF DI'S, CB'S OR MH'S
 STA. I+622.5, RT. - MH
 STA. I+661.0, RT. - MH

REMOVING SIGNS AS SHOWN - IO


PAINTED CURB - IN NO-PARKING AREAS AS DIRECTED BY RESIDENT ENGINEER

TEMPORARY & DURABLE 600 mm STOP BAR (TYPE I TAPE)
 STA. I+705.4, LT. (STOWELL ST.)

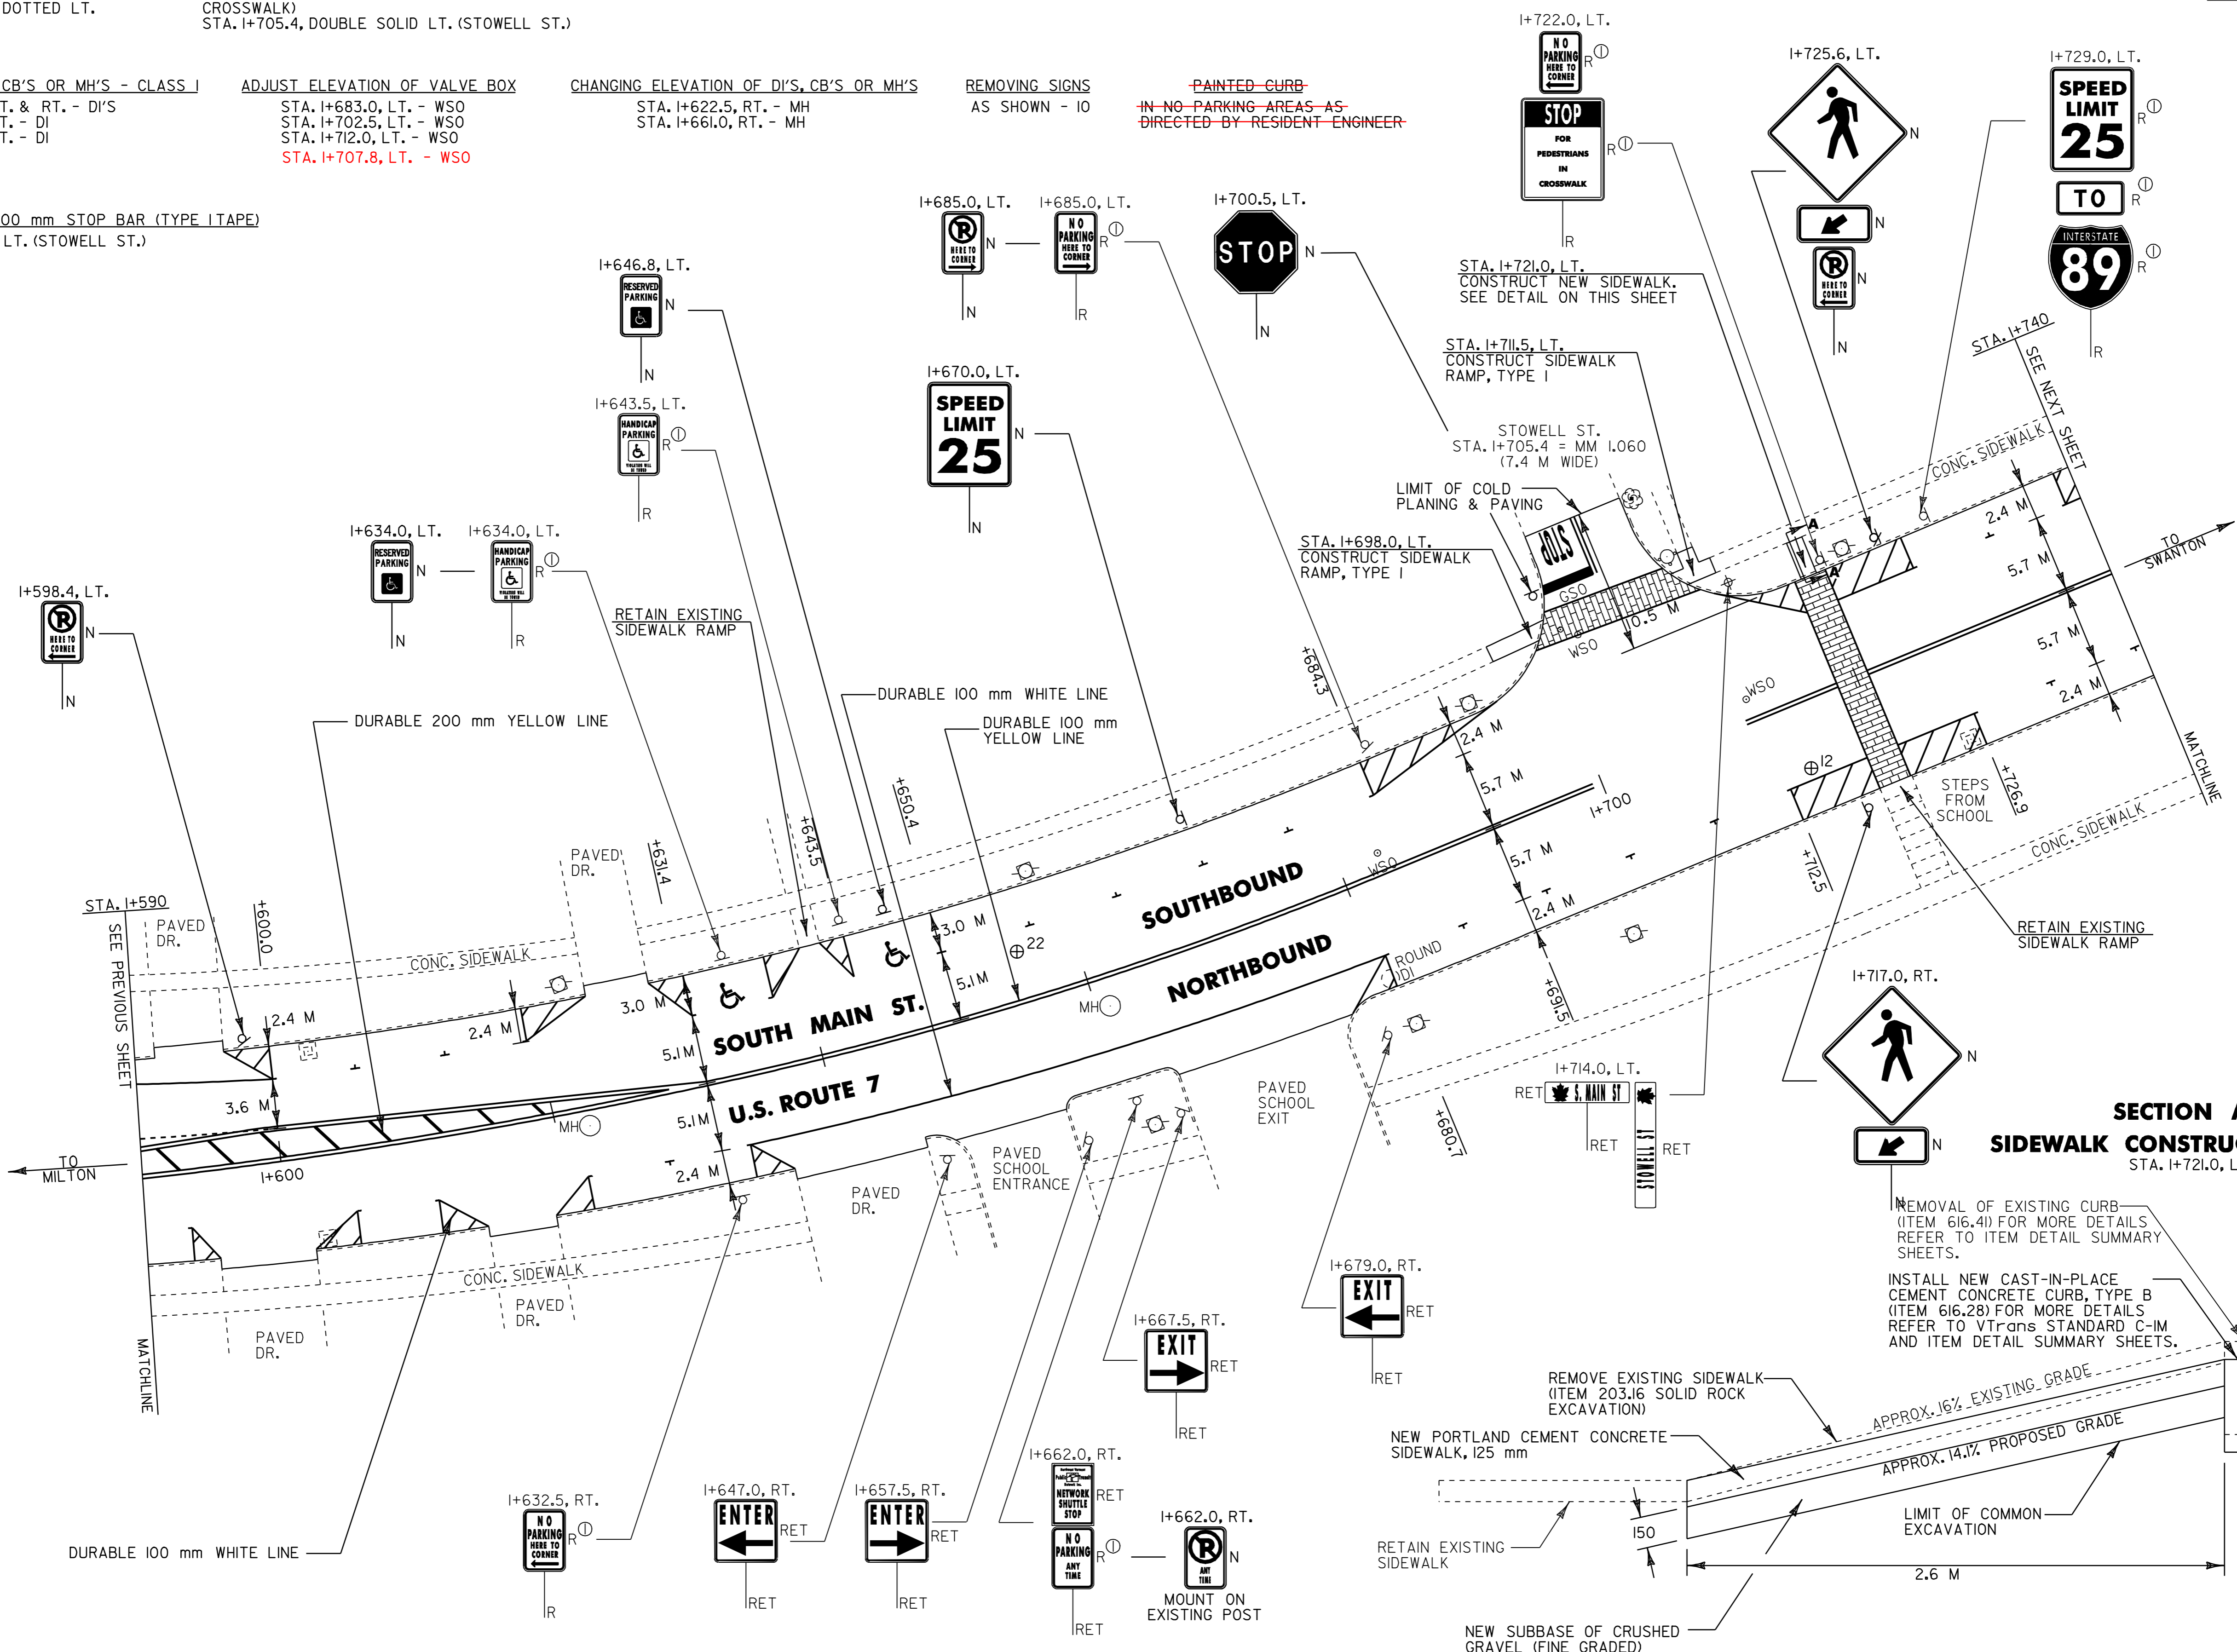

**SECTION A-A
 SIDEWALK CONSTRUCTION DETAIL
 STA. I+721.0, LT.**

REMOVAL OF EXISTING CURB (ITEM 616.41) FOR MORE DETAILS REFER TO ITEM DETAIL SUMMARY SHEETS.
 INSTALL NEW CAST-IN-PLACE CEMENT CONCRETE CURB, TYPE B (ITEM 616.28) FOR MORE DETAILS REFER TO VTRANS STANDARD C-1M AND ITEM DETAIL SUMMARY SHEETS.
 APPROXIMATE 50 mm EXISTING CURB REVEAL

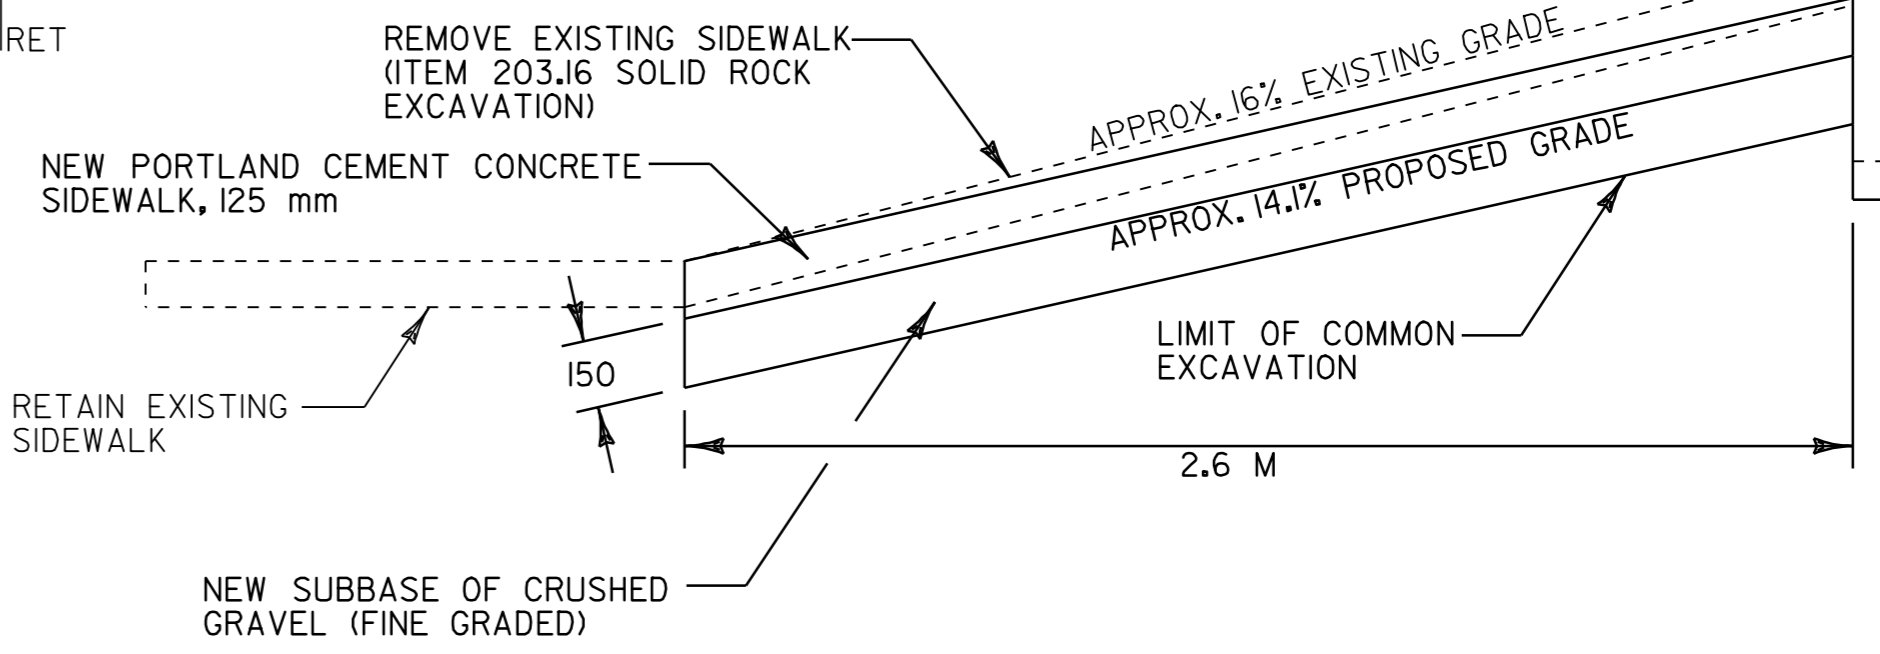

⊕ CORE LOCATION

PAVEMENT CORE DATA			
CORE #	LOCATION	DEPTH (mm)	PCC
12	I+714.0, RT.	191	NO
22	I+654.4, LT.	165	NO

NOTES: 1) ALL DIMENSIONS IN MILLIMETERS EXCEPT WHERE OTHERWISE INDICATED.
 2) ALL EXISTING SIGNS NOT SHOWN SHALL BE RETAINED AS DIRECTED BY THE RESIDENT ENGINEER.
 3) FOR ANY TOWN HIGHWAY OR STREET DETAILS, SEE VTRANS STANDARD E-193M.

LAYOUT SHEET #11

PROJECT NAME: ST. ALBANS CITY
 PROJECT NUMBER: STP_9804(1)S
 FILE NAME: Z:\pave\97\dl50\pd150.dgn
 PROJECT LEADER: JLL
 DESIGNED BY: D-H
 IPARM FILE NAME: pd150pl11
 PLOT DATE: 01-FEB-2006 07:4
 DRAWN BY: D-H
 CHECKED BY:
 SHEET 30 OF 105



~~TEMPORARY & DURABLE 100 mm WHITE LINE~~
 STA. 1+740.0 TO 1+835.0, SOLID LT. & RT. (PARKING SPACES & DIAGONALS WITH EDGELINE BREAKS FOR CROSSWALKS & STEBBINS ST. & FERRIS ST.)
 STA. 1+811.0, SOLID LT. (STEBBINS ST. EDGELINES)
 STA. 1+811.0, SOLID RT. (FERRIS ST. EDGELINES)
 STA. 1+825.0, DOTTED RT.

~~TEMPORARY & DURABLE 100 mm YELLOW LINE~~
 STA. 1+740.0 TO 1+785.0, SOLID LT. & RT. (WITH CENTERLINE BREAK FOR CROSSWALK)
 STA. 1+785.0 TO 1+835.0, DOUBLE SOLID LT. & RT. (WITH CENTERLINE BREAKS FOR STEBBINS ST., FERRIS ST. & CROSSWALK)
 STA. 1+811.0, DOUBLE SOLID LT. (STEBBINS ST.)
 STA. 1+811.0, DOUBLE SOLID RT. (FERRIS ST.)

~~TEMPORARY & DURABLE 200 mm YELLOW LINE~~
 STA. 1+785.0 TO 1+835.0, SOLID RT. (DIAGONALS) (WITH BREAK FOR STEBBINS ST., FERRIS ST. & CROSSWALK)

~~TEMPORARY & DURABLE CROSSWALK WITH DIAGONAL LINES (MOD.)~~
 STA. 1+758.0
 STA. 1+811.0, RT. (FERRIS ST.)
 STA. 1+811.0, RT. (STEBBINS ST.)
 STA. 1+818.0

~~TEMPORARY & DURABLE 600 mm STOP BAR (TYPE ITAPE)~~
 STA. 1+811.0, RT. (FERRIS ST.)
 STA. 1+811.0, LT. (STEBBINS ST.)

~~TEMPORARY & DURABLE LETTER OR SYMBOL (TYPE ITAPE)~~
 STA. 1+811.0, LT. - 'STOP'
 STA. 1+811.0, RT. - 'STOP'

~~REHABILITATION OF D'S, CB'S OR MH'S - CLASS I~~
 STA. 1+789.0, LT. & RT. - D'S
 STA. 1+816.0, RT. - DI

~~ADJUST ELEVATION OF VALVE BOX~~
 STA. 1+767.5, LT. - WSO
 STA. 1+808.0, LT. - WSO
 STA. 1+810.5, LT. - WSO
 STA. 1+814.5, RT. - WSO (2)


~~CHANGING ELEVATION OF D'S, CB'S OR MH'S~~
 STA. 1+810.0, RT. - MH
 STA. 1+812.0, RT. - DRAIN MH
 STA. 1+816.0, RT. - MH

~~CHANGING ELEVATION OF SMH'S~~
 STA. 1+741.0, LT.
 STA. 1+810.0, RT.

~~PAINTED CURB~~
 IN NO PARKING AREAS AS DIRECTED BY RESIDENT ENGINEER

~~REMOVING SIGNS~~
 AS SHOWN - 4

~~TEMPORARY STOP BARS INSTALLED (8-12-03)~~
 STA. 1+760 & STA. 2+400

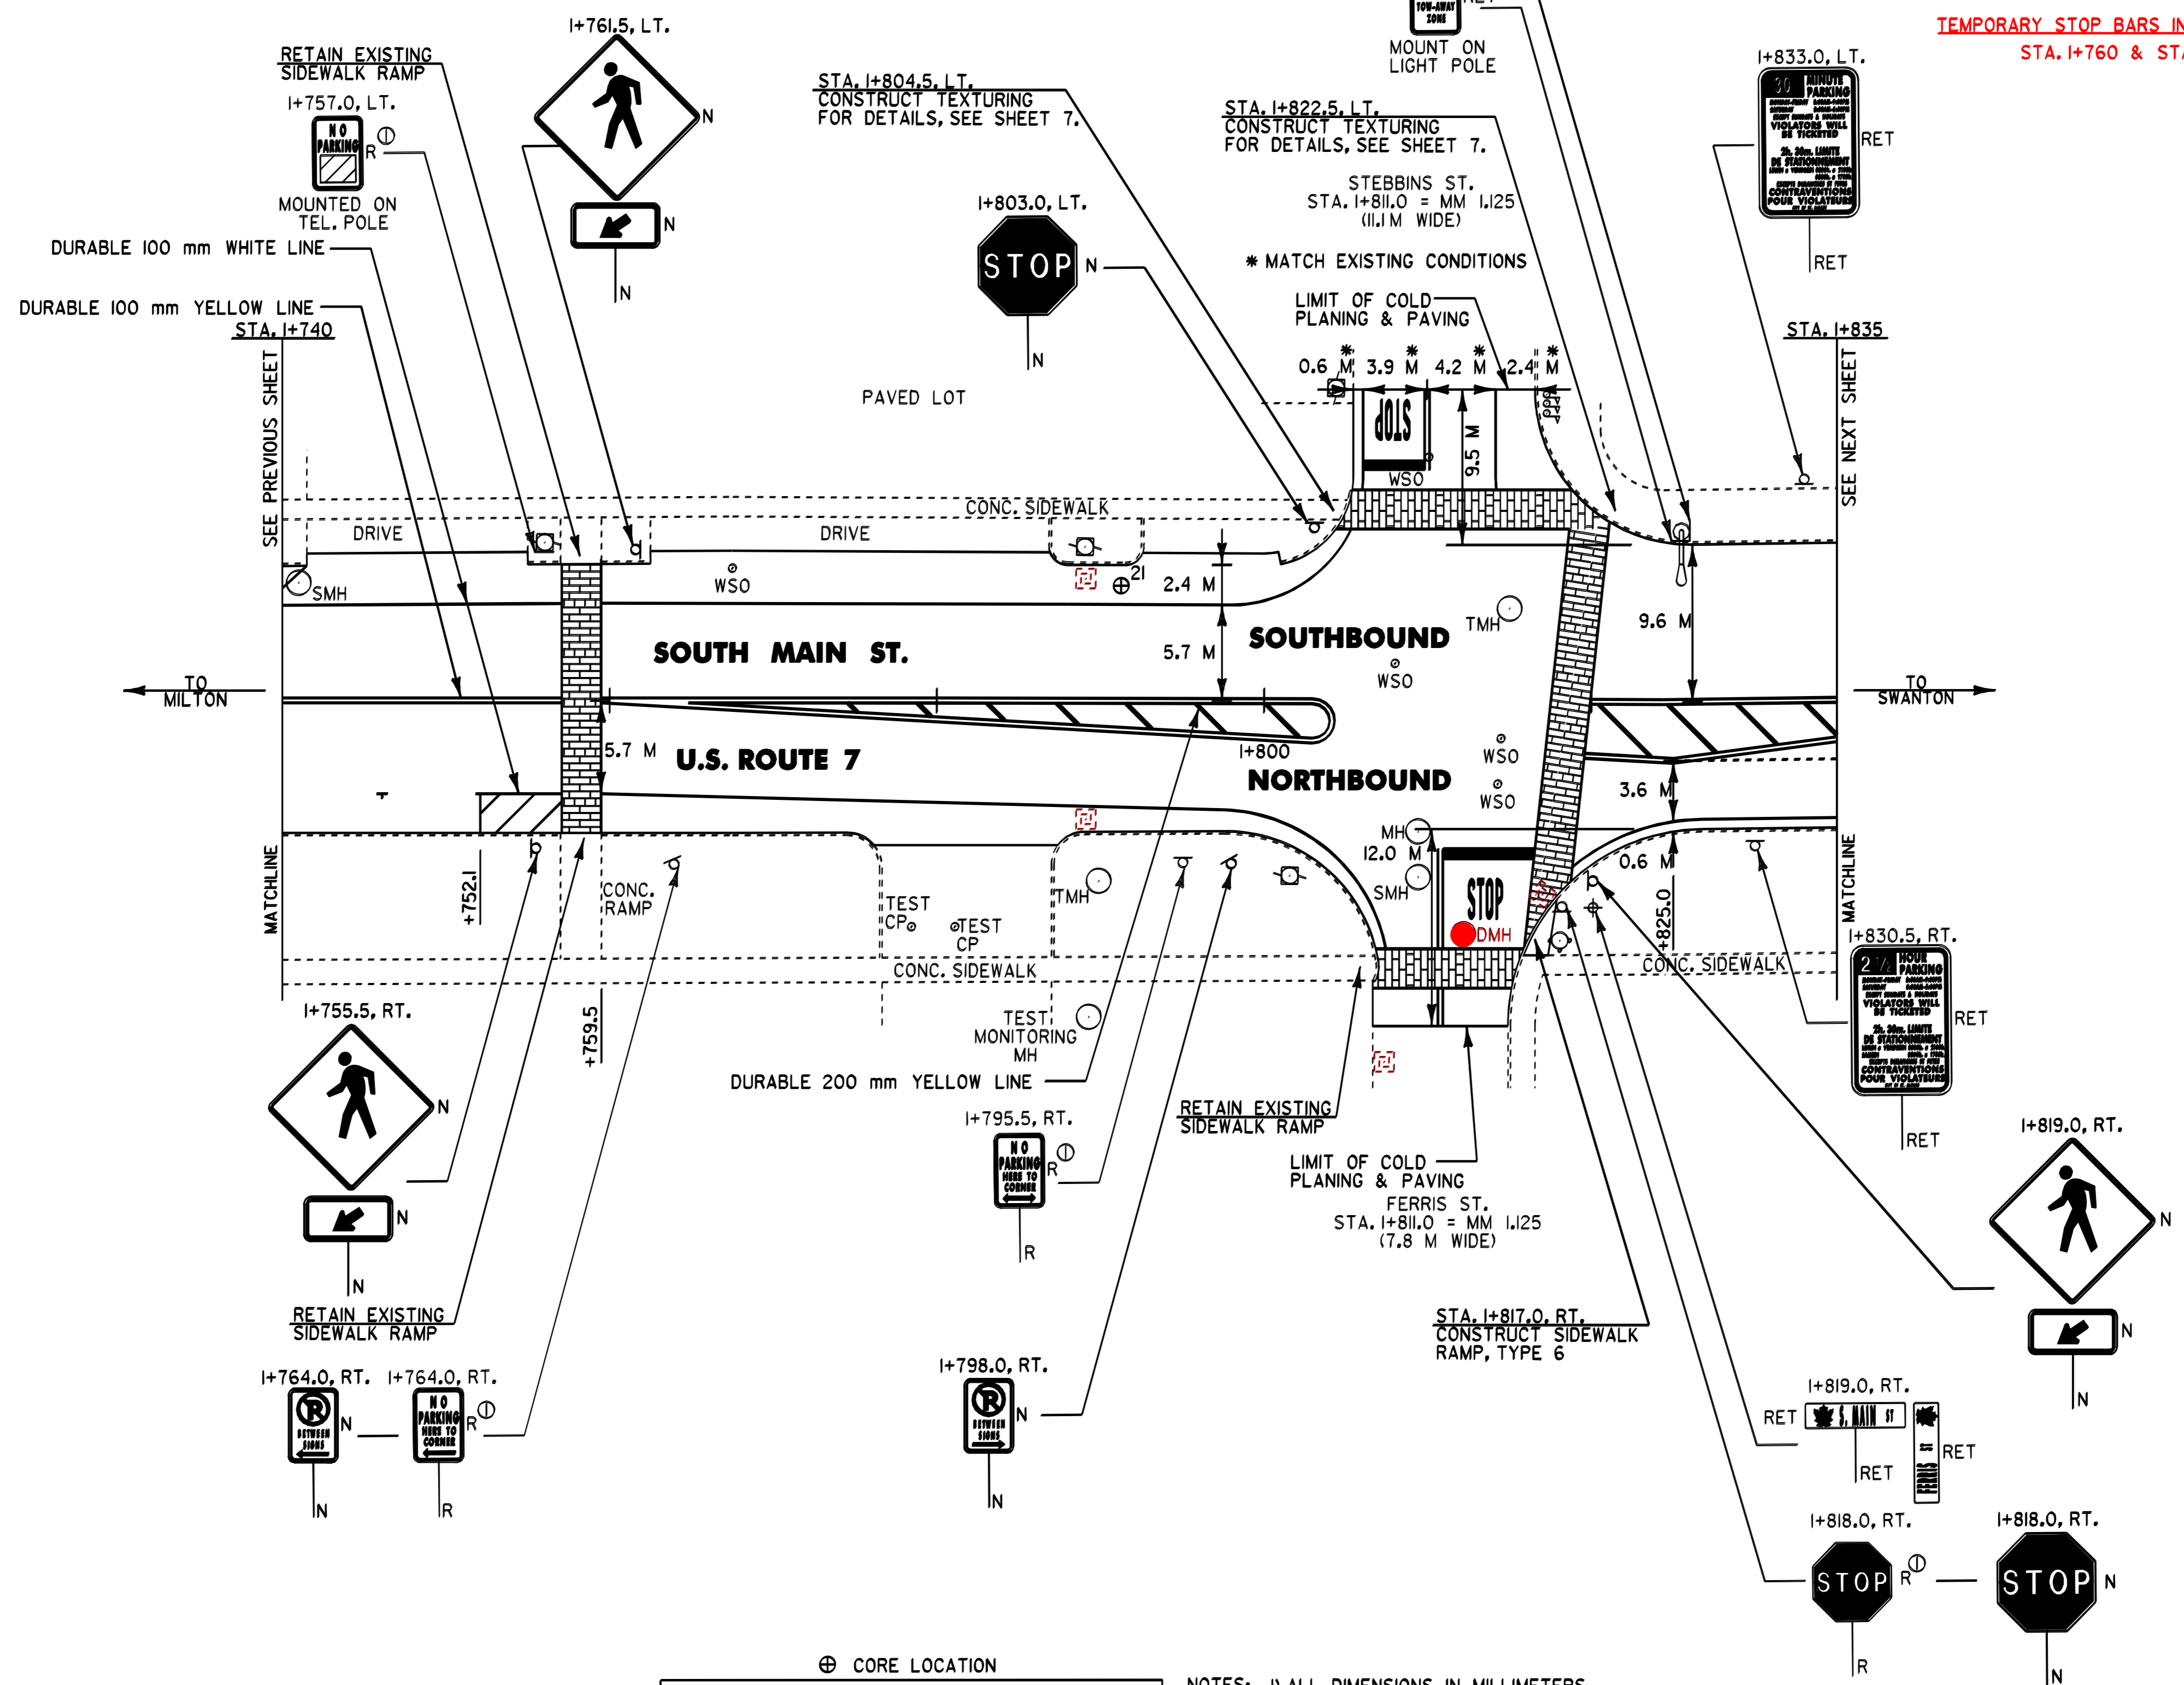

⊕ CORE LOCATION

PAVEMENT CORE DATA			
CORE #	LOCATION	DEPTH (mm)	PCC
21	1+791.2, LT.	140	NO

- NOTES:
- 1) ALL DIMENSIONS IN MILLIMETERS EXCEPT WHERE OTHERWISE INDICATED.
 - 2) ALL EXISTING SIGNS NOT SHOWN SHALL BE RETAINED AS DIRECTED BY THE RESIDENT ENGINEER.
 - 3) FOR ANY TOWN HIGHWAY OR STREET DETAILS, SEE VTRANS STANDARD E-193M.

LAYOUT SHEET #12

PROJECT NAME: ST. ALBANS CITY
 PROJECT NUMBER: SIP 9804(1)S
 FILE NAME: 2006021502150.dwg PLOT DATE: 01-FEB-2006 07:4
 PROJECT LEADER: JLL DRAWN BY: D-H
 DESIGNED BY: D-H CHECKED BY: _____
 IPARM FILE NAME: pd150p12.i SHEET 31 OF 105



~~TEMPORARY & DURABLE 100 mm WHITE LINE~~
 STA. I+835.0 TO I+940.0, SOLID RT.
 STA. I+835.0 TO I+855.0, DOTTED RT.
 STA. I+855.0 TO I+940.0, SOLID RT. (LANE LINE)

~~TEMPORARY & DURABLE 100 mm YELLOW LINE~~
 STA. I+835.0 TO I+855.0, DOUBLE SOLID LT. & RT.
 STA. I+855.0 TO I+935.0, SOLID LT. & RT.

~~TEMPORARY & DURABLE 200 mm YELLOW LINE~~
 STA. I+835.0 TO I+855.0, SOLID RT. (DIAGONALS)
 860

~~DURABLE LETTER OR SYMBOL (TYPE I TAPE)~~
 STA. I+856.2, RT. - "ONLY" 860
 STA. I+857.0, RT. - " " 860
 STA. I+859.8, RT. - " " 864
 STA. I+892.2, RT. - "ONLY" 898
 STA. I+895.8, RT. - " " 901
 STA. I+899.0, RT. - " " 905
 STA. I+928.7, RT. - "ONLY" 931
 STA. I+931.1, RT. - " " 935
 STA. I+940.0, RT. - " " 942

~~TEMPORARY LETTER OR SYMBOL~~
 STA. I+857.0, RT. - " " 860
 STA. I+859.8, RT. - " " 864
 STA. I+895.8, RT. - " " 898
 STA. I+899.0, RT. - " " 901
 STA. I+931.1, RT. - " " 931
 STA. I+940.0, RT. - " " 935

~~REMOVING SIGNS~~
 AS SHOWN - 3

~~TEMPORARY & DURABLE 600 mm STOP BAR (TYPE I TAPE)~~
 STA. I+935.0, RT.


~~REHABILITATION OF DI'S, CB'S OR MH'S - CLASS I~~
 STA. I+853.0, RT. - DI
 STA. I+893.0, LT. & RT. - DI'S
 STA. I+932.0, LT. - DI

~~ADJUST ELEVATION OF VALVE BOX~~
 STA. I+938.0, LT. - WSO

~~CHANGING ELEVATION OF DI'S, CB'S OR MH'S~~
 STA. I+853.0, LT. - DI

~~CHANGING ELEVATION OF SMH'S~~
 STA. I+840.0, LT.

~~ERECTING SALVAGED SIGNS~~
 AS SHOWN - 1

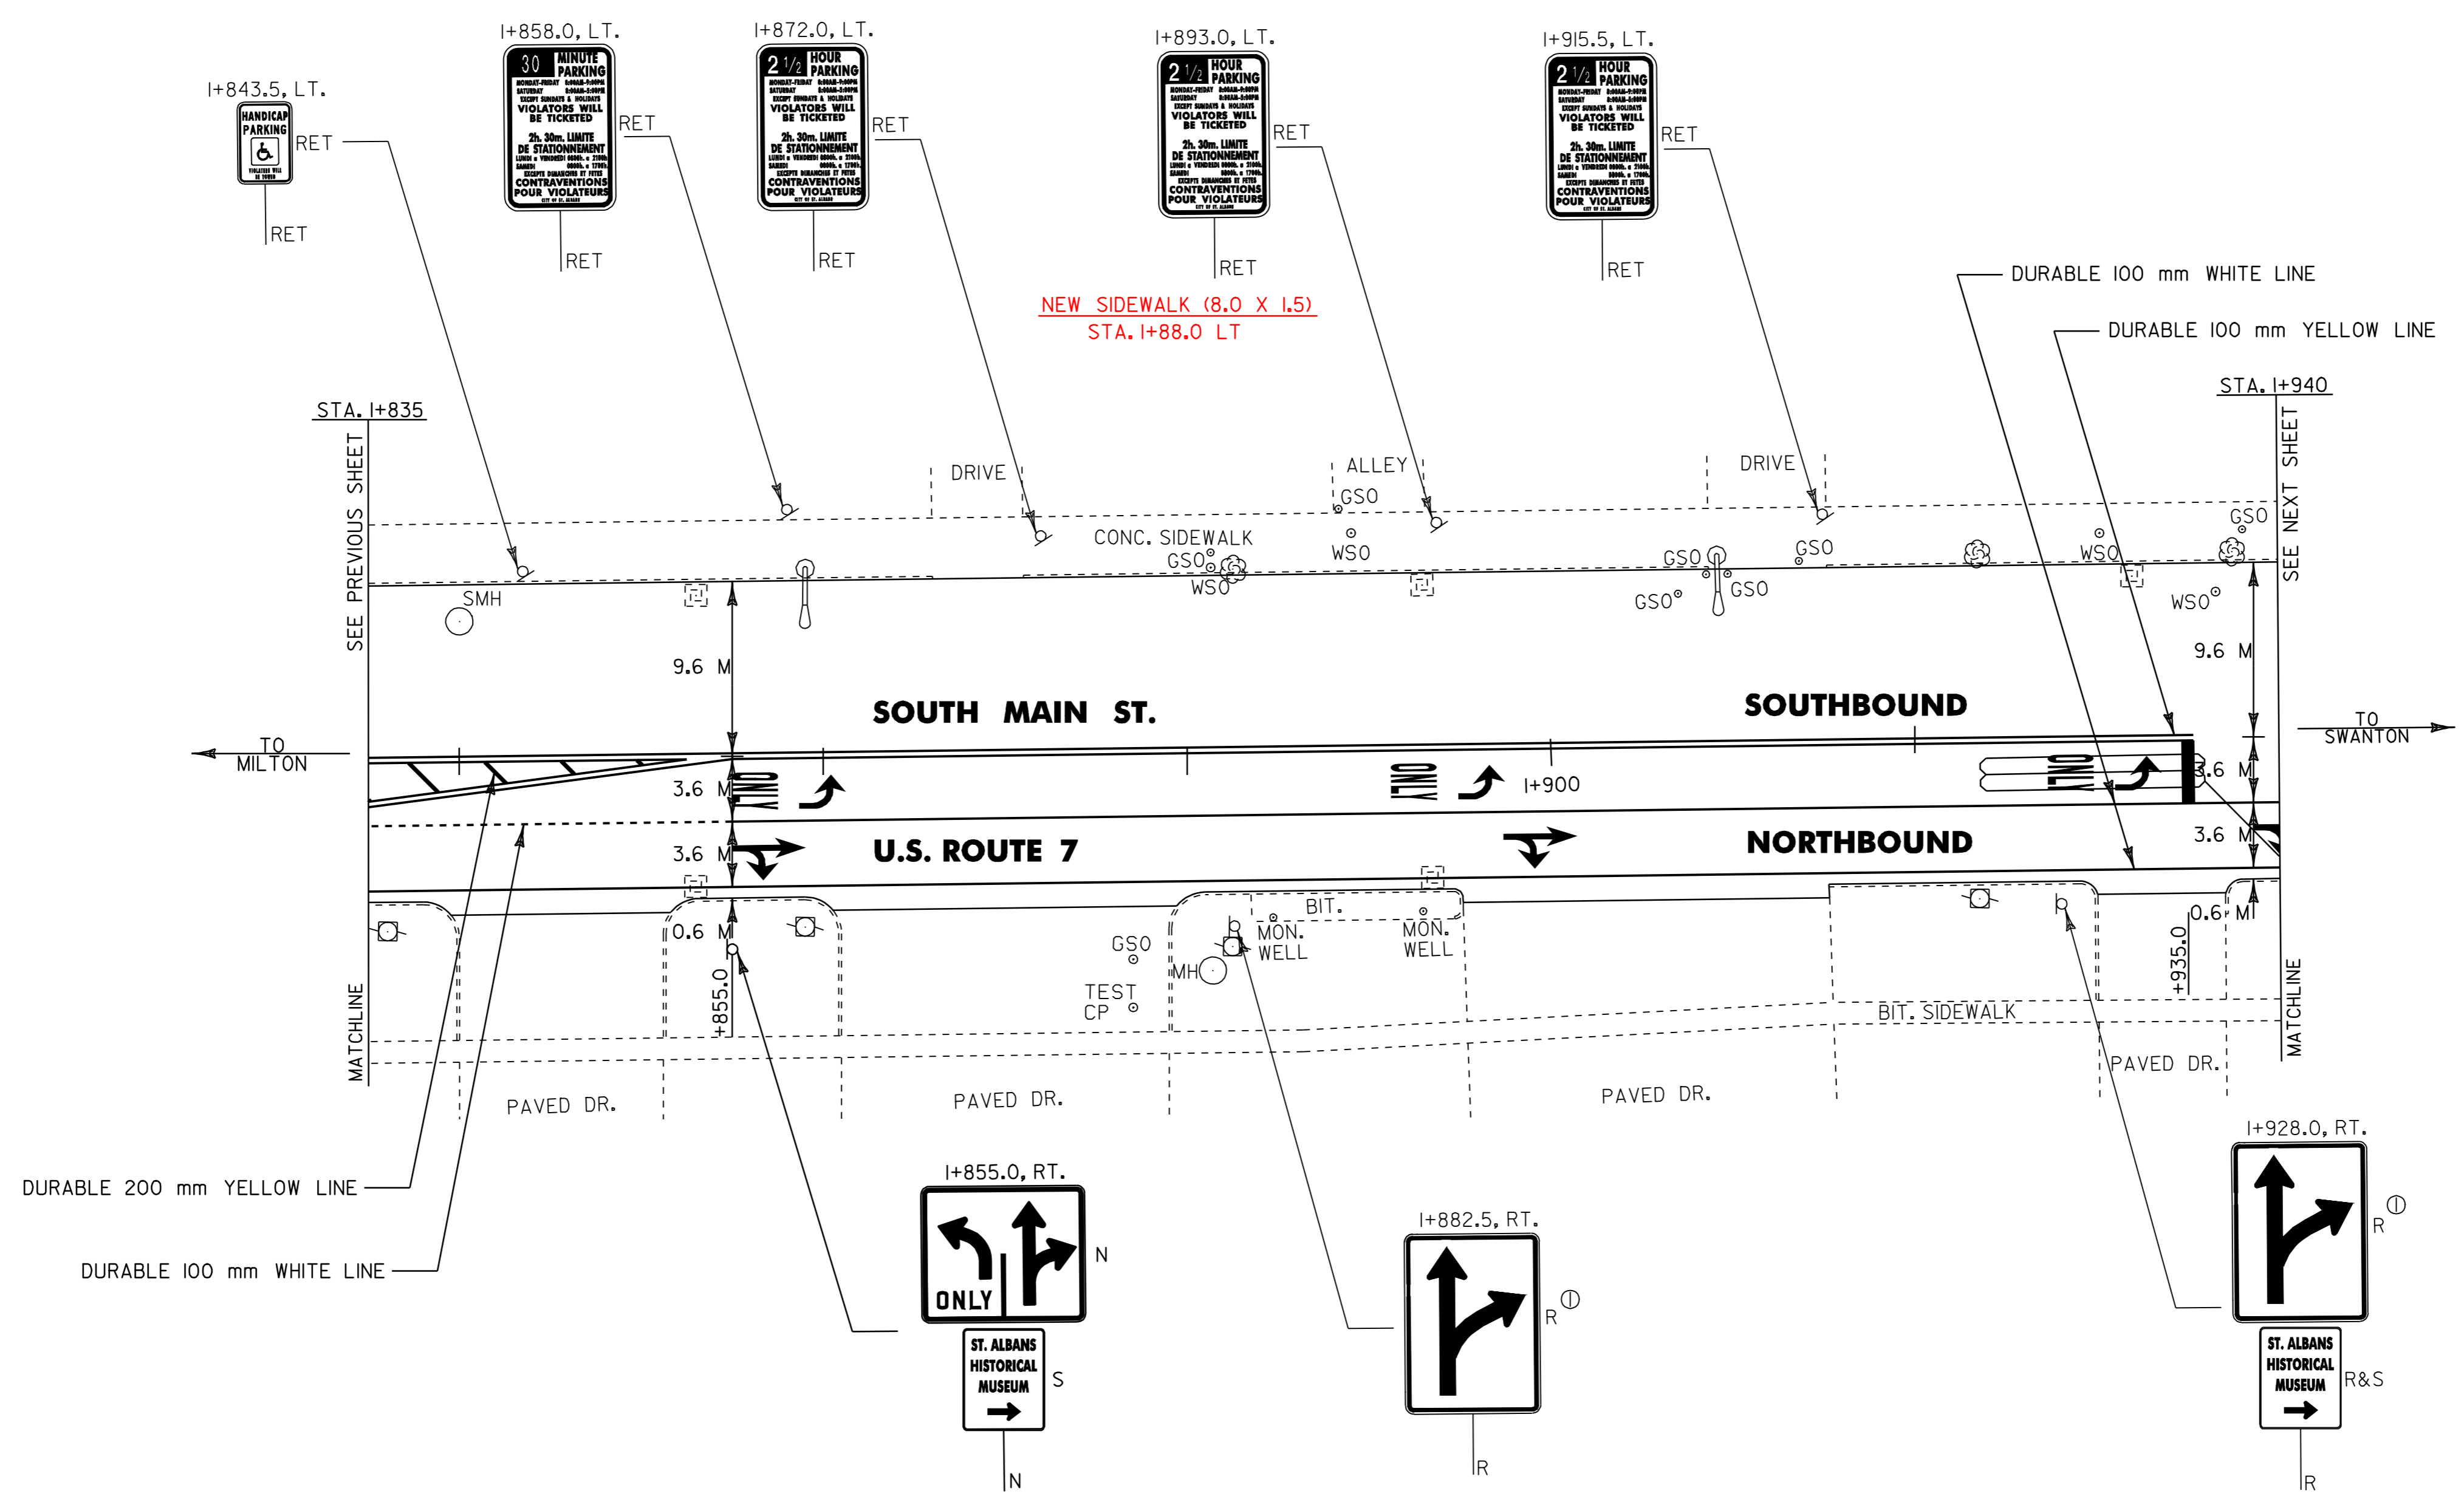


- NOTES:
- 1) ALL DIMENSIONS IN MILLIMETERS EXCEPT WHERE OTHERWISE INDICATED.
 - 2) ALL EXISTING SIGNS NOT SHOWN SHALL BE RETAINED AS DIRECTED BY THE RESIDENT ENGINEER.
 - 3) FOR ANY TOWN HIGHWAY OR STREET DETAILS, SEE VTRANS STANDARD E-193M.
 - 4) FOR VEHICLE DETECTOR LOOP DETAILS SEE SHEET 10.

LAYOUT SHEET #13

PROJECT NAME:	ST. ALBANS CITY	FILE NAME:	2pave297d1502pd150.dgn	PLOT DATE:	01-FEB-2006 07:4
PROJECT NUMBER:	STP_9804(I)S	PROJECT LEADER:	JLL	DRAWN BY:	D-H
DESIGNED BY:	D-H	CHECKED BY:			
IPARM FILE NAME:	pd150p13.i	SHEET	32	OF	105





NOTE: FOR NEW SIGNS AND ALL CONSTRUCTION NOTES, SEE NEXT SHEET.

REMOVING SIGNS AS SHOWN - 43

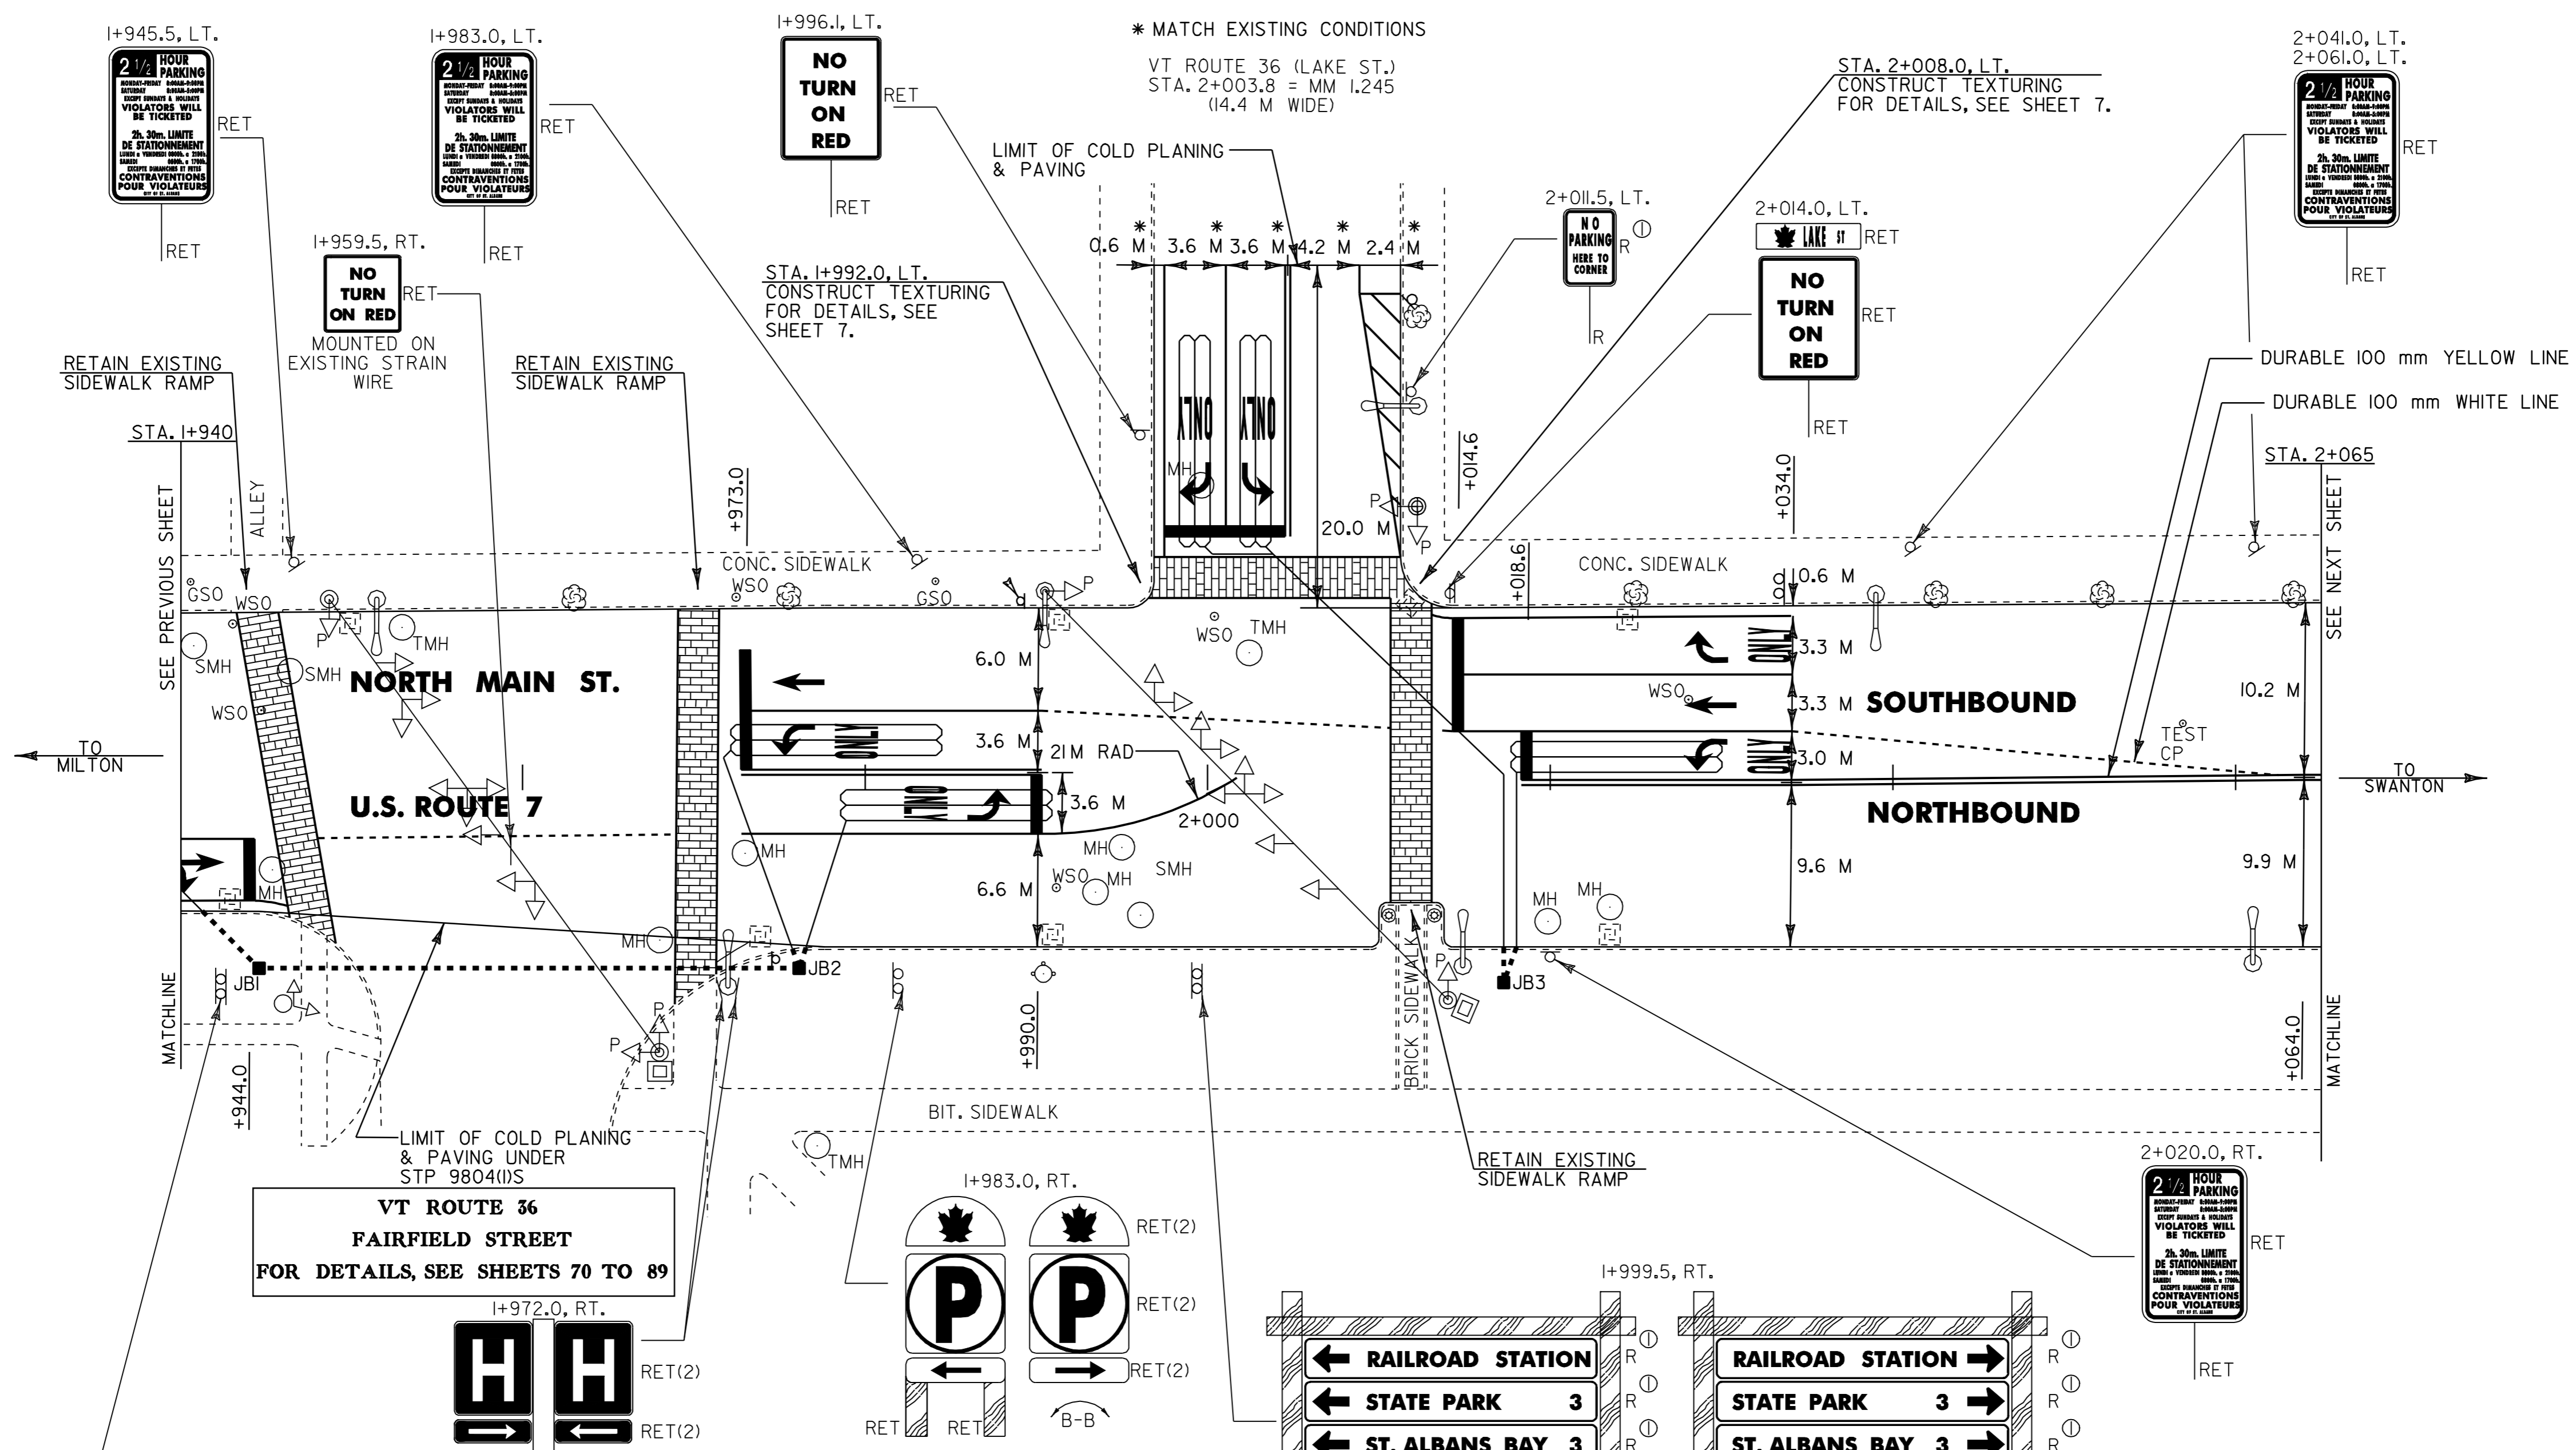

VT ROUTE 36
FAIRFIELD STREET
FOR DETAILS, SEE SHEETS 70 TO 89

BUILT AS DESIGNED

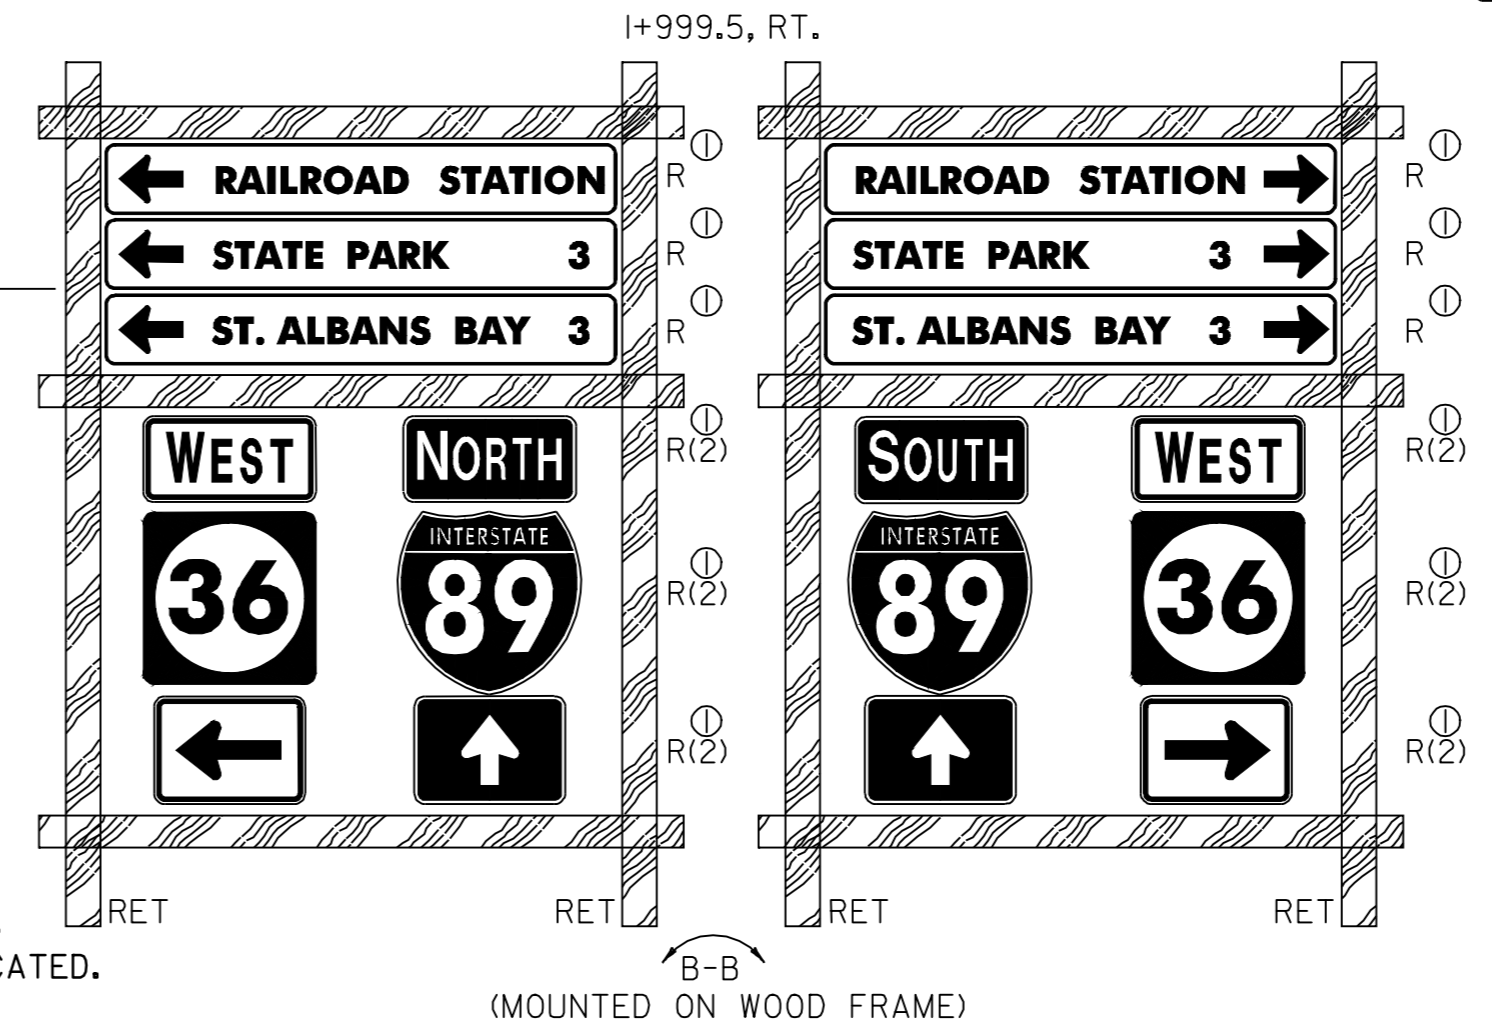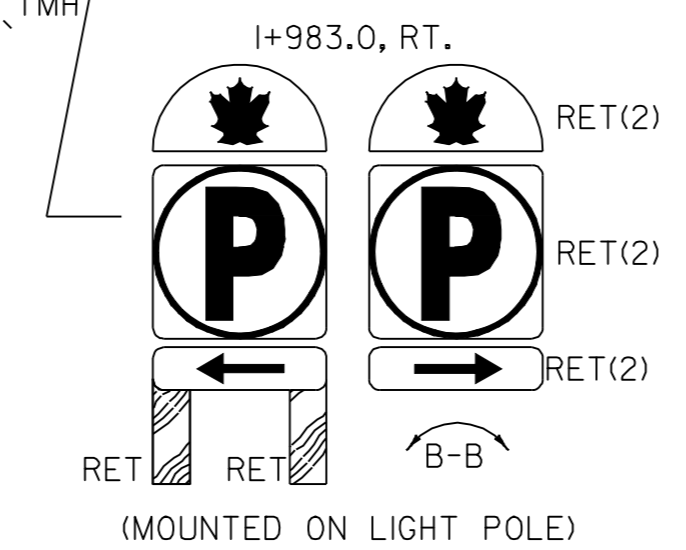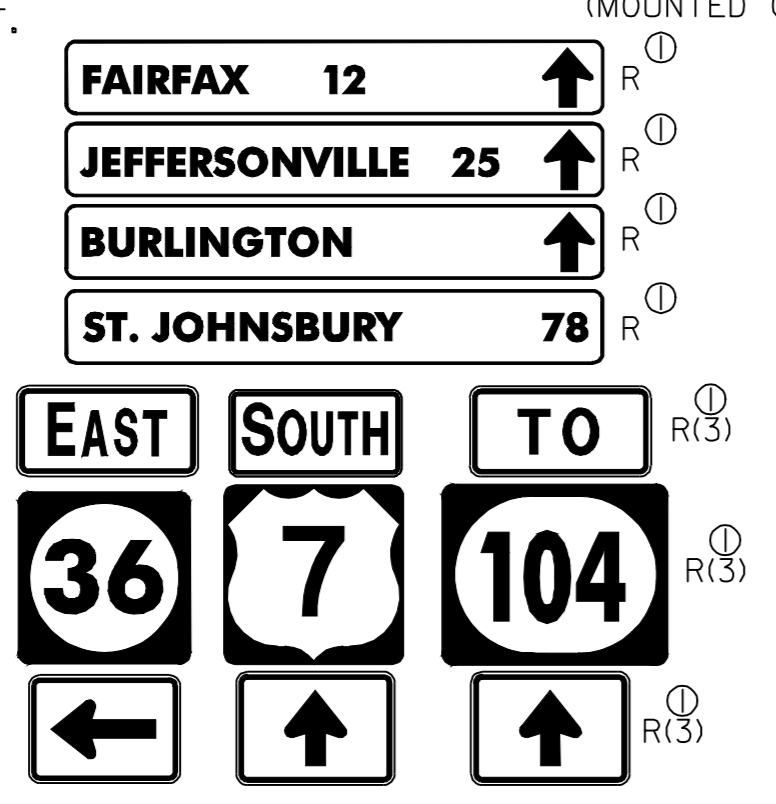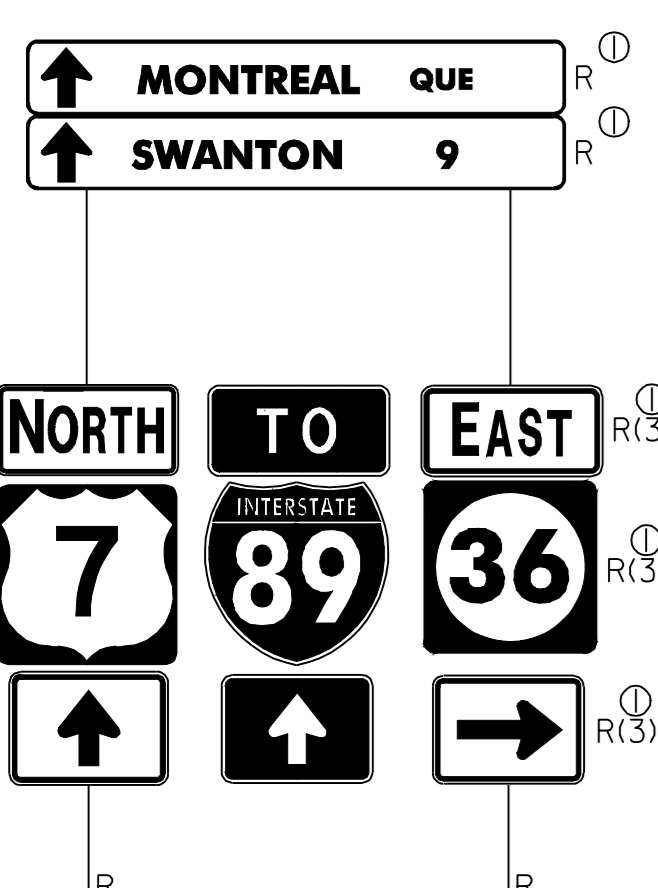

- NOTES:
- 1) ALL DIMENSIONS IN MILLIMETERS EXCEPT WHERE OTHERWISE INDICATED.
 - 2) ALL EXISTING SIGNS NOT SHOWN SHALL BE RETAINED AS DIRECTED BY THE RESIDENT ENGINEER.
 - 3) FOR ANY TOWN HIGHWAY OR STREET DETAILS, SEE VTrans STANDARD E-193M.
 - 4) FOR VEHICLE DETECTOR LOOP DETAILS SEE SHEET 10.

PROJECT LAYOUT #14A EXISTING SIGNS

PROJECT NAME:	ST. ALBANS CITY	FILE NAME:	zpqve297d150zpd150.dgn	PLOT DATE:	01-FEB-2006 07:4
PROJECT NUMBER:	STP_9804(I)S	PROJECT LEADER:	JLL	DRAWN BY:	D-H
DESIGNED BY:	D-H	CHECKED BY:			
IPARM FILE NAME:	pd150p14g1	SHEET	33	OF	105



TEMPORARY & DURABLE 100 mm WHITE LINE
 STA. I+940.0 TO I+944.0, SOLID RT. (LANE LINE)
 STA. I+945.0 TO I+969.0, DOTTED RT.
 STA. I+973.0 TO I+990.0, SOLID LT. (LANE LINE)
 STA. I+973.0 TO 2+002.0, SOLID RT. (LANE LINE)
 STA. I+990.0 TO 2+014.6, DOTTED LT.
 STA. 2+003.8, SOLID LT. (LAKE ST. EDGELINES, LANE LINES & DIAGONALS)
 STA. 2+014.6 TO 2+034.0, SOLID LT. (LANE LINES)
 STA. 2+034.0 TO 2+064.0, DOTTED LT.

TEMPORARY & DURABLE 100 mm YELLOW LINE
 STA. I+973.0 TO I+990.0, SOLID LT. & RT.
 STA. 2+018.6 TO 2+065.0, SOLID LT. & RT.
 STA. 2+003.8, DOUBLE SOLID LT. (LAKE ST.)

TEMPORARY & DURABLE CROSSWALK WITH DIAGONAL LINES (MOD.)
 STA. I+946.0
 STA. I+970.0
 STA. 2+003.8, LT. (LAKE ST.)
 STA. 2+012.0

DURABLE LETTER OR SYMBOL (TYPE ITAPE)
 STA. I+975.7, LT. - " " " 980.0
 STA. I+976.0, LT. - " " " 980.0
 STA. I+979.3, LT. - "ONLY" 985.0
 STA. I+983.7, RT. - "ONLY" 989.0
 STA. I+987.3, RT. - " " " 993.0
 STA. 2+003.8, LT. - "ONLY" (2) (LAKE ST.)
 STA. 2+003.8, LT. - " " " (2) (LAKE ST.)
 STA. 2+029.0, LT. - " " " 034.0
 STA. 2+029.2, LT. - " " " (2) 034.0
 STA. 2+032.8, LT. - "ONLY" (2) 034.0

TEMPORARY LETTER OR SYMBOL
 STA. I+975.7, LT. - " " " 983.0
 STA. I+976.0, LT. - " " " 983.0
 STA. I+987.3, RT. - " " " 983.0
 STA. 2+003.8, LT. - " " " (2)
 (LAKE ST.)
 STA. 2+029.0, LT. - " " " 034.0
 STA. 2+029.2, LT. - " " " (2) 034.0






NOTE: FOR EXISTING SIGNS, SEE PREVIOUS SHEET.

CHANGING ELEVATION OF VALVE BOX
 STA. I+943.5, LT. - WSO
 STA. I+945.5, LT. - WSO
 STA. I+991.0, RT. - WSO
 STA. 2+000.0, LT. - WSO
 STA. 2+028.0, LT. - WSO
 STA. 2+057.0, LT. - TEST CP

CHANGING ELEVATION OF DI'S, CB'S OR MH'S
 STA. I+945.5, RT. - MH
 STA. I+968.0, RT. - MH
 STA. I+973.0, RT. - MH
 STA. I+991.0, LT. - DI
 STA. I+993.0, RT. - MH
 STA. I+995.0, RT. - MH
 STA. I+999.0, LT. - MH
 STA. 2+020.0, RT. - MH
 STA. 2+023.5, RT. - MH

REHABILITATION OF DI'S, CB'S OR MH'S - CLASS I
 STA. I+943.0, RT. - DI
 STA. I+950.0, LT. - DI
 STA. I+974.0, RT. - DI LT.
 STA. I+991.0, RT. - DI RT.<.
 STA. 2+009.0, LT. - DI
 STA. 2+023.5, RT. - DI
 STA. 2+024.5, LT. - DI

CHANGING ELEVATION OF SMH'S
 STA. I+940.5, LT.
 STA. I+946.5, LT.
 STA. I+996.0, RT.
 PAINTED CURB
 IN NO-PARKING AREAS AS DIRECTED BY RESIDENT ENGINEER

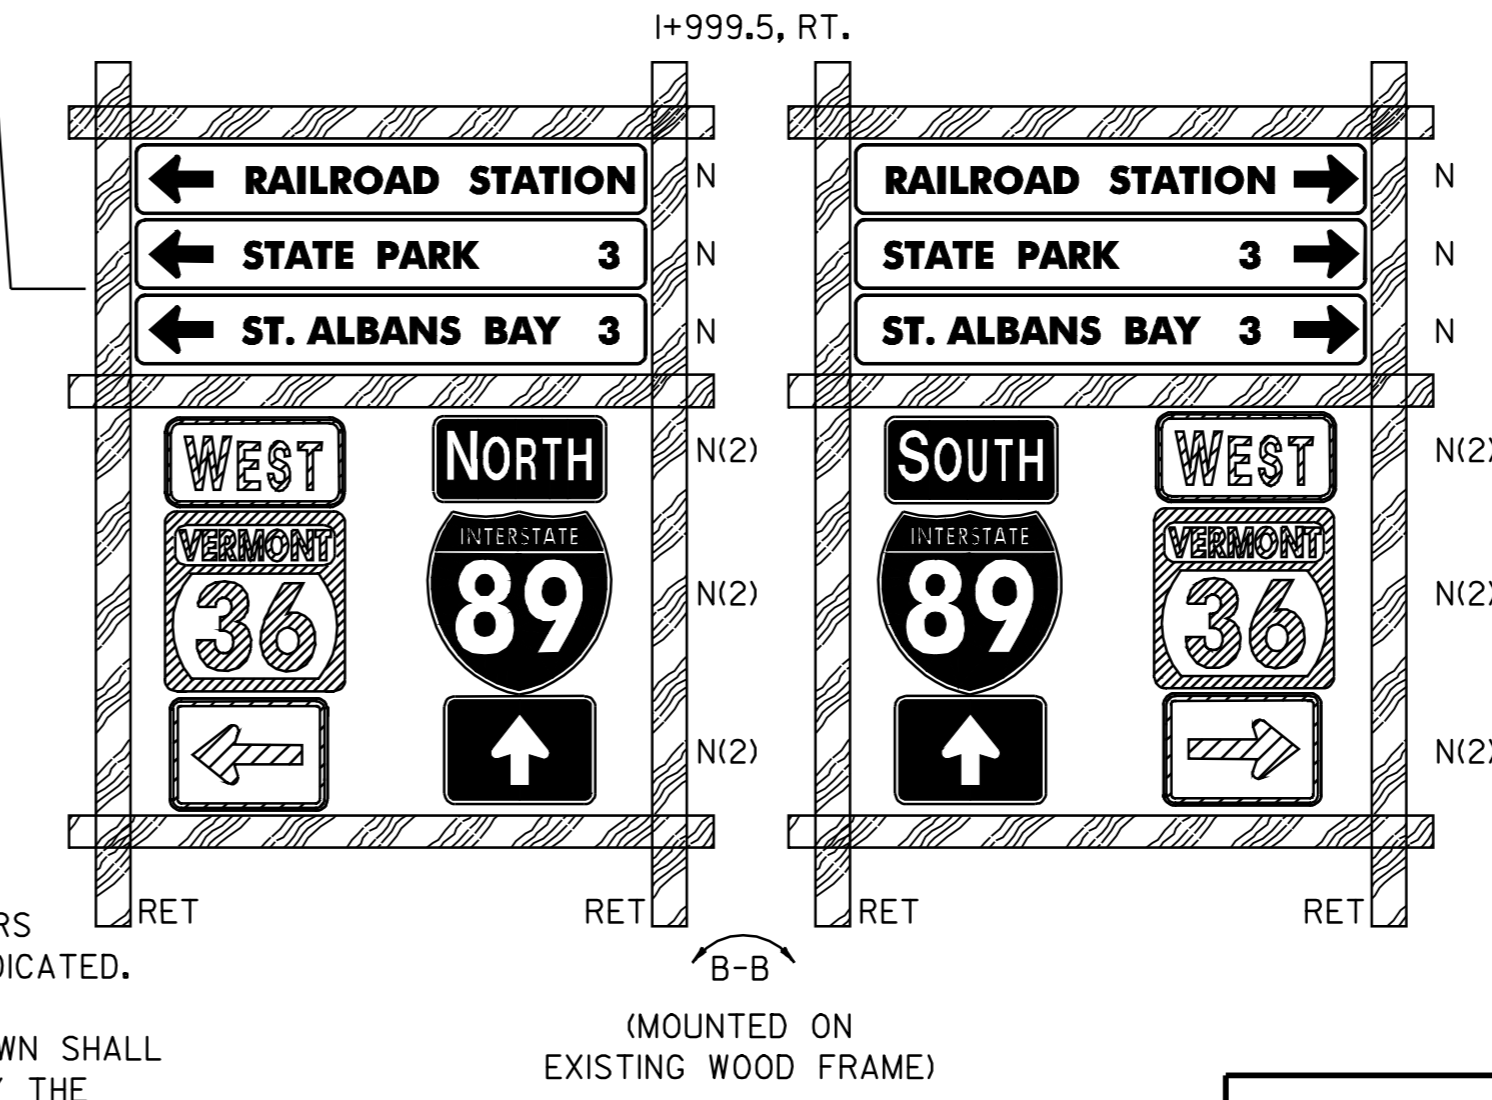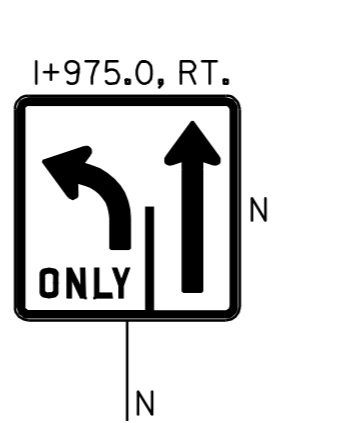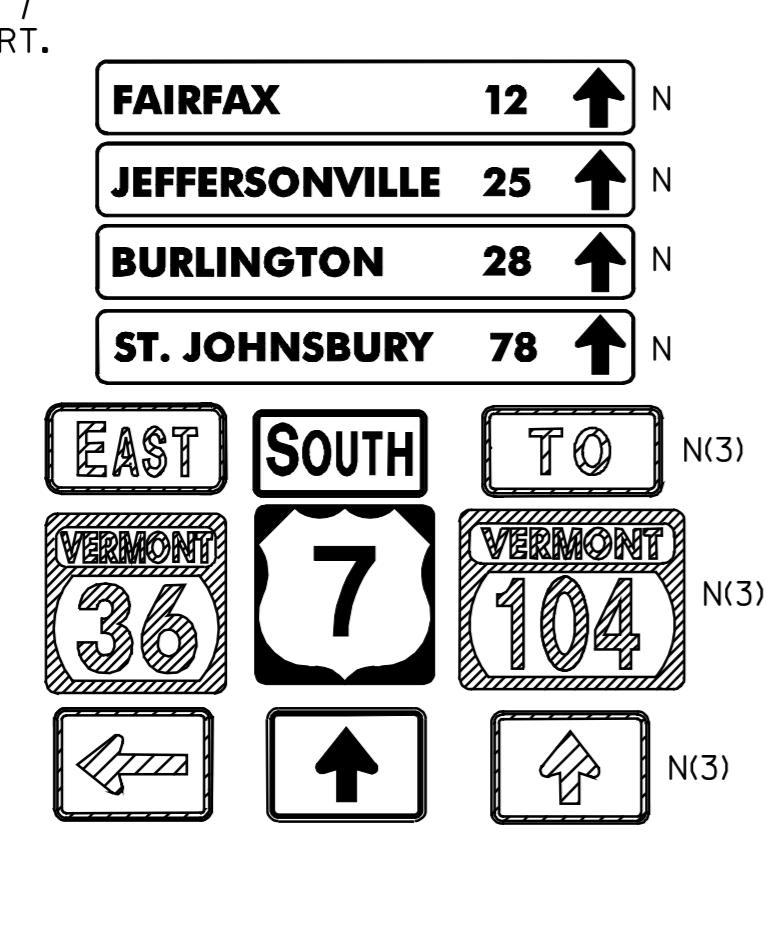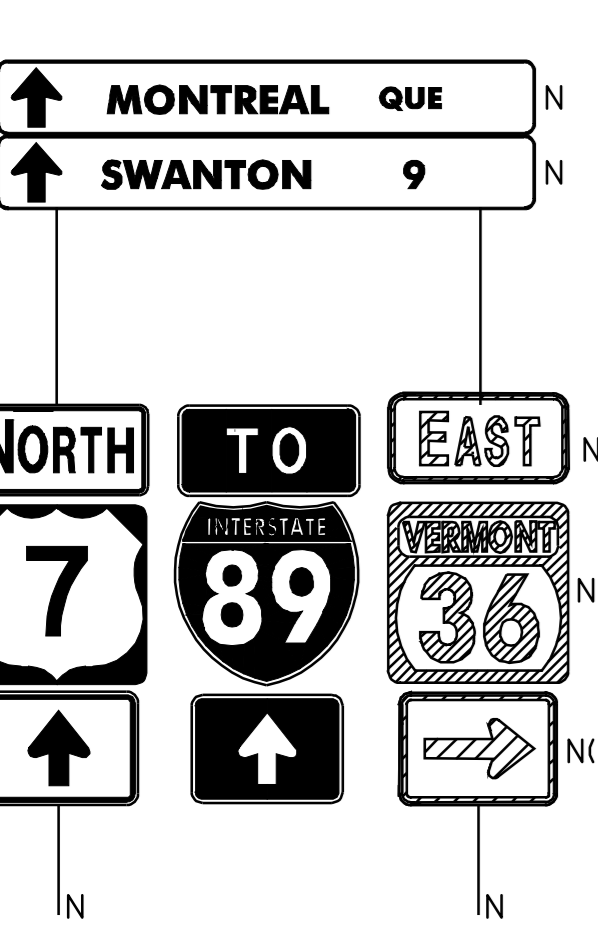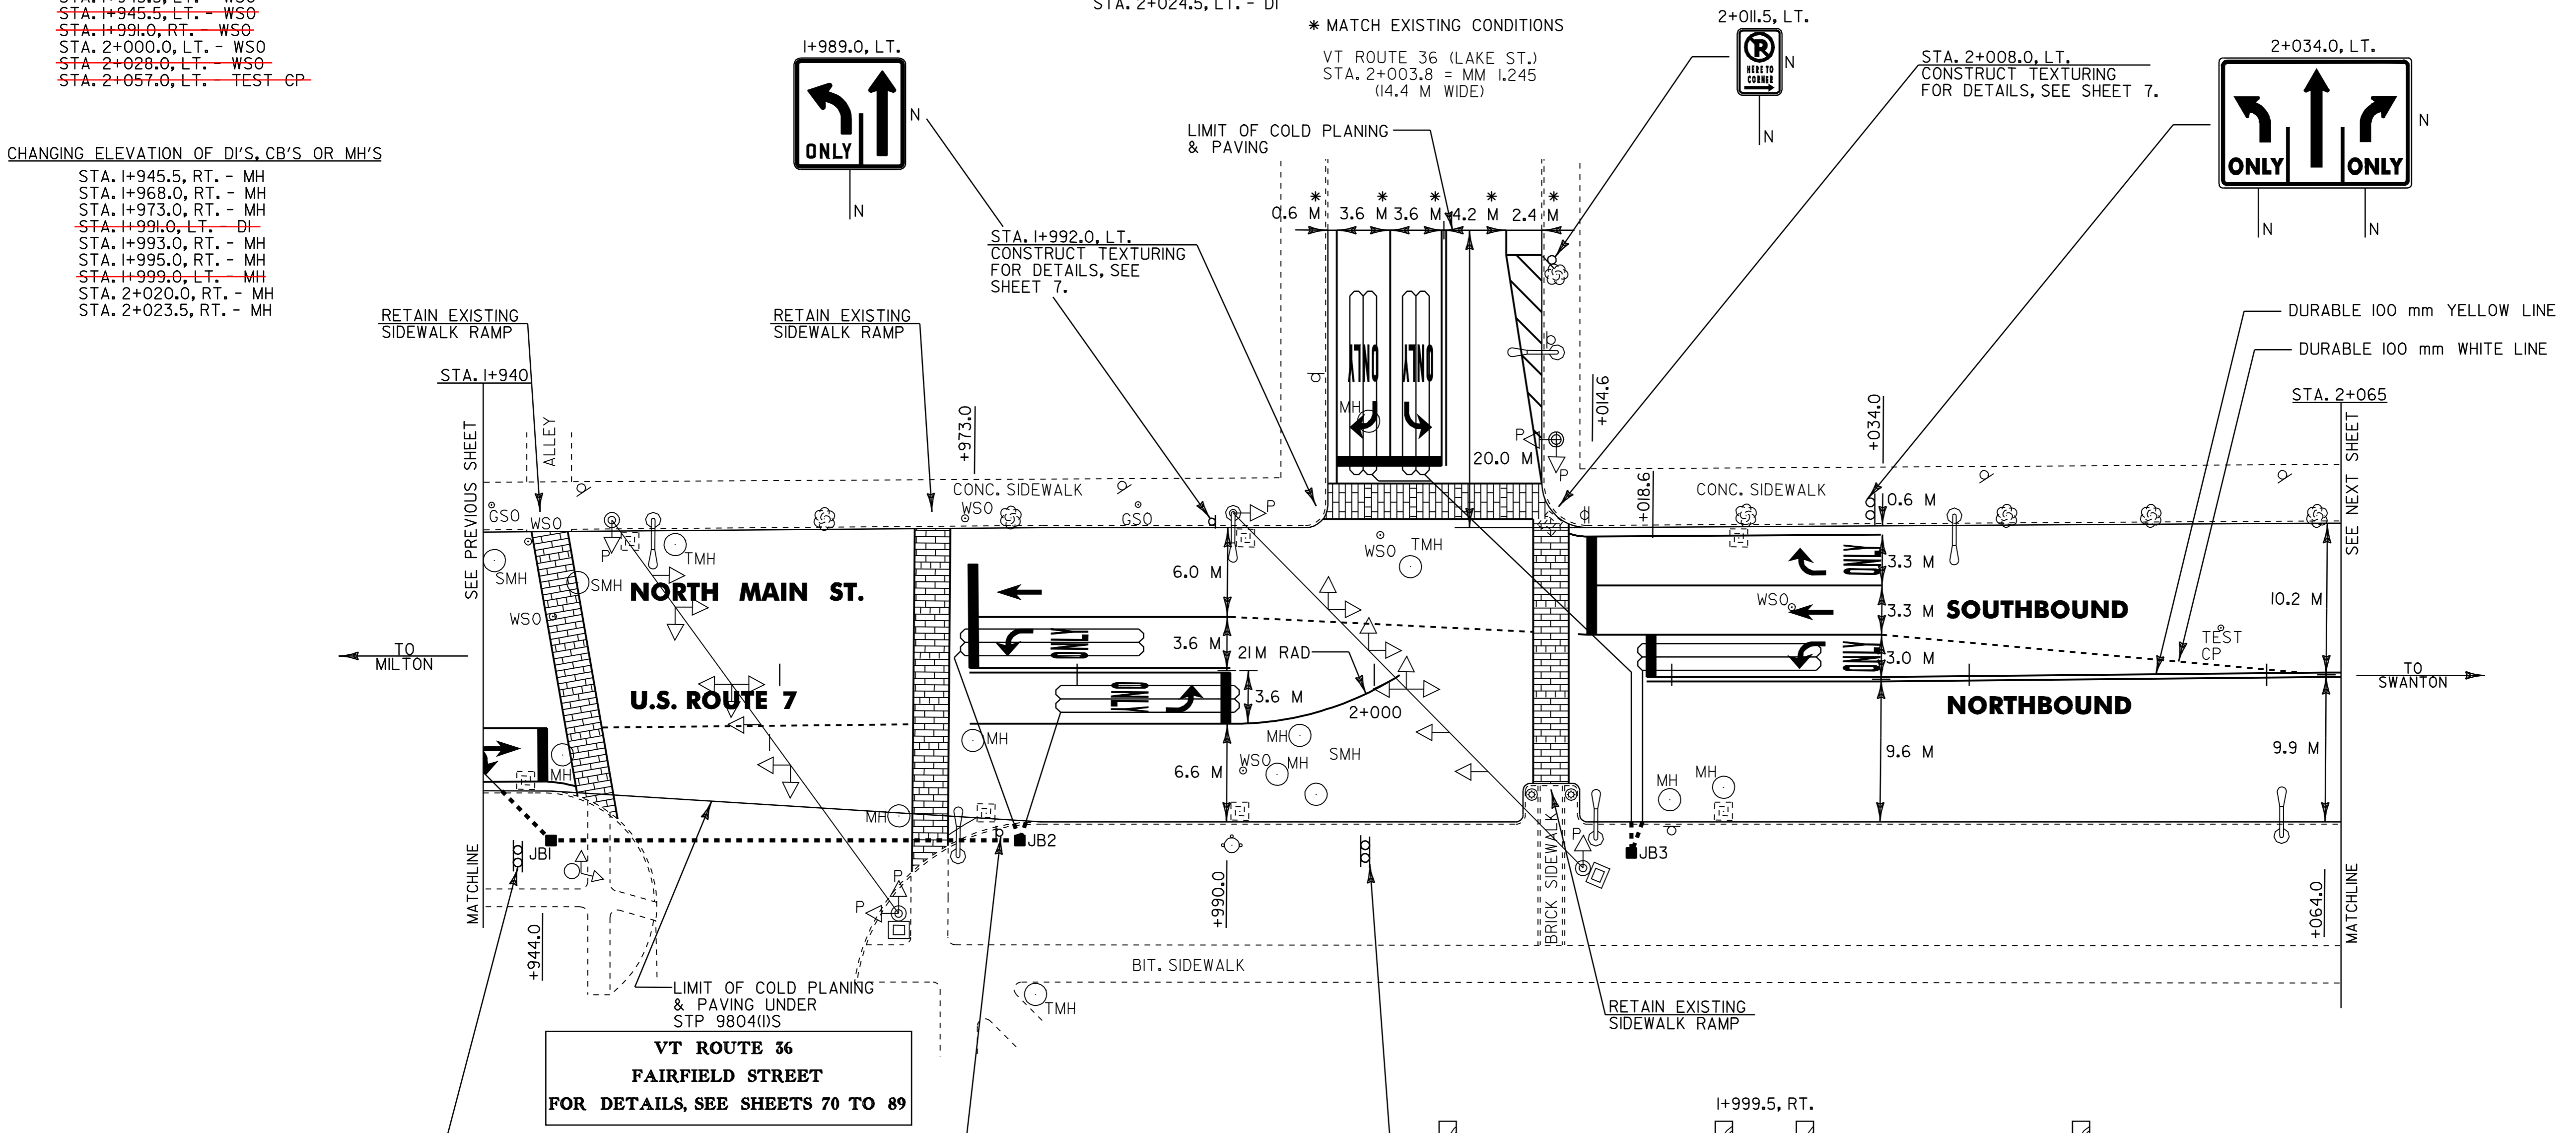

- NOTES: 1) ALL DIMENSIONS IN MILLIMETERS EXCEPT WHERE OTHERWISE INDICATED.
 2) ALL EXISTING SIGNS NOT SHOWN SHALL BE RETAINED AS DIRECTED BY THE RESIDENT ENGINEER.
 3) FOR ANY TOWN HIGHWAY OR STREET DETAILS, SEE VTrans STANDARD E-193M.
 4) FOR VEHICLE DETECTOR LOOP DETAILS SEE SHEET 10.


PROJECT LAYOUT #14B PROPOSED SIGNS

PROJECT NAME: ST. ALBANS CITY	PLOT DATE: 01-FEB-2006 07:4
PROJECT NUMBER: STP_9804(I)S	DRAWN BY: D-H
FILE NAME: Zpqve297d150Zpd150.dgn	CHECKED BY:
DESIGNED BY: D-H	SHEET 34 OF 105
IPARM FILE NAME: pd150pd14b.i	



NOTE: FOR NEW SIGNS AND ALL CONSTRUCTION NOTES, SEE NEXT SHEET.

REMOVING SIGNS AS SHOWN - 6

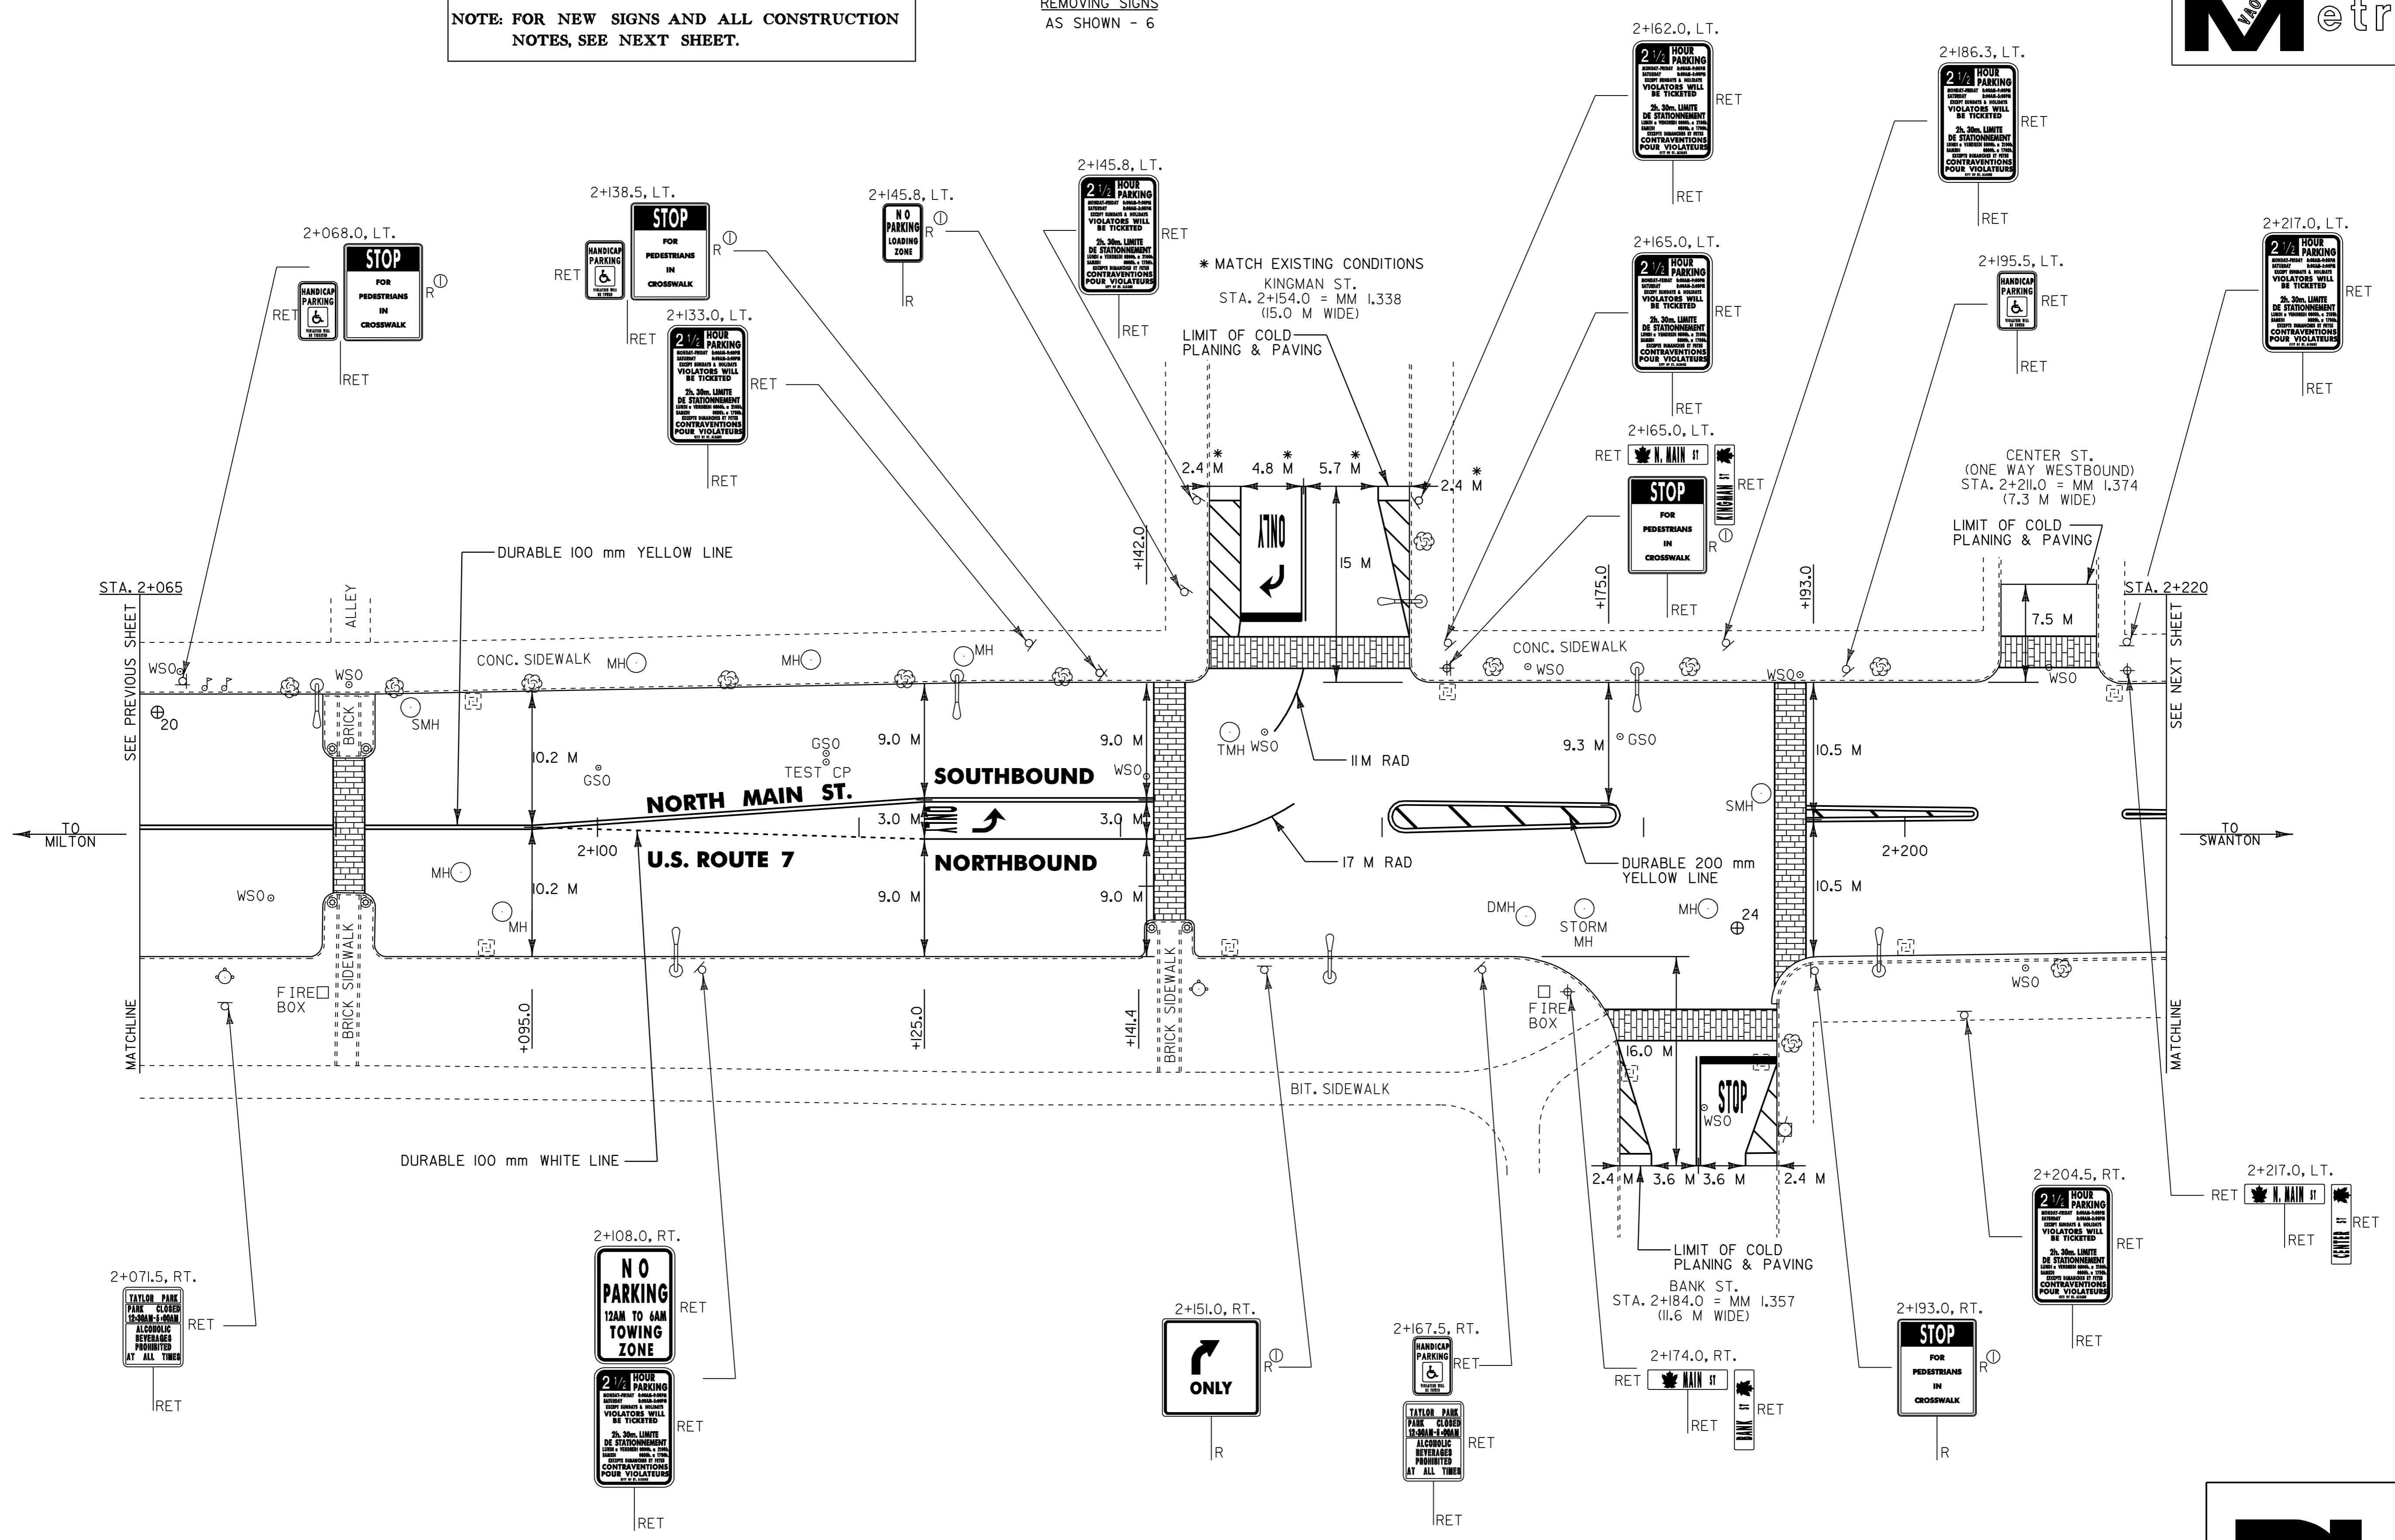

⊕ CORE LOCATION

PAVEMENT CORE DATA			
CORE #	LOCATION	DEPTH (mm)	PCC
20	2+066.4, LT.	89	NO
24	2+187.1, RT.	165	NO

- NOTES:
- 1) ALL DIMENSIONS IN MILLIMETERS EXCEPT WHERE OTHERWISE INDICATED.
 - 2) ALL EXISTING SIGNS NOT SHOWN SHALL BE RETAINED AS DIRECTED BY THE RESIDENT ENGINEER.
 - 3) FOR ANY TOWN HIGHWAY OR STREET DETAILS, SEE VTrans STANDARD E-193M.

PROJECT LAYOUT #15A EXISTING SIGNS

PROJECT NAME: ST. ALBANS CITY
 PROJECT NUMBER: STP_9804(1)S
 FILE NAME: \pave\97\dl50\pd150.dgn
 PROJECT LEADER: JLL
 DESIGNED BY: D-H
 IPARM FILE NAME: pd150pl5a.i
 PLOT DATE: 01-FEB-2006 07:45
 DRAWN BY: D-H
 CHECKED BY:
 SHEET 35 OF 105



TEMPORARY LETTER OR SYMBOL
 STA. 2+129.8, LT. - "ONLY" 125.0
 STA. 2+154.7, LT. - "ONLY" (KINGMAN ST.)
 STA. 2+184.0, RT. - "STOP"

DURABLE LETTER OR SYMBOL (TYPE I TAPE)
 STA. 2+126.2, LT. - "ONLY" 135.0
 STA. 2+129.8, LT. - "ONLY" 139.0
 STA. 2+154.7, LT. - "ONLY" (KINGMAN ST.)
 STA. 2+154.7, LT. - "ONLY" (KINGMAN ST.)
 STA. 2+184.0, RT. - "STOP"

TEMPORARY & DURABLE 200 mm YELLOW LINE
 STA. 2+160.0 TO 2+220.0, SOLID LT. (DIAGONALS)

TEMPORARY & DURABLE 600 mm STOP BAR (TYPE I TAPE)
 STA. 2+154.0, LT. (KINGMAN ST.)
 STA. 2+184.0, RT. (BANK ST.)

PAINTED CURB
 IN NO-PARKING AREAS AS DIRECTED BY RESIDENT ENGINEER

CHANGING ELEVATION OF SMH'S
 STA. 2+085.0, LT.
 STA. 2+189.0, LT.



TEMPORARY & DURABLE 100 mm WHITE LINE
 STA. 2+095.0 TO 2+125.0, DOTTED RT.
 STA. 2+125.0 TO 2+154.0, SOLID RT. (LANE LINE)
 STA. 2+154.0, SOLID LT. (KINGMAN ST. EDGELINES, & DIAGONALS)
 STA. 2+184.0, SOLID RT. (BANK ST. EDGELINES, & DIAGONALS)

REHABILITATION OF DI'S, CB'S OR MH'S - CLASS I
 STA. 2+090.0, LT. - DI
 STA. 2+091.0, RT. - DI
 STA. 2+148.5, RT. - DI
 STA. 2+165.0, LT. - DI
 STA. 2+180.0, RT. - DI
 STA. 2+189.0, RT. - DI
 STA. 2+200.0, RT. - DI
 STA. 2+216.0, LT. - DI


TEMPORARY & DURABLE CROSSWALK WITH DIAGONAL LINES (MOD.)
 STA. 2+071.7
 STA. 2+143.2
 STA. 2+154.0, LT. (KINGMAN ST.)
 STA. 2+184.0, RT. (BANK ST.)
 STA. 2+191.8
 STA. 2+211.0, LT. (CENTER ST.)

TEMPORARY & DURABLE 100 mm YELLOW LINE
 STA. 2+065.0 TO 2+142.0, SOLID LT. & RT.
 STA. 2+154.0, DOUBLE SOLID LT. (KINGMAN ST.)
 STA. 2+160.0 TO 2+220.0, DOUBLE SOLID (WITH CENTERLINE BREAKS FOR BANK ST. & CENTER ST.)
 STA. 2+184.0, DOUBLE SOLID RT. (BANK ST.)

CHANGING ELEVATION OF DI'S, CB'S OR MH'S
 STA. 2+089.0, RT. - MH
 STA. 2+092.0, RT. - MH
 STA. 2+171.0, RT. - DRAIN MH
 STA. 2+175.0, RT. - STORM MH
 STA. 2+185.0, RT. - MH
 STA. 2+211.0, RT. - MH

ADJUST ELEVATION OF VALVE BOX
 STA. 2+075.0, RT. - WSO
 STA. 2+175.0, LT. - TEST CP
 STA. 2+142.0, LT. - WSO
 STA. 2+150.0, LT. - WSO
 STA. 2+185.0, RT. - WSO
 STA. 2+211.0, LT. - WSO

NOTE: FOR EXISTING SIGNS, SEE PREVIOUS SHEET.

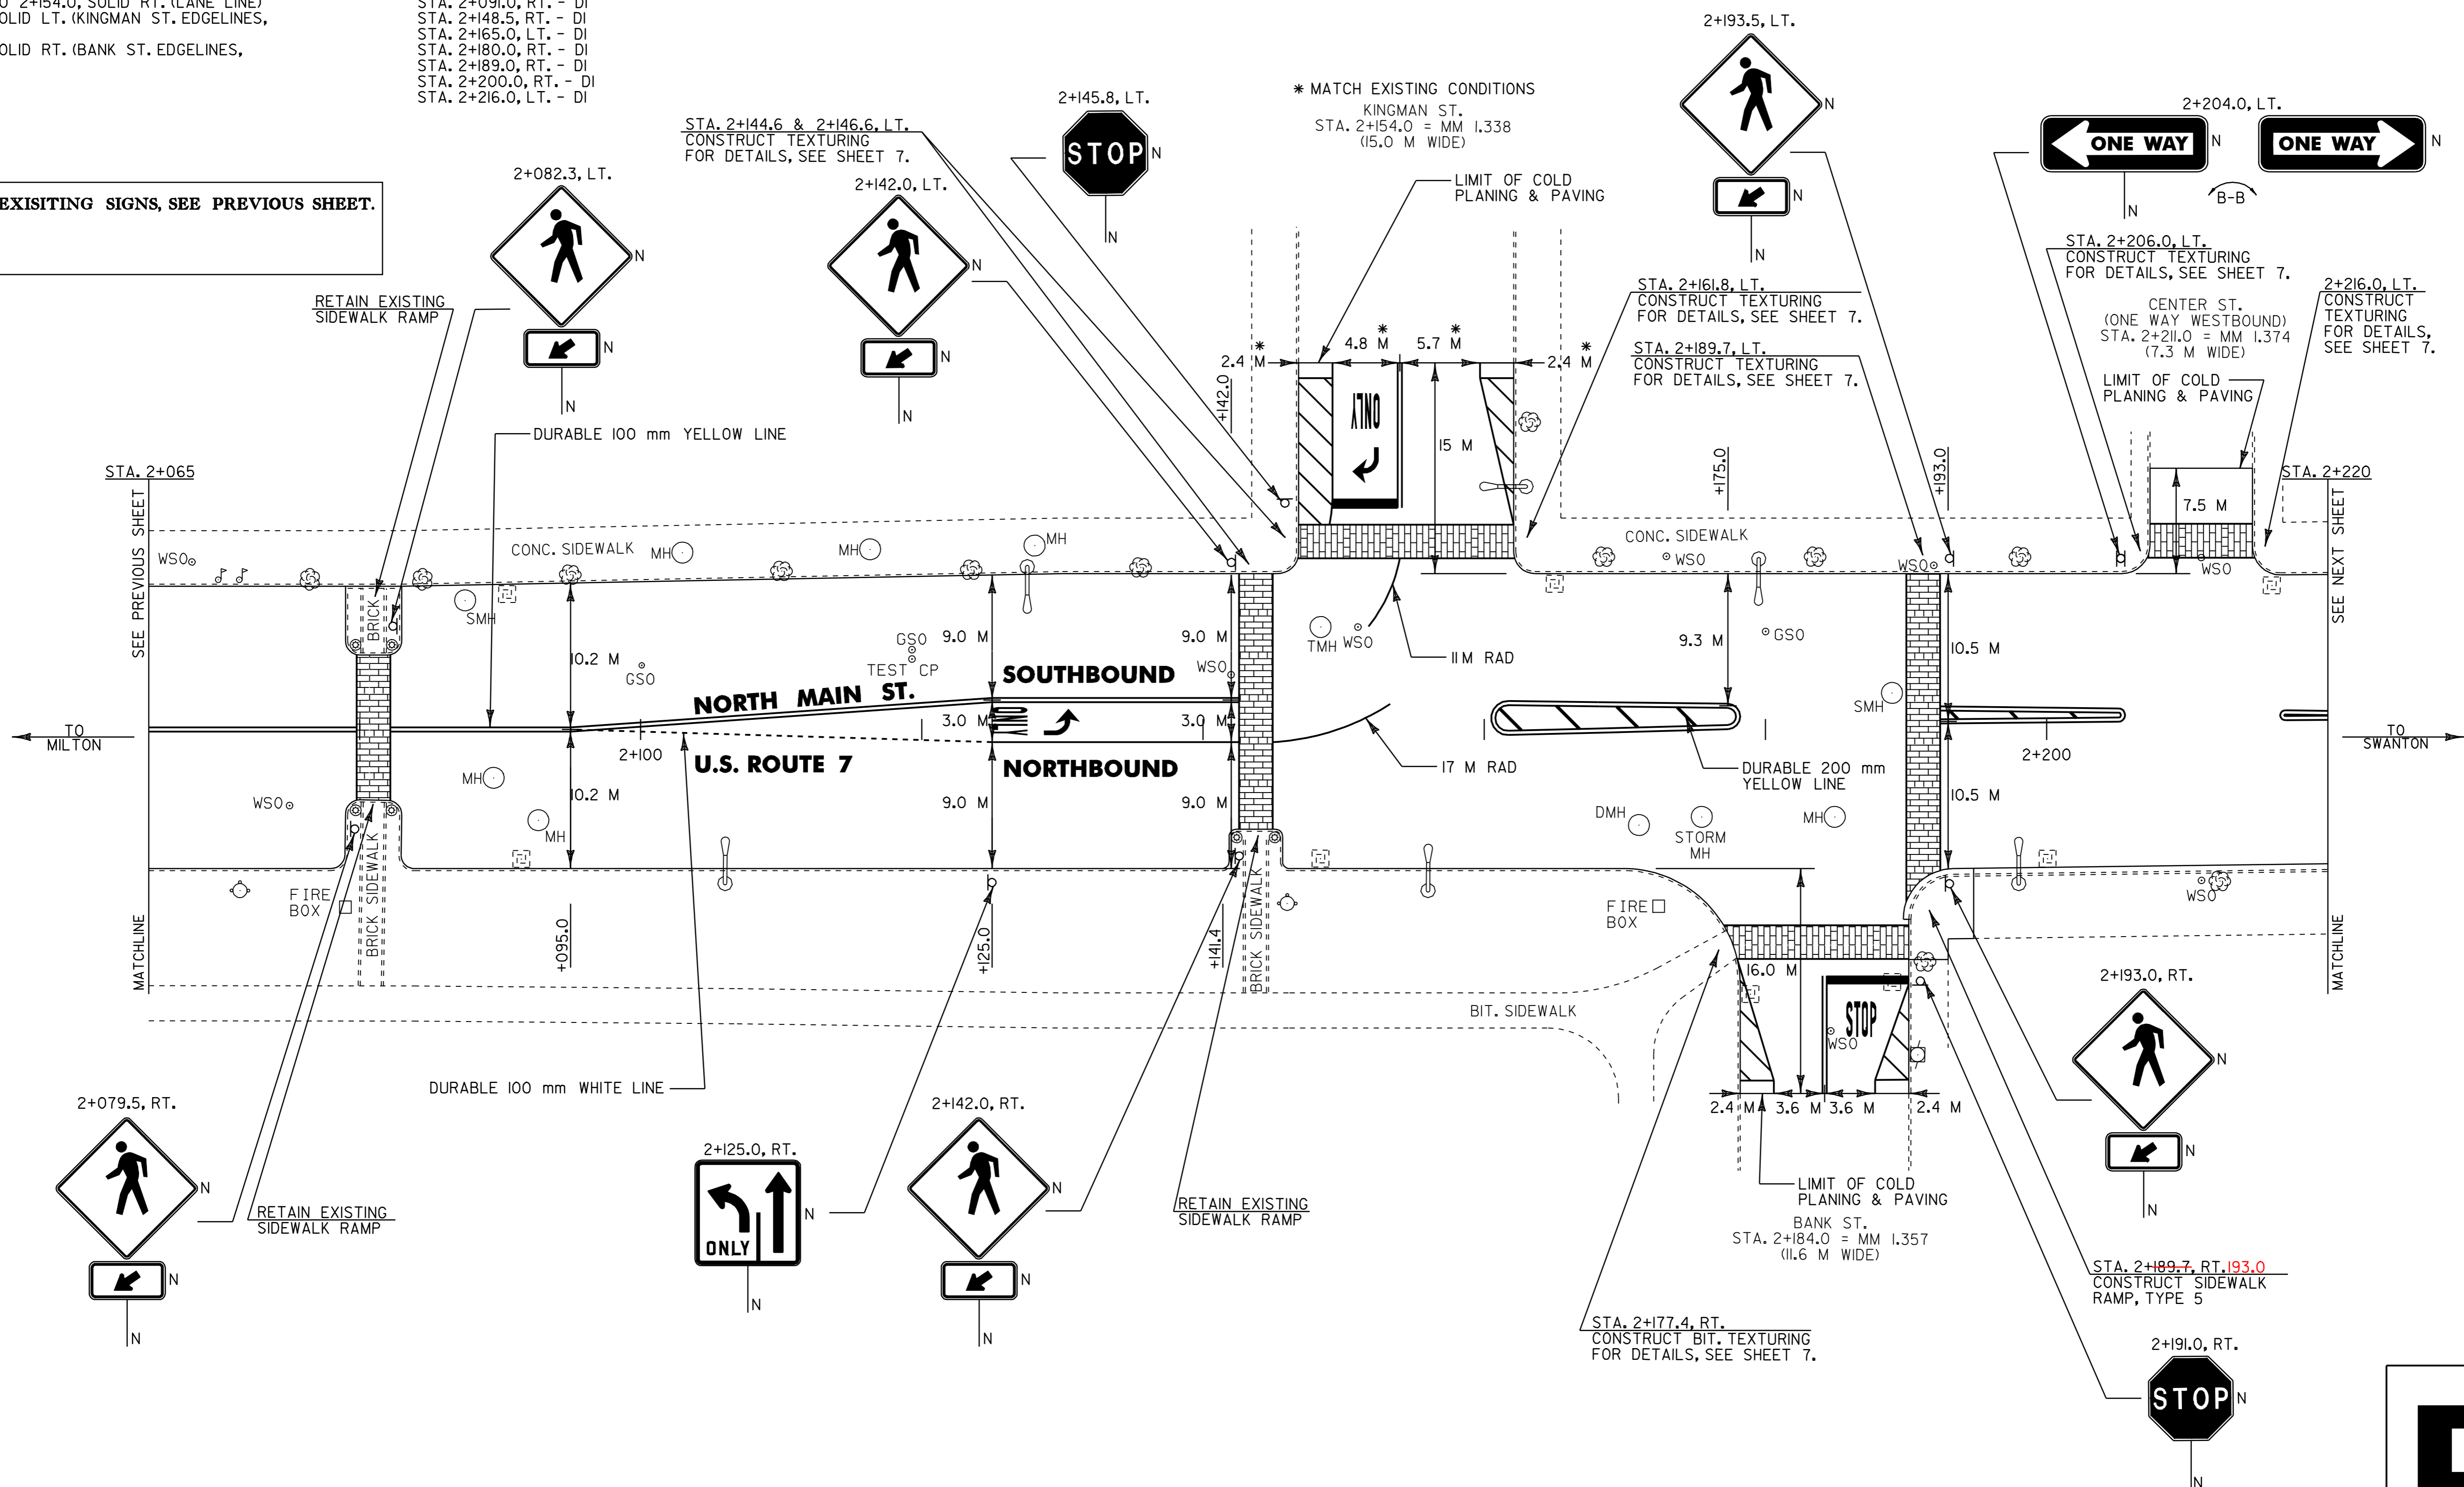

NOTES: 1) ALL DIMENSIONS IN MILLIMETERS EXCEPT WHERE OTHERWISE INDICATED.
 2) ALL EXISTING SIGNS NOT SHOWN SHALL BE RETAINED AS DIRECTED BY THE RESIDENT ENGINEER.
 3) FOR ANY TOWN HIGHWAY OR STREET DETAILS, SEE VTrans STANDARD E-193M.

PROJECT LAYOUT #15B PROPOSED SIGNS	PROJECT NAME: ST. ALBANS CITY	PLOT DATE: 01-FEB-2006 07:45
	PROJECT NUMBER: STP_9804(1)S	DRAWN BY: D-H
	FILE NAME: Z:\pave\97\d150\pd150.dgn	CHECKED BY:
	DESIGNED BY: D-H	SHEET 36 OF 105



STA. 2+259.0, LT. - MH
STA. 2+275.0, RT. - MH
STA. 2+301.0, RT. - MH
STA. 2+308.0, LT. - MH
STA. 2+311.0, RT. - DRAIN MH

STA. 2+220.0 TO 2+340.0, SOLID LT. & RT. (WITH CENTERLINE BREAKS FOR CONGRESS ST. & HUDSON ST.)
STA. 2+298.0, DOUBLE SOLID RT. (CONGRESS ST.)

STA. 2+298.0, RT. (CONGRESS ST.)
STA. 2+306.4
STA. 2+311.0, LT. (HUDSON ST.)

STA. 2+298.0, RT. - 'STOP'


STA. 2+300.0, RT.
STA. 2+259.0, LT.
STA. 2+308.0, LT.



STA. 2+288.0, RT. - DI
STA. 2+293.0, RT. - DI'S (2)
STA. 2+302.0, RT. - DI'S (2)
STA. 2+311.0, RT. - DI
STA. 2+314.0, LT. - DI
STA. 2+329.5, LT. - DI

STA. 2+229.0, LT. - WSO
STA. 2+234.0, LT. - WSO
STA. 2+244.0, RT. - WSO
STA. 2+245.0, RT. - WSO
STA. 2+246.0, LT. - WSO
STA. 2+250.0, LT. - TEST CP (2)
STA. 2+292.0, LT. - WSO
STA. 2+297.1, RT. - WSO
STA. 2+299.0, RT. - WSO
STA. 2+305.0, LT. - WSO
STA. 2+306.0, RT. - WSO
STA. 2+315.0, LT. - TEST CP
STA. 2+294.0, RT. - WSO

CONSTRUCT NEW SIDEWALK
STA. 2+276.5, LT.

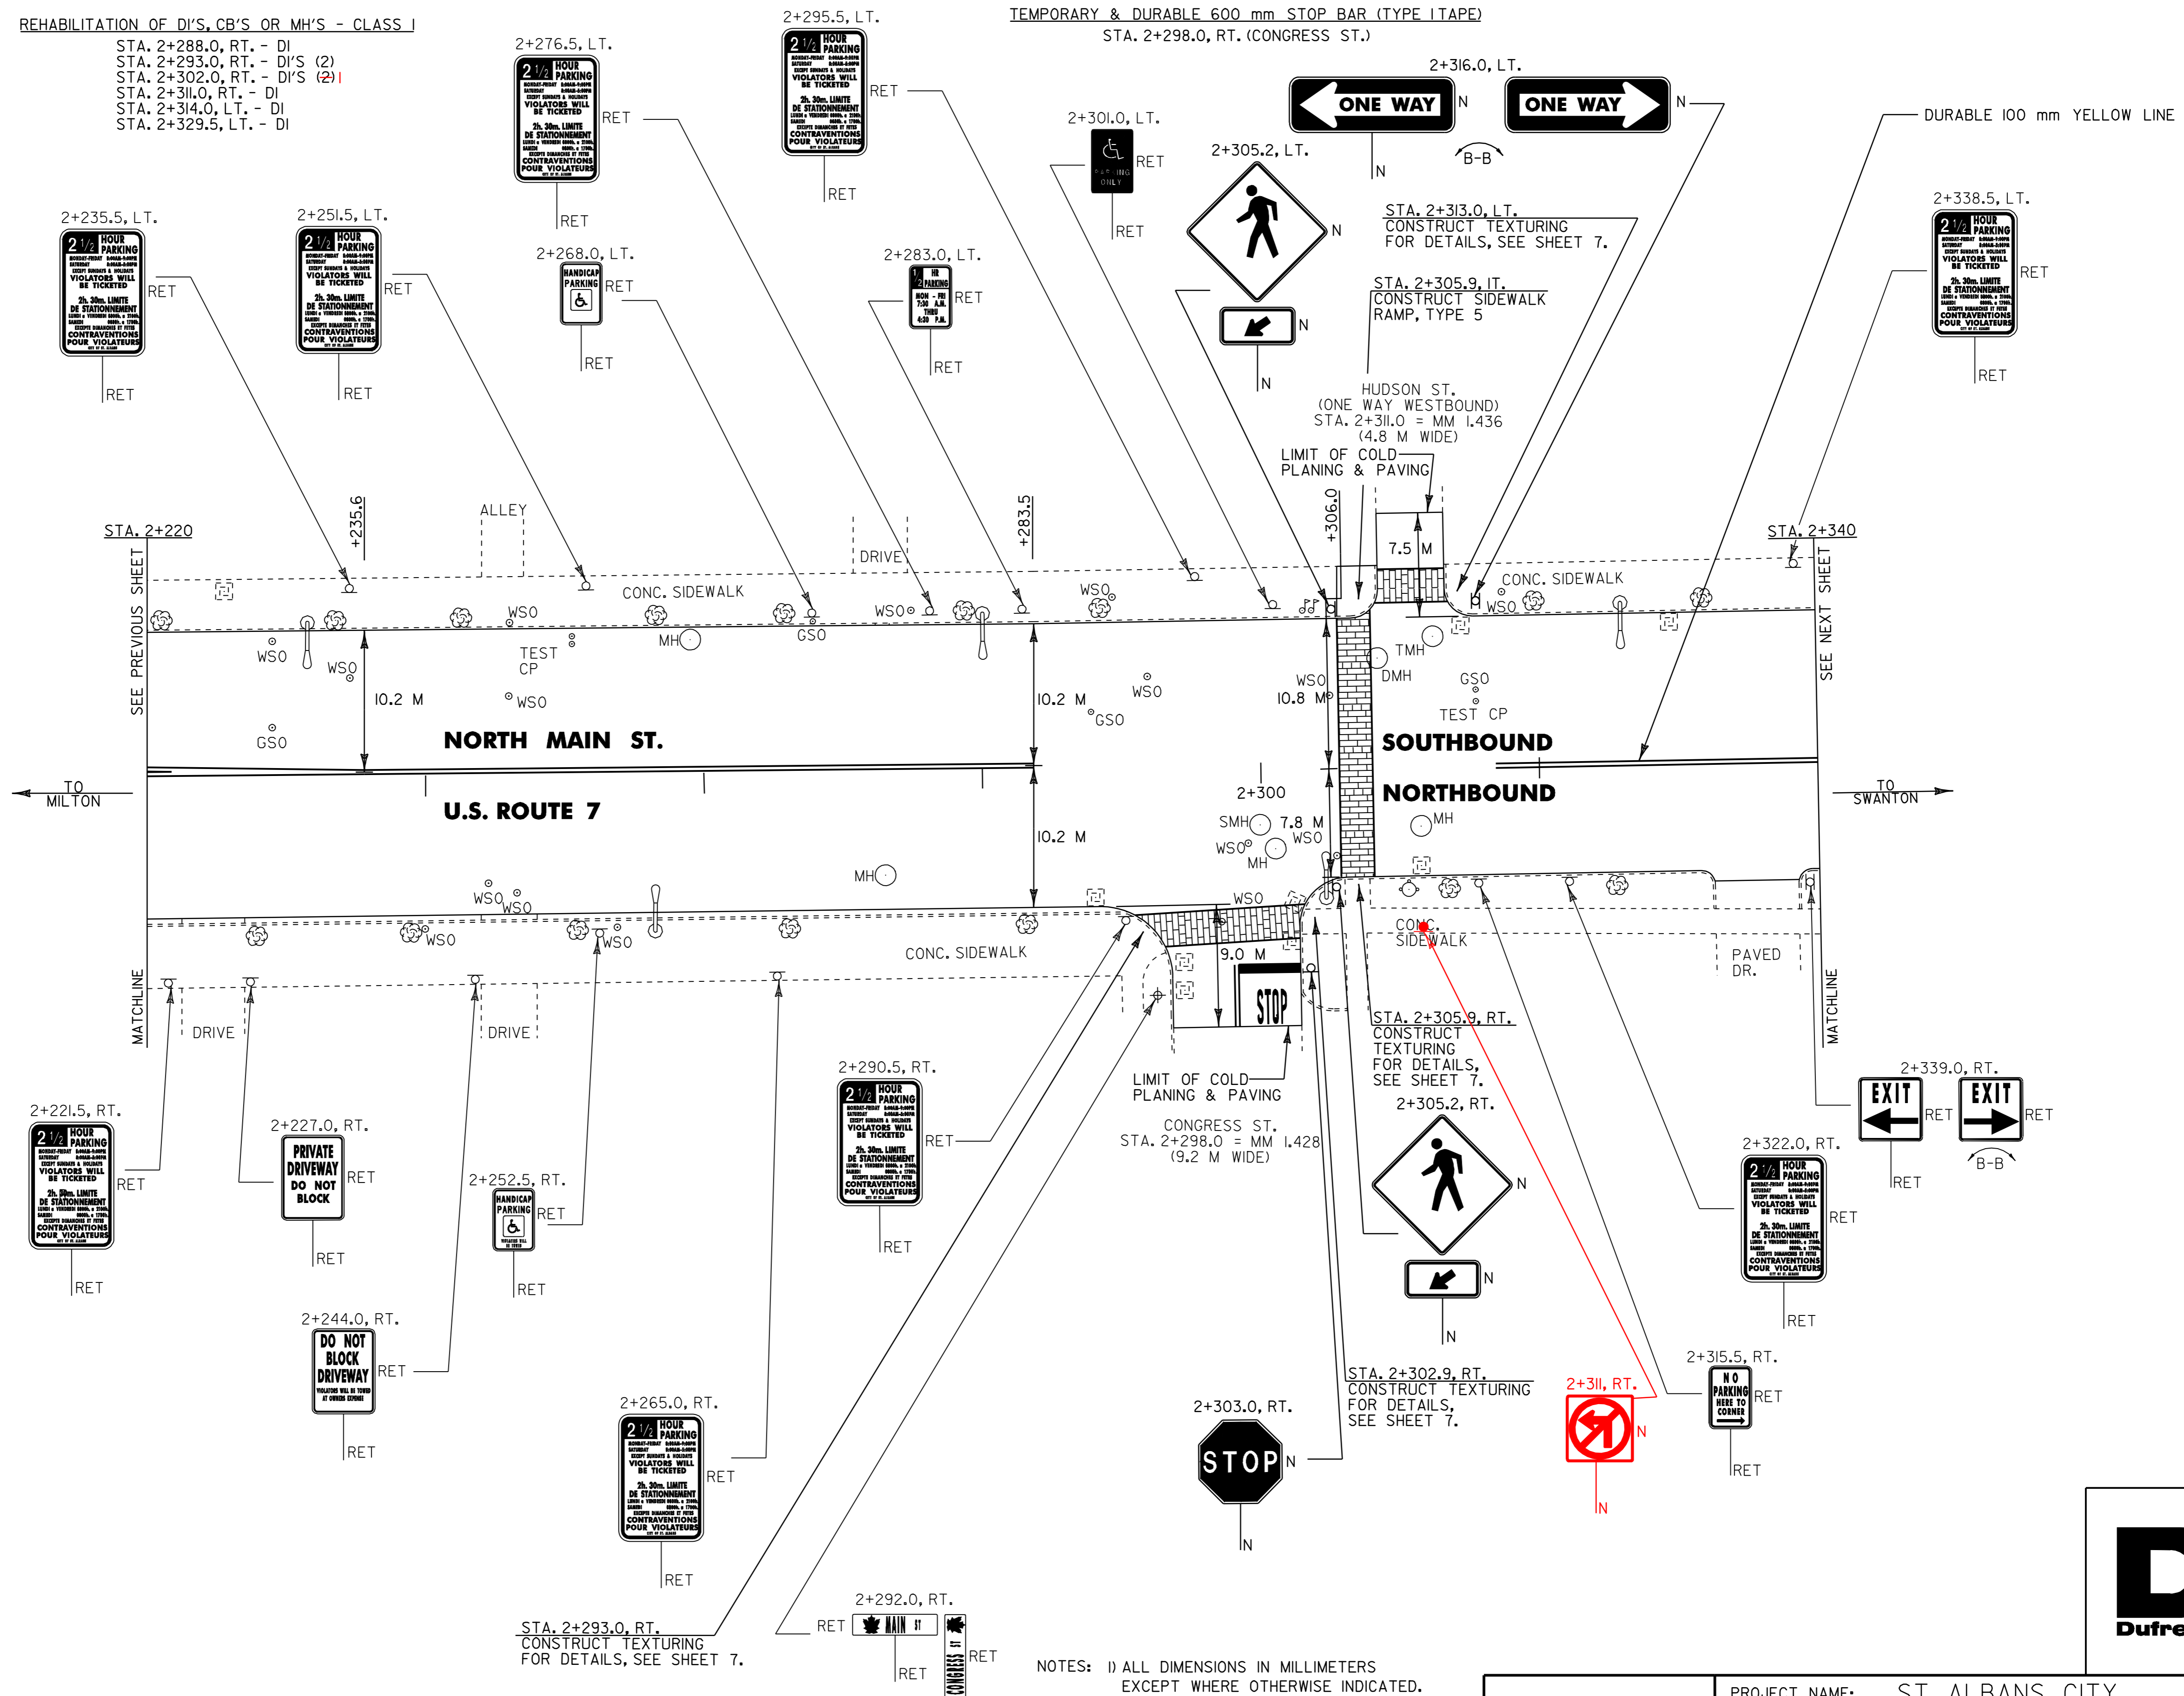

- NOTES:
- 1) ALL DIMENSIONS IN MILLIMETERS EXCEPT WHERE OTHERWISE INDICATED.
 - 2) ALL EXISTING SIGNS NOT SHOWN SHALL BE RETAINED AS DIRECTED BY THE RESIDENT ENGINEER.
 - 3) FOR ANY TOWN HIGHWAY OR STREET DETAILS, SEE VTrans STANDARD E-193M.

LAYOUT SHEET #16

PROJECT NAME:	ST. ALBANS CITY	FILE NAME:	zpxe297d150zpd150.dgn	PLOT DATE:	01-FEB-2006 07:4
PROJECT NUMBER:	STP_9804(1)S	PROJECT LEADER:	JLL	DRAWN BY:	D-H
		DESIGNED BY:	D-H	CHECKED BY:	
		IPARM FILE NAME:	pd150pd16.1	SHEET	37 OF 105



~~TEMPORARY & DURABLE 100 mm WHITE LINE~~
 STA. 2+375.0 TO 2+480.0, SOLID LT. & RT.
 STA. 2+382.9, SOLID LT. (LANE LINE)
 STA. 2+430.0 TO 2+460.0, DOTTED RT.
 STA. 2+460.0 TO 2+480.0, SOLID RT. (LANE LINE)

TEMPORARY & DURABLE 100 mm YELLOW LINE
 STA. 2+340.0 TO 2+480.0, SOLID LT. & RT. (WITH CENTERLINE BREAK FOR HOYT ST.)

~~TEMPORARY & DURABLE CROSSWALK WITH DIAGONAL LINES (MOD.)~~
 STA. 2+382.9, LT. (HOYT ST.)

DURABLE LETTER OR SYMBOL (TYPE I TAPE)
 STA. 2+382.3, LT. - "ONLY" (2) (HOYT ST.)
 STA. 2+382.3, LT. - " " (2) (HOYT ST.)
 STA. 2+461.2, RT. - "ONLY" 460.0
 STA. 2+464.8, RT. - " " 464.0
 STA. 2+465.0, RT. - " " 460.0, CL

TEMPORARY LETTER OR SYMBOL
 STA. 2+382.3, LT. - " " (2) (HOYT ST.)
 STA. 2+464.8, RT. - " " (2) (HOYT ST.)
 STA. 2+465.0, RT. - " " (2) (HOYT ST.)

REMOVING SIGNS
 AS SHOWN - 5

REHABILITATION OF DI'S, CB'S OR MH'S - CLASS I
 STA. 2+372.0, RT. - DI
 STA. 2+378.0, LT. - DI
 STA. 2+386.0, LT. - DI
 STA. 2+446.0, LT. - DI

CHANGING ELEVATION OF SMH'S
 STA. 2+384.0, LT.


CHANGING ELEVATION OF DI'S, CB'S OR MH'S
 STA. 2+392.0, RT. - STORM MH

TEMPORARY & DURABLE 600 mm STOP BAR (TYPE I TAPE)
 STA. 2+382.9, LT. (HOYT ST.)

ADJUST ELEVATION OF VALVE BOX
 STA. 2+380.0, RT. - WSO
 STA. 2+382.0, RT. - WSO
 STA. 2+382.0, LT. - TEST CP
 STA. 2+383.0, RT. - WSO
 STA. 2+445.0, RT. - WSO

ERECTING SALVAGED SIGNS
 AS SHOWN - 2

CONSTRUCT NEW SIDEWALK
 STA. 2+360.0, RT.

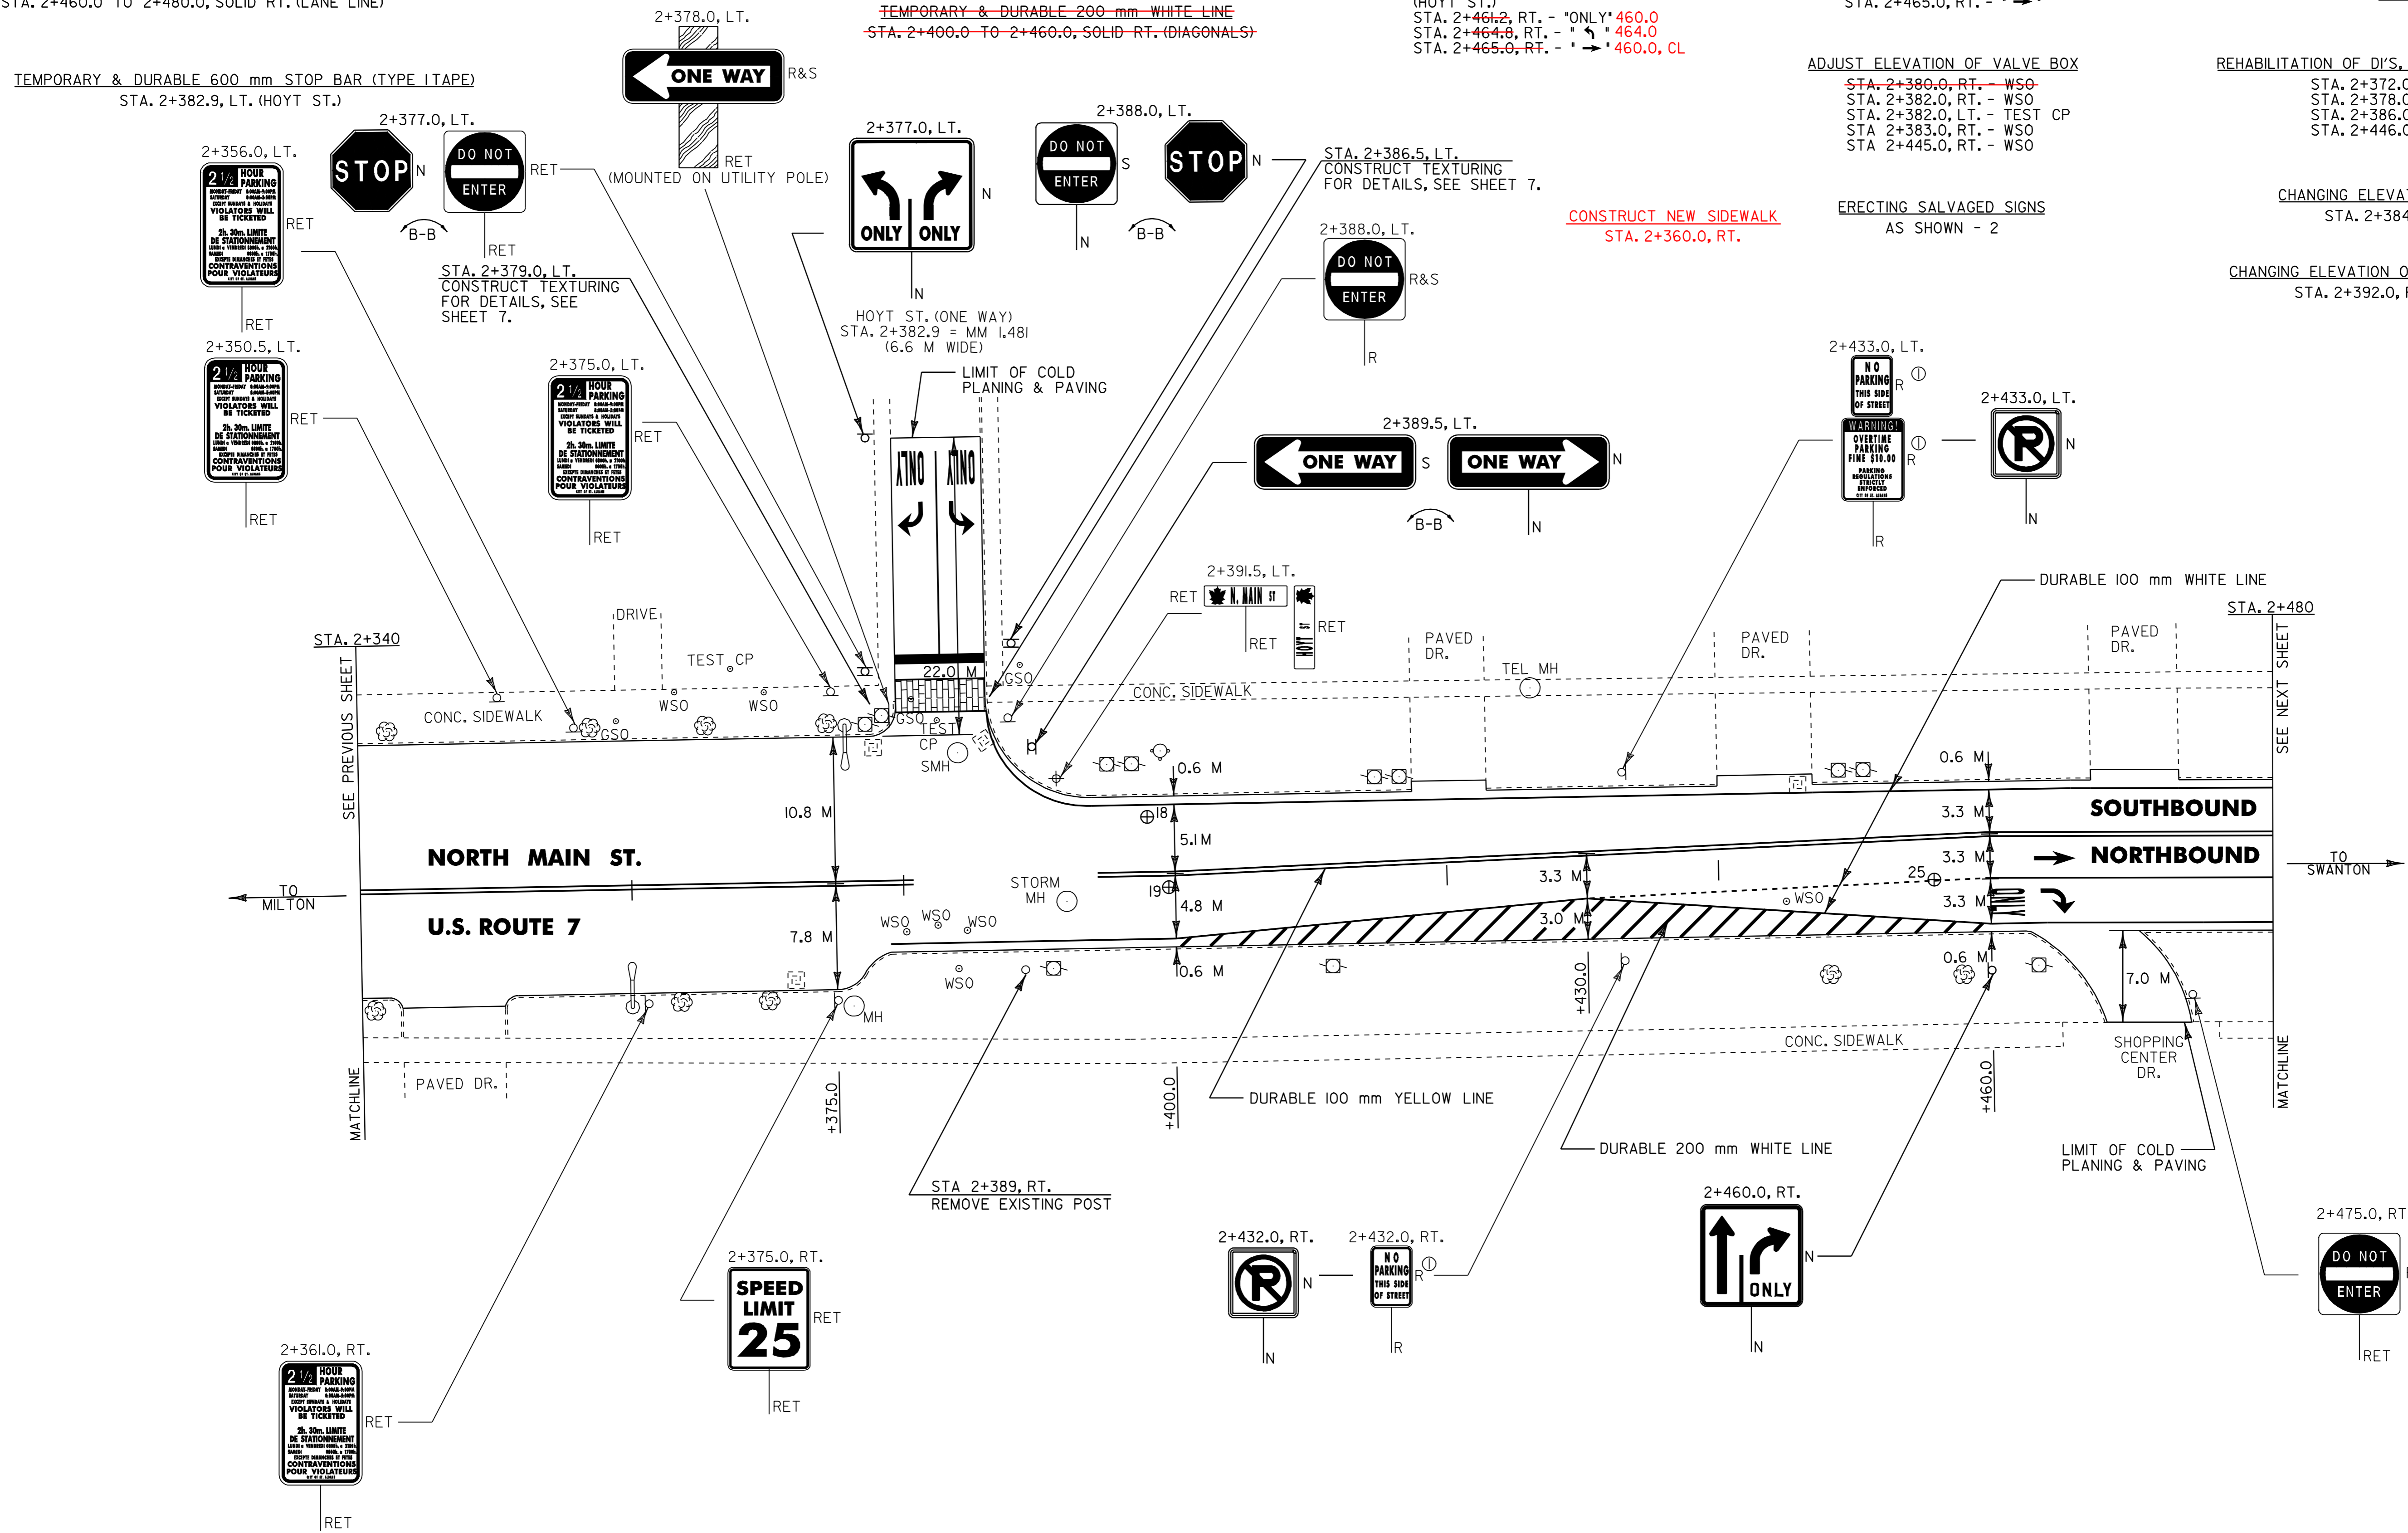

⊕ CORE LOCATION

PAVEMENT CORE DATA			
CORE #	LOCATION	DEPTH (mm)	PCC
18	2+397.9, LT.	102	YES
19	2+399.5, LT.	102	YES
25	2+455.9, RT.	89	YES

NOTES: 1) ALL DIMENSIONS IN MILLIMETERS EXCEPT WHERE OTHERWISE INDICATED.
 2) ALL EXISTING SIGNS NOT SHOWN SHALL BE RETAINED AS DIRECTED BY THE RESIDENT ENGINEER.
 3) FOR ANY TOWN HIGHWAY OR STREET DETAILS, SEE VTrans STANDARD E-193M.

LAYOUT SHEET #17

PROJECT NAME: ST. ALBANS CITY
 PROJECT NUMBER: STP_9804(I)S
 FILE NAME: Z:\pave\97\d150\d150.dgn
 PROJECT LEADER: JLL
 DESIGNED BY: D-H
 IPARM FILE NAME: pd150pl7.i
 PLOT DATE: 01-FEB-2006 07:44
 DRAWN BY: D-H
 CHECKED BY:
 SHEET 38 OF 105

~~TEMPORARY & DURABLE 100 mm WHITE LINE~~
 STA. 2+480.0 TO 2+600.0, SOLID LT. & RT. (WITH EDGELINE BREAKS FOR CROSSWALK & SHOPPING CENTER)
 STA. 2+480.0 TO 2+494.0, SOLID RT. (LANE LINE) (WITH BREAK FOR CROSSWALK)
 STA. 2+487.0 TO 2+494.0, SOLID RT. (LANE LINE)
 STA. 2+499.0, SOLID RT. (SHOPPING CENTER EDGELINES & LANE LINE)
 STA. 2+503.3 TO 2+538.0, SOLID LT. (LANE LINE)
 STA. 2+538.0 TO 2+568.0, DOTTED LT.

TEMPORARY & DURABLE 100 mm YELLOW LINE
 STA. 2+480.0 TO 2+538.0, SOLID LT. & RT. (WITH CENTERLINE BREAK FOR CROSSWALK & SHOPPING CENTER)
 STA. 2+499.0, RT. (AROUND ISLAND & INCLUDING DOUBLE SOLID FOR GORE)
 STA. 2+538.0 TO 2+600.0, DOUBLE SOLID LT. & RT.

TEMPORARY & DURABLE 200 mm YELLOW LINE
 STA. 2+499.0, SOLID RT. (DIAGONAL)
 STA. 2+538.0 TO 2+600.0, SOLID LT. & RT. (DIAGONALS)

TEMPORARY & DURABLE CROSSWALK WITH DIAGONAL LINES (MOD.)
 STA. 2+485.8

TEMPORARY & DURABLE 600 mm STOP BAR (TYPE I TAPE)
 STA. 2+483.1, RT.
 STA. 2+499.0, RT. (SHOPPING CENTER)
 STA. 2+516.0, LT.

DURABLE LETTER OR SYMBOL (TYPE I TAPE)
 STA. 2+499.0, RT. - "ONLY" (2) (SHOPPING CENTER)
 STA. 2+499.0, RT. - " " "&" " " (SHOPPING CENTER)
 STA. 2+533.2, LT. - " " " " 545.0, RT. (SHOPPING CENTER)
 STA. 2+536.5, LT. - " " " " 549.0, CL (SHOPPING CENTER)
 STA. 2+536.8, RT. - "ONLY" 549.0, RT. (SHOPPING CENTER)

TEMPORARY LETTER OR SYMBOL
 STA. 2+499.0, RT. - " " "&" " " (SHOPPING CENTER)
 STA. 2+533.2, LT. - " " " " 545.0, RT. (SHOPPING CENTER)
 STA. 2+536.5, LT. - " " " " 549.0, CL (SHOPPING CENTER)

REMOVING SIGNS
 AS SHOWN - 7


ERECTING SALVAGED SIGNS
 AS SHOWN - 1

CHANGING ELEVATION OF SMH'S
 STA. 2+482.0, RT.

ADJUST ELEVATION OF VALVE BOX
 STA. 2+534.0, RT. - WSO

REHABILITATION OF DI'S, CB'S OR MH'S - CLASS I
 STA. 2+482.0, LT. - DI
 STA. 2+483.0, RT. - DI
 STA. 2+487.0, LT. - DI
 STA. 2+577.0, LT. - DI
 STA. 2+591.0, RT. - DI

PAINTED ISLAND
 STA. 2+499.0, RT. (SHOPPING CENTER ISLAND)

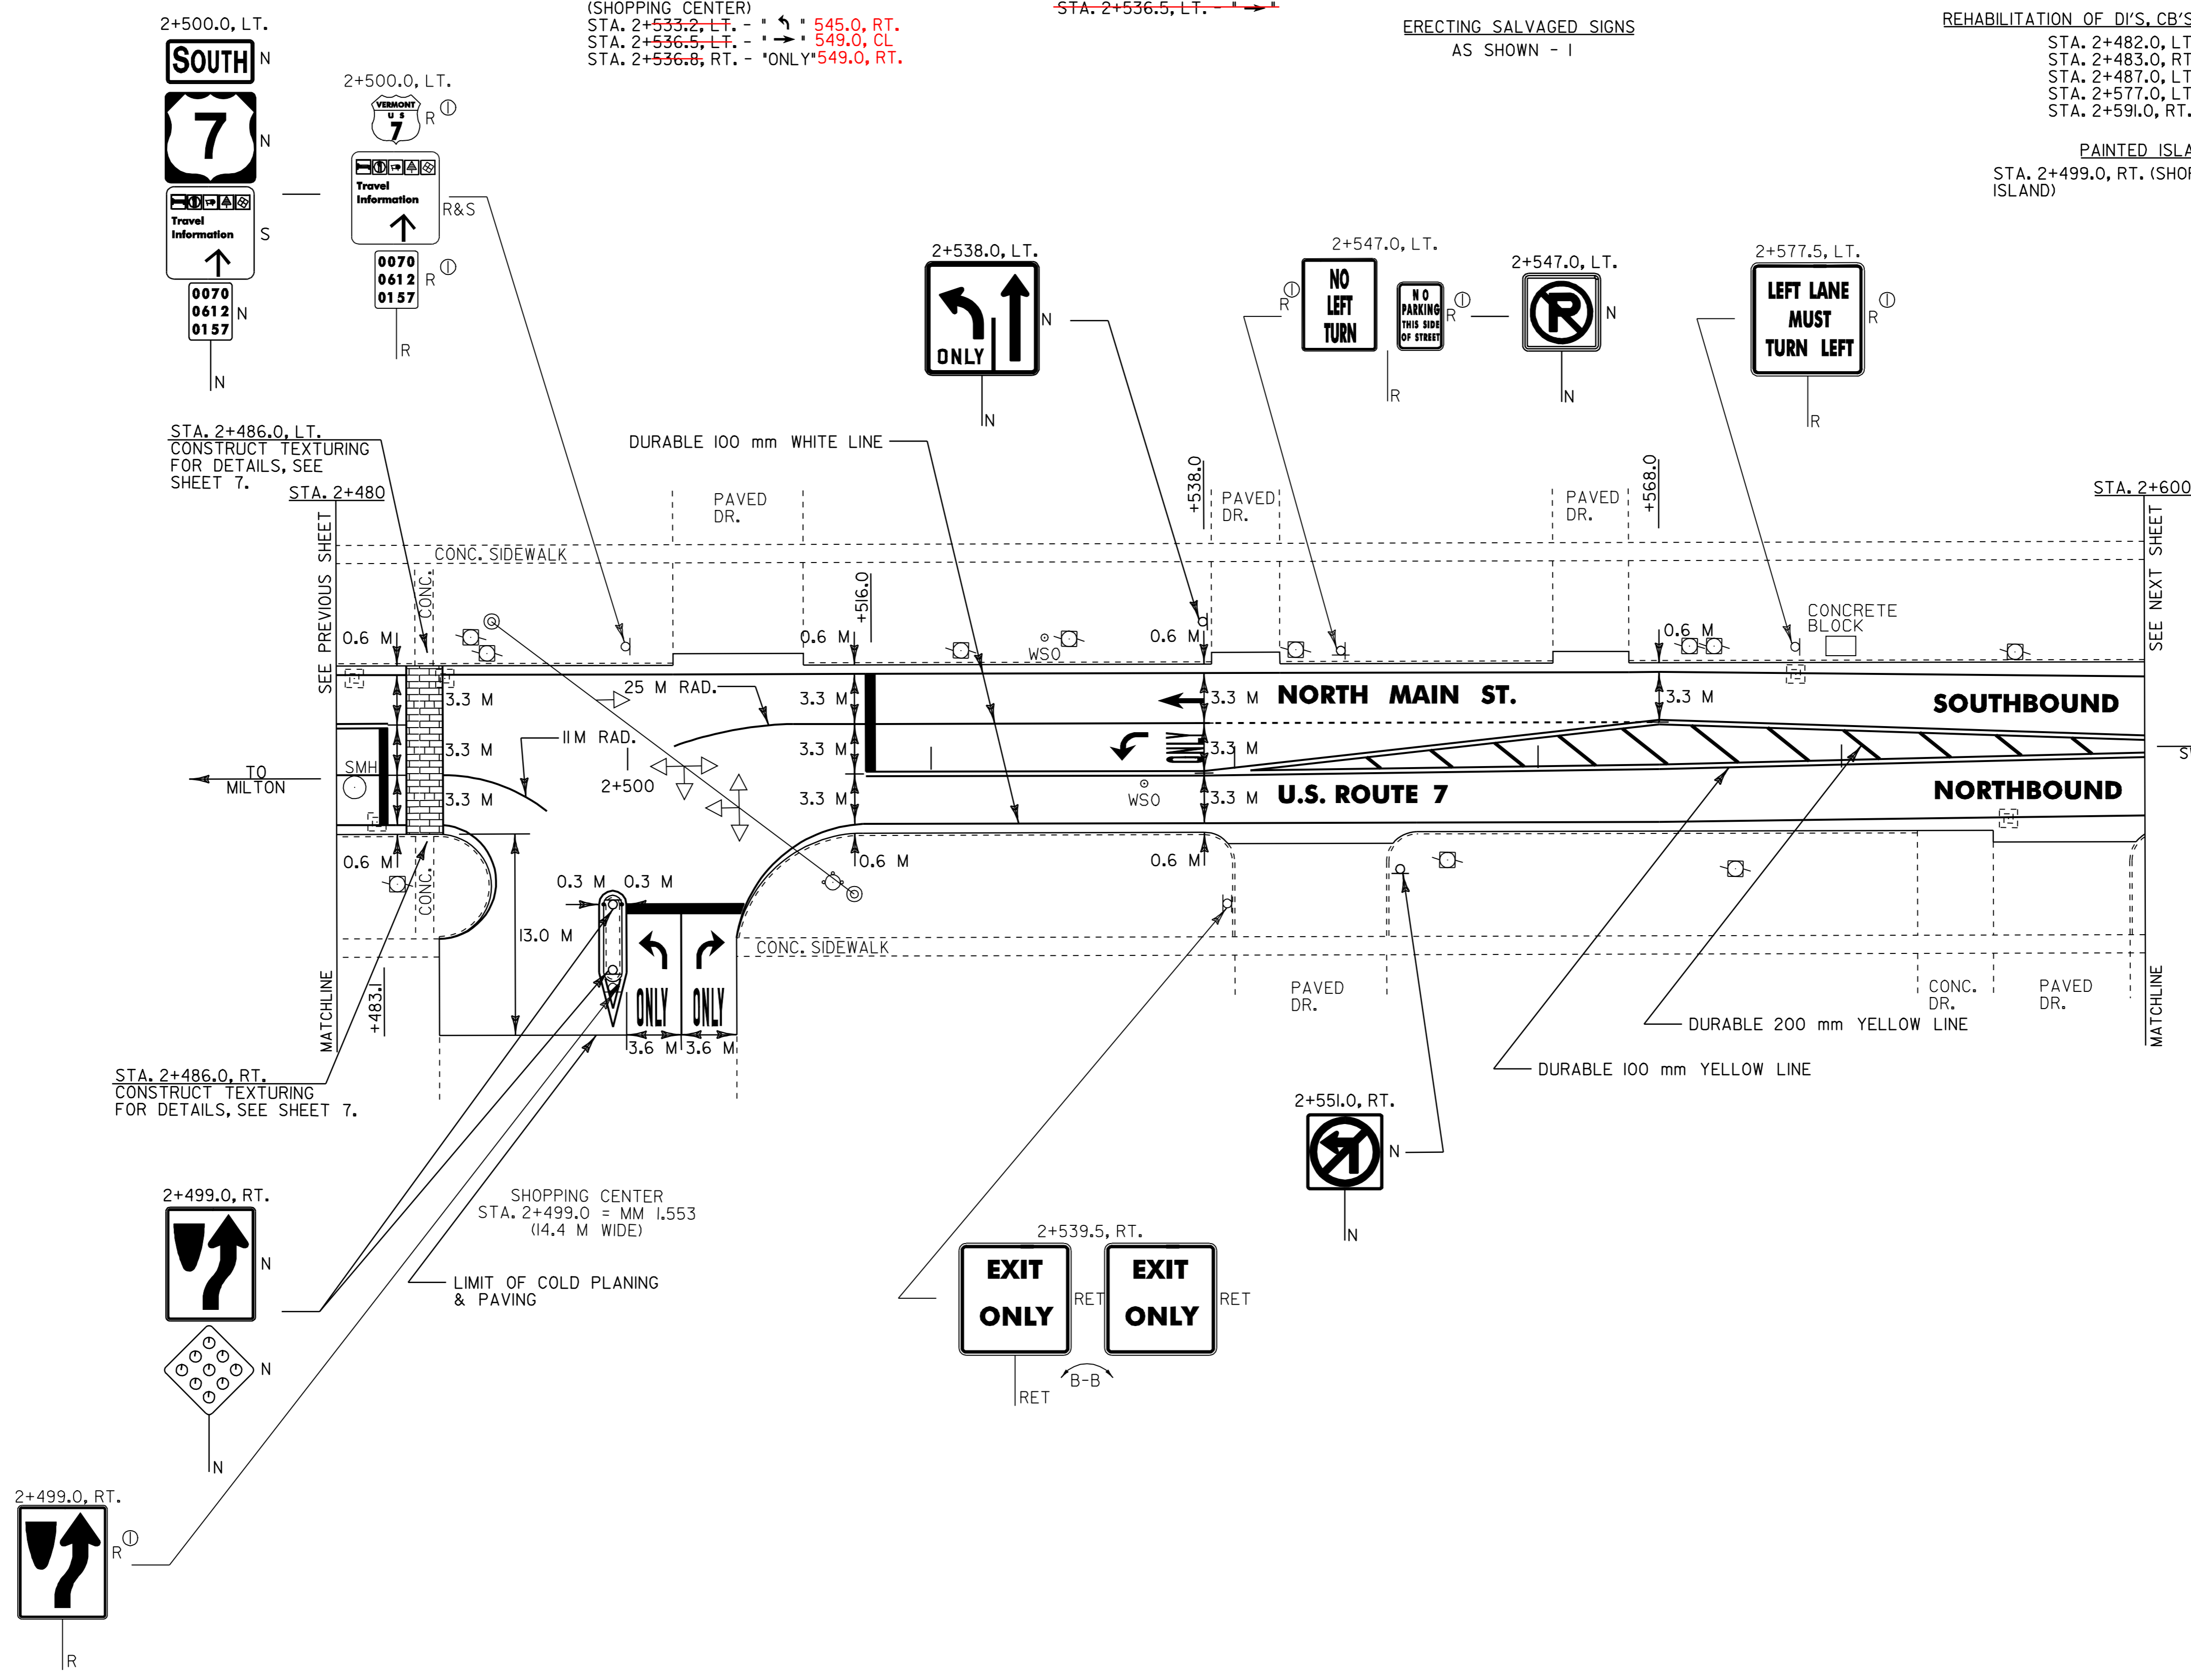

NOTES: 1) ALL DIMENSIONS IN MILLIMETERS EXCEPT WHERE OTHERWISE INDICATED.
 2) ALL EXISTING SIGNS NOT SHOWN SHALL BE RETAINED AS DIRECTED BY THE RESIDENT ENGINEER.
 3) FOR ANY TOWN HIGHWAY OR STREET DETAILS, SEE VTrans STANDARD E-193M.

LAYOUT SHEET #18	PROJECT NAME: ST. ALBANS CITY	PLOT DATE: 01-FEB-2006 07:4
	PROJECT NUMBER: STP_9804(I)S	DRAWN BY: D-H
	FILE NAME: Zpqve297d150Zpd150.dgn	CHECKED BY:
	DESIGNED BY: D-H	SHEET 39 OF 105

~~TEMPORARY & DURABLE 100 mm WHITE LINE~~
 STA. 2+600.0 TO 2+740.0, SOLID LT. & RT.
 (WITH EDGE LINE BREAK FOR BRAINERD ST.)

TEMPORARY & DURABLE 100 mm YELLOW LINE
 STA. 2+600.0 TO 2+620.0, DOUBLE SOLID LT. & RT.
 STA. 2+620.0 TO 2+740.0, SOLID LT. & RT. (WITH
 CENTERLINE BREAK FOR BRAINERD ST.)
 STA. 2+629.8, DOUBLE SOLID RT. (BRAINERD ST.)

~~TEMPORARY & DURABLE CROSSWALK WITH DIAGONAL LINES (MOD.)~~
 STA. 2+629.8, RT. (BRAINERD ST.)

REMOVING SIGNS
 AS SHOWN - 4

ADJUST ELEVATION OF VALVE BOX
 STA. 2+624.5, LT. - WSO
~~STA. 2+631.0, RT. - WSO~~

REHABILITATION OF DI'S, CB'S OR MH'S - CLASS I
~~STA. 2+627.0, RT. - DI~~
~~STA. 2+633.0, LT. - DI~~
~~STA. 2+639.5, LT. & RT. - DI'S~~
~~STA. 2+704.5, RT. - DI~~
~~STA. 2+720.0, LT. - DI~~

CHANGING ELEVATION OF SMH'S
 STA. 2+630.0, LT.
 STA. 2+709.0, LT.


CHANGING ELEVATION OF DI'S, CB'S OR MH'S
 STA. 2+629.0, RT. - MH

ERECTING SALVAGED SIGNS
 AS SHOWN - 1

~~TEMPORARY & DURABLE LETTER OR SYMBOL (TYPE ITAPE)~~
 STA. 2+629.8, RT. - 'STOP'

~~TEMPORARY & DURABLE 600 mm STOP BAR (TYPE ITAPE)~~
 STA. 2+629.8, RT. (BRAINERD ST.)

TEMPORARY & DURABLE 200 mm YELLOW LINE
 STA. 2+600.0 TO 2+620.0, SOLID LT. (DIAGONALS)

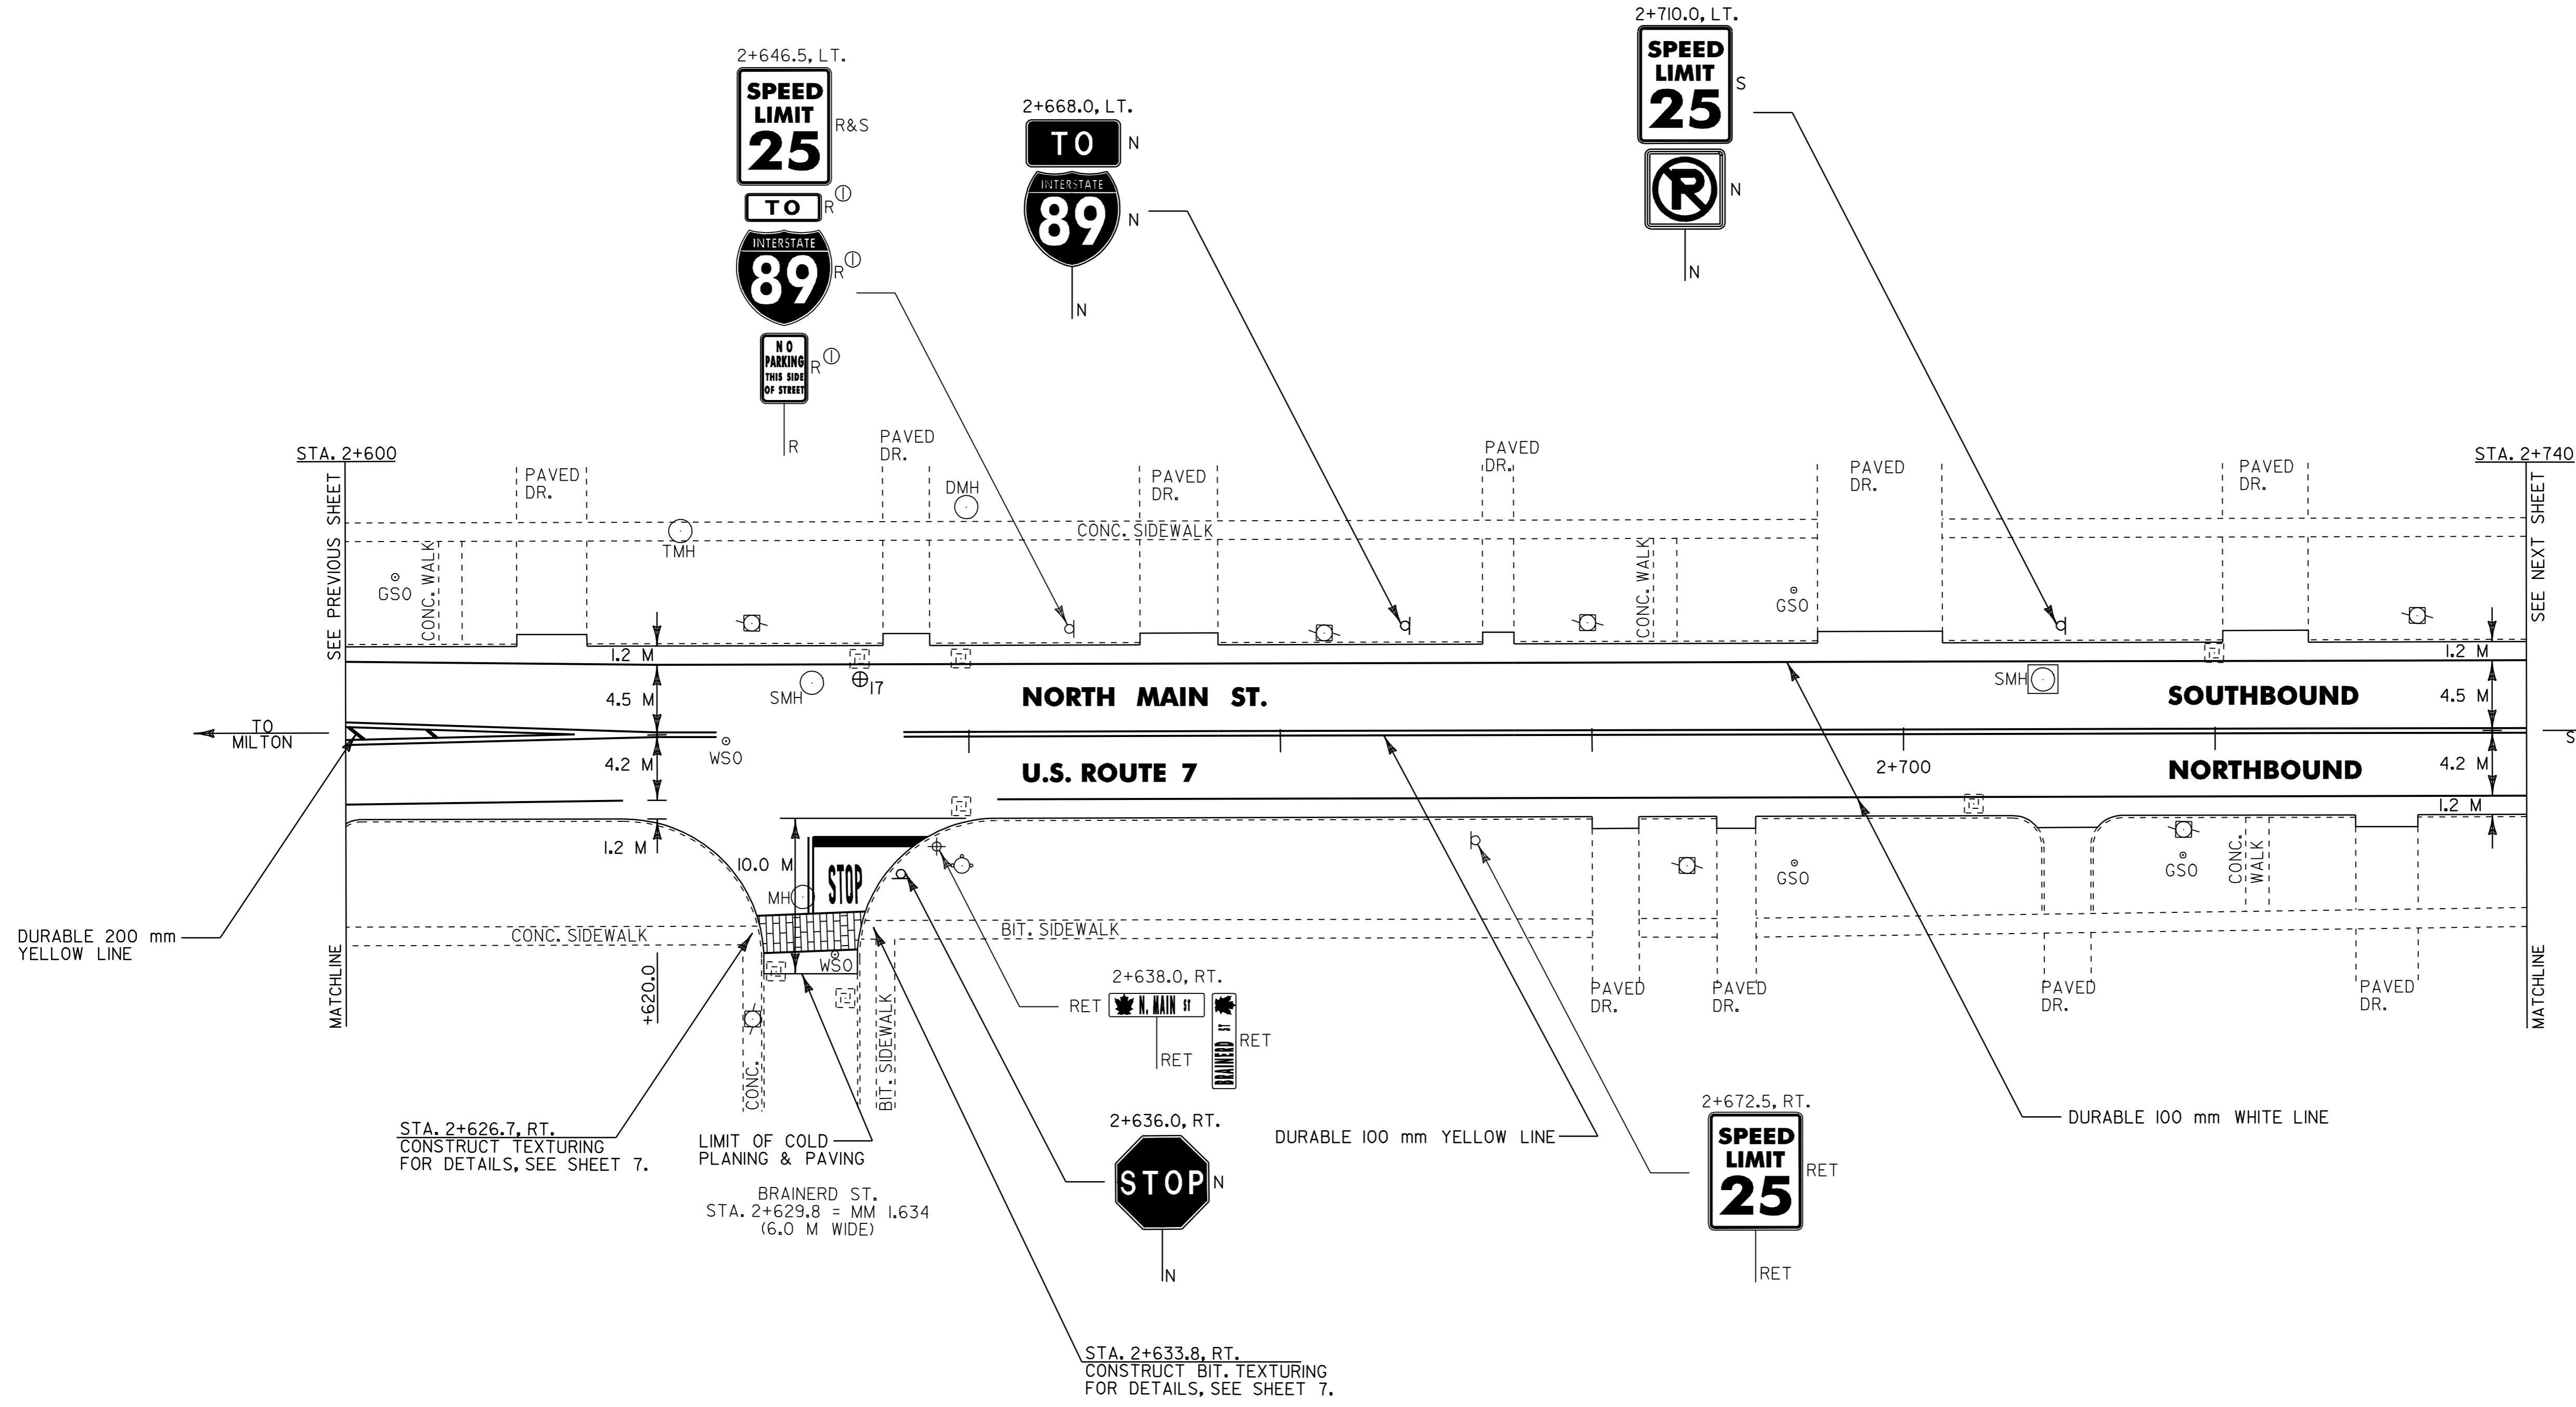

⊕ CORE LOCATION

PAVEMENT CORE DATA			
CORE #	LOCATION	DEPTH (mm)	PCC
17	2+632.9, LT.	165	YES

- NOTES:
- 1) ALL DIMENSIONS IN MILLIMETERS EXCEPT WHERE OTHERWISE INDICATED.
 - 2) ALL EXISTING SIGNS NOT SHOWN SHALL BE RETAINED AS DIRECTED BY THE RESIDENT ENGINEER.
 - 3) FOR ANY TOWN HIGHWAY OR STREET DETAILS, SEE VTrans STANDARD E-193M.

LAYOUT SHEET #19

PROJECT NAME: ST. ALBANS CITY
 PROJECT NUMBER: SIP 9804(I)S
 FILE NAME: 2pave297d150/pd150.dgn PLOT DATE: 01-FEB-2006 07:5
 PROJECT LEADER: JLL DRAWN BY: D-H
 DESIGNED BY: D-H CHECKED BY: _____
 IPARM FILE NAME: pd150p19.i SHEET 40 OF 105

~~TEMPORARY & DURABLE 100 mm WHITE LINE~~
 STA. 2+740.0 TO 2+820.0, SOLID LT. & RT.
 (WITH EDGELINE BREAK FOR BEST CT.)

TEMPORARY & DURABLE 100 mm YELLOW LINE
 STA. 2+740.0 TO 2+770.0, SOLID LT. & RT.
 STA. 2+770.0 TO 2+820, DOUBLE SOLID LT. & RT.
 (WITH CENTERLINE BREAK FOR BEST CT.)
 STA. 2+802.3, DOUBLE SOLID LT. (BEST CT.)

~~TEMPORARY & DURABLE 200 mm YELLOW LINE~~
 STA. 2+770.0 TO 2+820.0, SOLID LT. & RT. DIAGONALS

REMOVING SIGNS
 AS SHOWN - 6

ADJUST ELEVATION OF VALVE BOX
 STA. 2+803.0, LT. - WSO


REHABILITATION OF DI'S, CB'S OR MH'S - CLASS I
 STA. 2+776.0, RT. - ROUND DI
 STA. 2+806.0, RT. - DI
 STA. 2+812.5, LT. - DI



CHANGING ELEVATION OF DI'S, CB'S OR MH'S
 STA. 2+806.0, LT. - MH

~~TEMPORARY & DURABLE 600 mm STOP BAR (TYPE I TAPE)~~
 STA. 2+802.3, LT.

TEMPORARY AND DURABLE LETTER OR SYMBOL (TYPE I TAPE)
 STA. 2+802.3, LT. - "STOP"

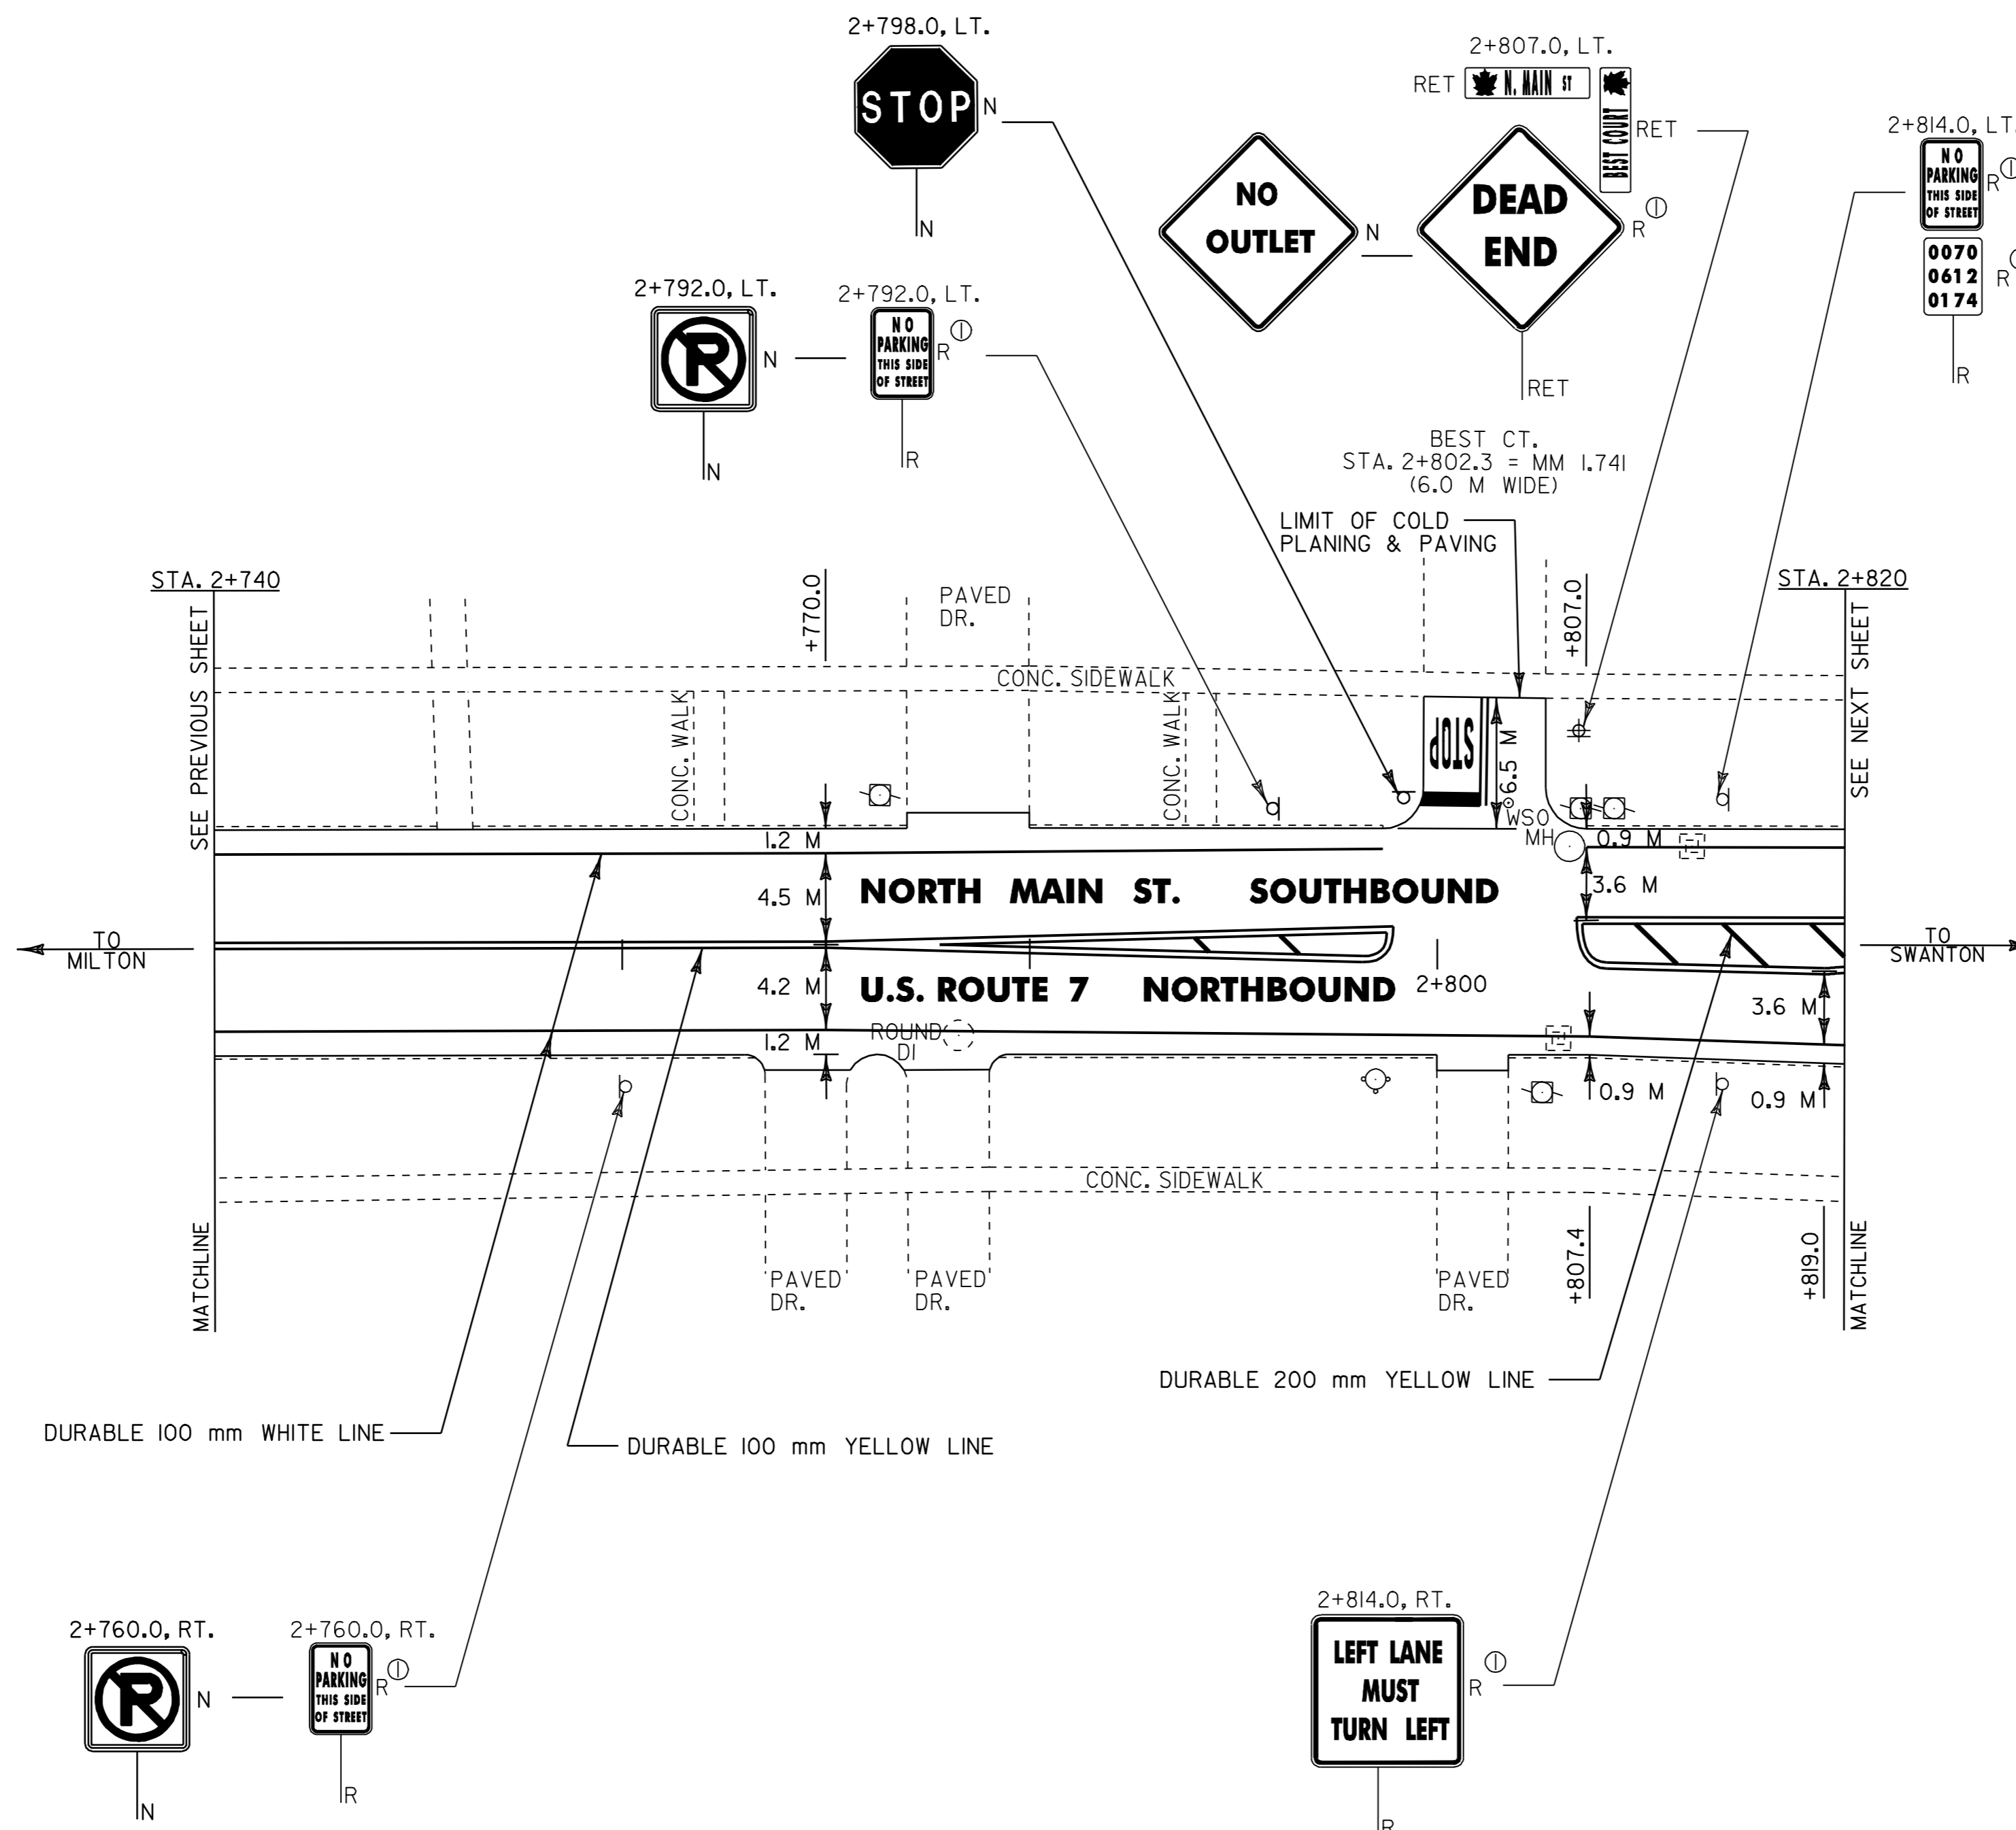

- NOTES: 1) ALL DIMENSIONS IN MILLIMETERS EXCEPT WHERE OTHERWISE INDICATED.
 2) ALL EXISTING SIGNS NOT SHOWN SHALL BE RETAINED AS DIRECTED BY THE RESIDENT ENGINEER.
 3) FOR ANY TOWN HIGHWAY OR STREET DETAILS, SEE VTrans STANDARD E-193M.

LAYOUT SHEET #20	PROJECT NAME: <u>ST. ALBANS CITY</u>	PLOT DATE: 01-FEB-2006 07:5
	PROJECT NUMBER: <u>STP_9804(I)S</u>	DRAWN BY: <u>D-H</u>
	FILE NAME: <u>2pave297d1502pd150.dgn</u>	CHECKED BY:
	DESIGNED BY: <u>D-H</u>	SHEET <u>41</u> OF <u>105</u>



TEMPORARY & DURABLE 100 mm WHITE LINE
 STA. 2+820.0 TO 2+940.0, SOLID LT. & RT. (WITH EDGELINE BREAKS FOR UPPER NEWTON ST. & LOWER NEWTON ST.)
 STA. 2+820.0 TO 2+849.0, DOTTED RT.
 STA. 2+849.0 TO 2+880.5, SOLID RT. (LANE LINE)
 STA. 2+890.0, SOLID RT. (UPPER NEWTON ST. EDGELINES)
 STA. 2+898.0, SOLID LT. (LOWER NEWTON ST. EDGELINES & LANE LINE)
 STA. 2+918.0 TO 2+940.0, SOLID LT. (LANE LINE)

TEMPORARY & DURABLE 100 mm YELLOW LINE
 STA. 2+820.0 TO 2+849.0, DOUBLE SOLID LT. & RT.
 STA. 2+849.0 TO 2+940.0, SOLID LT. & RT. (WITH CENTERLINE BREAK FOR UPPER NEWTON ST. & LOWER NEWTON ST.)
 STA. 2+898.0, DOUBLE SOLID LT. (LOWER NEWTON ST.)

TEMPORARY & DURABLE 200 mm YELLOW LINE
 STA. 2+820.0 TO 2+849.0, SOLID LT. & RT. (DIAGONALS)


TEMPORARY & DURABLE CROSSWALK WITH DIAGONAL LINES (MOD.)
 STA. 2+890.0, RT. (UPPER NEWTON ST.)
 STA. 2+895.0
 STA. 2+898.0, LT. (LOWER NEWTON ST.)

TEMPORARY & DURABLE 600 mm STOP BAR (TYPE ITAPE)
 STA. 2+880.5, RT.
 STA. 2+898.0, LT. (LOWER NEWTON ST.)
 STA. 2+918.0, LT.
 STA. 2+922.0, LT.

DURABLE LETTER OR SYMBOL (TYPE ITAPE)
 STA. 2+850.2, RT. - "ONLY" 861.0
 STA. 2+851.0, RT. - "861.0
 STA. 2+853.8, RT. - "866.0, CL
 STA. 2+874.2, RT. - "ONLY" 867.0, CL
 STA. 2+877.0, RT. - "891.0, RT.
 STA. 2+877.8, RT. - "891.0, RT.
 STA. 2+898.0, LT. - "ONLY" (LOWER NEWTON ST.)
 STA. 2+898.0, LT. - " (LOWER NEWTON ST.)
 STA. 2+898.0, LT. - " (LOWER NEWTON ST.)
 STA. 2+920.7, LT. - "940.0, LT.
 STA. 2+924.3, LT. - "ONLY" 943.0, LT.

TEMPORARY LETTER OR SYMBOL
 STA. 2+851.0, RT. - " (LOWER NEWTON ST.)
 STA. 2+853.8, RT. - " (LOWER NEWTON ST.)
 STA. 2+877.0, RT. - " (LOWER NEWTON ST.)
 STA. 2+877.8, RT. - " (LOWER NEWTON ST.)
 STA. 2+898.0, LT. - " (LOWER NEWTON ST.)
 STA. 2+898.0, LT. - " (LOWER NEWTON ST.)
 STA. 2+920.7, LT. - " (LOWER NEWTON ST.)
 STA. 2+924.3, LT. - " (LOWER NEWTON ST.)

REMOVING SIGNS AS SHOWN - 3

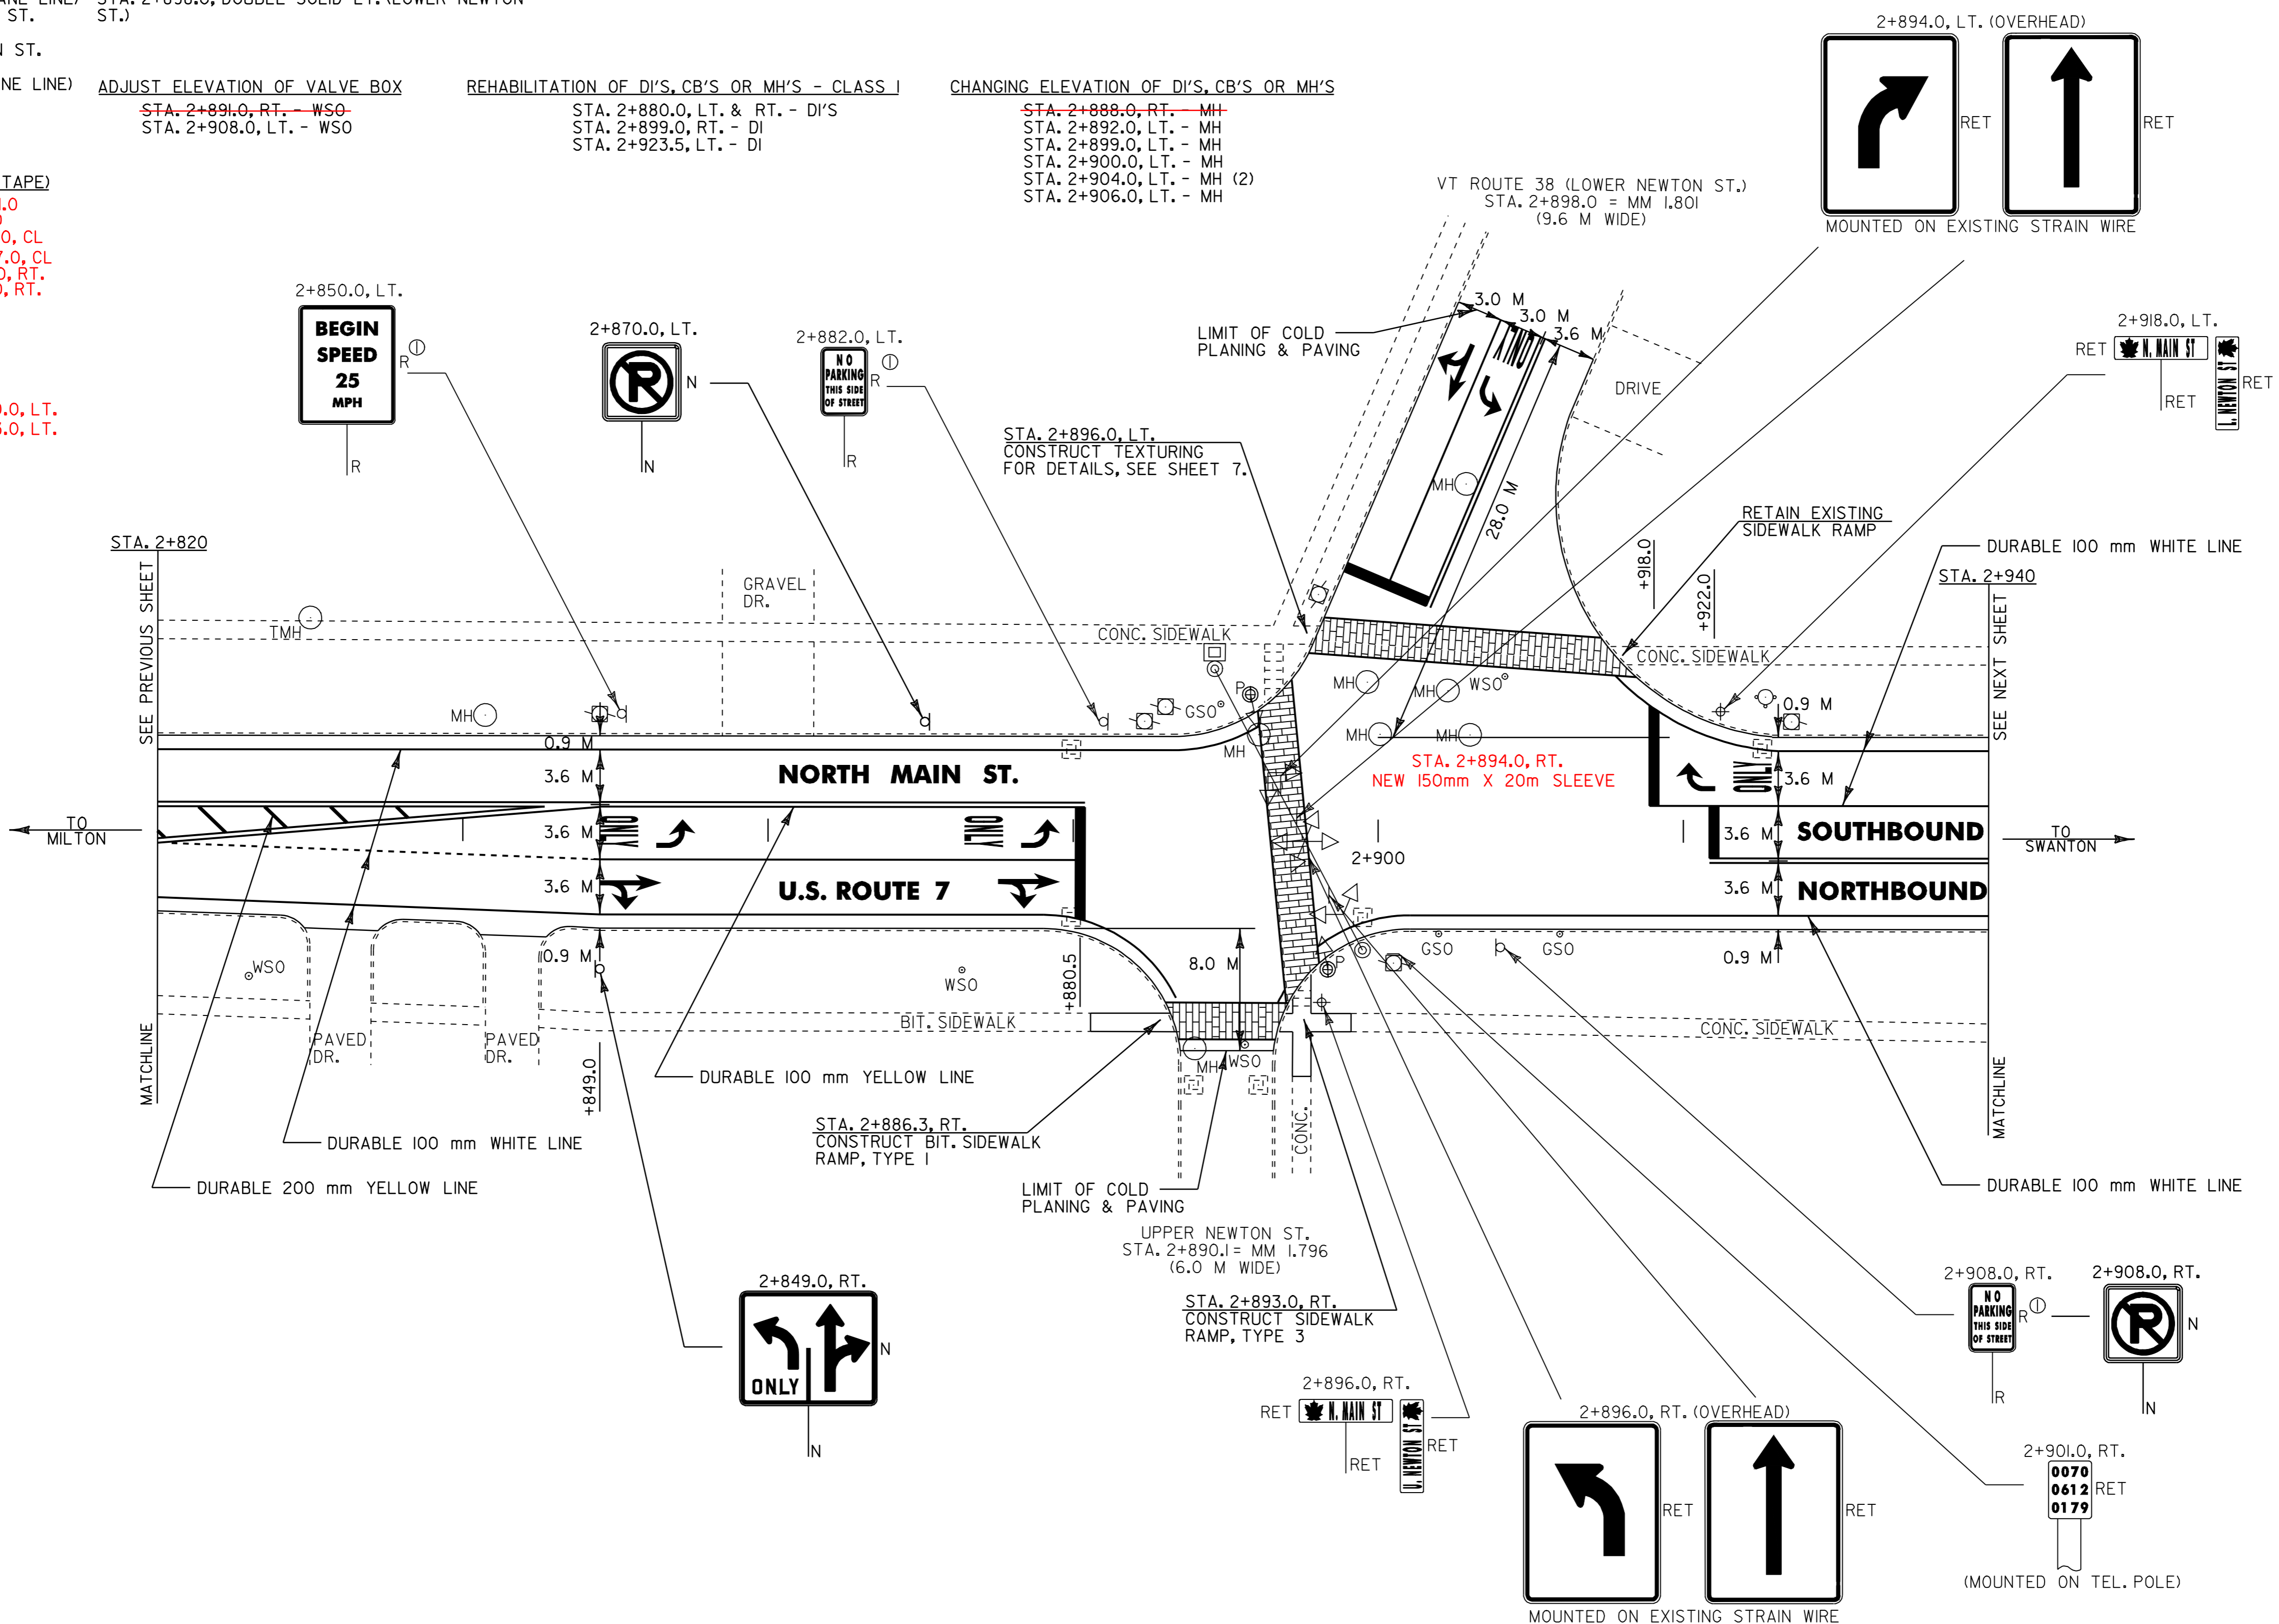

NOTES: 1) ALL DIMENSIONS IN MILLIMETERS EXCEPT WHERE OTHERWISE INDICATED.
 2) ALL EXISTING SIGNS NOT SHOWN SHALL BE RETAINED AS DIRECTED BY THE RESIDENT ENGINEER.
 3) FOR ANY TOWN HIGHWAY OR STREET DETAILS, SEE VTrans STANDARD E-193M.

LAYOUT SHEET #21

PROJECT NAME: ST. ALBANS CITY
 PROJECT NUMBER: STP_9804(I)S
 FILE NAME: Zpqve297d15QZpd15Q.dgn
 PROJECT LEADER: JLL
 DESIGNED BY: D-H
 IPARM FILE NAME: pd15Qp21.i
 PLOT DATE: 01-FEB-2006 07:4
 DRAWN BY: D-H
 CHECKED BY:
 SHEET 42 OF 105

~~TEMPORARY & DURABLE 100 mm WHITE LINE~~
 STA. 2+940.0 TO 3+038.0, SOLID RT.
 (WITH EDGELINE BREAK FOR FARRAR ST.)
 STA. 2+940.0 TO 3+020.0, SOLID LT.
 STA. 2+940.0 TO 2+952.0, SOLID LT. (LANE LINE)
 STA. 2+952.0 TO 3+020.0, DOTTED LT.

TEMPORARY & DURABLE 100 mm YELLOW LINE
 STA. 2+940.0 TO 3+060.0, SOLID LT. & RT.
 (WITH CENTERLINE BREAK FOR FARRAR ST.)
 STA. 3+029.7, DOUBLE SOLID RT. (FARRAR ST.)

~~TEMPORARY & DURABLE CROSSWALK WITH DIAGONAL LINES (MOD.)~~
 STA. 3+040.8, RT. (FARRAR ST.)

~~TEMPORARY & DURABLE 600 mm STOP BAR (TYPE I TAPE)~~
 STA. 3+029.7, RT. (FARRAR ST.)

DURABLE LETTER OR SYMBOL (TYPE I TAPE)
 STA. 2+947.2, LT. - "P" *964.0
 STA. 2+950.5, LT. - "P" *967.0
 STA. 2+950.8, LT. - "ONLY" *967.0
 STA. 3+029.7, RT. - "STOP"

REMOVING SIGNS
 AS SHOWN - 8

REHABILITATION OF DI'S, CB'S OR MH'S - CLASS I
 STA. 2+944.0, RT. - DI
 STA. 2+972.5, RT. - DI
 STA. 2+992.0, LT. - DI
 STA. 3+020.0, RT. - DI
~~STA. 3+033.5, RT. - ROUND DI~~
 STA. 3+034.0, RT. - DI


~~TEMPORARY LETTER OR SYMBOL~~
 STA. 2+947.2, LT. - "P"
 STA. 2+950.5, LT. - "P"
 STA. 3+029.7, RT. - "STOP"

LETTER OR SYMBOL (MOD.)
 STA. 3+040.8, RT. - "P" *055.0
 STA. 3+044.4, RT. - "P" *059.0

TEMPORARY LETTER OR SYMBOL (MOD.)
 STA. 3+040.8, RT. - "P" *055.0
 STA. 3+044.4, RT. - "P" *059.0

~~TEMPORARY & DURABLE 150 mm WHITE LINE~~
 STA. 3+020.0 TO 3+060.0, SOLID LT.
 STA. 3+038.0 TO 3+060.0, SOLID RT.

ADJUST ELEVATION OF VALVE BOX
 STA. 3+040.0, C - VALVE (PAVED OVER)

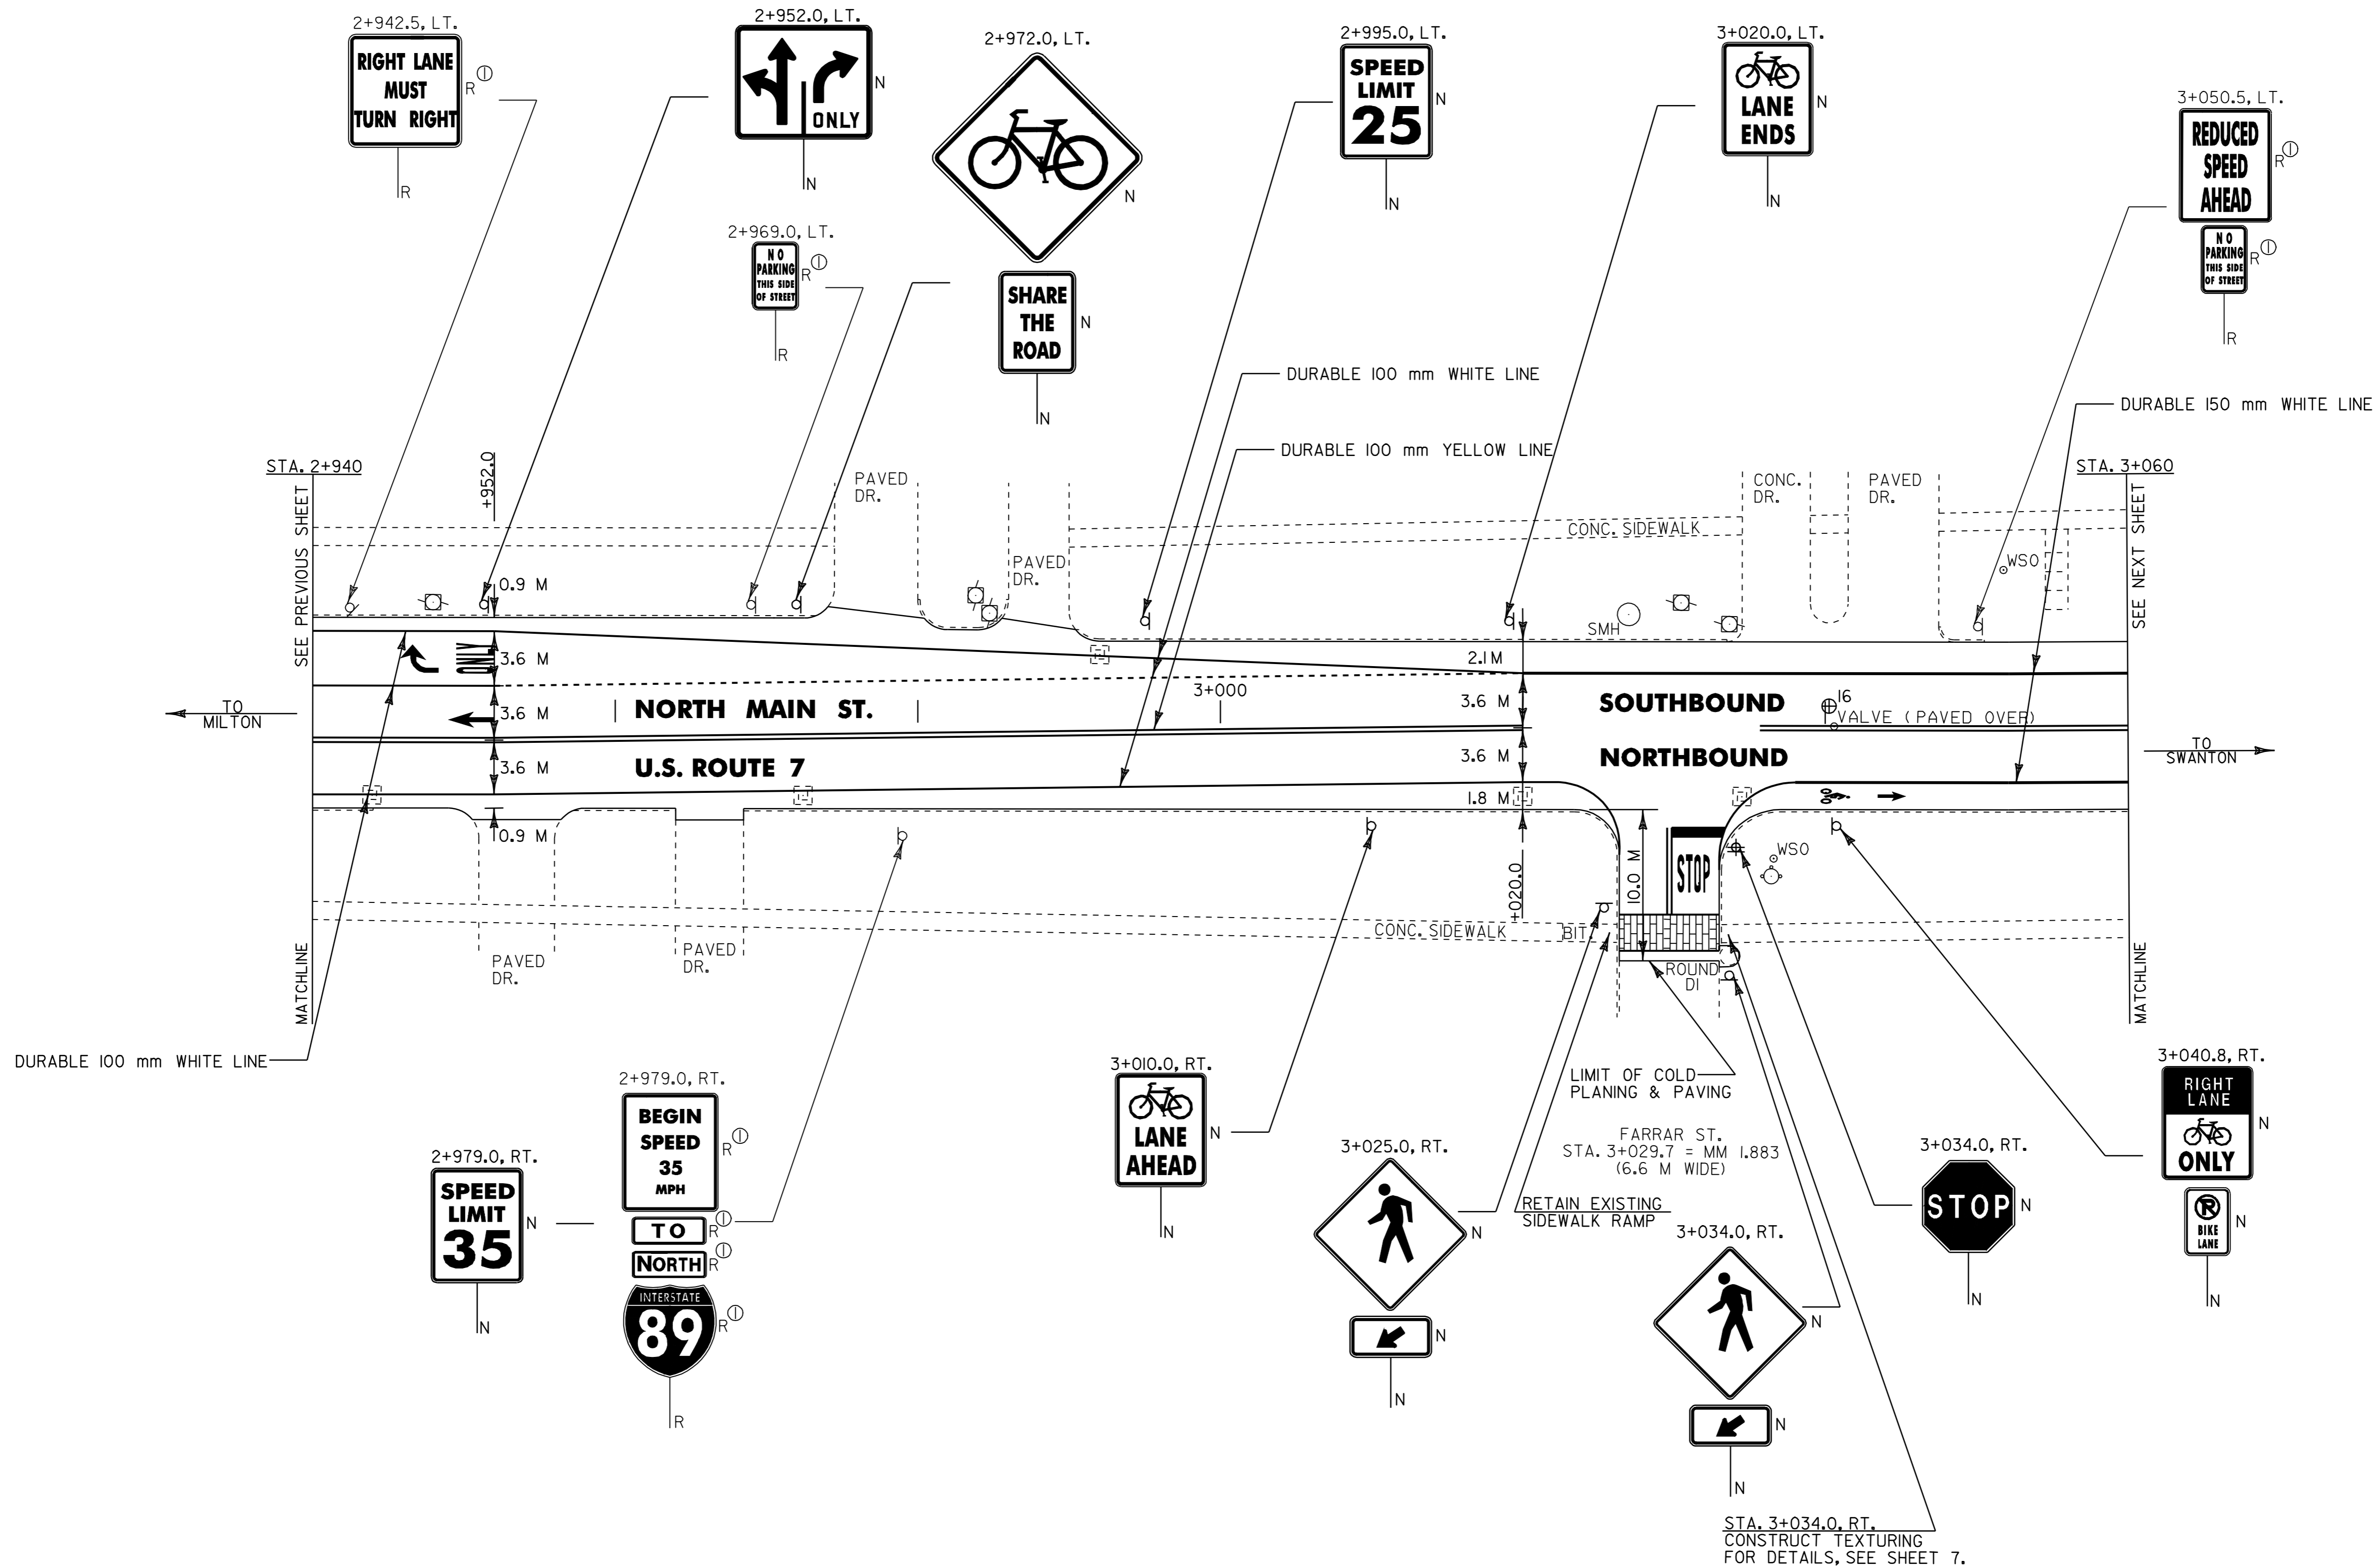

⊕ CORE LOCATION

PAVEMENT CORE DATA			
CORE #	LOCATION	DEPTH (mm)	PCC
16	3+040.1, LT.	152	YES

- NOTES:
- 1) ALL DIMENSIONS IN MILLIMETERS EXCEPT WHERE OTHERWISE INDICATED.
 - 2) ALL EXISTING SIGNS NOT SHOWN SHALL BE RETAINED AS DIRECTED BY THE RESIDENT ENGINEER.
 - 3) FOR ANY TOWN HIGHWAY OR STREET DETAILS, SEE VTrans STANDARD E-193M.

LAYOUT SHEET #22

PROJECT NAME: ST. ALBANS CITY
 PROJECT NUMBER: STP_9804(I)S
 FILE NAME: Z:\pave\297d150\pd150.dgn
 PROJECT LEADER: JLL
 DESIGNED BY: D-H
 IPARM FILE NAME: pd150p22.i
 PLOT DATE: 01-FEB-2006 07:5
 DRAWN BY: D-H
 CHECKED BY:
 SHEET 43 OF 105

TEMPORARY & DURABLE 150 mm WHITE LINE
 STA. 3+060.0 TO 3+200.0, SOLID LT. & RT.


TEMPORARY & DURABLE 100 mm YELLOW LINE
 STA. 3+060.0 TO 3+200.0, SOLID LT. & RT.

REMOVING SIGNS
 AS SHOWN - 3

REHABILITATION OF DI'S, CB'S OR MH'S - CLASS I
 STA. 3+082.0, RT. - DI
 STA. 3+111.5, RT. - DI
 STA. 3+115.0, LT. - DI
 STA. 3+156.5, RT. - DI

LETTER OR SYMBOL (MOD.)
 STA. 3+106.4, LT. - " 120.0
 STA. 3+110.0, LT. - " 123.0
 STA. 3+120.0, RT. - " 138.0
 STA. 3+123.6, RT. - " 142.0

TEMPORARY LETTER OR SYMBOL (MOD.)
 STA. 3+106.4, LT. - " 120.0
 STA. 3+110.0, LT. - " 123.0
 STA. 3+120.0, RT. - " 138.0
 STA. 3+123.6, RT. - " 142.0

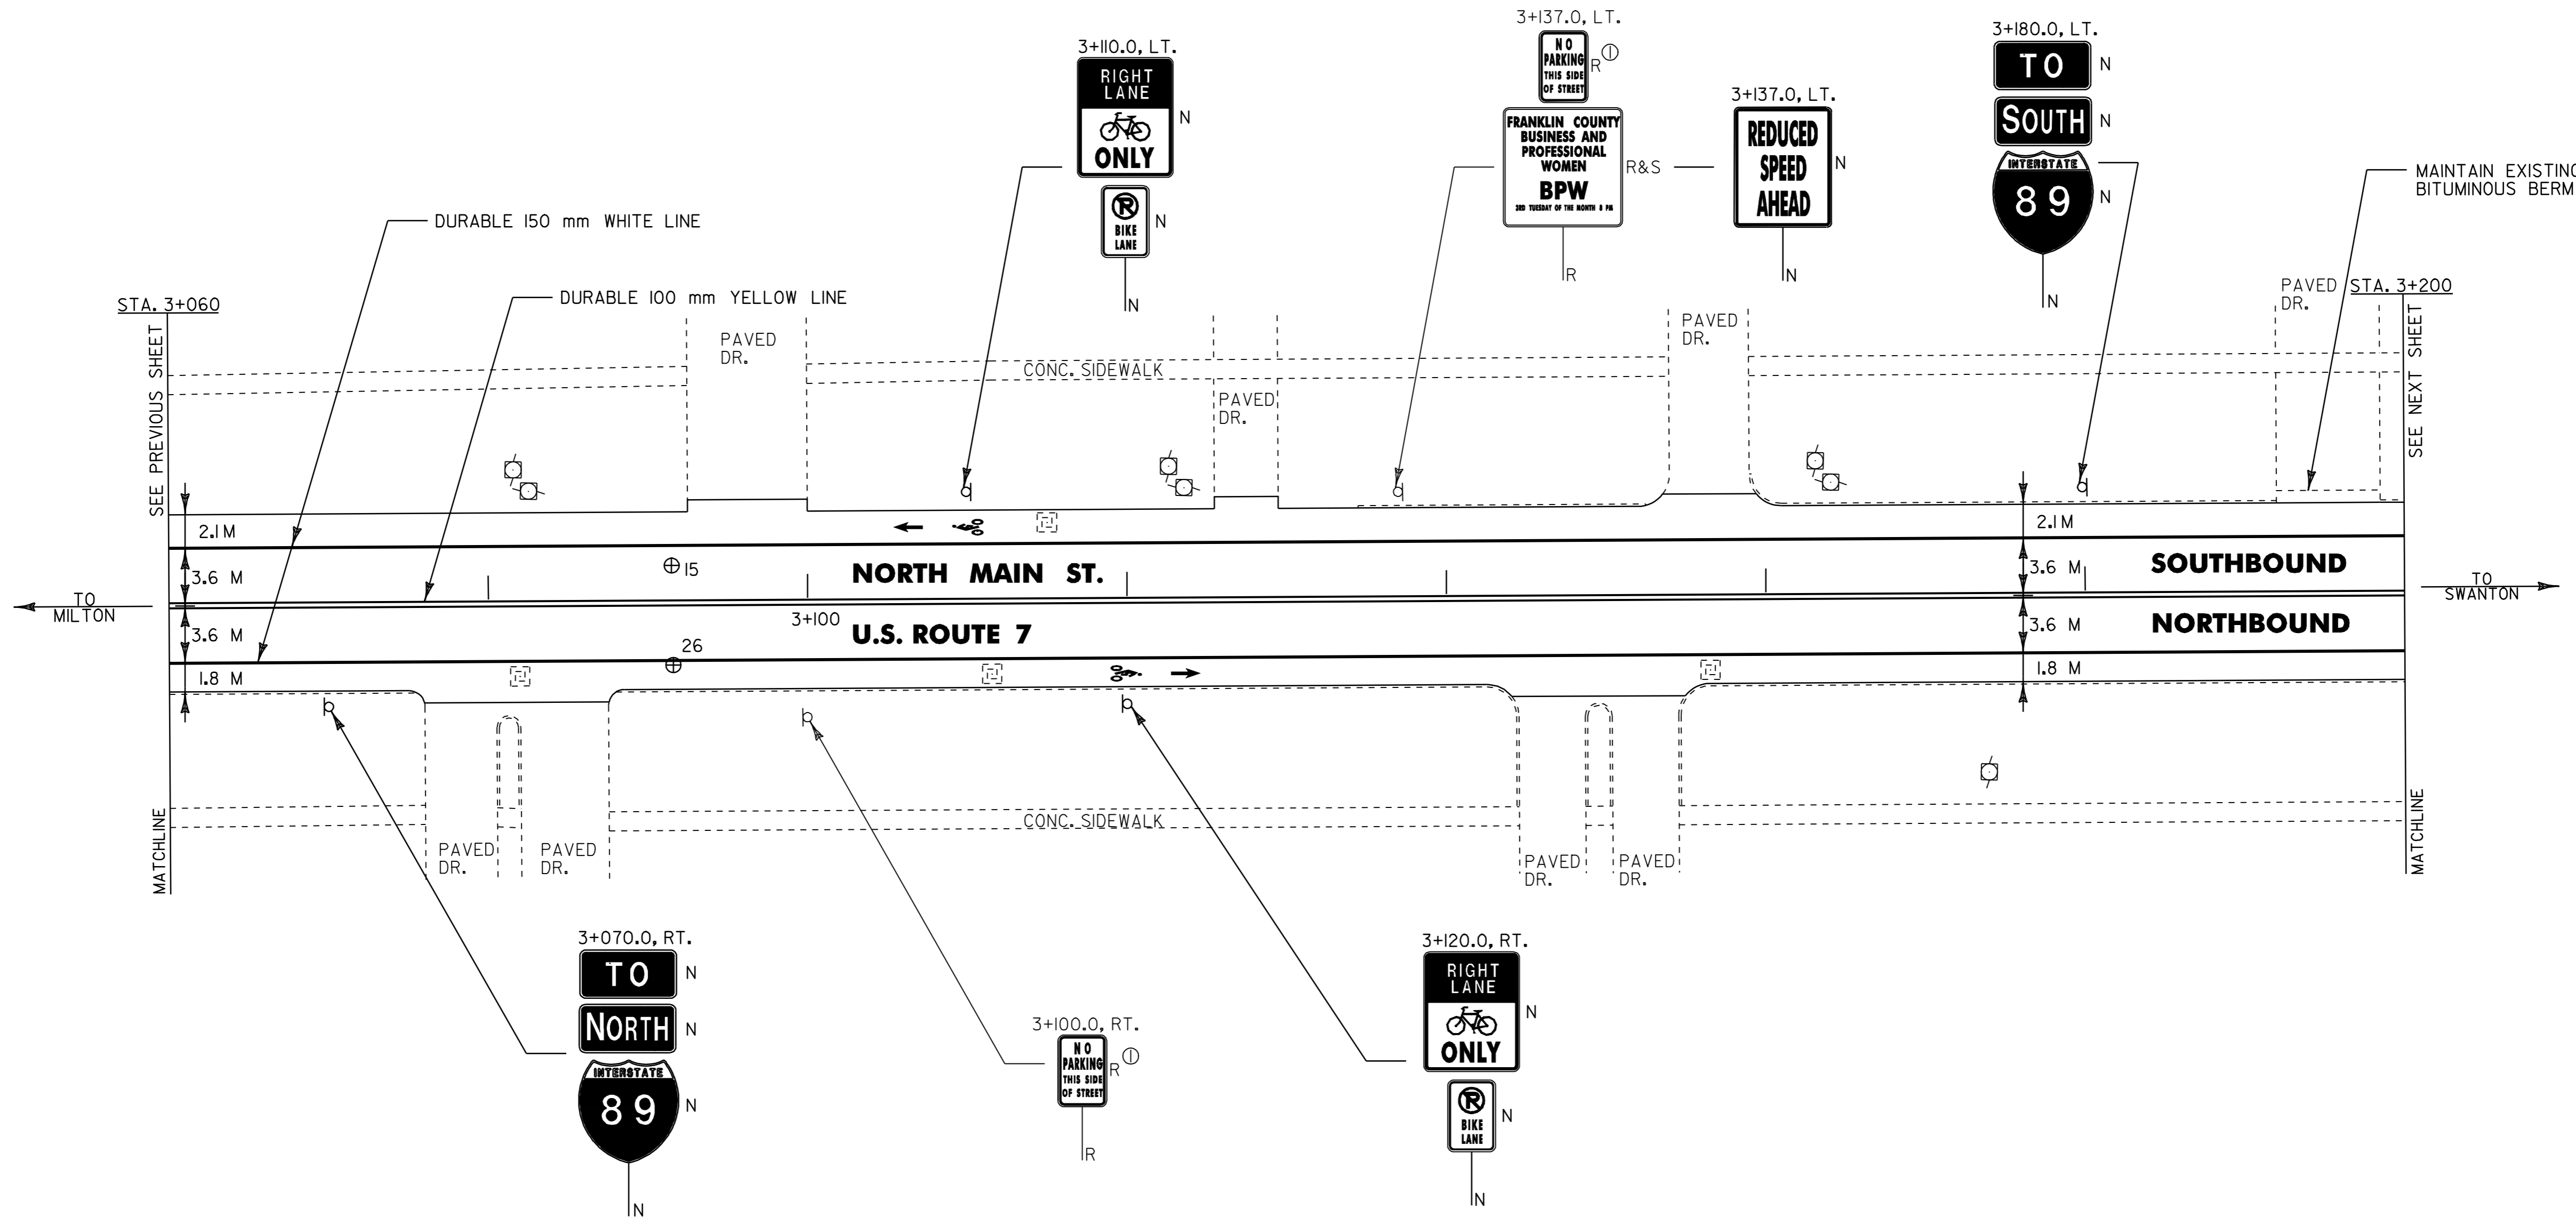

⊕ CORE LOCATION

PAVEMENT CORE DATA			
CORE #	LOCATION	DEPTH (mm)	PCC
15	3+091.5, LT.	178	NO
26	3+091.5, RT.	178	YES

- NOTES: 1) ALL DIMENSIONS IN MILLIMETERS EXCEPT WHERE OTHERWISE INDICATED.
 2) ALL EXISTING SIGNS NOT SHOWN SHALL BE RETAINED AS DIRECTED BY THE RESIDENT ENGINEER.
 3) FOR ANY TOWN HIGHWAY OR STREET DETAILS, SEE VTrans STANDARD E-193M.

LAYOUT SHEET #23

PROJECT NAME: ST. ALBANS CITY
 PROJECT NUMBER: STP_9804(I)S
 FILE NAME: \pave\97\dl50\pd150.dgn
 PROJECT LEADER: JLL
 DESIGNED BY: D-H
 IPARM FILE NAME: pd150p23.i
 PLOT DATE: 01-FEB-2006 07:30
 DRAWN BY: D-H
 CHECKED BY:
 SHEET 44 OF 105



TEMPORARY & DURABLE 150 mm WHITE LINE
STA. 3+200.0 TO 3+360.0, SOLID LT. & RT.

TEMPORARY & DURABLE 100 mm YELLOW LINE
STA. 3+200.0 TO 3+360.0, SOLID LT. & RT.

REMOVING SIGNS
AS SHOWN - 10

ERECTING SALVAGED SIGNS
AS SHOWN - 4


REHABILITATION OF DI'S, CB'S OR MH'S - CLASS I
STA. 3+238.0, LT. - DI
STA. 3+254.0, RT. - DI
STA. 3+307.0, RT. - DI
STA. 3+323.0, RT. - DI
STA. 3+314.0, LT. - DI

ADJUST ELEVATION OF VALVE BOX
STA. 3+303.0, RT. - WSO
STA. 3+314.0, RT. - WSO
STA. 3+354.5, RT. - WSO

CHANGING ELEVATION OF DI'S, CB'S OR MH'S
~~STA. 3+314.0, LT. - MH~~
STA. 3+317.5, RT. - MH (CONCRETE COLLAR)



LETTER OR SYMBOL (MOD.) TEMPORARY LETTER OR SYMBOL (MOD.)
STA. 3+230.0, RT. - 249.0 STA. 3+230.0, RT. - 249.0
STA. 3+233.6, RT. - 253.0 STA. 3+233.6, RT. - 253.0
STA. 3+296.4, LT. - 331.0 STA. 3+296.4, LT. - 331.0
STA. 3+300.0, LT. - 334.0 STA. 3+300.0, LT. - 334.0

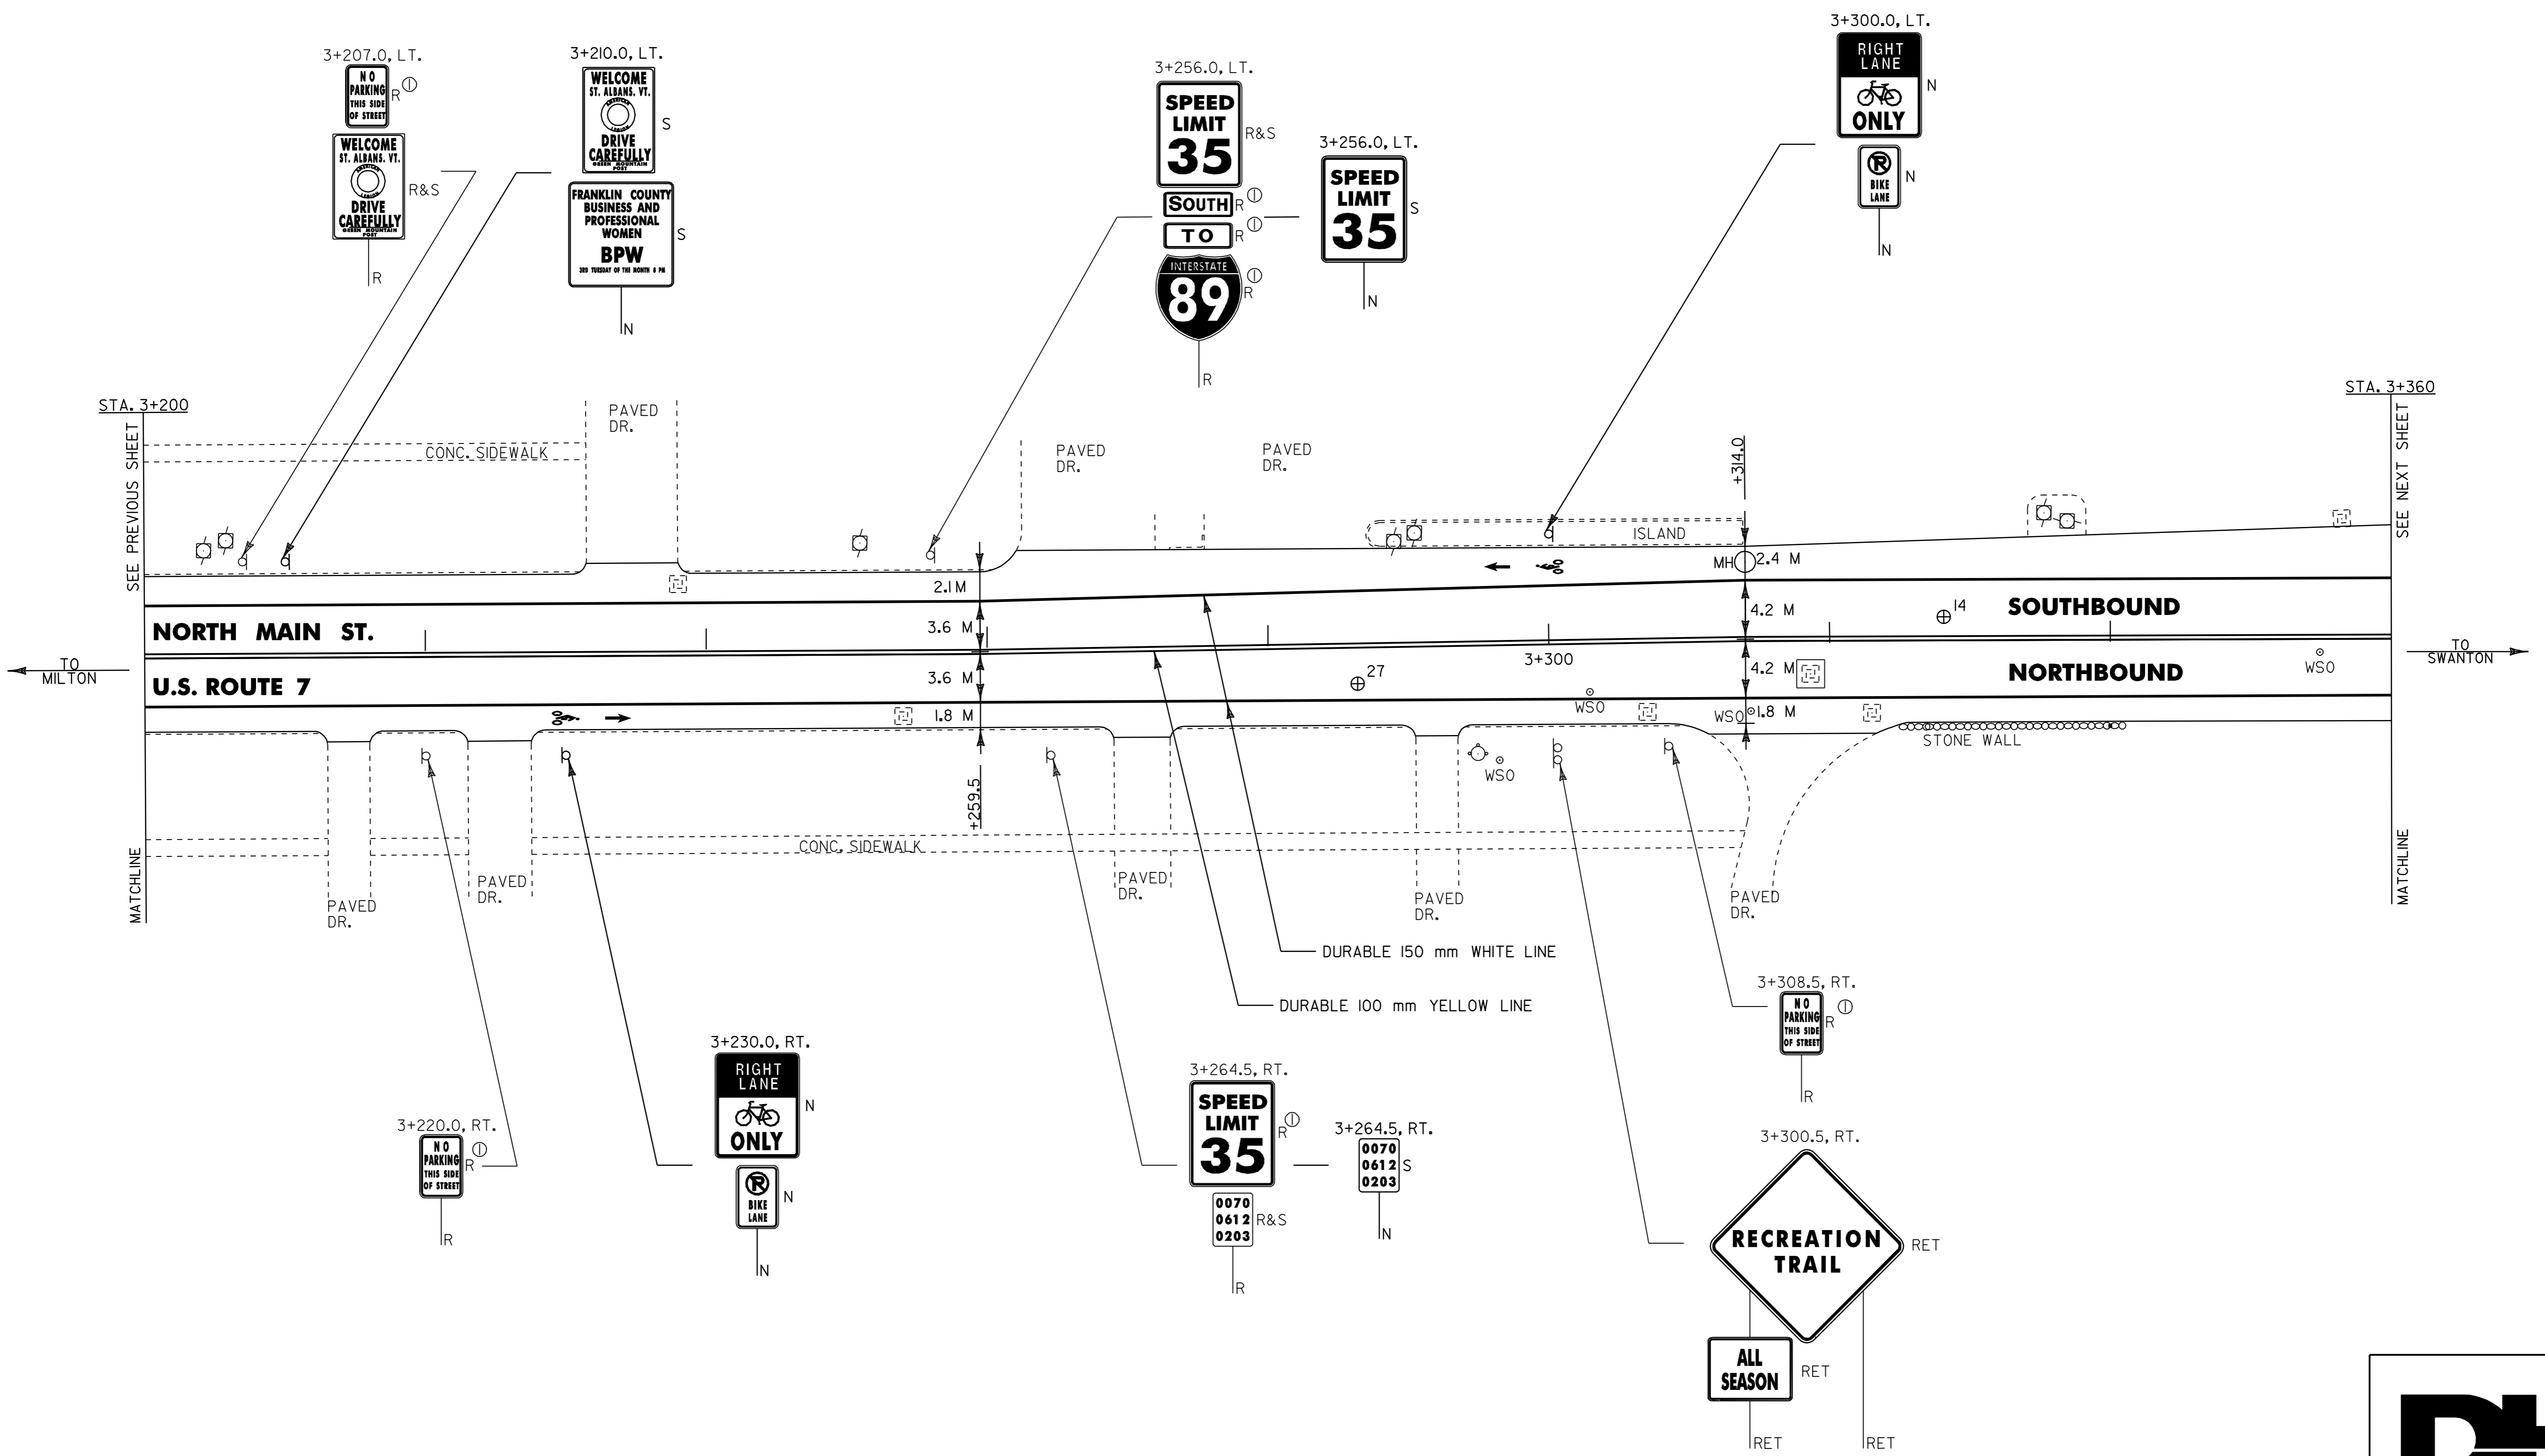

⊕ CORE LOCATION

PAVEMENT CORE DATA			
CORE #	LOCATION	DEPTH (mm)	PCC
14	3+328.1, LT.	152	YES
27	3+286.3, RT.	127	YES

NOTES: 1) ALL DIMENSIONS IN MILLIMETERS EXCEPT WHERE OTHERWISE INDICATED.
2) ALL EXISTING SIGNS NOT SHOWN SHALL BE RETAINED AS DIRECTED BY THE RESIDENT ENGINEER.
3) FOR ANY TOWN HIGHWAY OR STREET DETAILS, SEE VTrans STANDARD E-193M.

LAYOUT SHEET #24

PROJECT NAME: ST. ALBANS CITY
PROJECT NUMBER: SIP_9804(I)S
FILE NAME: 2pave297d1502pd150.dgn PLOT DATE: 01-FEB-2006 07:5
PROJECT LEADER: JLL DRAWN BY: D-H
DESIGNED BY: D-H CHECKED BY:
IPARM FILE NAME: pd150p24.i SHEET 45 OF 105



~~TEMPORARY & DURABLE 100 mm WHITE LINE~~
 STA. 3+447.0, RT. (LAKEVIEW TERR. EDGELINES)

TEMPORARY & DURABLE 100 mm YELLOW LINE
 STA. 3+360.0 TO 3+510.0, SOLID LT. & RT.
 (WITH CENTERLINE BREAK FOR LAKEVIEW TERR.)
 STA. 3+447.0, DOUBLE SOLID RT. (LAKEVIEW TERR.)

~~TEMPORARY & DURABLE 600 mm STOP BAR (TYPE ITAPE)~~
 STA. 3+447.0, RT. (LAKEVIEW TERR.)

~~TEMPORARY & DURABLE LETTER OR SYMBOL (TYPE ITAPE)~~
 STA. 3+447.0, RT. - 'STOP'

REMOVING SIGNS
 AS SHOWN - 4

ERECTING SALVAGED SIGNS
 AS SHOWN - 3



REHABILITATION OF DI'S, CB'S OR MH'S - CLASS I
 STA. 3+393.0, RT. - DI
 STA. 3+438.0, RT. - DI
 STA. 3+452.0, RT. - DI
 STA. 3+454.0, LT. - DI
 STA. 3+431.0, LT.


ADJUST ELEVATION OF VALVE BOX
 STA. 3+435.0, RT. - TEST CP
 STA. 3+440.0, RT. - TEST CP
 STA. 3+450.0, RT. - WSO
 STA. 3+453.0, RT.

CHANGING ELEVATION OF DI'S, CB'S OR MH'S
 STA. 3+431.0, LT. - MH
 STA. 3+443.0, RT. - MH
 STA. 3+446.0, RT. - DRAIN MH
 STA. 3+452.0, LT. - DRAIN MH

LETTER OR SYMBOL (MOD.)
 STA. 3+463.0, RT. - '475.0'
 STA. 3+466.6, RT. - '480.0'

TEMPORARY LETTER OR SYMBOL (MOD.)
 STA. 3+463.0, RT. - '475.0'
 STA. 3+466.6, RT. - '480.0'

~~TEMPORARY & DURABLE 150 mm WHITE LINE~~
 STA. 3+360.0 TO 3+510.0, SOLID LT. & RT.
 (WITH EDGELINE BREAK FOR LAKEVIEW TERR.)

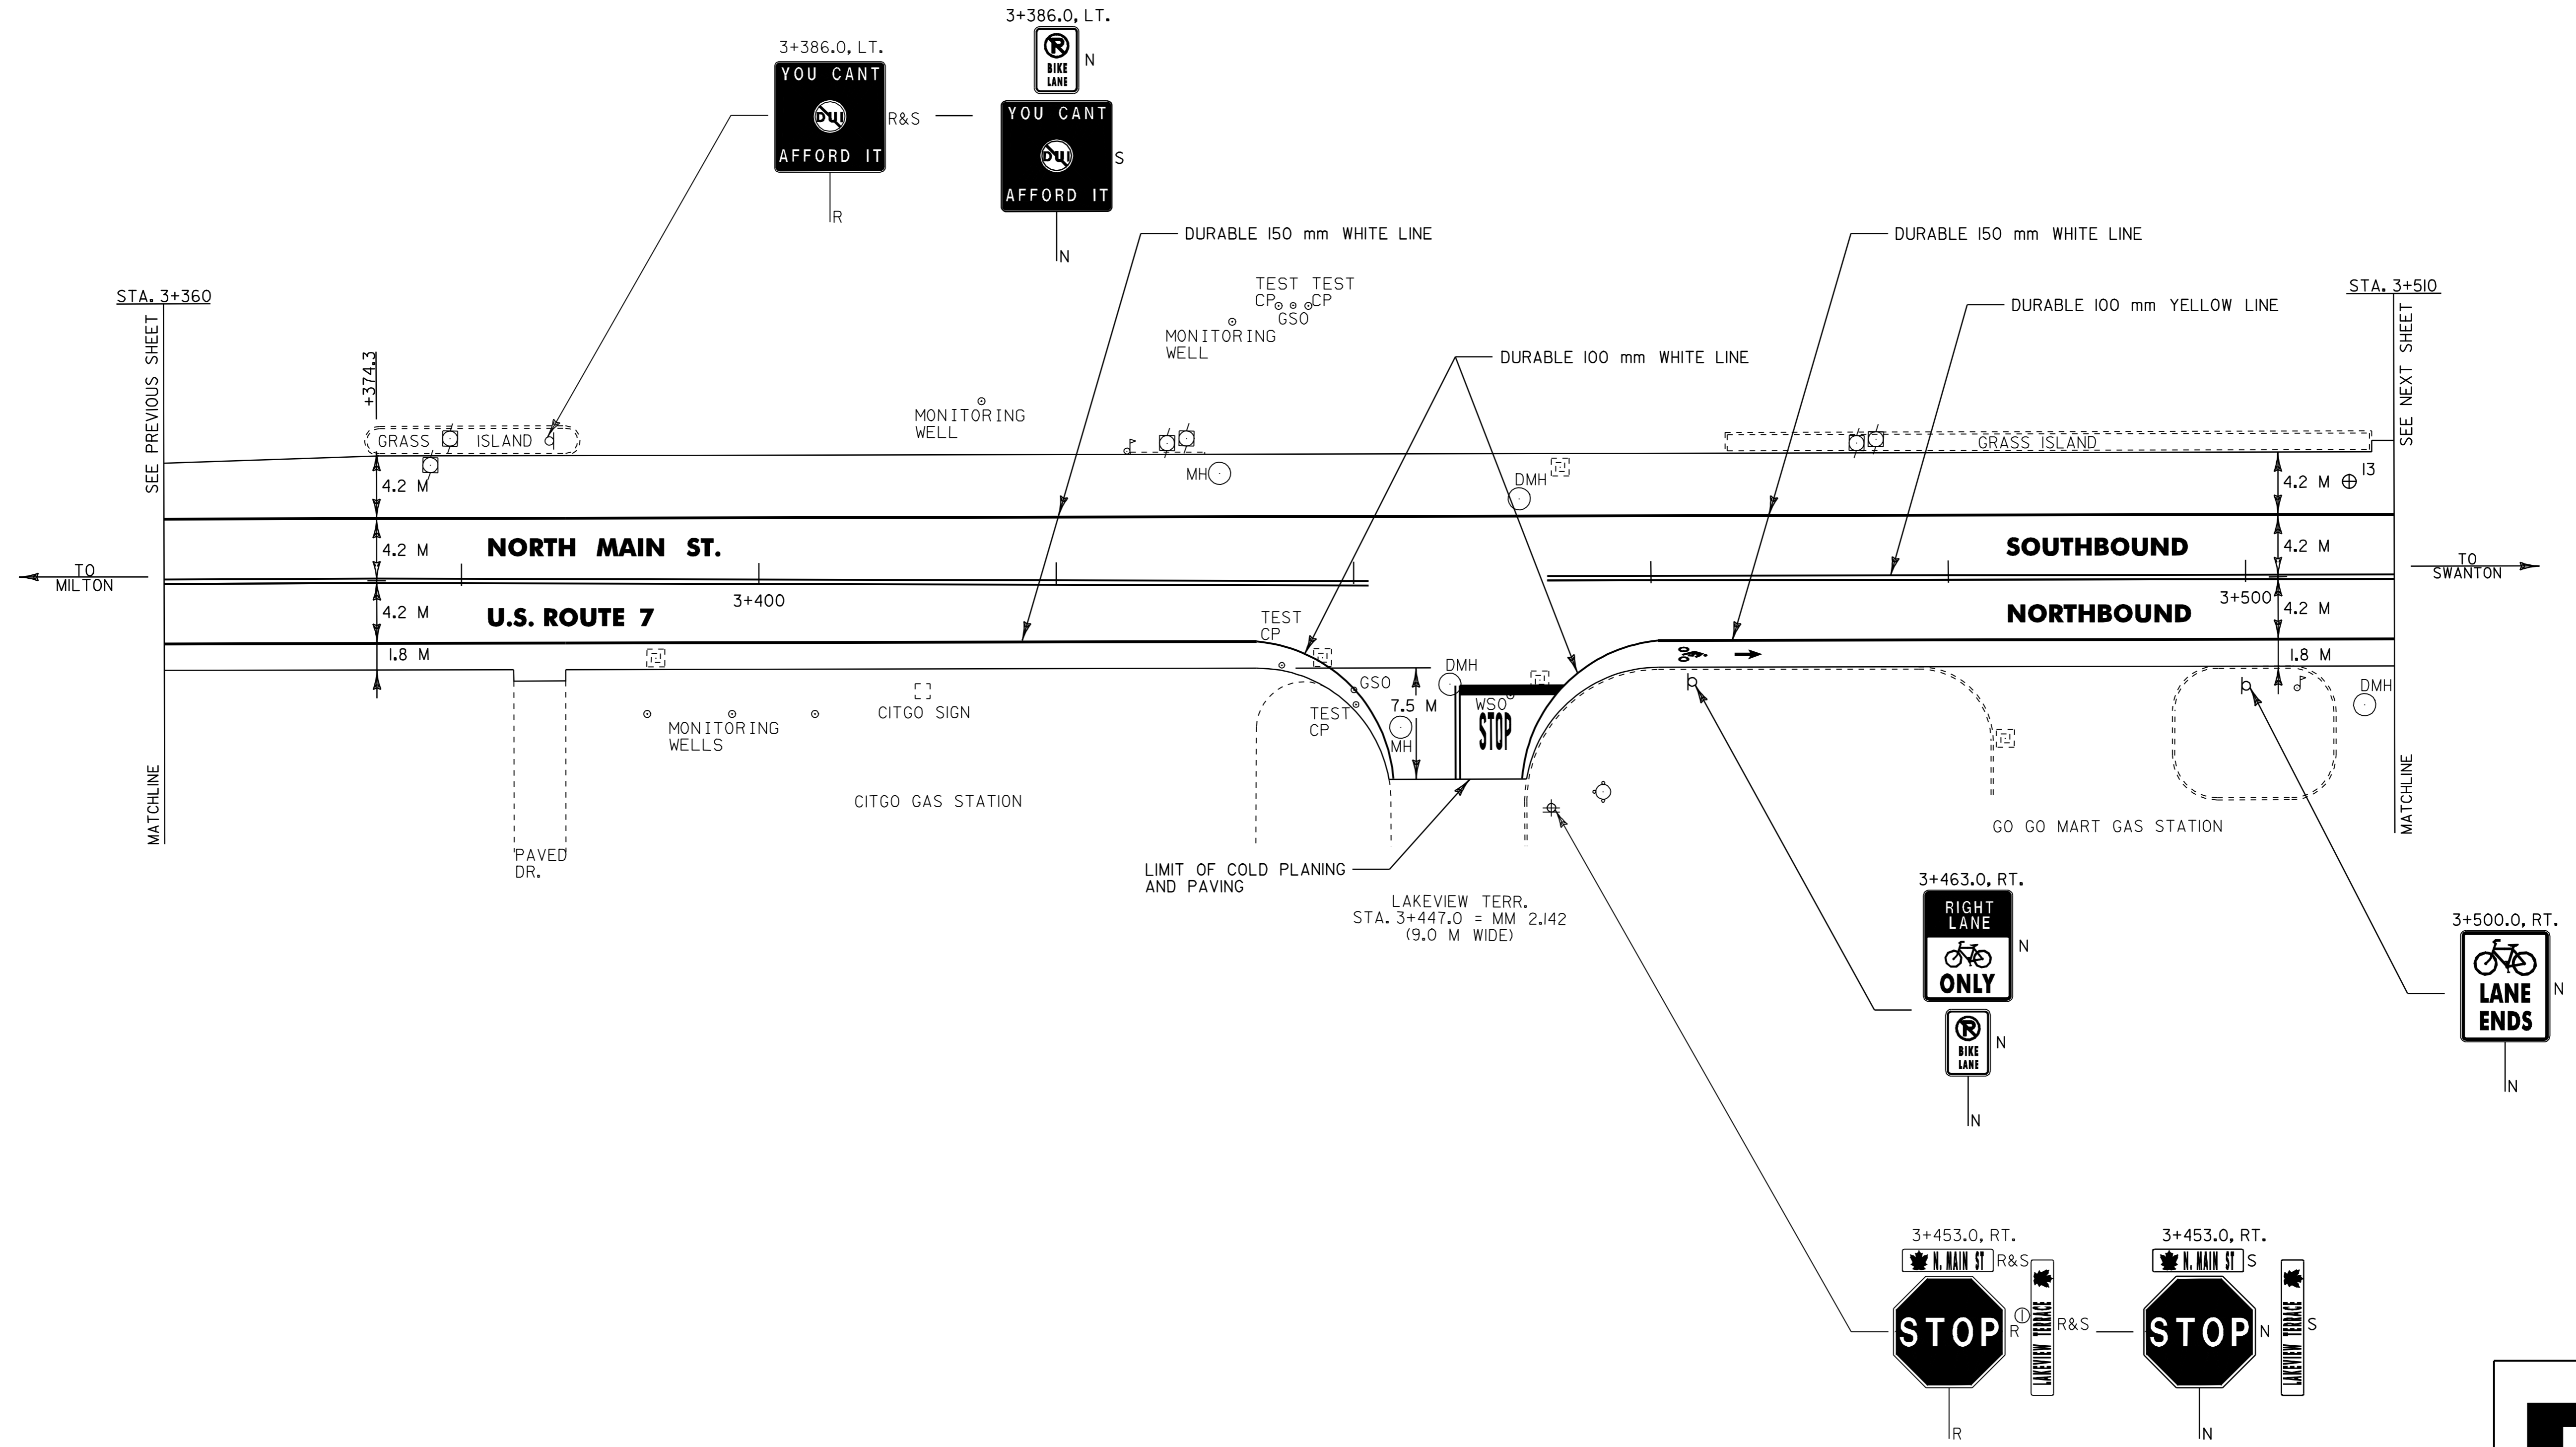

⊕ CORE LOCATION

PAVEMENT CORE DATA			
CORE #	LOCATION	DEPTH (mm)	PCC
13	3+506.8, LT.	127	NO

- NOTES:
- 1) ALL DIMENSIONS IN MILLIMETERS EXCEPT WHERE OTHERWISE INDICATED.
 - 2) ALL EXISTING SIGNS NOT SHOWN SHALL BE RETAINED AS DIRECTED BY THE RESIDENT ENGINEER.
 - 3) FOR ANY TOWN HIGHWAY OR STREET DETAILS, SEE VTrans STANDARD E-193M.

LAYOUT SHEET #25

PROJECT NAME: ST. ALBANS CITY
 PROJECT NUMBER: STP_9804(I)
 FILE NAME: Z:\pave\97\d150\pd150.dgn
 PROJECT LEADER: JLL
 DESIGNED BY: D-H
 IPARM FILE NAME: pd150p25.i
 PLOT DATE: 01-FEB-2006 07:5
 DRAWN BY: D-H
 CHECKED BY:
 SHEET 46 OF 105



~~TEMPORARY & DURABLE 100 mm WHITE LINE~~
 STA. 3+560.0 TO 3+640.40, SOLID RT.
 (WITH EDGELINE BREAK FOR VT ROUTE 105
 STA. 3+568.0, DOUBLE SOLID RT. (VT ROUTE
 105 EDGELINES)
 STA. 3+568.0 TO 3+640.40, SOLID LT.

~~TEMPORARY & DURABLE 100 mm YELLOW LINE~~
 STA. 3+510.0 TO 3+640.40, SOLID LT. & RT.
 (WITH CENTERLINE BREAK FOR VT ROUTE 105
 STA. 3+568.0, DOUBLE SOLID RT. (VT ROUTE
 105 CENTERLINE)

~~TEMPORARY & DURABLE 600 mm STOP BAR (TYPE ITAPE)~~
 STA. 3+568.0, RT. (VT ROUTE 105)

~~TEMPORARY & DURABLE LETTER OR SYMBOL (TYPE ITAPE)~~
 STA. 3+568.0, RT. - "STOP"

~~REHABILITATION OF DI'S, CB'S OR MH'S - CLASS I~~
 STA. 3+585.0, RT. - DI




BITUMINOUS CONCRETE GUTTER
 STA. 3+566.0, LT.
~~STA. 3+568.0 TO 3+608.0, RT.~~
 (FOR DETAILS SEE SHEET 13)

ADJUST ELEVATION OF VALVE BOX
 STA. 3+563.0, RT. - WSO

REMOVING SIGNS AS SHOWN - 3
 LETTER OR SYMBOL (MOD.)
 STA. 3+536.4, LT. - 548.0
 STA. 3+540.0, LT. - 552.0
 STA. 3+536.4, RT. - 552.0
 STA. 3+540.0, RT. - 555.0
 TEMPORARY LETTER OR SYMBOL (MOD.)
 STA. 3+536.4, LT. - 548.0
 STA. 3+540.0, LT. - 552.0
 STA. 3+536.4, RT. - 552.0
 STA. 3+540.0, RT. - 555.0

~~TEMPORARY & DURABLE 150 mm WHITE LINE~~
 STA. 3+510.0 TO 3+557.6, SOLID RT.
 STA. 3+510.0 TO 3+568.0, SOLID LT.

~~CHANGING ELEVATION OF DI'S, CB'S OR MH'S~~
~~STA. 3+512.0, RT. - DRAIN MH~~

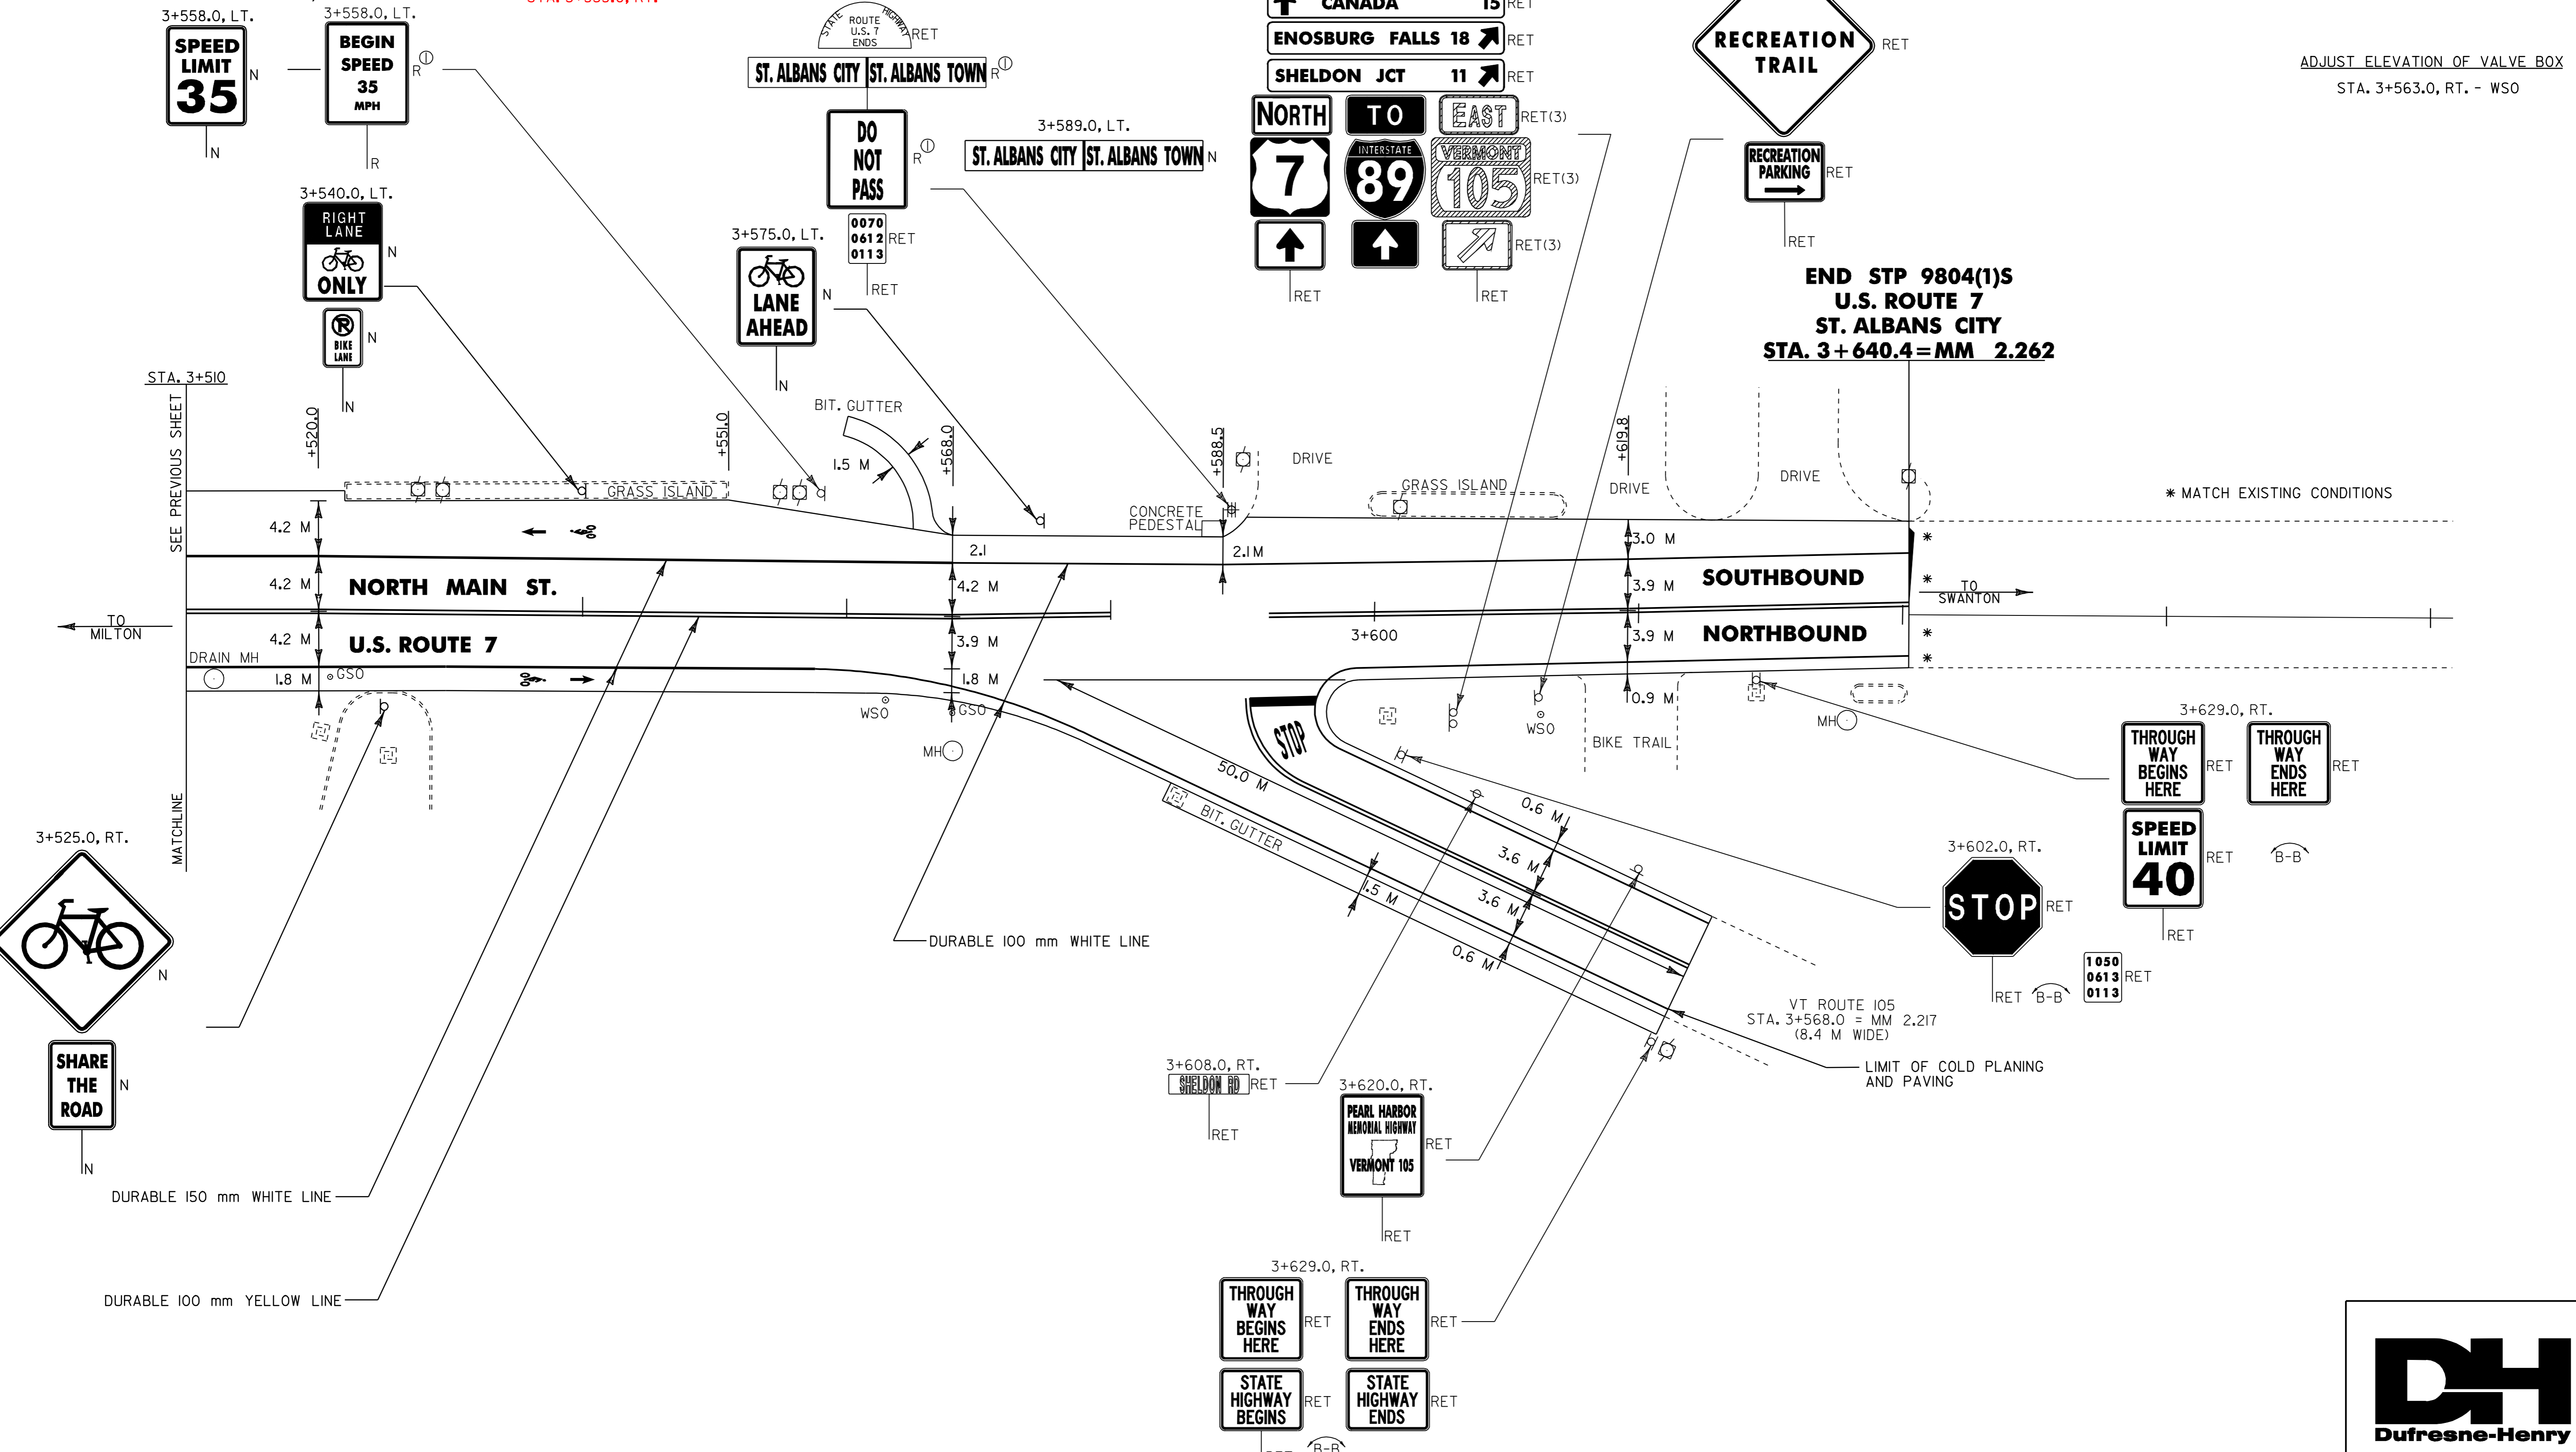

THROUGH WAY BEGINS HERE
 THROUGH WAY ENDS HERE
 STATE HIGHWAY BEGINS
 STATE HIGHWAY ENDS

NOTES: 1) ALL DIMENSIONS IN MILLIMETERS EXCEPT WHERE OTHERWISE INDICATED.
 2) ALL EXISTING SIGNS NOT SHOWN SHALL BE RETAINED AS DIRECTED BY THE RESIDENT ENGINEER.
 3) FOR ANY TOWN HIGHWAY OR STREET DETAILS, SEE VTrans STANDARD E-193M.

LAYOUT SHEET #26

PROJECT NAME: ST. ALBANS CITY
 PROJECT NUMBER: STP_9804(1)S
 FILE NAME: Z:\pave\297\d150\pd150.dgn
 PROJECT LEADER: JLL
 DESIGNED BY: D-H
 IPARM FILE NAME: pd150p26.i
 PLOT DATE: 01-FEB-2006 07:5
 DRAWN BY: D-H
 CHECKED BY:
 SHEET 47 OF 105



TRAFFIC SIGN SUMMARY SHEET

KILOMETER MARKER, STATION, OR SIGN NUMBER	SIGN LEGEND	SIGN DIMENSIONS		NEW & SALVAGED SIGNS				EXIST POST	NO. OF POSTS	NEW SIGN POSTS												REMARKS	SIGN DETAIL							
		EA	WIDTH (mm)	HEIGHT (mm)	"A"	"B"	SALV SIGN			SALV TIS	FLANGED CHANNEL			SQUARE STEEL (mm)			TUBULAR ALUMINUM (mm)			TUBULAR STEEL (mm)				W-SHAPE STEEL		DETAIL ON SHEET NUMBER	STD. SHEET NUMBER			
								1.7	3.0		4.5	3.4	3.9	5.0	75	100	100 MOD	FOUND-ACTION	75	89	100		125	FTG. SIZE				WEIGHT	POST SIZE	
																								kg/m	kg/m					kg/m
OPTION ITEMS																														
U.S. ROUTE 7 0+000.0, RT.		1	600	750	0.45				1			3.54																	E-142M	
		1	600	600	0.36				1		X	X																	E-141M	
		1	600	450	0.27																								E-141M	
0+000.0, RT.		1	150	200	0.03																								E-138M	
		1	150	200	0.03			X																					E-138M	
0+000.0, LT.		1	600	750	0.45							3.54																	E-142M	
		1	600	600	0.36				1		X	X																	E-141M	
		1	600	450	0.27																								E-141M	
0+018.8, RT.		1	750	750	0.56				1		X	2.96																	E-143M	
0+104.5, RT.		1	300	450	0.14				1		X	2.77														64				
0+128.5, RT.		1	750	750	0.56				1		X	2.90																	E-143M	
0+231.3, LT.		1	750	750	0.56				1		X	3.44																	E-143M	
0+242.1, LT.		1	600	750	0.45				1		X	2.93																	E-144M	
		1	450	450	0.20																								E-150M	
0+312.3, RT.		1	750	750	0.56				1		X	2.96																	E-143M	
0+431.5, LT									2		X	3.10																		

<p>FINAL POST LENGTHS ARE TO BE DETERMINED IN THE FIELD. POST SIZES ARE COMPUTED BASED ON INFORMATION FURNISHED ON THE STANDARD SHEETS AND THE TRAFFIC & SAFETY DIVISION'S "SIGN POST DESIGN GUIDELINE."</p>									EA	kg	kg	kg	kg	kg	kg	kg	kg													
									EA	kg	kg	kg	kg	kg	kg	kg	kg	kg	kg											
TOTALS	5.25	m ²	m ²	EA	EA	EA	EA	EA	46.0	m	m	46.0	m	EA	kg	kg	kg	kg	kg	kg	kg	EA	EA	EA	EA	EA	EA	EA	EA	EA

PROJECT NAME: ST. ALBANS CITY	PLOT DATE: 01-FEB-2006 07:58
PROJECT NUMBER: STP_9804(1)S	DRAWN BY: D-H
FILE NAME: Z:\pave\97\d150\d150.dgn	CHECKED BY:
DESIGNED BY: D-H	SHEET 48 OF 105
IPARM_FILE_NAME: pd150t01	

KILOMETER MARKER, STATION, OR SIGN NUMBER	SIGN LEGEND	SIGN DIMENSIONS		NEW & SALVAGED SIGNS				EXIST POST NO. OF POSTS	NEW SIGN POSTS												REMARKS	SIGN DETAIL									
		EA	WIDTH (mm)	HEIGHT (mm)	"A"	"B"	SALV SIGN		SALV TIS	FLANGED CHANNEL			SQUARE STEEL (mm)			TUBULAR ALUMINUM Ø (mm)			TUBULAR STEEL Ø (mm)				W-SHAPE STEEL		DETAIL ON SHEET NUMBER	STD. SHEET NUMBER					
										1.7	3.0	4.5	44	50	63	75	100	100 MOD	FOUND- ATION	75		89	100	125			FTG. SIZE		WEIGHT	POST SIZE	
									OPTION ITEMS																						
U.S. ROUTE 7 0+537.4, RT.		1	750	750	0.56				1		X	2.99 X																		E-143M	
0+550.0, RT.		1	300	450	0.14				1		X	2.71 X																	64		
0+687.0, RT.		1	750	750	0.56				1		X	3.35 X																		E-153M	
		1	600	300	0.18																										65
0+735.0, RT.		1	600	300	0.18																										E-135M
		1	600	600	0.36																										E-135M
		1	525	375	0.20					1		X	3.51 X																		E-135M
		1	150	200	0.03																										E-138M
0+766.5, RT.		1	750	750	0.56				1		X	2.93 X																		E-145AM	
0+825.0, RT.									1		X	2.99 X																		-	
0+849.5, LT.		1	600	750	0.45				1		X	3.75 X																			64
																															-
0+862.0, RT		1	600	300	0.18																										E-135M
		1	600	600	0.36					1		X	3.47 X																		E-135M
		1	525	375	0.20																										

<p>FINAL POST LENGTHS ARE TO BE DETERMINED IN THE FIELD. POST SIZES ARE COMPUTED BASED ON INFORMATION FURNISHED ON THE STANDARD SHEETS AND THE TRAFFIC & SAFETY DIVISION'S "SIGN POST DESIGN GUIDELINE."</p>												36.8	m	m	EA	kg	kg	kg	kg	kg	kg	kg	EA.	kg	EA.	EA.	kg		
TOTALS												36.8	m	m	EA.	EA.	EA.	EA.	EA.	EA.	EA.	EA.	EA.	EA.	EA.	EA.	EA.	EA.	EA.
												36.8	36.8	2	36.8	36.8	25.70												

PROJECT NAME: ST. ALBANS CITY
PROJECT NUMBER: STP 9804(I)S

FILE NAME: /pave/97d150/pdl50.dgn
PROJECT LEADER: JLL
DESIGNED BY: D-H
IPARM FILE NAME: pdl50+02.1

PLOT DATE: 01-FEB-2006 07:54
DRAWN BY: D-H
CHECKED BY:
SHEET 49 OF 105

KILOMETER MARKER, STATION, OR SIGN NUMBER	SIGN LEGEND	SIGN DIMENSIONS		NEW & SALVAGED SIGNS				EXIST POST RETAI N S A L V A G E	NO. OF P O S T S	NEW SIGN POSTS																	REMARKS	SIGN DETAIL							
		EA	WIDTH (mm)	HEIGHT (mm)	"A"	"B"	SALV SIGN			SALV TIS	FLANGED CHANNEL		SQUARE STEEL (mm)			TUBULAR ALUMINUM Ø (mm)			TUBULAR STEEL Ø (mm)				W-SHAPE STEEL					FR A M E S I G N E	R E Q U I R E D	DETAIL ON SHEET NUMBER	STD. SHEET NUMBER				
											1.7	3.0	4.5	44	50	63	75	100	100 MOD	FOUND- ATION	75	89	100	125	FTG. SIZE							WEIGHT	POST SIZE		
																									kg/m	kg/m								kg/m	kg/m
OPTION ITEMS																																			
U.S. ROUTE 7							2																												
0+894.5, LT							2		1			X		3.78	X																	X			
							1																												
0+928.5, LT		1	600	300	0.18																												E-136BM		
		1	750	600	0.45					1			X		3.48	X																		E-136BM	
		1	525	375	0.20																													E-136BM	
0+962.0, RT		1	750	750	0.56					1			X		2.99	X																		E-145AM	
0+970.0, LT		1	750	750	0.56					1			X		3.08	X																		E-145AM	
0+978.0, LT							2																												
		1	750	750	0.56					1			X			2.74	X																		SALVAGED STREET SIGNS TO BE INSTALLED 90° TO EACH OTHER MOUNTED 150 mm ABOVE THE NEW STOP SIGN USING A POST TOP MOUNTING BRACKET, MOUNTED ON A NEW POST. E-143M
1+010.5, LT		1	600	300	0.18																													E-135M	
		1	600	600	0.36					1			X		3.44	X																			E-135M
		1	525	375	0.20																														E-135M
1+021.0, LT							1																												
		1						1					X			3.11	X																		

TRAFFIC SIGN SUMMARY SHEET

KILOMETER MARKER, STATION, OR SIGN NUMBER	SIGN LEGEND	SIGN DIMENSIONS		NEW & SALVAGED SIGNS				EXIST POST RETAIN	SALVAGED	NO. OF POSTS	NEW SIGN POSTS															REMARKS	SIGN DETAIL							
		EA	WIDTH (mm)	HEIGHT (mm)	"A"	"B"	SALV SIGN				SALV TIS	FLANGED CHANNEL			SQUARE STEEL (mm)			TUBULAR ALUMINUM Ø (mm)			TUBULAR STEEL Ø (mm)				W-SHAPE STEEL		FRAMING SIGN REQUIRED	DETAIL ON SHEET NUMBER	STD. SHEET NUMBER					
												1.7	3.0	4.5	44	50	63	75	100	100 MOD	75	89	100	125	600 mm					750 mm	WEIGHT	POST SIZE		
																																	kg/m	kg/m
OPTION ITEMS																																		
U.S. ROUTE 7 1+242.0, RT.		1	750	750	0.56					1			X	2.71	X																		E-143M	
1+254.8, RT.		1	300	450	0.14					1			X	2.68	X																	64		
1+255.5, LT.		1	750	750	0.56					1			X	3.17	X																		E-153M	
		1	600	300	0.18																												65	
1+271.5, LT.		1	750	750	0.56					1			X	2.83	X																		E-143M	
1+280.1, LT.		1	750	750	0.56					1			X	2.99	X																		65	
1+293.5, LT.		1	300	450	0.14					1			X	3.14	X																			64
		1	300	450	0.14																													64
1+333.5, RT.		1	600	750	0.45					1			X	2.96	X																			E-142M
1+352.0, RT.		1	300	450	0.14					1			X	2.59	X																			64
1+374.2, RT.		1	750	750	0.56					1			X	2.96	X																			E-143M
1+378.9, LT.		1	600	750	0.45					1			X	2.96	X																			E-142M

FINAL POST LENGTHS ARE TO BE DETERMINED IN THE FIELD. POST SIZES ARE COMPUTED BASED ON INFORMATION FURNISHED ON THE STANDARD SHEETS AND THE TRAFFIC & SAFETY DIVISION'S "SIGN POST DESIGN GUIDELINE."

TOTALS	m ²	m ²	EA.	m ²				m	m	EA	kg	kg	kg	kg	kg	kg	kg	EA.	EA.	kg
	4.44				46.0	46.0														

PROJECT NAME: ST. ALBANS CITY
PROJECT NUMBER: STP 9804(I)S
FILE NAME: /pave/97d150/pd150.dgn
PROJECT LEADER: JLL
DESIGNED BY: D-H
IPARM FILE NAME: pd150+05.1
PLOT DATE: 01-FEB-2006 07:53
DRAWN BY: D-H
CHECKED BY:
SHEET 52 OF 105

KILOMETER MARKER, STATION, OR SIGN NUMBER	SIGN LEGEND	SIGN DIMENSIONS		NEW & SALVAGED SIGNS				EXIST POST	NO. OF POSTS	NEW SIGN POSTS														REMARKS	SIGN DETAIL								
		EA	WIDTH (mm)	HEIGHT (mm)	"A"	"B"	SALV SIGN			SALV TIS	FLANGED CHANNEL			SQUARE STEEL (mm)			TUBULAR ALUMINUM Ø (mm)			TUBULAR STEEL Ø (mm)					W-SHAPE STEEL		SIGN	REQUIRED	DETAIL ON SHEET NUMBER	STD. SHEET NUMBER			
											1.7	3.0	4.5	44	50	63	75	100	100 MOD	FOUND-ATION	75	89	100		125	FTG. SIZE					WEIGHT	POST SIZE	
														kg/m			kg/m				kg/m				600 mm	750 mm							
OPTION ITEMS																																	
U.S. ROUTE 7 1+425.0, LT.		1	300	450	0.14				1		X		2.62																64				
1+429.0, RT.		1	300	450	0.14				1		X		2.62																64				
1+441.0, LT.		1	750	750	0.56				1		X		2.71																	E-143M			
1+447.5, LT.		1	300	450	0.14				1		X		2.68																64				
1+480.0, RT.		1	900	750	0.68				1		X		2.96																	E-145AM			
1+510.0, RT.		1	300	450	0.14				1		X		2.62																64				
1+515.0, LT.		1	300	450	0.14				1		X		2.62																64				
1+527.0, LT.		1	900	750	0.68				1		X		2.99																	E-145AM			
1+563.0, LT.									1		X		3.29																-	-			
1+565.0, RT.		1	300	450	0.14				1		X		2.56																64				
1+570.0, LT.		1	900	750	0.68				1		X		3.02																	E-145AM			
1+598.4, LT.		1	300	450	0.14				1		X		2.68																64				
1+634.0, LT.		1	300	450	0.14				1		X		2.62																64				
1+646.8, LT.		1	300	450	0.14				1		X		2.65																64				

FINAL POST LENGTHS ARE TO BE DETERMINED IN THE FIELD. POST SIZES ARE COMPUTED BASED ON INFORMATION FURNISHED ON THE STANDARD SHEETS AND THE TRAFFIC & SAFETY DIVISION'S "SIGN POST DESIGN GUIDELINE."

TOTALS	m ² 3.86	m ²	EA. 1	m ²		64.4	m 64.4	m	EA	kg	kg	kg	kg	kg	kg	kg	kg	EA.	kg	EA.	EA.	kg

PROJECT NAME: ST. ALBANS CITY
PROJECT NUMBER: STP 9804(I)S
FILE NAME: /pave/97d150/pd150.dgn PLOT DATE: 01-FEB-2006 07:59
PROJECT LEADER: JLL DRAWN BY: D-H
DESIGNED BY: D-H CHECKED BY:
IPARM FILE NAME: pd150+06.i SHEET 53 OF 105

KILOMETER MARKER, STATION, OR SIGN NUMBER	SIGN LEGEND	SIGN DIMENSIONS		NEW & SALVAGED SIGNS				EXIST POST RETAIN SALVAGE	NO. OF POSTS	NEW SIGN POSTS																REMARKS	SIGN DETAIL							
		EA	WIDTH (mm)	HEIGHT (mm)	"A"	"B"	SALV SIGN			SALV TIS	FLANGED CHANNEL		SQUARE STEEL (mm)			TUBULAR ALUMINUM Ø (mm)			TUBULAR STEEL Ø (mm)				W-SHAPE STEEL		FRAMING SIGN		REQUIRED	DETAIL ON SHEET NUMBER	STD. SHEET NUMBER					
											1.7	3.0	4.5	3.4	44	50	63	75	100	100 MOD	FOUND-ATION	75	89	100						125	FTG. SIZE		WEIGHT	POST SIZE
																															kg/m	kg/m		
OPTION ITEMS																																		
U.S. ROUTE 7 1+662.0, RT.		1	300	450	0.14				X																				MOUNT NEW SIGN BELOW EXISTING EXISTING SIGN ON EXISTING POST.	64				
1+670.0, LT.		1	600	750	0.45							X		2.87																	E-142M			
1+685.0, LT.		1	300	450	0.14							X		2.65																	64			
1+700.5, LT.		1	750	750	0.56							X		2.96																	E-143M			
1+717.0, RT.		1	750	750	0.56							X		3.26																	E-152M			
		1	600	300	0.18																											65		
1+725.6, LT.		1	750	750	0.56							X		3.78																	E-152M			
		1	600	300	0.18																											65		
		1	300	450	0.14																											64		
1+755.5, RT.		1	750	750	0.56							X		3.23																	E-152M			
		1	600	300	0.18																											65		
1+761.5, LT.		1	750	750	0.56							X		3.23																	E-152M			
1+764.0, RT.		1	300	450	0.14							X		2.65																	64			
1+798.0, RT.		1	300	450	0.14							X		2.65																	64			

KILOMETER MARKER, STATION, OR SIGN NUMBER	SIGN LEGEND	SIGN DIMENSIONS		NEW & SALVAGED SIGNS				EXIST POST NO. OF POSTS	NEW SIGN POSTS														REMARKS	SIGN DETAIL										
		EA	WIDTH (mm)	HEIGHT (mm)	"A"	"B"	SALV SIGN		SALV TIS	FLANGED CHANNEL			SQUARE STEEL (mm)			TUBULAR ALUMINUM Ø (mm)			TUBULAR STEEL Ø (mm)					W-SHAPE STEEL			DETAIL ON SHEET NUMBER	STD. SHEET NUMBER						
										1.7	3.0	4.5	44	50	63	75	100	100 MOD	75	89	100	125		600 mm	750 mm	WEIGHT			POST SIZE					
OPTION ITEMS																																		
U.S. ROUTE 7 I+803.0, LT.			750	750	0.56							X		2.95																	E-143M			
I+818.0, RT.			750	750	0.56							X		2.96																E-143M				
I+819.0, RT.			750	750	0.56							X		3.26																E-152M				
			600	300	0.18																							65						
I+825.5, LT.			750	750	0.56	NO																									E-152M			
			600	300	0.18	NO																										E-152M		
I+855.0, RT.			900	750	0.68								X		3.44																E-145AM			
																															-	-		
I+942.2, RT	<p>4 POSTS NEEDED</p>		1800	250	0.45																										E-123M			
			1800	250	0.45																											E-123M		
			600	300	0.18																												E-136AM	
			600	600	0.36																												E-136AM	
			525	375	0.20																												E-135M	
			600	300	0.18																												E-135M	
			600	600	0.36																												E-135M	
			525	375	0.20																													E-135M
			600	300	0.18																													E-136BM
			600	600	0.36																													E-136BM
			525	375	0.20																													E-136BM
			1800	600	0.45									X		4.02																	E-136BM	
			1800	600	0.45											4.02																	E-136BM	
	1800	600	0.45																												E-123M			
	600	300	0.18									X		X																	E-123M			
	600	300	0.18																												E-136BM			
	600	600	0.36																												E-136AM			
	525	375	0.20																												E-136AM			
	600	300	0.18																												E-136AM			
	600	600	0.36																												E-136AM			
	525	375	0.20																												E-136BM			
	600	300	0.18																												E-136BM			
	750	600	0.45																												E-136BM			
	525	375	0.20																												E-136BM			

FINAL POST LENGTHS ARE TO BE DETERMINED IN THE FIELD. POST SIZES ARE COMPUTED BASED ON INFORMATION FURNISHED ON THE STANDARD SHEETS AND THE TRAFFIC & SAFETY DIVISION'S "SIGN POST DESIGN GUIDELINE."

TOTALS	EA	m ²	m ²	EA	m ²	EA	m	m	EA	kg	kg	kg	kg	kg	EA	kg	EA	EA	kg
	1	10.51					27.6			27.6									

PROJECT NAME: ST. ALBANS CITY
PROJECT NUMBER: STP 9804(I)S
FILE NAME: /pave/97d150/pd150.dgn PLOT DATE: 01-FEB-2006 07:54
PROJECT LEADER: JLL DRAWN BY: D-H
DESIGNED BY: D-H CHECKED BY:
IPARM FILE NAME: pd150+08.1 SHEET 55 OF 105

KILOMETER MARKER, STATION, OR SIGN NUMBER	SIGN LEGEND	SIGN DIMENSIONS			NEW & SALVAGED SIGNS				EXIST. POST RETAINED SALVAGED	NO. OF POSTS	NEW SIGN POSTS																REMARKS	SIGN DETAIL				
		EA	WIDTH (mm)	HEIGHT (mm)	"A"	"B"	SALV SIGN	SALV TIS			FLANGED CHANNEL				SQUARE STEEL (mm)			TUBULAR ALUMINUM Ø (mm)			TUBULAR STEEL Ø (mm)				W-SHAPE STEEL			FRAMING SIGN	REQUIRED	DETAIL ON SHEET NUMBER	STD. SHEET NUMBER	
											1.7	3.0	4.5	3.4	5.0	75	100	100 MOD	FOUND-ATION	75	89	100	125	FTG. SIZE		WEIGHT						POST SIZE
																								kg/m	kg/m							
1+975.0, RT		1	750	750	0.56					1		X			2.93	X																E-145AM
1+989.0, LT		1	750	750	0.56					1		X			2.93	X															INSTALL POST USING SLEEVE AS DETAILED ON STANDARD E-121M	E-145AM
1+999.5, RT		1	1800	250	0.45																										E-123M E-123M E-123M	
		1	600	300	0.18																										E-135M E-135M E-135M	
		1	1800	250	0.45					2																					E-123M E-123M E-123M	
		1	1800	250	0.45																										E-136BM E-136BM E-136BM	
		1	600	300	0.18																										E-135M E-135M E-135M	
2+011.5, LT.		1	300	450	0.14					1		X			2.68	X															INSTALL POST USING SLEEVE AS DETAILED ON STANDARD E-121M	64
2+034.0, LT.		1	1200	750	0.90					2		X			2.95	X															INSTALL POSTS USING SLEEVE AS DETAILED ON STANDARD E-121M	E-145BM
2+079.5, RT		1	750	750	0.56							X			3.23	X																E-152M
		1	600	300	0.18																											65

	27.6	m	EA	kg	kg	kg	kg	kg	kg
TOTALS	27.6	m	EA	kg	EA	kg	EA	EA	kg

FINAL POST LENGTHS ARE TO BE DETERMINED IN THE FIELD. POST SIZES ARE COMPUTED BASED ON INFORMATION FURNISHED ON THE STANDARD SHEETS AND THE TRAFFIC & SAFETY DIVISION'S "SIGN POST DESIGN GUIDELINE."

PROJECT NAME: ST. ALBANS CITY
 PROJECT NUMBER: STP 9804(I)S
 FILE NAME: /pave/97d150/pdl50.dgn PLOT DATE: 01-FEB-2006 07:30
 PROJECT LEADER: JLL DRAWN BY: D-H
 DESIGNED BY: D-H CHECKED BY:
 IPARM FILE NAME: pdl50+09.1 SHEET 56 OF 105

KILOMETER MARKER, STATION, OR SIGN NUMBER	SIGN LEGEND	SIGN DIMENSIONS			NEW & SALVAGED SIGNS				EXISTING POST RETAIN	NO. OF POSTS	FLANGED CHANNEL			SQUARE STEEL (mm)				TUBULAR ALUMINUM Ø (mm)			TUBULAR STEEL Ø (mm)				W-SHAPE STEEL			REQUIREMENTS	SIGN DETAIL								
		EA	WIDTH (mm)	HEIGHT (mm)	"A"	"B"	SALV SIGN	SALV TIS			1.7	3.0	4.5	44	50	63	ANCHOR	S	75	100	100 MOD	FOUND- ATION	75	89	100	125	FTG. SIZE		WEIGHT	POST SIZE	DETAIL ON SHEET NUMBER	STD. SHEET NUMBER					
																											kg/m						kg/m	kg/m	kg/m	600 mm	750 mm
		EA	kg	kg	kg	kg	EA	EA			kg	EA	EA	kg																							
OPTION ITEMS																																					
U.S. ROUTE 7 2+082.3, LT		I	750	750	0.56																												E-152M				
		I	600	300	0.18						X			3.29																		65					
2+125.0, RT		I	750	750	0.56																												E-145AM				
		I	750	750	0.56																												E-152M				
		I	600	300	0.18																												65				
2+142.0, LT.		I	750	750	0.56																												E-152M				
		I	600	300	0.18																													65			
2+142.0, RT.		I	750	750	0.56																													E-152M			
		I	600	300	0.18																													65			
2+145.8, LT.		I	750	750	0.56																													E-143M			
		I	750	750	0.56																													E-143M			
2+191.0, RT		I	750	750	0.56																													E-143M			
2+193.0, RT		I	750	750	0.56																													E-152M			
		I	600	300	0.18																														65		
2+193.5, LT		I	750	750	0.56																														E-152M		
		I	600	300	0.18																														65		
2+204.0, LT.		I	900	300	0.27																														E-142M		
		I	900	300	0.27																														E-142M		
2+303.0, RT.		I	750	750	0.56																														E-143M		
FINAL POST LENGTHS ARE TO BE DETERMINED IN THE FIELD. POST SIZES ARE COMPUTED BASED ON INFORMATION FURNISHED ON THE STANDARD SHEETS AND THE TRAFFIC & SAFETY DIVISION'S "SIGN POST DESIGN GUIDELINE."																																					
TOTALS			6.48			EA.																															

PROJECT NAME: ST. ALBANS CITY
 PROJECT NUMBER: STP 9804(I)S
 FILE NAME: /pave/97d150/pdl50.dgn PLOT DATE: 01-FEB-2006 07:5
 PROJECT LEADER: JLL DRAWN BY: D-H
 DESIGNED BY: D-H CHECKED BY:
 IPARM FILE NAME: pdl50+10.1 SHEET 57 OF 105


KILOMETER MARKER, STATION, OR SIGN NUMBER	SIGN LEGEND	SIGN DIMENSIONS		NEW & SALVAGED SIGNS				EXIST POST RETAINED SALVAGED	NO. OF POSTS	NEW SIGN POSTS												REMARKS	SIGN DETAIL								
		EA	WIDTH (mm)	HEIGHT (mm)	"A"	"B"	SALV SIGN			SALV TIS	FLANGED CHANNEL			SQUARE STEEL (mm)			TUBULAR ALUMINUM Ø (mm)			TUBULAR STEEL Ø (mm)				W-SHAPE STEEL		DETAIL ON SHEET NUMBER	STD. SHEET NUMBER				
											1.7	3.0	4.5	44	50	63	75	100	100 MOD	FOUND-ATION	75		89	100	125			FTG. SIZE		WEIGHT	POST SIZE
																												kg/m	kg/m		
OPTION ITEMS																															
U.S. ROUTE 7 2+305.2, RT.		1	750	750	0.56				1		X	3.26	X															65	E-152M		
		1	600	300	0.18																										
2+305.2, LT.		1	750	750	0.56				1		X	3.29	X															65	E-152M		
		1	600	300	0.18																										
2+316.0, LT.		1	900	300	0.27				1		X	2.53	X																E-142M		
		1	900	300	0.27																								E-142M		
2+377.0, LT.		1	750	750	0.56				1			2.93																	E-143M		
2+377.0, LT.		1	900	750	0.68				1		X	2.96	X																E-145AM		
2+311.0, RT.		1	600	600	0.36							2.47	X																		
2+388.0, LT.		1	750	750	0.56				1		X	2.90	X																E-143M		
2+389.5, LT.		1	900	300	0.27				1		X	2.56	X																E-142M		
2+432.0, RT.		1	300	300	0.09				1		X	2.50	X																E-143M		
2+433.0, LT.		1	300	300	0.09				1		X	2.56	X																E-143M		
2+460.0, RT.		1	750	750	0.56				1		X	2.93	X																E-145AM		
2+499.0, RT.		2	600	750	0.90				2		X	2.87	X																E-144M		
		2	450	450	0.40																									E-150M	

FINAL POST LENGTHS ARE TO BE DETERMINED IN THE FIELD. POST SIZES ARE COMPUTED BASED ON INFORMATION FURNISHED ON THE STANDARD SHEETS AND THE TRAFFIC & SAFETY DIVISION'S "SIGN POST DESIGN GUIDELINE."

TOTALS	m ²	m ²	EA.	m ²		m	m	EA	kg	kg	kg	kg	kg	kg	EA.	EA.	kg
	6.13	6.49	2		50.6	50.6											
					50.6	33.76											

PROJECT NAME: ST. ALBANS CITY
 PROJECT NUMBER: STP_9804(I)S
 FILE NAME: 297d1502pd150.dgn PLOT DATE: 01-FEB-2006 07:5
 PROJECT LEADER: JLL DRAWN BY: D-H
 DESIGNED BY: D-H CHECKED BY:
 IPARM_FILE_NAME: pd150t11.i SHEET 58 OF 105

KILOMETER MARKER, STATION, OR SIGN NUMBER	SIGN LEGEND	SIGN DIMENSIONS		NEW & SALVAGED SIGNS				EXIST POST	NO. OF POSTS	NEW SIGN POSTS										REMARKS	SIGN DETAIL															
		EA	WIDTH (mm)	HEIGHT (mm)	"A"	"B"	SALV SIGN			SALV TIS	RETAIN	SALVAGE	FLANGED CHANNEL			SQUARE STEEL (mm)			TUBULAR ALUMINUM Ø (mm)			TUBULAR STEEL Ø (mm)				W-SHAPE STEEL		SIGN	REQUIRED	DETAIL ON SHEET NUMBER	STD. SHEET NUMBER					
													1.7	kg/m		3.4	44	50	63		75	100	100 MOD	FOUND-ATION	75	89	100					125	FTG. SIZE		WEIGHT	POST SIZE
														3.0	4.5		3.9	5.0	1.9						2.5	2.5	11.3					13.4	16.1	21.7		
U.S. ROUTE 7 2+500.0, LT.		1	600	300	0.18																										E-136AM					
		1	600	600	0.36																										E-136AM					
		1	150	200	0.03				1		X	3.20 X																			E-138M					
2+538.0, LT.		1	750	750	0.56				1		X	2.83 X																			E-145AM					
2+547.0, LT.		1	300	300	0.09				1		X	2.50 X																			E-143M					
2+551.0, RT.		1	600	600	0.36				1		X	2.87 X																			E-143M					
2+636.0, RT.		1	750	750	0.56				1		X	2.93 X																			E-143M					
2+668.0, LT.		1	600	300	0.18						X	3.14 X																				E-135M				
		1	600	600	0.36						X																					E-135M				
2+710.0, LT.		1	300	300	0.09				1		X	3.47 X																				E-143M				
2+760.0, RT.		1	300	300	0.09				1		X	2.53 X																				E-143M				
2+792.0, LT.		1	300	300	0.09				1		X	2.50 X																				E-143M				

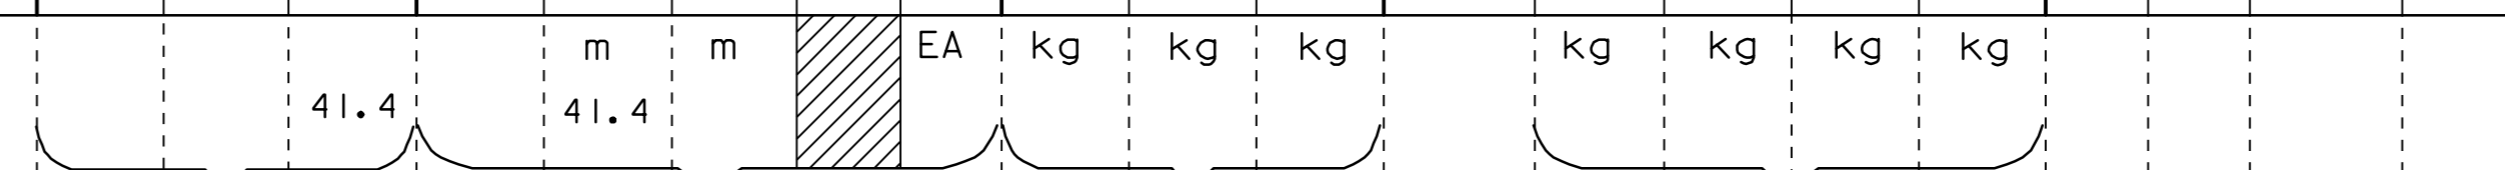

FINAL POST LENGTHS ARE TO BE DETERMINED IN THE FIELD. POST SIZES ARE COMPUTED BASED ON INFORMATION FURNISHED ON THE STANDARD SHEETS AND THE TRAFFIC & SAFETY DIVISION'S "SIGN POST DESIGN GUIDELINE."

TOTALS

m ² 2.95	m ²	EA. 2	m ²	EA	m 41.4	m 41.4 25.97	kg	EA.	kg	EA.	EA.	kg
------------------------	----------------	----------	----------------	----	----------------------	-------------------------------	----	-----	----	-----	-----	----

PROJECT NAME: ST. ALBANS CITY
 PROJECT NUMBER: STP_9804(I)S
 FILE NAME: Zpqve297dl5QZpd15Q.dgn
 PROJECT LEADER: JLL
 DESIGNED BY: D-H
 IPARM_FILE_NAME: pd15Q12.1
 PLOT DATE: 01-FEB-2006 07:54
 DRAWN BY: D-H
 CHECKED BY:
 SHEET 59 OF 105

KILOMETER MARKER, STATION, OR SIGN NUMBER	SIGN LEGEND	SIGN DIMENSIONS		NEW & SALVAGED SIGNS				EXIST POST		NEW SIGN POSTS												REMARKS	SIGN DETAIL																						
		EA	WIDTH (mm)	HEIGHT (mm)	"A"	"B"	SALV SIGN	SALV TIS	RETAIN	SALVAGE	NO. OF POSTS	FLANGED CHANNEL			SQUARE STEEL (mm)			TUBULAR ALUMINUM Ø (mm)			TUBULAR STEEL Ø (mm)				W-SHAPE STEEL		SIGN	REQUIRED	DETAIL ON SHEET NUMBER	STD. SHEET NUMBER															
												1.7	3.0	4.5	44	50	63	75	100	100 MOD	FOUND-ATION		75	89	100	125					FTG. SIZE	WEIGHT	POST SIZE												
OPTION ITEMS																																													
U.S. ROUTE 7 3+034.0, RT.		1	750	750	0.56						1			X			3.41																	E-152M											
			1	600	300	0.18						1			X																		65												
3+034.0, RT.		1	750	750	0.56						1			X			2.90																E-143M												
3+040.8, RT.		1	600	750	0.45						1			X			3.29																66												
		1	300	450	0.14						1			X																			66												
3+070.0, RT.		1	600	300	0.18						1																						E-135M												
		1	600	300	0.18						1			X			3.47																E-135M												
		1	600	600	0.36						1																						E-135M												
3+110.0, LT.		1	600	750	0.45						1			X			3.44																66												
		1	300	450	0.14						1			X																			66												
3+120.0, RT.		1	600	750	0.45						1			X			3.38																66												
		1	300	450	0.14						1			X																			66												
3+137.0, LT.		1	600	750	0.45						1			X			2.90																E-142M												
3+180.0, LT.		1	600	300	0.18						1																						E-135M												
		1	600	300	0.18						1			X			3.60																E-135M												
		1	600	600	0.36						1																						E-135M												

FINAL POST LENGTHS ARE TO BE DETERMINED IN THE FIELD. POST SIZES ARE COMPUTED BASED ON INFORMATION FURNISHED ON THE STANDARD SHEETS AND THE TRAFFIC & SAFETY DIVISION'S "SIGN POST DESIGN GUIDELINE."

TOTALS

m ²	m ²	EA.	m ²		m	m	EA	kg	kg	kg	kg	kg	kg	kg	EA.	kg	EA.	EA.	kg
4.96					36.8	36.8													
					36.8	26.39													

PROJECT NAME:	ST. ALBANS CITY	PLOT DATE:	01-FEB-2006 07:5
PROJECT NUMBER:	SIP_9804(1)S	DRAWN BY:	D-H
FILE NAME:	Zpqve297dl5QZpd15Q.dgn	CHECKED BY:	
DESIGNED BY:	D-H	SHEET	61 OF 105

KILOMETER MARKER, STATION, OR SIGN NUMBER	SIGN LEGEND	SIGN DIMENSIONS		NEW & SALVAGED SIGNS				EXIST POST	NO. OF POSTS	NEW SIGN POSTS																REMARKS	SIGN DETAIL															
		EA	WIDTH (mm)	HEIGHT (mm)	"A"	"B"	SALV SIGN			SALV TIS	FLANGED CHANNEL		SQUARE STEEL (mm)			TUBULAR ALUMINUM (mm)			TUBULAR STEEL (mm)				W-SHAPE STEEL		DETAIL ON SHEET NUMBER		STD. SHEET NUMBER															
											1.7	3.0	4.5	44	50	63	75	100	100 MOD	FOUNDATION				600 mm				750 mm	WEIGHT	POST SIZE												
U.S. ROUTE 7		OPTION ITEMS																																								
3+525.0, RT.		I	750	750	0.56				I	X	3.53																												65			
		I	450	600	0.27					X																														65		
3+540.0, LT.		I	600	750	0.45				I	X	3.29																													66		
		I	300	450	0.14					X																														66		
3+558.0, LT.		I	600	750	0.45				I	X	2.74																															E-142M
3+575.0, LT.		I	600	750	0.45				I	X	2.90																													66		
3+589.0, LT.	ST. ALBANS CITY ST. ALBANS TOWN	I	1500	190	0.29			I																																	MOUNT NEW TOWN LINE SIGN ON EXISTING POST	E-124M
	SHEET 48 TOTALS				5.25						46.0	46.0	31.68																													
	SHEET 49 TOTALS				3.96						36.8	36.8	25.70																													
	SHEET 50 TOTALS				3.25						32.2	32.2	26.40																													
	SHEET 51 TOTALS				4.76						46.0	46.0	30.88																													
	SHEET 52 TOTALS				4.44						46.0	46.0	28.99																													
	SHEET 53 TOTALS				3.86						64.4	64.4	38.64																													
	SHEET 54 TOTALS				4.67						41.4	41.4	27.28																													
	SHEET 55 TOTALS				10.51	9.77					27.6	27.6	20.65																													
	SHEET 56 TOTALS				8.56						27.6	27.6	17.68																													
	SHEET 57 TOTALS				6.48						46.0	46.0	30.64																													
	SHEET 58 TOTALS				6.13	6.49					50.6	50.6	33.76																													
	SHEET 59 TOTALS				2.95						41.4	41.4	25.97																													
	SHEET 60 TOTALS				6.03						50.6	50.6	32.40																													
	SHEET 61 TOTALS				4.96						36.8	36.8	26.39																													
	SHEET 62 TOTALS				2.92						41.4	41.4	27.48																													
	SHEET 63 TOTALS				2.61						18.4	18.4	12.46																													
	SUBTOTALS				80.96						653.2	653.2	437.0																													
	ROUNDING				.09						12.8	12.8																														

FINAL POST LENGTHS ARE TO BE DETERMINED IN THE FIELD. POST SIZES ARE COMPUTED BASED ON INFORMATION FURNISHED ON THE STANDARD SHEETS AND THE TRAFFIC & SAFETY DIVISION'S "SIGN POST DESIGN GUIDELINE."

TOTALS	m ²	m ²	EA.	m ²		m	m			EA	kg	kg	kg	kg	kg	kg	kg	EA.	EA.	kg
	83		27			666	666													

PROJECT NAME: ST. ALBANS CITY


PROJECT NUMBER: STP_9804(I)S

FILE NAME: zpqve297d150zpd150.dgn PLOT DATE: 01-FEB-2006 07:34

PROJECT LEADER: JLL DRAWN BY: D-H

DESIGNED BY: D-H CHECKED BY: _____


IPARM_FILE_NAME: pd150t16.i SHEET 63 OF 105

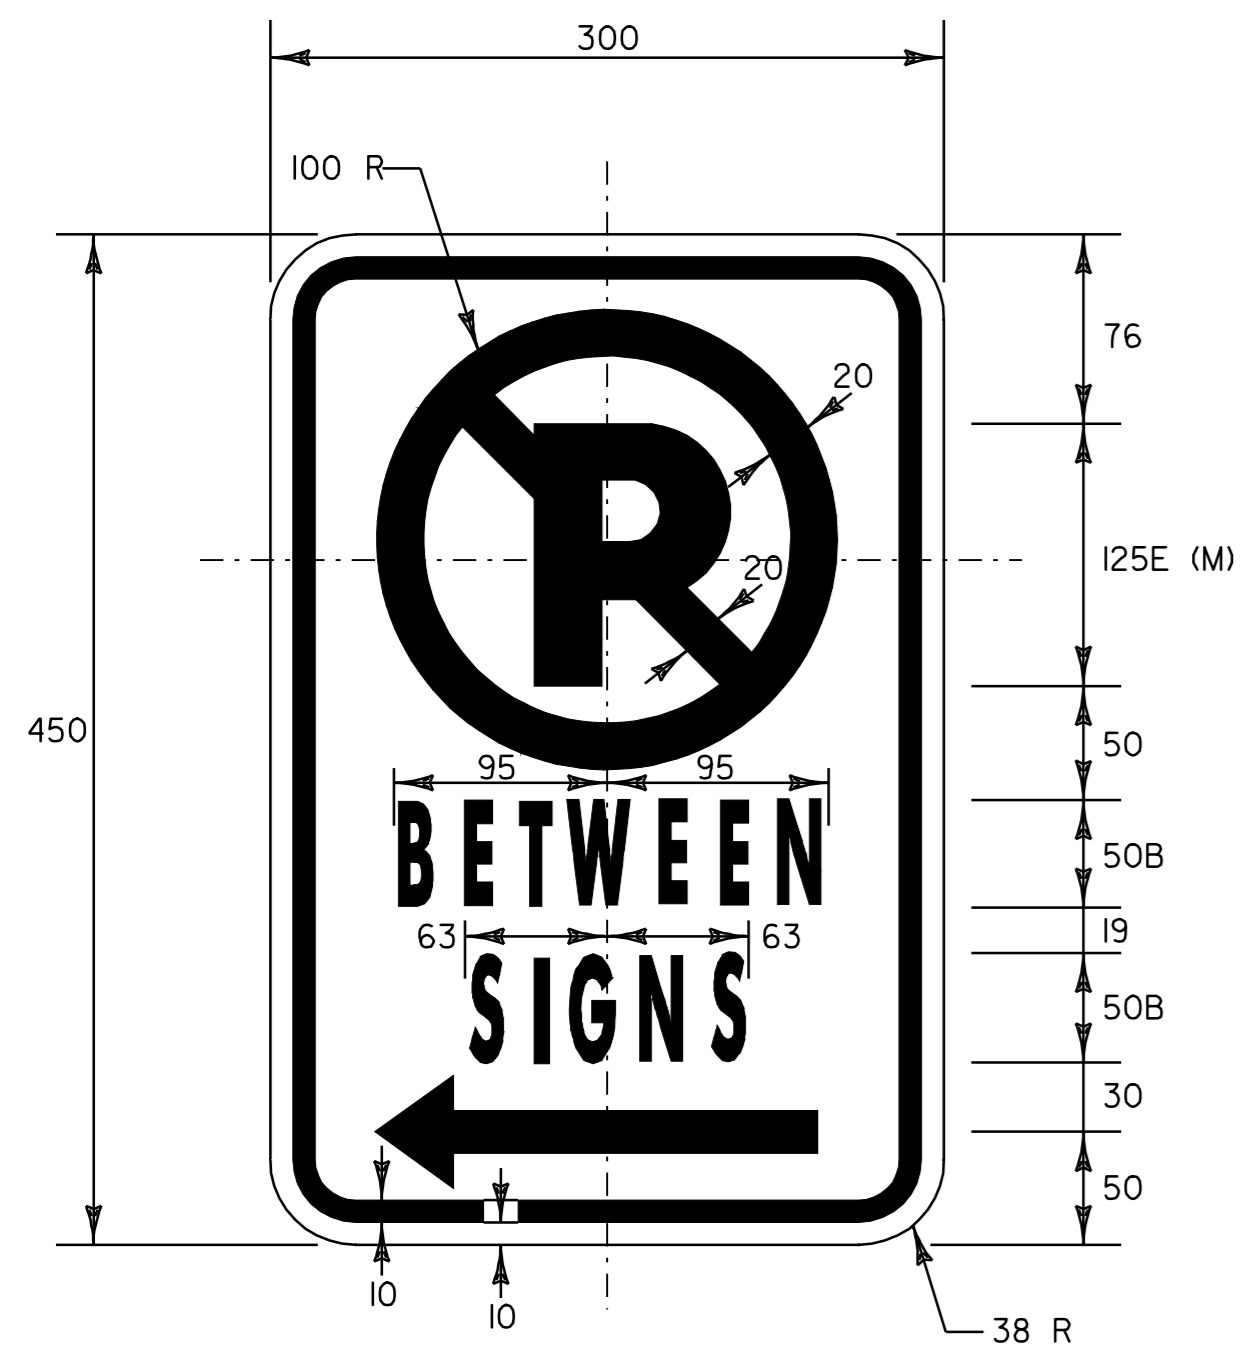

RED LEGEND, CIRCLE, DIAGONAL AND BORDER WITH WHITE (REFL.) BACKGROUND
SEE VTrans STANDARD E-143M FOR MATERIALS

LOCATIONS



- STA. I+429.0, RT. (LEFT ARROW)
- STA. I+447.5, LT. (RIGHT ARROW)
- STA. I+510.0, RT. (RIGHT ARROW)
- STA. I+515.0, LT. (LEFT ARROW)
- STA. I+764.0, RT. (LEFT ARROW)
- STA. I+798.0, RT. (RIGHT ARROW)

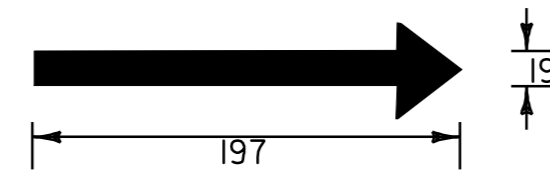

COLOR: GREEN LEGEND & BORDER
WHITE SYMBOL ON BLUE BACKGROUND
WHITE BACKGROUND
SEE VTRANS STANDARD E-143M FOR MATERIALS

LOCATIONS


- STA. I+293.5, LT.
- STA. I+634.0, LT.
- STA. I+646.8, LT.

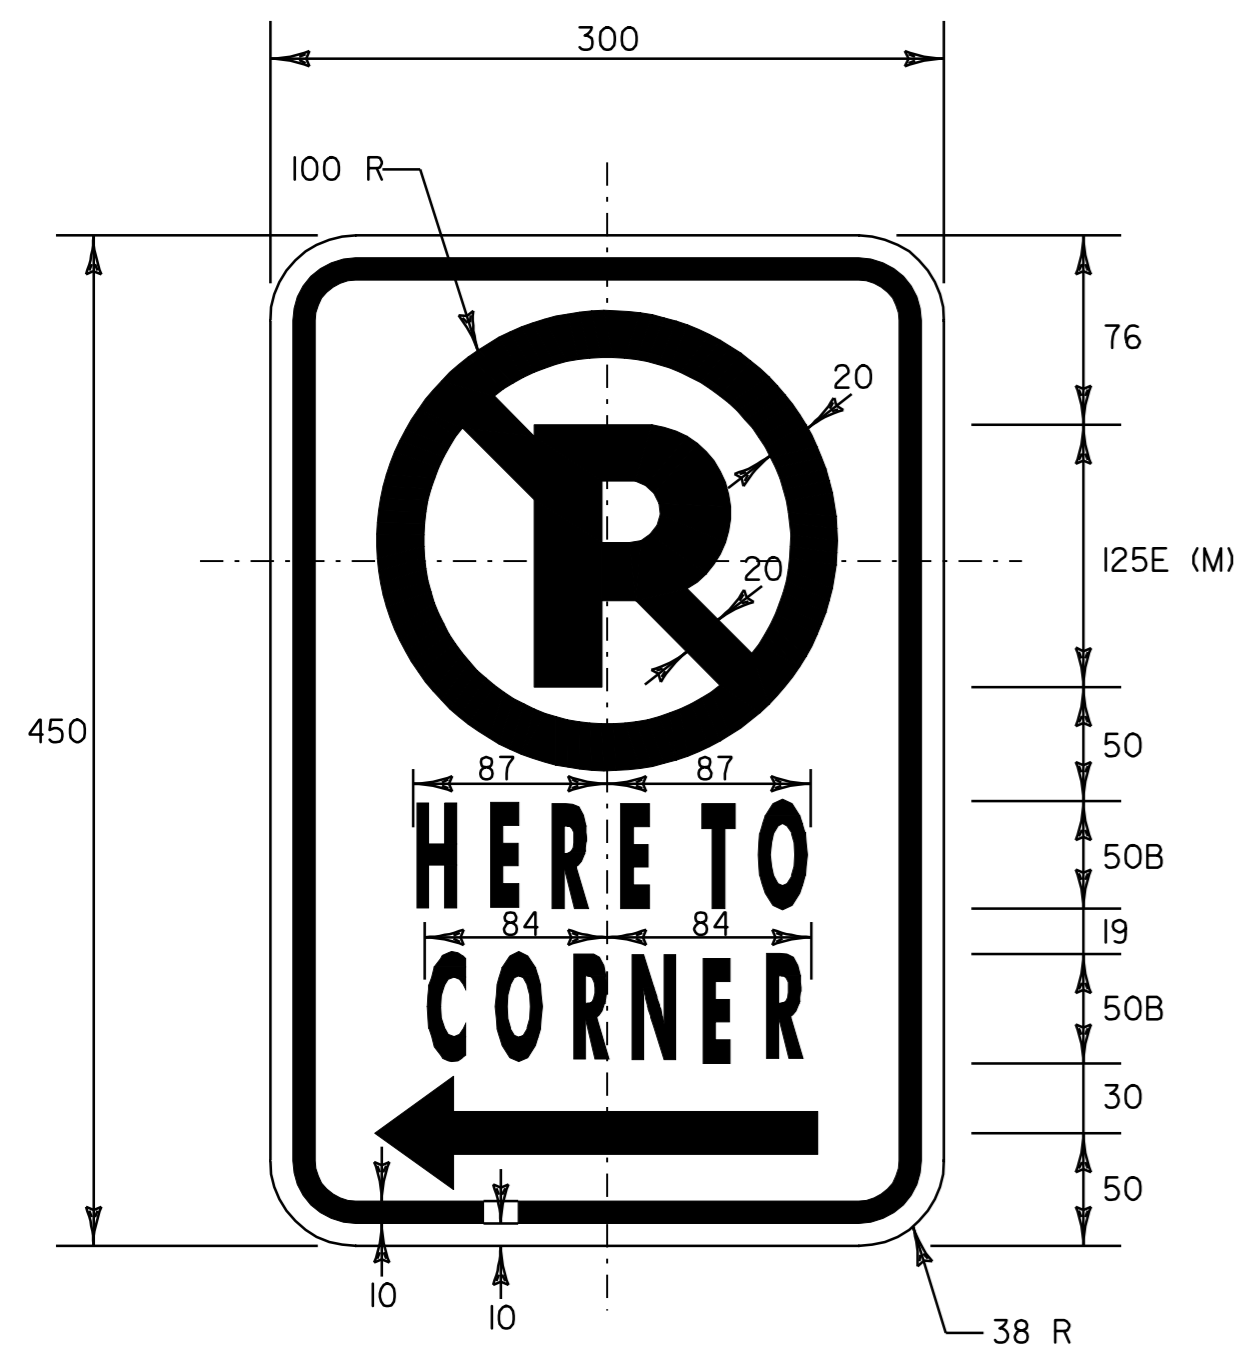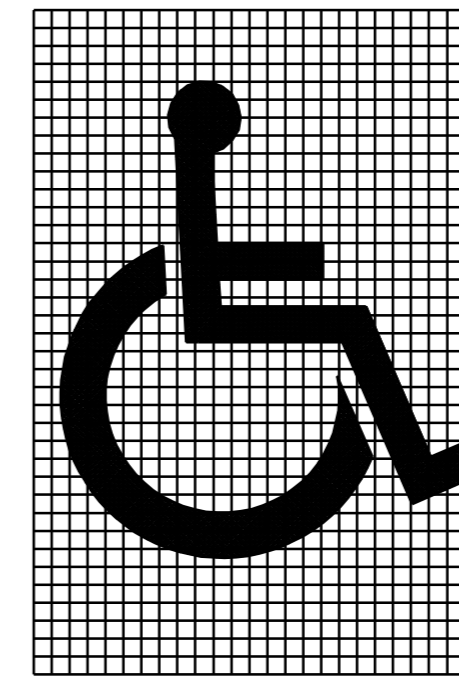

RED LEGEND, CIRCLE, DIAGONAL AND BORDER WITH WHITE (REFL.) BACKGROUND
SEE VTrans STANDARD E-143M FOR MATERIALS

LOCATIONS


- STA. 0+104.5, RT. (LEFT ARROW)
- STA. 0+550.0, RT. (RIGHT ARROW)
- STA. I+086.0, LT. (RIGHT ARROW)
- STA. I+254.8, RT. (RIGHT ARROW)
- STA. I+293.5, LT. (LEFT ARROW)
- STA. I+352.0, RT. (LEFT ARROW)
- STA. I+425.0, LT. (RIGHT ARROW)
- STA. I+565.0, RT. (RIGHT ARROW)
- STA. I+598.4, LT. (LEFT ARROW)
- STA. I+685.0, LT. (RIGHT ARROW)
- STA. I+725.6, LT. (LEFT ARROW)
- STA. 2+011.5, LT. (RIGHT ARROW)

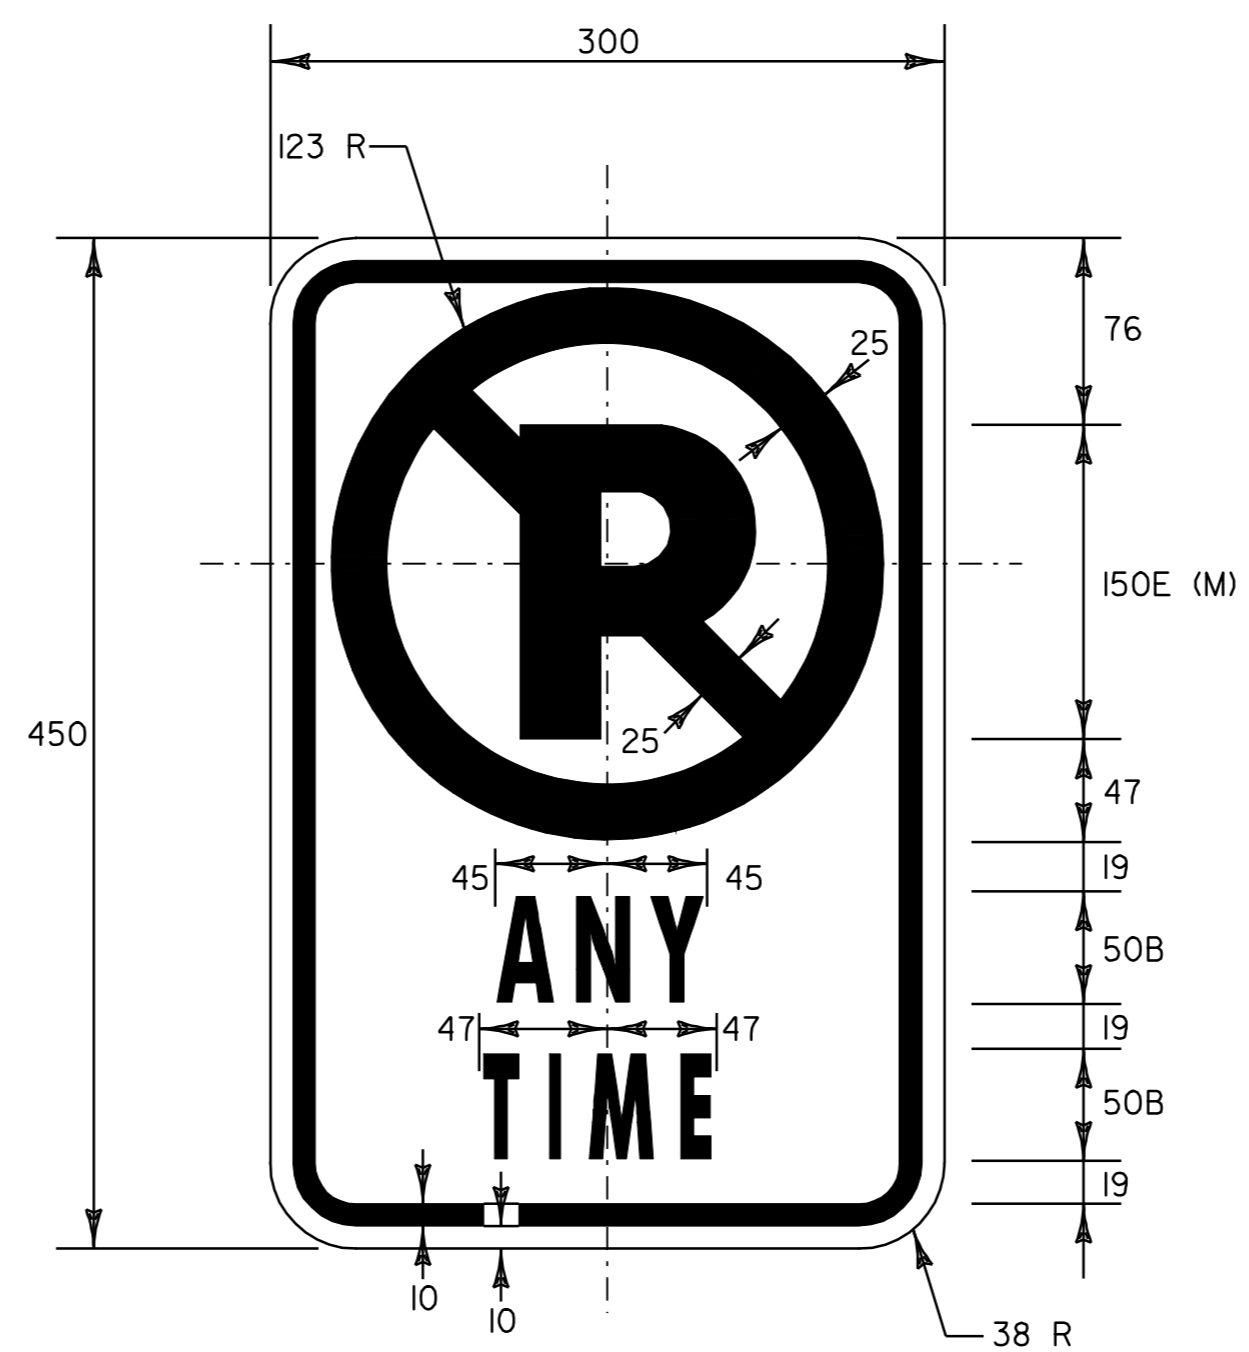

RED LEGEND, CIRCLE, DIAGONAL AND BORDER WITH WHITE (REFL.) BACKGROUND
SEE VTrans STANDARD E-143M FOR MATERIALS

LOCATIONS

- STA. I+662.0, RT.

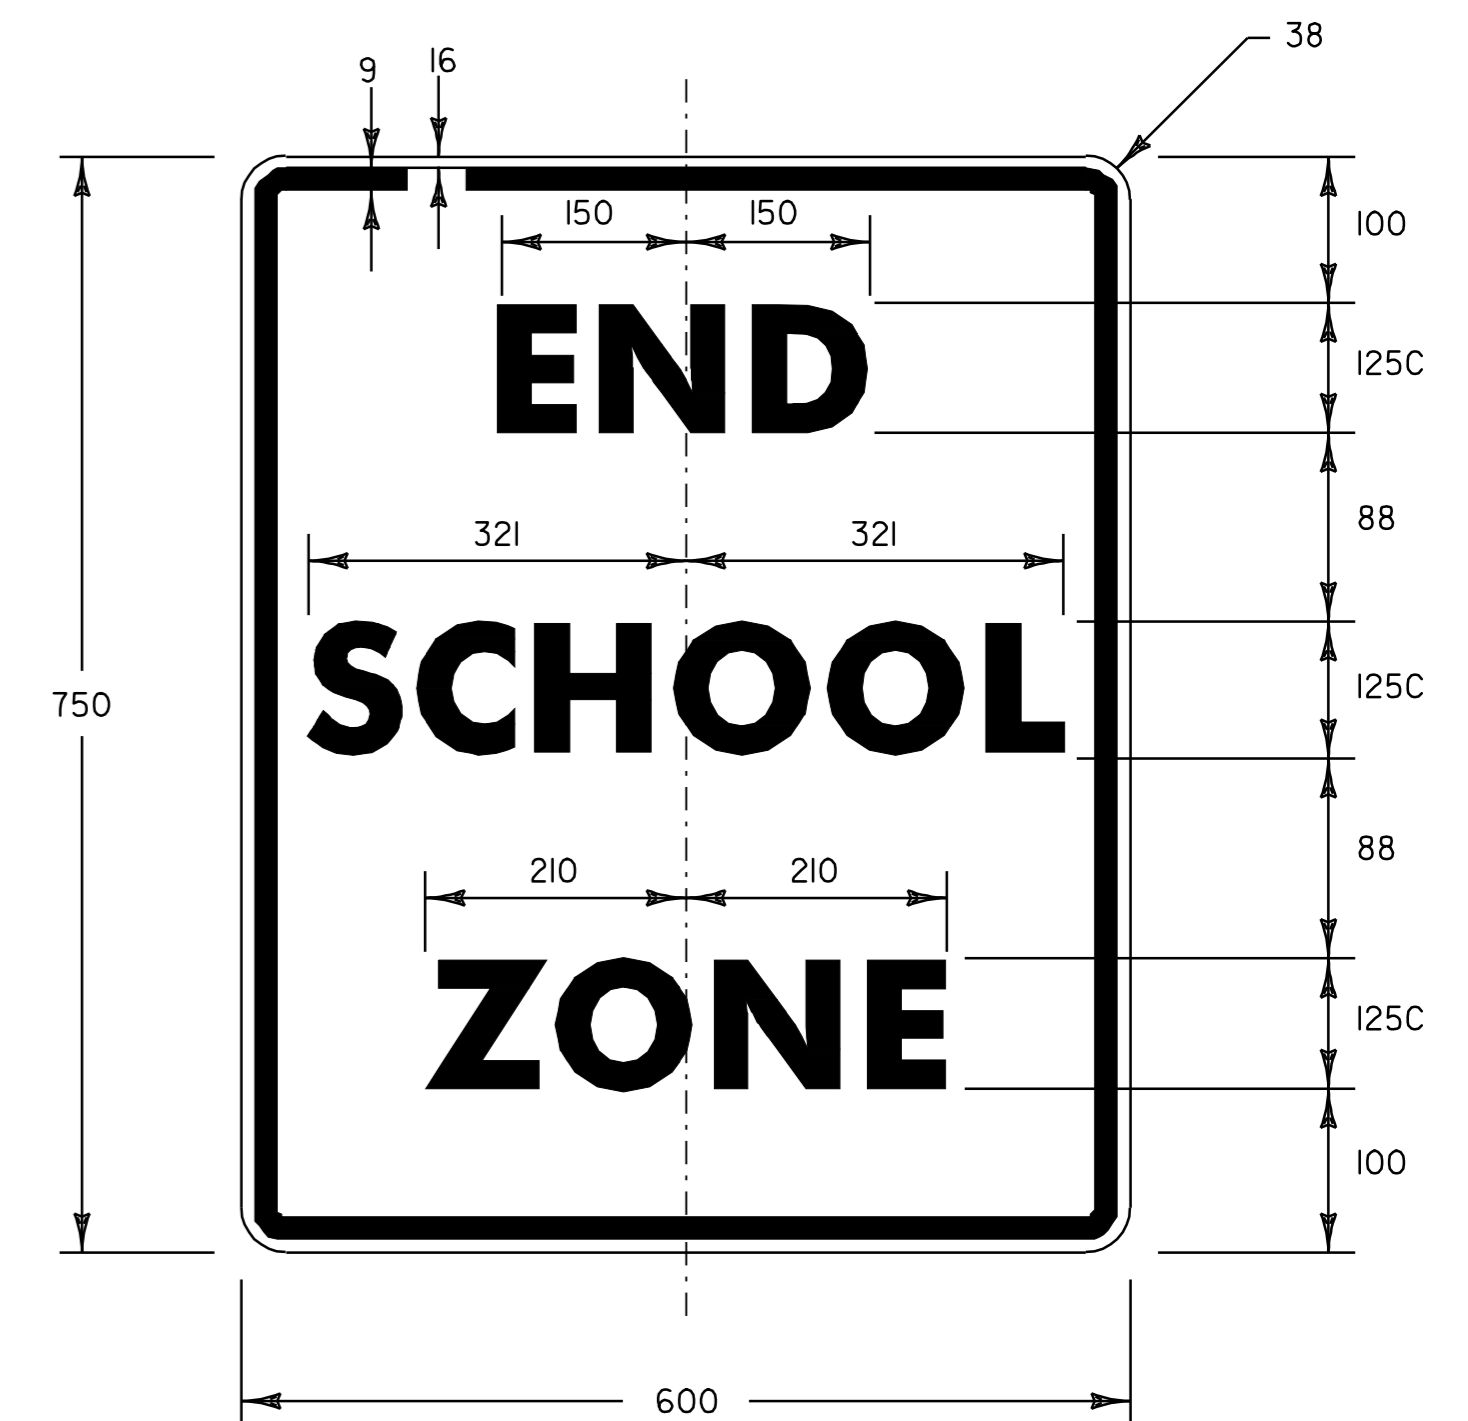

BLACK TEXT AND BORDER WITH WHITE (REFL.) BACKGROUND
SEE VTrans STANDARD E-142M FOR MATERIALS


LOCATIONS

- STA. 0+849.5, LT.
- STA. I+162.0, RT.

NOTES: 1) ALL DIMENSIONS IN MILLIMETERS EXCEPT WHERE OTHERWISE INDICATED.

TRAFFIC SIGN DETAILS	
PROJECT NAME:	ST. ALBANS CITY
PROJECT NUMBER:	STP_9804(I)S
FILE NAME:	2paxv297d1502pd150.dgn
PROJECT LEADER:	JLL
DESIGNED BY:	D-H
IPARM FILE NAME:	pd150t17.1
PLOT DATE:	01-FEB-2006 07:5
DRAWN BY:	D-H
CHECKED BY:	
SHEET	64 OF 105



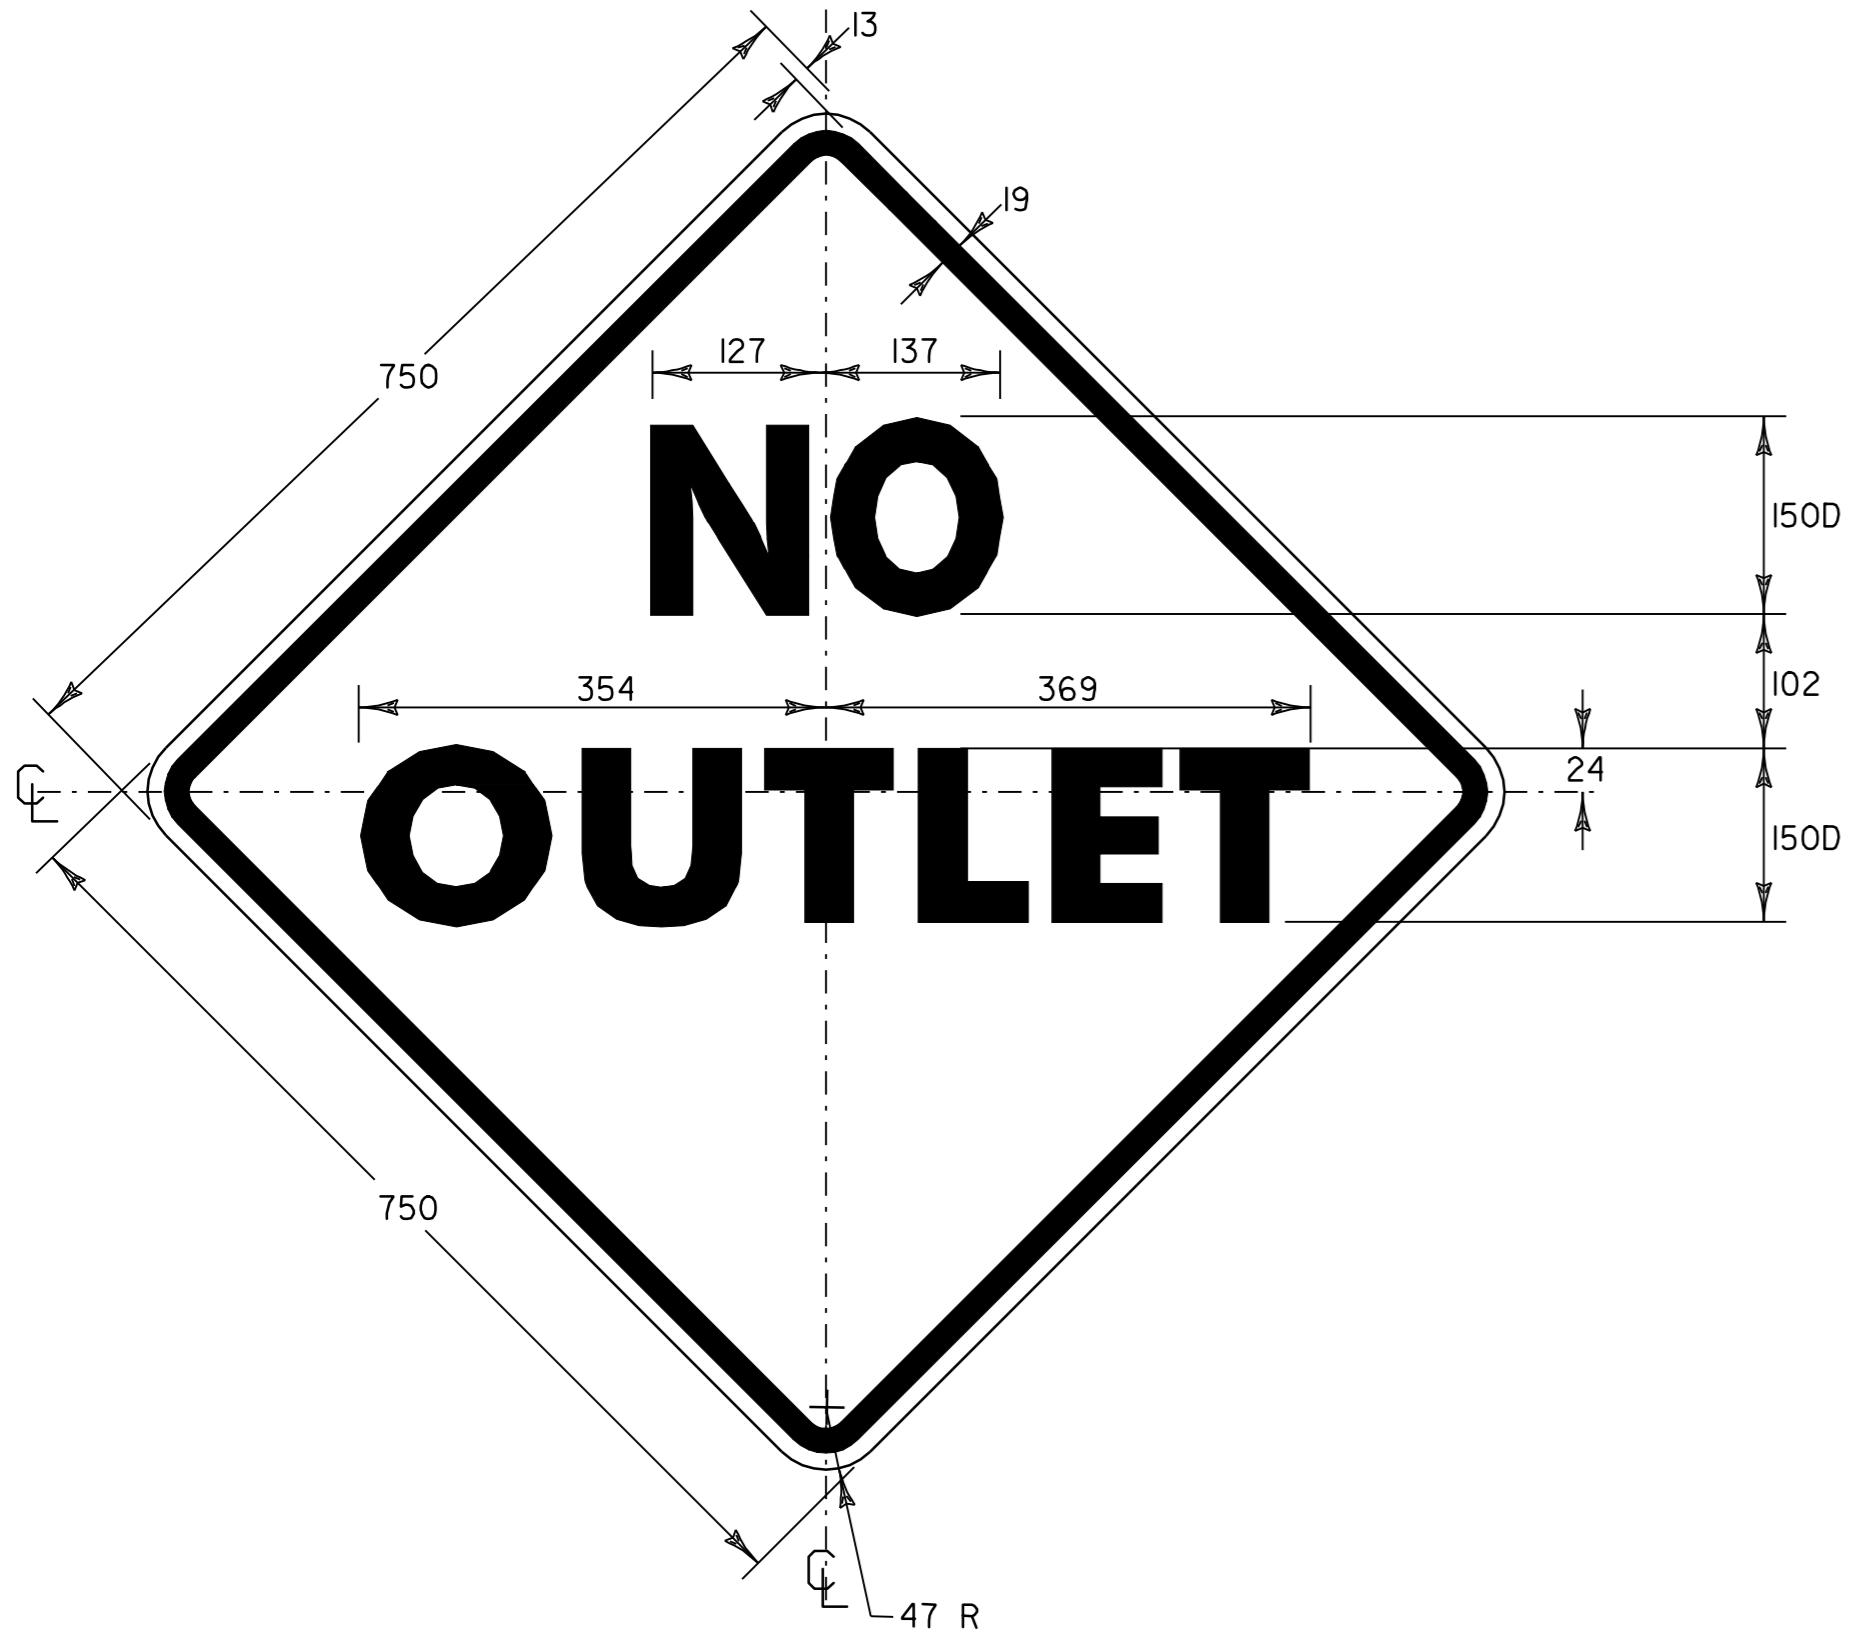


W14-2

BLACK BORDER & TEXT
WITH REFLECTORIZED YELLOW BACKGROUND
SEE VTrans STANDARD E-153M FOR MATERIALS

LOCATIONS

U.S. ROUTE 7 STA. 1+280.1, LT.
U.S. ROUTE 7 STA. 2+807.0, LT.

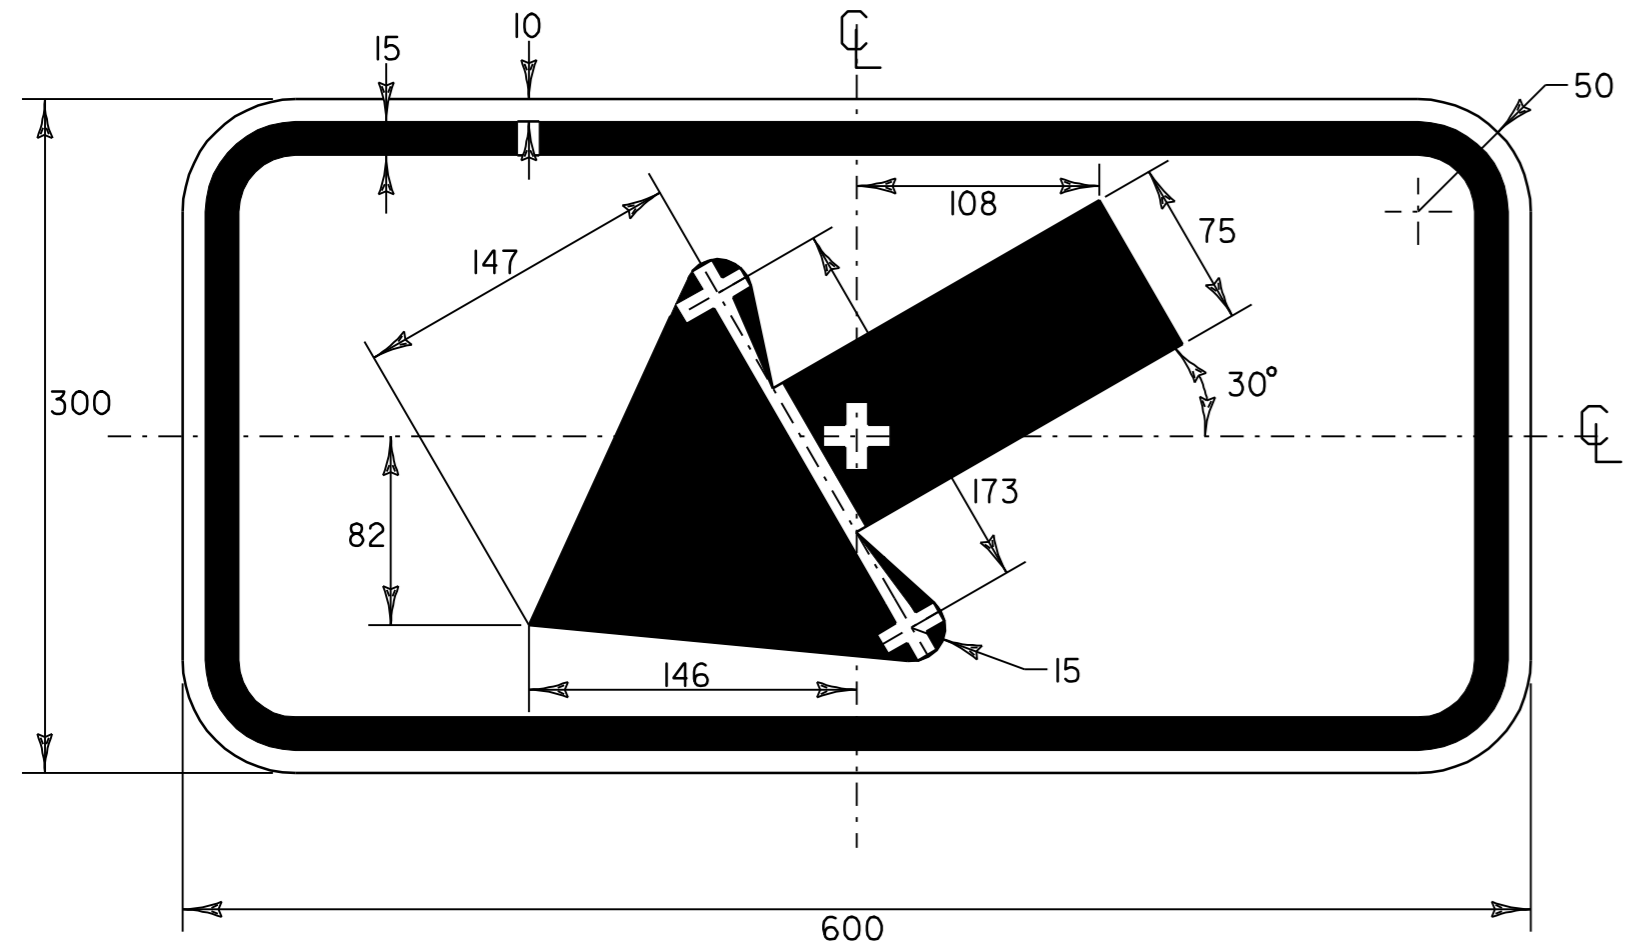


W16-7L


BLACK BORDER & SYMBOL
WITH REFLECTORIZED YELLOW BACKGROUND
SEE VTrans STANDARD E-153M FOR MATERIALS

LOCATIONS

U.S. ROUTE 7 STA. 1+028.0, RT.
U.S. ROUTE 7 STA. 1+029.0, LT.
U.S. ROUTE 7 STA. 1+225.5, RT.
U.S. ROUTE 7 STA. 1+234.2, LT.
U.S. ROUTE 7 STA. 1+717.0, RT.
U.S. ROUTE 7 STA. 1+725.6, LT.
U.S. ROUTE 7 STA. 1+755.5, RT.
U.S. ROUTE 7 STA. 1+761.5, LT.
U.S. ROUTE 7 STA. 1+819.0, RT.
U.S. ROUTE 7 STA. 1+825.5, LT. (MOUNTED ON LIGHT POLE)
U.S. ROUTE 7 STA. 2+079.5, RT.
U.S. ROUTE 7 STA. 2+082.3, LT.
U.S. ROUTE 7 STA. 2+142.0, RT.
U.S. ROUTE 7 STA. 2+142.0, LT.
U.S. ROUTE 7 STA. 2+193.0, RT.
U.S. ROUTE 7 STA. 2+193.5, LT.
U.S. ROUTE 7 STA. 2+305.2, RT.
U.S. ROUTE 7 STA. 2+305.2, LT.
U.S. ROUTE 7 STA. 3+025.0, RT.
U.S. ROUTE 7 STA. 3+034.0, RT.

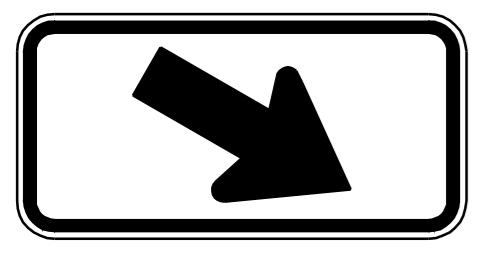

W16-7R

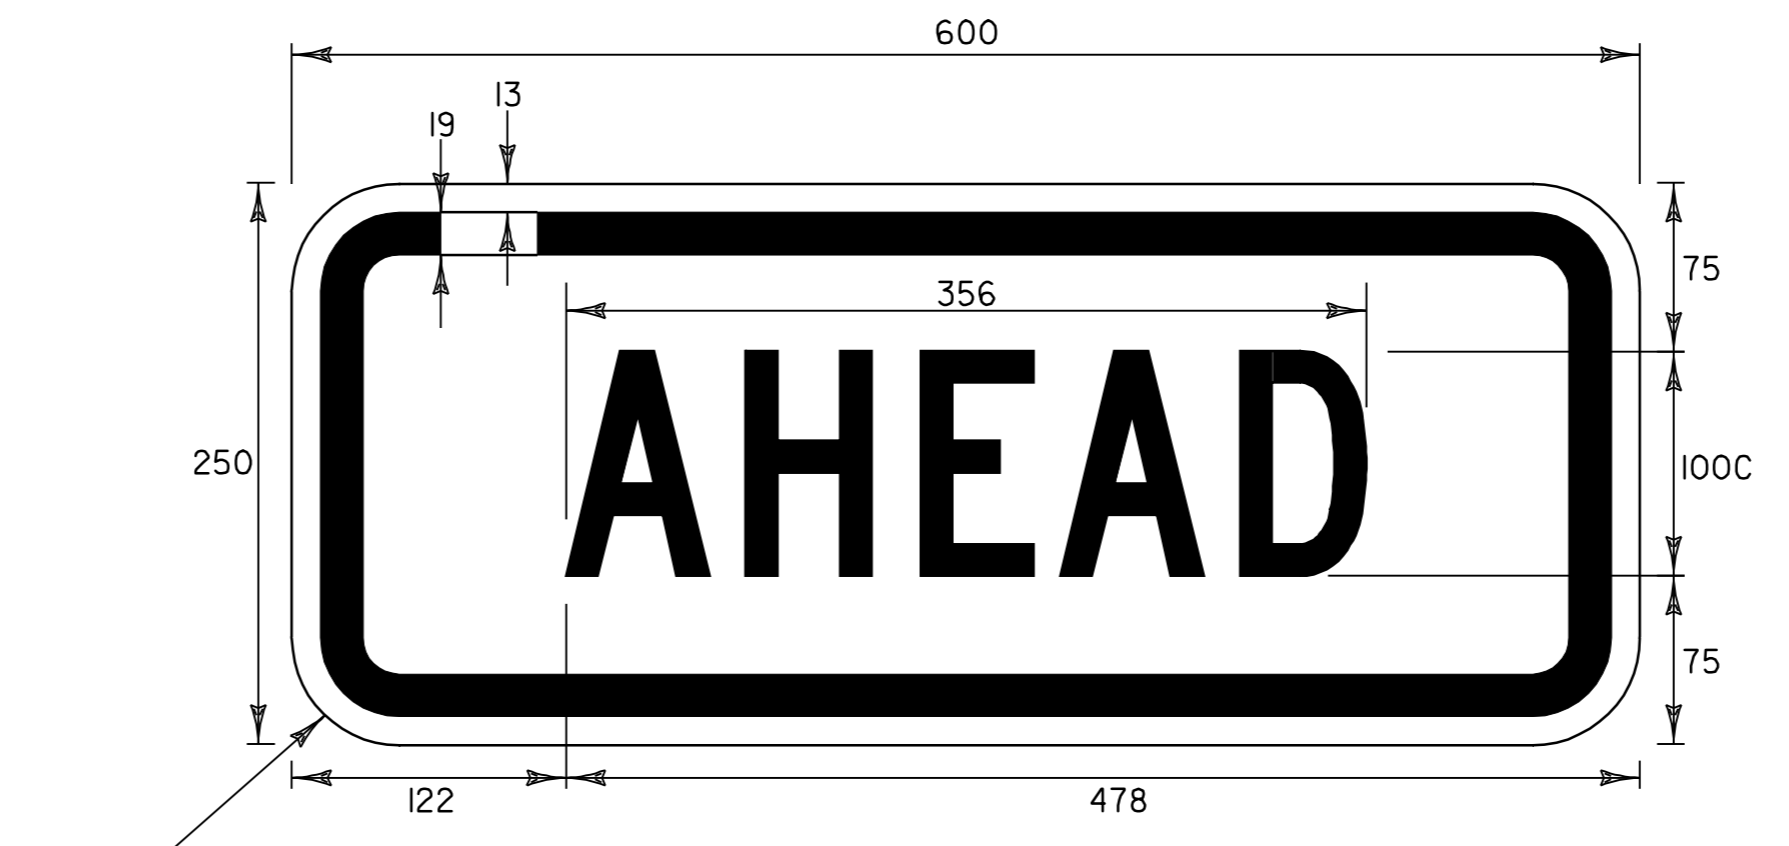


W16-9p

BLACK BORDER & TEXT
WITH REFLECTORIZED YELLOW BACKGROUND
SEE VTrans STANDARD E-153M FOR MATERIALS

LOCATIONS

U.S. ROUTE 7 STA. 0+687.0, RT.
U.S. ROUTE 7 STA. 1+255.5, LT.

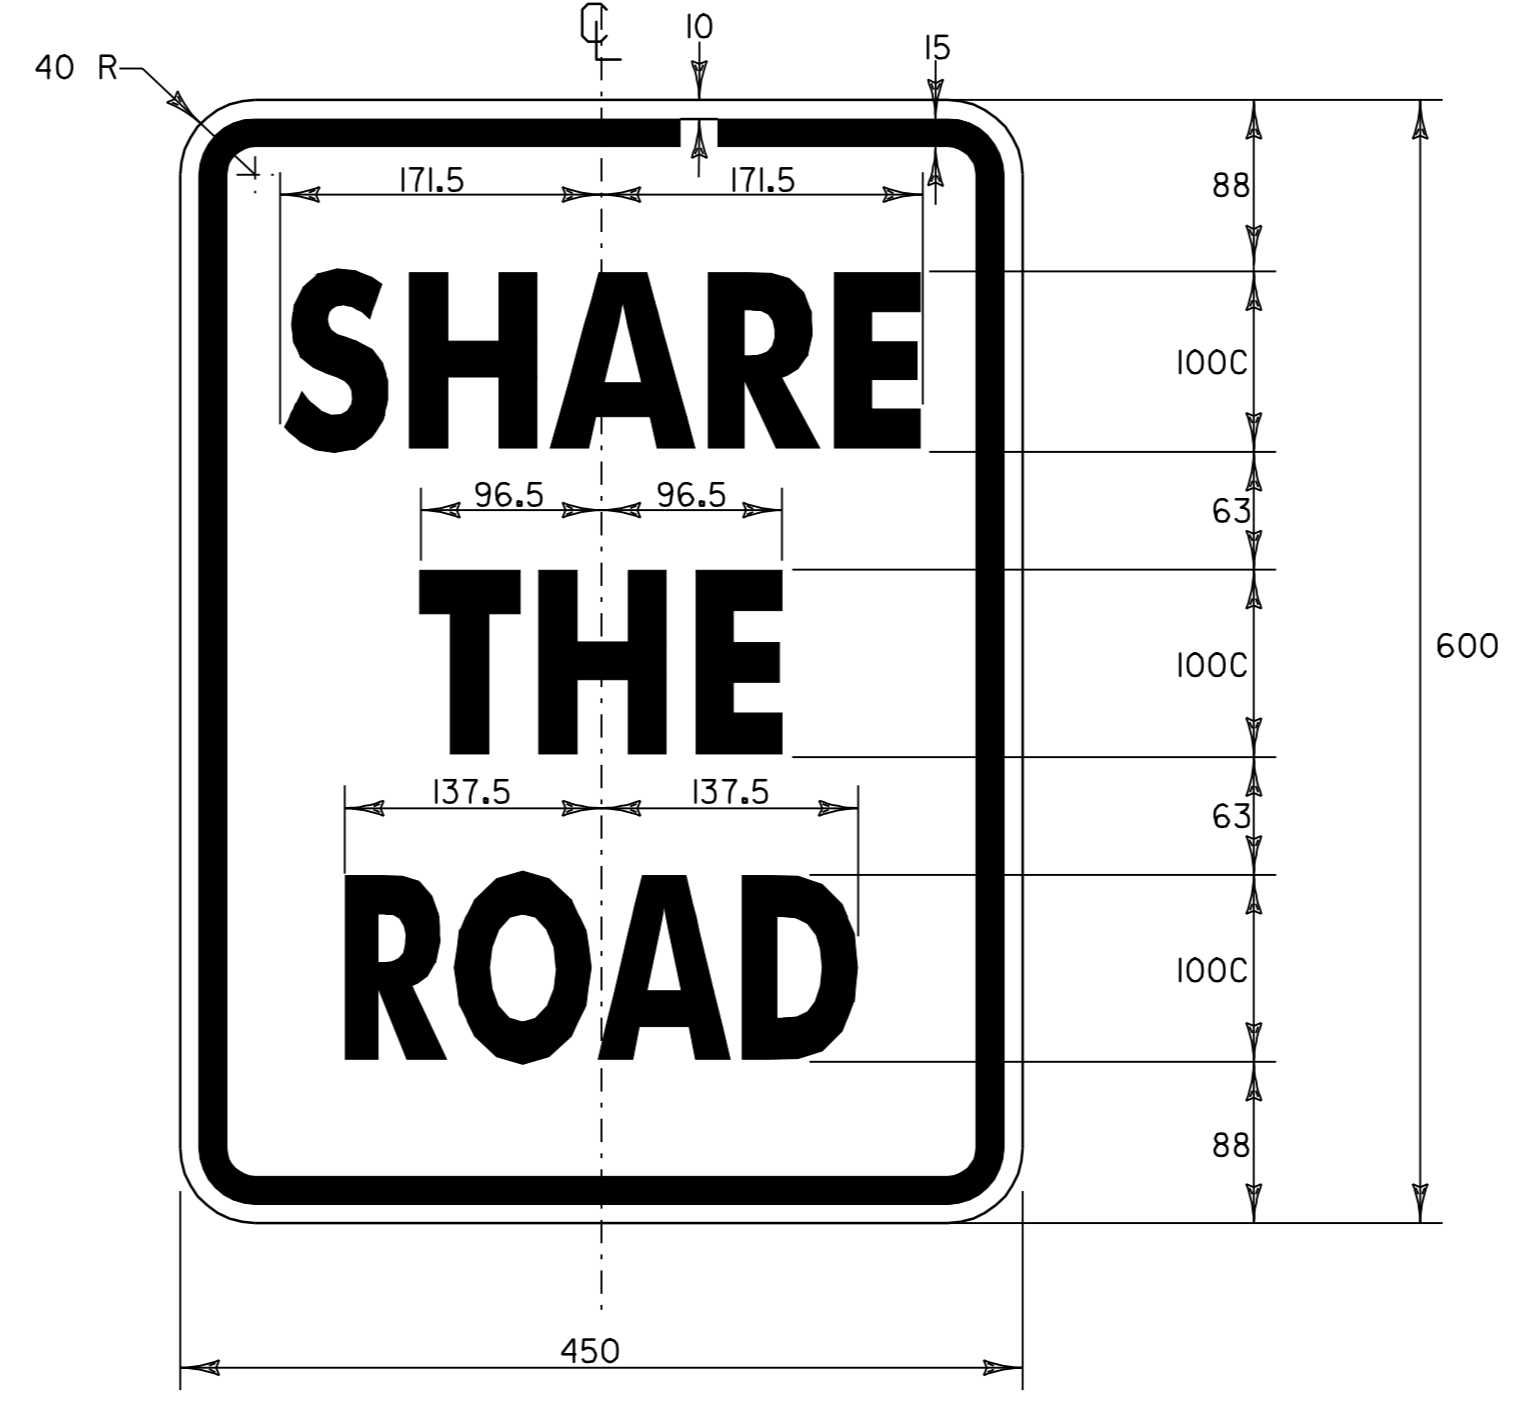


W16-1

BLACK BORDER & TEXT
WITH REFLECTORIZED WHITE BACKGROUND
SEE VTrans STANDARD E-142M FOR MATERIALS

LOCATIONS

U.S. ROUTE 7 STA. 2+972.0, LT.
U.S. ROUTE 7 STA. 3+525.0, RT.

NOTES: 1) ALL DIMENSIONS IN MILLIMETERS
EXCEPT WHERE OTHERWISE INDICATED.

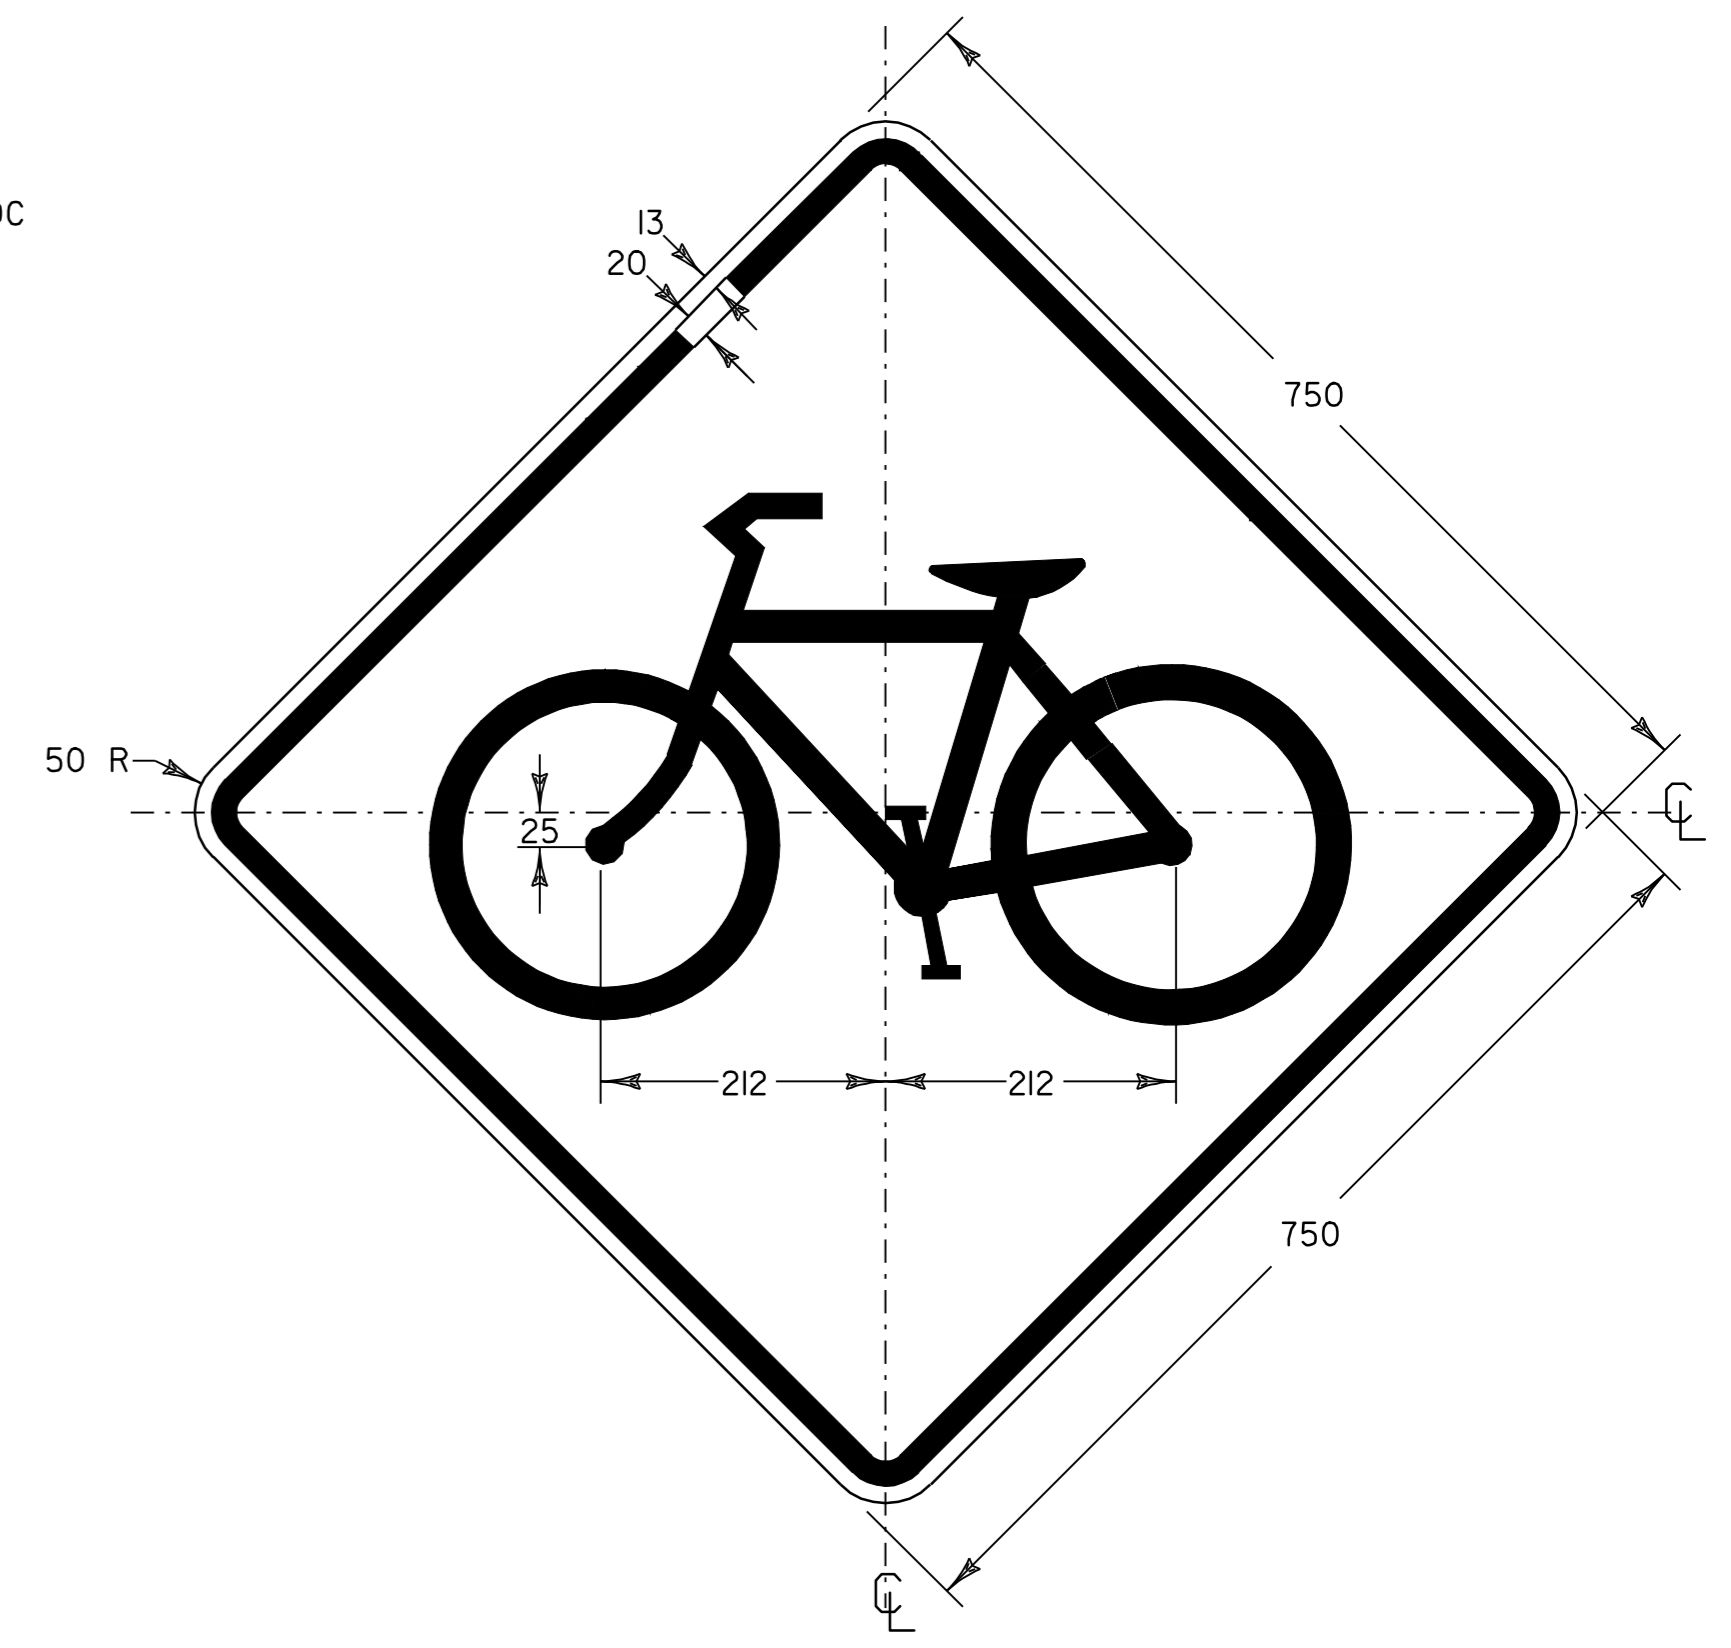


W11-1

BLACK BORDER & SYMBOL
WITH REFLECTORIZED YELLOW BACKGROUND
SEE VTrans STANDARD E-151M FOR MATERIALS

LOCATIONS

U.S. ROUTE 7 STA. 2+972.0, LT.
U.S. ROUTE 7 STA. 3+525.0, RT.

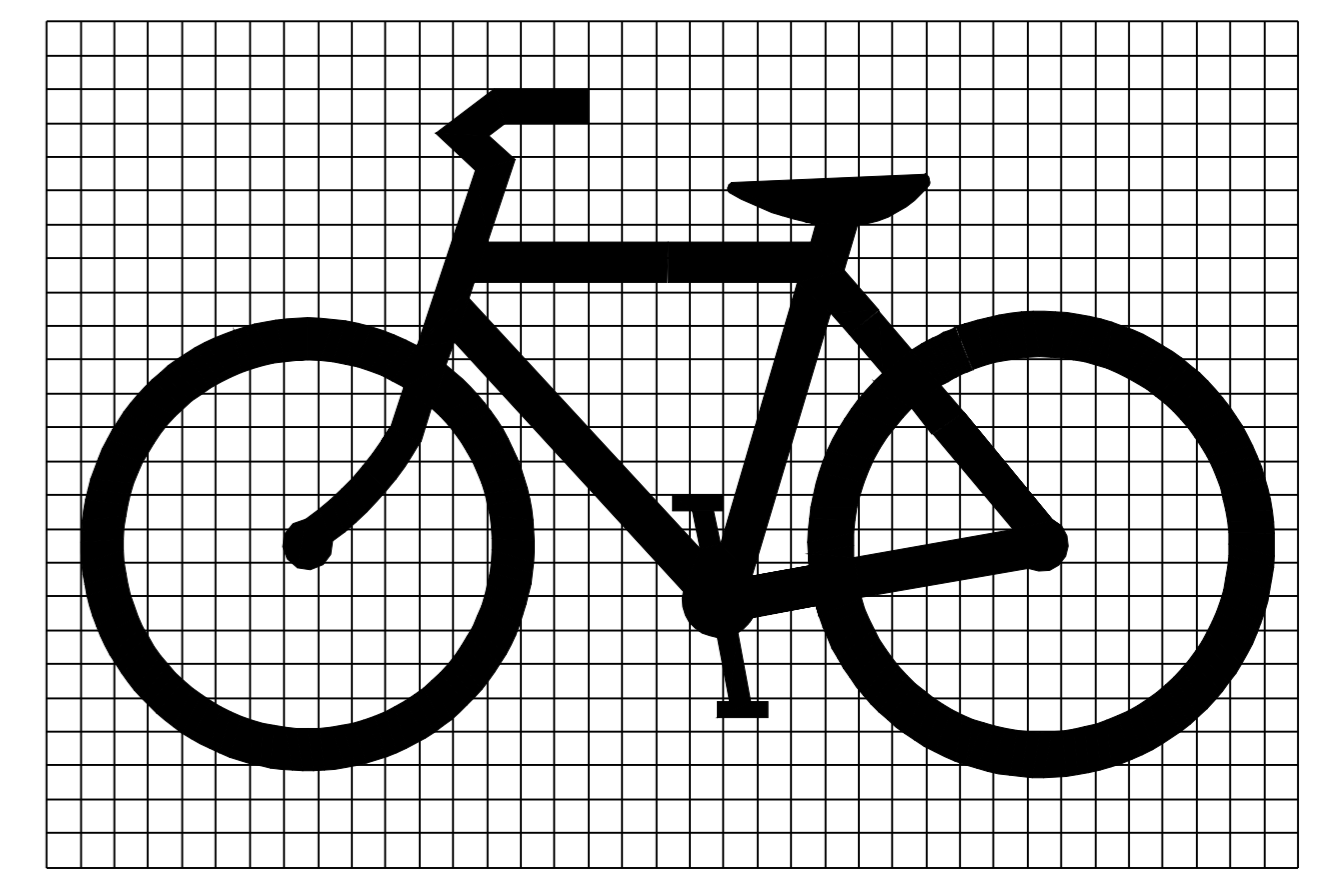


1 SQUARE = 25 mm


**TRAFFIC SIGN
DETAILS**

PROJECT NAME:	ST. ALBANS CITY	PLOT DATE:	01-FEB-2006 07:4
PROJECT NUMBER:	STP_9804(1)S	DRAWN BY:	D-H
FILE NAME:	Z:\pave\97\d150\d150.dgn	DESIGNED BY:	D-H
PROJECT LEADER:	JLL	CHECKED BY:	
IPARM FILE NAME:	d150t18.1	SHEET	65 OF 105



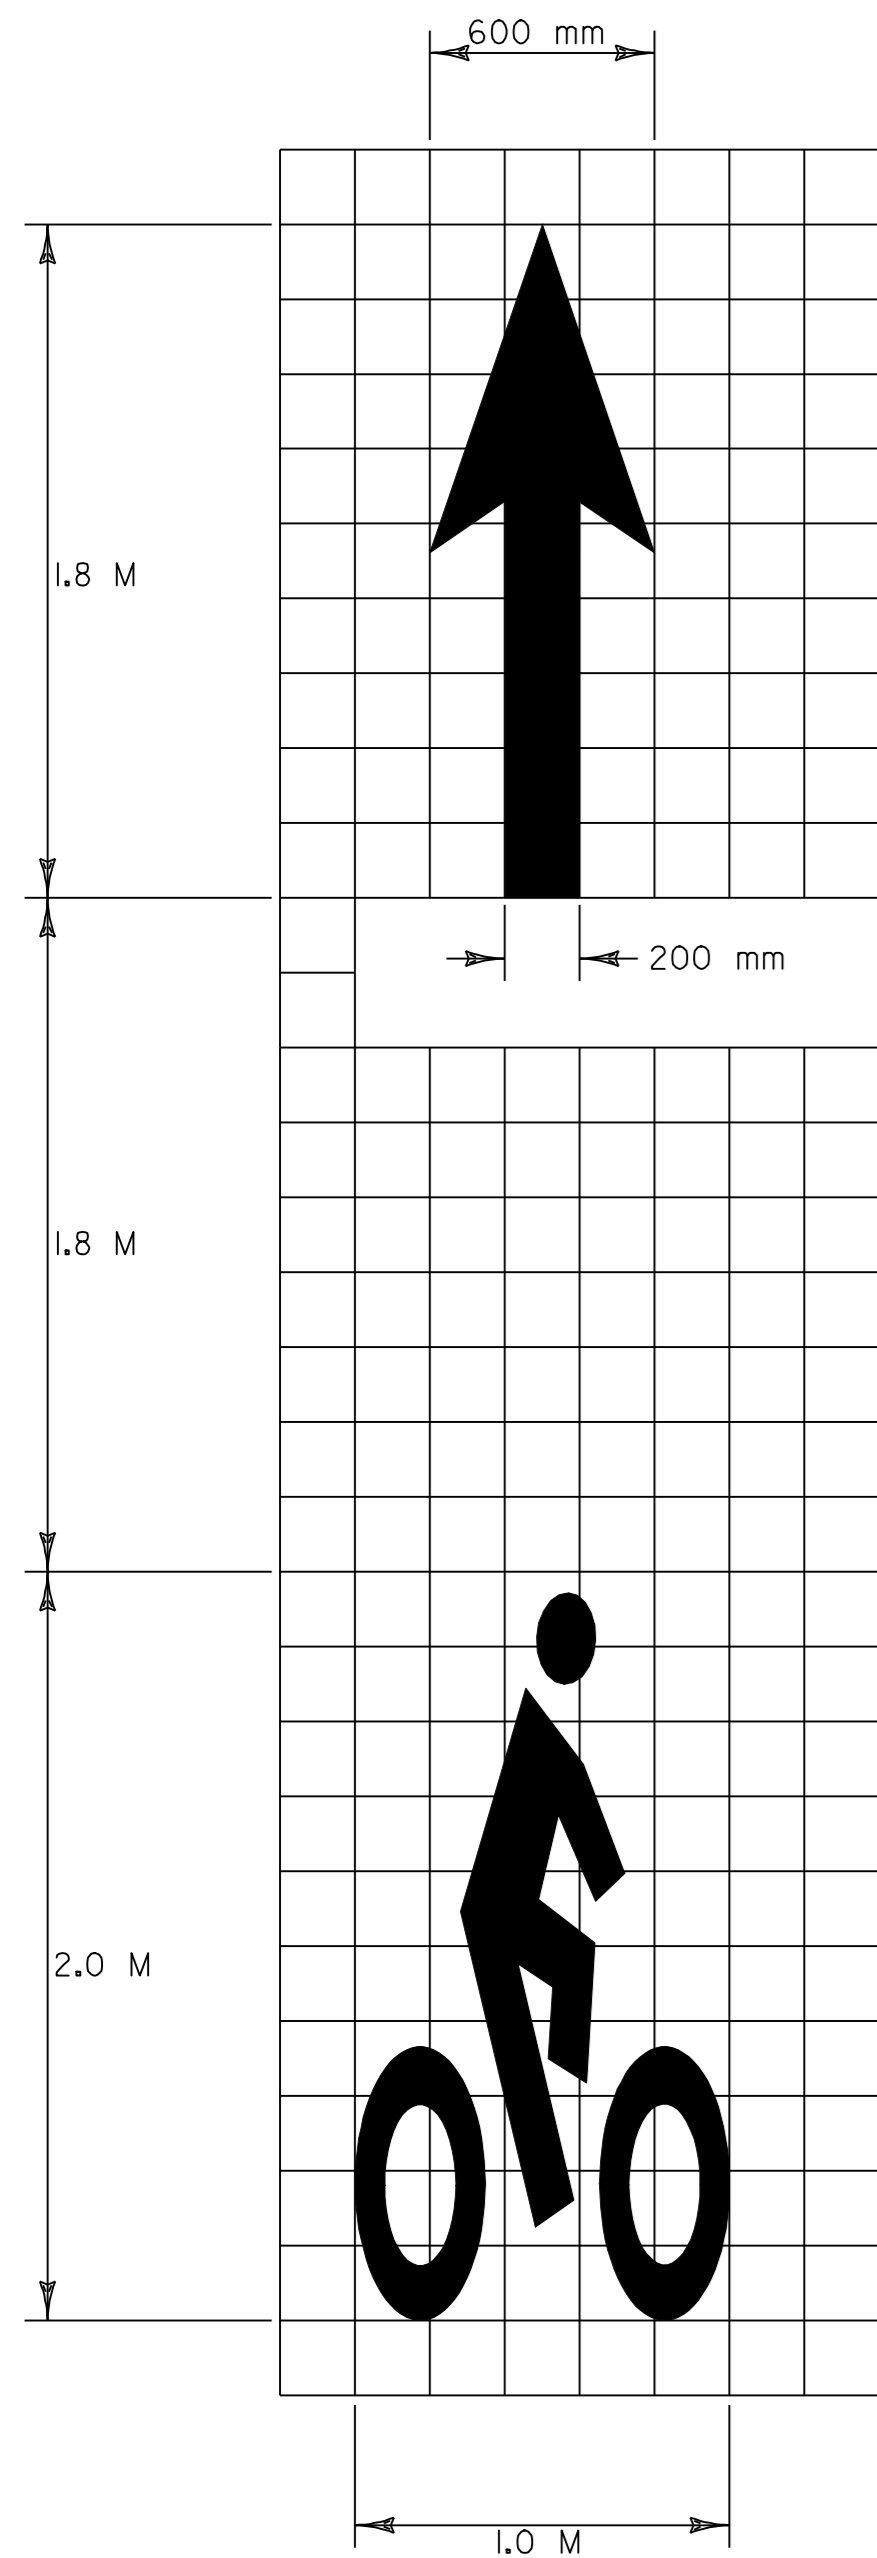

BICYCLE LANE PAVEMENT MARKING DETAIL
SEE LAYOUT SHEETS FOR LOCATIONS

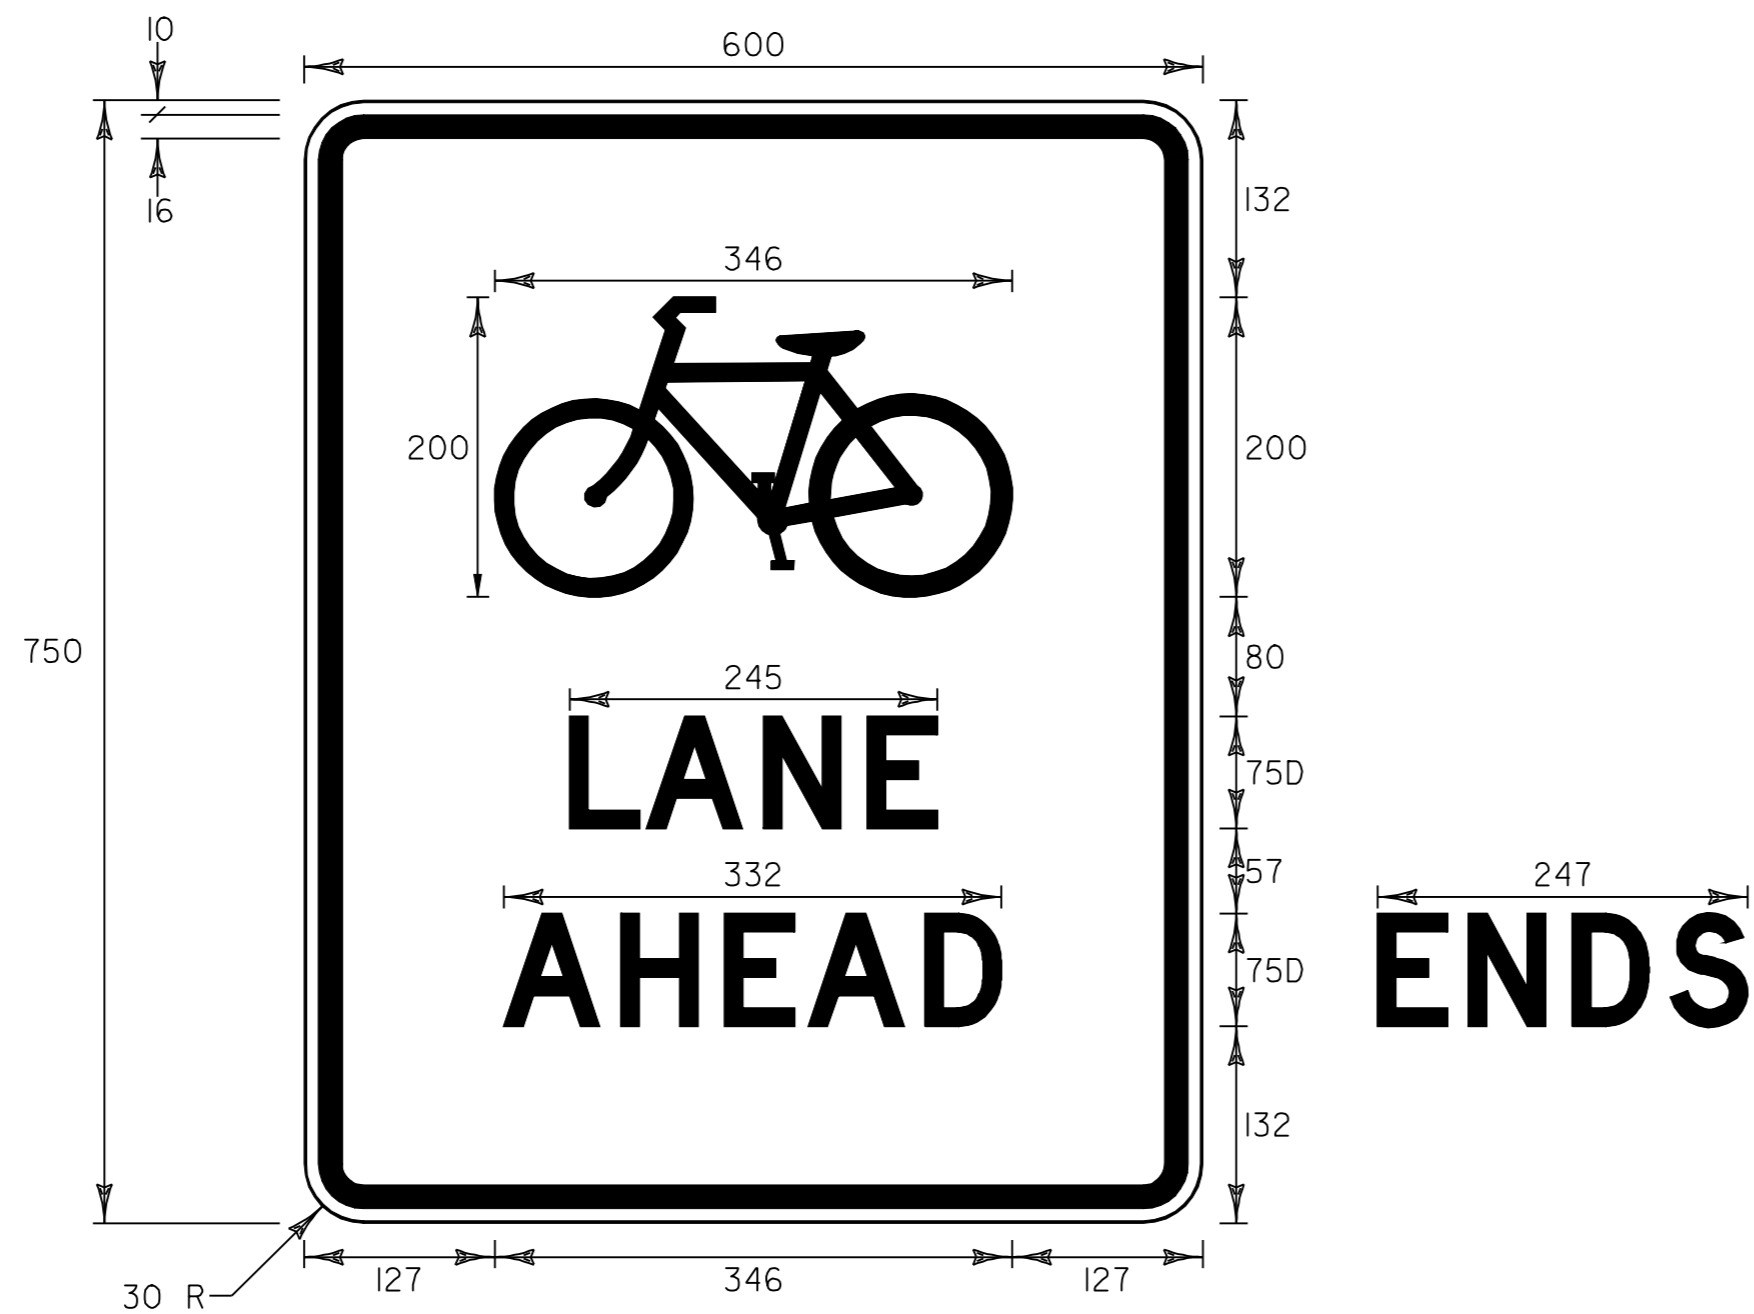


R3-16 & R3-16a


BLACK TEXT, SYMBOL & BORDER
WITH REFLECTORIZED WHITE BACKGROUND
SEE VTrans STANDARD E-142M FOR MATERIALS

LOCATIONS

- U.S. ROUTE 7 ST. ALBANS STA. 3+010.0, RT. "AHEAD"
- U.S. ROUTE 7 ST. ALBANS STA. 3+020.0, LT. "ENDS"
- U.S. ROUTE 7 ST. ALBANS STA. 3+500.0, RT. "ENDS"
- U.S. ROUTE 7 ST. ALBANS STA. 3+575.0, LT. "AHEAD"

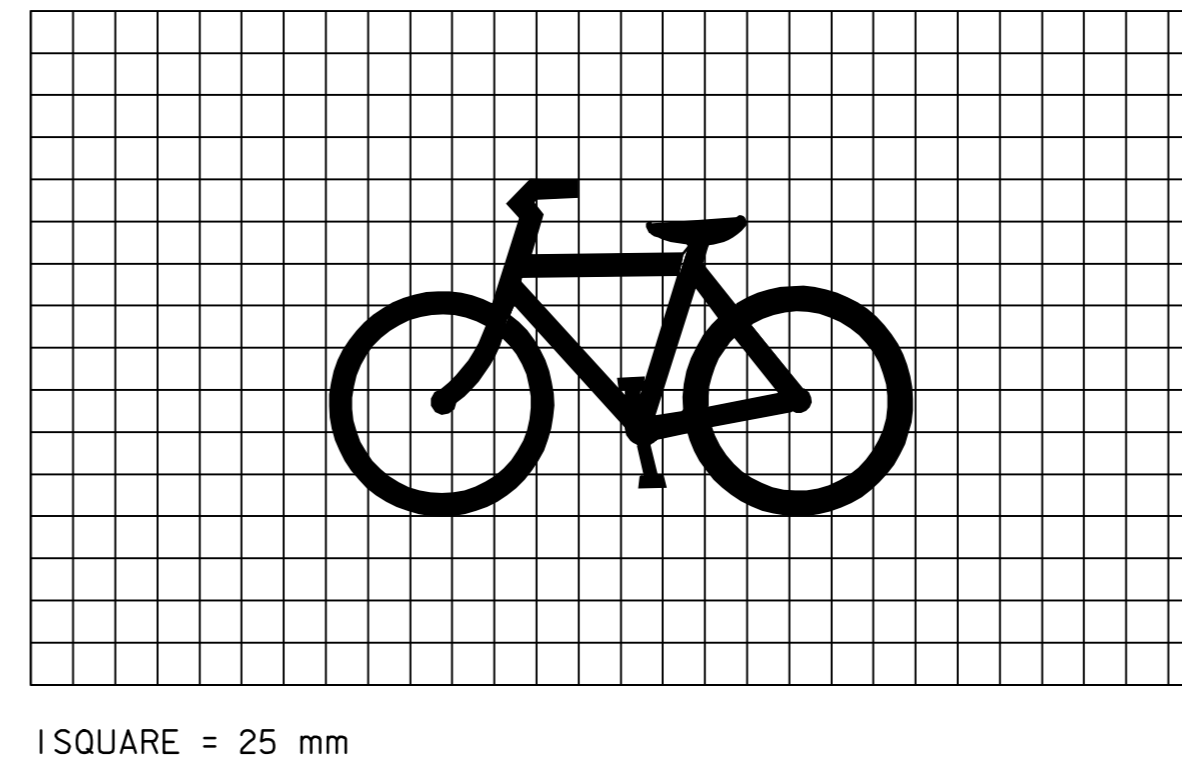

1 SQUARE = 25 mm

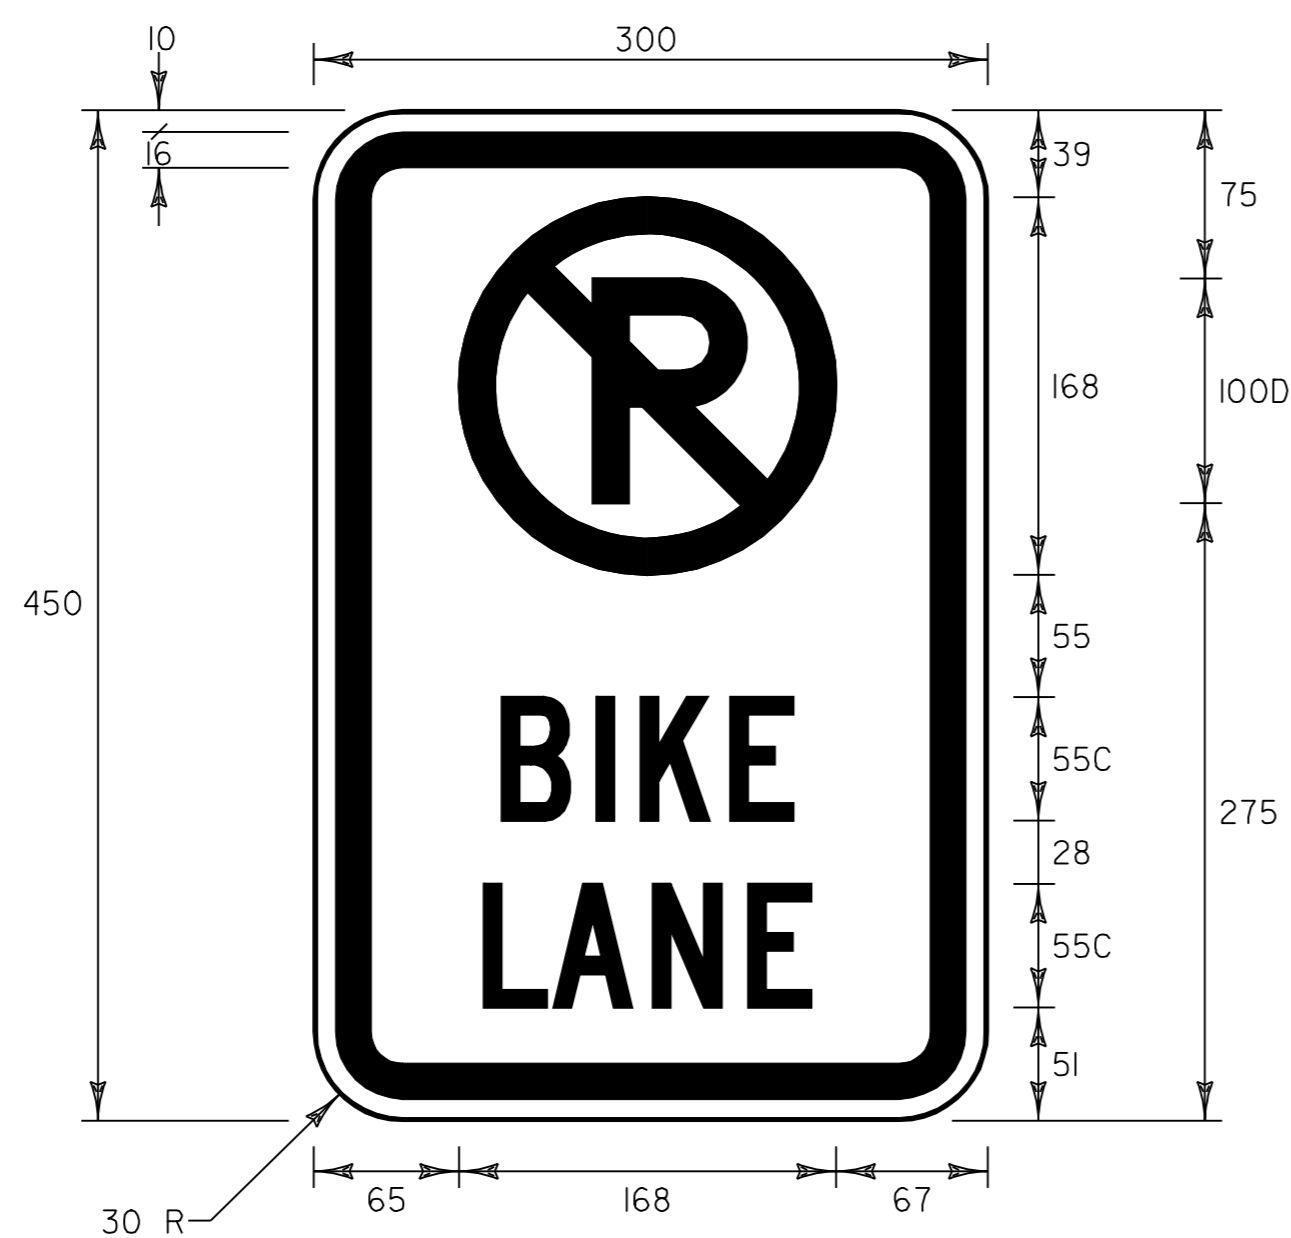

R7-9a

RED LEGEND, CIRCLE, & DIAGONAL
BLACK LETTER 'P' & BORDER
WITH REFLECTORIZED WHITE BACKGROUND
SEE VTrans STANDARD E-143M FOR MATERIALS

LOCATIONS

- U.S. ROUTE 7 ST. ALBANS STA. 3+040.8, RT.
- U.S. ROUTE 7 ST. ALBANS STA. 3+10.0, LT.
- U.S. ROUTE 7 ST. ALBANS STA. 3+120.0, RT.
- U.S. ROUTE 7 ST. ALBANS STA. 3+230.0, RT.
- U.S. ROUTE 7 ST. ALBANS STA. 3+300.0, LT.
- U.S. ROUTE 7 ST. ALBANS STA. 3+386.0, LT.
- U.S. ROUTE 7 ST. ALBANS STA. 3+463.0, RT.
- U.S. ROUTE 7 ST. ALBANS STA. 3+540.0, LT.



R3-17

BLACK TEXT, SYMBOL & BORDER
WITH REFLECTORIZED WHITE BACKGROUND
SEE VTrans STANDARD E-142M FOR MATERIALS

LOCATIONS

- U.S. ROUTE 7 ST. ALBANS STA. 3+040.8, RT.
- U.S. ROUTE 7 ST. ALBANS STA. 3+10.0, LT.
- U.S. ROUTE 7 ST. ALBANS STA. 3+120.0, RT.
- U.S. ROUTE 7 ST. ALBANS STA. 3+230.0, RT.
- U.S. ROUTE 7 ST. ALBANS STA. 3+300.0, LT.
- U.S. ROUTE 7 ST. ALBANS STA. 3+463.0, RT.
- U.S. ROUTE 7 ST. ALBANS STA. 3+540.0, LT.

NOTES: 1) ALL DIMENSIONS IN MILLIMETERS
EXCEPT WHERE OTHERWISE INDICATED.

**BICYCLE LANE
SIGNS &
PAVEMENT
MARKING
DETAILS**

PROJECT NAME:	ST. ALBANS CITY
PROJECT NUMBER:	STP_9804(1)S
FILE NAME:	zpqve297d150zpd150.dgn
PROJECT LEADER:	JLL
DESIGNED BY:	D-H
IPARM FILE NAME:	pd150t19.i
PLOT DATE:	01-FEB-2006 07:5
DRAWN BY:	D-H
CHECKED BY:	
SHEET	66 OF 105

REHABILITATION OF DI'S, CB'S OR MH'S, CLASS I


(ITEM 604.412)

NOTE: ITEMS 204.21, 501.25, 507.15, AND 604.47 ARE INCLUDED FOR USE AS DIRECTED BY THE RESIDENT ENGINEER AT THOSE LOCATIONS WHERE STRUCTURE REHABILITATION IS BEYOND THAT AS SPECIFIED UNDER ITEM 604.412.

STATION	POSITION	DESCRIPTION
U.S. ROUTE 7		
0+000.0	RT	DI
0+028.7	LT & RT	DI
0+112.0	LT & RT	DI
0+121.0	RT	DI
0+201.5	LT & RT	DI
0+292.0	LT & RT	DI
0+321.5	RT	DI
0+428.0	RT	DI
0+431.5	LT	DI
0+503.0	LT & RT	DI
0+546.0	LT & RT	DI
0+623.1	RT	DI
0+628.0	LT	DI
0+686.0	LT & RT	DI
0+824.0	LT & RT	DI
0+918.0	RT	DI
0+919.5	LT	DI
I+013.5	LT & RT	DI
I+090.0	LT & RT	DI
I+142.5	LT	DI
I+157.5	RT	DI
I+160.0	LT	DI
I+212.0	LT & RT	DI
I+242.0	RT	DI
I+287.0	LT & RT	DI
I+354.0	LT & RT	DI
I+444.0	RT	DI
I+448.0	LT	DI
I+511.5	LT & RT	DI
I+548.0	RT	DI
I+603.0	LT & RT	DI
I+680.5	RT	ROUND DI
I+726.0	RT	DI

STATION	POSITION	DESCRIPTION
U.S. ROUTE 7		
I+789.0	LT & RT	DI
I+816.0	RT	DI
I+853.0	RT	DI
I+893.0	LT & RT	DI
I+932.0	LT	DI
I+943.0	RT	DI
I+950.0	LT	DI
I+974.0	RT	DI
I+991.0	RT	DI
2+009.0	LT	DI
2+023.5	RT	DI
2+024.5	LT	DI
2+090.0	LT	DI
2+091.0	RT	DI
2+148.5	RT	DI
2+165.0	LT	DI
2+180.0	RT	DI
2+189.0	RT	DI
2+200.0	RT	DI
2+216.0	LT	DI
2+288.0	RT	DI
2+293.0	RT	(2) DI
2+302.0	RT	(2) DI
2+311.0	RT	DI
2+314.0	LT	DI
2+329.5	LT	DI
2+372.0	RT	DI
2+378.0	LT	DI
2+386.0	LT	DI
2+446.0	LT	DI
2+482.0	LT	DI
2+483.0	RT	DI
2+487.0	LT	DI

STATION	POSITION	DESCRIPTION
U.S. ROUTE 7		
2+577.0	LT	DI
2+591.0	RT	DI
2+627.0	RT	DI
2+633.0	LT	DI
2+639.5	LT & RT	DI
2+704.5	RT	DI
2+720.0	LT	DI
2+776.0	RT	ROUND DI
2+806.0	RT	DI
2+812.5	LT	DI
2+880.0	LT & RT	DI
2+899.0	RT	DI
2+923.5	LT	DI
2+944.0	RT	DI
2+972.5	RT	DI
2+992.0	LT	DI
3+020.0	RT	DI
3+033.5	RT	ROUND DI
3+034.0	RT	DI
3+082.0	RT	DI
3+111.5	RT	DI
3+115.0	LT	DI
3+156.5	RT	DI
3+238.0	LT	DI
3+254.0	RT	DI
3+307.0	RT	DI
3+323.0	RT	DI
3+393.0	RT	DI
3+438.0	RT	DI
3+452.0	RT	DI
3+454.0	LT	DI
3+585.0	RT	DI

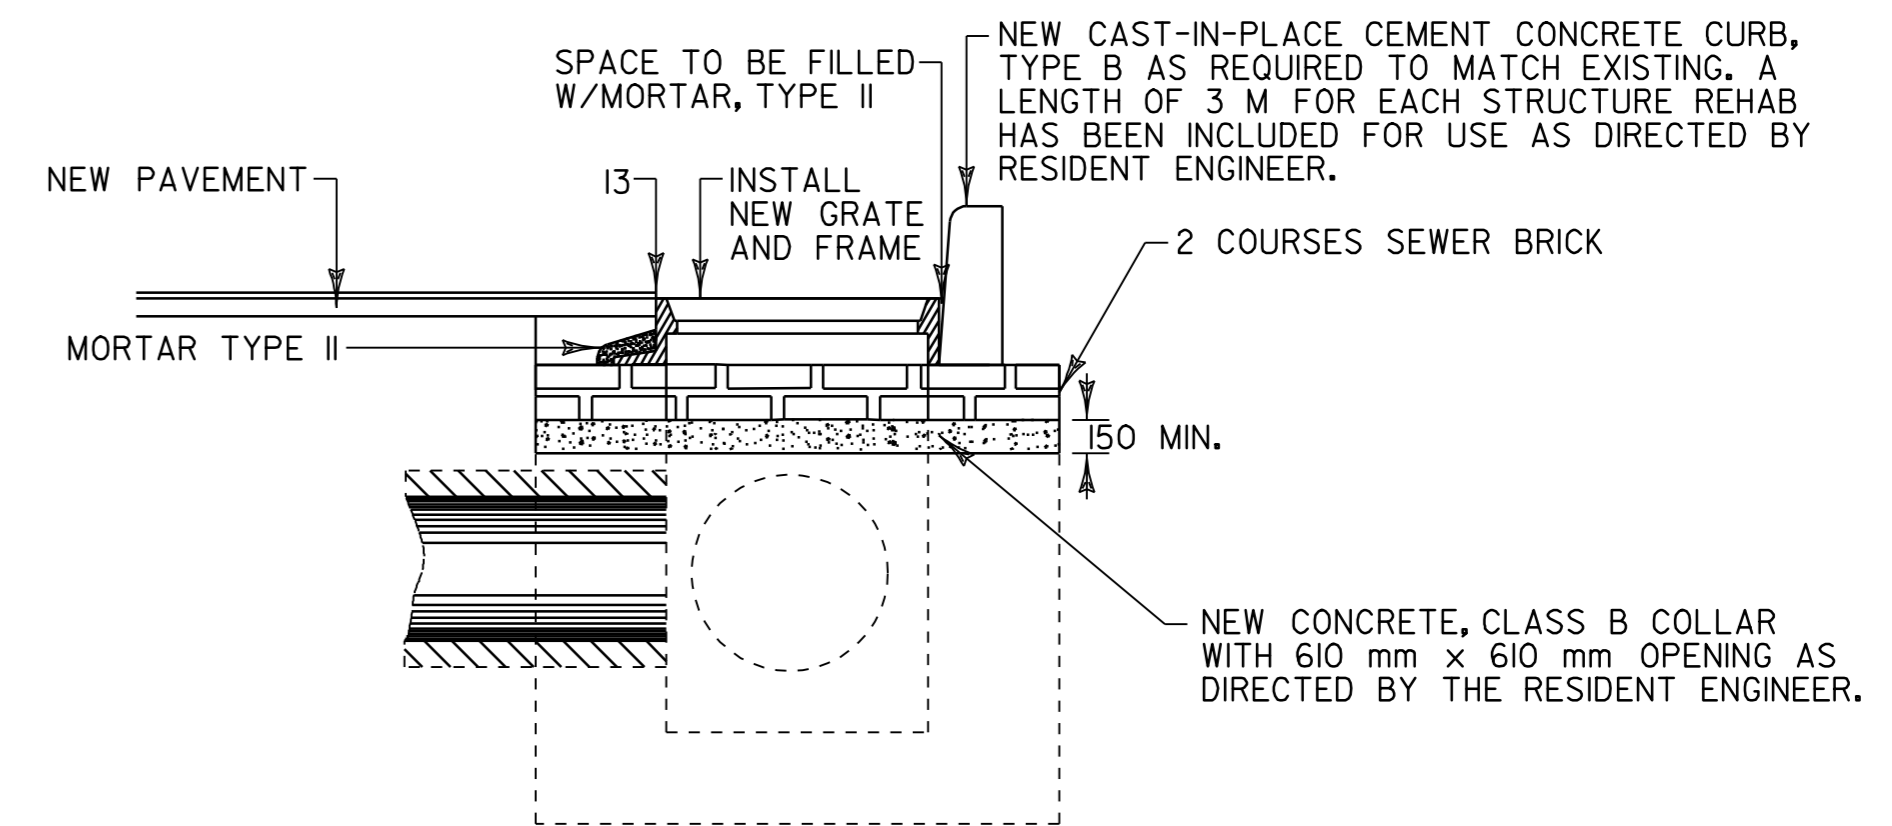

NEW D.I. TOP PLACEMENT FOR USE IN REHABILITATION OF DI'S, CB'S OR MH'S

ADJUST ELEVATION OF VALVE BOX

(ITEM 629.20)

STATION	POSITION	DESCRIPTION
U.S. ROUTE 7		
0+242.0	LT	(2) WSO
0+244.0	LT	WSO
0+307.0	C	WSO
0+421.5	LT	WSO
0+860.0	RT	WSO
0+979.0	RT	WSO
0+980.0	LT	WSO
0+982.0	LT	WSO
I+102.0	LT	WSO
I+146.5	RT	WSO
I+148.0	RT	WSO
I+149.0	RT	WSO
I+181.0	RT	WSO
I+182.0	RT	(2) WSO
I+183.0	RT	WSO
I+233.0	RT	WSO
I+365.0	RT	WSO
I+370.0	RT	WSO
I+523.0	RT	WSO
I+538.0	LT	WSO
I+683.0	LT	WSO
I+702.5	LT	WSO
I+712.0	LT	WSO
I+767.5	LT	WSO
I+808.0	LT	WSO
I+810.5	LT	WSO
I+814.5	RT	(2) WSO
I+938.0	LT	WSO
I+943.5	LT	WSO
I+945.5	LT	WSO
I+991.0	RT	WSO
2+000.0	LT	WSO
2+028.0	LT	WSO
2+057.0	LT	TEST CP
2+075.0	RT	WSO
2+117.5	LT	TEST CP

STATION	POSITION	DESCRIPTION
U.S. ROUTE 7		
2+142.0	LT	WSO
2+150.0	LT	WSO
2+185.0	RT	WSO
2+211.0	LT	WSO
2+229.0	LT	WSO
2+234.0	LT	WSO
2+244.0	RT	WSO
2+245.0	RT	WSO
2+246.0	LT	WSO
2+250.0	LT	(2) TEST CP
2+292.0	LT	WSO
2+297.1	RT	WSO
2+299.0	RT	WSO
2+305.0	LT	WSO
2+306.0	RT	WSO
2+315.0	LT	TEST CP
2+380.0	RT	WSO
2+382.0	RT	WSO
2+382.0	LT	TEST CP
2+383.0	RT	WSO
2+445.0	RT	WSO
2+534.0	RT	WSO
2+624.5	LT	WSO
2+631.0	RT	WSO
2+803.0	LT	WSO
2+891.0	RT	WSO
2+908.0	LT	WSO
3+040.0	C	VALVE (PAVED OVER)
3+303.0	RT	WSO
3+314.0	RT	WSO
3+354.5	RT	WSO
3+435.0	RT	TEST CP
3+440.0	RT	TEST CP
3+450.0	RT	WSO
3+563.0	RT	WSO

NOTES: 1) ALL DIMENSIONS IN MILLIMETERS EXCEPT WHERE OTHERWISE INDICATED.

UTILITY AND STRUCTURE LOCATIONS SHEET #2


PROJECT NAME:	ST. ALBANS CITY	FILE NAME:	zpqve297d150zpd150.dgn	PLOT DATE:	01-FEB-2006 07:5
PROJECT NUMBER:	STP_9804(I)S	PROJECT LEADER:	JLL	DRAWN BY:	D-H
		DESIGNED BY:	D-H	CHECKED BY:	
		IPARM FILE NAME:	pd150us2.1	SHEET	_68_ OF 105

STATE OF VERMONT AGENCY OF TRANSPORTATION



PROPOSED IMPROVEMENT CLASS I TOWN HIGHWAY CITY OF ST. ALBANS COUNTY OF FRANKLIN VT ROUTE 36

PROJECT LOCATION STP 2129(1)S

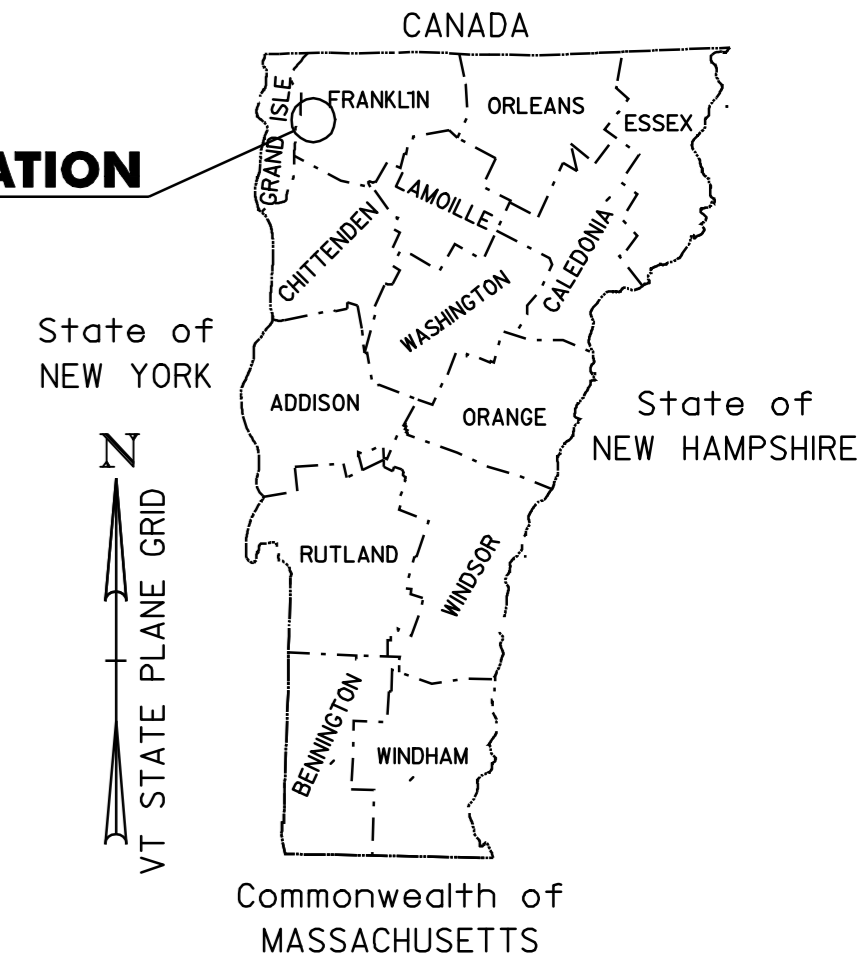

BEGINNING IN ST. ALBANS CITY ON VT ROUTE 36 AT STA. 1+406.57 (MM 0.874)
AND EXTENDING EASTERLY ALONG VT ROUTE 36 FOR A DISTANCE OF 991.35 M
(0.616 MILE) TO THE ST. ALBANS CITY/ST. ALBANS TOWN LINE AT STA. 2+397.92 (MM 1.490).

PROJECT DATA	LENGTH	LENGTH
CITY OF ST. ALBANS	(METERS)	(MILES)
ROUTE 36		
STA. 1+406.57 TO 2+397.92	991.35	
MM 0.874 TO MM 1.490		0.616
TOTAL LENGTH OF PROJECT	991.35	0.616
TOTAL LENGTH OF ROADWAY	991.35	0.616


TRAFFIC DATA

VT ROUTE 36 (MM 0.874 TO MM 1.519)

LOCATION	ADT		DHV		ESALS
	2001	2011	2001	2011	2001-2011
U.S. ROUTE 7 TO SMITH STREET	6,600	7,900	850	970	359,000
SMITH STREET TO VT ROUTE 104	6,000	7,200	790	900	418,000

WORK TO BE PERFORMED UNDER THIS PROJECT INCLUDES COLD PLANING AND
RESURFACING OF THE EXISTING HIGHWAY, NEW PAVEMENT MARKINGS
AND INCIDENTAL ITEMS.

**BEGIN STP 2129(1)S
VT ROUTE 36 - FAIRFIELD STREET
ST. ALBANS CITY
STA. 1+406.57 (MM 0.874)**

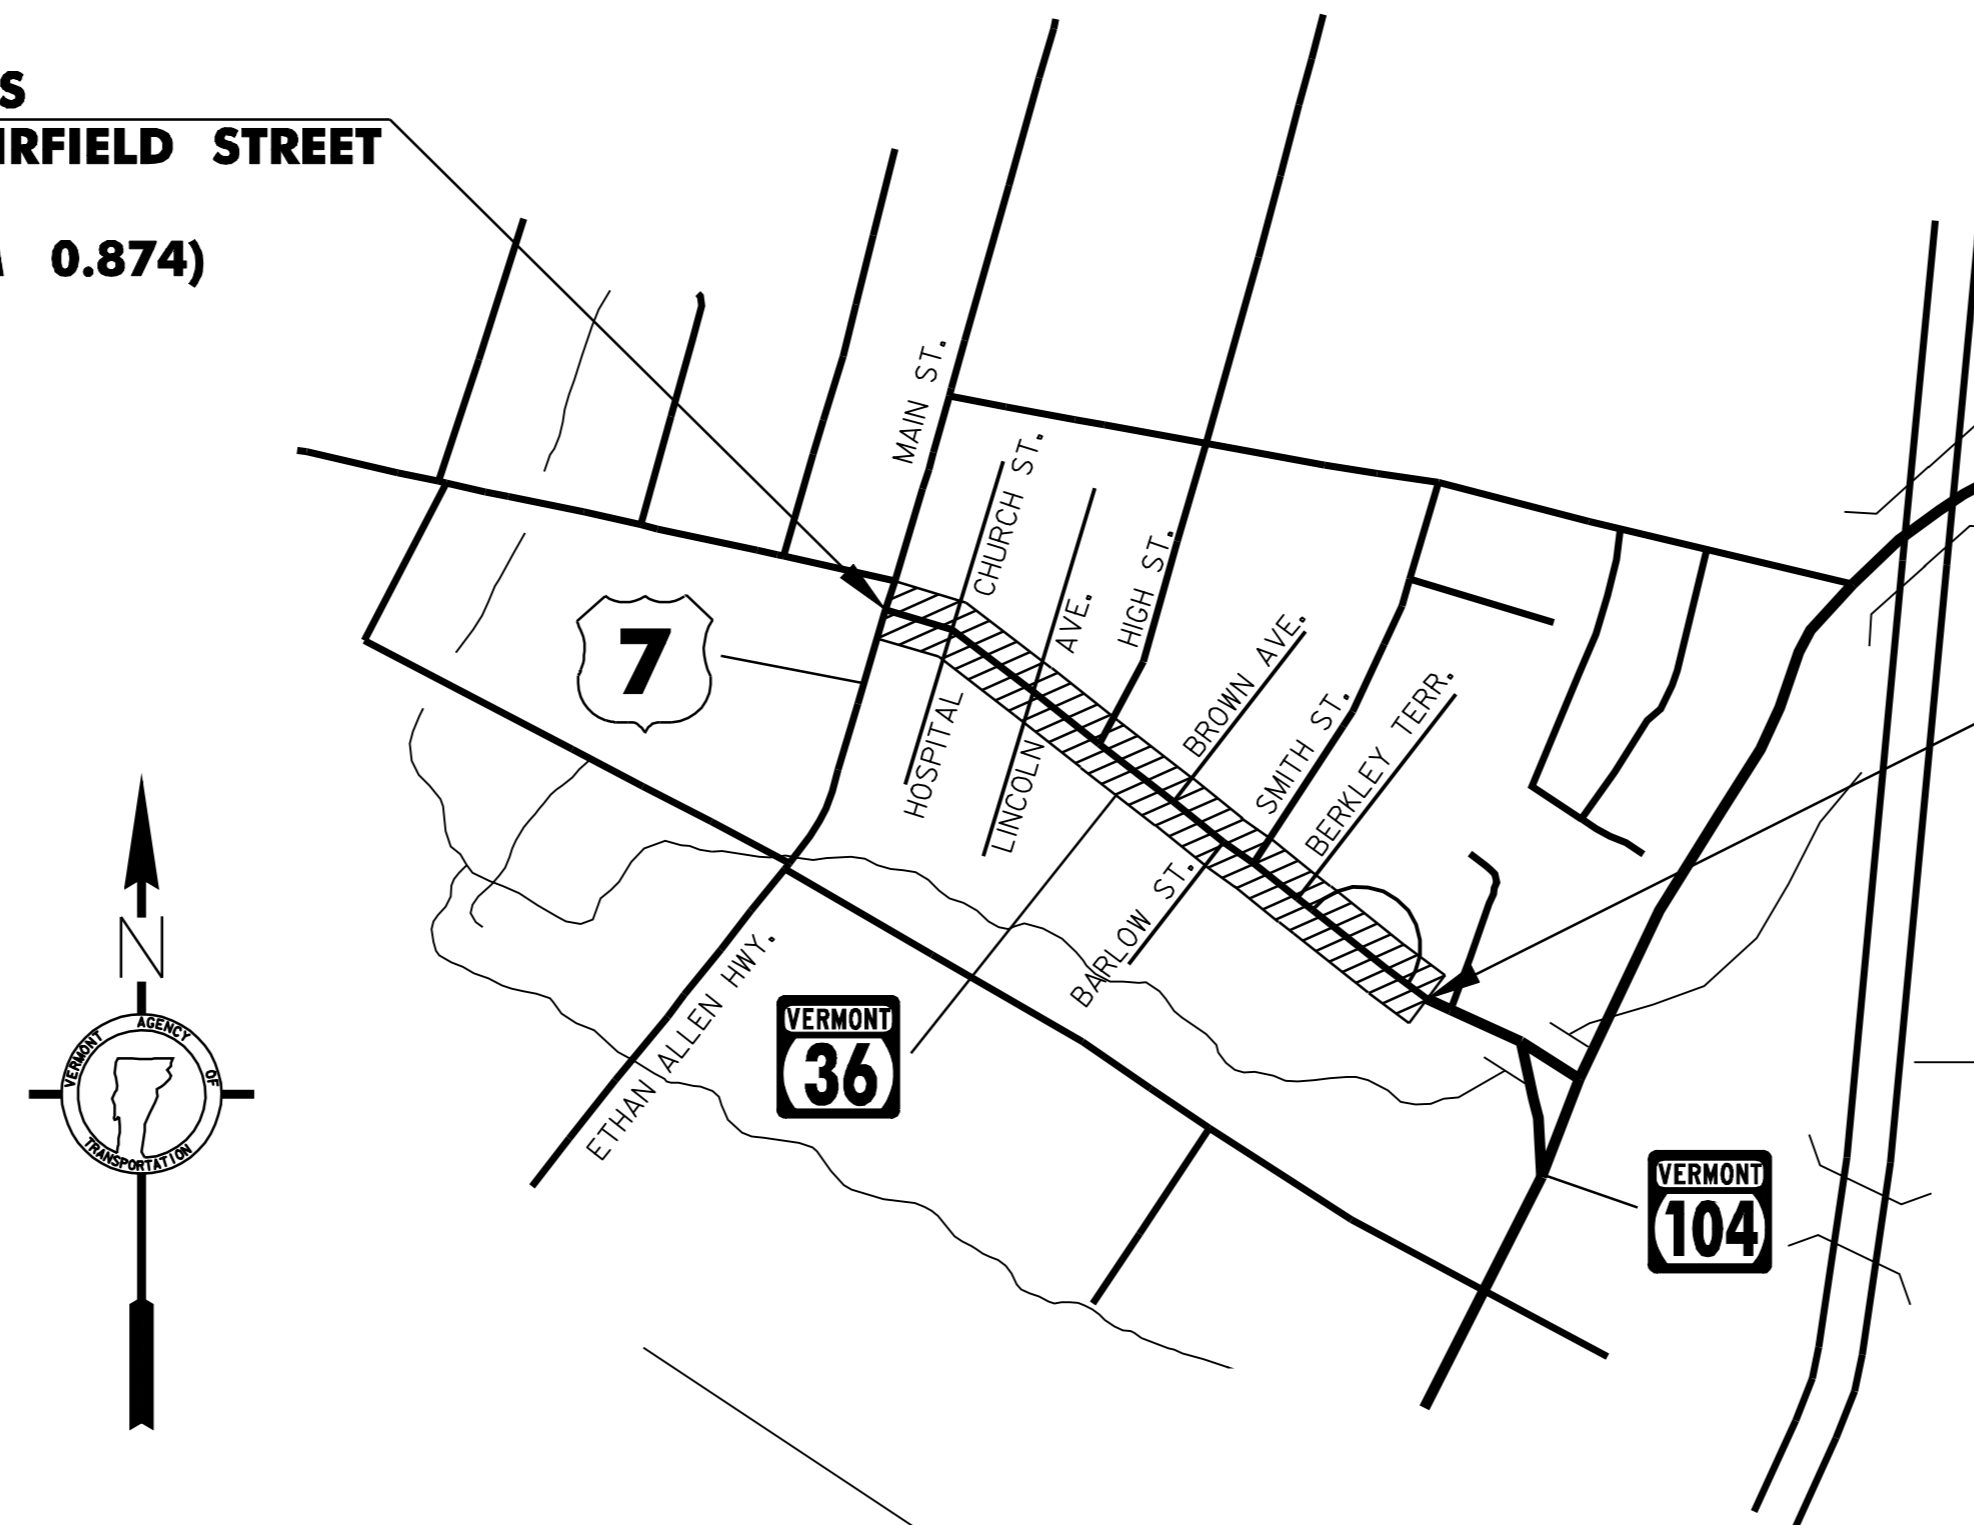

**END STP 2129(1)S
VT ROUTE 36 - FAIRFIELD STREET
ST. ALBANS CITY
STA. 2+397.92 (MM 1.490)**

NOTE:

RIGHT-OF-WAY LIMITS, IF APPLICABLE, ARE PROVIDED SOLELY FOR THE CONVENIENCE OF THE STATE AND ITS CONTRACTOR DURING THE COURSE OF THIS PAVING PROJECT. ANY REFERENCES TO OFFSETS ON THESE PLANS ARE APPROXIMATE AND SHOULD NOT BE RELIED UPON FOR ANY PURPOSES.

UNLESS OTHERWISE NOTED, ALL DRAWINGS AND DETAILS ON THESE PLANS ARE DRAWN "NOT TO SCALE".



UNLESS NOTED OTHERWISE
STATIONS ARE IN KILOMETERS
ELEVATIONS ARE IN METERS
DIMENSIONS ARE IN MILLIMETERS

DEPARTMENT OF TRANSPORTATION FEDERAL HIGHWAY ADMINISTRATOR	
APPROVED _____	DATE _____
DIRECTOR OF PROJECT DEVELOPMENT	
APPROVED _____	DATE _____
PROJECT MANAGER :	
PROJECT NAME :	ST. ALBANS CITY
PROJECT NUMBER :	STP 2129(1)S
SHEET 70 OF 105 SHEETS	

THESE PLANS ARE SUBJECT TO SUCH ENGINEERING CHANGES AS MAY BE REQUIRED BY THE FEDERAL HIGHWAY ADMINISTRATION OR THE DIRECTOR OF PROJECT DEVELOPMENT.
CONSTRUCTION IS TO BE CARRIED ON IN ACCORDANCE WITH THESE PLANS AND THE STANDARD SPECIFICATIONS FOR CONSTRUCTION DATED 2001, AS APPROVED BY THE FEDERAL HIGHWAY ADMINISTRATION ON JANUARY 4, 2001 FOR USE ON THIS PROJECT, INCLUDING ALL SUBSEQUENT REVISIONS AND SUCH REVISED SPECIFICATIONS AND SPECIAL PROVISIONS AS ARE INCORPORATED IN THESE PLANS.



CONVENTIONAL SYMBOLS

COUNTY LINE	
TOWN LINE	
LIMITS OF ACCESS	
POINT OF ACCESS	
FENCE LINE	
STONE WALL	
TRAVELED WAY	
GUARD RAIL	
RAILROAD	
SURVEY LINE	
CULVERT	
POWER POLE	
TELEPHONE POLE	
TREES	
CONTROL OF ACCESS	
PROPERTY LINE	
R.O.W. TAKING LINE	
SLOPE RIGHTS	
TOP OF CUT	
TOE OF SLOPE	

UTILITY LEGEND

	= EXISTING HYDRANT
	= EXISTING DI
	= EXISTING MANHOLE
	= EXISTING TELEPHONE MANHOLE
	= EXISTING ELECTRIC MANHOLE
	= EXISTING SEWER MANHOLE
	= EXISTING WATER SHUTOFF
	= EXISTING GAS SHUTOFF
	= EXISTING MAILBOX


SIGN LEGEND

N	= NEW
R	= REMOVE
R&S	= REMOVE & SALVAGE
S	= SALVAGE SIGN
RET	= RETAIN
B-B	= BACK TO BACK
⓪	= RETURN TO CITY OF ST. ALBANS


SURVEYED BY : D-H
SURVEYED DATE : 10-20-99

DATUM
VERTICAL N/A
HORIZONTAL N/A



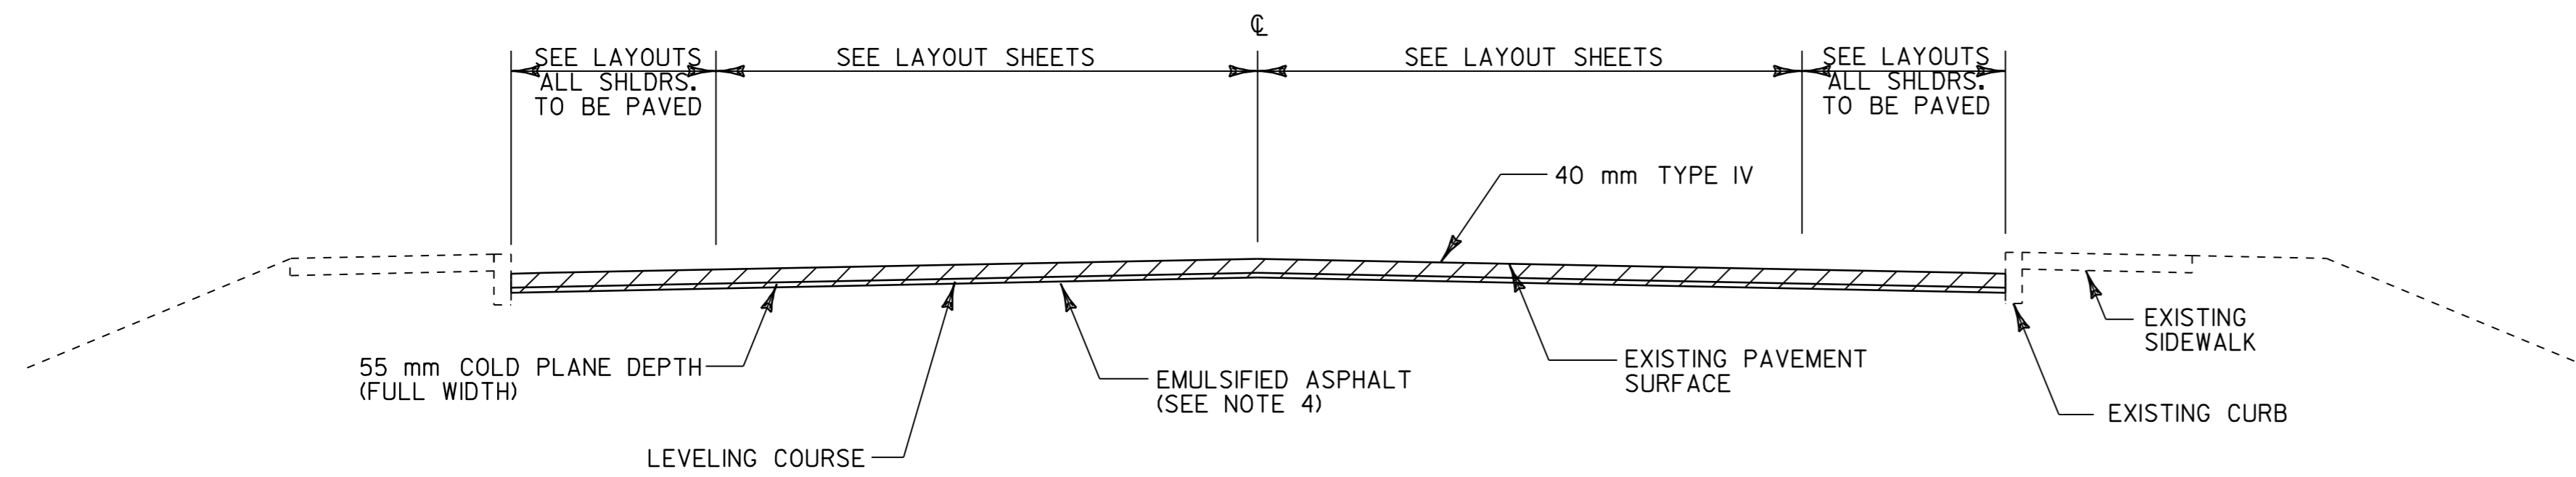

COLD PLANE TYPICAL SECTION - CURBED
VT ROUTE 36 - FAIRFIELD STREET STA. 1+406.57 TO 2+397.92

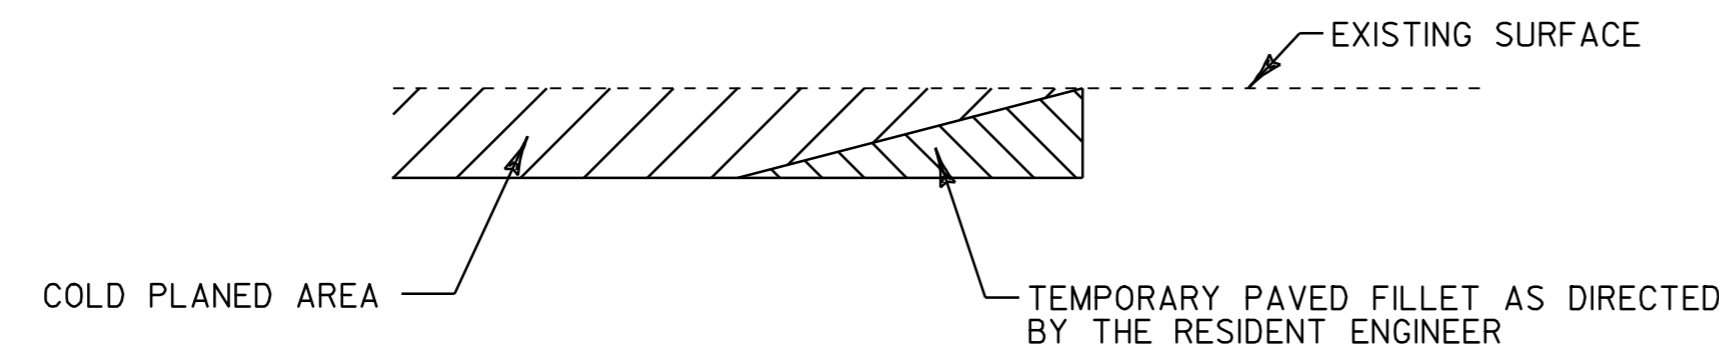

DETAIL AT VERTICAL COLD PLANE JOINTS

PROJECT PAVING LIMITS

TOWN & ROUTE	BEGIN STATION	END STATION	LANE TYPICAL	WEARING DEPTH	LEVELING TONS	NOTES
ST. ALBANS VT ROUTE 36	1+406.57	1+420.6	SEE LAYOUT SHEET	40 mm	8	COLD PLANE 55 mm, LEVEL, THEN PAVE WITH 40 mm TYPE IV
ST. ALBANS VT ROUTE 36	1+420.6	1+451.0	0.6 M - 3.3 M - 3.3 M - 0.6 M	40 mm	12	COLD PLANE 55 mm, LEVEL, THEN PAVE WITH 40 mm TYPE IV
ST. ALBANS VT ROUTE 36	1+451.0	1+482.3	SEE LAYOUT SHEETS	40 mm	10	COLD PLANE 55 mm, LEVEL, THEN PAVE WITH 40 mm TYPE IV
ST. ALBANS VT ROUTE 36	1+482.3	1+633.2	0.6 M - 5.4 M - 5.4 M - 0.6 M	40 mm	81	COLD PLANE 55 mm, LEVEL, THEN PAVE WITH 40 mm TYPE IV
ST. ALBANS VT ROUTE 36	1+633.2	1+671.2	SEE LAYOUT SHEETS	40 mm	12	COLD PLANE 55 mm, LEVEL, THEN PAVE WITH 40 mm TYPE IV
ST. ALBANS VT ROUTE 36	1+671.2	2+089.5	0.6 M - 3.3 M - 3.3 M - 0.6 M	40 mm	110	COLD PLANE 55 mm, LEVEL, THEN PAVE WITH 40 mm TYPE IV
ST. ALBANS VT ROUTE 36	2+089.5	2+105.6	SEE LAYOUT SHEETS	40 mm	27	COLD PLANE 55 mm, LEVEL, THEN PAVE WITH 40 mm TYPE IV
ST. ALBANS VT ROUTE 36	2+105.6	2+397.92	0.0 M - 3.6 M - 3.6 M - 0.0 M	40 mm	74	COLD PLANE 55 mm, LEVEL, THEN PAVE WITH 40 mm TYPE IV

NOTES

- THE PAVEMENT WEARING COURSE SHALL BE TYPE IV. THE 15 mm LEVELING COURSE SHALL BE TYPE IV UNLESS OTHERWISE DIRECTED BY THE ENGINEER. ALL ASPHALT CEMENT USED IN THE BITUMINOUS CONCRETE PAVEMENT SHALL BE PG 58-34.
- GRASS GROWING ADJACENT TO PAVEMENT OR THROUGH CRACKS IN THE PAVEMENT WHICH MAY HAMPER THE PLACEMENT OF NEW BITUMINOUS CONCRETE SHALL BE REMOVED BY THE CONTRACTOR AS DIRECTED BY THE ENGINEER. PAYMENT FOR THIS WORK WILL NOT BE MADE DIRECTLY, BUT WILL BE CONSIDERED SUBSIDIARY TO ITEM 406.25 BITUMINOUS CONCRETE PAVEMENT.
- BITUMINOUS CONCRETE PAVEMENT TOLERANCE = ±5 mm. (TOTAL THICKNESS EXCLUDING LEVELING)
- EMULSIFIED ASPHALT SHALL BE APPLIED ON EXISTING PAVEMENT SURFACES, BETWEEN ALL COURSES OF PAVEMENT AND ON COLD PLANED SURFACES, AT THE RATE OF 0.12 L/m² OR AS DIRECTED BY THE ENGINEER.
- COLD PLANING TO BE COMPLETED ACCORDING TO TYPICAL OR AS NOTED OTHERWISE ON THE PLANS. THE COLD PLANING AND PAVING SHALL MATCH THE EXISTING CONDITIONS AT THE BEGINNING AND END OF CONSTRUCTION AREAS BY THE USE OF A VERTICAL BUTT JOINT. SEE DETAIL ON THIS SHEET.
- ALL DRIVES SHALL RECEIVE A PAVED APRON TO THE EDGE OF SIDEWALK AS DIRECTED BY THE RESIDENT ENGINEER. ANY AND ALL REQUIRED EXCAVATION IN DRIVE AREAS SHALL BE AS DIRECTED AND WILL BE PAID FOR UNDER ITEM 210.10. IF REQUIRED, A NEW DRIVEWAY SUBBASE SHALL BE CONSTRUCTED AND WILL BE PAID FOR UNDER ITEM 301.28. A NEW BITUMINOUS SURFACE SHALL BE CONSTRUCTED AS DIRECTED AND WILL BE PAID FOR UNDER ITEM 406.25. ESTIMATED QUANTITIES OF THE ABOVE ITEMS HAVE BEEN INCLUDED TO PAY FOR THIS WORK.
- FOR VEHICLE DETECTOR LOOP NOTES, SEE SHEET 10.
- ALL PAVING WHICH COULD INVOLVE SOME HANDWORK (SUCH AS DRIVEWAYS, AROUND SEWER MANHOLES AND DROP INLETS, ETC.) SHALL BE PAID AS ITEM 406.25.
- ALL TELEPHONE MH'S AND GSO'S WILL BE ADJUSTED BY OTHERS AND SHOULD NOT BE INCLUDED IN OTHER PAY ITEMS.

URBAN AREAS - SEED MIXTURE

% WT	KG/HA	NAME	PUR %	GERM %
42.2	38	CREEPING RED FESCUE	98	85
10.0	9	PERENNIAL RYE GRASS	95	90
42.2	38	KENTUCKY BLUE GRASS	85	85
5.6	5	ANNUAL RYE GRASS	95	85
100	90			

SEED MIXTURE:
SHALL NOT HAVE A WEED CONTENT EXCEEDING 0.40% BY WEIGHT AND SHALL BE FREE OF ALL NOXIOUS SEED.

SEED:
TO BE APPLIED PER SEEDING FORMULAS OR AS DIRECTED BY THE ENGINEER.

FERTILIZER:
FORMULA 10-20-10, TO BE USED WITH SEED, APPLIED AT THE RATE OF 560 KG/HA. (HYDRO SEEDERS MAY USE 19-19-19 FORMULA.)

AGRICULTURAL LIMESTONE:
TO BE APPLIED AT THE RATE OF 4500 KG/HA, OR AS DIRECTED BY THE ENGINEER.

HAY MULCH:
TO BE PLACED ON EARTH SLOPES AT THE RATE OF 4500 KG/HA, OR AS DIRECTED BY THE ENGINEER.

TOPSOIL:
TO BE USED AS INDICATED ON THE PLANS, OR AS DIRECTED BY THE ENGINEER.

NOTE:
ALL DIMENSIONS IN MILLIMETERS EXCEPT WHERE OTHERWISE INDICATED



PROJECT TYPICAL & PAVING LIMITS

PROJECT NAME: ST. ALBANS CITY	PLOT DATE: 01-FEB-2006 07:5
PROJECT NUMBER: STP 2129(1)S	DRAWN BY: D-H
FILE NAME: /pave/99d070/pd070.dgn	CHECKED BY: D-H
PROJECT LEADER: JLL	SHEET 71 OF 105
DESIGNED BY: D-H	
IPARM FILE NAME: pd070+yl.l	

STATION		POS.	203.15	203.16	203.30	212.20	212.20	301.28	402.12		604.40	604.412	604.42	604.47	616.28	616.40	616.41	616.47	618.10	618.15	629.20	REMARKS
BEGIN	END		COMMON EXCAV. m ³	SOLID ROCK EXCAV. m ³	EARTH BORROW m ³	SCARIFYING PAVEMENT (MOD.1) m ²	SCARIFYING PAVEMENT (MOD.2) m ²	SUBBASE OF C.R. GRAVEL (T)	AGG. SHOULDERS T	GRATE TYPE EA	CHAN ELEV EA	REHAB DI CLASS I EA	CHAN ELEV SEWER MANHOLE EA	CAST IRON GRATE W/FRAME TYPE D EA	CAST-IN-PLACE CEM. CONC. CURB TYPE B M	REMOVING & RESETTING CURB (M)	REMOVAL OF EXISTING CURB M	BIT. CONC. GUTTERS & TRAFFIC ISLANDS T	P.C. CONCRETE SIDEWALK 125 mm m ²	BIT. CONCRETE SIDEWALK T	ADJUST ELEV OF VALVE BOX EA	
VT ROUTE 36																						
I+406.0	2+397.92	LT&RT									30		9								15	QUANTITIES FOR USE AS DIRECTED BY THE ENGINEER. FOR STRUCTURE LOCATIONS, SEE SHEET 89.
I+406.0		RT				2.3																CONSTRUCT TEXTURING. FOR DETAILS SEE SHEET 7.
I+409.0		LT	0.5				2.3	0.9												0.3		CONSTRUCT BITUMINOUS SIDEWALK RAMP, TYPE I; FOR TEXTURING DETAILS, SEE SHEET 7.
I+413.0		RT				2.3																CONSTRUCT TEXTURING. FOR DETAILS SEE SHEET 7.
I+417.0		LT	1.4				2.3	2.4						3.9	3.9					0.8		CONSTRUCT BITUMINOUS SIDEWALK RAMP, TYPE I; FOR TEXTURING DETAILS, SEE SHEET 7.
I+498.9		LT	1.5	0.5				3.5						7.9	7.9			10.1				CONSTRUCT SIDEWALK RAMP, TYPE I
I+498.9		RT				2.3																CONSTRUCT TEXTURING. FOR DETAILS SEE SHEET 7.
I+511.3		RT				2.3																CONSTRUCT TEXTURING. FOR DETAILS SEE SHEET 7.
I+511.3		LT	1.0	0.9				2.4											6.9			CONSTRUCT SIDEWALK RAMP, TYPE 6
I+591.2		RT	0.3	0.3				0.7						3.4	3.4				2.1			CONSTRUCT SIDEWALK RAMP, TYPE 2
I+594.0		LT				2.3																CONSTRUCT TEXTURING. FOR DETAILS SEE SHEET 7.
I+651.8		LT	0.5	0.4				1.2											3.4			CONSTRUCT SIDEWALK RAMP, TYPE I
I+655.0		RT	0.5	0.3				1.1						2.3	2.3				3.3			CONSTRUCT SIDEWALK RAMP, TYPE I
I+661.0		LT				2.3																CONSTRUCT TEXTURING. FOR DETAILS SEE SHEET 7.
I+666.0		RT	1.4	0.9				3.1											9.0			CONSTRUCT SIDEWALK RAMP, TYPE 6
I+782.0		LT				1.4																CONSTRUCT TEXTURING. FOR DETAILS SEE SHEET 7.
I+788.0		LT	0.6	0.5				1.3						4.6	4.6				3.7			CONSTRUCT SIDEWALK RAMP, TYPE I
I+940.0		LT	0.4	0.3				0.8											2.4			CONSTRUCT SIDEWALK RAMP, TYPE I
I+948.0		LT	0.4	0.3				1.0											2.8			CONSTRUCT SIDEWALK RAMP, TYPE I
2+038.0		RT	0.4	0.3				0.8											2.4			CONSTRUCT SIDEWALK RAMP, TYPE 3
2+041.5		LT	0.5	0.4				1.2											3.4			CONSTRUCT SIDEWALK RAMP, TYPE 2
2+048.0		RT				2.3																CONSTRUCT TEXTURING. FOR DETAILS SEE SHEET 7.
SEE REMARKS														3.0	3.0							CURB ITEMS FOR USE IN CONJUNCTION WITH WIRED CONDUIT INSTALLATION AS DIRECTED BY THE RESIDENT ENGINEER. FOR DETAILS, SEE SHEET 10.
SUBTOTALS			9.4	5.1		17.5	4.6	20.4			30		9	25.1	25.1				49.5	1.1	15	
ROUNDING			0.6	0.9		0.5	0.4	0.6			-		-	0.9	0.9				1.5	0.9	-	
PROJECT TOTALS			10	6		18	5	21			30		9	26	26				51	2	15	

PROJECT NAME : ST. ALBANS CITY	PROJECT NO. : STP 2129(1)S
DESIGN FILE NAME: /pave/99d070/pd070.dgn	PLOT DATE: 01-FEB-2006 0
IPARM FILE NAME: pd0701d1	SURVEY DATE: 09/98
SURVEYED BY: D-H	DRAWN BY: D-H
DESIGNED BY: JLL	SHEET: 74 OF 105

TEMPORARY AND DURABLE 100 mm WHITE LINE
 STA. I+420.6 TO I+480.0, SOLID LT. & RT. DURABLE ONLY STA. I+420.6 TO I+480.0, SOLID LT. & RT.
 STA. I+420.6 TO I+448.5, SOLID LT. (LANE LINE)

TEMPORARY AND DURABLE 100 mm YELLOW LINE
 STA. I+420.6 TO I+480.0, SOLID LT. & RT. DURABLE ONLY STA. I+420.6 TO I+480.0, SOLID LT. & RT.
 STA. I+420.6 TO I+448.5, SOLID LT. (LANE LINE)

TEMPORARY AND DURABLE CROSSWALK MARKING W/DIAGONAL LINES (MOD.)
 STA. I+417.5
 I+406 ~ I+409

TEMPORARY LETTER OR SYMBOL
 STA. I+422.4, LT. - (2) 425
 STA. I+444.8, LT. - (2) 451



TEMPORARY AND DURABLE 600 mm STOP BAR (TYPE ITAPE)
 STA. I+420.6, LT.

CHANGING ELEVATION OF DI'S, CB'S OR MH'S
 STA. I+478.3, LT. - MH
 STA. I+478.3, LT. - DI
 STA. I+480.0, RT. - DI

CHANGING ELEVATION OF SMH'S
 STA. I+476.8, C

DURABLE LETTER OR SYMBOL (TYPE ITAPE)
 STA. I+422.4, LT. - (2) 425
 STA. I+426.4, LT. - "ONLY" (2) 428
 STA. I+444.8, LT. - (2) 451
 STA. I+448.5, LT. - "ONLY" (2) 455



REMOVING SIGNS
 AS SHOWN - 15

CONCRETE SIDEWALK
 STA. I+406, RT.
 STA. I+413, RT.

CAST IN PLACE CONCRETE CURB
 STA. I+413, RT.

REMOVAL OF EXISTING CURB
 STA. I+413, RT.

**BEGIN STP 2129(1) S
 VT ROUTE 36
 ST. ALBANS CITY
 STA 1+406.57 = MM 0.874**

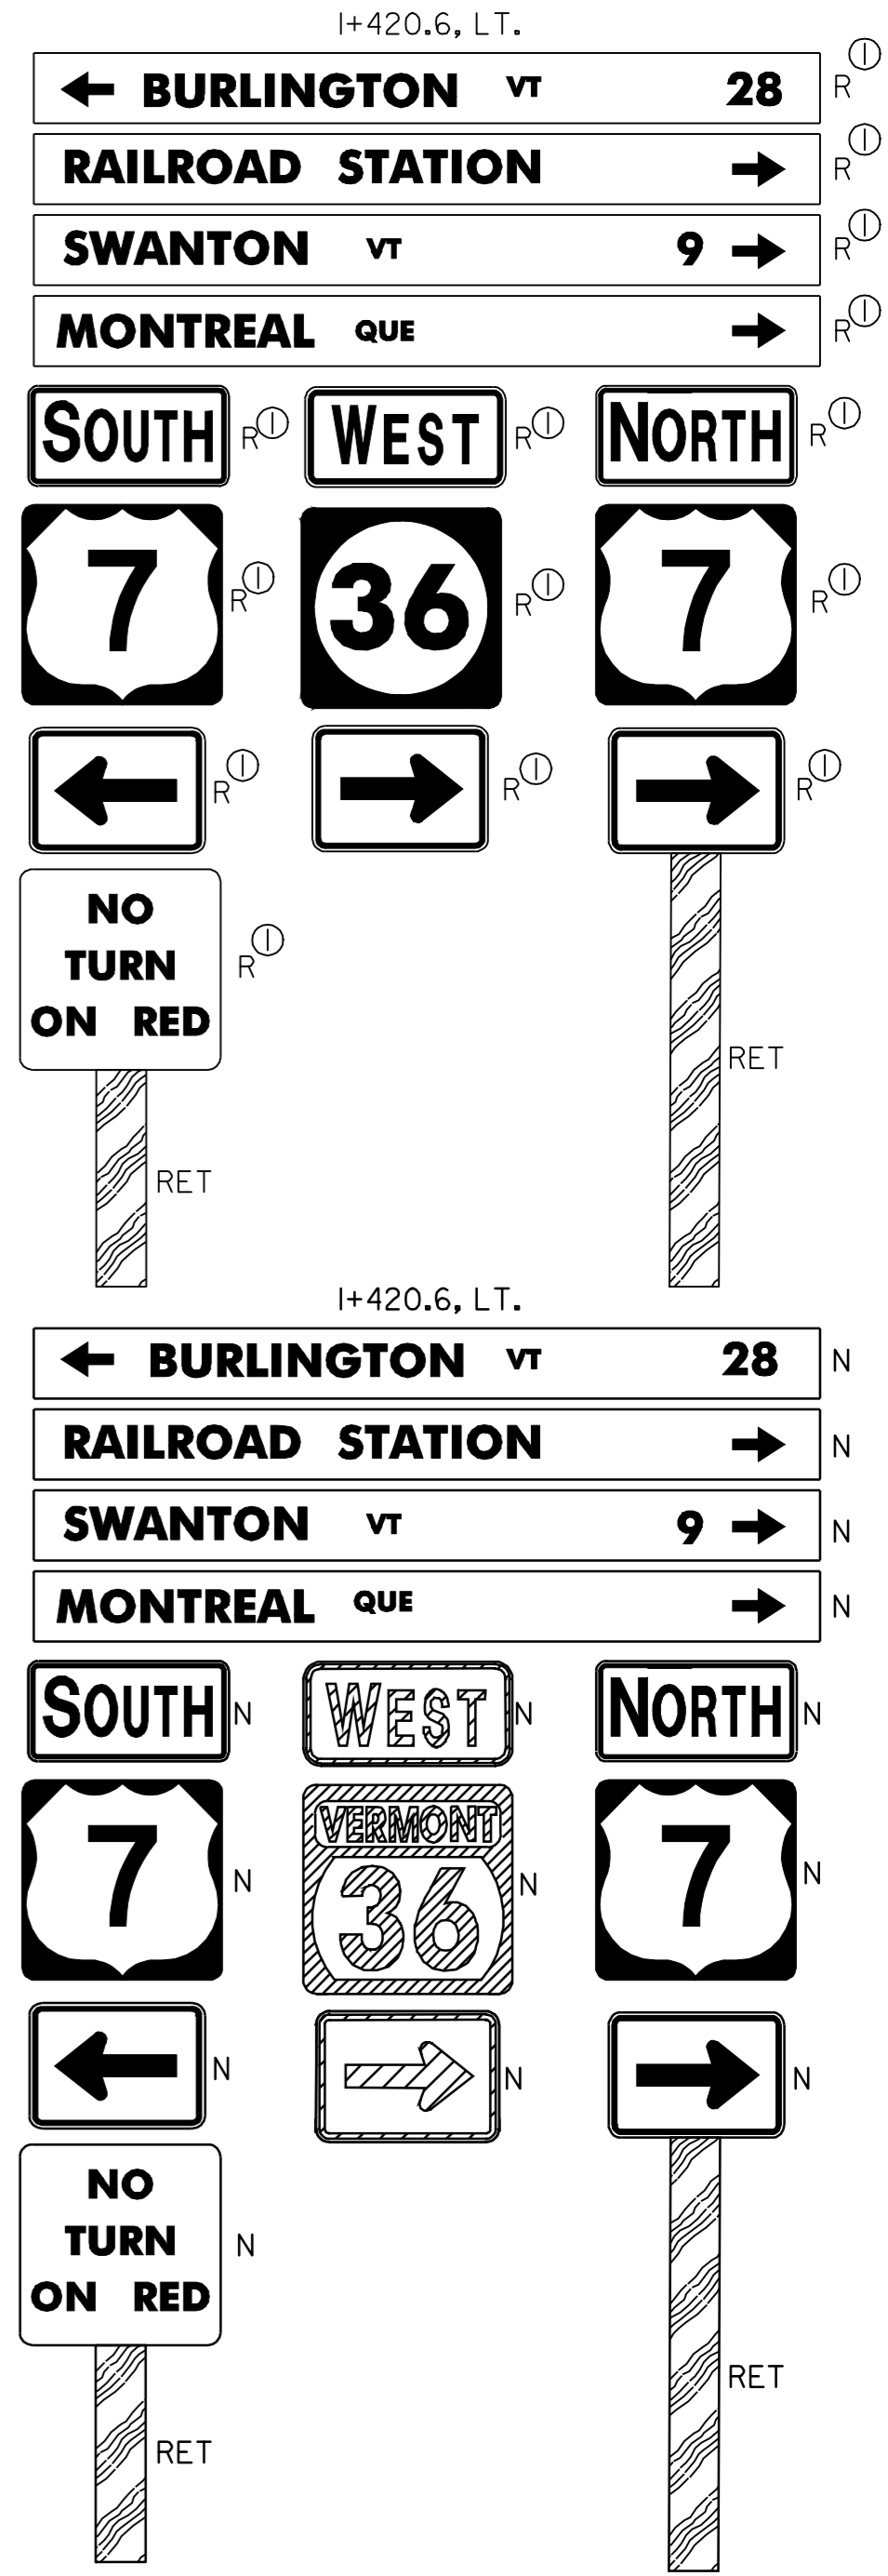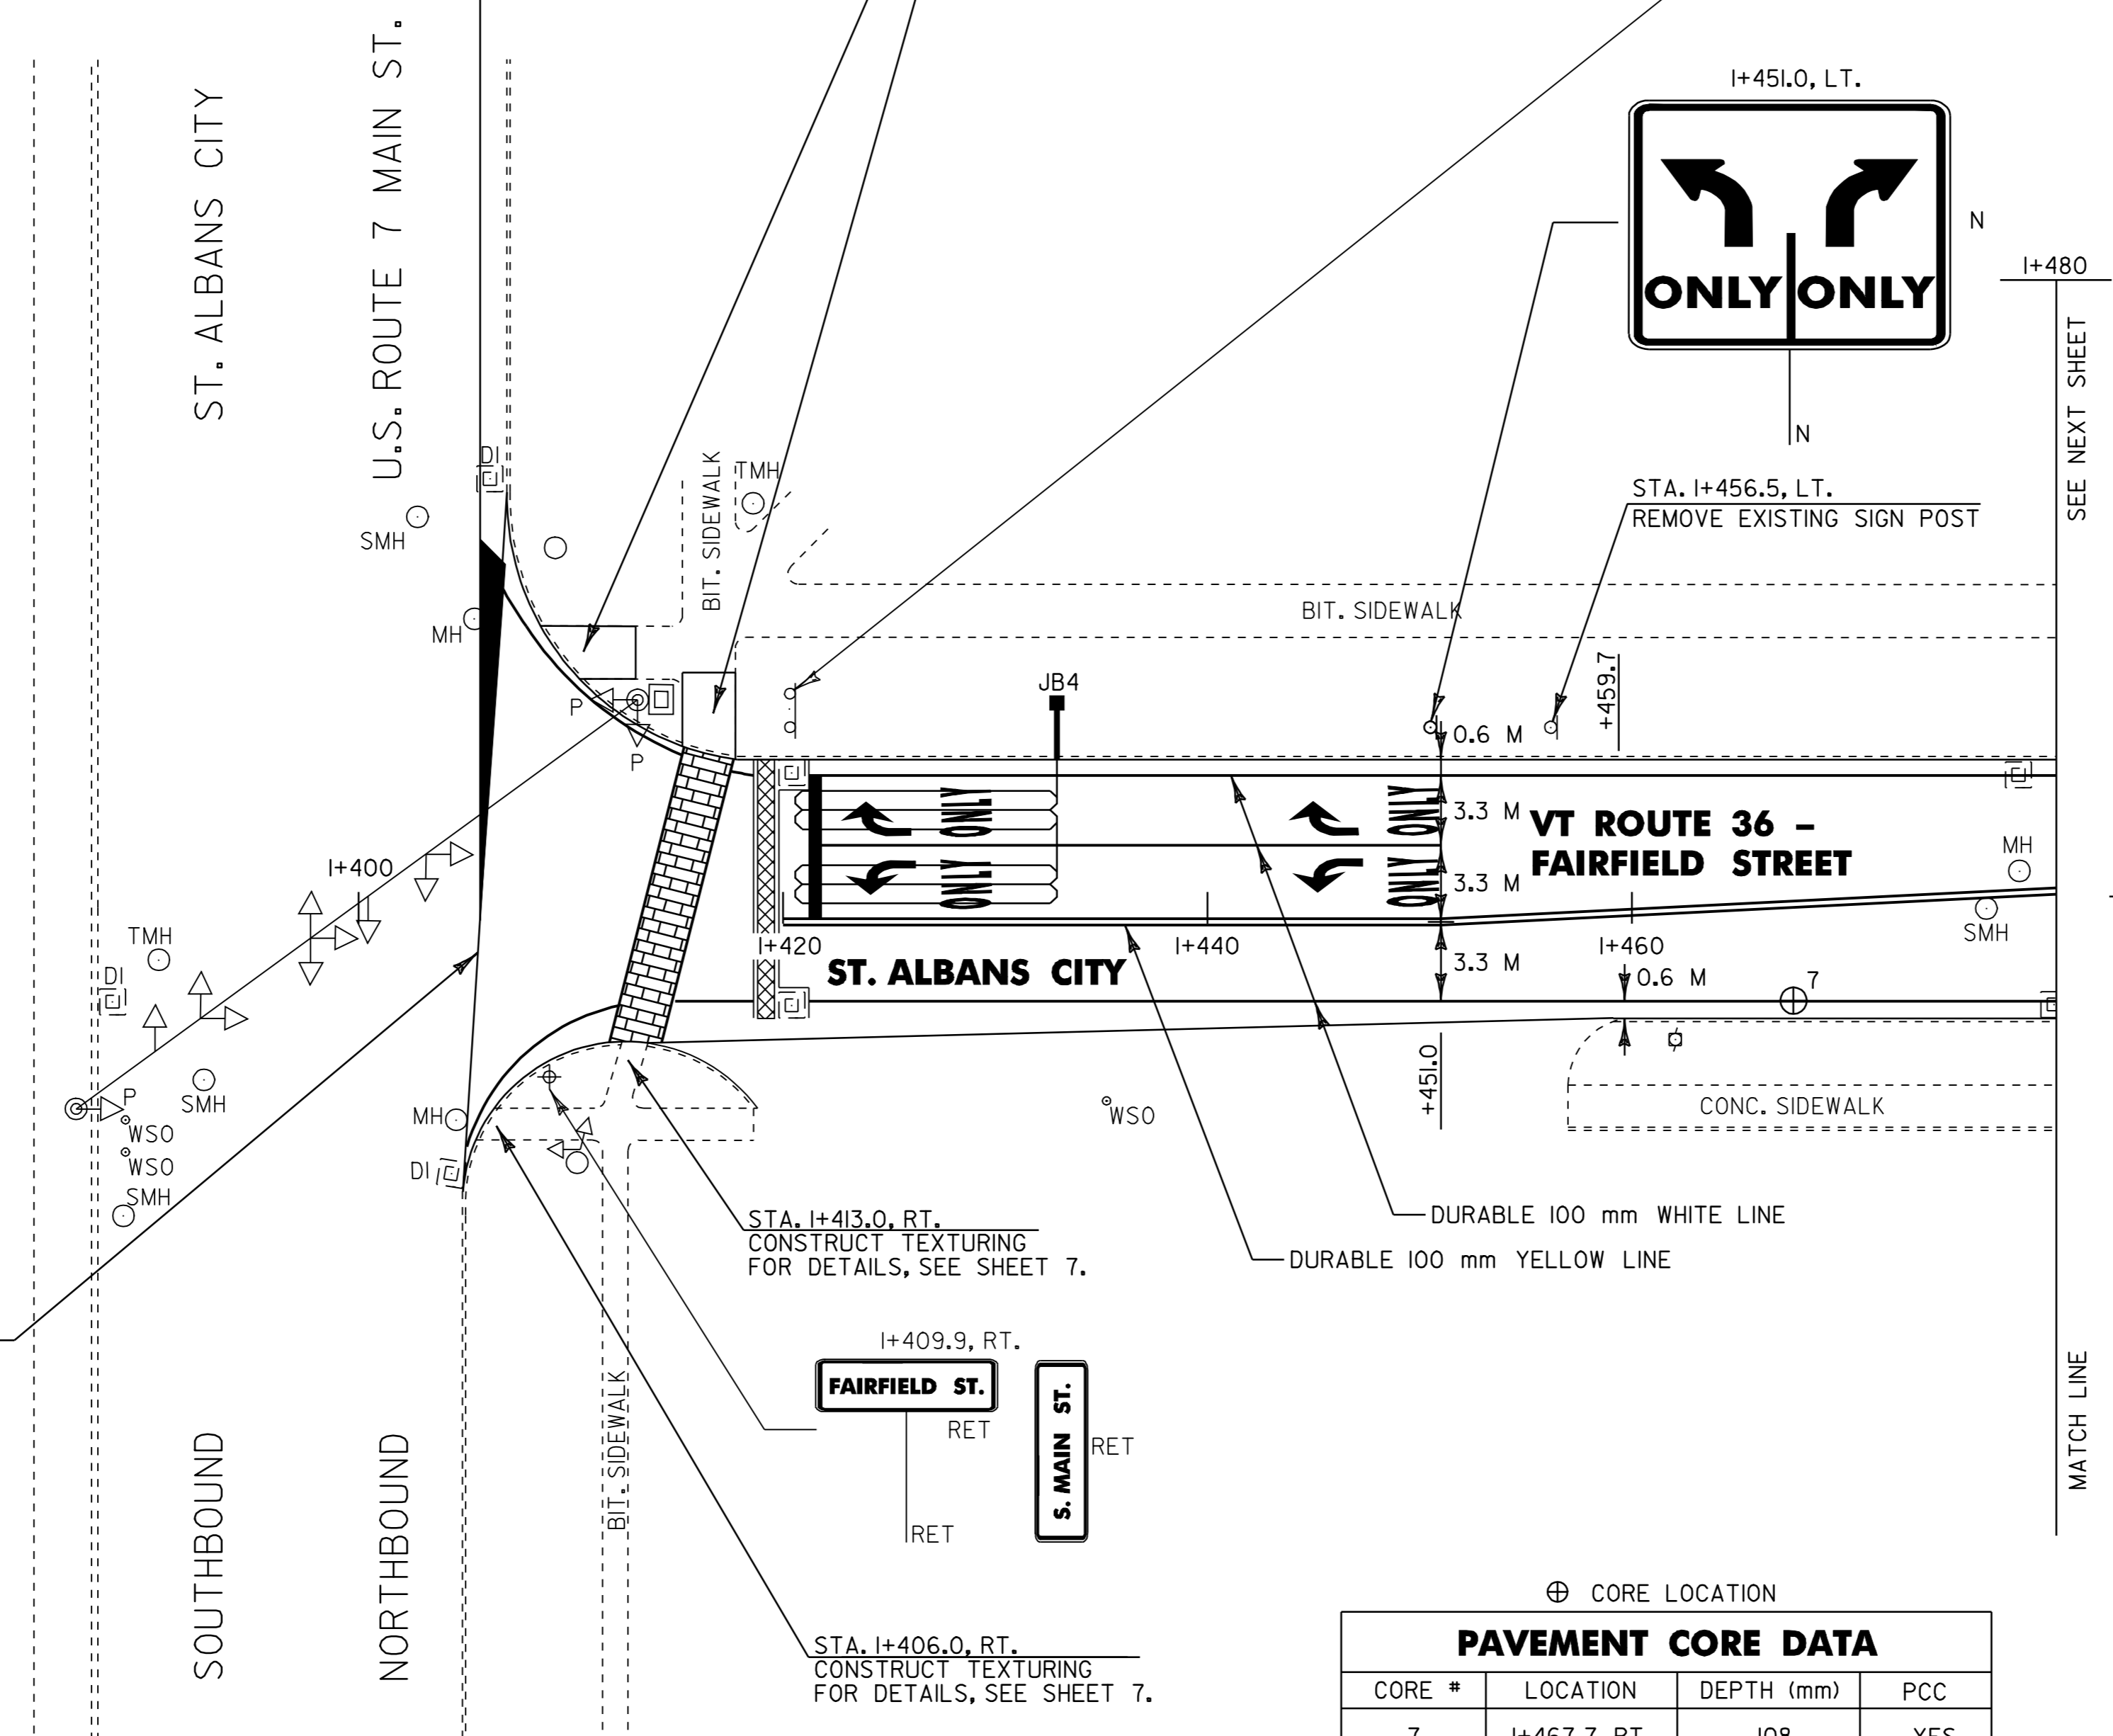

ST. ALBANS CITY U.S. ROUTE 7
 FOR DETAILS, SEE SHEETS 12 - 68.

STA. I+413.0, RT.
 CONSTRUCT TEXTURING
 FOR DETAILS, SEE SHEET 7.



⊕ CORE LOCATION

CORE #	LOCATION	DEPTH (mm)	PCC
7	I+467.7, RT.	108	YES

- NOTES:
- 1) ALL DIMENSIONS IN MILLIMETERS EXCEPT WHERE OTHERWISE INDICATED.
 - 2) ALL EXISTING SIGNS NOT SHOWN SHALL BE RETAINED AS DIRECTED BY THE RESIDENT ENGINEER.
 - 3) FOR ANY TOWN HIGHWAY OR STREET DETAILS, SEE VTrans STANDARD E-193M.
 - 4) FOR VEHICLE DETECTOR LOOP DETAILS SEE SHEET 10.

PROJECT LAYOUT #1

PROJECT NAME: ST. ALBANS CITY
 PROJECT NUMBER: STP 2129(1)S
 FILE NAME: /pave/99d070/pd070.dgn
 PROJECT LEADER: JLL
 DESIGNED BY: D-H
 IPARM FILE NAME: pd070p01.i
 PLOT DATE: 01-FEB-2006 07:59
 DRAWN BY: D-H
 CHECKED BY:
 SHEET 75 OF 105



~~TEMPORARY AND DURABLE 100 mm WHITE LINE~~
 STA. I+480.0 TO I+493.4, SOLID LT. & RT.
 STA. I+511.8 TO I+620.0, SOLID LT. & RT.
 (PARKING SPACES & DIAGONALS WITH
 EDGELINE BREAKS FOR CROSSWALK)

~~TEMPORARY AND DURABLE 100 mm YELLOW LINE~~
 STA. I+480.0 TO I+620.0, SOLID LT. & RT.
 (WITH CENTERLINE BREAKS FOR CHURCH ST.;
 BELLOWS FREE ACADEMY AND CROSSWALK)
 STA. I+500.5, DOUBLE SOLID LT. (CHURCH ST.)
 STA. I+500.5, DOUBLE SOLID RT. (BELLOWS FREE
 ACADEMY)

~~TEMPORARY AND DURABLE CROSSWALK MARKING W/DIAGONAL LINES (MOD.)~~
 STA. I+500.5, LT.
 STA. I+500.5, RT.
 STA. I+511.3
 STA. I+591.0

~~TEMPORARY AND DURABLE LETTER OR SYMBOL (TYPE I TAPE)~~
 STA. I+500.5, LT. - "STOP"
 STA. I+500.5, RT. - "STOP"
 STA. I+524.7, LT. - "S"

~~REMOVING SIGNS AS SHOWN - 15~~
 CHANGING ELEVATION OF DI'S, CB'S OR MH'S
 STA. I+498.6, LT. - DI
 STA. I+507.3, LT. - DI
 STA. I+507.8, LT. - MH
 STA. I+513.4, LT. - DI
 STA. I+515.9, RT. - DI
 STA. I+520.0, RT. - DI



~~TEMPORARY AND DURABLE 600 mm STOP BAR (TYPE I TAPE)~~
 STA. I+500.5, LT. (CHURCH ST.)
 STA. I+500.5, RT. (BELLOWS FREE ACADEMY)


PAINTED CURB
 IN NO PARKING AREAS AS
 DIRECTED BY RESIDENT ENGINEER

ADJUST ELEVATION OF VALVE BOX
 STA. I+507.8, RT. - (3) WSO

CONCRETE SIDEWALK
 STA. I+511.3, LT.
 STA. I+591.2, RT.

CAST IN PLACE CONCRETE CURB
 STA. I+498.9, LT.
 STA. I+511.3, LT.
 STA. I+591, RT.

CHANGING ELEVATION OF SMH'S
 STA. I+498.4, LT.

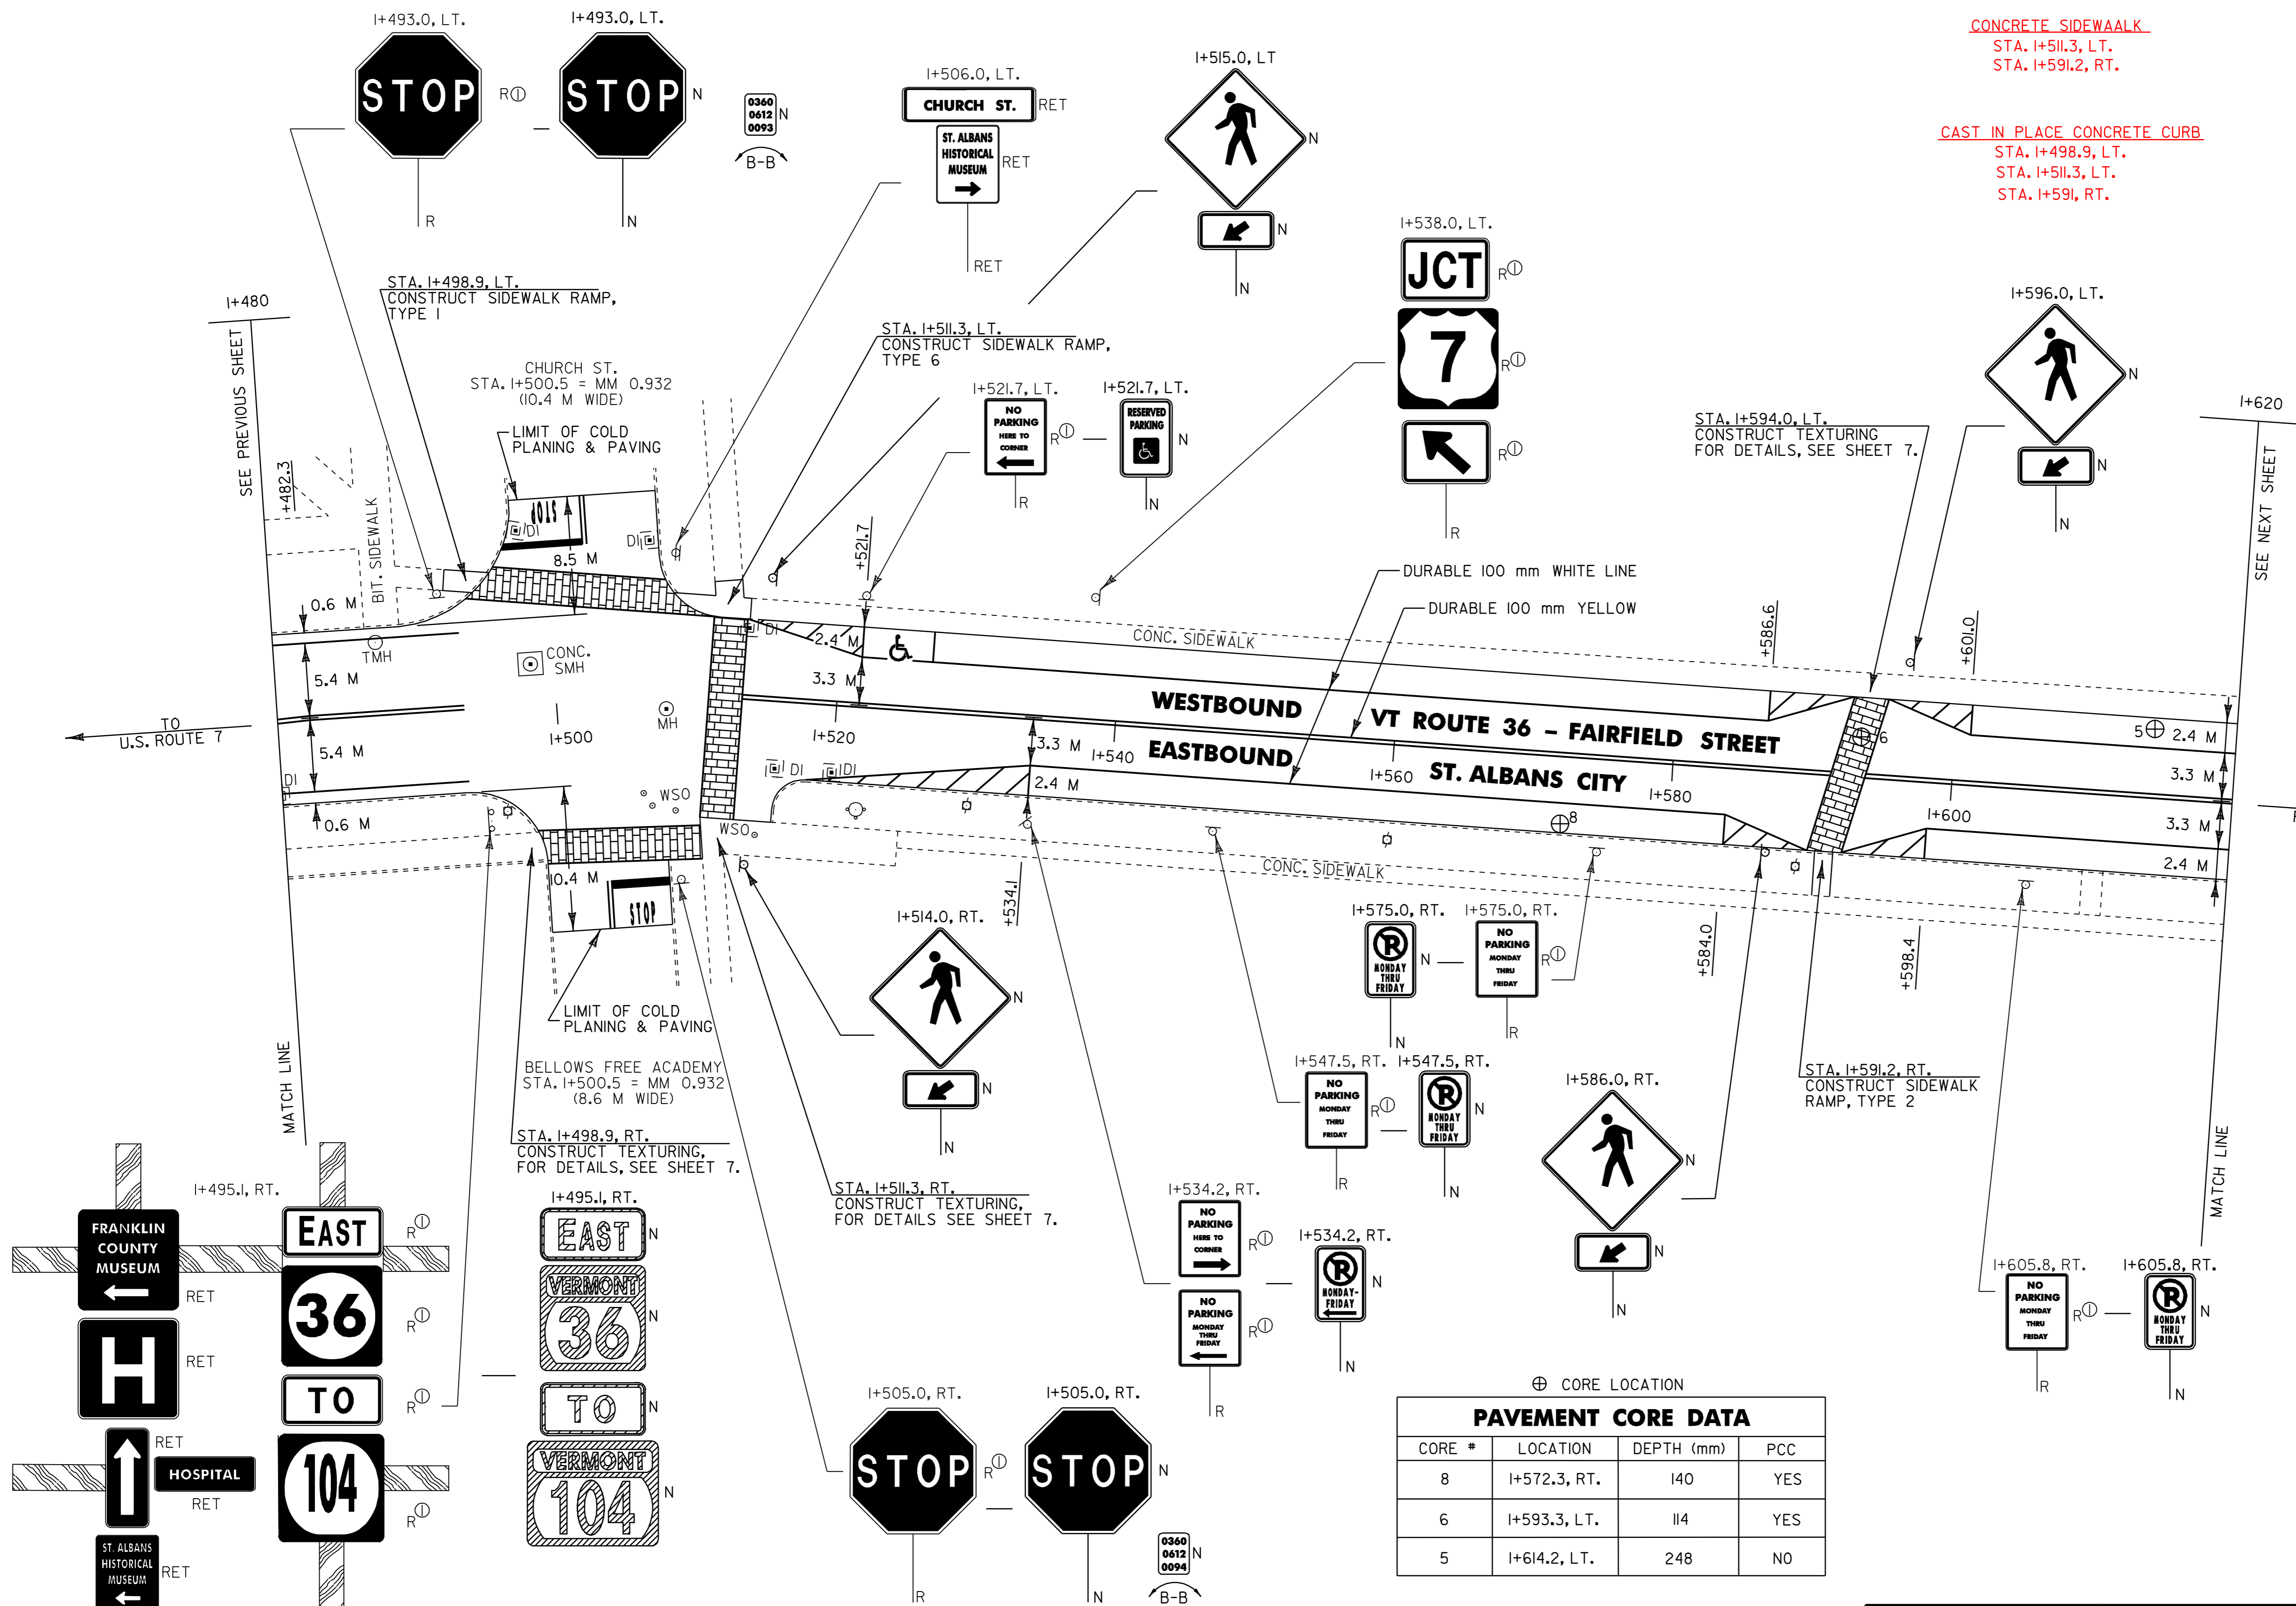

⊕ CORE LOCATION

CORE #	LOCATION	DEPTH (mm)	PCC
8	I+572.3, RT.	140	YES
6	I+593.3, LT.	114	YES
5	I+614.2, LT.	248	NO

NOTES: 1) ALL DIMENSIONS IN MILLIMETERS EXCEPT WHERE OTHERWISE INDICATED.
 2) ALL EXISTING SIGNS NOT SHOWN SHALL BE RETAINED AS DIRECTED BY THE RESIDENT ENGINEER.
 3) FOR ANY TOWN HIGHWAY OR STREET DETAILS, SEE VTrans STANDARD E-193M.

PROJECT LAYOUT #2

PROJECT NAME: ST. ALBANS CITY
 PROJECT NUMBER: STP 2129(1)S

FILE NAME: /pave/99d070/pd070.dgn
 PROJECT LEADER: JLL
 DESIGNED BY: D-H
 IPARM FILE NAME: pd070p02.i

PLOT DATE: 01-FEB-2006 07:15
 DRAWN BY: D-H
 CHECKED BY:
 SHEET 76 OF 105



~~TEMPORARY AND DURABLE 100 mm WHITE LINE~~
 STA. I+620.0 TO I+651.4, SOLID LT. & RT.
 (PARKING SPACES & DIAGONALS)
 STA. I+665.0 TO I+760.0, SOLID LT. & RT.

TEMPORARY AND DURABLE 100 mm YELLOW LINE
 STA. I+620.0 TO I+760.0, SOLID LT. & RT.
 (WITH CENTERLINE BREAK FOR LINCOLN AVE.)
 STA. I+657.9, RT. DOUBLE SOLID (LINCOLN AVE.)

~~TEMPORARY AND DURABLE CROSSWALK MARKING W/DIAGONAL LINES (MOD.)~~
 STA. I+657.9, LT.
 STA. I+657.9, RT.
 STA. I+663.5

TEMPORARY AND DURABLE LETTER OR SYMBOL (TYPE I TAPE)
~~STA. I+630.0, LT.~~
 STA. I+657.9, RT. - "STOP"

CHANGING ELEVATION OF SMH'S
~~STA. I+657.9, C~~

TEMPORARY AND DURABLE 600 mm STOP BAR (TYPE I TAPE)
~~STA. I+657.9, RT. (LINCOLN AVE.)~~

CHANGING ELEVATION OF DI'S, CB'S OR MH'S
~~STA. I+649.0, LT. - DI~~
 STA. I+657.0, RT. - MH
 STA. I+662.5, LT. - MH RT.
 STA. I+664.3, LT. - DI
 STA. I+667.2, RT. - DI

REMOVING SIGNS
 AS SHOWN - I3

ADJUST ELEVATION OF VALVE BOX
 STA. I+661.5, RT. - (4) WSO


ERECTING SALVAGED SIGNS
 AS SHOWN - I

PAINTED CURB
 IN NO PARKING AREAS AS
 DIRECTED BY RESIDENT ENGINEER

CONCRETE SIDEWALK
 STA. I+651, RT.
 STA. I+655, RT.
 STA. I+666, RT.

REMOVAL OF EXISTING CURB
 STA. I+651.8, LT.
 STA. I+655, RT.
 STA. I+666, RT.

CAST IN PLACE CONCRETE CURB
 STA. I+651, RT.
 STA. I+655, RT.
 STA. I+666, RT.

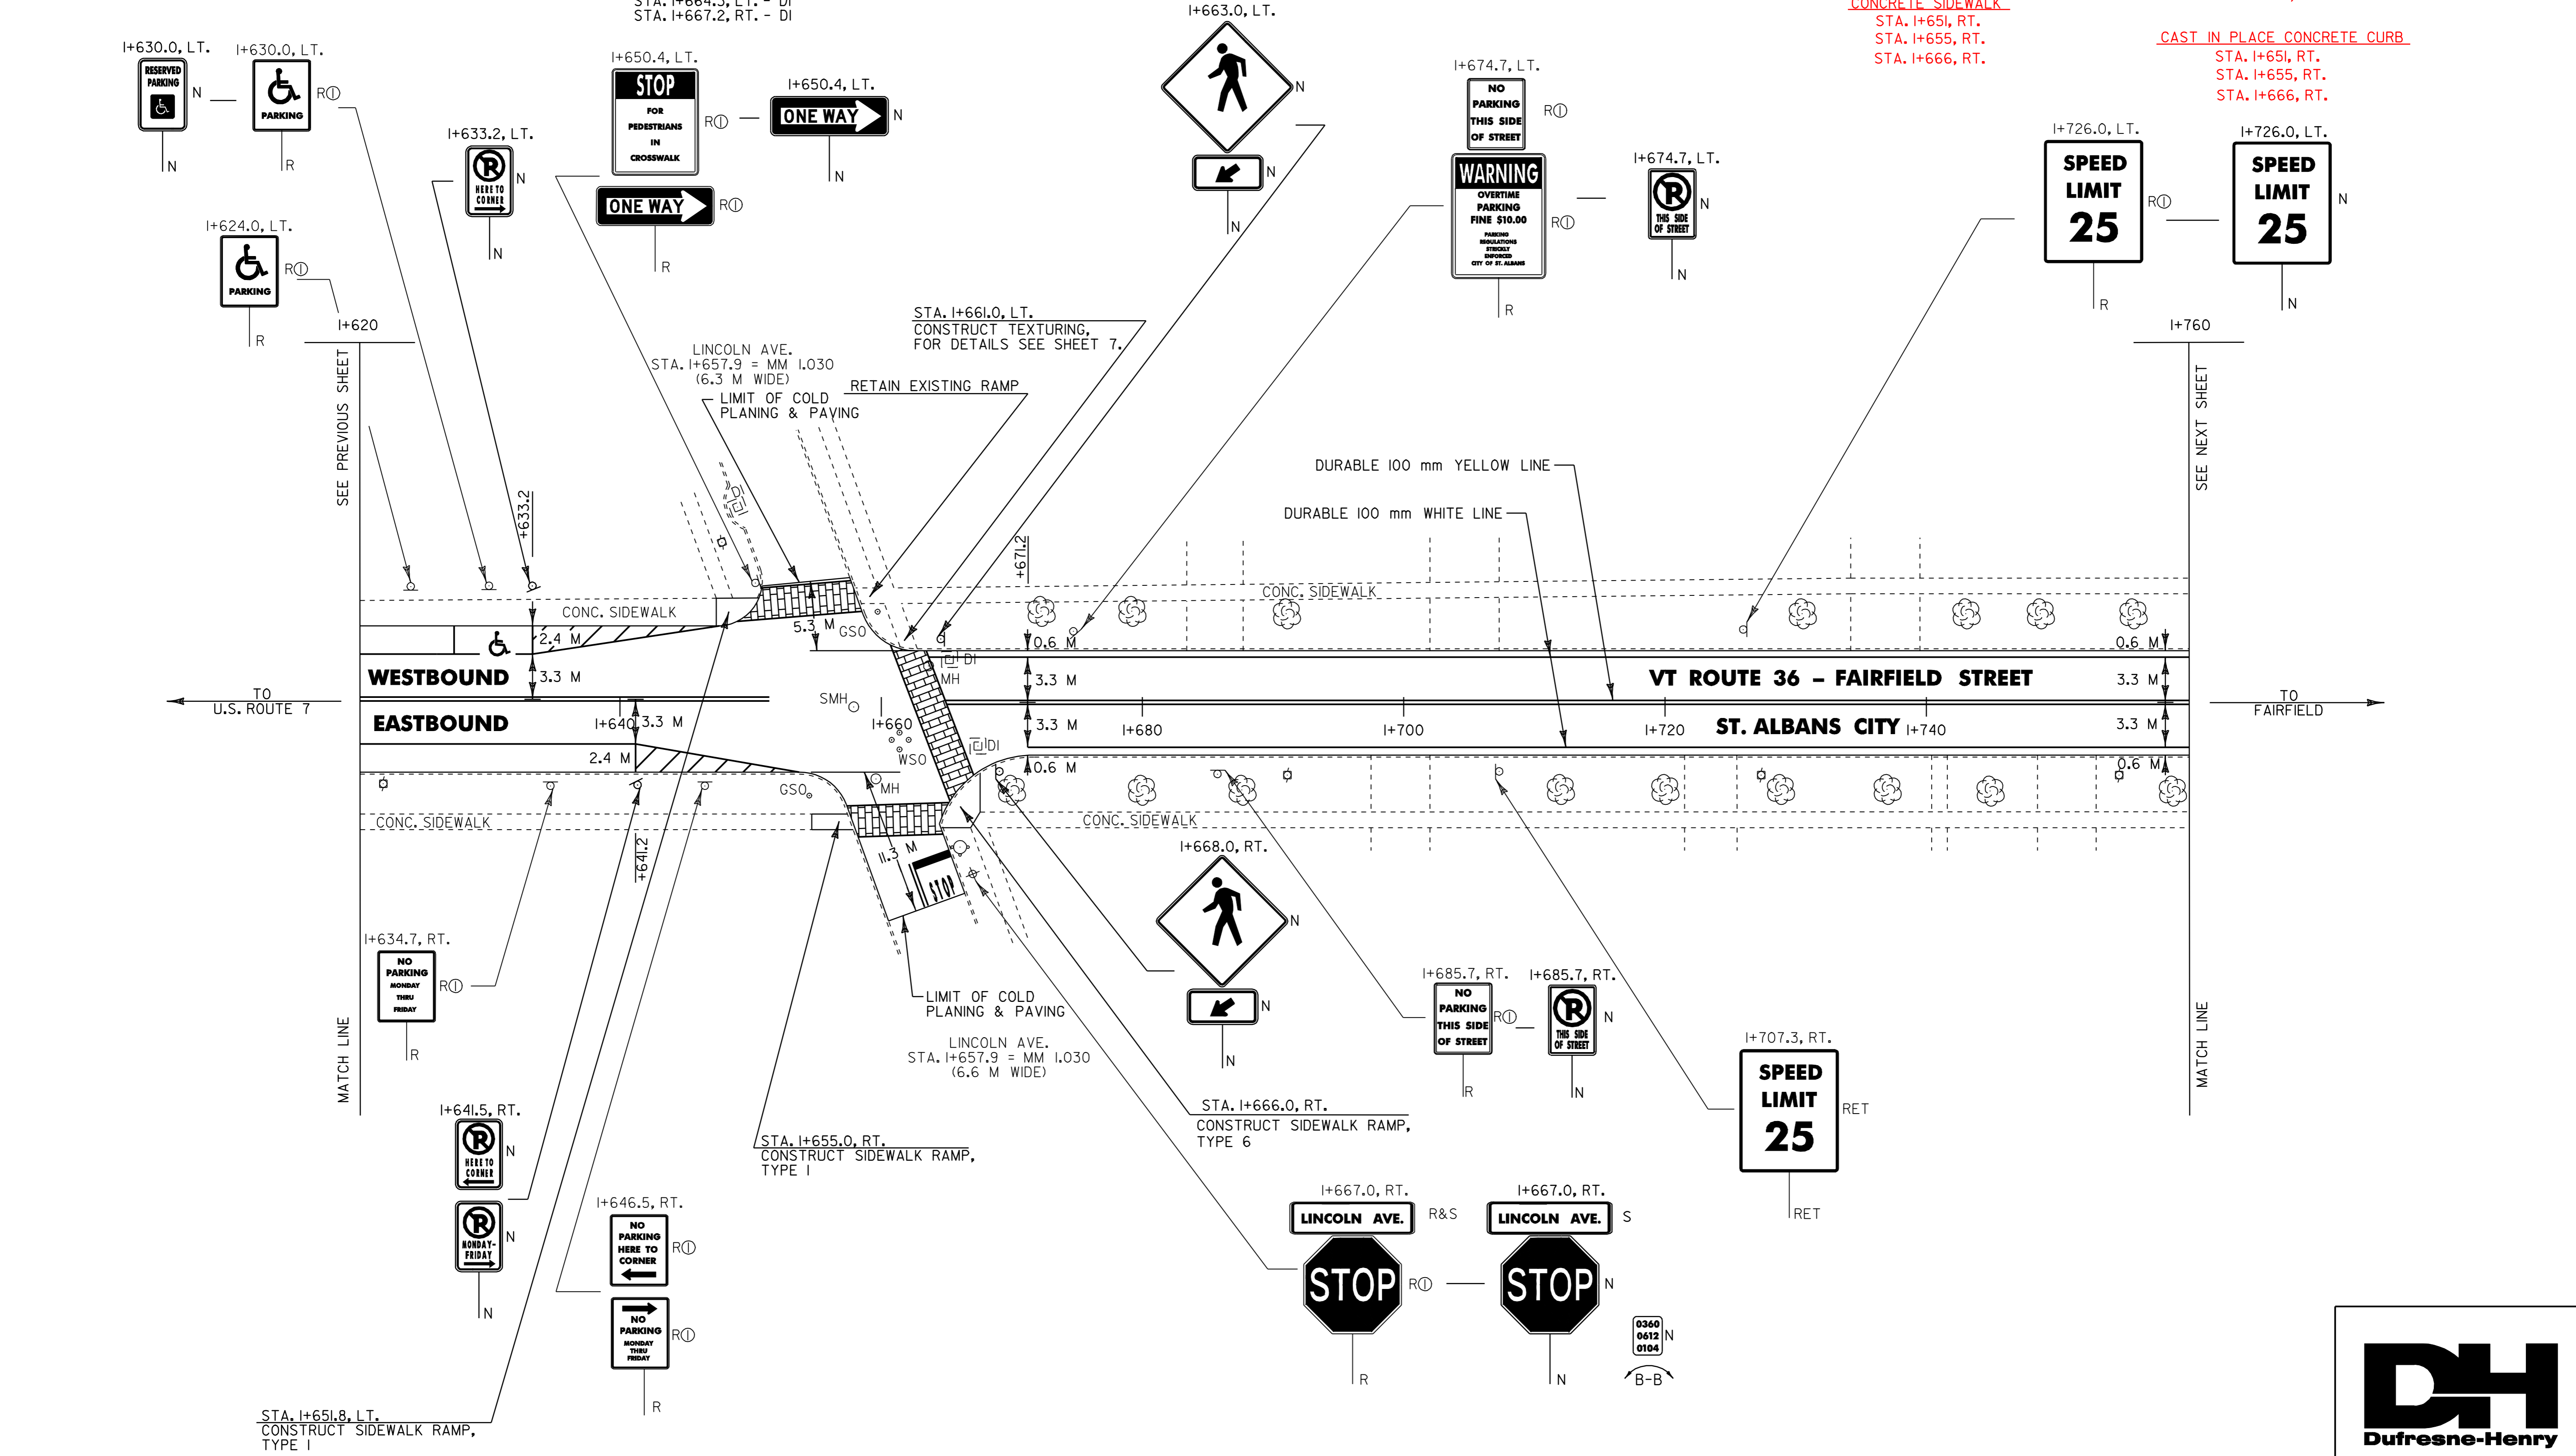

- NOTES:
- 1) ALL DIMENSIONS IN MILLIMETERS EXCEPT WHERE OTHERWISE INDICATED.
 - 2) ALL EXISTING SIGNS NOT SHOWN SHALL BE RETAINED AS DIRECTED BY THE RESIDENT ENGINEER.
 - 3) FOR ANY TOWN HIGHWAY OR STREET DETAILS, SEE VTrans STANDARD E-193M.

PROJECT LAYOUT #3	PROJECT NAME: ST. ALBANS CITY
	PROJECT NUMBER: STP 2129(1)S
	FILE NAME: /pave/99d070/pd070.dgn
	IPARM FILE NAME: pd070p03.i
	PLOT DATE: 01-FEB-2006 07:5
	DRAWN BY: D-H
	CHECKED BY:
	SHEET 77 OF 105



~~TEMPORARY AND DURABLE~~ 100 mm WHITE LINE
 STA. I+760.0 TO I+920.0, SOLID LT. & RT.
 (WITH EDGELINE BREAK FOR HIGH ST.)

TEMPORARY AND DURABLE 100 mm YELLOW LINE
 STA. I+760.0 TO I+920.0, SOLID LT. & RT.
 (WITH CENTERLINE BREAK FOR HIGH ST.)
 STA. I+786.3, LT. DOUBLE SOLID (HIGH ST.)

~~TEMPORARY AND DURABLE~~ CROSSWALK MARKING W/DIAGONAL LINES (MOD.)
 STA. I+786.3, LT.

TEMPORARY AND DURABLE LETTER OR SYMBOL (TYPE ITAPE)
 STA. I+786.3, LT. - 'STOP'

REMOVING SIGNS
 AS SHOWN - 6




~~TEMPORARY AND DURABLE~~ 600 mm STOP BAR (TYPE ITAPE)
 STA. I+786.3, LT. (HIGH ST.)

CHANGING ELEVATION OF DI'S, CB'S OR MH'S
 STA. I+778.7, LT. - DI
 STA. I+778.7, RT. - DI
 STA. I+788.0, LT. - MH
 STA. I+788, LT. - DI

ADJUST ELEVATION OF VALVE BOX
 STA. I+785.8, RT. - (3) WSO
 2
CAST IN PLACE CONCRETE CURB
 STA. I+788, LT.

ERECTING SALVAGED SIGNS
 AS SHOWN - 1
CONCRETE SIDEWALK
 STA. I+788, LT.

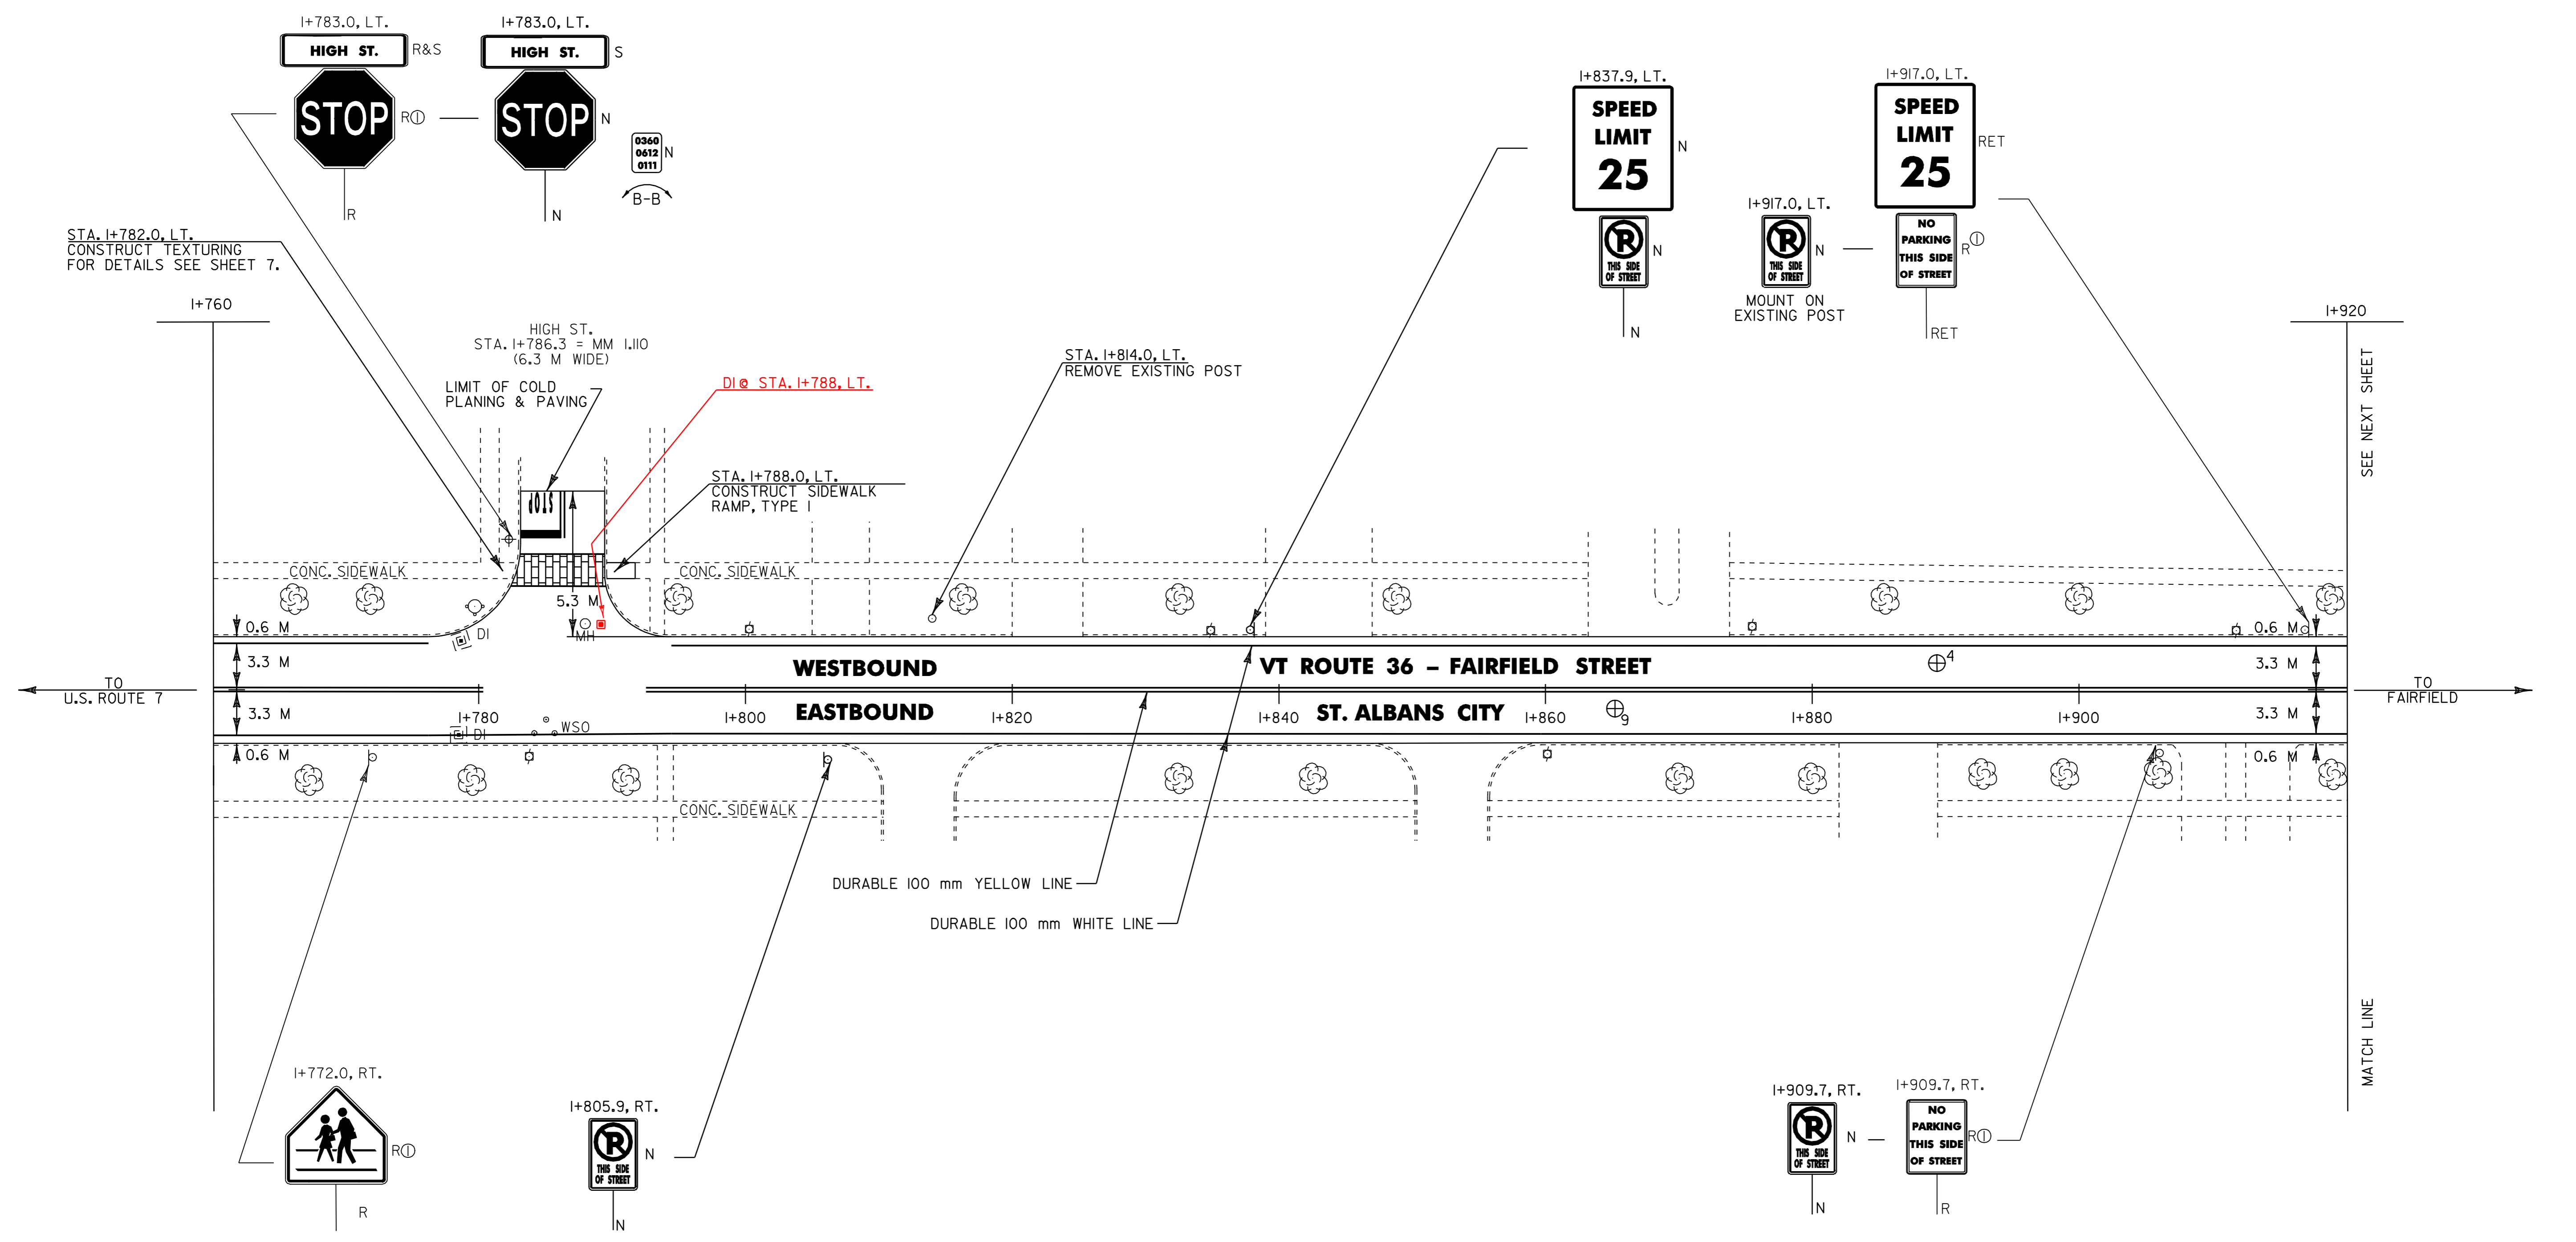

⊕ CORE LOCATION

PAVEMENT CORE DATA			
CORE #	LOCATION	DEPTH (mm)	PCC
9	I+865.2, RT.	127	YES
4	I+889.4, LT.	114	YES

NOTES: 1) ALL DIMENSIONS IN MILLIMETERS EXCEPT WHERE OTHERWISE INDICATED.
 2) ALL EXISTING SIGNS NOT SHOWN SHALL BE RETAINED AS DIRECTED BY THE RESIDENT ENGINEER.
 3) FOR ANY TOWN HIGHWAY OR STREET DETAILS, SEE VTrans STANDARD E-193M.

PROJECT LAYOUT #4	PROJECT NAME: ST. ALBANS CITY	PLOT DATE: 01-FEB-2006 07:5
	PROJECT NUMBER: STP 2129(1)S	DRAWN BY: D-H
	FILE NAME: /pave/99d070/pd070.dgn	CHECKED BY:
	DESIGNED BY: D-H	SHEET 78 OF 105
	IPARM FILE NAME: pd070p04.i	



~~TEMPORARY AND DURABLE~~ 100 mm WHITE LINE
 STA. 1+920.0 TO 2+060.0, SOLID LT. & RT.
 (WITH EDGELINE BREAKS FOR BROWN AVE.
 AND BARLOW ST.)

TEMPORARY AND DURABLE 100 mm YELLOW LINE
 STA. 1+920.0 TO 2+060.0, SOLID LT. & RT.
 (WITH CENTERLINE BREAKS FOR BROWN AVE.
 AND BARLOW ST.)
 STA. 1+944.3, LT. DOUBLE SOLID (BROWN AVE.)
 STA. 2+044.6, RT. DOUBLE SOLID (BARLOW ST.)

~~TEMPORARY AND DURABLE~~ CROSSWALK MARKING W/DIAGONAL LINES (MOD.)
 STA. 1+944.3, LT.
 STA. 2+038.0, RT. TO 2+042.0, LT.
 STA. 2+044.6, RT.

TEMPORARY AND DURABLE LETTER OR SYMBOL (TYPE 1 TAPE)
 STA. 1+944.3, LT. - 'STOP'
 STA. 2+044.6, RT. - 'STOP' DURABLE ONLY

ERECTING SALVAGED SIGNS
 AS SHOWN - 3

REMOVING SIGNS
 AS SHOWN - 5

ADJUST ELEVATION OF VALVE BOX
 STA. 1+941.6, RT. - (2) WSO
 STA. 2+050.0, RT. - WSO

CHANGING ELEVATION OF DI'S, CB'S OR MH'S
 STA. 1+932.8, LT. - DI
 STA. 1+966.5, RT. - DI
 STA. 2+044.6, RT. - MH
 STA. 2+050.0, RT. - MH & LT.


CHANGING ELEVATION OF SMH'S
 STA. 1+939.0, LT.
 STA. 1+939.0, LT.
 STA. 1+997.0, LT.
 STA. 2+047.2, RT.

~~TEMPORARY AND DURABLE~~ 600 mm STOP BAR (TYPE 1 TAPE)
 STA. 1+944.3, LT. (BROWN AVE.)
 STA. 2+044.6, RT. (BARLOW ST.)

CAST IN PLACE CONCRETE CURB
 STA. 1+940, LT.
 STA. 1+948, LT.
 STA. 2+038, RT.
 STA. 2+041.5, LT.

REMOVAL OF EXISTING CURB
 STA. 1+940, LT.
 STA. 1+948, LT.
 STA. 2+038, RT.

CONCRETE SIDEWALK
 STA. 1+940, LT.
 STA. 1+948, LT.
 STA. 2+038, LT.
 STA. 2+041.5, LT.

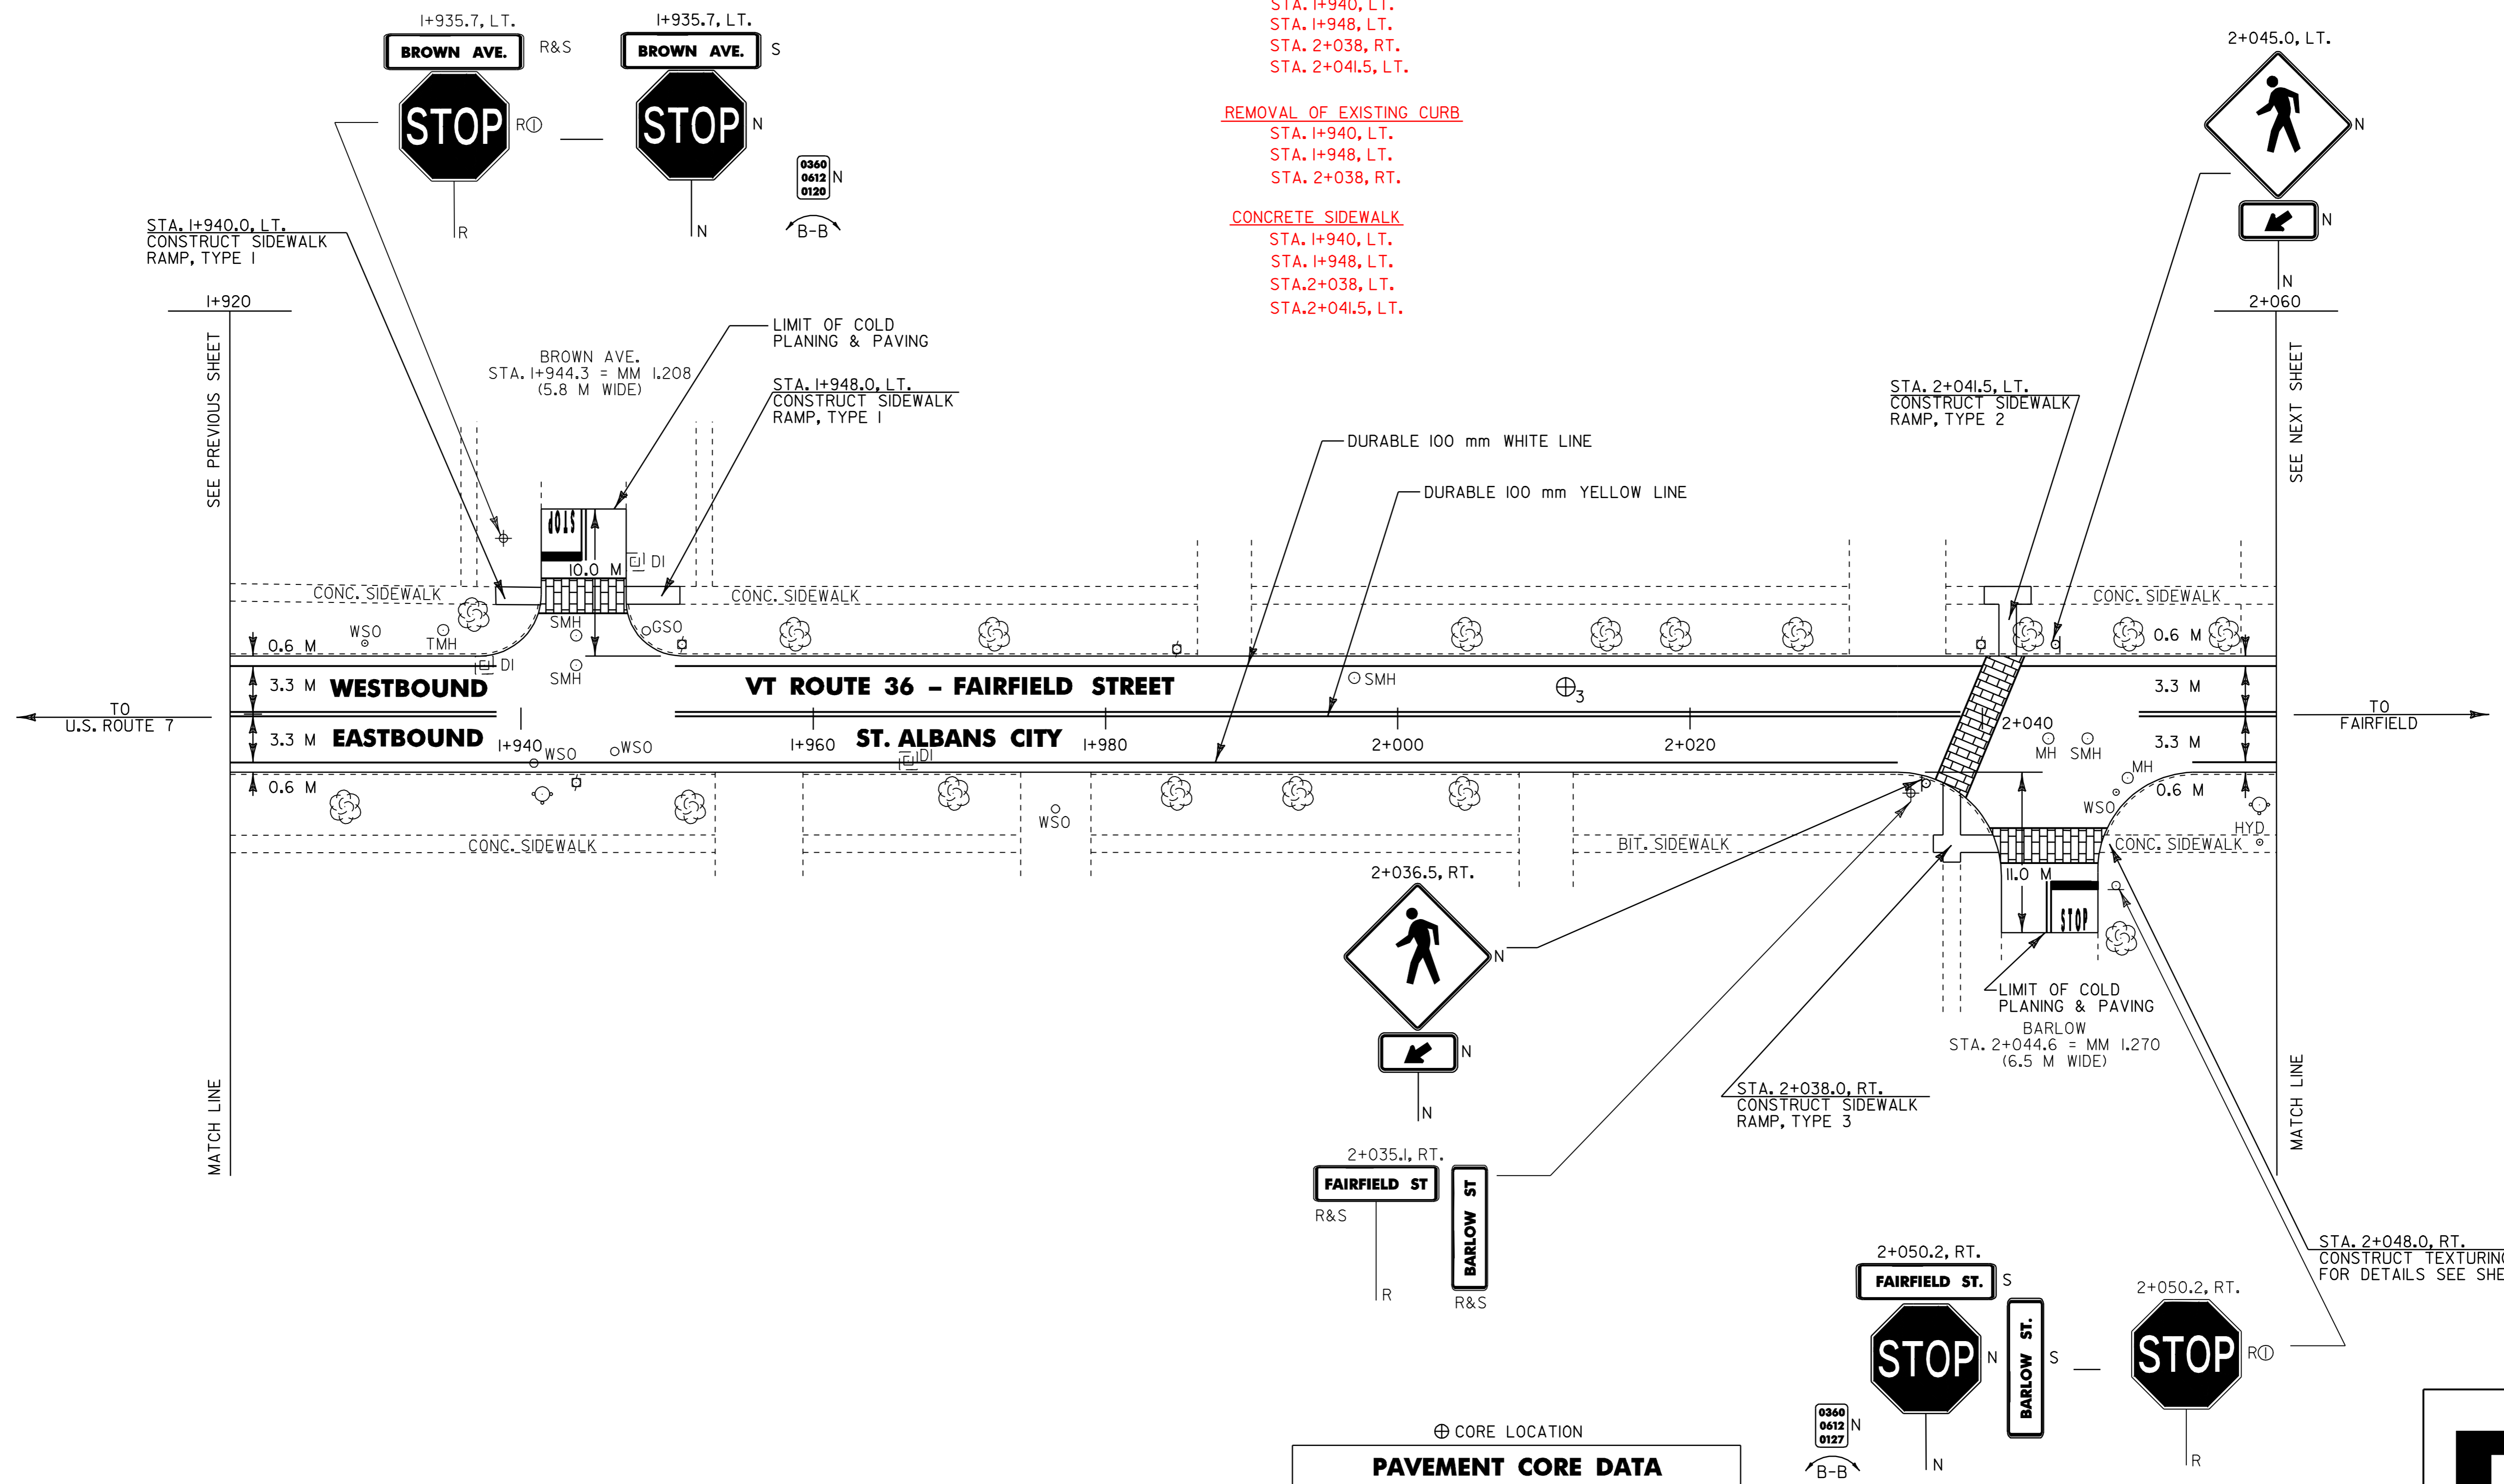

⊕ CORE LOCATION

PAVEMENT CORE DATA			
CORE #	LOCATION	DEPTH (mm)	PCC
3	2+011.7, LT.	114	YES

- NOTES:
- 1) ALL DIMENSIONS IN MILLIMETERS EXCEPT WHERE OTHERWISE INDICATED.
 - 2) ALL EXISTING SIGNS NOT SHOWN SHALL BE RETAINED AS DIRECTED BY THE RESIDENT ENGINEER.
 - 3) FOR ANY TOWN HIGHWAY OR STREET DETAILS, SEE VTRANS STANDARD E-193M.

PROJECT LAYOUT #5	PROJECT NAME: ST. ALBANS CITY	PLOT DATE: 01-FEB-2006 07:59
	PROJECT NUMBER: STP 2129(1)S	DRAWN BY: D-H
	FILE NAME: /pave/99d070/pd070.dgn	CHECKED BY:
	DESIGNED BY: D-H	SHEET 79 OF 105



~~TEMPORARY AND DURABLE 100 mm WHITE LINE~~
 STA. 2+060.0 TO 2+089.5, SOLID LT. & RT.

TEMPORARY AND DURABLE 100 mm YELLOW LINE
 STA. 2+060.0 TO 2+200.0, SOLID LT. & RT.
 (WITH CENTERLINE BREAKS FOR SMITH ST.
 AND BERKLEY TER.)
 STA. 2+097.6, LT. DOUBLE SOLID (SMITH ST.)
 STA. 2+184.5, LT. DOUBLE SOLID (BERKLEY TER.)

~~TEMPORARY AND DURABLE CROSSWALK MARKING W/DIAGONAL LINES (MOD.)~~
 STA. 2+097.6, LT.
 STA. 2+184.5, LT.

~~TEMPORARY AND DURABLE LETTER OR SYMBOL (TYPE I TAPE)~~
 STA. 2+097.6, LT. - "STOP"
 STA. 2+184.5, LT. - "STOP"

~~CHANGING ELEVATION OF DI'S, CB'S OR MH'S~~
 STA. 2+089.7, LT. - DI
 STA. 2+097.6, RT. - MH
 STA. 2+097.6, LT. - MH
 STA. 2+109.2, LT. - DI
 STA. 2+112.3, RT. - DI
 STA. 2+182.0, LT. - DI
 STA. 2+191.6, LT. - DI
 STA. 2+196.8, LT. - DI


~~ADJUST ELEVATION OF VALVE BOX~~
 STA. 2+100.1, LT. - WSO
 STA. 2+102.1, C. - WSO

~~ERECTING SALVAGED SIGNS~~
 AS SHOWN - 2

~~CHANGING ELEVATION OF SMH'S~~
 STA. 2+097.6, LT.
 STA. 2+186.0, RT.

~~REMOVING SIGNS~~
 AS SHOWN - 7

~~TEMPORARY AND DURABLE 600 mm STOP BAR (TYPE I TAPE)~~
 STA. 2+097.6, LT. (SMITH ST.)
 STA. 2+184.5, LT. (BERKLEY TER.)

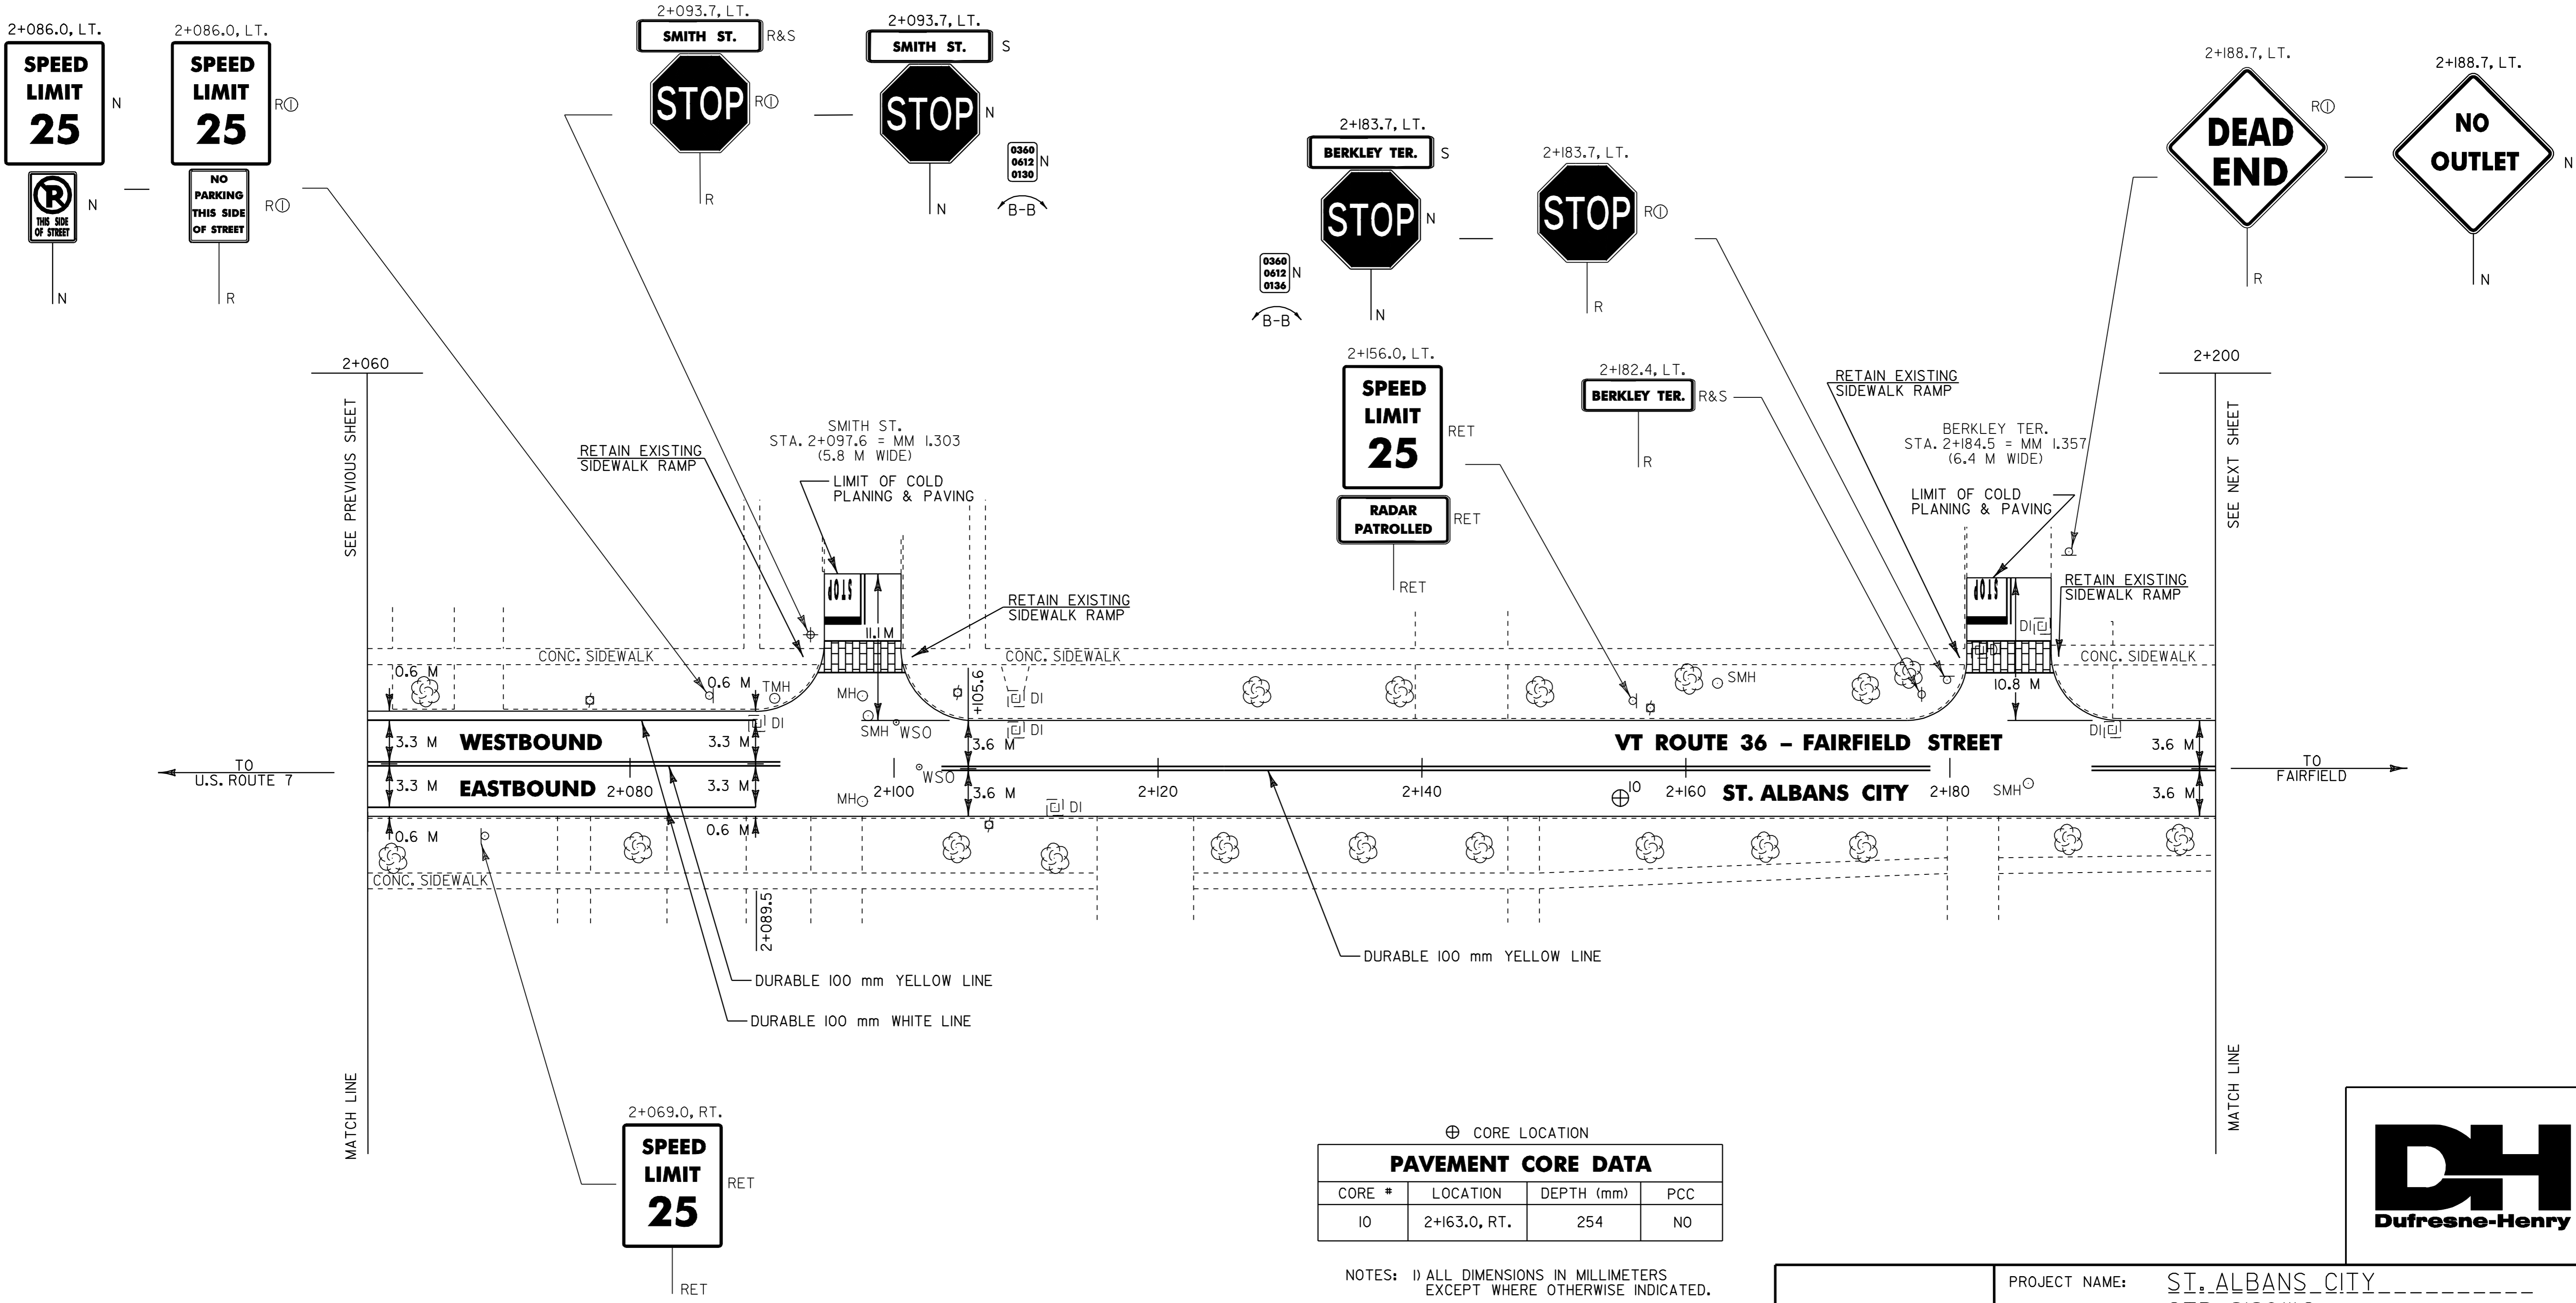

⊕ CORE LOCATION


PAVEMENT CORE DATA			
CORE #	LOCATION	DEPTH (mm)	PCC
10	2+163.0, RT.	254	NO

NOTES: 1) ALL DIMENSIONS IN MILLIMETERS EXCEPT WHERE OTHERWISE INDICATED.
 2) ALL EXISTING SIGNS NOT SHOWN SHALL BE RETAINED AS DIRECTED BY THE RESIDENT ENGINEER.
 3) FOR ANY TOWN HIGHWAY OR STREET DETAILS, SEE VTtrans STANDARD E-193M.

PROJECT LAYOUT #6

PROJECT NAME: ST. ALBANS CITY
 PROJECT NUMBER: STP 2129(1)S
 FILE NAME: zpqve299d070zpd070.dgn PLOT DATE: 01-FEB-2006 07:5
 PROJECT LEADER: JLL DRAWN BY: D-H
 DESIGNED BY: D-H CHECKED BY:
 IPARM FILE NAME: pd070p06.i SHEET 80 OF 105



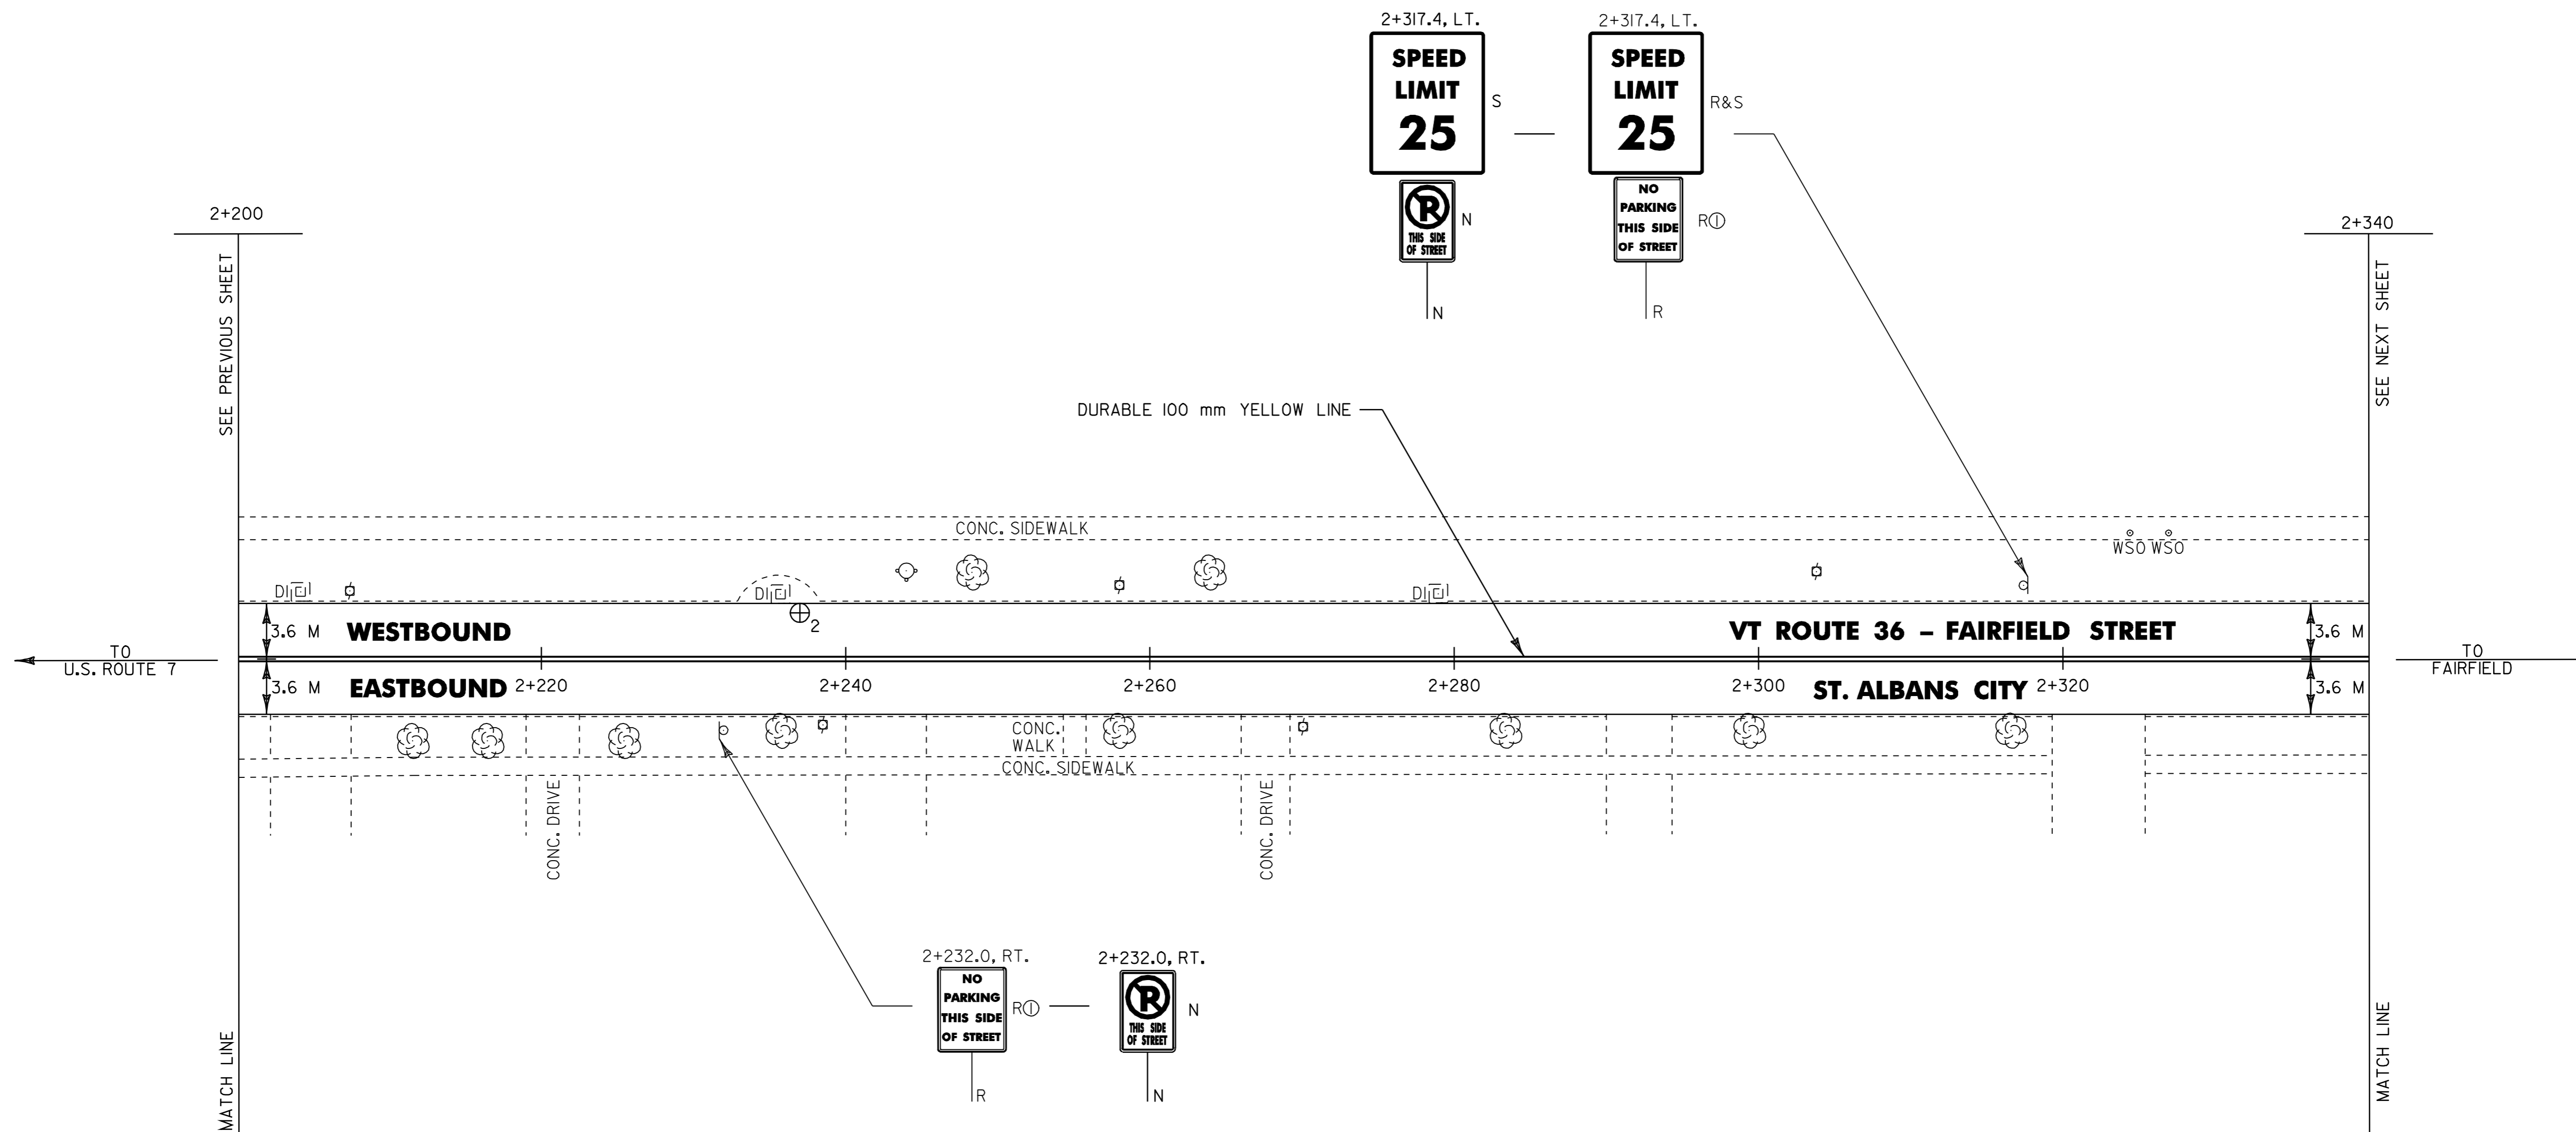

⊕ CORE LOCATION

PAVEMENT CORE DATA			
CORE #	LOCATION	DEPTH (mm)	PCC
2	2+237.0, LT.	159	YES

- NOTES:
- 1) ALL DIMENSIONS IN MILLIMETERS EXCEPT WHERE OTHERWISE INDICATED.
 - 2) ALL EXISTING SIGNS NOT SHOWN SHALL BE RETAINED AS DIRECTED BY THE RESIDENT ENGINEER.
 - 3) FOR ANY TOWN HIGHWAY OR STREET DETAILS, SEE VTrans STANDARD E-193M.

PROJECT LAYOUT #7	PROJECT NAME: ST. ALBANS CITY	PLOT DATE: 01-FEB-2006 07:5
	PROJECT NUMBER: STP_2129(1)S	DRAWN BY: D-H
	DESIGNED BY: D-H	CHECKED BY:
	IPARM FILE NAME: pd070p07.i	SHEET 81 OF 105




TEMPORARY AND DURABLE 100 mm YELLOW LINE
 STA. 2+340.0 TO 2+397.9, SOLID LT. & RT.
 (WITH CENTERLINE BREAKS FOR HOSPITAL)
 STA. 2+355.2, LT. DOUBLE SOLID (HOSPITAL)

TEMPORARY AND DURABLE 600 mm STOP BAR (TYPE ITAPE)
 STA. 2+355.2, LT. (PVT TO HOSPITAL)

TEMPORARY AND DURABLE LETTER OR SYMBOL (TYPE ITAPE)
 STA. 2+355.2, LT. - 'STOP'

TEMPORARY AND DURABLE CROSSWALK MARKING W/DIAGONAL LINES (MOD.)
 STA. 2+355.2, LT.

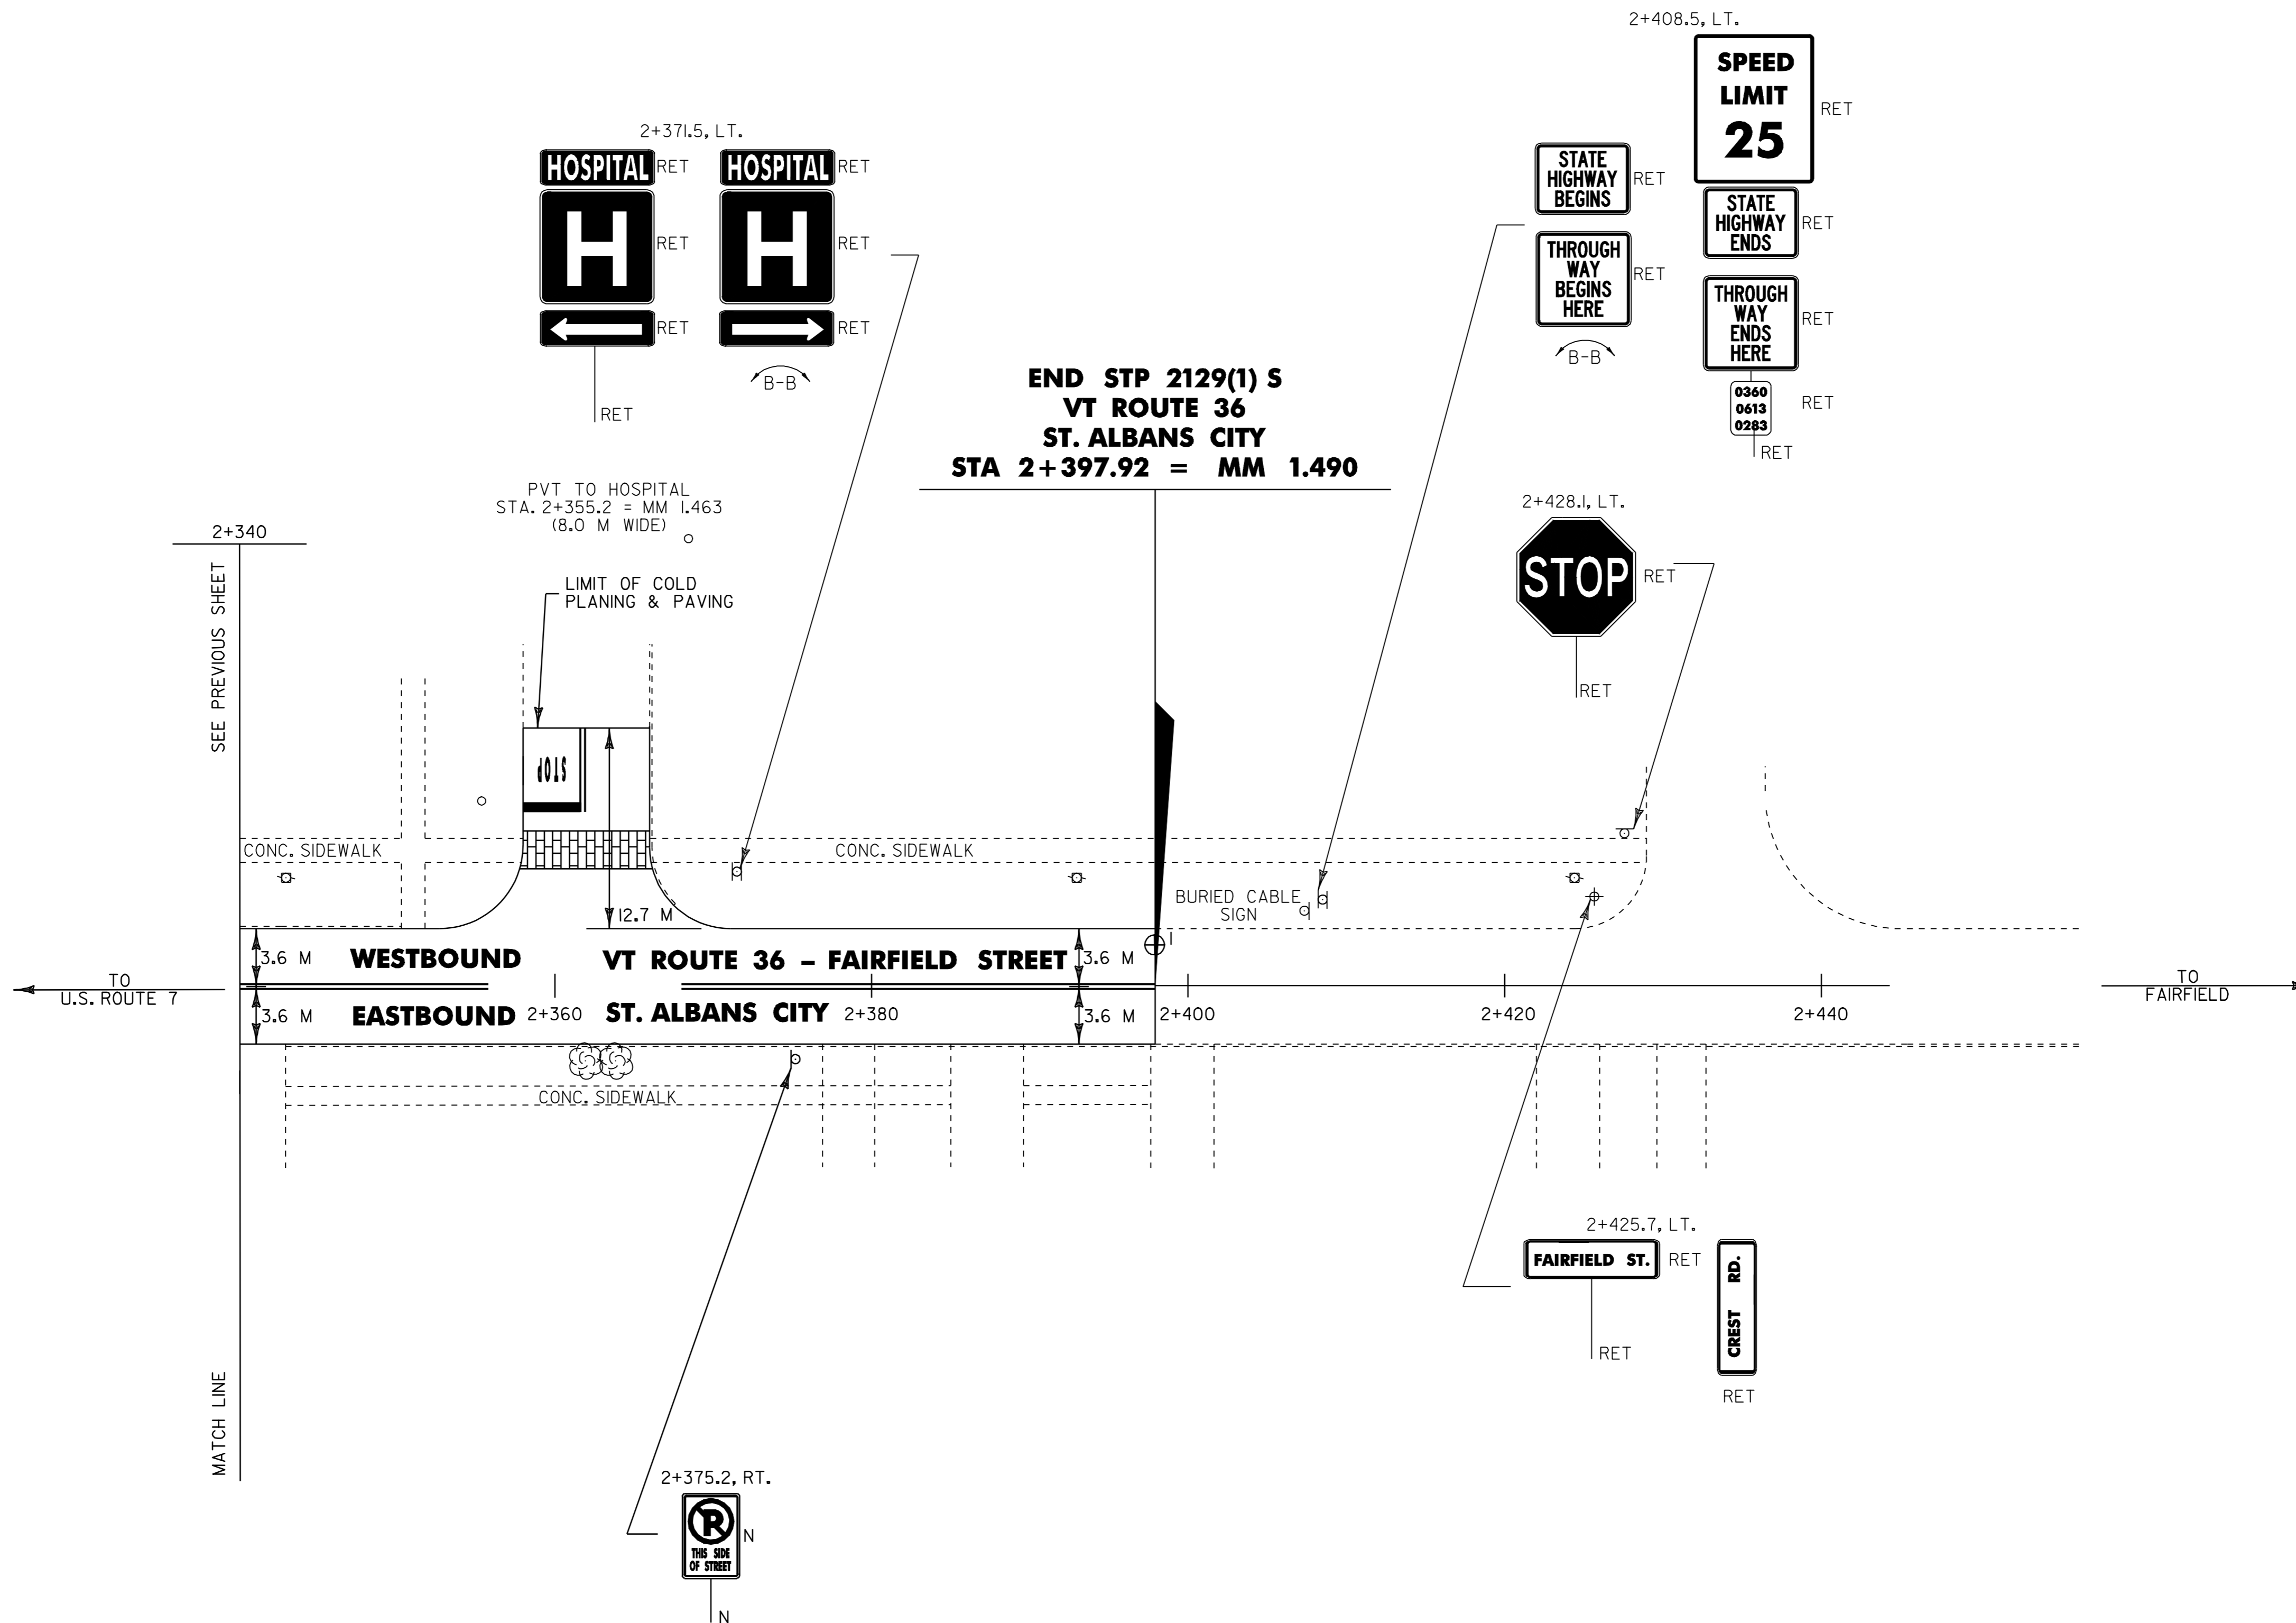

⊕ CORE LOCATION

PAVEMENT CORE DATA			
CORE #	LOCATION	DEPTH (mm)	PCC
1	2+397.9, LT.	171	YES

NOTES: 1) ALL DIMENSIONS IN MILLIMETERS EXCEPT WHERE OTHERWISE INDICATED.
 2) ALL EXISTING SIGNS NOT SHOWN SHALL BE RETAINED AS DIRECTED BY THE RESIDENT ENGINEER.
 3) FOR ANY TOWN HIGHWAY OR STREET DETAILS, SEE VTrans STANDARD E-193M.

PROJECT LAYOUT #8	PROJECT NAME: <u>ST. ALBANS CITY</u>	PLOT DATE: 01-FEB-2006 07:5
	PROJECT NUMBER: <u>STP_2129(1)S</u>	DRAWN BY: <u>D-H</u>
	DESIGNED BY: <u>D-H</u>	CHECKED BY: _____
	IPARM FILE NAME: <u>pd070p08.i</u>	SHEET <u>82</u> OF 105



KILOMETER MARKER, STATION, OR SIGN NUMBER	SIGN LEGEND	SIGN DIMENSIONS		NEW & SALVAGED SIGNS				EXIST POST RETAIN SALVAGE	NO. OF POSTS	NEW SIGN POSTS												REMARKS	SIGN DETAIL															
		EA	WIDTH (mm)	HEIGHT (mm)	"A"	"B"	SALV SIGN			SALV TIS	FLANGED CHANNEL			SQUARE STEEL (mm)			TUBULAR ALUMINUM Ø (mm)			TUBULAR STEEL Ø (mm)				W-SHAPE STEEL		DETAIL ON SHEET NUMBER	STD. SHEET NUMBER											
											kg/m	kg/m	kg/m	44	50	63	75	100	100 MOD	75	89		100	125	600 mm			750 mm	WEIGHT	POST SIZE								
OPTION ITEMS										* ANCHOR = 1 METER																												
VT ROUTE 36 I+420.6, LT.		I	1800	250	0.45																																	E-123M
		I	1800	250	0.45																																E-123M	
		I	1800	250	0.45																																E-123M	
		I	600	300	0.18																																E-136AM	
		I	600	600	0.36																																E-136AM	
		I	525	375	0.20																																E-136AM	
		I	600	600	0.36																																E-140M	
		I	600	300	0.18																															E-136BM		
		I	525	375	0.20																																E-136BM	
I+451.0, LT.		I	900	750	0.68																																E-145AM	
		I	750	750	0.56																																E-143M	
I+493.0, LT.		I	150	200	0.03																																E-138M	
		I	600	300	0.18																																	E-136BM
I+495.1, RT.		I	600	600	0.36																																E-136BM	
		I	600	300	0.18																																	E-136BM
I+505.0, RT.		I	750	750	0.56																																	E-143M
		I	150	200	0.03																																	E-138M
I+514.0, RT.		I	750	750	0.56																																	E-152M
		I	600	300	0.18																																	88
I+515.0, LT.		I	750	750	0.56																																E-152M	
		I	600	300	0.18																																	88
I+521.7, LT.		I	300	450	0.14																																	88

FINAL POST LENGTHS ARE TO BE DETERMINED IN THE FIELD. POST SIZES ARE COMPUTED BASED ON INFORMATION FURNISHED ON THE STANDARD SHEETS AND THE TRAFFIC & SAFETY DIVISION'S "SIGN POST DESIGN GUIDELINE."

TOTALS	m ²	m ²	EA.	m ²		m	m	m	m	m	m	EA	kg	kg	kg	kg	kg	kg	kg	EA.	EA.	kg
	9.03					27.6	27.6	16.7	6.0	22.7	27.6											

PROJECT: ST. ALBANS CITY	PROJECT NO.: STP 2129(I)S
DESIGN FILE NAME: /pave/99d070/pd070.dgn	PLOT DATE: 01-FEB-2006 0
IPARM FILE NAME: pd070+01.l	SURVEY DATE: 09/98
SURVEYED BY: D-H	DRAWN BY: D-H
DESIGNED BY: D-H	SHEET: 83 OF 105












KILOMETER MARKER, STATION, OR SIGN NUMBER	SIGN LEGEND	SIGN DIMENSIONS EA WIDTH (mm) HEIGHT (mm)		NEW & SALVAGED SIGNS				EXIST POST RE SALV AGE	NO. OF POSTS	NEW SIGN POSTS																REMARKS	SIGN DETAIL						
				"A"	"B"	SALV SIGN	SALV TIS			FLANGED CHANNEL			SQUARE STEEL (mm)			TUBULAR ALUMINUM (mm)			TUBULAR STEEL (mm)				W-SHAPE STEEL		DETAIL ON SHEET NUMBER		STD. SHEET NUMBER						
										1.7	3.0	4.5	44	50	63	75	100	100 MOD	75	89	100	125	FTG. SIZE	WEIGHT				POST SIZE					
OPTION ITEMS										* ANCHOR = 1 METER																							
I+534.2, RT.		I	300	450	0.14				I		X		2.8			1.0															88		
I+547.5, RT.		I	300	450	0.14				I		X		2.7			1.0															88		
I+575.0, RT.		I	300	450	0.14				I		X		2.6			1.0															88		
I+586.0, RT.		I	750	750	0.56				I		X		3.0			1.0															E-152M		
		I	600	300	0.18																											88	-
I+596.0, LT.		I	750	750	0.56				I		X		3.2			1.0																E-152M	
		I	600	300	0.18																											88	
I+605.8, RT.		I	300	450	0.14				I		X		2.6			1.0																88	
I+630.0, LT.		I	300	450	0.14				I		X		2.6			1.0																88	
I+633.2, LT.		I	300	450	0.14				I		X		2.6			1.0																88	
I+641.5, RT.		I	300	450	0.14				I		X		2.9			1.0																88	
		I	300	450	0.14																												88
I+650.4, LT.		I	900	300	0.27				I		X		2.1			1.0																E-142M	









FINAL POST LENGTHS ARE TO BE DETERMINED IN THE FIELD. POST SIZES ARE COMPUTED BASED ON INFORMATION FURNISHED ON THE STANDARD SHEETS AND THE TRAFFIC & SAFETY DIVISION'S "SIGN POST DESIGN GUIDELINE."

	m	m	m	m	EA	kg	kg	kg	kg	kg	kg	kg	kg	EA.	EA.	kg
TOTALS	m ²	m ²	EA.	m ²	m	m	kg	EA.	kg	EA.	EA.	kg				
	2.87				46.0	46.0	37.1									

PROJECT:	PROJECT NO.:
DESIGN FILE NAME: /pave/99d070/pd070.dgn	PLOT DATE: 01-FEB-2006
IPARM FILE NAME: pd070+02.i	SURVEY DATE: 09/98
SURVEYED BY: D-H	DRAWN BY: D-H
DESIGNED BY: D-H	SHEET: 84 OF 105

TRAFFIC SIGN SUMMARY SHEET

KILOMETER MARKER, STATION, OR SIGN NUMBER	SIGN LEGEND	SIGN DIMENSIONS		NEW & SALVAGED SIGNS				EXIST POST RETAIN	NO. OF POSTS	NEW SIGN POSTS												REMARKS	SIGN DETAIL									
		EA	WIDTH (mm)	HEIGHT (mm)	"A"	"B"	SALV SIGN			SALV TIS	FLANGED CHANNEL			SQUARE STEEL (mm)			TUBULAR ALUMINUM Ø (mm)			TUBULAR STEEL Ø (mm)				W-SHAPE STEEL		FRAMING SIGN	REQUIRED	DETAIL ON SHEET NUMBER	STD. SHEET NUMBER			
											1.7	3.0	4.5	44	50	63	75	100	100 MOD	75	89		100	125	FTG. SIZE					WEIGHT	POST SIZE	
																									kg/m							kg/m
OPTION ITEMS * ANCHOR = 1 METER																																
VT ROUTE 36		1	750	750	0.56				1		X		3.3		1.0																E-152M	
I+663.0, LT.		1	600	300	0.18				1		X		X																88			
I+667.0, RT.	LINCOLN AVE.  0360 0612 0104	1	750	750	0.56				1		X		2.9		1.0																NEW STOP SIGN AND MILEMARKER MOUNTED BACK TO BACK. SALVAGED STREET SIGN INSTALLED 150 mm ABOVE THE 'STOP' SIGN USING POST TOP MOUNTING BRACKET ON NEW POST.	
		1	150	200	0.03				1		X		X																		E-143M E-138M	
I+668.0, RT.		1	750	750	0.56				1		X		3.0		1.0																E-152M	
		1	600	300	0.18				1		X		X																	88		
I+674.7, LT.		1	300	450	0.14				1		X		2.6		1.0																88	
I+685.7, RT.		1	300	450	0.14				1		X		2.7		1.0																88	
I+726.0, LT.	SPEED LIMIT 25	1	600	750	0.45				1		X		3.0		1.0																E-142	
I+783.0, LT.	HIGH ST.  0360 0612 0111	1	750	750	0.56				1		X		2.8		1.0																NEW STOP SIGN AND MILEMARKER MOUNTED BACK TO BACK. SALVAGED STREET SIGN INSTALLED 150 mm ABOVE THE 'STOP' SIGN USING POST TOP MOUNTING BRACKET ON NEW POST.	
		1	150	200	0.03				1		X		X																		E-143M E-138M	
I+805.9, RT.		1	300	450	0.14				1		X		2.7		1.0																88	
I+837.9, LT.	SPEED LIMIT 25 	1	600	750	0.45				1		X		3.3		1.0																E-142M	
		1	300	450	0.14				1		X		X																		88	
I+909.7, RT.		1	300	450	0.14				1		X		2.5		1.0																88	


KILOMETER MARKER, STATION, OR SIGN NUMBER	SIGN LEGEND	SIGN DIMENSIONS		NEW & SALVAGED SIGNS				EXIST POST RETAI N SALVAGE	NO. OF POSTS	NEW SIGN POSTS																	REQUIRE D S I G N E	REMARKS	SIGN DETAIL																		
		E A	WIDTH (mm)	HEIGHT (mm)	"A"	"B"	SALV SIGN			SALV TIS	FLANGED CHANNEL			SQUARE STEEL (mm)			TUBULAR ALUMINUM Ø (mm)			TUBULAR STEEL Ø (mm)				W-SHAPE STEEL					DETAIL ON SHEET NUMBER	STD. SHEET NUMBER																	
											kg/m	kg/m	kg/m	44	50	63	75	100	100 MOD	FOUND- ATION			FTG. SIZE		WEIGHT	POST SIZE																					
OPTION ITEMS * ANCHOR = 1 METER																																															
VT ROUTE 36 1+917.0, LT.			300	450	0.14																					MOUNT NEW SIGN ON EXISTING POST UNDER EXISTING SPEED LIMIT SIGN.	88																				
1+935.7, LT.	BROWN AVE.  0360 0612 0120																									NEW STOP SIGN AND MILEMARKER MOUNTED BACK TO BACK. SALVAGED STREET SIGN INSTALLED 150 mm ABOVE THE 'STOP' SIGN USING POST TOP MOUNTING BRACKET ON NEW POST.	-	-																			
			750	750	0.56					X		2.8		1.0																																	
2+036.5, RT.																																															
			750	750	0.56					X		3.3		1.0																																	
2+045.0, LT.																																															
			750	750	0.56					X		3.2		1.0																																	
2+050.2, RT.	FAIRFIELD ST. BARLOW ST.  0360 0612 0127																									NEW STOP SIGN AND MILEMARKER MOUNTED BACK TO BACK. SALVAGED STREET SIGN INSTALLED 90° TO EACH OTHER, 150 mm ABOVE THE 'STOP' SIGNS USING POST TOP MOUNTING BRACKET ON NEW POST.	-	-																			
			750	750	0.56					X		2.7		1.0																																	
2+086.0, LT.	SPEED LIMIT 25 																																														
			600	750	0.45					X		3.2		1.0																																	
2+093.7, LT.	SMITH ST.  0360 0612 0130																									NEW STOP SIGN AND MILEMARKER MOUNTED BACK TO BACK. SALVAGED STREET SIGN INSTALLED 150 mm ABOVE THE 'STOP' SIGN USING POST TOP MOUNTING BRACKET ON NEW POST.	-	-																			
			750	750	0.56					X		2.8		1.0																																	
2+183.7, LT.	BERKLEY TER.  0360 0612 0136																									NEW STOP SIGN AND MILEMARKER MOUNTED BACK TO BACK. SALVAGED STREET SIGN INSTALLED 150 mm ABOVE THE 'STOP' SIGN USING POST TOP MOUNTING BRACKET ON NEW POST.	-	-																			
			750	750	0.56					X		2.8		1.0																																	

FINAL POST LENGTHS ARE TO BE DETERMINED IN THE FIELD. POST SIZES ARE COMPUTED BASED ON INFORMATION FURNISHED ON THE STANDARD SHEETS AND THE TRAFFIC & SAFETY DIVISION'S "SIGN POST DESIGN GUIDELINE."

TOTALS	m ²	m ²	EA.	m ²				m	m	m	m	EA.	kg	kg	kg	kg	kg	kg	EA.	EA.	kg
	4.57		5		32.2			32.2	32.2	20.8	1.0										

PROJECT: ST. ALBANS CITY	PROJECT NO. : STP 2129(I)S
DESIGN FILE NAME: /pave/99d070/pd070.dgn	PLOT DATE: 01-FEB-2006 0
IPARM FILE NAME: pd070+04.I	SURVEY DATE: 09/98
SURVEYED BY: D-H	DRAWN BY: D-H
DESIGNED BY: D-H	SHEET: 86 OF 105

KILOMETER MARKER, STATION, OR SIGN NUMBER	SIGN LEGEND	SIGN DIMENSIONS		NEW & SALVAGED SIGNS				EXIST POST RETAIN	SALVAGED	NO. OF POSTS	NEW SIGN POSTS																REMARKS	SIGN DETAIL													
		EA	WIDTH (mm)	HEIGHT (mm)	"A"	"B"	SALV SIGN				SALV TIS	FLANGED CHANNEL		SQUARE STEEL (mm)			TUBULAR ALUMINUM Ø (mm)			TUBULAR STEEL Ø (mm)				W-SHAPE STEEL		DETAIL ON SHEET NUMBER		STD. SHEET NUMBER													
												1.7	3.0	4.5	44	50	63	75	100	100 MOD	FOUND-ACTION	75	89	100	125				FTG. SIZE	WEIGHT	POST SIZE										
OPTION ITEMS												* ANCHOR = 1 METER																													
2+188.7, LT.		1	750	750	0.56					1		X		3.0	X		1.0																							88	
2+232.0, RT.		1	300	450	0.14					1		X		2.4	X		1.0																						88		
2+317.4, LT.												X		3.0	X		1.0																						-	-	
		1	300	450	0.14					1		X																											88		
2+375.2, RT.		1	300	450	0.14					1		X		2.5	X		1.0																							88	
TOTALS					0.98									10.9			4.0																								
														14.9																											
SHEET 83 TOTALS					9.03								27.6	27.6	22.7																										
SHEET 84 TOTALS					2.87							46.0	46.0	37.1																											
SHEET 85 TOTALS					4.26							46.0	46.0	38.8																											
SHEET 86 TOTALS					4.57				5			32.2	32.2	27.8																											
SHEET 87 TOTALS					0.98				1			18.4	18.4	14.9																											
SUBTOTALS					21.71				8			170.2	170.2	141.3																											
ROUNDING					-0.29				-			3.8	3.8	0																											

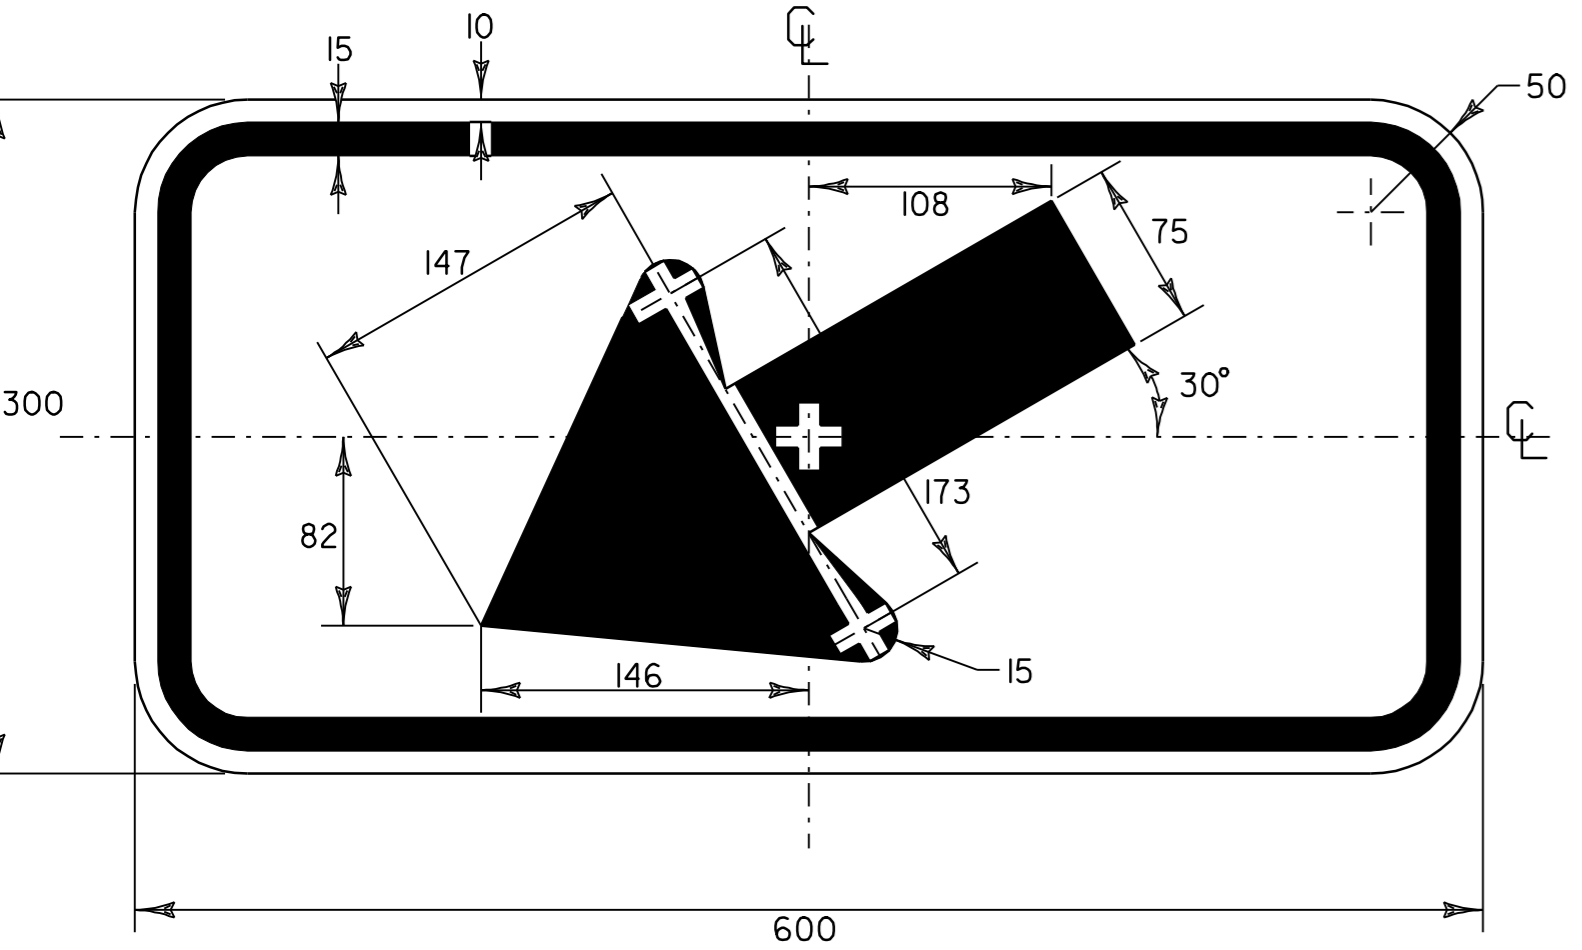


W16-7L


BLACK BORDER & SYMBOL
WITH REFLECTORIZED YELLOW BACKGROUND
SEE VTrans STANDARD E-153M FOR MATERIALS

LOCATIONS

- VT ROUTE 36 STA. 1+514.0, RT.
- VT ROUTE 36 STA. 1+515.0, LT.
- VT ROUTE 36 STA. 1+586.0, RT.
- VT ROUTE 36 STA. 1+596.0, LT.
- VT ROUTE 36 STA. 1+663.0, LT.
- VT ROUTE 36 STA. 1+668.0, RT.
- VT ROUTE 36 STA. 2+036.5, RT.
- VT ROUTE 36 STA. 2+045.0, LT.

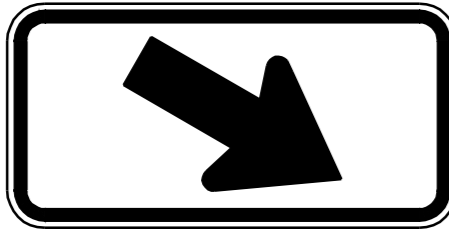


W16-7R

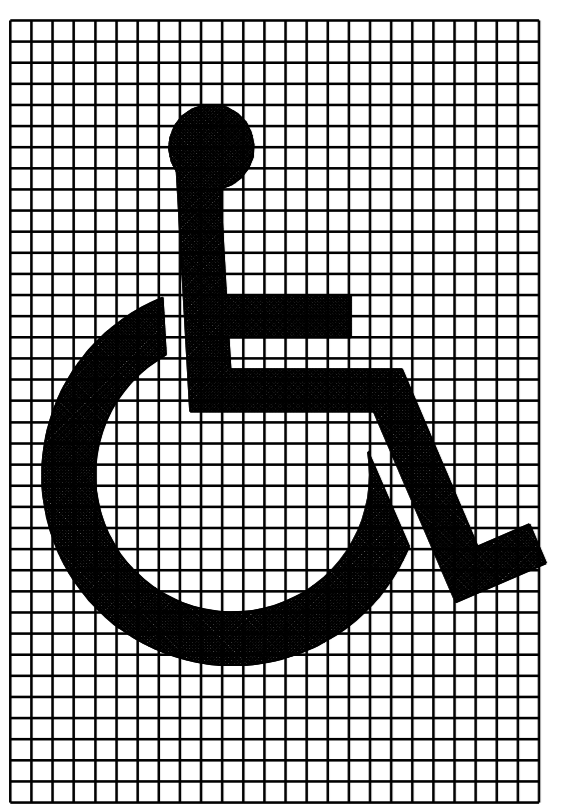

GREEN LEGEND AND BORDER WITH WHITE (REFL.) BACKGROUND
WHITE SYMBOL ON BLUE BACKGROUND
SEE VTrans STANDARD E-143M FOR MATERIALS

LOCATIONS


- VT ROUTE 36 - STA. 1+521.7, LT.
- VT ROUTE 36 - STA. 1+630.0, LT.

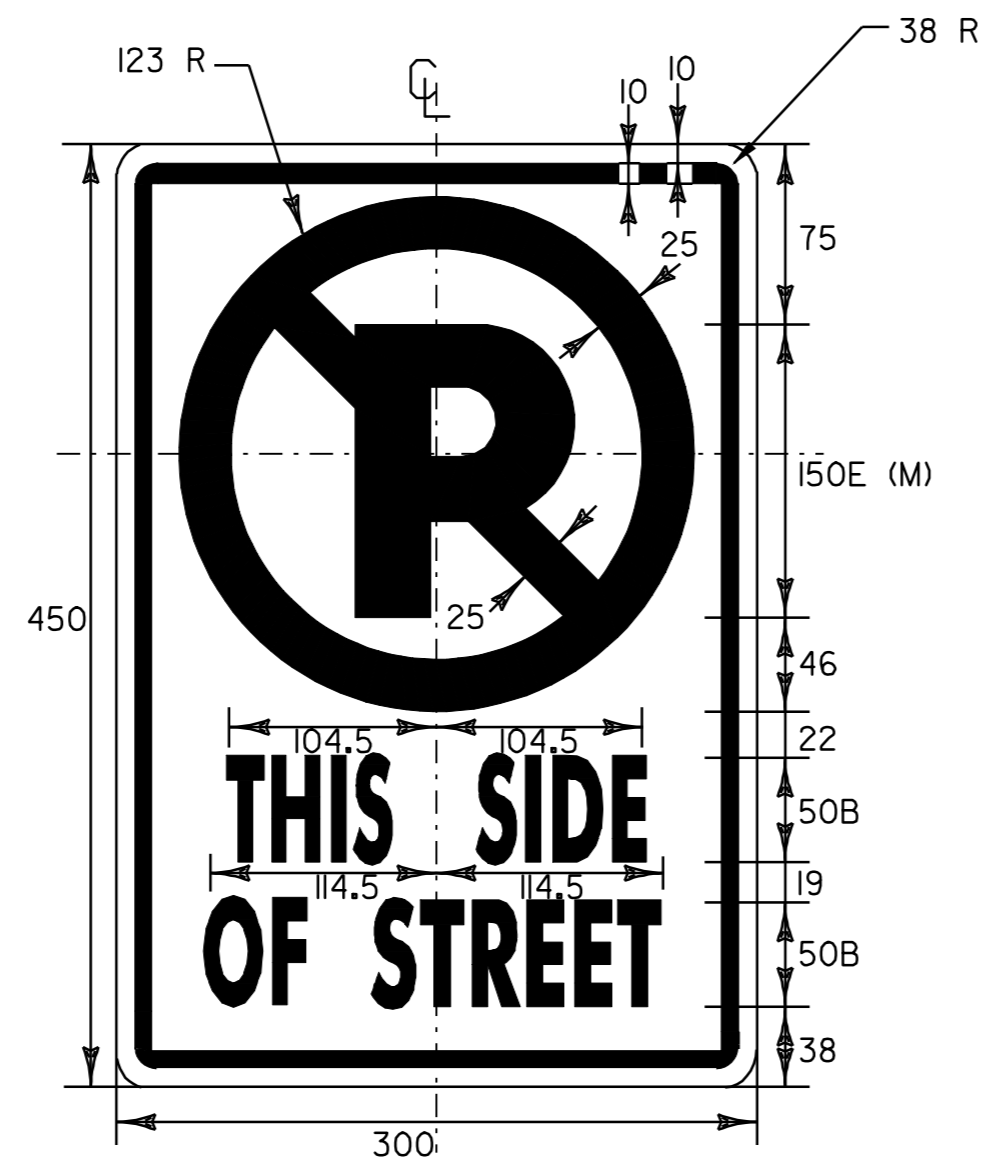

RED (REFL.) LEGEND AND BORDER
WHITE (REFL.) BACKGROUND
BLACK "P"
SEE VTrans STANDARD E-143M FOR MATERIALS

LOCATIONS

- VT ROUTE 36 - STA. 1+674.7, LT.
- VT ROUTE 36 - STA. 1+685.7, RT.
- VT ROUTE 36 - STA. 1+805.9, RT.
- VT ROUTE 36 - STA. 1+837.9, LT.
- VT ROUTE 36 - STA. 1+909.7, RT.
- VT ROUTE 36 - STA. 1+917.0, LT.
- VT ROUTE 36 - STA. 2+086.0, LT.
- VT ROUTE 36 - STA. 2+232.0, RT.
- VT ROUTE 36 - STA. 2+317.4, LT.
- VT ROUTE 36 - STA. 2+375.2, RT.

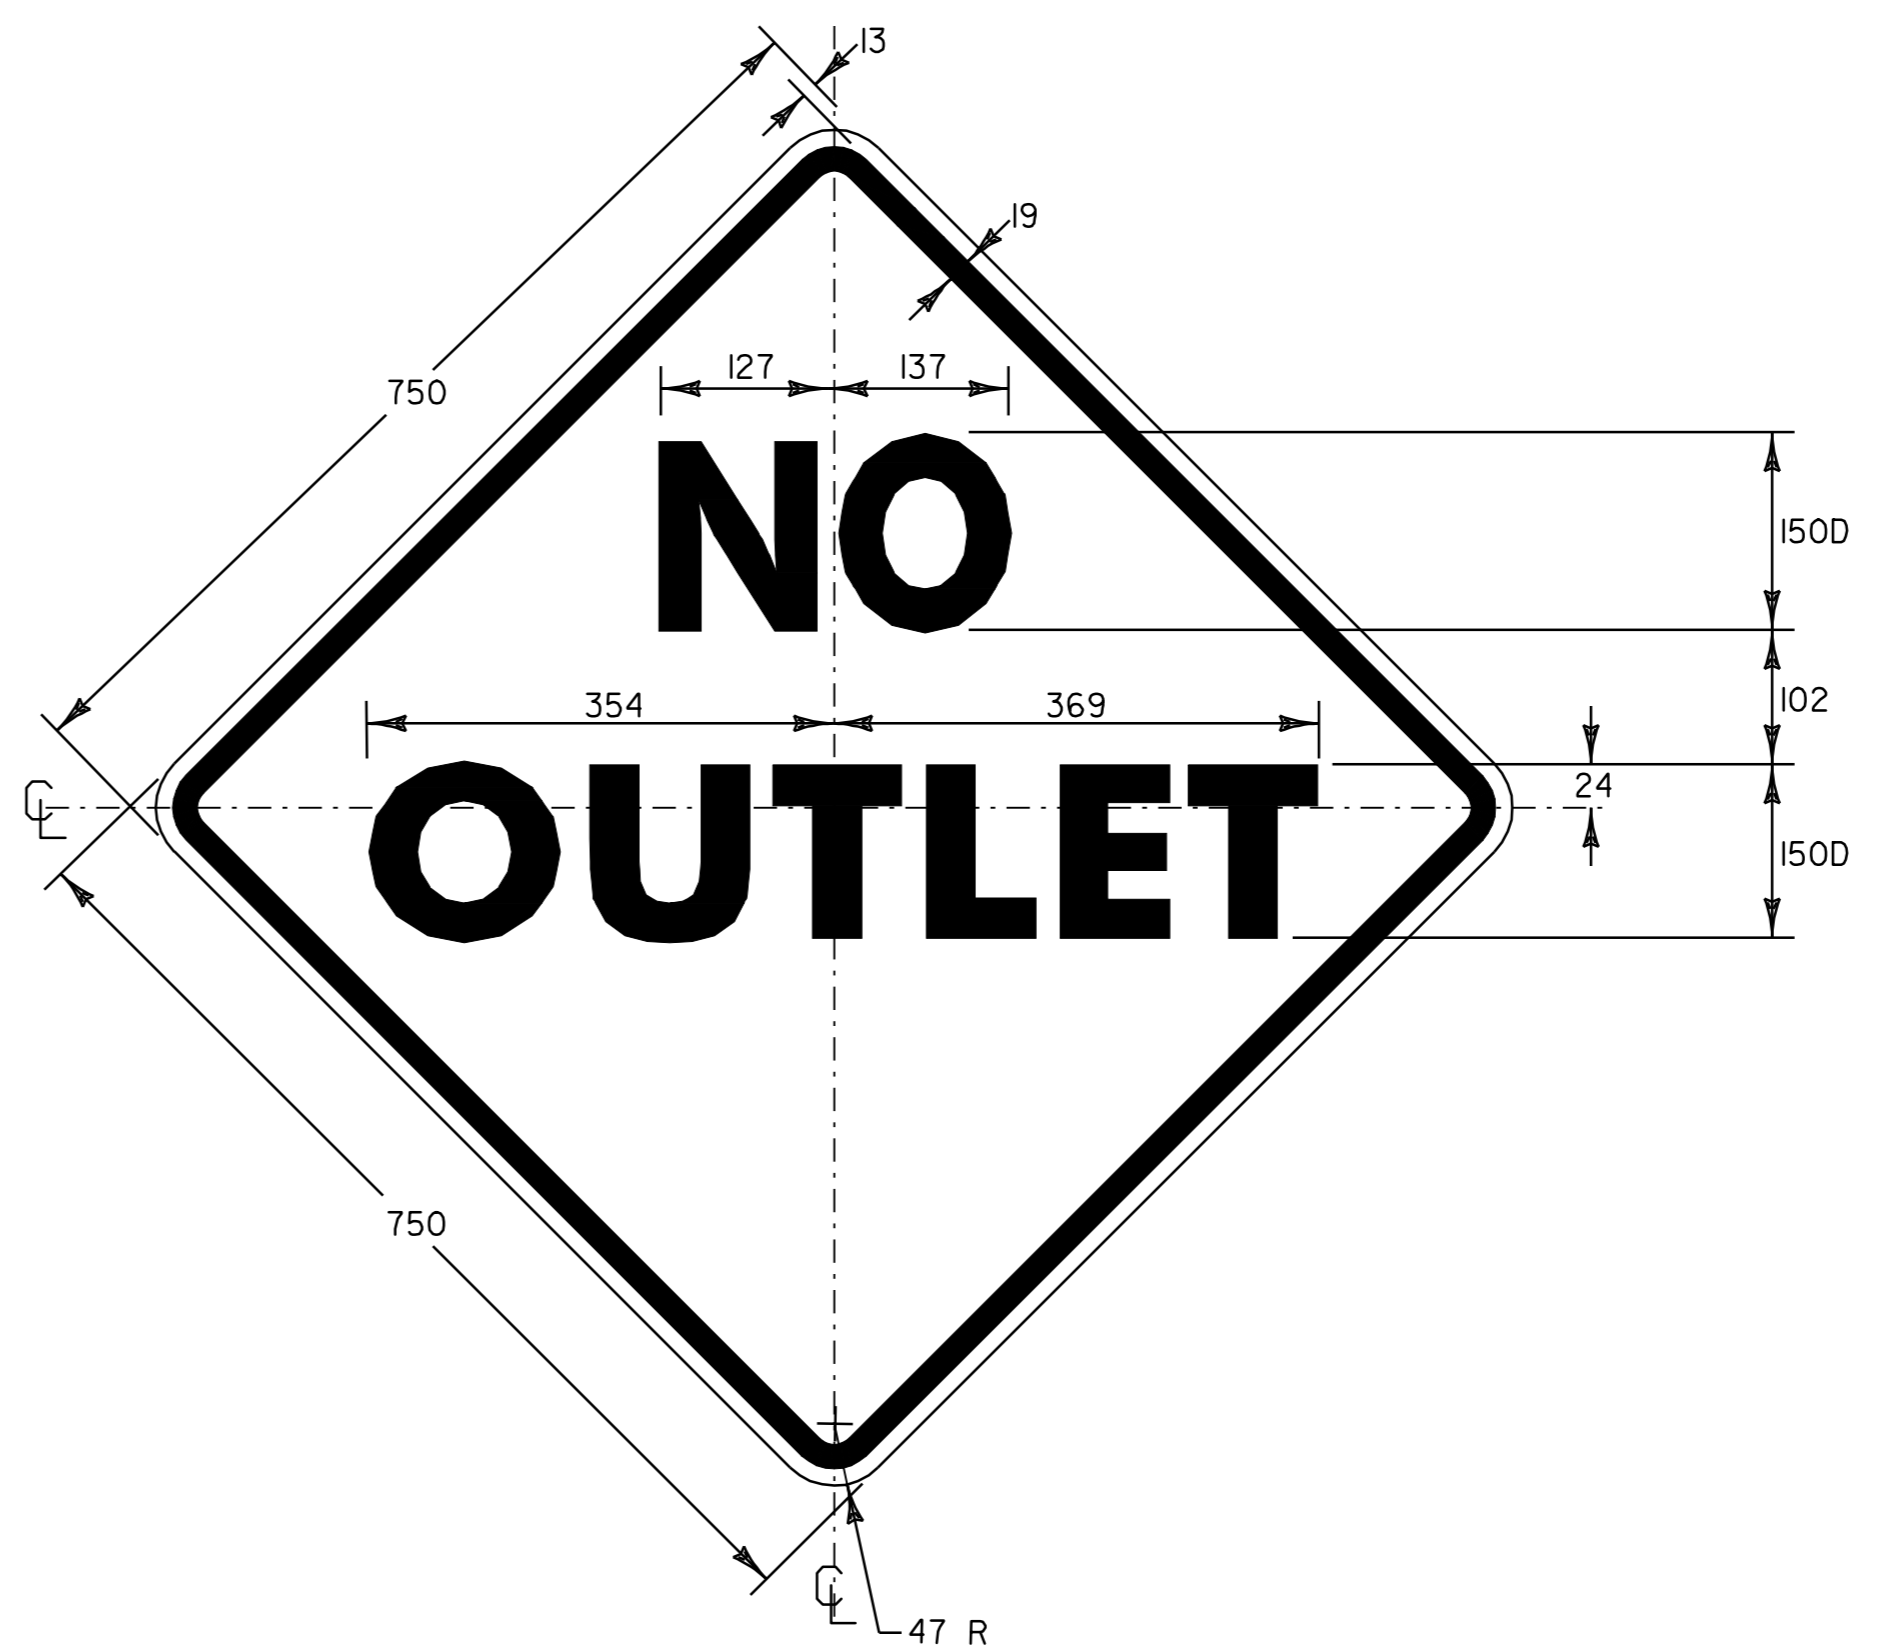


W14-2

BLACK BORDER & TEXT
WITH REFLECTORIZED YELLOW BACKGROUND
SEE VTrans STANDARD E-152M FOR MATERIALS

LOCATIONS



- VT ROUTE 36 - STA. 2+188.7, LT.

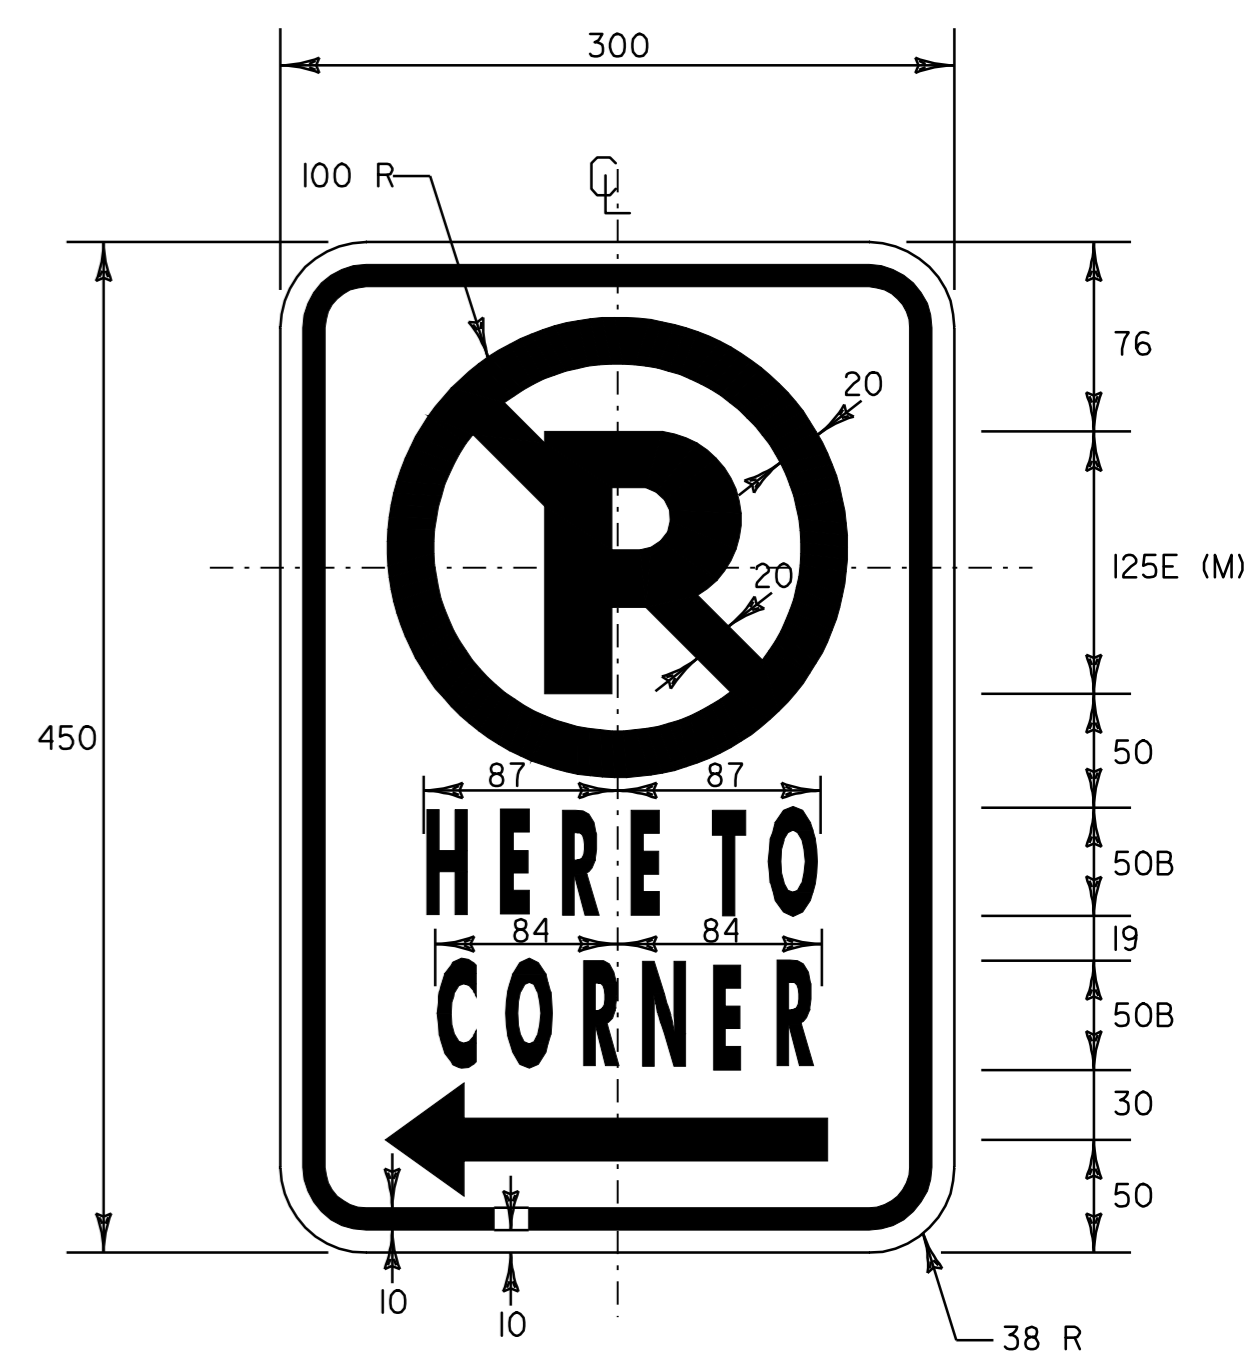

RED (REFL.) LEGEND, BORDER AND ARROW
WHITE (REFL.) BACKGROUND
BLACK "P"
SEE VTrans STANDARD E-143M FOR MATERIALS

LOCATIONS


- VT ROUTE 36 - STA. 1+633.2, LT.
- VT ROUTE 36 - STA. 1+641.5, RT.

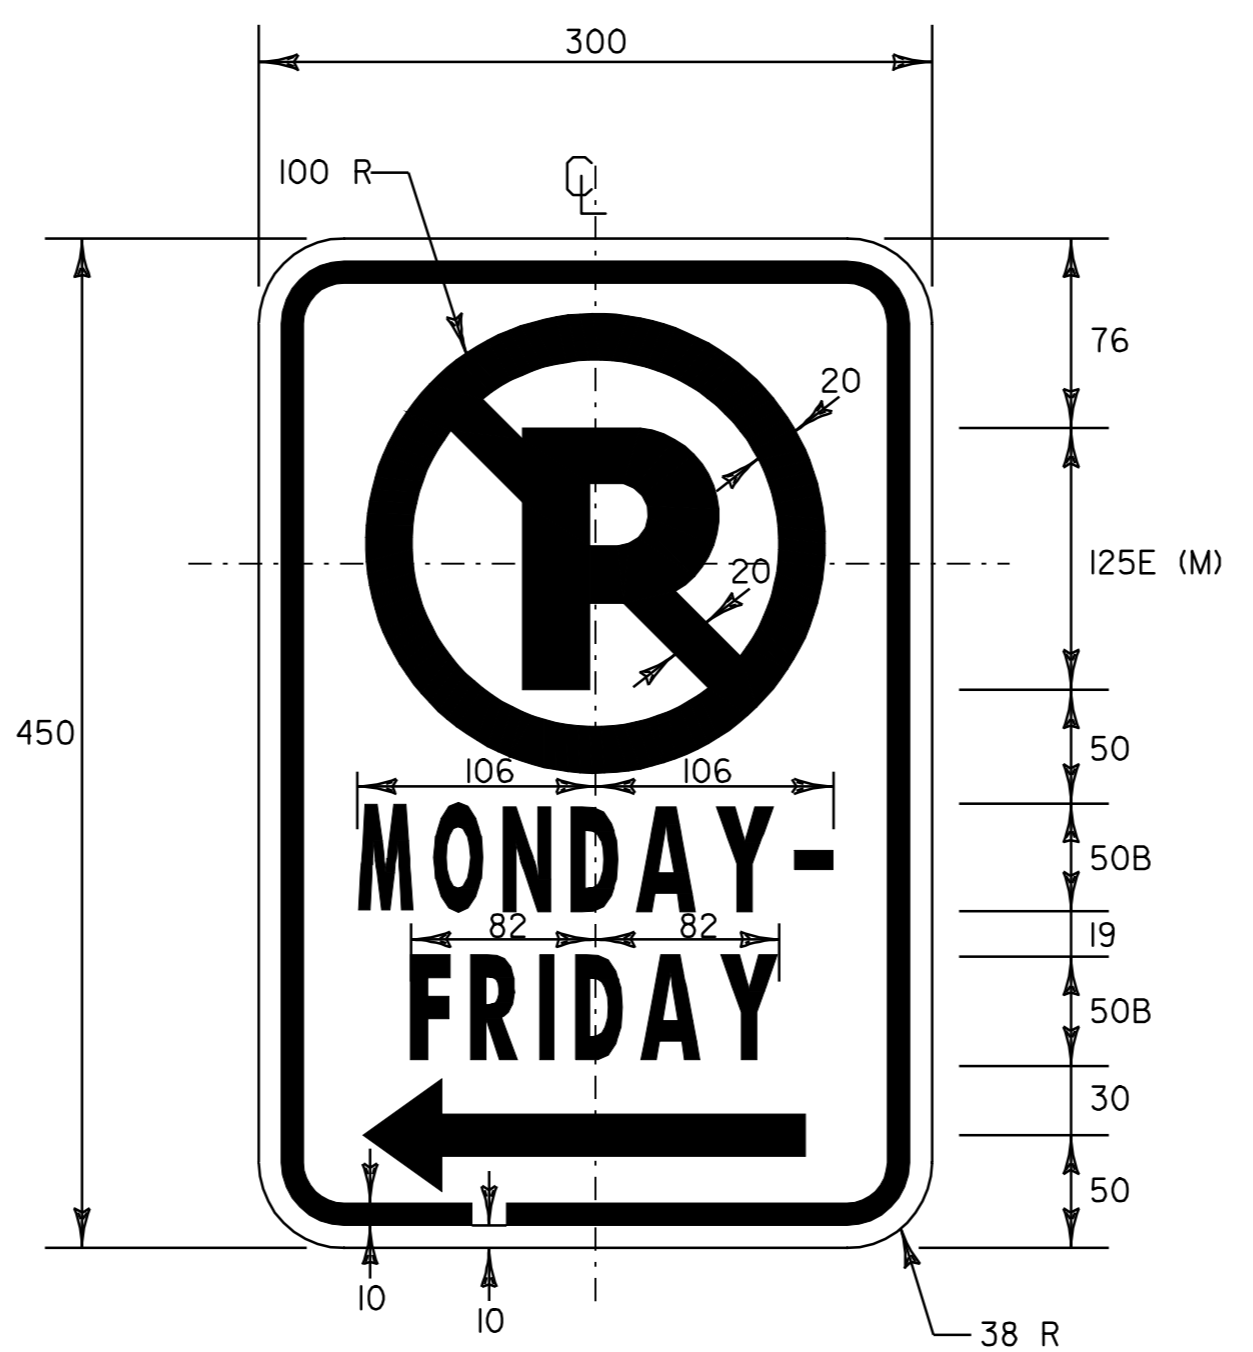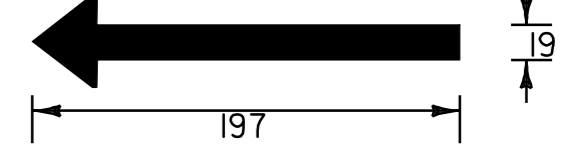

RED (REFL.) LEGEND, BORDER AND ARROW
WHITE (REFL.) BACKGROUND
BLACK "P"
SEE VTrans STANDARD E-143M FOR MATERIALS

LOCATIONS


- VT ROUTE 36 - STA. 1+534.2, RT.
- VT ROUTE 36 - STA. 1+641.5, RT.

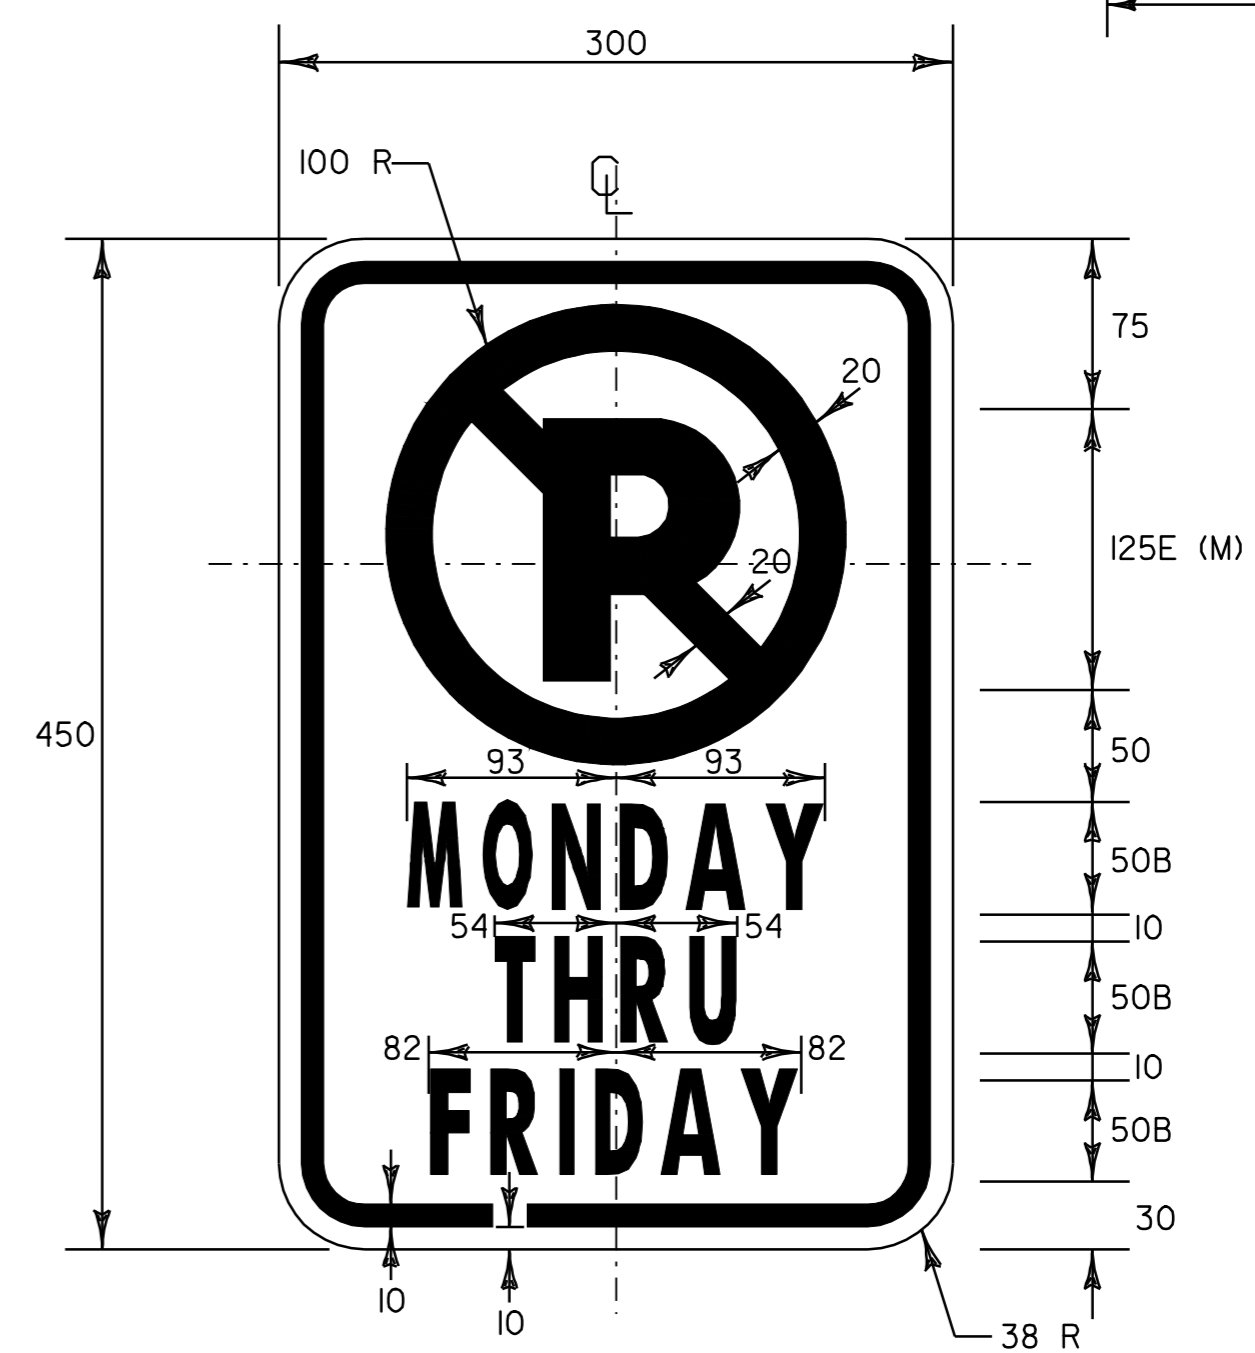

RED (REFL.) LEGEND, BORDER AND ARROW
WHITE (REFL.) BACKGROUND
BLACK "P"
SEE VTrans STANDARD E-143M FOR MATERIALS


LOCATIONS

- VT ROUTE 36 - STA. 1+547.5, RT.
- VT ROUTE 36 - STA. 1+575.0, RT.
- VT ROUTE 36 - STA. 1+605.8, RT.

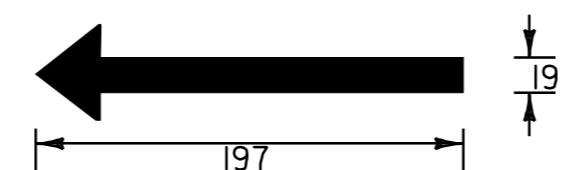

NOTE:
ALL DIMENSIONS IN MILLIMETERS
EXCEPT WHERE OTHERWISE INDICATED

TRAFFIC SIGN DETAILS	PROJECT NAME: ST. ALBANS CITY	PLOT DATE: 01-FEB-2006 07:5
	PROJECT NUMBER: STP 2129(1)S	DRAWN BY: D-H
	FILE NAME: /pave/99d070/pd070.dgn	CHECKED BY: D-H
	DESIGNED BY: D-H	SHEET 88 OF 105
	IPARM FILE NAME: pd070+06.1	

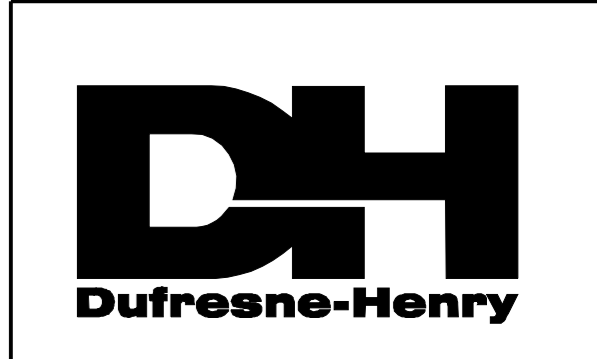

UTILITY LOCATIONS*
(FOR INFORMATIONAL PURPOSES ONLY)

STATION	POSITION	DESCRIPTION
VT ROUTE 36 - FAIRFIELD STREET		
I+476.8	CL	SMH
I+478.3	LT	MH
I+478.3	LT	DI
I+480.0	RT	DI
I+487.4	LT	TMH
I+498.4	LT	SMH
I+498.6	LT	DI
I+507.3	LT	DI
I+507.8	RT	MH
I+507.8	RT	WSO - (3)
I+513.4	LT	DI
I+515.9	RT	DI
I+520.0	RT	DI
I+649.0	LT	DI
I+657.9	CL	SMH
I+660.0	LT	GSO - (IN GREENBELT)
I+661.5	RT	WSO - (4)
I+664.3	LT	MH
I+664.3	LT	DI
I+667.2	RT	DI
I+778.7	LT & RT	DI - (2)
I+785.8	RT	WSO - (3)
I+788.0	LT	MH
I+932.8	LT	DI
I+939.0	LT	SMH - (2)
I+941.6	RT	WSO - (2)
I+966.5	RT	DI
I+997.0	LT	SMH
2+044.6	RT	MH
2+047.2	RT	SMH
2+050.0	RT	MH
2+050.0	RT	WSO
2+089.7	LT	DI
2+097.6	RT	MH
2+097.6	LT	MH
2+097.6	LT	SMH
2+100.1	LT	WSO
2+102.1	CL	WSO
2+109.2	LT	DI
2+112.3	RT	DI
2+182.0	LT	DI
2+186.0	RT	SMH
2+191.6	LT	DI
2+196.8	LT	DI
2+235.8	LT	DI

* NOTE: THE UTILITY LOCATIONS AND DESCRIPTIONS SHOWN ABOVE ARE APPROXIMATE AND ARE BASED ON INFORMATION OBTAINED FROM FIELD REVIEWS AND/OR RECORD UTILITY PLANS AS SUPPLIED BY THE MUNICIPALITY. REFER TO THE SPECIAL PROVISIONS FOR CONTACT PERSONS OF PRIVATE UTILITY COMPANIES.

ADJUST ELEVATION OF VALVE BOX

(ITEM 629.20)

STATION	POSITION	DESCRIPTION
VT ROUTE 36 - FAIRFIELD STREET		
I+507.8	RT	WSO - (3)
I+661.5	RT	WSO - (4)
I+785.8	RT	WSO - (3) 2
I+941.6	RT	WSO - (2)
2+050.0	RT	WSO
2+100.1	LT	WSO
2+102.1	CL	WSO

CHANGING ELEVATION OF DI'S, CB'S, OR MH'S

(ITEM 604.40)

STATION	POSITION	DESCRIPTION
VT ROUTE 36 - FAIRFIELD STREET		
I+478.3	LT	MH
I+478.3	LT	DI
I+480.0	RT	DI
I+498.6	LT	DI
I+507.3	RT	DI
I+507.8	LT	MH
I+513.4	LT	DI
I+515.9	RT	DI
I+520.0	RT	DI
I+649.0	LT	DI
I+657.0	RT	MH
I+662.5	LT RT	MH
I+664.3	LT	DI
I+667.2	RT	DI
I+778.7	RT	DI
I+778.7	LT	DI
I+788.0	LT	MH 2

STATION	POSITION	DESCRIPTION
VT ROUTE 36 - FAIRFIELD STREET		
I+932.8	LT	DI
I+966.5	RT	DI
2+044.6	RT	MH
2+050.0	RT & LT 2	MH
2+089.7	LT	DI
2+097.6	RT	MH
2+097.6	LT	MH
2+109.2	LT	DI
2+112.3	RT	DI
2+182.0	LT	DI
2+191.6	LT	DI
2+196.8	LT	DI
2+235.8	LT	DI

CHANGING ELEVATION OF SEWER MANHOLE

(ITEM 604.42)

STATION	POSITION	DESCRIPTION
VT ROUTE 36 - FAIRFIELD STREET		
I+476.8	CL	SMH
I+498.4	LT	SMH
I+657.9	CL	SMH
I+939.0	LT	SMH - (2) 1
I+997.0	LT	SMH
2+047.2	RT	SMH
2+097.6	LT	SMH
2+186.0	RT	SMH



UTILITY AND STRUCTURE LOCATIONS

PROJECT NAME: ST. ALBANS CITY
 PROJECT NUMBER: STP 2129(I)S
 FILE NAME: /pave/99d070/pd070.dgn PLOT DATE: 01-FEB-2006 07:5
 PROJECT LEADER: JLL DRAWN BY: D-H
 DESIGNED BY: D-H CHECKED BY: D-H
 IPARM FILE NAME: pd070usl.I SHEET 89 OF 105

STATE OF VERMONT AGENCY OF TRANSPORTATION




PROPOSED IMPROVEMENT CITY OF ST. ALBANS AND TOWN OF ST. ALBANS COUNTY OF FRANKLIN ST. ALBANS STATE HIGHWAY

BEGINNING IN THE CITY OF ST. ALBANS ON ST. ALBANS S.H. AT STA. 0+008.05 (MM 0.005) AND
EXTENDING EASTERLY ALONG ST. ALBANS S. H. FOR A DISTANCE OF 1126.54 M (0.700 MILE) TO STA. 1+039.64
(MM 0.646) IN THE TOWN OF ST. ALBANS.

PROJECT DATA	LENGTH (M)	LENGTH (MILES)
CITY OF ST. ALBANS STA. 0+008.05 TO STA. 0+094.95 MM 0.005 TO MM 0.059	= 86.90	0.054
TOWN OF ST. ALBANS STA. 0+000.00 TO STA. 1+039.64 MM 0.000 TO MM 0.646	= 1039.64	0.646
TOTAL LENGTH OF PROJECT	= 1126.54	0.700
TOTAL LENGTH OF ROADWAY	= 1126.54	0.700

WORK TO BE PERFORMED UNDER THIS PROJECT INCLUDES COLD
PLANING, LEVELING AND RESURFACING OF THE EXISTING HIGHWAY, NEW
PAVEMENT MARKINGS AND INCIDENTAL ITEMS.

**PROJECT LOCATION
STP 2204(1)S**


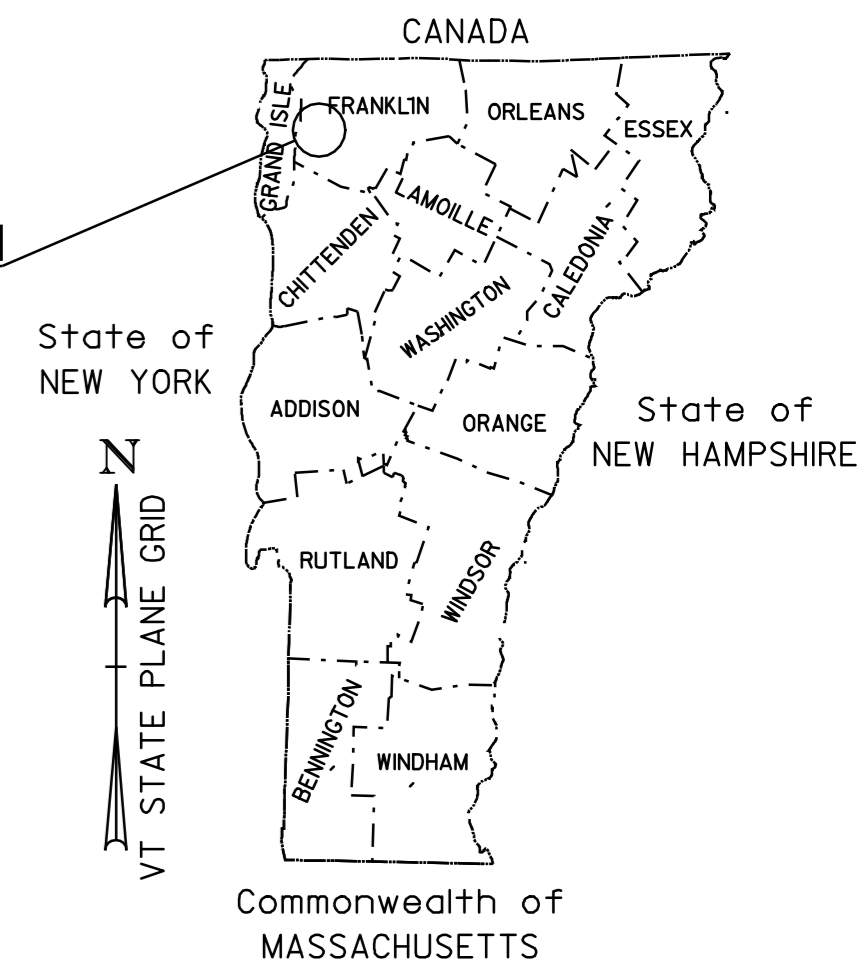


TRAFFIC DATA

ST. ALBANS STATE HIGHWAY

LOCATION	ADT		DHV		ESALS (2002-2012)
	2002	2012	2002	2012	
BEGIN PROJECT TO VT ROUTE 104	6700	8000	860	970	1,514,000

**BEGIN STP 2204(1)S
ST. ALBANS S. H.
ST. ALBANS CITY
STA. 0+008.05 (MM 0.005)**

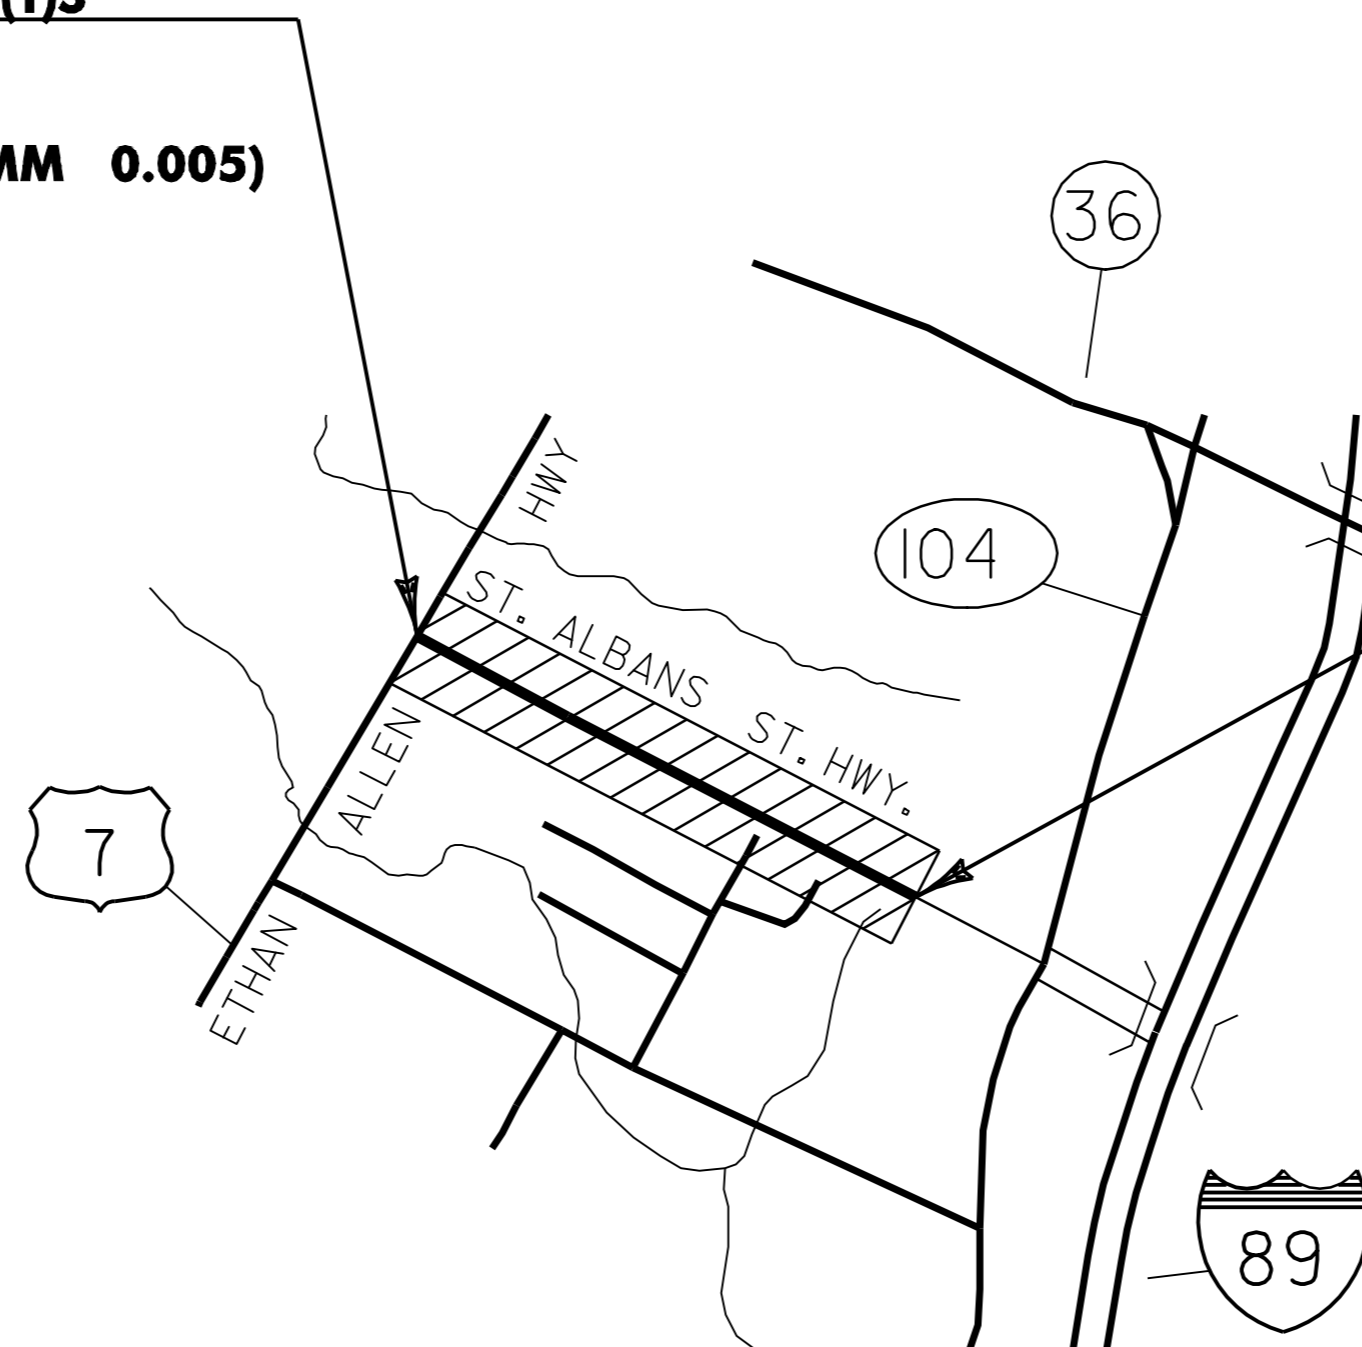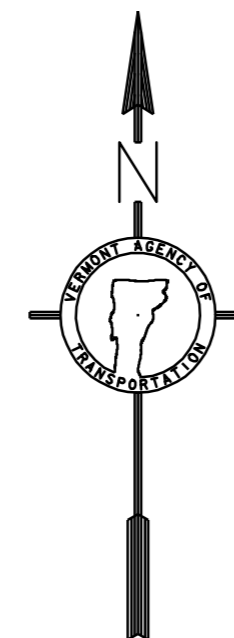

**END STP 2204(1)S
ST. ALBANS S. H.
ST. ALBANS
STA. 1+039.64 (MM 0.646)**

THESE PLANS ARE SUBJECT TO SUCH ENGINEERING
CHANGES AS MAY BE REQUIRED BY THE FEDERAL HIGHWAY
ADMINISTRATION OR THE DIRECTOR OF PROJECT
DEVELOPMENT.

CONSTRUCTION IS TO BE CARRIED ON IN ACCORDANCE
WITH THESE PLANS AND THE STANDARD SPECIFICATIONS
FOR CONSTRUCTION DATED 2001, AS APPROVED BY THE
FEDERAL HIGHWAY ADMINISTRATION ON JANUARY 4, 2001
FOR USE ON THIS PROJECT, INCLUDING ALL SUBSEQUENT
REVISIONS AND SUCH REVISED SPECIFICATIONS AND
SPECIAL PROVISIONS AS ARE INCORPORATED IN THESE
PLANS.

NOTE:

RIGHT-OF-WAY LIMITS, IF APPLICABLE, ARE
PROVIDED SOLELY FOR THE CONVENIENCE
OF THE STATE AND ITS CONTRACTOR DURING
THE COURSE OF THIS PAVING PROJECT.
ANY REFERENCES TO OFFSETS ON THESE
PLANS ARE APPROXIMATE AND SHOULD NOT
BE RELIED UPON FOR ANY PURPOSES.

UNLESS OTHERWISE NOTED, ALL DRAWINGS
AND DETAILS ON THESE PLANS ARE DRAWN
'NOT TO SCALE'.



UNLESS NOTED OTHERWISE
STATIONS ARE IN KILOMETERS
ELEVATIONS ARE IN METERS
DIMENSIONS ARE IN MILLIMETERS

DEPARTMENT OF TRANSPORTATION
FEDERAL HIGHWAY ADMINISTRATOR

APPROVED _____ DATE _____

DIRECTOR OF PROJECT DEVELOPMENT

APPROVED _____ DATE _____

PROJECT MANAGER :

PROJECT NAME : ST. ALBANS CITY-ST. ALBANS
PROJECT NUMBER : STP 2204 (1) S

SHEET 90 OF 105 SHEETS



CONVENTIONAL SYMBOLS

- UTILITY LEGEND**
- ⊙ = EXISTING HYDRANT
 - ⊕ = EXISTING DI
 - = EXISTING MANHOLE
 - TEL = EXISTING TELEPHONE MANHOLE
 - ELEC = EXISTING ELECTRIC MANHOLE
 - SMH = EXISTING SEWER MANHOLE
 - WSO = EXISTING WATER SHUTOFF
 - GSO = EXISTING GAS SHUTOFF
 - ♂ = EXISTING MAILBOX
 - = EXISTING SIGNAL HEAD


- SIGN LEGEND**
- N = NEW
 - R = REMOVE
 - R&S = REMOVE & SALVAGE
 - S = SALVAGE SIGN
 - RET = RETAIN
 - B-B = BACK TO BACK

SURVEYED BY : D-H
SURVEYED DATE : 4/13/00

DATUM


VERTICAL N/A
HORIZONTAL N/A

- COUNTY LINE
- TOWN LINE
- LIMITS OF ACCESS
- POINT OF ACCESS
- FENCE LINE
- STONE WALL
- TRAVELED WAY
- GUARD RAIL
- RAILROAD
- SURVEY LINE
- CULVERT
- POWER POLE
- TELEPHONE POLE
- TREES
- CONTROL OF ACCESS
- PROPERTY LINE
- R.O.W. TAKING LINE
- SLOPE RIGHTS
- TOP OF CUT
- TOE OF SLOPE

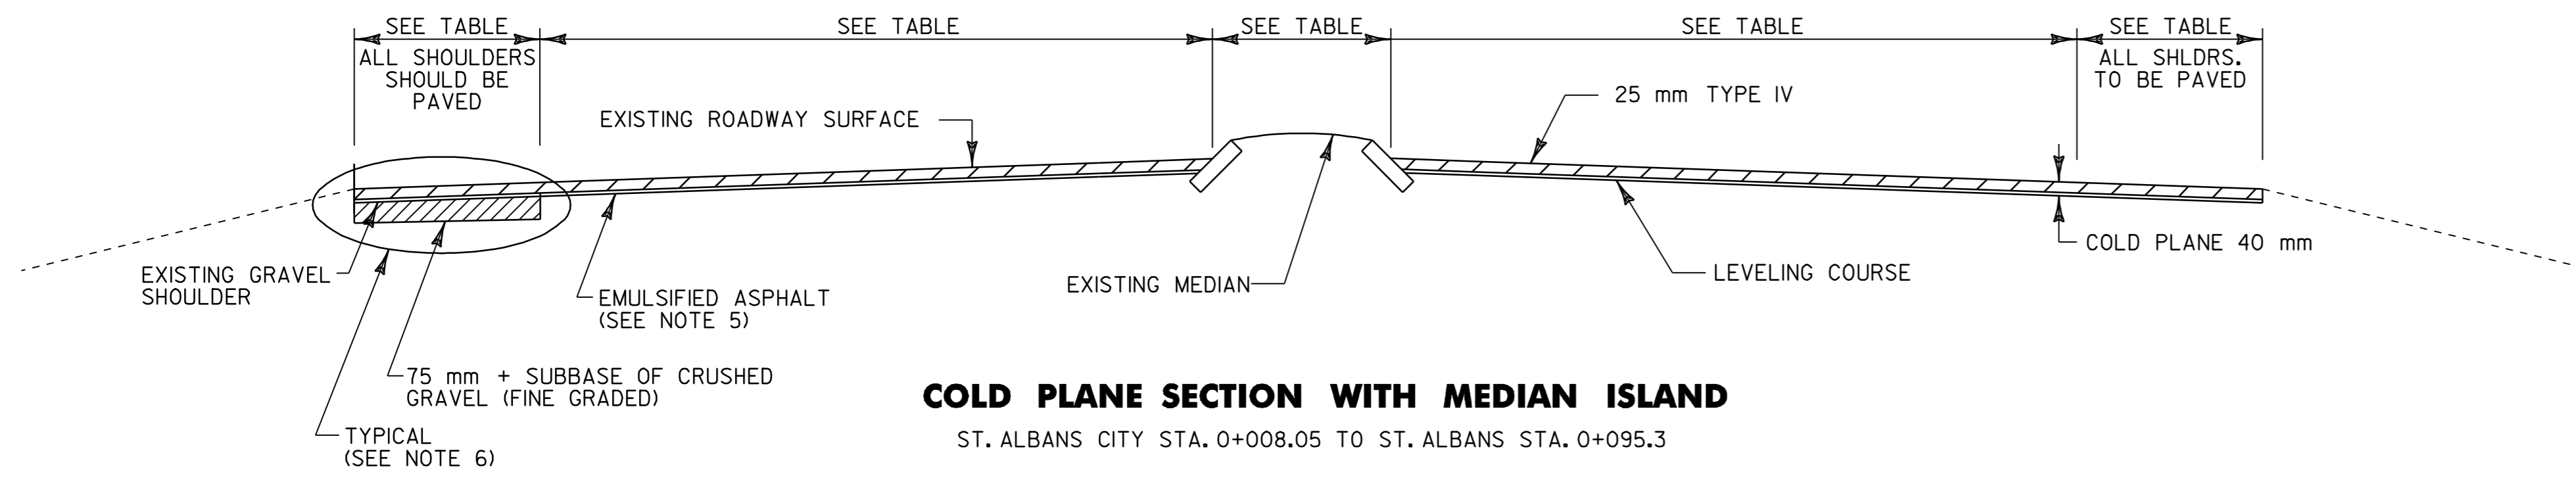


COLD PLANE SECTION WITH MEDIAN ISLAND

ST. ALBANS CITY STA. 0+008.05 TO ST. ALBANS STA. 0+095.3

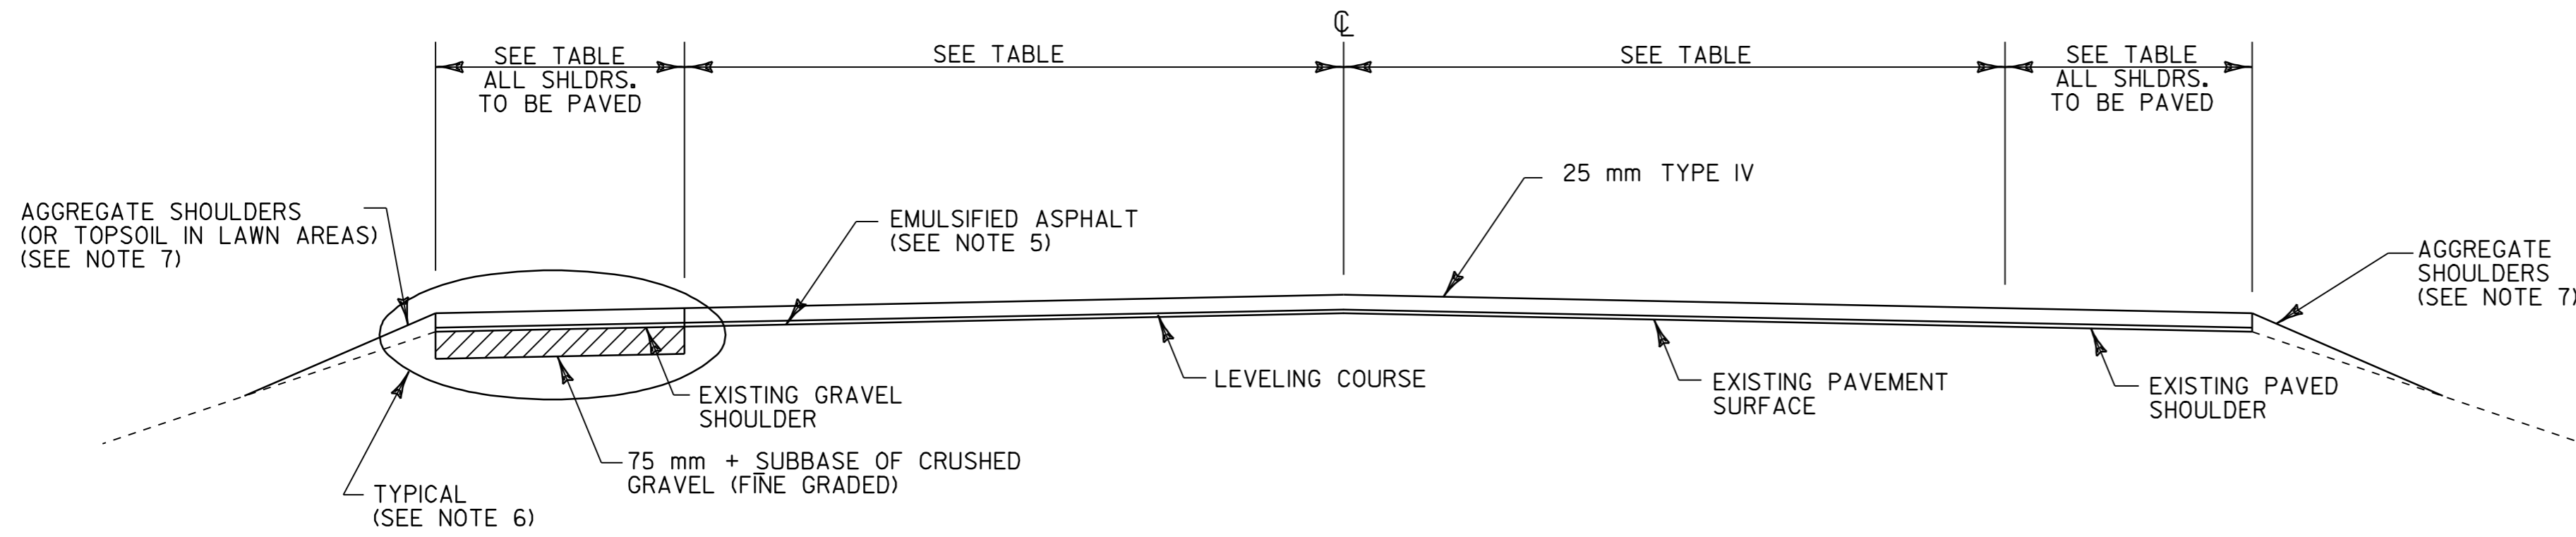

OVERLAY TYPICAL SECTION - ROADWAY

ST. ALBANS STA. 0+095.3 TO 1+039.6

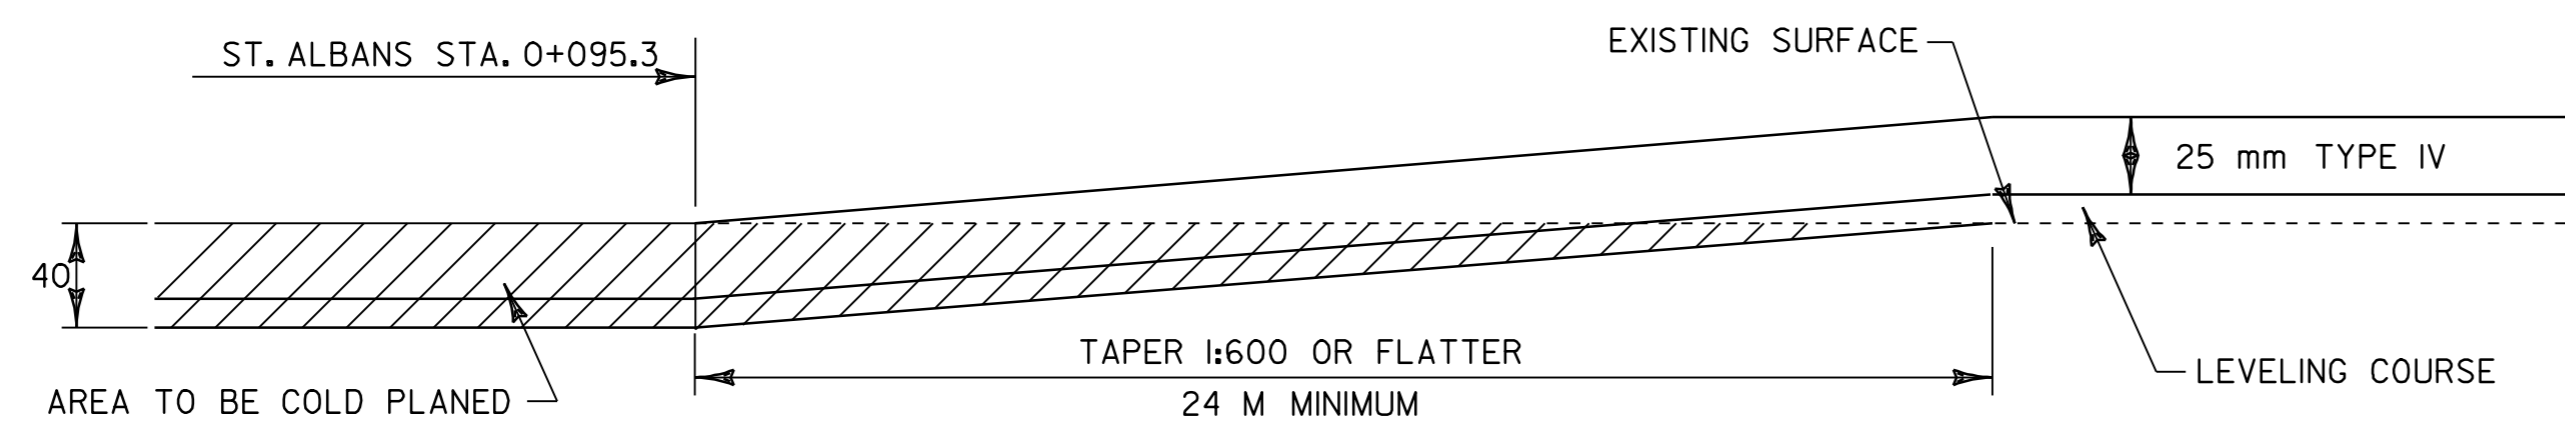

**TRANSITION AREA DETAIL
FULL ROADWAY WIDTH**

(COLD PLANE, LEVEL AND OVERLAY TO LEVEL AND OVERLAY)
ST. ALBANS STA. 0+095.3 TO 0+119.3

NOTES

1. THE PAVEMENT WEARING COURSE AND LEVELING COURSE ON THE ROADWAY SHALL BE TYPE IV, UNLESS OTHERWISE DIRECTED BY THE ENGINEER. THE TYPE IV LEVELING COURSE QUANTITY IS ESTIMATED AT 15 mm. ALL ASPHALT CEMENT USED IN THE BITUMINOUS CONCRETE PAVEMENT SHALL BE PG 58-34.
2. BITUMINOUS CONCRETE PAVEMENT TOLERANCE = ± 5 mm. (TOTAL THICKNESS EXCLUDING LEVELING)
3. GRASS GROWING ADJACENT TO PAVEMENT OR THROUGH CRACKS IN THE PAVEMENT WHICH MAY HAMPER THE PLACEMENT OF NEW BITUMINOUS CONCRETE SHALL BE REMOVED BY THE CONTRACTOR AS DIRECTED BY THE ENGINEER. PAYMENT FOR THIS WORK WILL NOT BE MADE DIRECTLY, BUT WILL BE CONSIDERED SUBSIDIARY TO ITEM 406.25 BITUMINOUS CONCRETE PAVEMENT.
4. THE COLD PLANING AND PAVING SHALL MATCH THE EXISTING CONDITIONS AT THE BEGINNING OF THE PROJECT BY THE USE OF A VERTICAL BUTT JOINT AS DETAILED ON THIS SHEET.
5. EMULSIFIED ASPHALT TO BE APPLIED ON EXISTING PAVEMENT, BETWEEN ALL COURSES OF PAVEMENT AND ON COLD PLANED SURFACES, AT THE RATE OF 0.12 L/m² OR AS DIRECTED BY THE ENGINEER.
6. EXISTING SHOULDER MATERIAL DEEMED UNSUITABLE BY THE RESIDENT ENGINEER, SHALL BE EXCAVATED TO A DEPTH OF 75 mm OR AS DIRECTED BY THE ENGINEER.
EXCAVATION WILL BE PAID FOR AS ALL PURPOSE EXCAVATOR OR GRADER RENTAL.
MATERIAL REMOVED SHALL BE REPLACED WITH SUBBASE OF CRUSHED GRAVEL (FINE GRADED) OR COLD PLANE GRINDINGS, ITEM 402.12 (MOD.) AS DIRECTED BY THE RESIDENT ENGINEER.
EXCAVATED MATERIAL SHALL BE SPREAD ON THE ADJACENT SLOPES OR REMOVED FROM PROJECT, AS DIRECTED BY THE ENGINEER.
7. COLD PLANE GRINDINGS SHALL BE USED INSTEAD OF AGGREGATE SHOULDERS TO BACK UP THE NEW PAVEMENT OVERLAY AS DIRECTED BY THE RESIDENT ENGINEER. THIS WILL BE PAID UNDER ITEM 402.12 (MOD.)

RURAL AREAS - SEED MIXTURE

% WT	KG/HA	NAME	PUR %	GERM %
37.1	26.0	CREEPING RED FESCUE	98	85
37.1	26.0	TALL FESCUE	95	90
5.7	4.0	RED TOP	95	90
14.4	10.0	BIRDSFOOT TREFLOIL	98	85
5.7	4.0	ANNUAL RYE GRASS	95	85
100.0	70.0			

SEED MIXTURE:
SHALL NOT HAVE A WEED CONTENT EXCEEDING 0.40% BY WEIGHT AND SHALL BE FREE OF ALL NOXIOUS SEED.


SEED:
TO BE APPLIED PER SEEDING FORMULAS OR AS DIRECTED BY THE ENGINEER.

FERTILIZER:
FORMULA 10-20-10, TO BE USED WITH SEED, APPLIED AT THE RATE OF 560 KG/HA. (HYDRO SEEDERS MAY USE 19-19-19 FORMULA.)

AGRICULTURAL LIMESTONE:
TO BE APPLIED AT THE RATE OF 4500 KG/HA, OR AS DIRECTED BY THE ENGINEER.


HAY MULCH:
TO BE PLACED ON EARTH SLOPES AT THE RATE OF 4500 KG/HA, OR AS DIRECTED BY THE ENGINEER.

TOPSOIL:
TO BE USED AS INDICATED ON THE PLANS, OR AS DIRECTED BY THE ENGINEER.

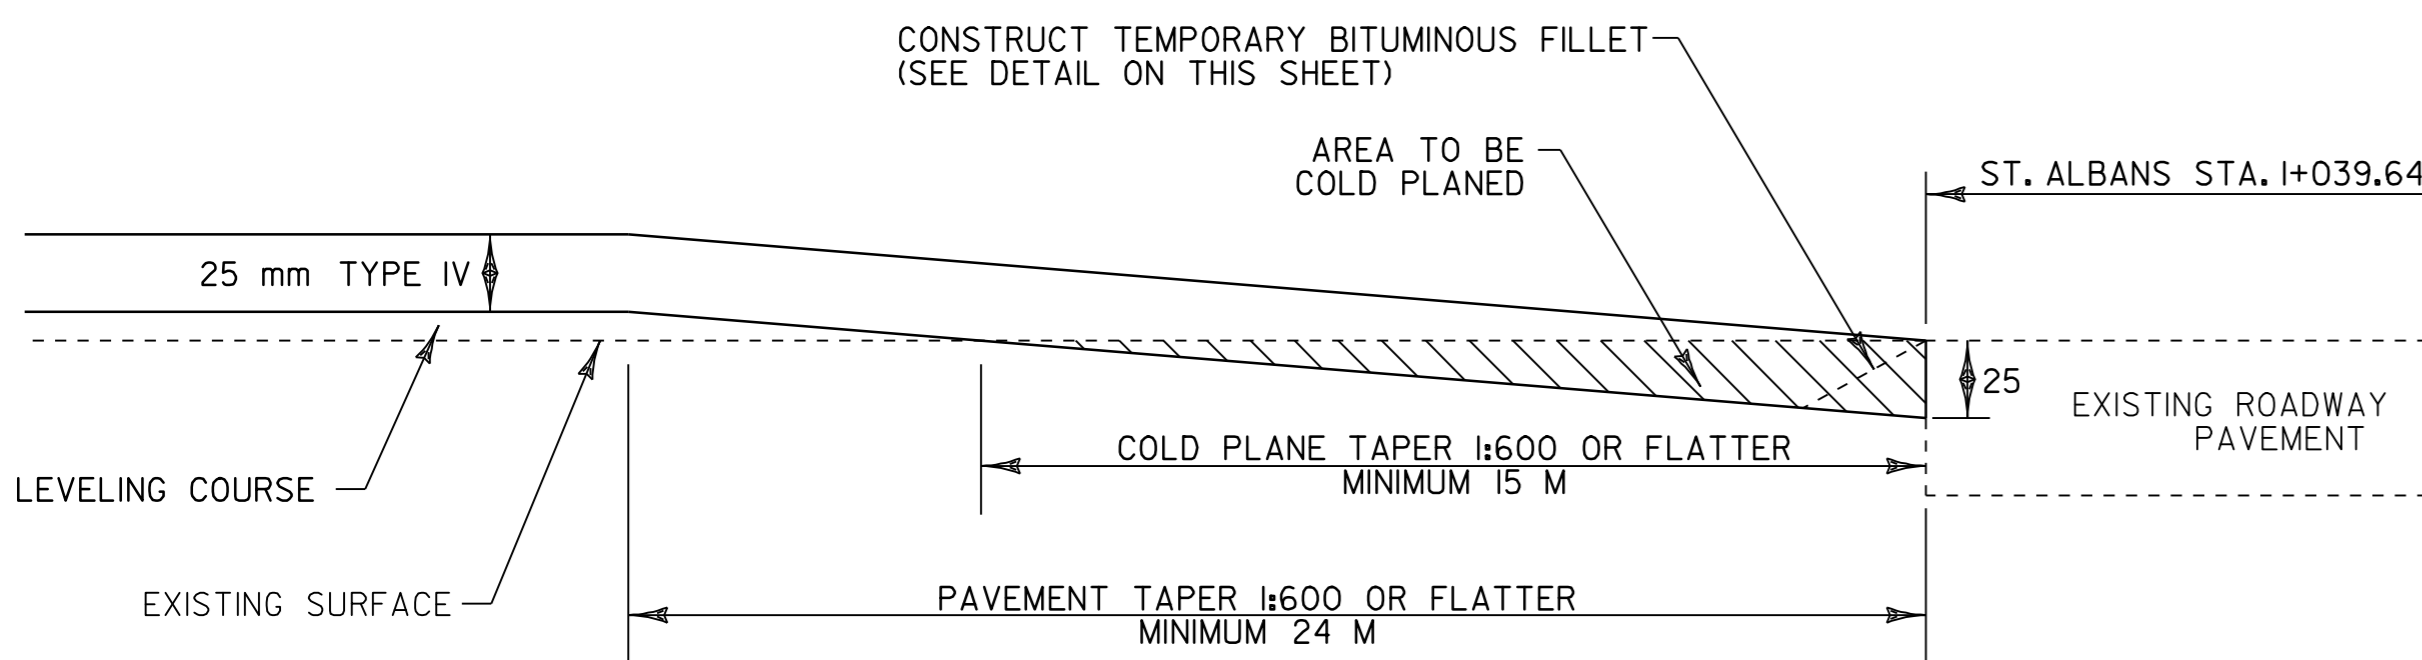

**APPROACH AREA DETAIL
(END LEVELING AND OVERLAY)
FULL ROADWAY WIDTH**

ST. ALBANS STA. 1+015.64 TO 1+039.64

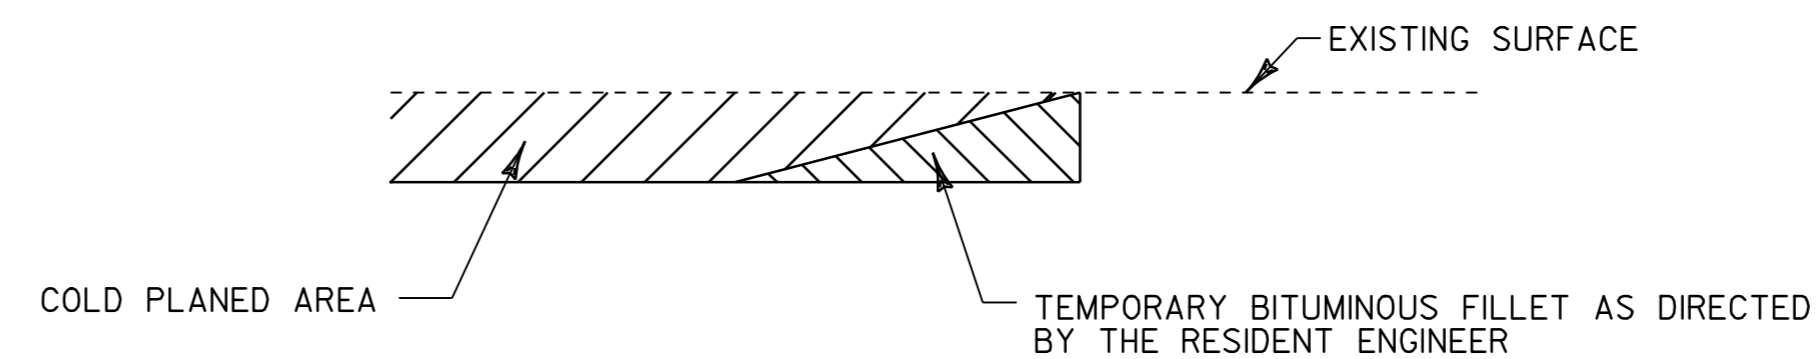

DETAIL AT VERTICAL COLD PLANE JOINTS

PROJECT PAVING LIMITS

TOWN & ROUTE	BEGIN STATION	END STATION	LANE TYPICAL	WEARING DEPTH	LEVELING TONS	NOTES
ST. ALBANS, ST. ALBANS S.H.	0+000.00	0+095.3	VARIES - SEE LAYOUTS	25 mm	51	COLD PLANE 40 mm, LEVEL WITH TYPE IV, THEN OVERLAY WITH 25 mm TYPE IV
ST. ALBANS, ST. ALBANS S.H.	0+095.3	1+039.64	VARIES - SEE LAYOUTS	25 mm	476	LEVEL WITH TYPE IV, THEN OVERLAY WITH 25 mm TYPE IV


NOTE: 1) ALL DIMENSIONS IN MILLIMETERS EXCEPT WHERE OTHERWISE INDICATED.

PROJECT TYPICALS & PAVING LIMITS

PROJECT NAME: ST. ALBANS CITY - ST. ALBANS
PROJECT NUMBER: STP 2204(I)S
FILE NAME: /pave/99b160/pbi60.dgn PLOT DATE: 01-FEB-2006 07:5
PROJECT LEADER: JLL DRAWN BY: D-H
DESIGNED BY: D-H CHECKED BY:
IPARM FILE NAME: pbi60+yp.i SHEET 91 OF 105

LOCATION				METERS OF DITCHING			MISC. ITEMS			REMARKS
SITE	STATION	STATION	POS.	PERCENT GRADE			613.10 STONE FILL TYP. I	649.31 GEOT. UNDER STONE FILL	654.10 EROS. MATT.	
				0-1	1-2.5	2.5-10				
ST. ALBANS CITY-ST. ALBANS DISTRICT #8							m3	m2	m2	
ST. ALBANS										
1	0+032	0+161	RT		129					
2	0+032	0+161	LT		129					
3	0+402	0+547	LT	145						
4	0+644	0+740	RT	96						
5	0+837	1+039.64	LT	203						
PROJECT SUBTOTALS (EST.)				444	258		10	10	10	
ROUNDING				-	-		-	-	-	
PROJECT TOTALS				444	258		10	10	10	


LOCATION				METERS OF DITCHING			MISC. ITEMS			REMARKS
SITE	STATION	STATION	POS.	PERCENT GRADE			613.10 STONE FILL TYP. I	649.31 GEOT. UNDER STONE FILL	654.10 EROS. MATT.	
				0-1	1-2.5	2.5-10				
							m3	m2	m2	

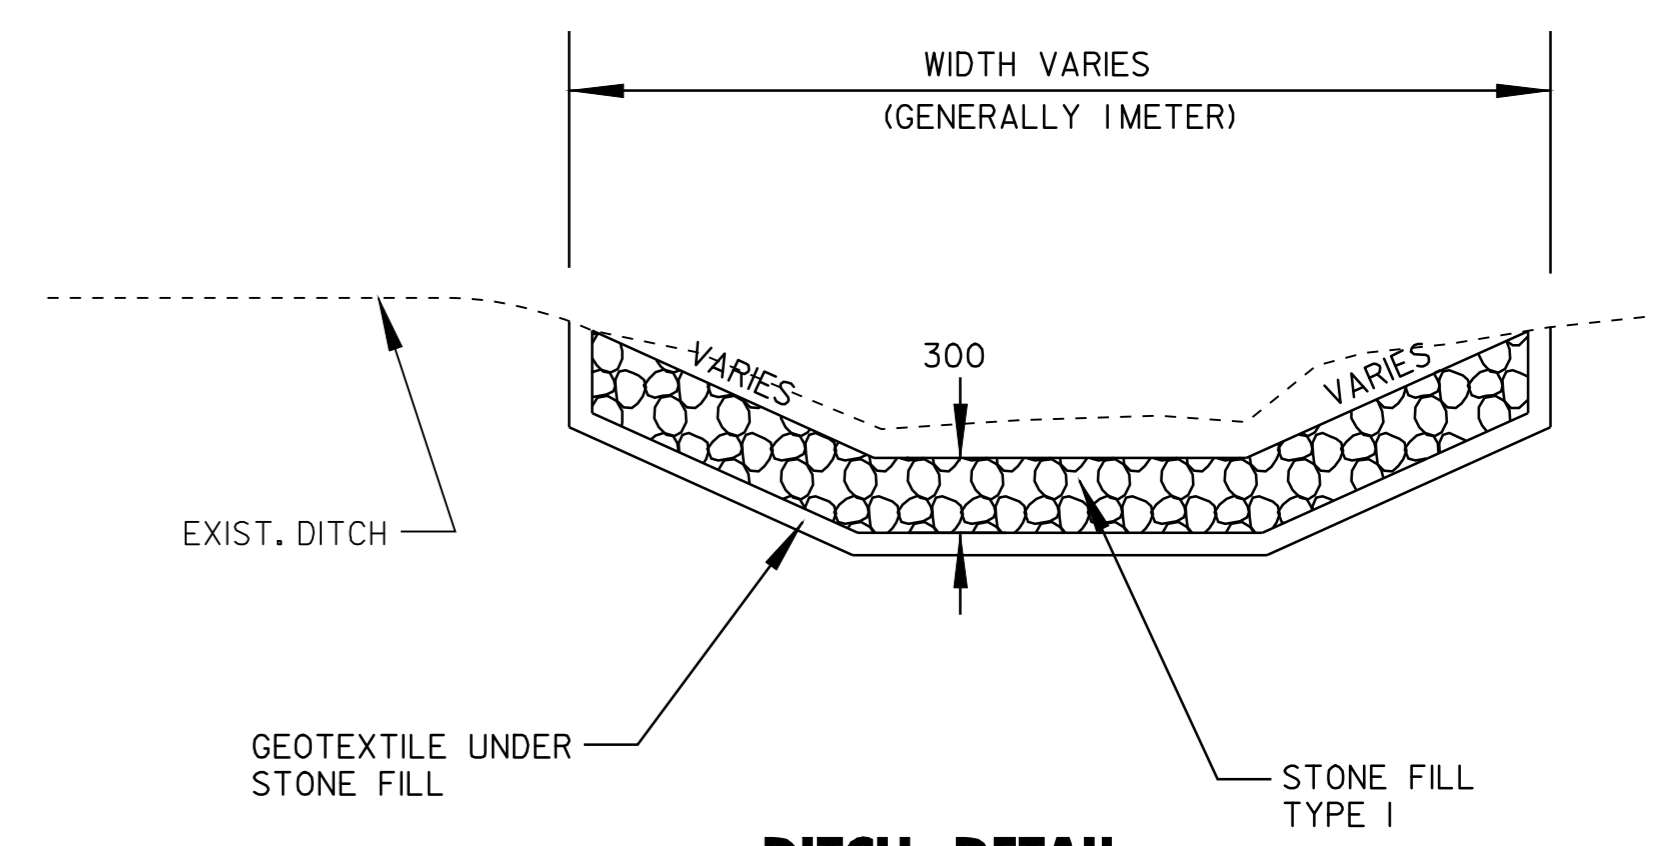

NOTES:

PIPE INLET AND OUTLET AREAS, AND DITCH CLEANING THROUGH PROJECT, SHALL BE PERFORMED AT LOCATIONS AND AS DIRECTED BY THE RESIDENT ENGINEER. PAYMENT WILL BE UNDER THE APPLICABLE EQUIPMENT RENTAL ITEM(S).

AN ESTIMATED QUANTITY OF EROSION MATTING AND STONE FILL TYPE I HAS BEEN INCLUDED. EROSION MATTING SHALL BE USED IN ALL DITCHES WITH A GRADE BETWEEN 2 AND 5 PERCENT AND STONE FILL TYPE I SHALL BE USED IN ALL DITCHES WITH A GRADE GREATER THAN 5 PERCENT OR AS DIRECTED BY THE RESIDENT ENGINEER.

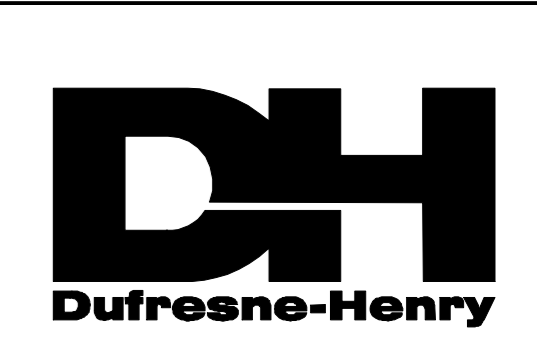

DITCH CLEANING DETAIL SHEET	PROJECT NAME: ST. ALBANS CITY - ST. ALBANS
	PROJECT NUMBER: STP 2204(I)S
	FILE NAME: /pave/99b160/pbl60.dgn
	PLOT DATE: 01-FEB-2006 07:5
PROJECT LEADER: JLL	DRAWN BY: D-H
DESIGNED BY: D-H	CHECKED BY:
IPARM FILE NAME: pbl60dd.i	SHEET 92 OF 105

ITEM DETAIL SUMMARY SHEET



STATION		POS.	203.15	203.16	203.30	203.99	301.28	402.12	402.12	604.40	604.412	616.21	616.40	618.10	621.20	621.505	621.505	621.75	621.76	621.77	621.80	621.81	629.20	REMARKS	
BEGIN	END		COMMON EXCAV. m ³	SOLID ROCK EXCAV. m ³	EARTH BORROW m ³	SHOULDER BERM REMOVAL M	SUBBASE OF CR. GRAVEL T	AGGREGATE SHOULDERS T	AGGREGATE SHOULDERS (MOD.) T	CHAN ELEV EA	REHAB DI CLASS I EA	VERTICAL GRANITE CURB M	REMOVING AND RESETTING CURB M	P.C. CONCRETE SIDEWALK 125 mm m ²	STEEL BEAM G.R. M	MAN. TERMINAL SECTION (TANGENT) EA	MAN. TERMINAL SECTION (FLARED) EA	REMOVING AND RESET G.R. M	REPLACE G.R. POST ASSEMBLY EA	REPLACE G.R. BEAM UNIT EA	REMOVAL AND DISPOSAL OF G.R. M	REMOVAL AND DISPOSAL OF GUIDE POSTS EA	ADJUST ELEVATION OF VALVE BOXES EA		
ST. ALBANS CITY - TOWN																									
0+008.05	1+039.64	LT./RT.			1		14		342		7	1											1	QUANTITIES LISTED ARE FOR USE AS DIRECTED BY THE RESIDENT ENGINEER. FOR STRUCTURE LOCATIONS, SEE SHEET 105.	
ST. ALBANS CITY																									
0+010.9		RT.	0.8	0.7			1.6						7	5.7											CONSTRUCT SIDEWALK RAMP, TYPE 6
0+012.2		LT.	1.2	1.0			2.2						5	7.8											CONSTRUCT SIDEWALK RAMP, TYPE 6
SUBTOTALS			2	1.7	1		17.8		342		7	1	12	13.5									1		
ROUNDING			1	0.3	-		1.2		8		-	-	1	0.5									-		
TOTALS			3	2	1		19		350		7	1	13	14									1		

PROJECT NAME: ST. ALBANS CITY - ST. ALBANS
 PROJECT NUMBER: STP 2204(I)S
 FILE NAME: /pave/99b160/pbl60.dgn PLOT DATE: 01-FEB-2006 07:5
 PROJECT LEADER: JLL DRAWN BY: D-H
 DESIGNED BY: D-H CHECKED BY:
 IPARM FILE NAME: pbl60id.i SHEET 95 OF 105

TEMPORARY AND DURABLE 150 mm WHITE LINE
 ST. ALBANS CITY STA. 0+008.1 TO
 ST. ALBANS TOWN STA. 0+060.0, SOLID LT. & RT.
 ST. ALBANS CITY STA. 0+015.2 TO
 ST. ALBANS TOWN STA. 0+000.5, SOLID LT.

BEGIN STP 2204(1)S
ST. ALBANS STATE HIGHWAY
ST. ALBANS CITY
STA. 0+008.05 = MM 0.005

TEMPORARY LETTER OR SYMBOL
 ST. ALBANS CITY STA. 0+017.6, LT. - "STOP" (2)
~~ST. ALBANS CITY STA. 0+021.2, LT. - "STOP" (2)~~
~~ST. ALBANS CITY STA. 0+056.0, LT. - "STOP" (2)~~
 ST. ALBANS CITY STA. 0+090.7, LT. - "STOP" (2)
 040.0

TEMPORARY AND DURABLE 150 mm YELLOW LINE
 ST. ALBANS CITY STA. 0+013.5 TO
 ST. ALBANS TOWN STA. 0+060.0, SOLID LT. & RT.

DURABLE LETTER OR SYMBOL (TYPE ITAPE)
 ST. ALBANS CITY STA. 0+017.6, LT. - "STOP" (2)
 ST. ALBANS CITY STA. 0+021.2, LT. - "STOP" (2)
 ST. ALBANS CITY STA. 0+024.8, LT. - "ONLY" (2)
 ST. ALBANS CITY STA. 0+056.0, LT. - "ONLY" (2) 072
 ST. ALBANS CITY STA. 0+059.6, LT. - "ONLY" (2) 076
 ST. ALBANS CITY STA. 0+090.7, LT. - "STOP" (2) 109
 ST. ALBANS CITY STA. 0+094.3, LT. - "ONLY" (2) 000

DURABLE 600 mm STOP BAR (TYPE ITAPE)
 ST. ALBANS CITY STA. 0+014.9, LT.

TEMPORARY 600 mm STOP BAR
 ST. ALBANS CITY STA. 0+014.9, LT.

TEMPORARY AND DURABLE CROSSWALK MARKING W/DIAGONAL LINES
 ST. ALBANS CITY STA. 0+010.2, RT. TO 0+012.2, LT.

REHABILITATION OF D'S, CB'S OR MH'S - CLASS I
 ST. ALBANS CITY STA. 0+010.2, RT.
 ST. ALBANS CITY STA. 0+012.2, LT.
 ST. ALBANS CITY STA. 0+039.5, LT.


FLASHING BEACON-GROUND MOUNTED (MOD.)
 ST. ALBANS CITY STA. 0+019.0, LT

~~PAINTED ISLAND~~
~~ST. ALBANS CITY STA. 0+013.0 TO~~
~~ST. ALBANS TOWN STA. 0+000.5~~



DITCH CLEANING
 ST. ALBANS TOWN STA. 0+032.0 TO 0+060.0, RT. (SITE 1)
 ST. ALBANS TOWN STA. 0+032.0 TO 0+060.0, LT. (SITE 2)
 (FOR DETAILS, SEE SHEET 92)

~~PAINTED CURB~~
~~ST. ALBANS TOWN STA. 0+000.5 TO 0+009.5, LT. & RT.~~
~~ST. ALBANS TOWN STA. 0+041.1 TO 0+060.0, LT.~~

ST. ALBANS CITY STA. 0+094.95 = MM 0.059
ST. ALBANS TOWN STA. 0+000.00 = MM 0.000
CITY OF ST. ALBANS - TOWN OF ST. ALBANS TOWN LINE

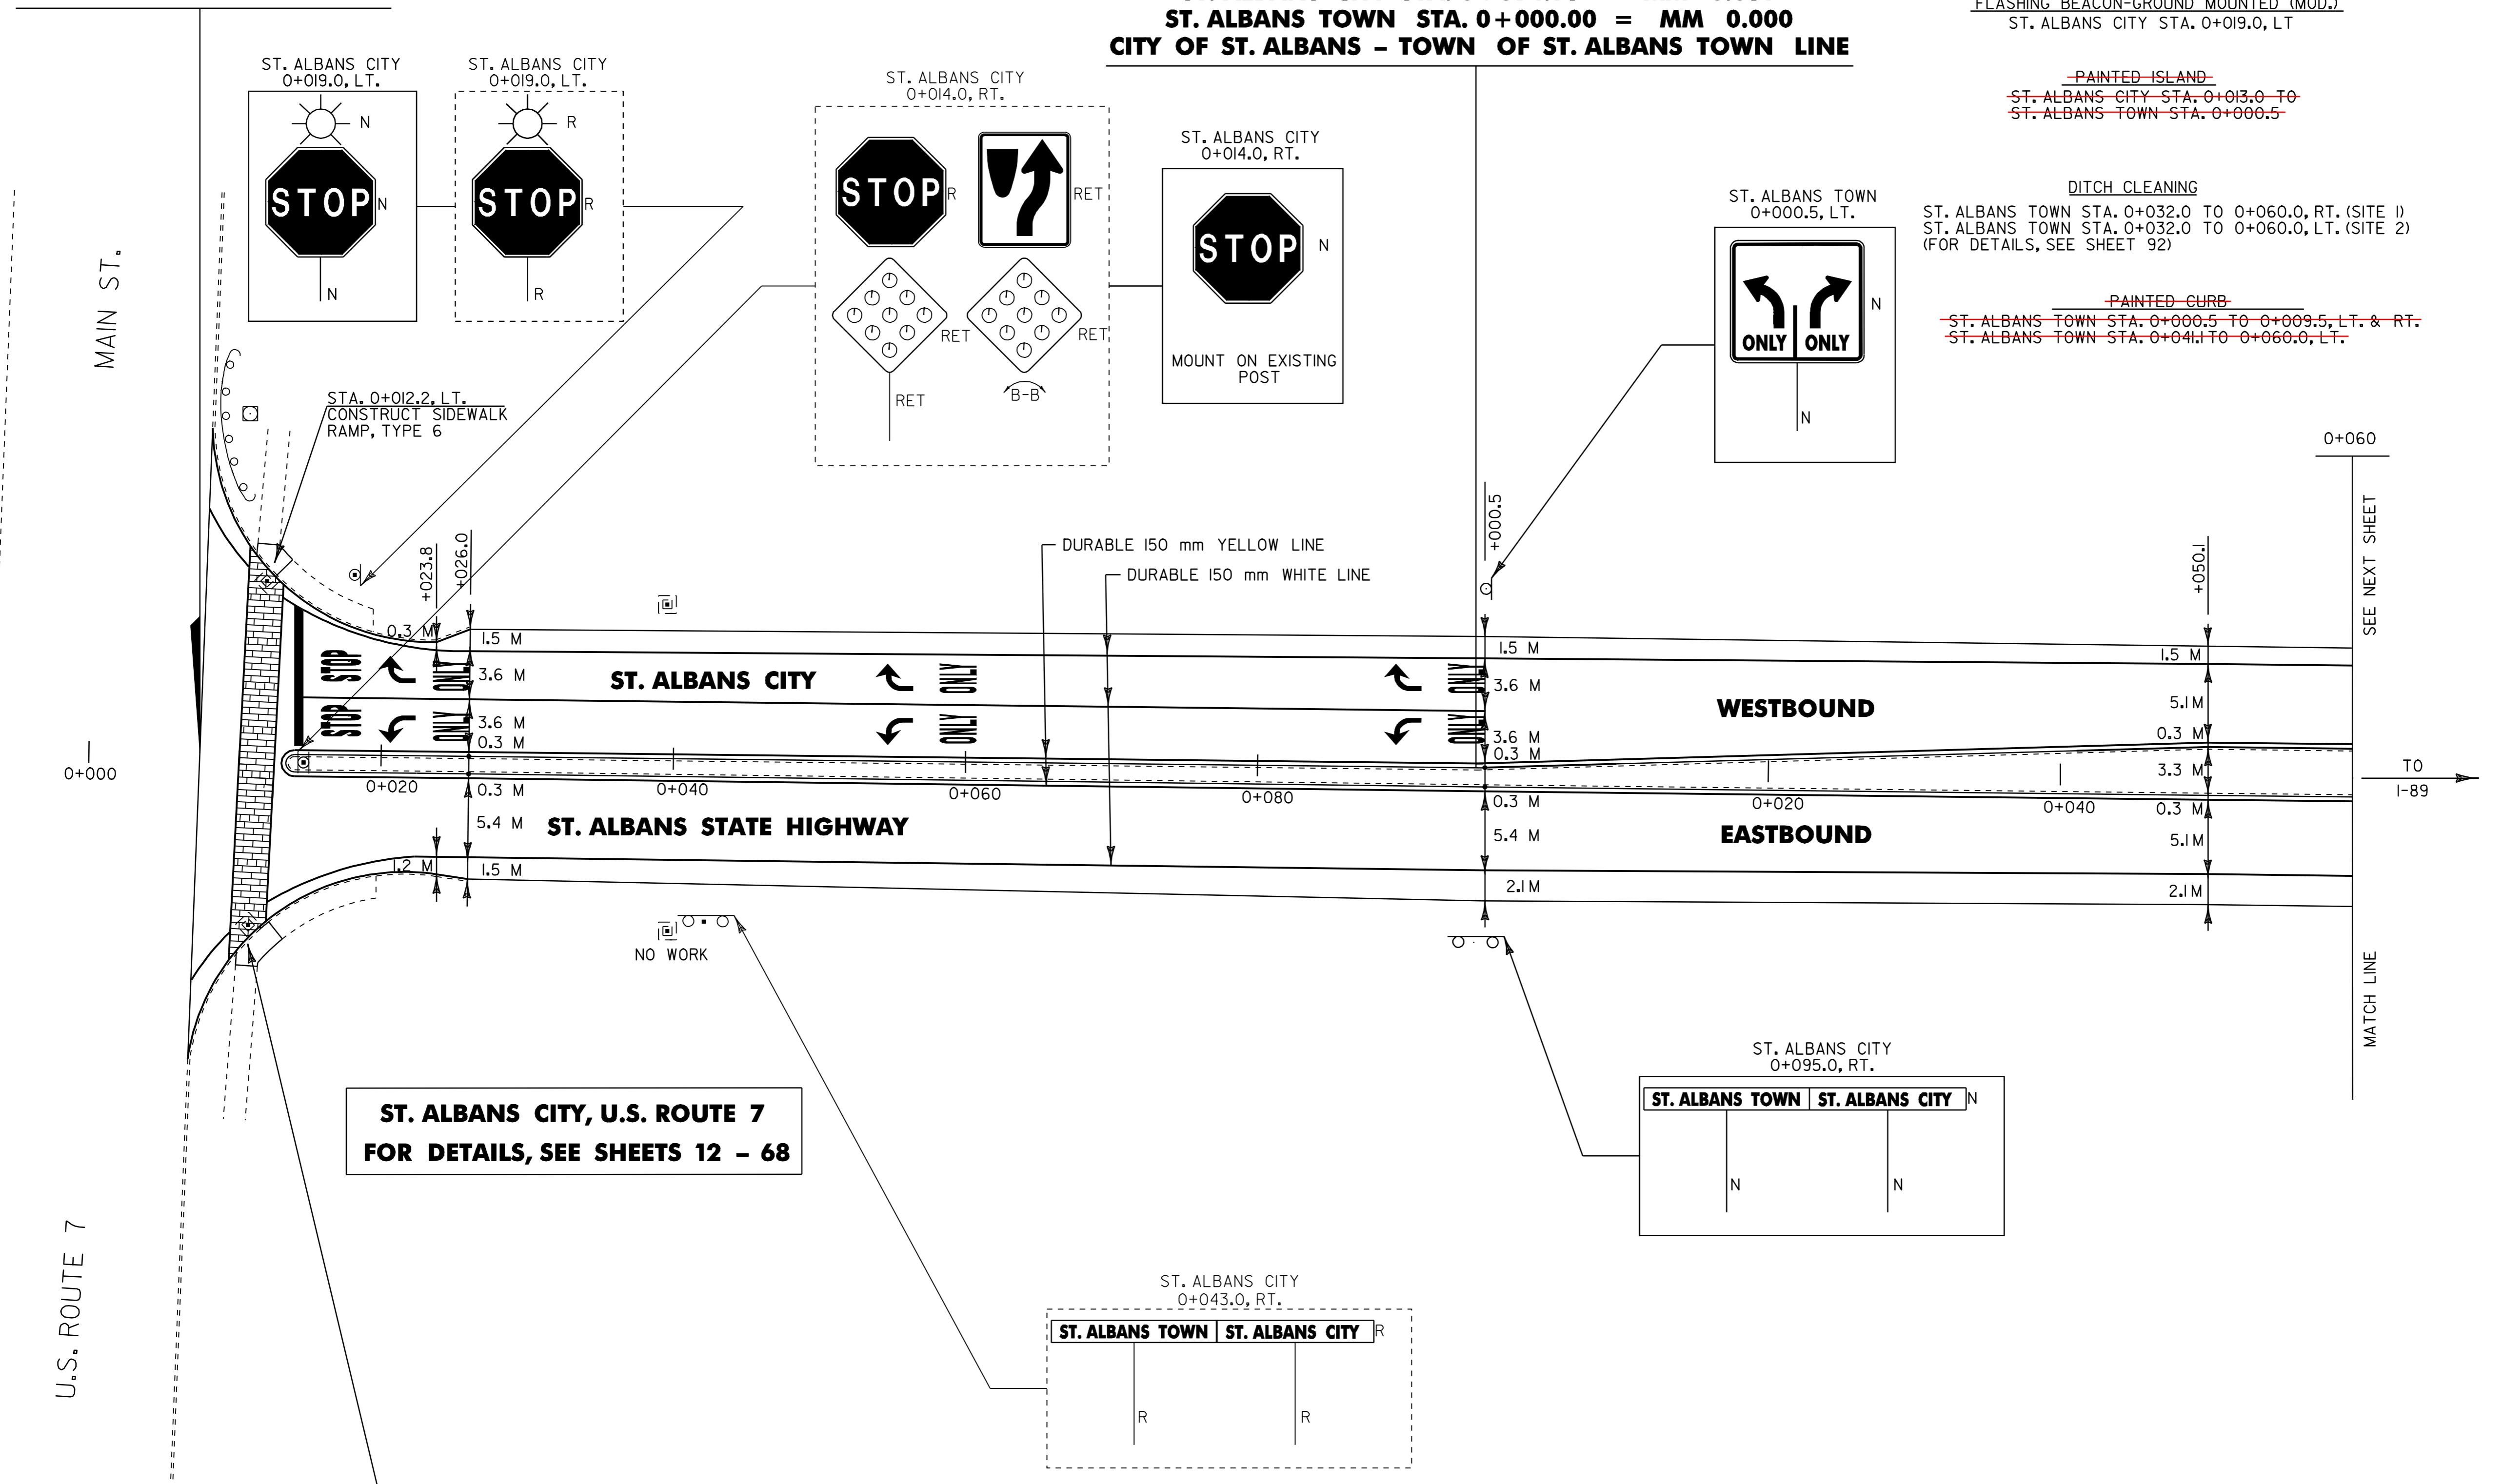

ST. ALBANS CITY, U.S. ROUTE 7
FOR DETAILS, SEE SHEETS 12 - 68

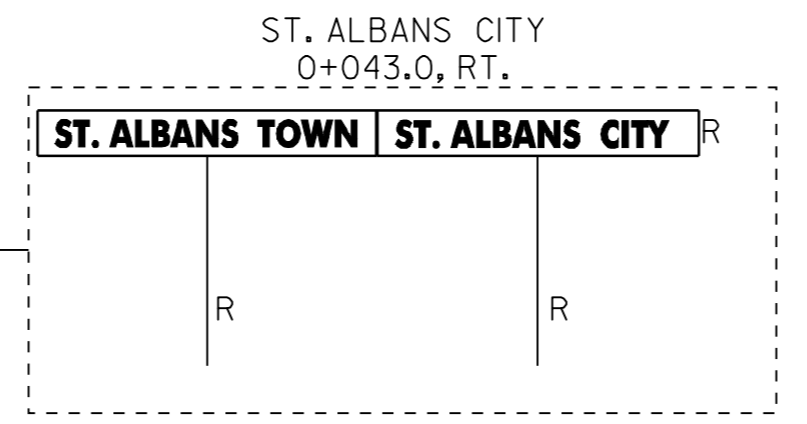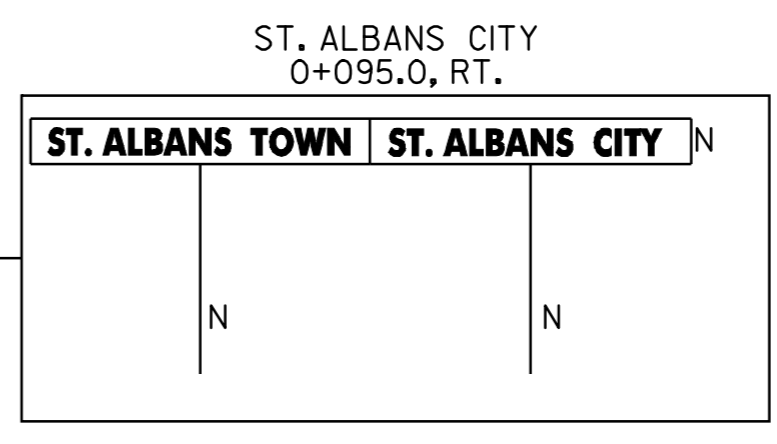

NOTE:
 1) ALL DIMENSIONS IN MILLIMETERS EXCEPT WHERE OTHERWISE INDICATED
 2) ALL EXISTING SIGNS NOT SHOWN SHALL BE RETAINED AS DIRECTED BY THE RESIDENT ENGINEER.

PROJECT LAYOUT #1

PROJECT NAME:	ST. ALBANS CITY-ST. ALBANS
PROJECT NUMBER:	STP_2204(1)S
FILE NAME:	zpxve299bl60zbb160.dgn
PLOT DATE:	01-FEB-2006 07:5
PROJECT LEADER:	JLL
DRAWN BY:	D-H
DESIGNED BY:	D-H
CHECKED BY:	
IPARM FILE NAME:	db16011
SHEET	96 OF 105



TEMPORARY AND DURABLE 150 mm WHITE LINE
STA. 0+060.0 TO 0+220.0, SOLID LT. & RT.

TEMPORARY AND DURABLE 150 mm YELLOW LINE
STA. 0+060.0 TO 0+095.3, SOLID LT. & RT.
STA. 0+095.3 TO 0+200.0, DOUBLE SOLID LT. & RT.
STA. 0+200.0 TO 0+220.0, SOLID LT. & RT.

TEMPORARY AND DURABLE 300 mm YELLOW LINE
STA. 0+069.8 TO 0+174.7 (DIAGONALS)

DURABLE LETTER OR SYMBOL (TYPE ITAPE)
STA. 0+212.5, LT. - "AHEAD" I95
STA. 0+207.0, LT. - "STOP"


REHABILITATION OF DI'S, CB'S OR MH'S
STA. 0+064.7, LT. & RT.
STA. 0+188.5, LT.



TEMPORARY LETTER OR SYMBOL
STA. 0+212.5, LT. - "AHEAD"

PAINTED CURB
STA. 0+060.0 TO 0+074.0, LT.
STA. 0+086.3 TO 0+095.3, LT. & RT.

DITCH CLEANING
STA. 0+060.0 TO 0+161.0, RT. (SITE 1)
STA. 0+060.0 TO 0+161.0, LT. (SITE 2)
(FOR DETAILS, SEE SHEET 92)

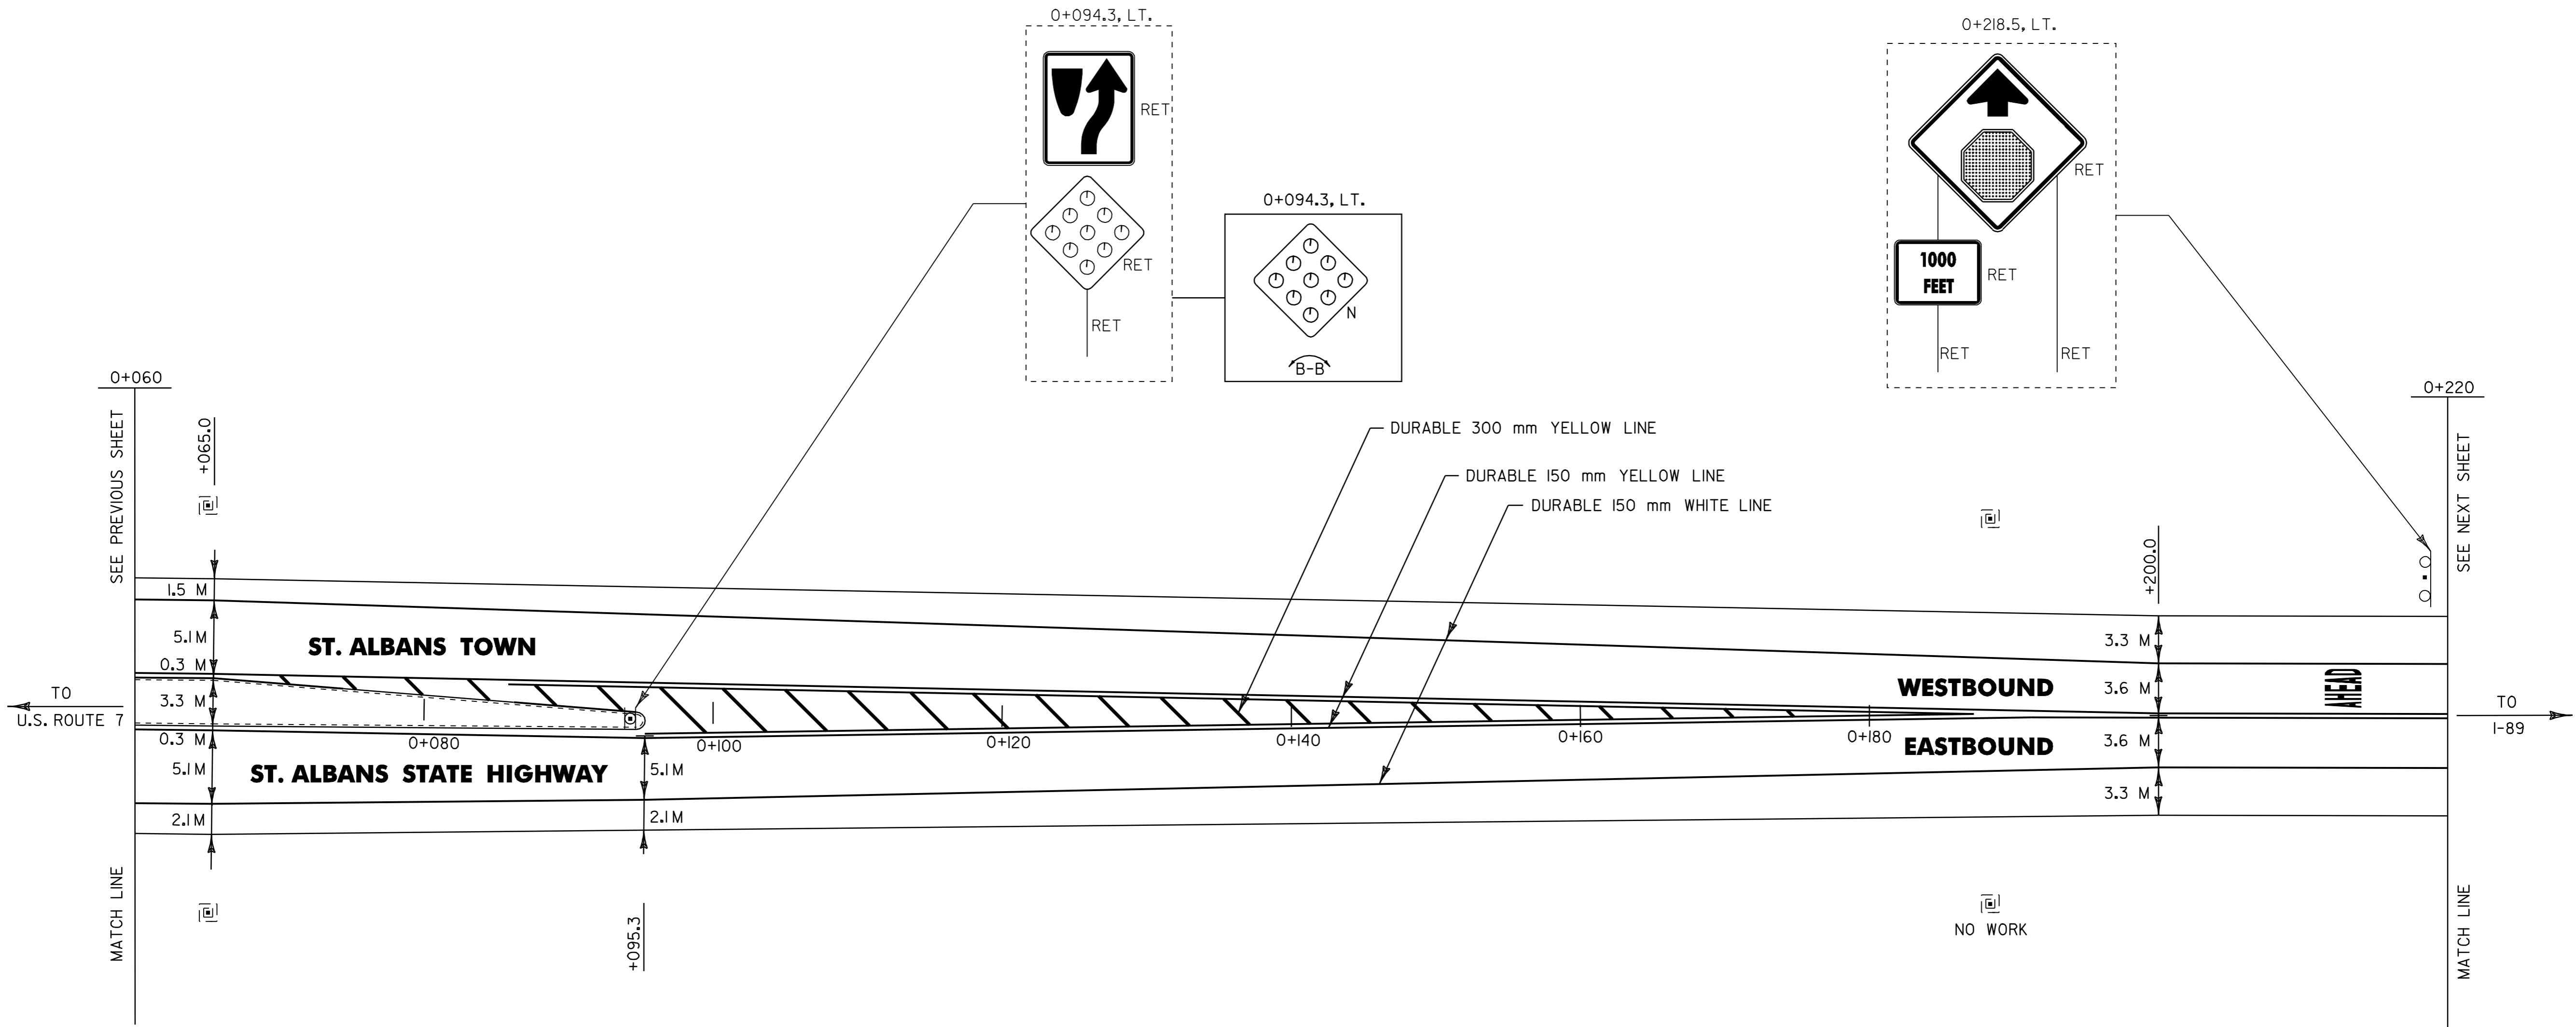

NOTE:
1) ALL DIMENSIONS IN MILLIMETERS EXCEPT WHERE OTHERWISE INDICATED
2) ALL EXISTING SIGNS NOT SHOWN SHALL BE RETAINED AS DIRECTED BY THE RESIDENT ENGINEER.

PROJECT LAYOUT #2

PROJECT NAME: ST. ALBANS CITY-ST. ALBANS
PROJECT NUMBER: STP 2204(I)S
FILE NAME: Z:\pave\2204\pb160.dgn
PLOT DATE: 01-FEB-2006 07:59
PROJECT LEADER: JLL
DRAWN BY: D-H
DESIGNED BY: D-H
CHECKED BY:
IPARM FILE NAME: pb16021
SHEET 97 OF 105




TEMPORARY AND DURABLE 150 mm WHITE LINE
STA. 0+220.0 TO 0+380.0, SOLID LT. & RT.

TEMPORARY AND DURABLE 150 mm YELLOW LINE
STA. 0+220.0 TO 0+380.0, SOLID LT. & RT.

~~DURABLE LETTERS OR SYMBOLS (TYPE I TAPE)~~
~~STA. 0+224.5, LT - STOP~~

~~TEMPORARY LETTERS OR SYMBOLS~~
~~STA. 0+224.5, LT - STOP~~

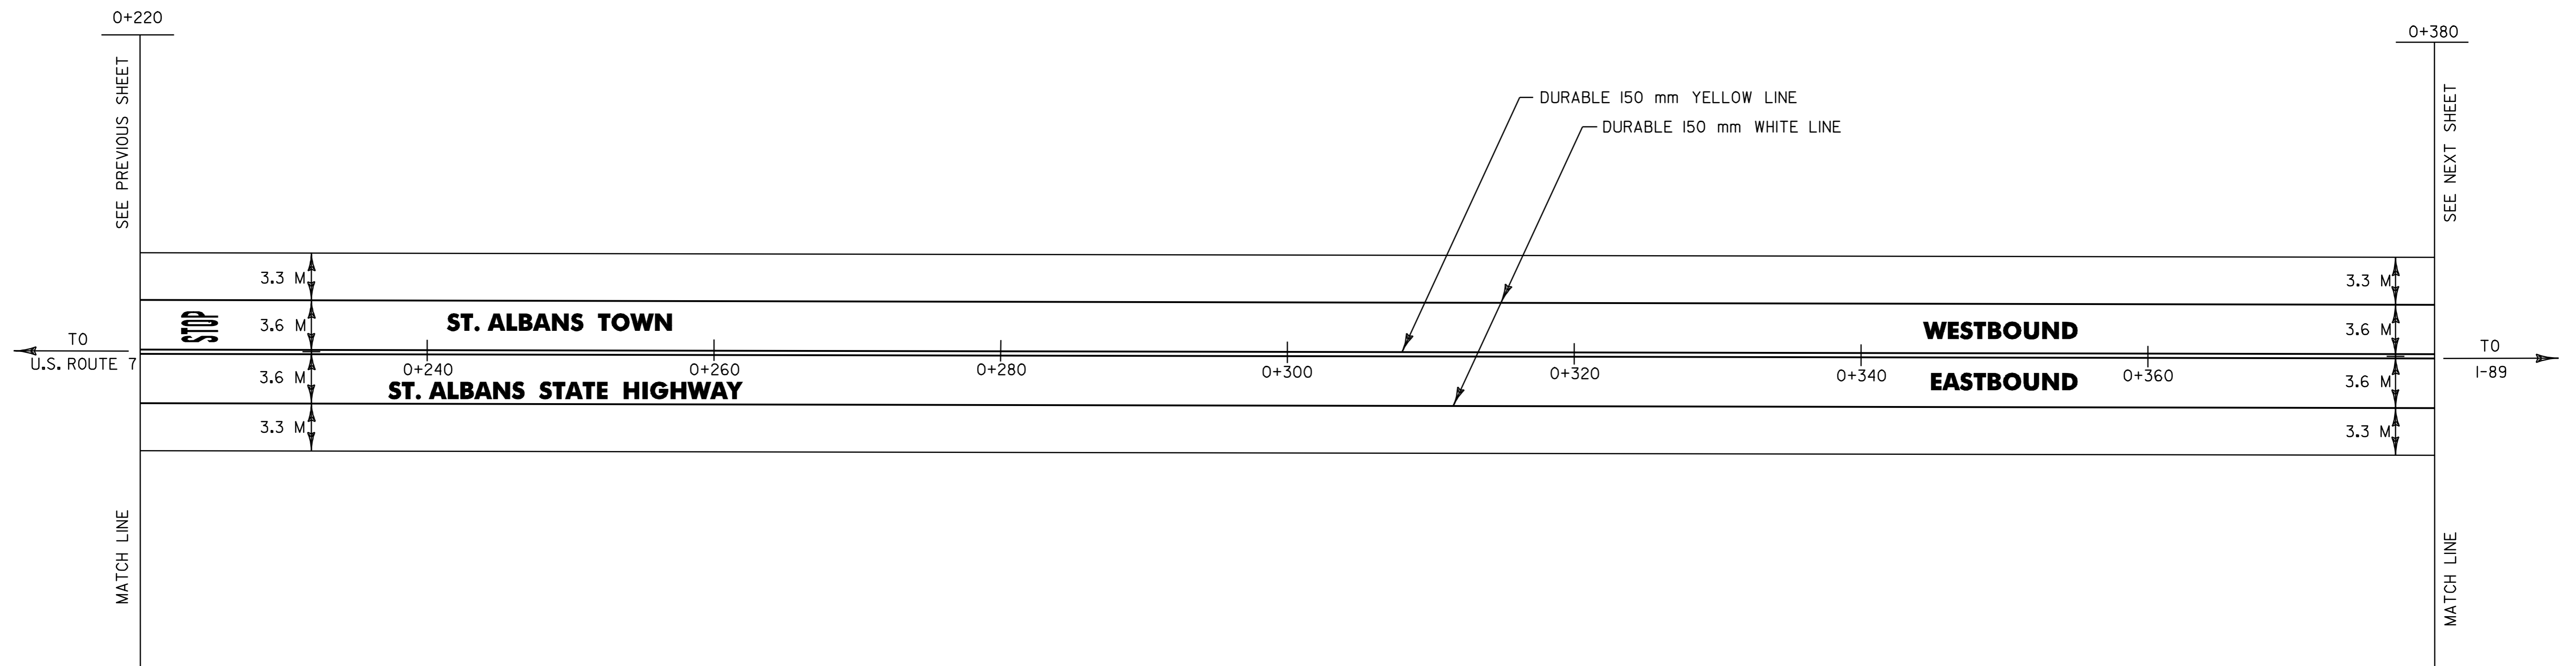

NOTE: _____
 1) ALL DIMENSIONS IN MILLIMETERS
 EXCEPT WHERE OTHERWISE INDICATED _____
 2) ALL EXISTING SIGNS NOT SHOWN
 SHALL BE RETAINED AS DIRECTED
 BY THE RESIDENT ENGINEER. _____

PROJECT LAYOUT #3

PROJECT NAME: ST. ALBANS CITY-ST. ALBANS
 PROJECT NUMBER: STP 2204(I)S
 FILE NAME: Z:\gve\99\bl60\bl60.dgn PLOT DATE: 01-FEB-2006 07:59
 PROJECT LEADER: JLL DRAWN BY: Q-H
 DESIGNED BY: Q-H CHECKED BY:
 IPARM FILE NAME: bl603.l SHEET 98 OF 105




TEMPORARY AND DURABLE 150 mm WHITE LINE
 STA. 0+380.0 TO 0+540.0, SOLID LT. & RT.

TEMPORARY AND DURABLE 150 mm YELLOW LINE
 STA. 0+380.0 TO 0+540.0, SOLID LT. & RT.

DURABLE LETTERS AND SYMBOLS (TYPE ITAPE)
 STA. 0+497.0, LT. - "AHEAD" 479
 STA. 0+509.0, LT. - "STOP" 492

DITCH CLEANING
 STA. 0+402.0 TO 0+540.0, LT. (SITE 3)
 (FOR DETAILS, SEE SHEET 92)

~~TEMPORARY LETTERS AND SYMBOLS~~
~~STA. 0+497.0, LT. - "AHEAD"~~
~~STA. 0+509.0, LT. - "STOP"~~

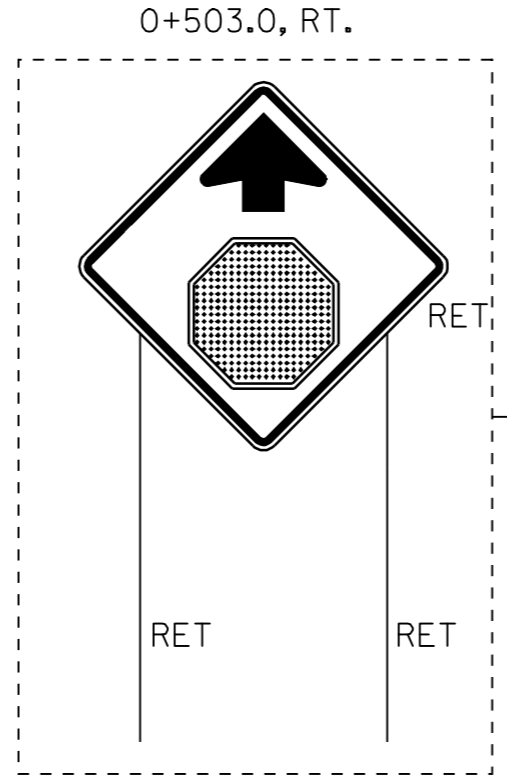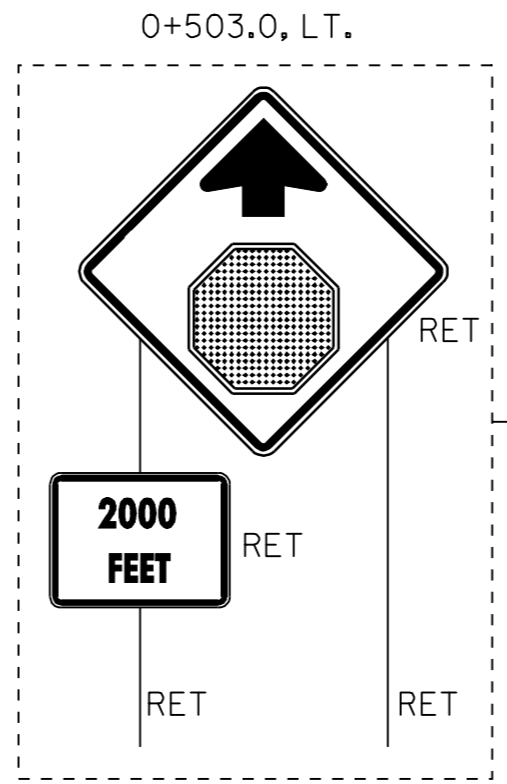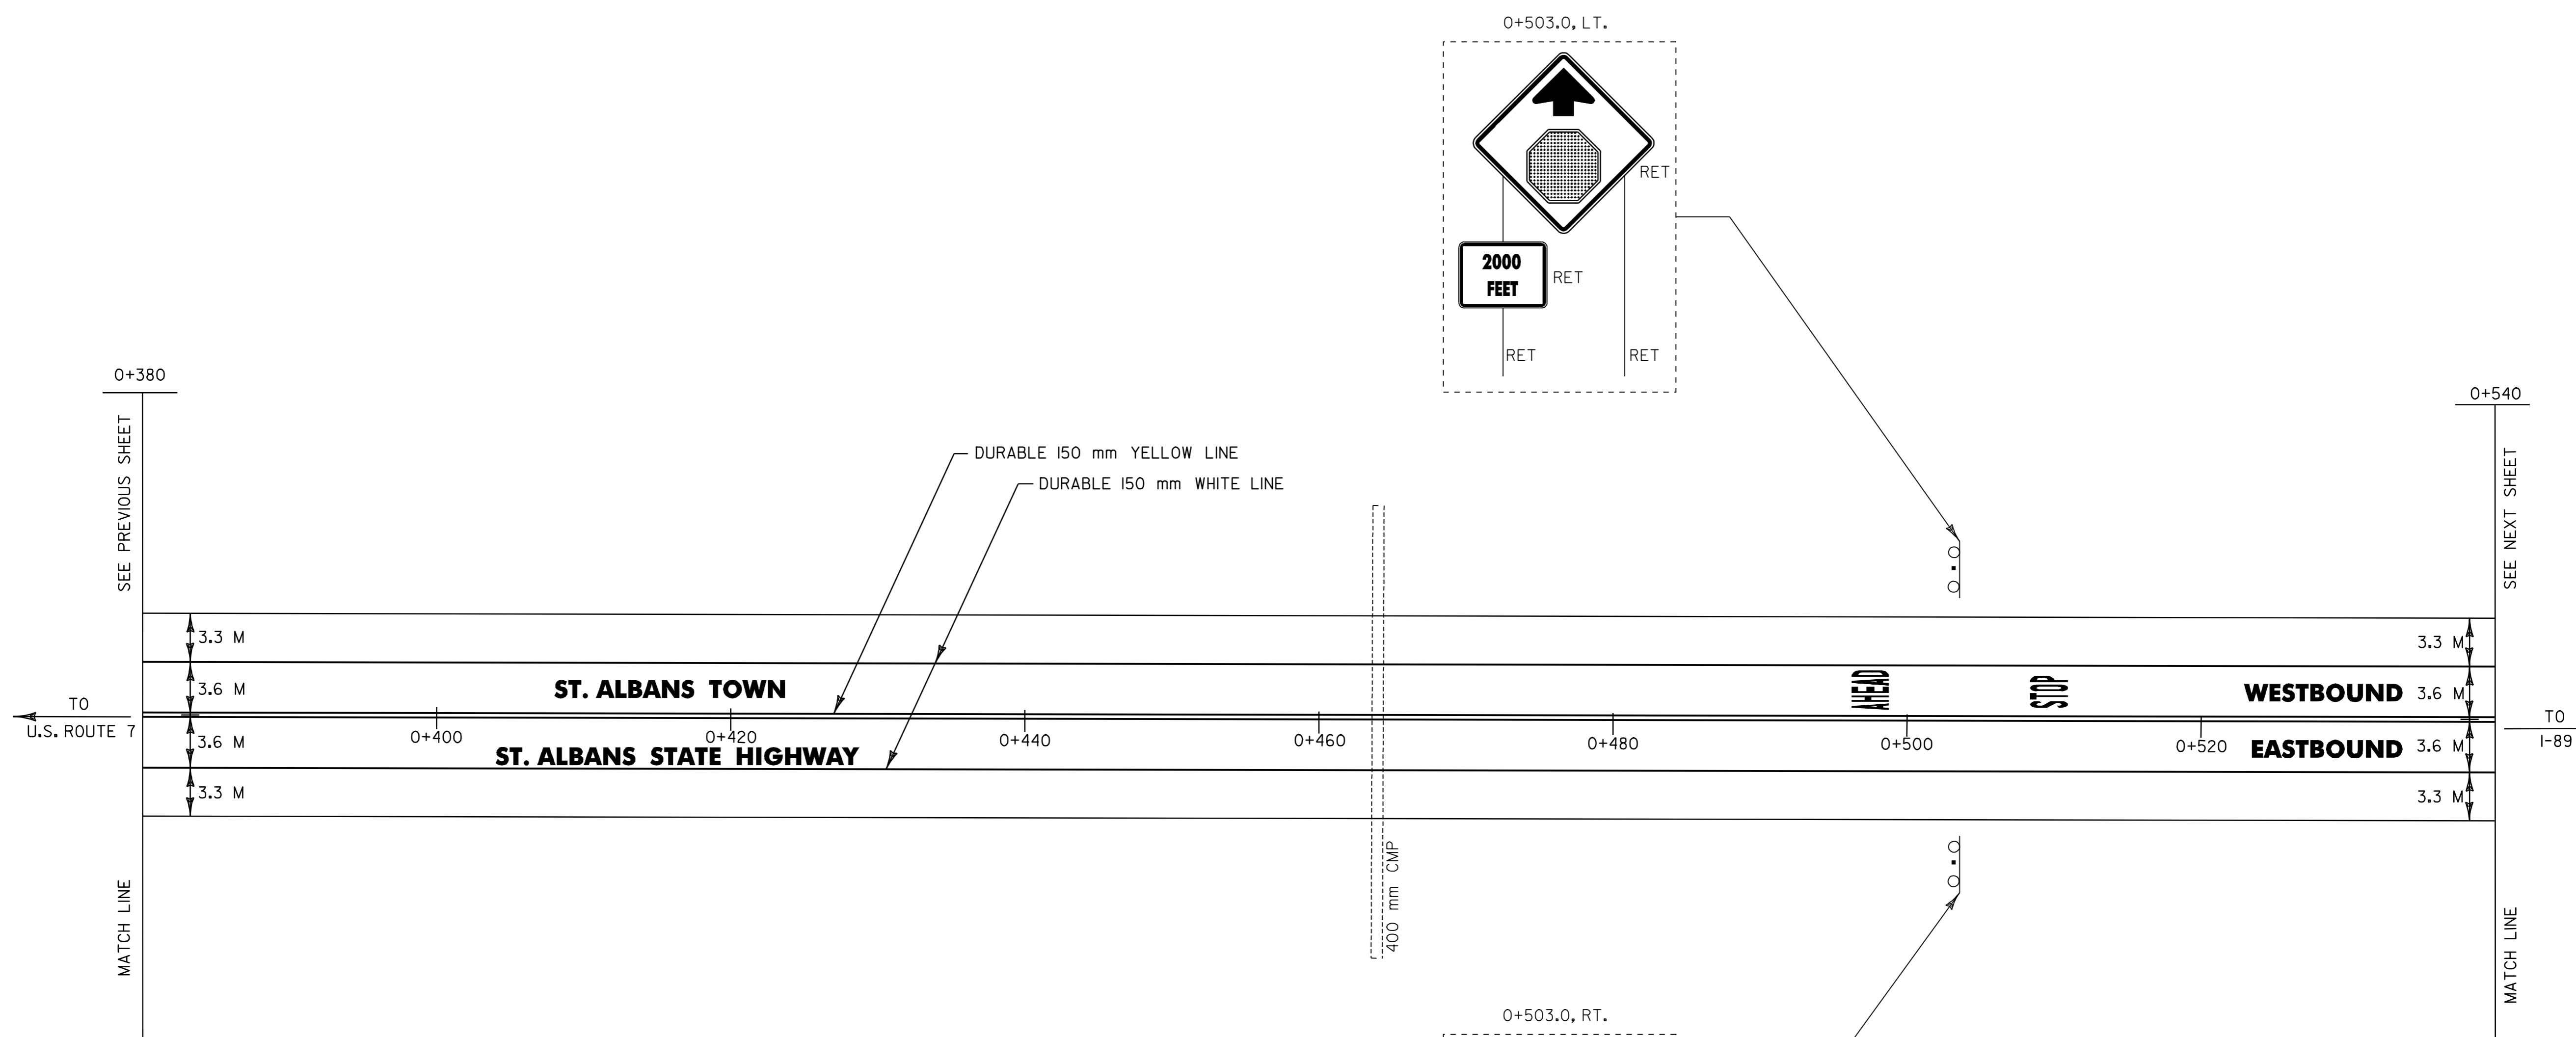

NOTE:
 1) ALL DIMENSIONS IN MILLIMETERS EXCEPT WHERE OTHERWISE INDICATED
 2) ALL EXISTING SIGNS NOT SHOWN SHALL BE RETAINED AS DIRECTED BY THE RESIDENT ENGINEER.

PROJECT LAYOUT #4


PROJECT NAME:	ST. ALBANS CITY-ST. ALBANS
PROJECT NUMBER:	STP 2204(I)S
FILE NAME:	/pave/99bl60/pbl60.dgn
PROJECT LEADER:	JLL
DESIGNED BY:	D-H
IPARM FILE NAME:	pbl6014.i
PLOT DATE:	01-FEB-2006 07:5
DRAWN BY:	D-H
CHECKED BY:	
SHEET	99 OF 105



TEMPORARY AND DURABLE 150 mm WHITE LINE
STA. 0+540.0 TO 0+700.0, SOLID LT. & RT.

TEMPORARY AND DURABLE 150 mm YELLOW LINE
STA. 0+540.0 TO 0+700.0, SOLID LT. & RT.

DITCH CLEANING
STA. 0+540.0 TO 0+547.0, LT. (SITE 3)
STA. 0+644.0 TO 0+700.0, RT. (SITE 4)
(FOR DETAILS, SEE SHEET 92)

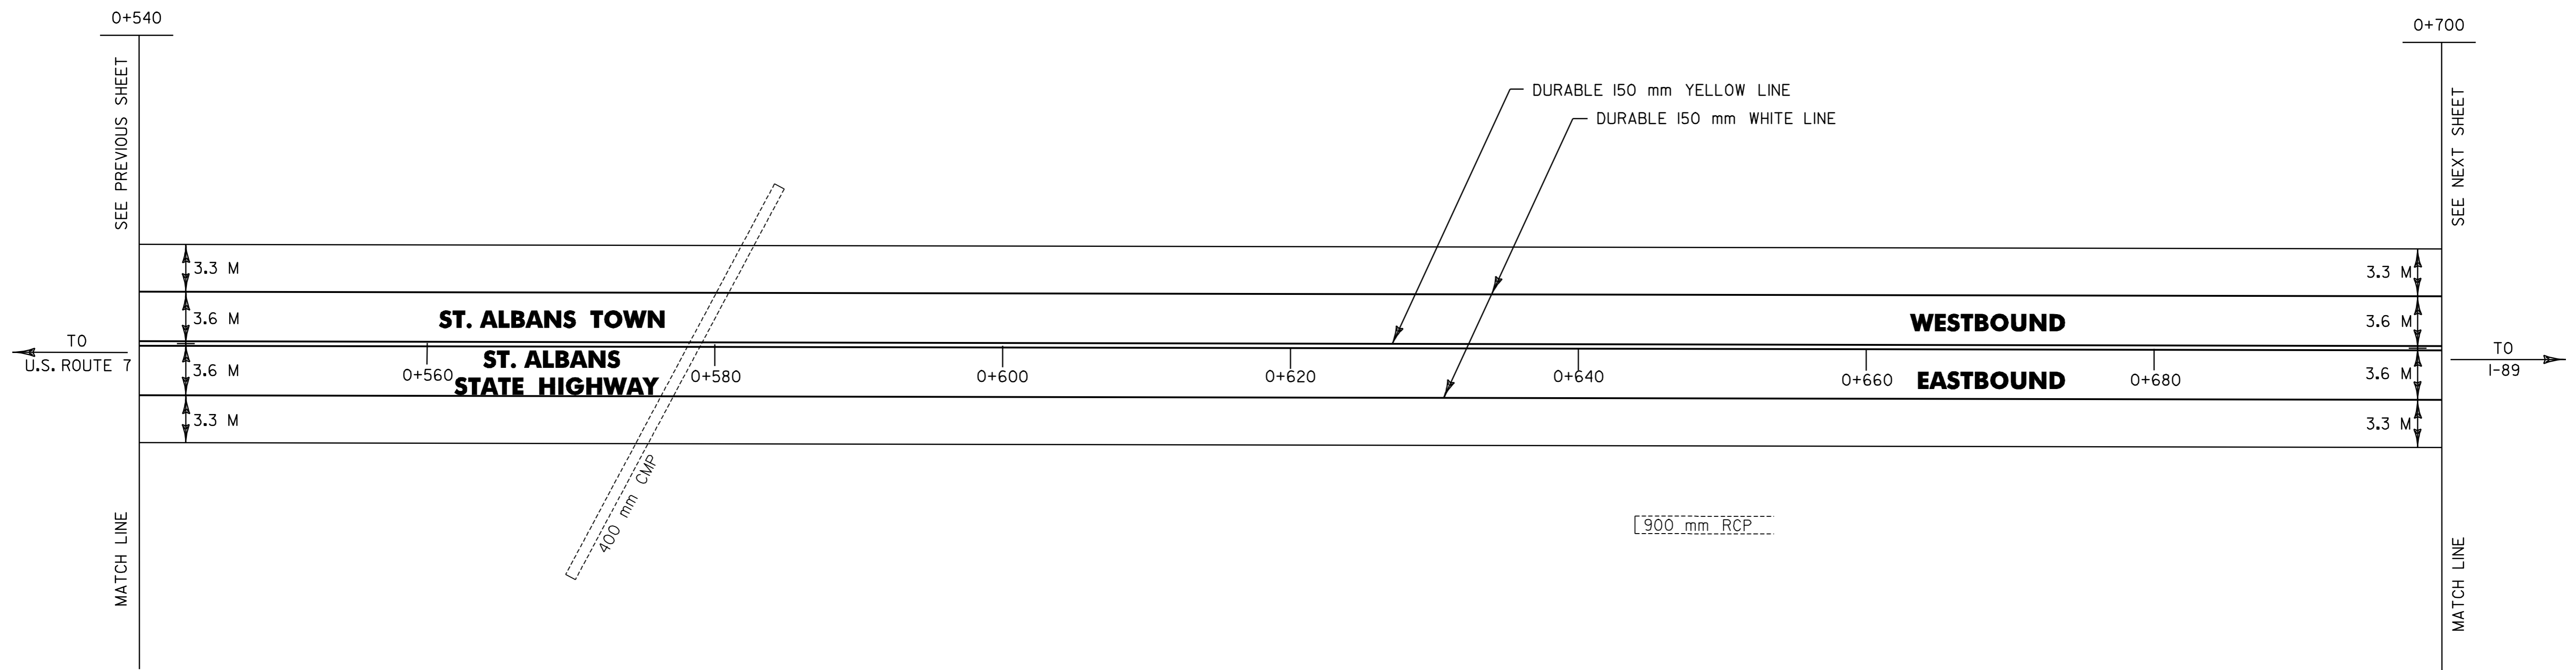

NOTE:
 1) ALL DIMENSIONS IN MILLIMETERS EXCEPT WHERE OTHERWISE INDICATED
 2) ALL EXISTING SIGNS NOT SHOWN SHALL BE RETAINED AS DIRECTED BY THE RESIDENT ENGINEER.

PROJECT LAYOUT #5

PROJECT NAME: ST. ALBANS CITY-ST. ALBANS	PLOT DATE: 01-FEB-2006 07:5
PROJECT NUMBER: STP 2204(I)S	DRAWN BY: D-H
FILE NAME: /pave/99bl60/pbl60.dgn	CHECKED BY:
PROJECT LEADER: JLL	SHEET 100 OF 105
DESIGNED BY: D-H	
IPARM FILE NAME: pbl6015.i	




TEMPORARY AND DURABLE 150 mm WHITE LINE
STA. 0+700.0 TO 0+860.0, SOLID LT. & RT.

TEMPORARY AND DURABLE 150 mm YELLOW LINE
STA. 0+700.0 TO 0+860.0, SOLID LT. & RT.

REHABILITATION OF DI'S, CB'S OR MH'S
STA. 0+740.0, LT. & RT.

DITCH CLEANING
STA. 0+700.0 TO 0+740.0, RT. (SITE 4)
STA. 0+837.0 TO 0+860.0, LT. (SITE 5)
(FOR DETAILS, SEE SHEET 92)

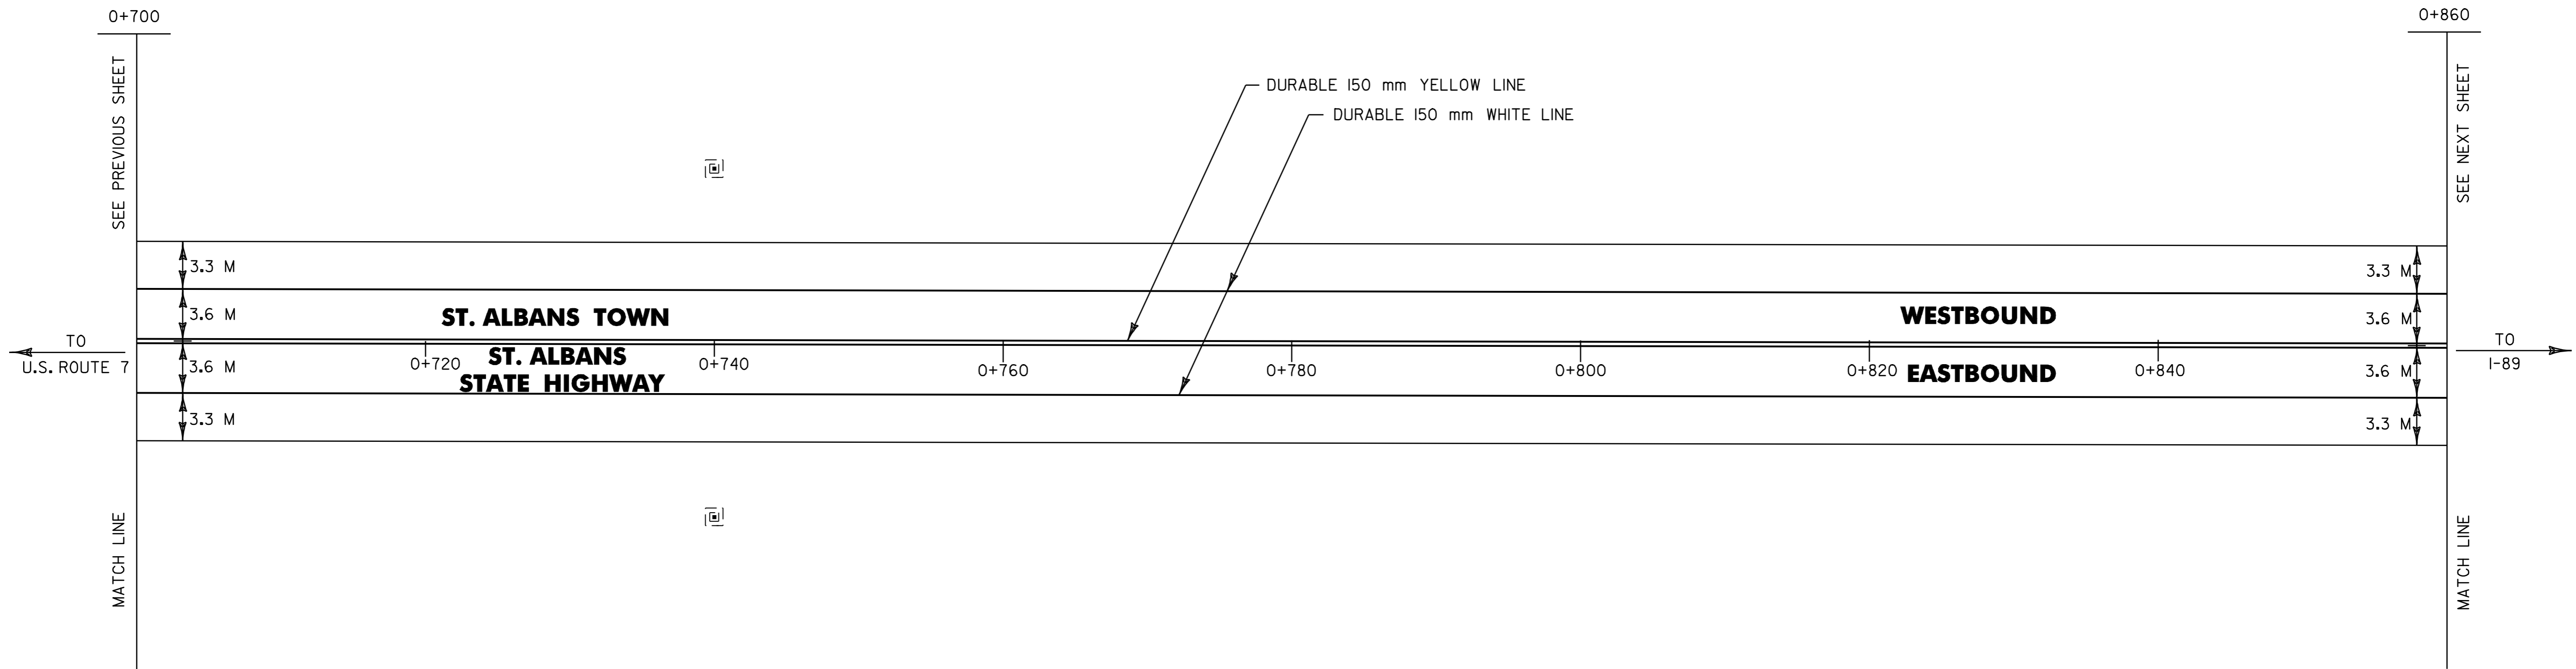

NOTE:
 1) ALL DIMENSIONS IN MILLIMETERS EXCEPT WHERE OTHERWISE INDICATED
 2) ALL EXISTING SIGNS NOT SHOWN SHALL BE RETAINED AS DIRECTED BY THE RESIDENT ENGINEER.

PROJECT LAYOUT #6

PROJECT NAME:	ST. ALBANS CITY-ST. ALBANS
PROJECT NUMBER:	STP 2204(I)S
FILE NAME:	/pave/99bl60/pbl60.dgn
PROJECT LEADER:	JLL
DESIGNED BY:	D-H
IPARM FILE NAME:	pbl6016.i
PLOT DATE:	01-FEB-2006 07:5
DRAWN BY:	D-H
CHECKED BY:	
SHEET	101 OF 105



TEMPORARY AND DURABLE 150 mm WHITE LINE
STA. 0+860.0 TO 1+020.0, SOLID LT. & RT.

TEMPORARY AND DURABLE 150 mm YELLOW LINE
STA. 0+860.0 TO 0+937.6, SOLID LT. & RT.
STA. 0+937.6 TO 1+020.0, DOUBLE SOLID LT. & RT.

~~TEMPORARY AND DURABLE 300 mm YELLOW LINE~~
STA. 0+953.7 TO 1+020.0 (DIAGONALS)


DURABLE LETTERS OR SYMBOLS (TYPE I TAPE)
STA. 0+969.0, RT - *SIGNAL* 957
STA. 0+981.0, RT - *AHEAD* 963

DITCH CLEANING
STA. 0+860.0 TO 1+020.0, LT. (SITE 5)
(FOR DETAILS, SEE SHEET 92)



~~TEMPORARY LETTERS OR SYMBOLS~~
STA. 0+969.0, RT - *SIGNAL*
STA. 0+981.0, RT - *AHEAD*

REMOVING SIGNS
AS SHOWN - 1

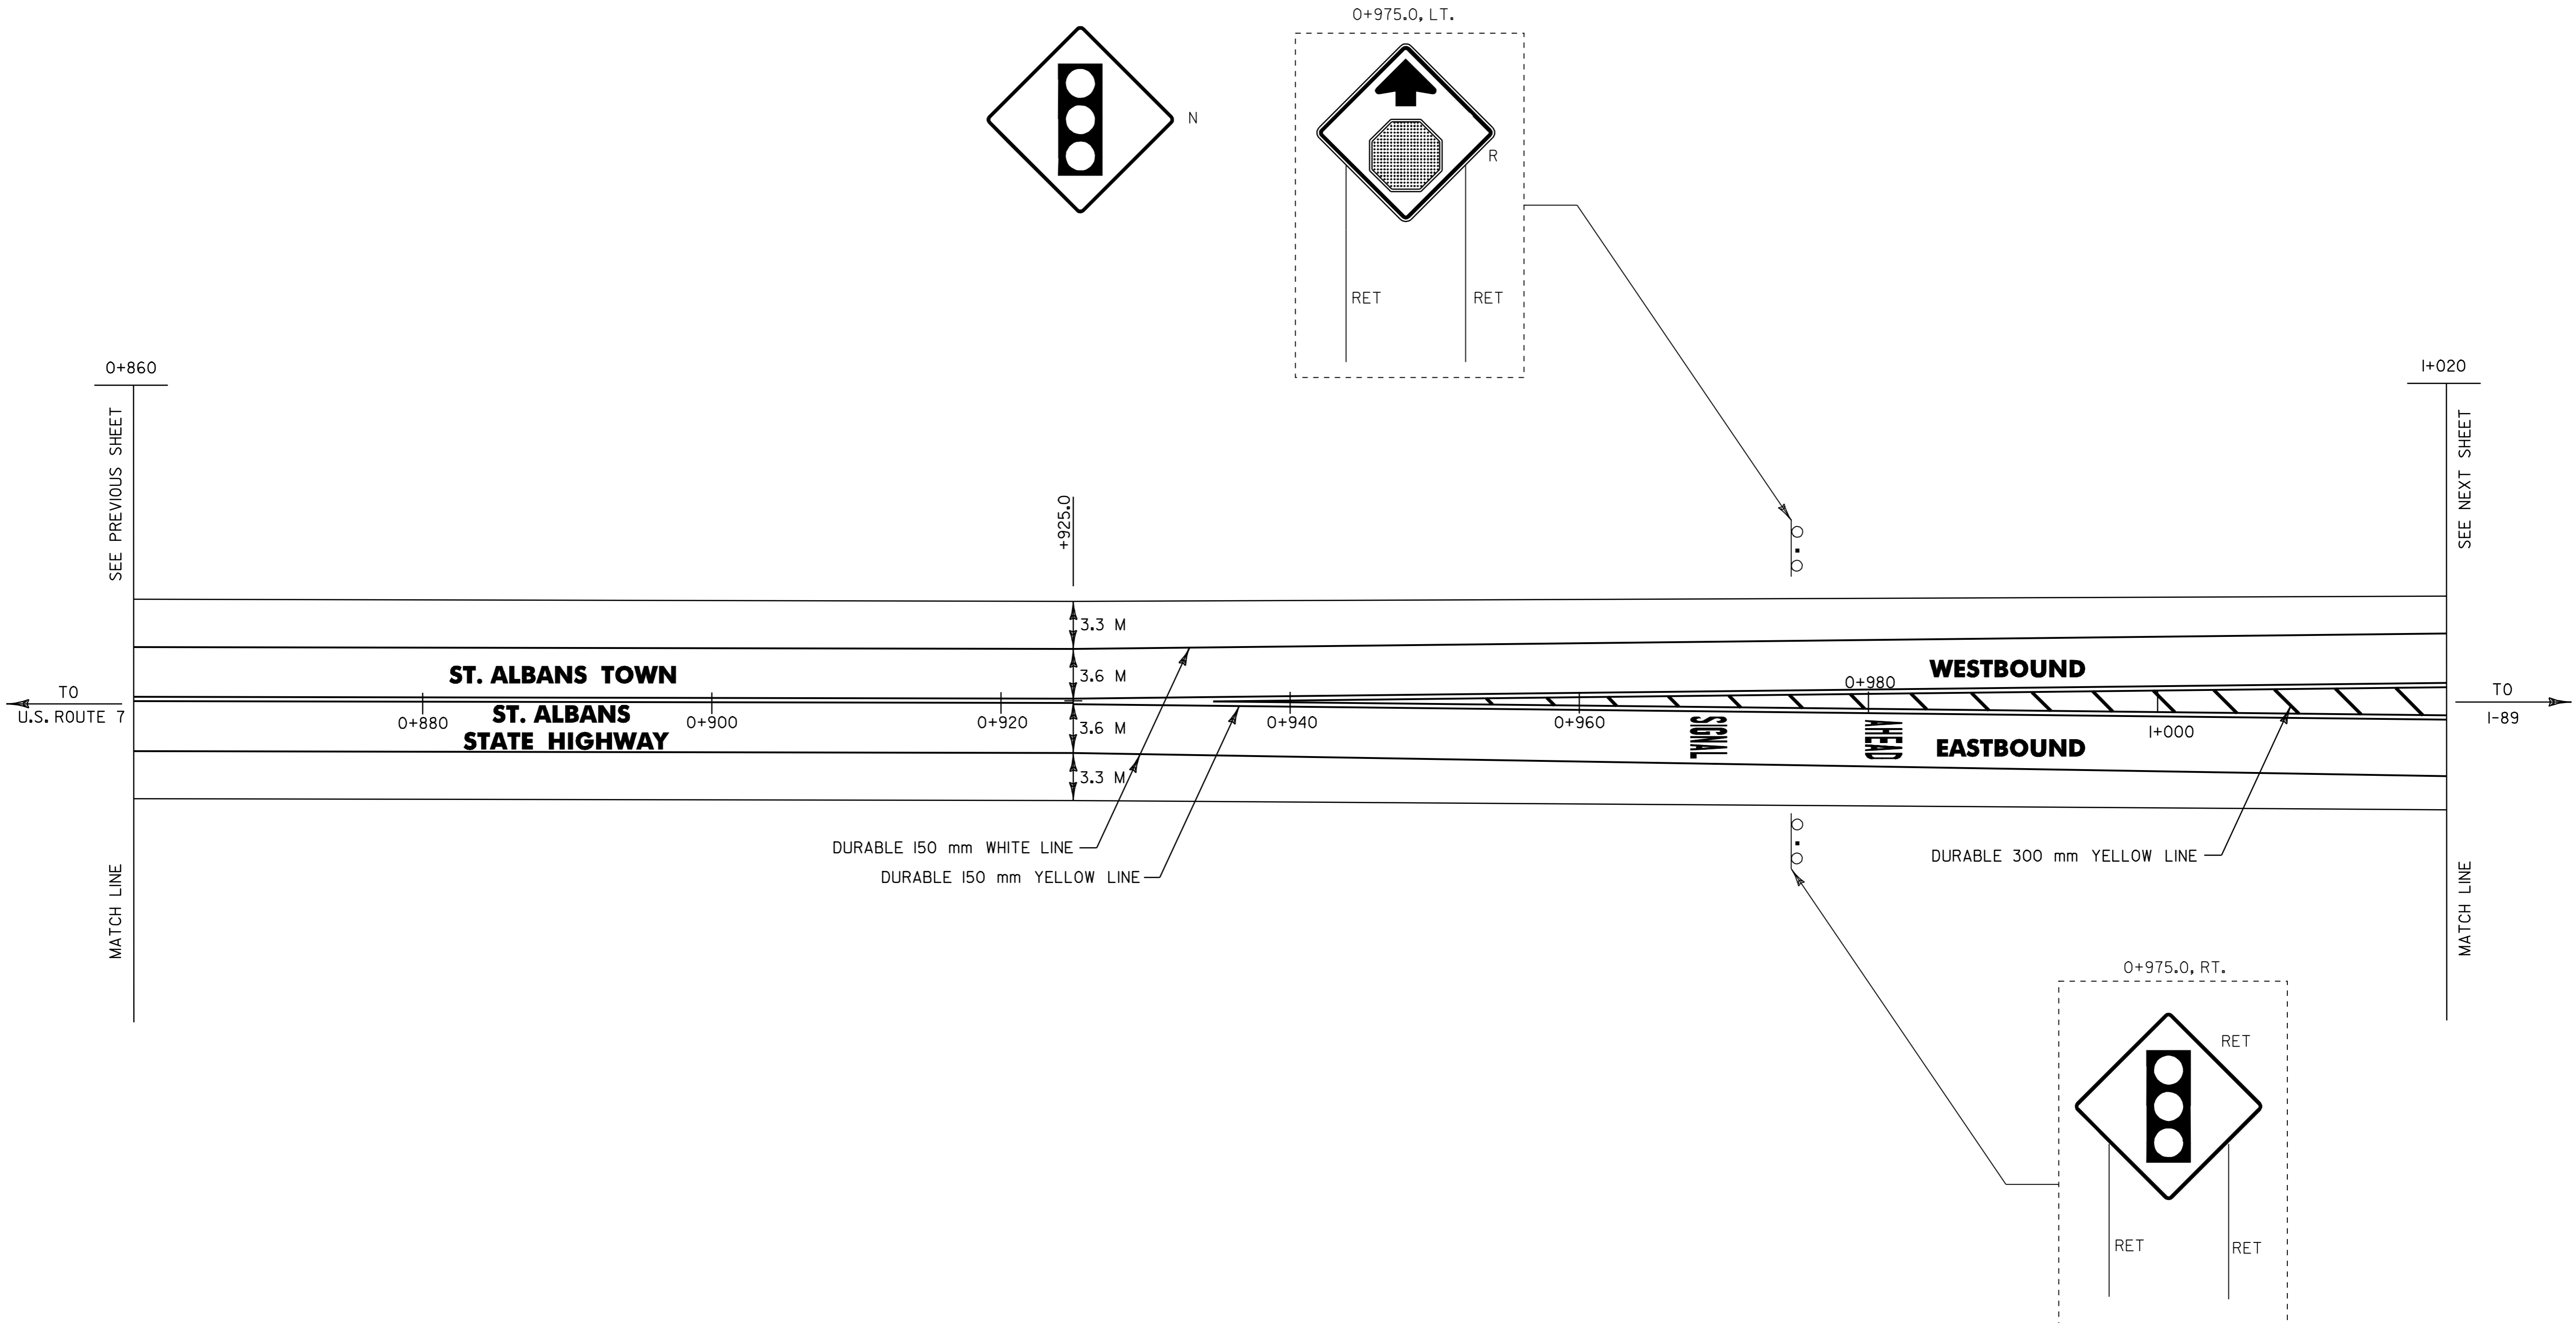

NOTE:
1) ALL DIMENSIONS IN MILLIMETERS EXCEPT WHERE OTHERWISE INDICATED
2) ALL EXISTING SIGNS NOT SHOWN SHALL BE RETAINED AS DIRECTED BY THE RESIDENT ENGINEER.

PROJECT LAYOUT #7

PROJECT NAME:	ST. ALBANS CITY-ST. ALBANS	FILE NAME:	/pave/99bl60/pbl60.dgn	PLOT DATE:	01-FEB-2006 07:5
PROJECT NUMBER:	STP 2204(I)S	PROJECT LEADER:	JLL	DRAWN BY:	D-H
		DESIGNED BY:	D-H	CHECKED BY:	
		IPARM FILE NAME:	pbl6017.i	SHEET	102 OF 105



TEMPORARY AND DURABLE 150 mm WHITE LINE
 STA. I+020.0 TO I+039.64, SOLID LT. & RT.


TEMPORARY AND DURABLE 150 mm YELLOW LINE
 STA. I+020.0 TO I+039.64, DOUBLE SOLID LT. & RT.

TEMPORARY AND DURABLE 300 mm YELLOW LINE
 STA. I+020.0 TO I+039.64 (DIAGONALS)

DITCH CLEANING
 STA. I+020.0 TO I+039.64, LT. (SITE 5)
 (FOR DETAILS, SEE SHEET 92)



END STP 2204(1)S
ST. ALBANS STATE HIGHWAY
ST. ALBANS TOWN
STA. I+039.64 = MM 0.646

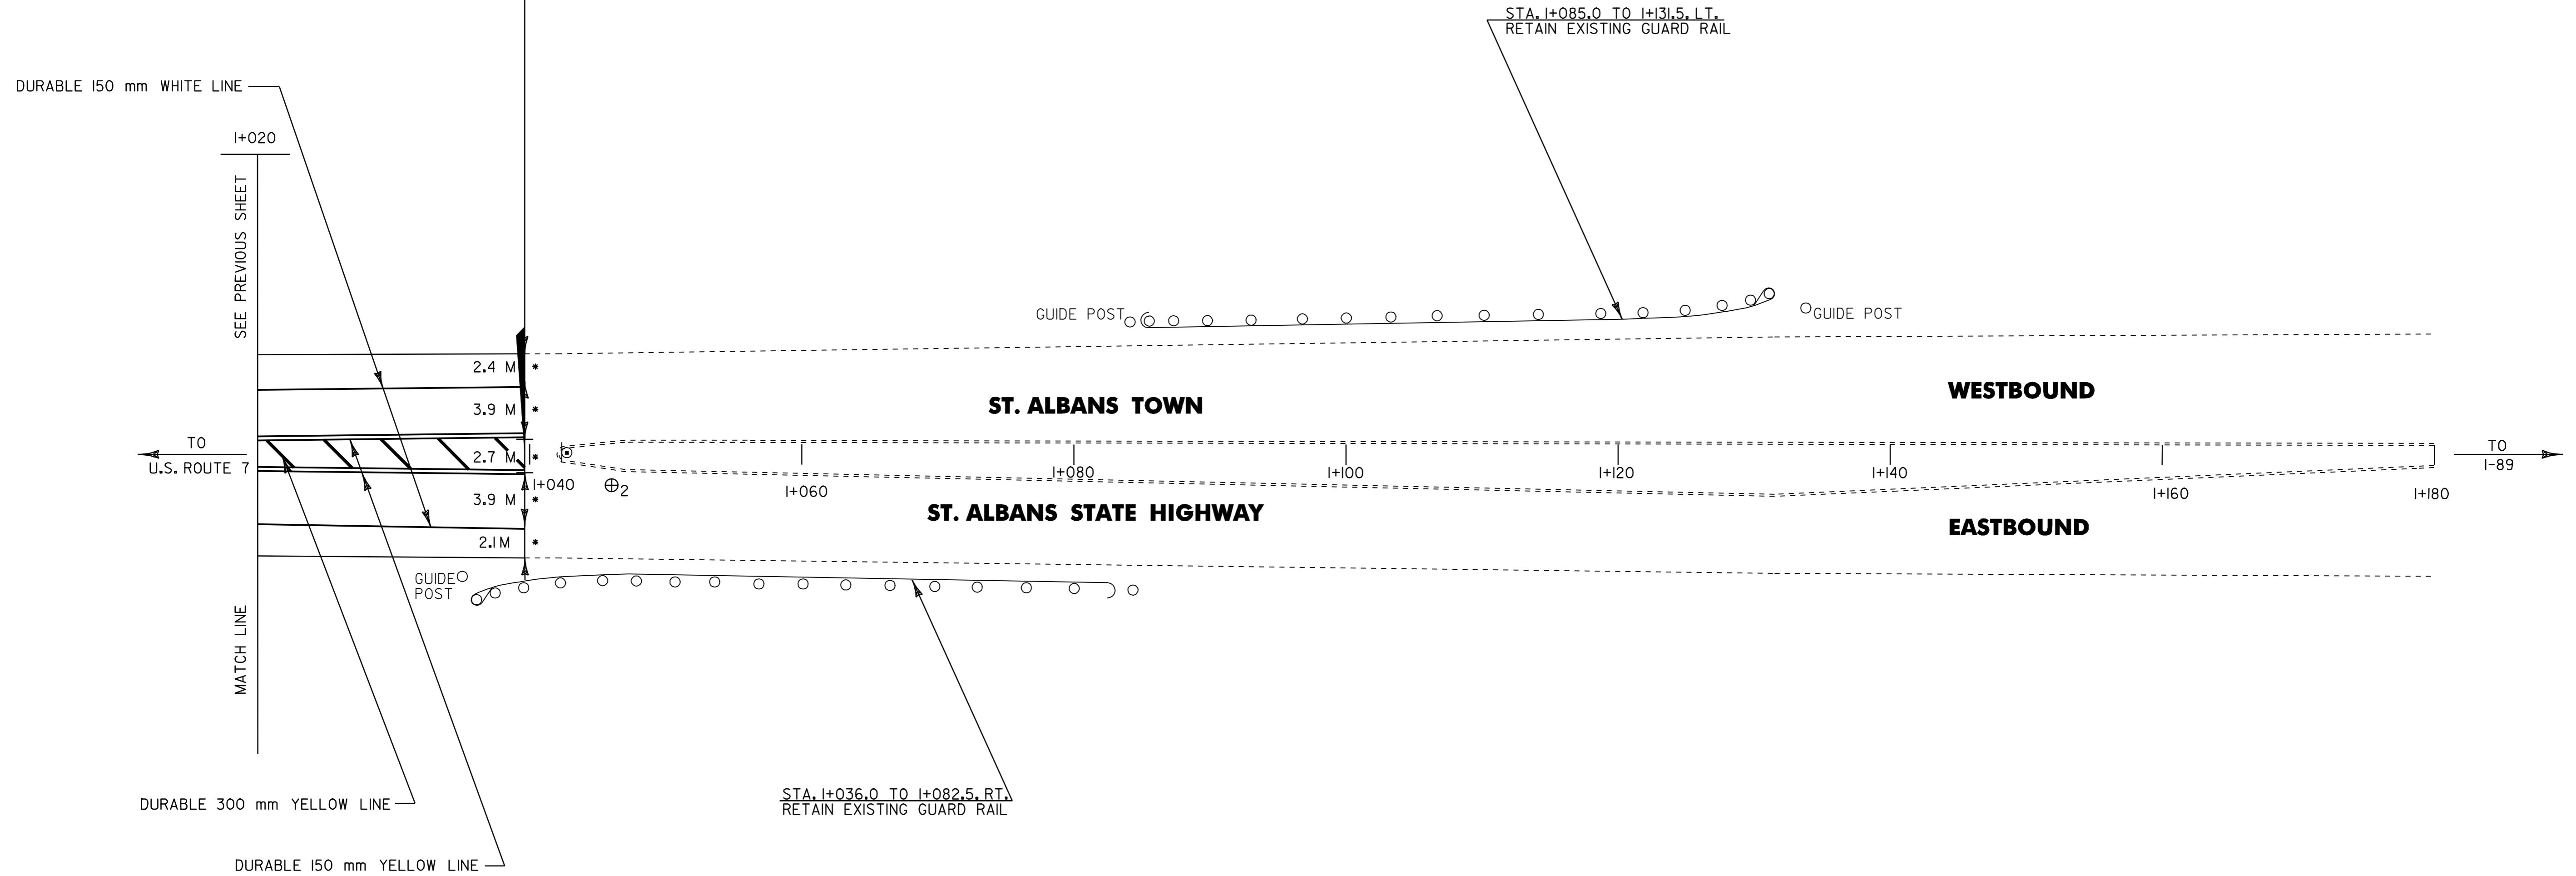

⊕ CORE LOCATION

PAVEMENT CORE DATA			
CORE #	LOCATION	DEPTH (mm)	PCC
2	I+046.1, RT.	83	NO

NOTE:
 1) ALL DIMENSIONS IN MILLIMETERS EXCEPT WHERE OTHERWISE INDICATED

2) ALL EXISTING SIGNS NOT SHOWN SHALL BE RETAINED AS DIRECTED BY THE RESIDENT ENGINEER.

* MATCH EXISTING CONDITIONS

PROJECT LAYOUT #8

PROJECT NAME: ST. ALBANS CITY-ST. ALBANS
 PROJECT NUMBER: STP 2204(1)S

FILE NAME: /pave/99bl60/pbl60.dgn
 PROJECT LEADER: JLL
 DESIGNED BY: D-H
 IPARM FILE NAME: pbl6018.1

PLOT DATE: 01-FEB-2006 07:5
 DRAWN BY: D-H
 CHECKED BY:
 SHEET 103 OF 105



KILOMETER MARKER, STATION, OR SIGN NUMBER	SIGN LEGEND	SIGN DIMENSIONS		NEW & SALVAGED SIGNS				EXIST POST RETAINED	SALVAGED	NO. OF POSTS	NEW SIGN POSTS																REMARKS	SIGN DETAIL							
		EA	WIDTH (mm)	HEIGHT (mm)	"A"	"B"	SALV SIGN				SALV TIS	FLANGED CHANNEL			SQUARE STEEL (mm)			TUBULAR ALUMINUM Ø (mm)			TUBULAR STEEL Ø (mm)				W-SHAPE STEEL			DETAIL ON SHEET NUMBER	STD. SHEET NUMBER						
												1.7	3.0	4.5	44	50	63	75	100	100 MOD	FOUND-ATION		75	89	100	125				FTG. SIZE		WEIGHT	POST SIZE		
											OPTION ITEMS * ANCHOR = 1 METER																								
ST. ALBANS CITY 0+014.0, RT.		1	900	900	0.81					-																							MOUNT NEW STOP SIGN ON EXISTING ASSEMBLY, REPLACING THE EXISTING STOP SIGN		E-143M
0+019.0, LT.		1	900	900	0.81					-																						MOUNT NEW STOP SIGN BELOW NEW FLASHING BEACON ON THE EXISTING POST, USING THE EXISTING POWER SOURCE AND WIRING		E-143M	
0+095.0, RT.		1	1500	190	0.29					2			3.1		1.0																	MOUNT NEW SIGN ON TWO NEW POSTS	-	E-124M	
ST. ALBANS TOWN 0+000.5, LT.		1	900	750	0.68					1			3.2		1.0																		MOUNT NEW SIGN ON EXISTING POSTS		E-145AM
0+094.3, LT.		1	450	450	0.20					1																							MOUNT NEW SIGN BACK TO BACK WITH EXISTING HAZARD SIGN ON EXISTING POST.		E-150M
0+975.0, LT.		1	1200	1200	1.44					1			4.0		1.0																		MOUNT NEW SIGN ON EXISTING POSTS		E-152M
SUBTOTALS					4.23								+3.8		13.4																				
ROUNDING					-0.77								-0.2		-0.2																				

FINAL POST LENGTHS ARE TO BE DETERMINED IN THE FIELD. POST SIZES ARE COMPUTED BASED ON INFORMATION FURNISHED ON THE STANDARD SHEETS AND THE TRAFFIC & SAFETY DIVISION'S "SIGN POST DESIGN GUIDELINE."

TOTALS

m ²	m ²	EA.	m ²		m	m	EA	kg	kg	kg	kg	kg	kg	EA.	EA.	kg
4.23	5.0				14.0	14.0										

PROJECT NAME: ST. ALBANS CITY - ST. ALBANS
 PROJECT NUMBER: STP 2204(I)S
 FILE NAME: /pave/99b160/pbl60.dgn PLOT DATE: 01-FEB-2006 07:59
 PROJECT LEADER: JLL DRAWN BY: D-H
 DESIGNED BY: D-H CHECKED BY:
 IPARM FILE NAME: pbl60ts.i SHEET 104 OF 105

UTILITY LOCATIONS*
(FOR INFORMATIONAL PURPOSES ONLY)

STATION	POSITION	DESCRIPTION
ST. ALBANS CITY		
0+010.2	RT	DI
0+012.2	LT	DI
0+039.5	LT & RT	DI
ST. ALBANS		
0+066.7	LT & RT	DI
0+188.0	LT & RT	DI
0+740.0	LT & RT	DI

REHABILITATION OF DI'S, CB'S OR MH'S - CLASS I
(ITEM 604.412)

STATION	POSITION	DESCRIPTION
ST. ALBANS CITY		
0+010.2	RT	DI
0+012.2	LT	DI
0+039.5	LT	DI
ST. ALBANS		
0+064.7	LT & RT	DI 2
0+188.5	LT	DI
0+740.0	LT & RT	DI 2
0+212.2	LT	DI

*NOTE: THE UTILITY LOCATIONS AND DESCRIPTIONS SHOWN ABOVE ARE APPROXIMATE AND ARE BASED ON INFORMATION OBTAINED FROM FIELD REVIEWS AND/OR RECORD UTILITY PLANS AS SUPPLIED BY THE MUNICIPALITY. REFER TO THE SPECIAL PROVISIONS FOR CONTACT PERSONS OF PRIVATE UTILITY COMPANIES.



UTILITY AND STRUCTURE LOCATIONS	PROJECT NAME: ST. ALBANS CITY - ST. ALBANS	
	PROJECT NUMBER: STP 2204(I)S	
	FILE NAME: /pave/99b160/pbl60.dgn	PLOT DATE: 01-FEB-2006 07:5
	PROJECT LEADER: JLL	DRAWN BY: D-H
	DESIGNED BY: D-H	CHECKED BY:
	IPARM FILE NAME: pbl60usl.1	SHEET 105 OF 105