

VERTICAL GRANITE CURB
 2+830.000 RT ~ 22+040.000 RT
 2+837.392 LT ~ 2+858.767 LT
 2+860.513 RT ~ 2+940.334 RT
 2+878.370 LT ~ 2+942.164 LT
 2+898.153 RT ~ 2+918.413 RT
 2+926.242 RT ~ 2+938.812 RT
 2+942.734 RT ~ 2+948.893 RT
 2+961.144 RT ~ 2+984.000 RT
 32+032.032 RT ~ 3+000.000 LT
 32+032.032 RT ~ 2+990.217 LT
 22+009.221 LT ~ 22+022.251 LT
 22+033.685 LT ~ 22+040.000 LT
 32+008.931 LT ~ 32+040.000 LT

REMOVAL OF EXISTING FENCE
 2+884.000 LT ~ 2+887.000 LT
 2+940.000 LT ~ 2+943.000 LT

CONSTRUCT PAVED ISLAND
 32+032.032 RT ~ 2+990.217 LT

CONSTRUCT BIKE/PED PATH
 22+040.000 LT ~ 2+939.426 RT
 32+011.311 LT ~ 32+040.000 LT

REMOVING AND RESETTING LIGHT POLE
 FROM 22+021.346, 23.735m LT
 TO 22+018.000, 19.400m LT

CONSTRUCT SIDEWALK
 RAMP WITH
 DETECTABLE WARNING
 SURFACE
 (SEE STD C-3A, C-3B)

22+008.030 LT, RAMP TYPE 2
 2+941.539 RT, RAMP TYPE 1
 2+943.520 LT, RAMP TYPE 1

CONSTRUCT DRIVE
 2+832.386 LT (8.8 m PAVED)
 2+871.121 LT (7.3 m PAVED)
 2+955.001 RT (12.2m PAVED)
 32+040.044 RT (12 m PAVED)
 22+027.733 LT (7.3 m PAVED)

4B
TOWN OF COLCHESTER

**JR MARVIN PROPERTIES LLC
 and
 GERRY ROY PROPERTIES LLC**

U.S. ROUTE 7 POT 2+859.940 = 3619 ROOSEVELT HWY
 VT ROUTE 2A POT 22+000.000
 $\Delta = 129^\circ 56' 54.2''$ RT
 END FULL DEPTH
 US ROUTE 7 2+857.000
 CONSTRUCTION
 BEGIN OVERLAY
 CONSTRUCTION

12
**CREEK FARM REAL ESTATE
 HOLDINGS LLC**
 63-69 CREEK FARM RD

END MAINT. AGREE. #2
TH16 32+033.0 CL
L = 25.2M(83')

U.S. ROUTE 7 2+954.251, 7.892 m LT =
 CREEK FARM RD (TH 16) 32+008.183
 BEGIN APPROACH CONSTRUCTION

**BRAULT'S
 MOBILE
 HOME, INC.**

BEGIN MAINT. AGREE. #2
TH16 32+007.8 CL

**WESCO REALTY,
 LLC**

STATE OF VERMONT
 COND. HWYS I/P. 76
 7/16/1941
 PROJ. 165-L

**AMERICAN LEGION
 COLCHESTER POST #91 INC.**
 3650 ROOSEVELT HWY

**BRAULT'S MOBILE
 HOME, INC.**


**FOR R.O.W.
 USE ONLY**

LINE SHOWN ON THIS PLAN AS EXISTING
 PROPERTY LINES P/L ARE BELIEVED TO
 BE ACCURATE BUT SHOULD NOT BE RELIED
 UPON FOR PURPOSES UNRELATED TO THE
 STATE OF VERMONT'S ACQUISITION OF LAND
 AND RIGHTS FOR THIS PROJECT.

**NEW HORIZON
 ENTERPRISES**

EXISTING	PROPOSED
IP 2+837.109 11.328LT	NONE
BND 2+837.328 10.570LT	BND 2+837.328 10.570LT
IP 2+947.728 11.672RT	IP 2+947.728 11.672RT
BND 2+947.728 11.672RT	BND 2+947.728 11.672RT

- 2) SEE SIGNAL PLANS FOR LOCATIONS OF TRAFFIC SIGNALS AND MAST ARMS.
- 3) SEE DRAINAGE PLANS FOR LOCATION OF PROPOSED DRAINAGE FACILITIES.
- 4) SEE UTILITY PLANS FOR LOCATIONS OF PROPOSED UTILITY RELOCATIONS.
- 5) CLEARING IS ALLOWED TO THE PDF FENCING, HOWEVER, CONTRACTOR SHALL MINIMIZE CLEARING OF VEGETATION TO THE EXTENT POSSIBLE.

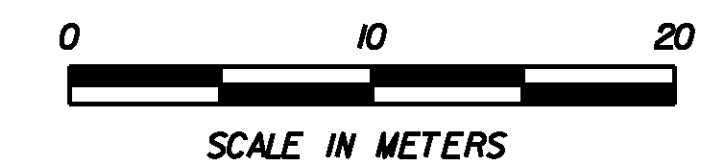

PROJECT NAME: COLCHESTER
 PROJECT NUMBER: STP 5600(9)S

FILE NAME: r97d206Lay3.dgn
 PROJECT LEADER: J. SCHULTZ
 DESIGNED BY: D. BRYANT
 ROW LAYOUT SHEET 3 OF 9

PLOT DATE: 23-FEB-2016
 DRAWN BY: E. PIERCE
 CHECKED BY: E. PIERCE
 SHEET 12 OF 74