


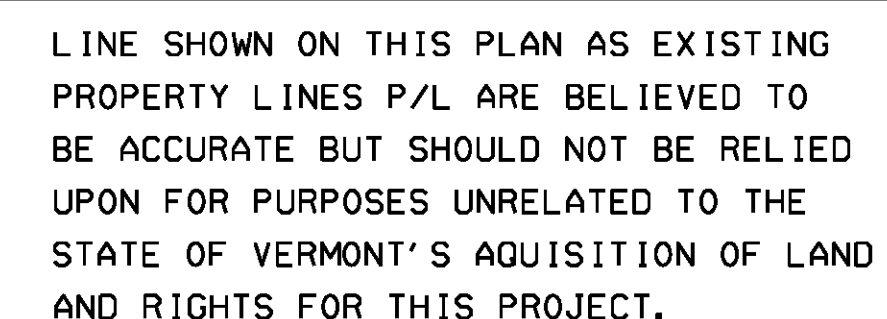

0 10 20
SCALE IN METERS

FILE NAME: r97d206Lay5.dgn	PLOT DATE: 21-FEB-2013
PROJECT LEADER: J. SCHULTZ	DRAWN BY: E. PIERCE
DESIGNED BY: D. BRYANT	CHECKED BY: E. PIERCE
ROW LAYOUT SHEET 5 OF 9	SHEET 14 OF 74