
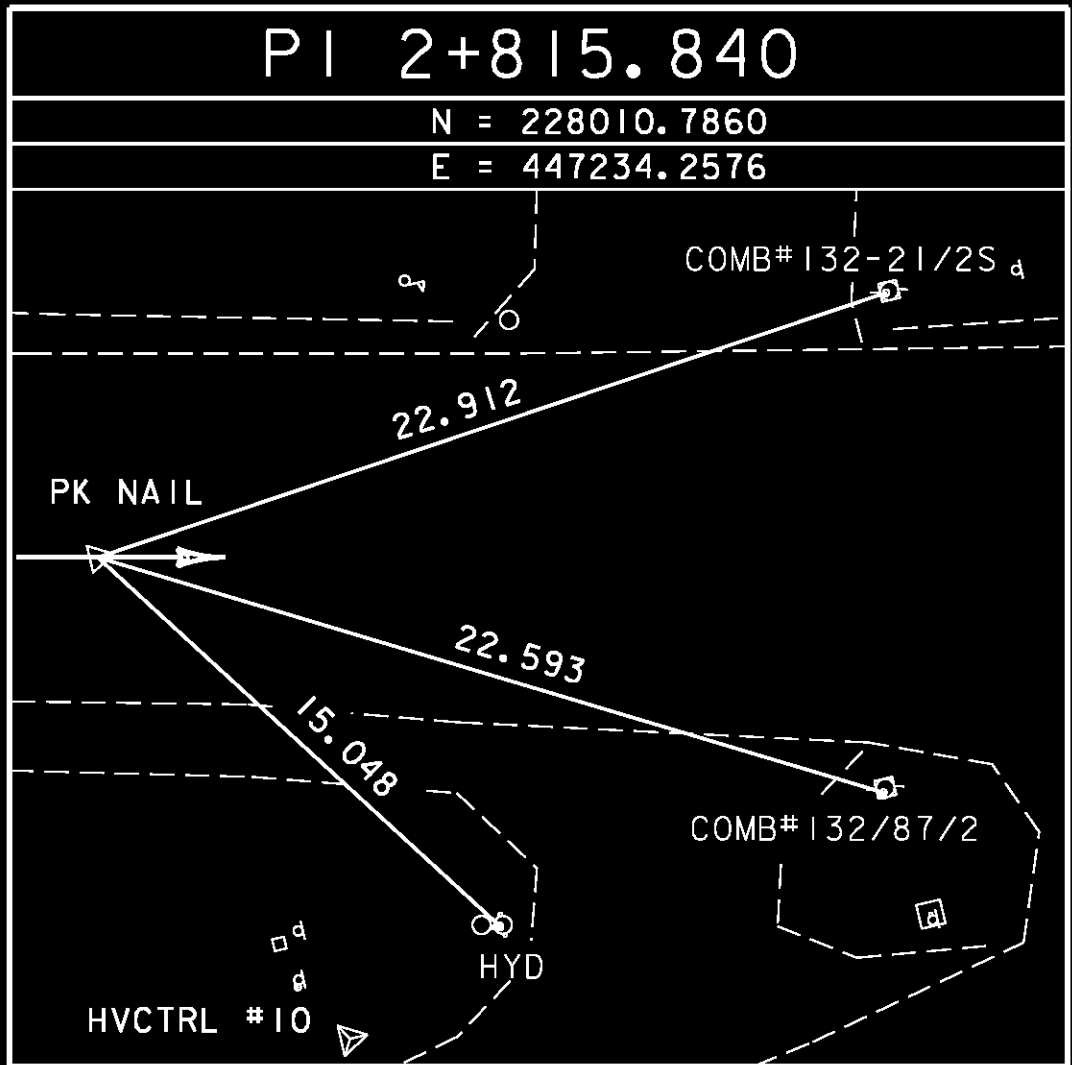
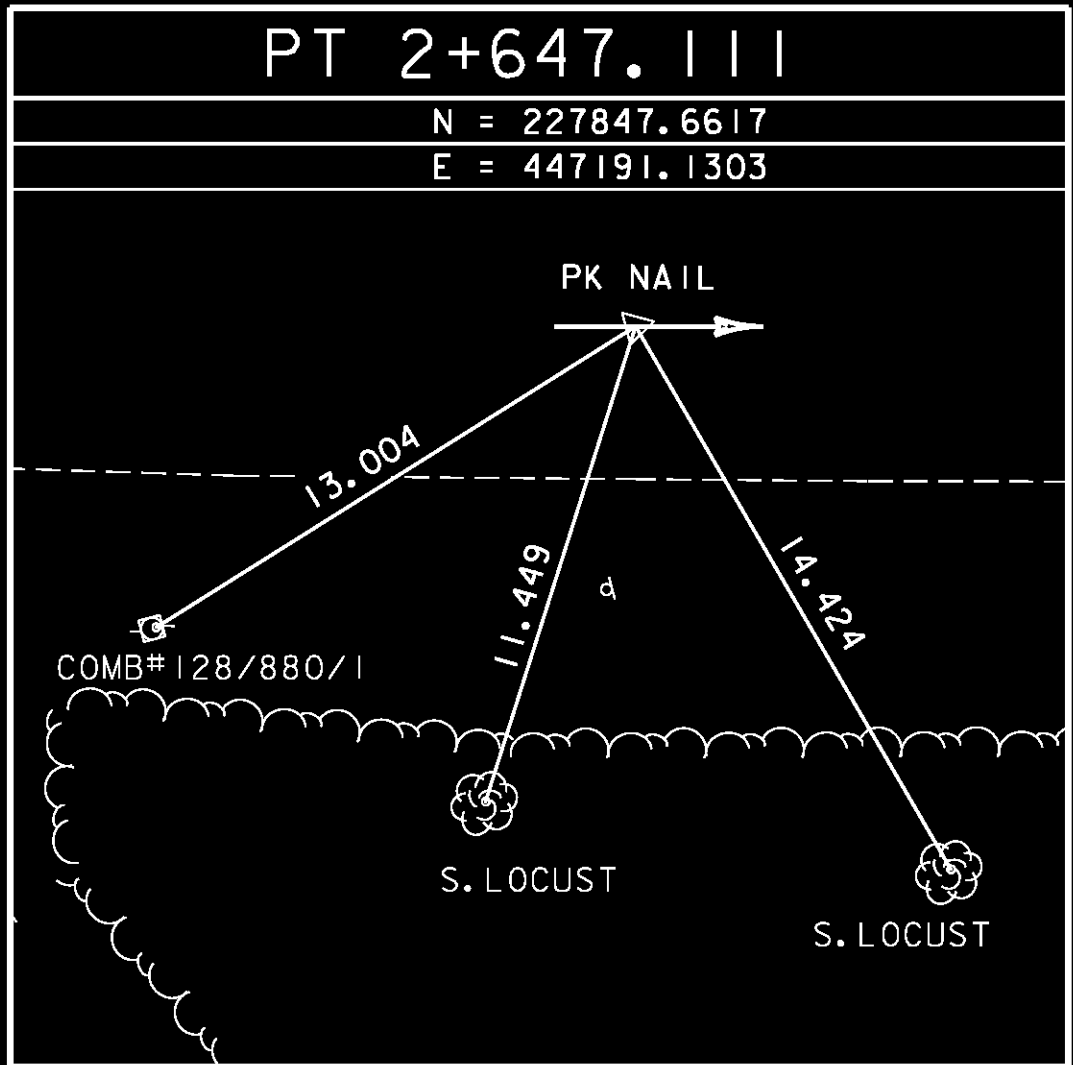
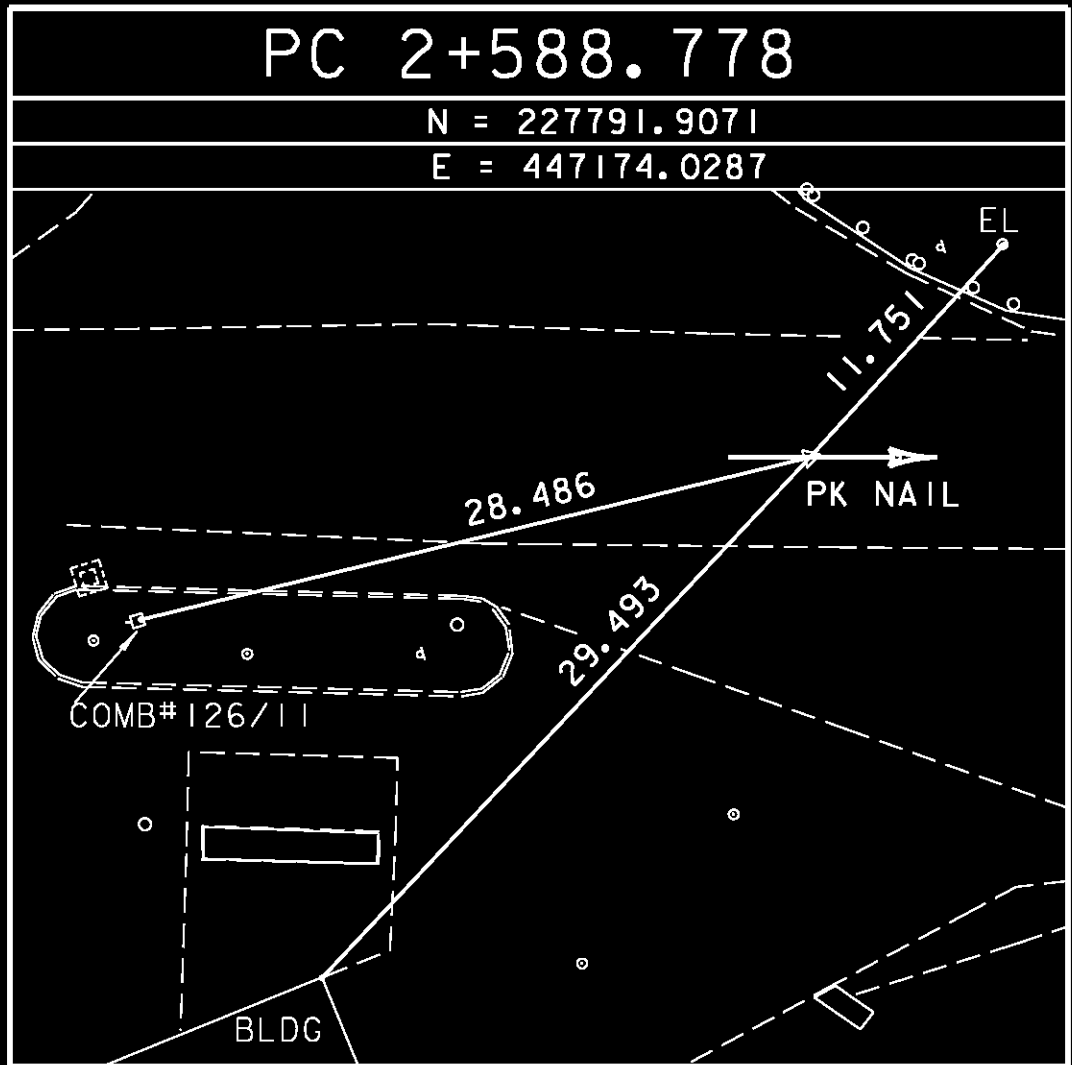




GPS CONTROL POINTS

ALIGNMENT TIES

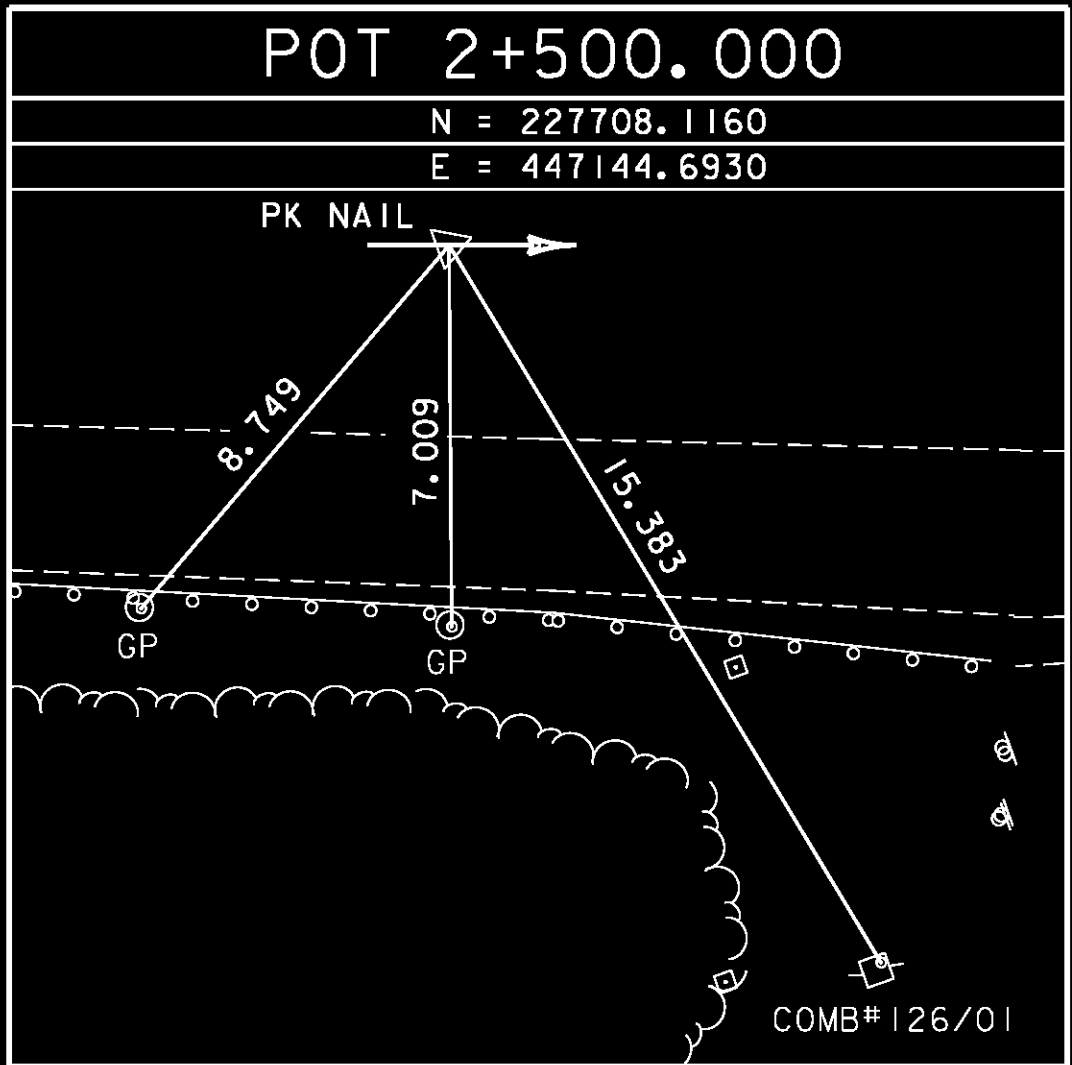

* ALIGNMENT STAKED ON JANUARY 25, 2002 BY R.GILMAN, P.WINTERS & J.HULETT

ALIGNMENT TIES

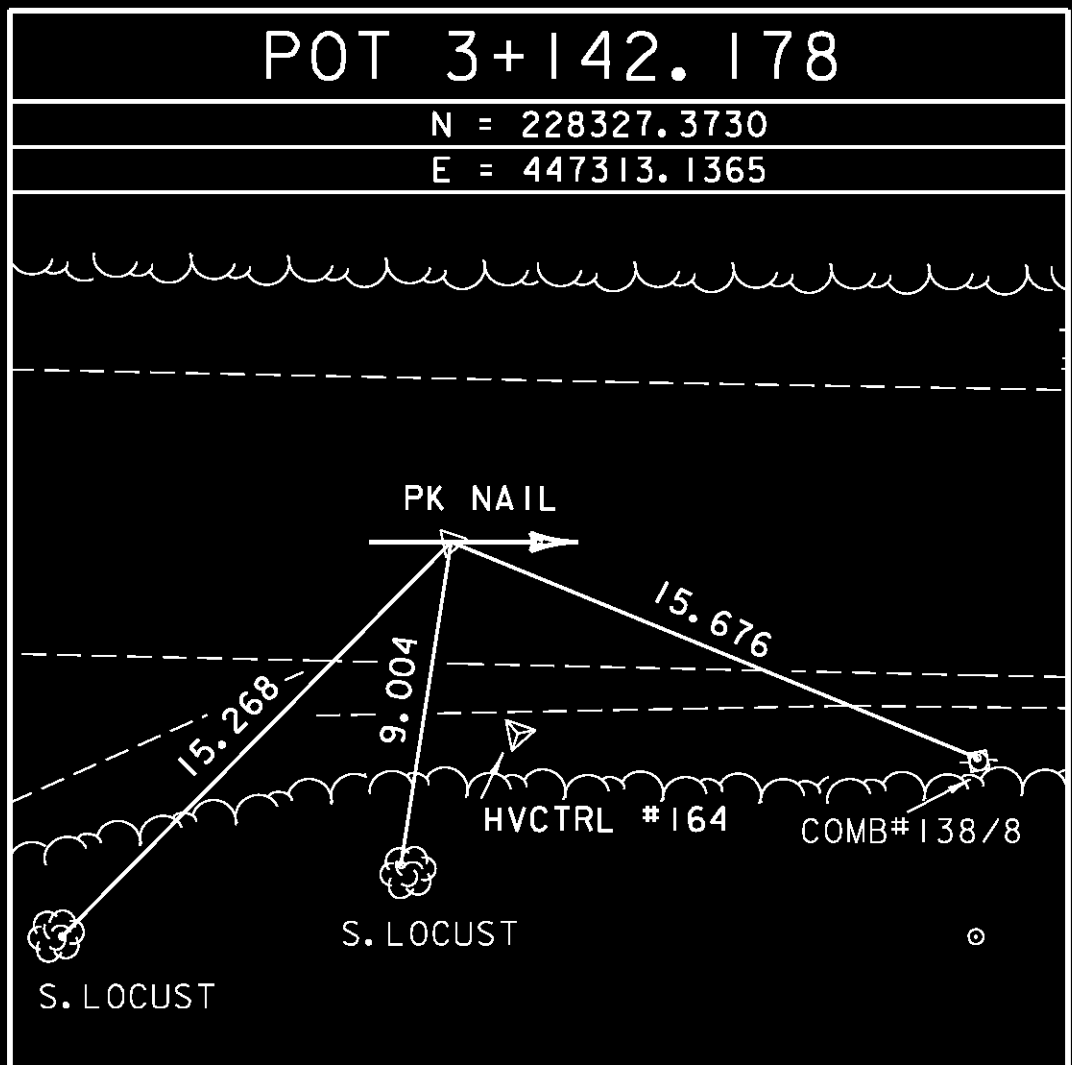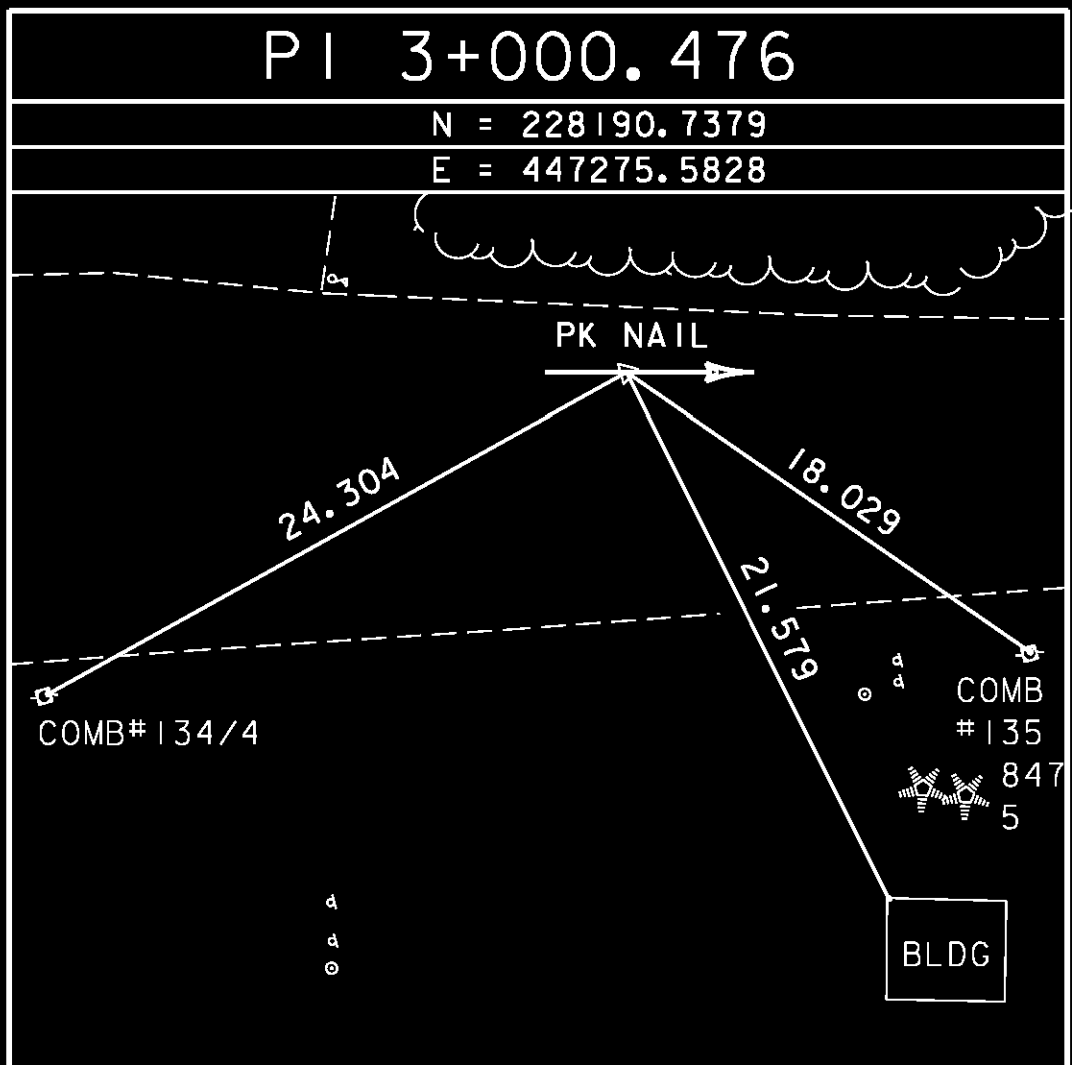

* ALIGNMENT STAKED ON JANUARY 25, 2002 BY R.GILMAN, P.WINTERS & J.HULETT
** ALL TRAVERSE POINTS ARE REBAR DRIVEN FLUSH TO THE GROUND UNLESS OTHERWISE NOTED.

DATUM	
VERTICAL	NAVD 88
HORIZONTAL	NAD 83/96

PROJECT NAME: COLCHESTER	
PROJECT NUMBER: STP 5600(9)S	
FILE NAME: r97d206TIE.dgn	PLOT DATE: 21-FEB-2013
PROJECT LEADER: J. SCHULTZ	DRAWN BY: J. HULETT
DESIGNED BY: D. BRYANT	CHECKED BY: P. HODGE
TIE SHEET 2 OF 2	SHEET 20 OF 74