



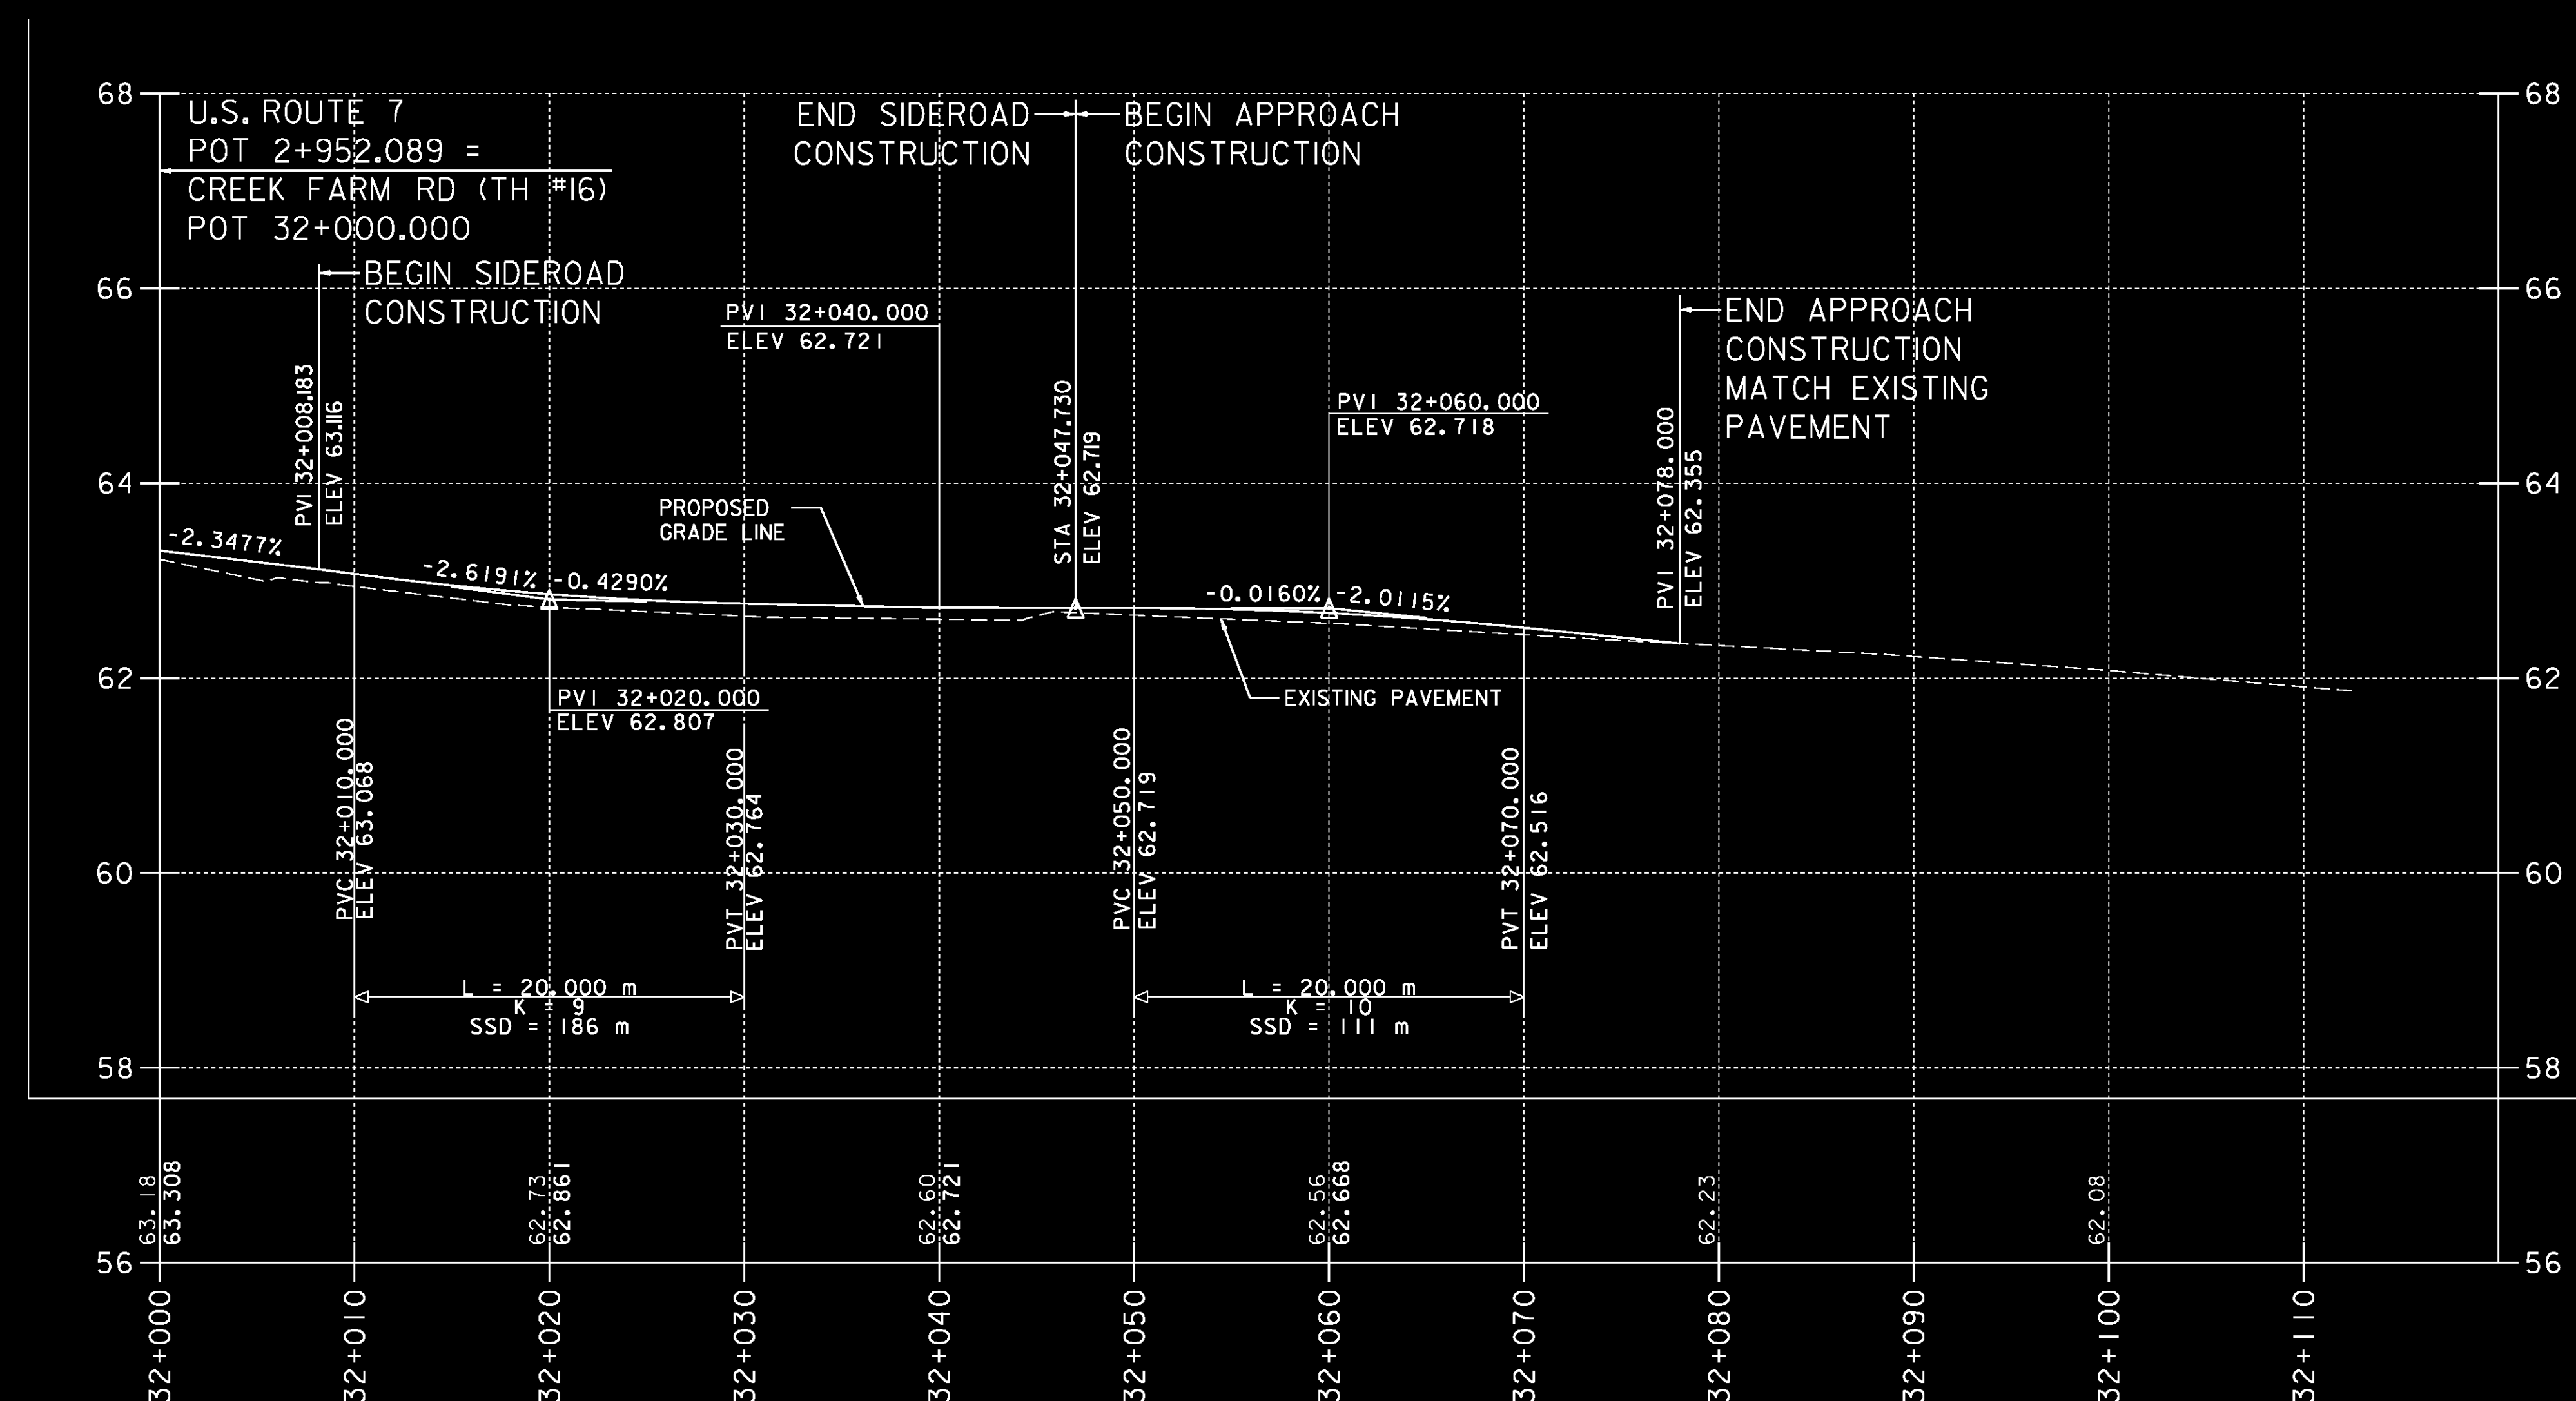

GRADES SHOWN TO THE NEAREST HUNDREDTH ARE EXISTING
GROUND ALONG CENTERLINE. GRADES SHOWN TO THE NEAREST
THOUSANDTH ARE FINISHED GRADE ALONG CENTERLINE.

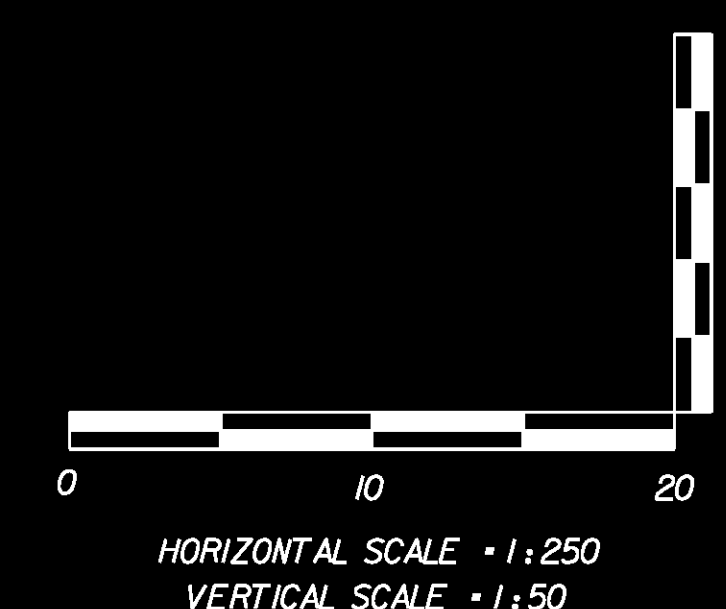

CREEK FARM RD (TH#16)

PROJECT NAME: COLCHESTER
PROJECT NUMBER: STP 5600(9)S

FILE NAME: r97d206PRO.dgn
PROJECT LEADER: J. SCHULTZ
DESIGNED BY: D. BRYANT
PROFILE SHEET 8 OF 9

PLOT DATE: 21-FEB-2013
DRAWN BY: T. KELLEY
CHECKED BY: D. BURHANS
SHEET 31 OF 74