



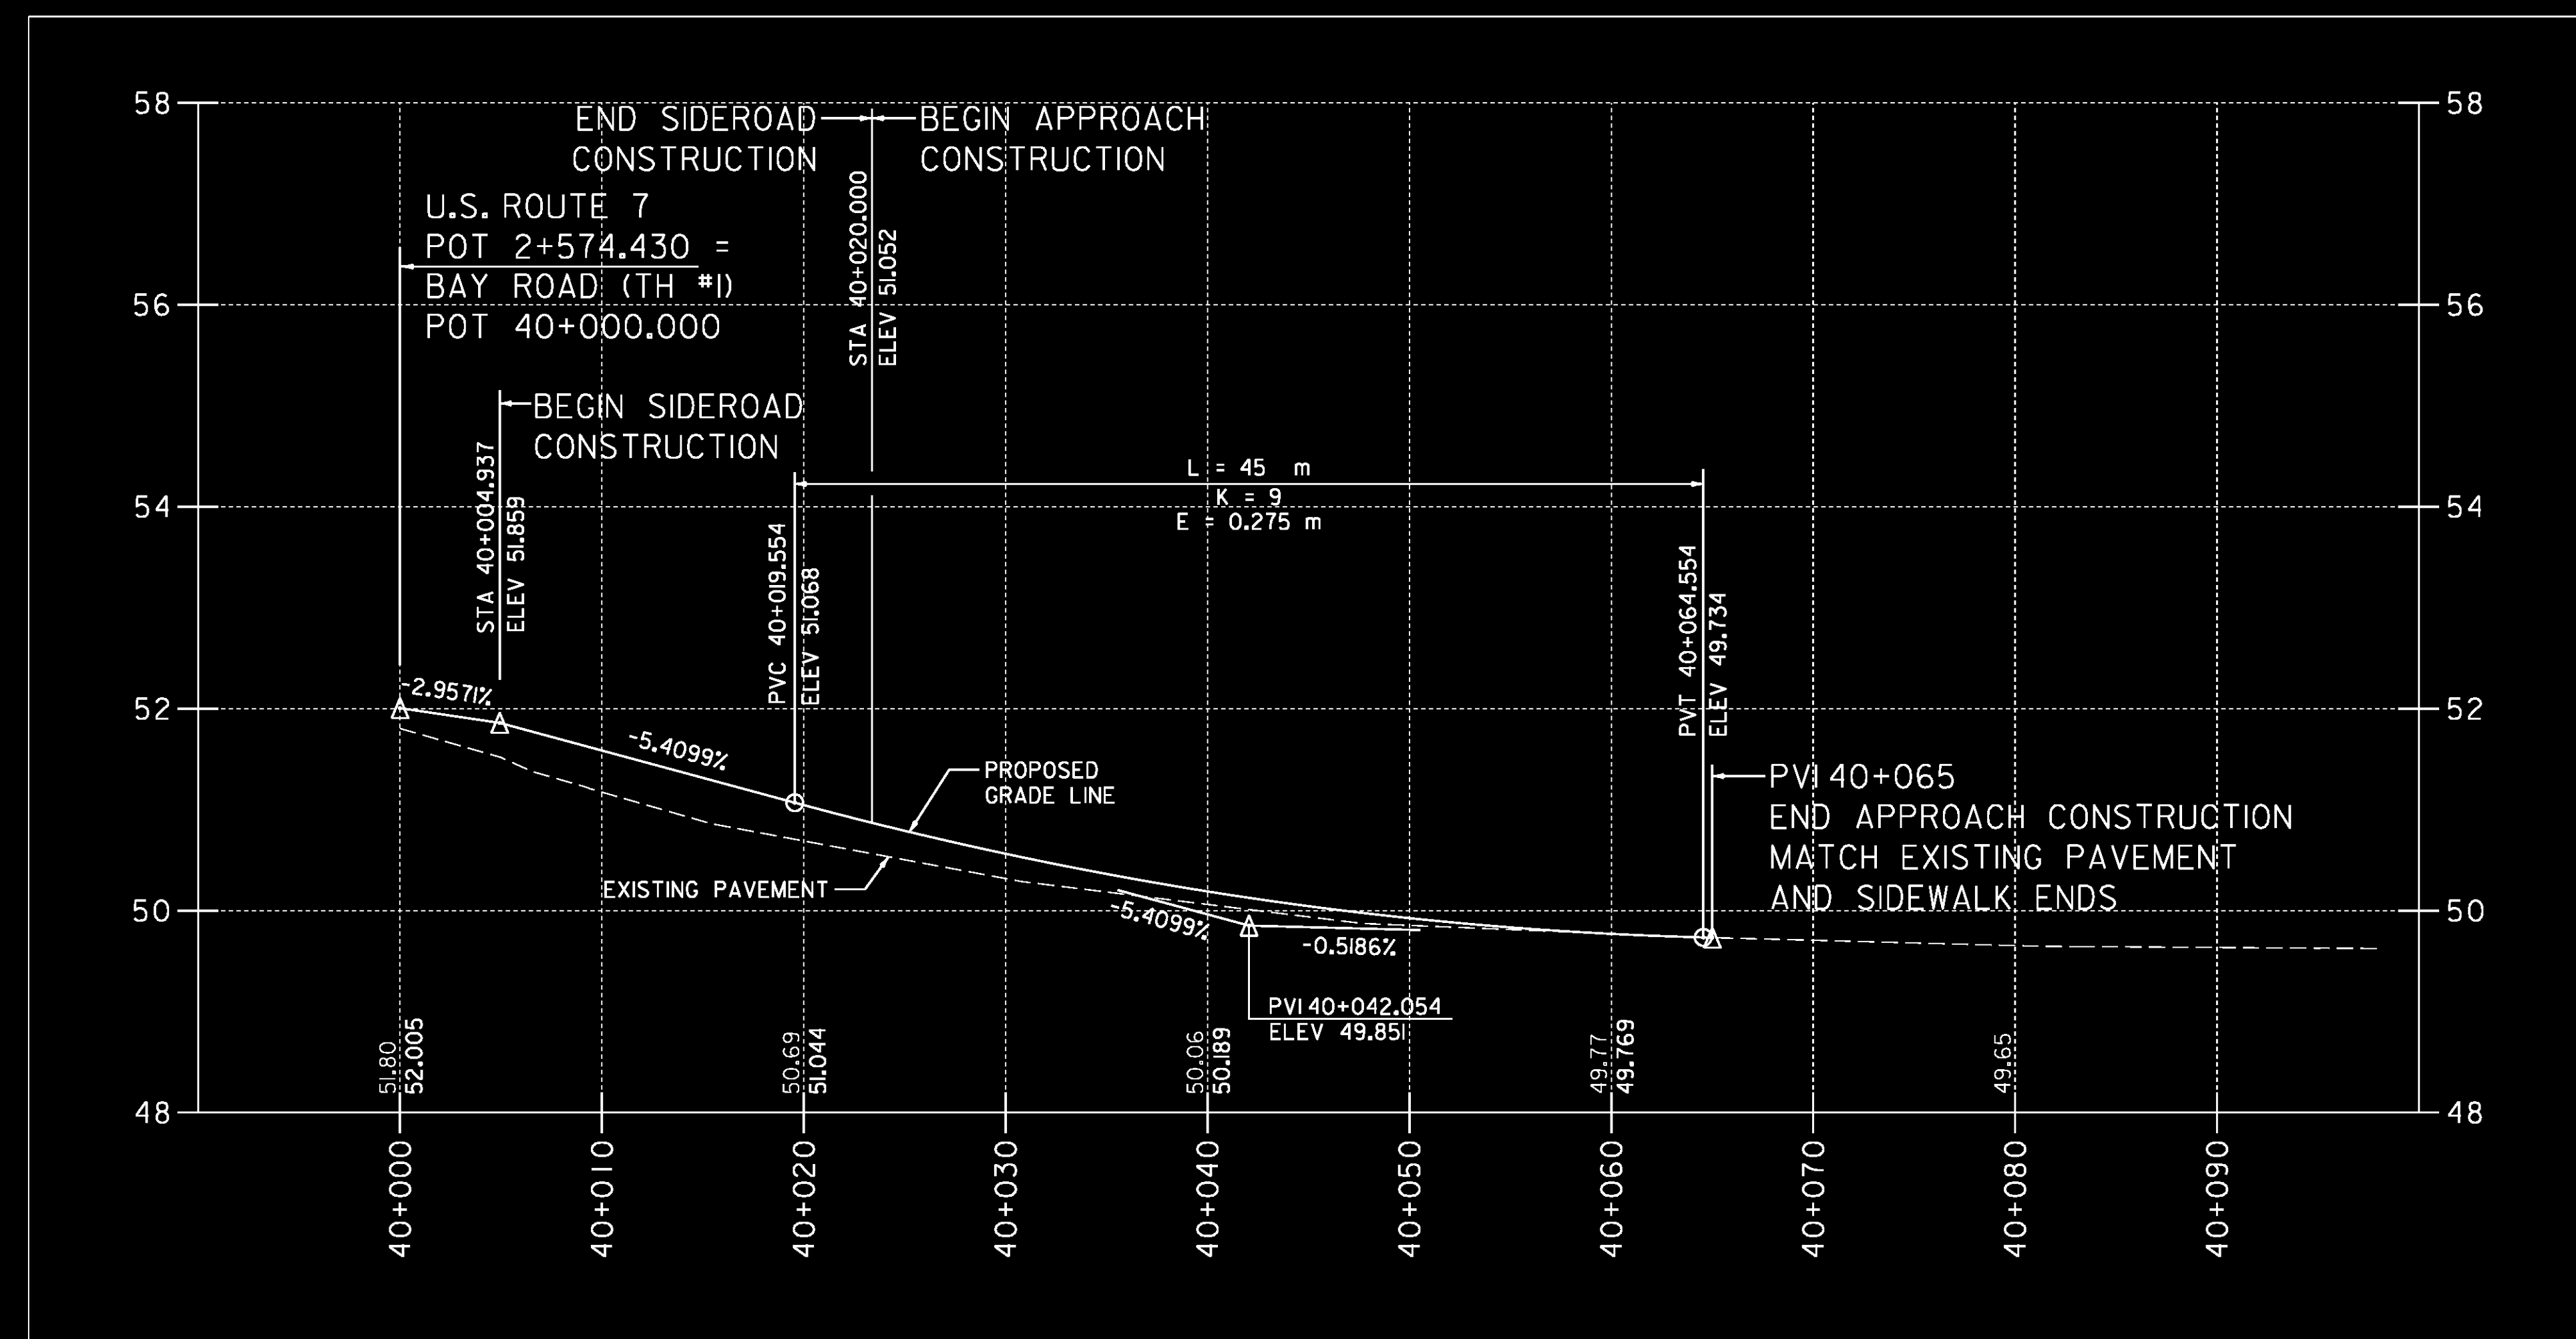


BAY ROAD (TH#1) PROFILE

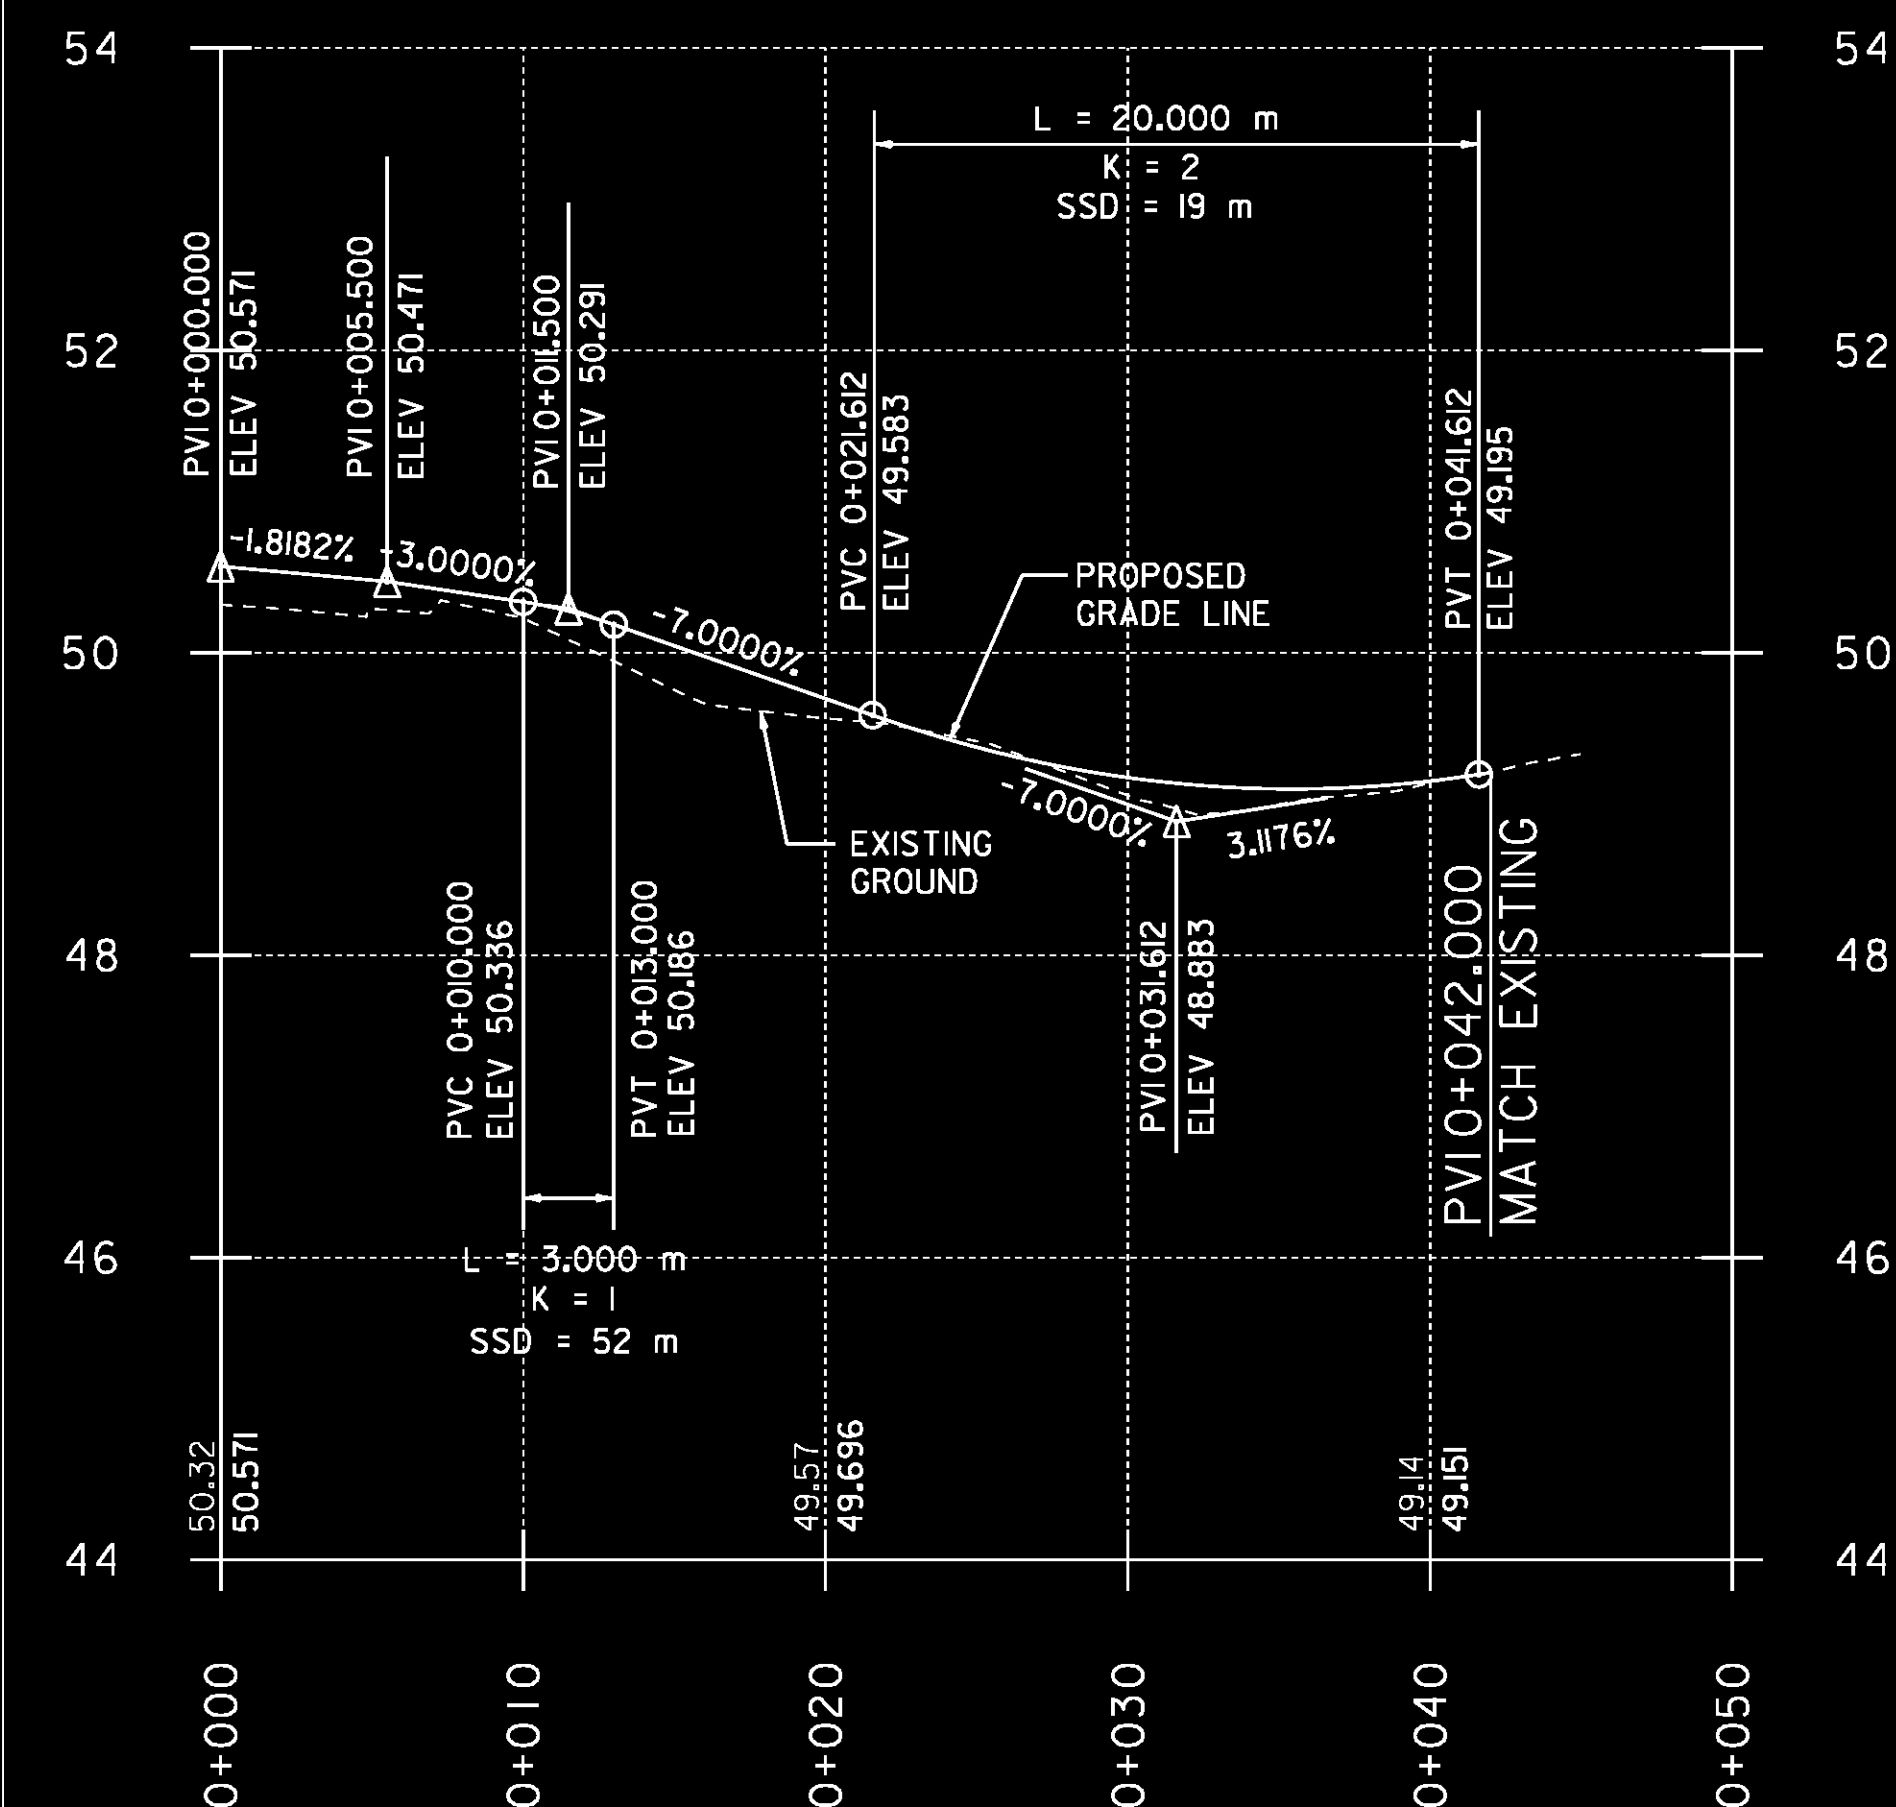

BAY ROAD GRAVEL DRIVE PROFILE

GRADES SHOWN TO THE NEAREST HUNDREDTH ARE EXISTING
GROUND ALONG CENTERLINE. GRADES SHOWN TO THE NEAREST
THOUSANDTH ARE FINISHED GRADE ALONG CENTERLINE.

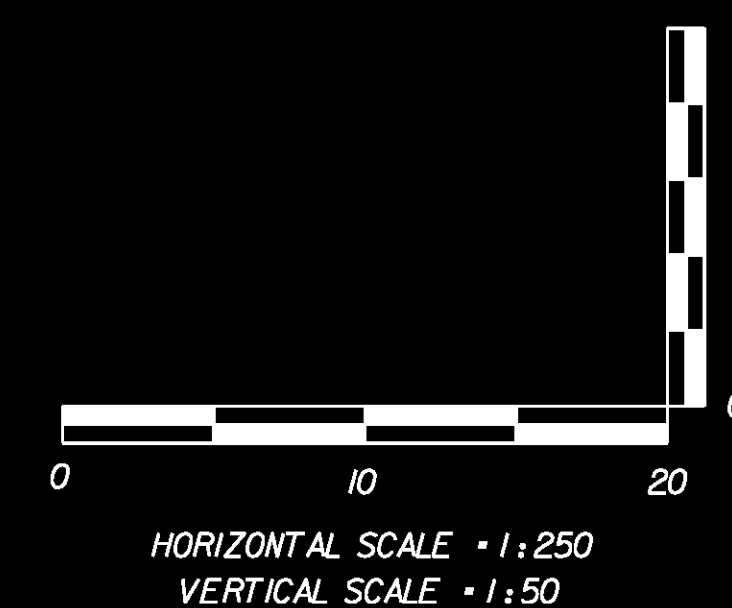

BAY ROAD (TH#1)

PROJECT NAME:	COLCHESTER
PROJECT NUMBER:	STP 5600(9)S

FILE NAME: r97d206PRO.dgn
PROJECT LEADER: J. SCHULTZ
DESIGNED BY: D. BRYANT
PROFILE SHEET 9 OF 9

PLOT DATE: 21-FEB-2013
DRAWN BY: T. KELLEY
CHECKED BY: D. BURHANS
SHEET 32 OF 74