


STONE DITCH NOTES

3+288.605 LT ~ 3+294.282 LT
CONSTRUCT RIPRAP BASIN X 0.300 m D
WITH STONE FILL TYPE I

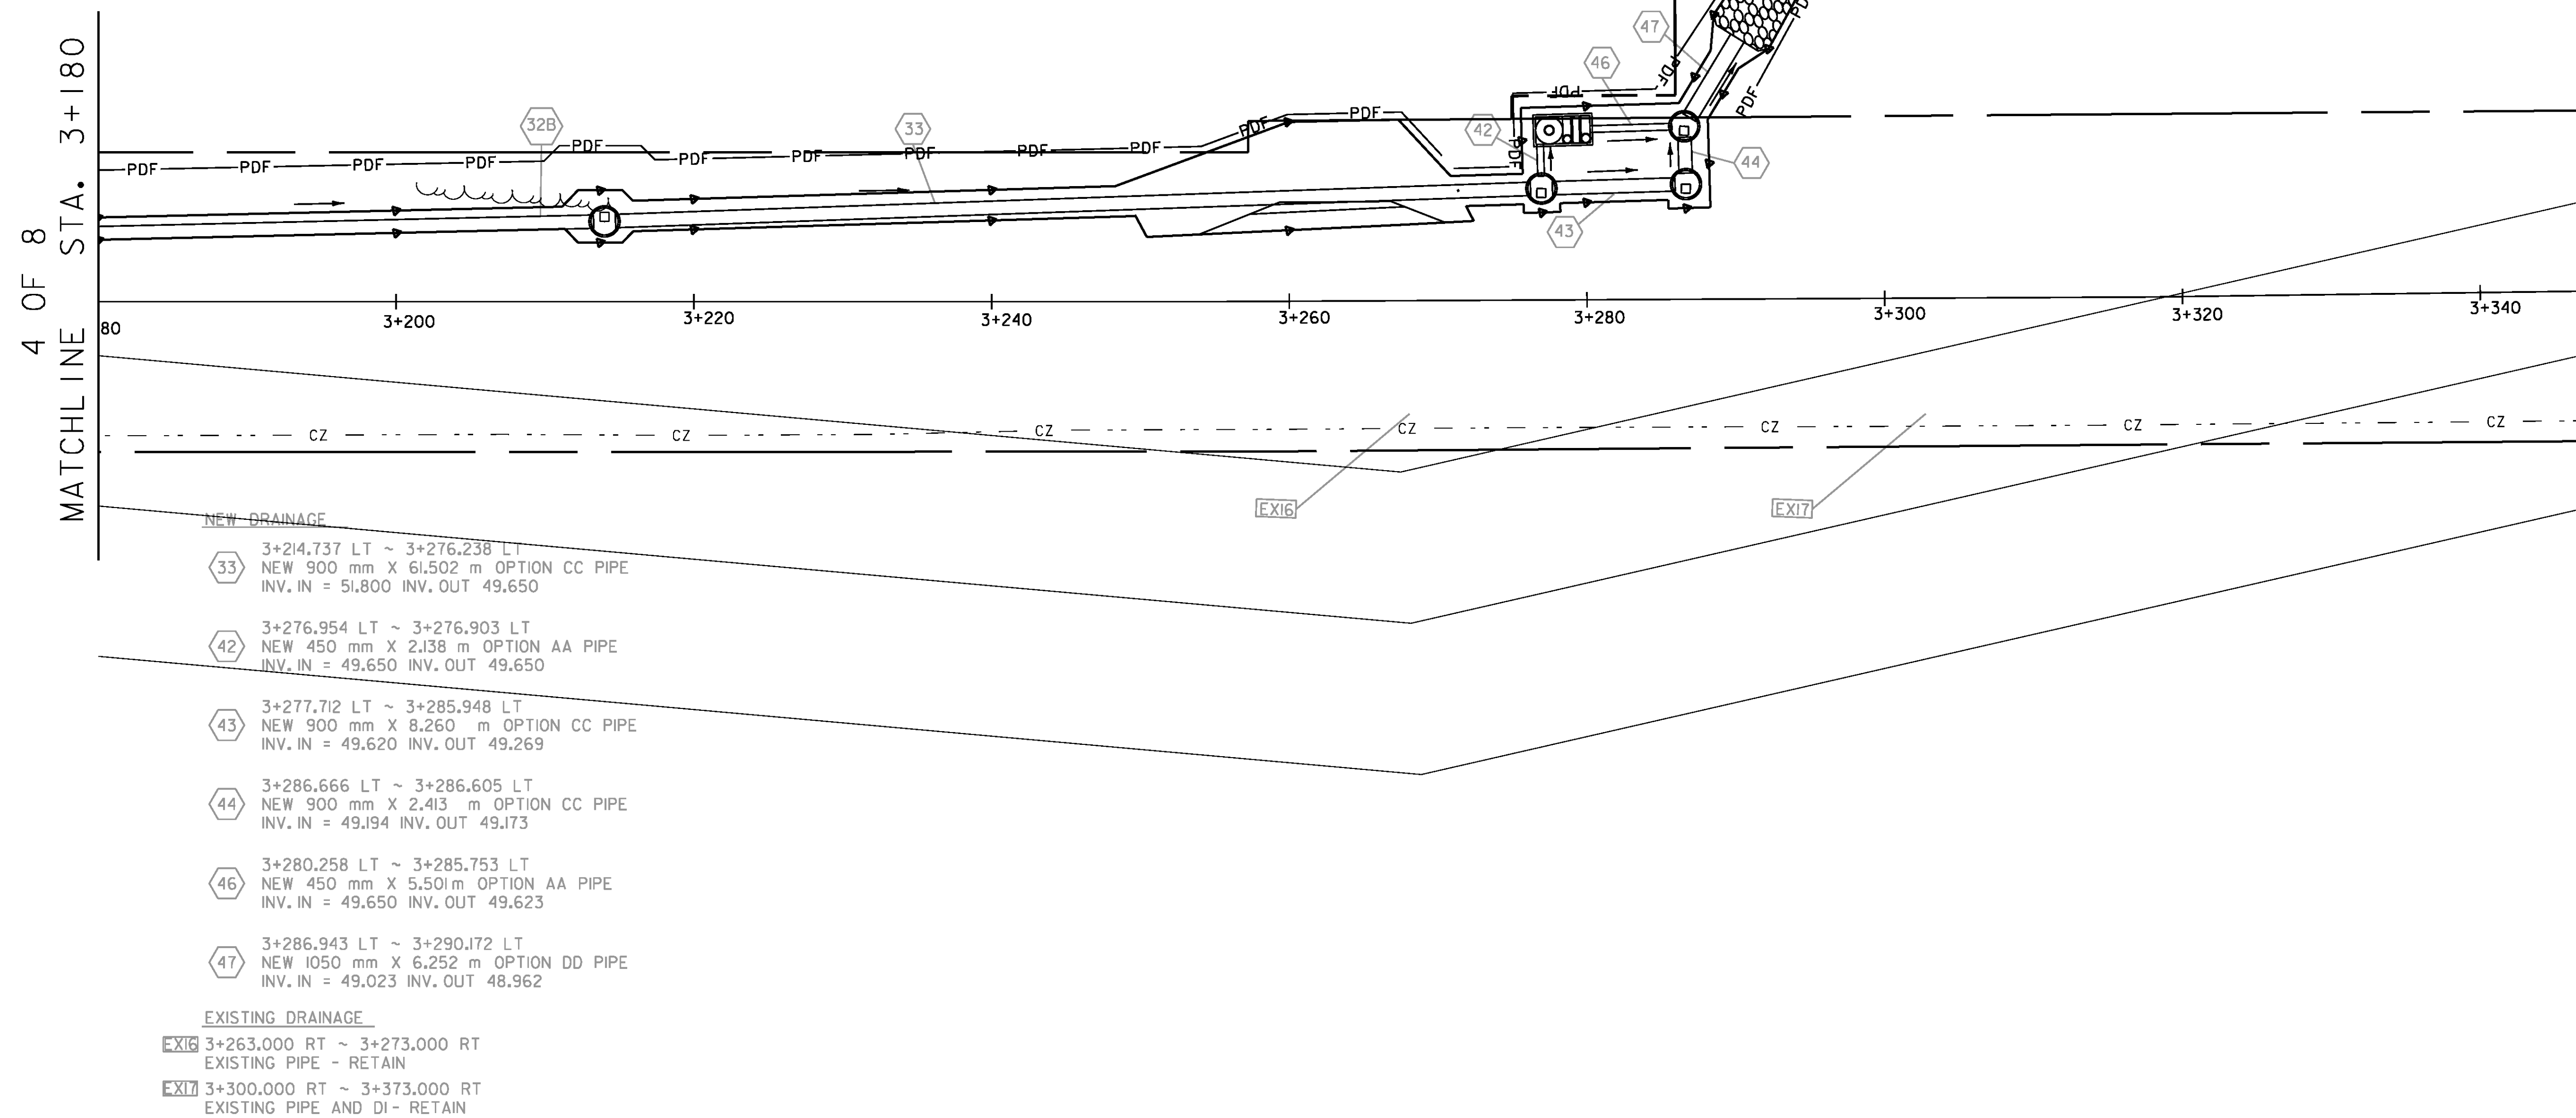


NEW DRAINAGE

- 3+214.737 LT ~ 3+276.238 LT
NEW 900 mm X 61.502 m OPTION CC PIPE
INV. IN = 51.800 INV. OUT 49.650
- 3+276.954 LT ~ 3+276.903 LT
NEW 450 mm X 2.138 m OPTION AA PIPE
INV. IN = 49.650 INV. OUT 49.650
- 3+277.712 LT ~ 3+285.948 LT
NEW 900 mm X 8.260 m OPTION CC PIPE
INV. IN = 49.620 INV. OUT 49.269
- 3+286.666 LT ~ 3+286.605 LT
NEW 900 mm X 2.413 m OPTION CC PIPE
INV. IN = 49.194 INV. OUT 49.173
- 3+280.258 LT ~ 3+285.753 LT
NEW 450 mm X 5.501m OPTION AA PIPE
INV. IN = 49.650 INV. OUT 49.623
- 3+286.943 LT ~ 3+290.172 LT
NEW 1050 mm X 6.252 m OPTION DD PIPE
INV. IN = 49.023 INV. OUT 48.962

EXISTING DRAINAGE

- EX16 3+263.000 RT ~ 3+273.000 RT
EXISTING PIPE - RETAIN
- EX17 3+300.000 RT ~ 3+373.000 RT
EXISTING PIPE AND DI- RETAIN

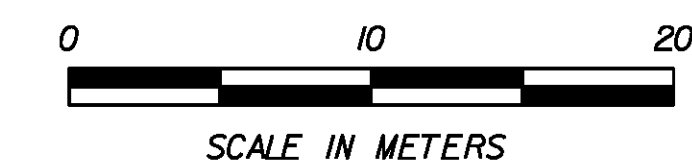

DATUM	
VERTICAL	NAVD 88
HORIZONTAL	NAD 83/96

PROJECT NAME:	Colchester
PROJECT NUMBER:	STP 5600(9)S
FILE NAME:	r97d206DRN5.dgn
PROJECT LEADER:	D Bryant
DESIGNED BY:	D Bryant
DRAINAGE PLAN SHEET	5 OF 8
PLOT DATE:	21-FEB-2013
DRAWN BY:	T Kelley
CHECKED BY:	D Burhans
SHEET	37 OF 74