



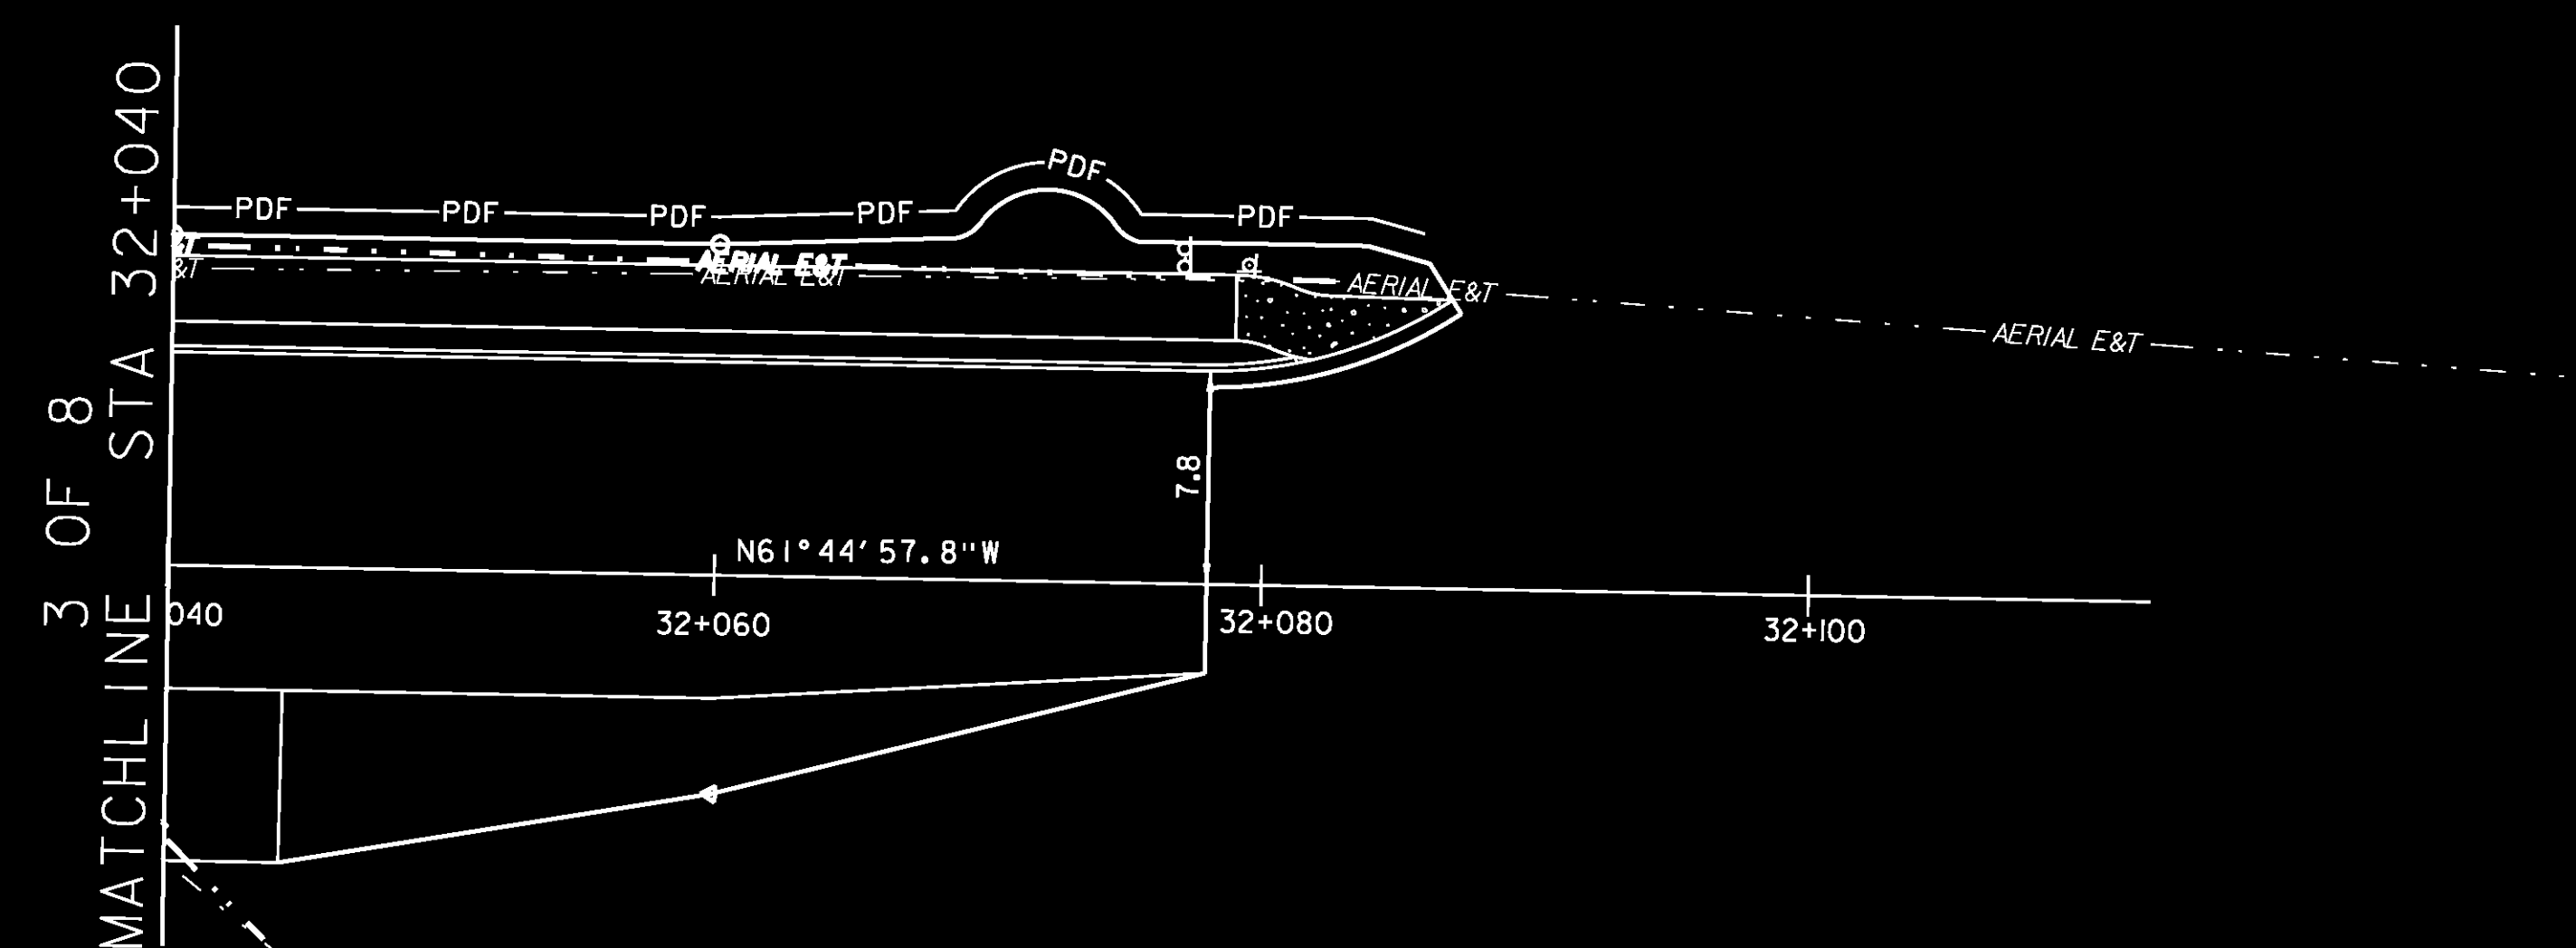

4" STEEL XTRU

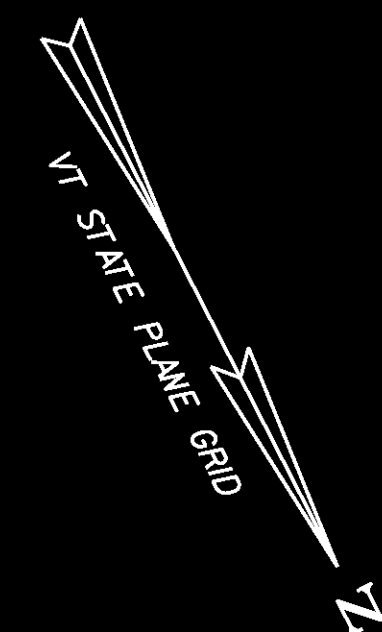

NOTES

- 1) SEE DRAINAGE PLANS FOR LOCATION OF PROPOSED DRAINAGE FACILITIES.
- 2) SEE CONSTRUCTION PLANS FOR ADDITIONAL PROPOSED FACILITIES.
- 3) NO PROPOSED UTILITIES ON THIS SHEET.

DATUM
VERTICAL NAVD 88
HORIZONTAL NAD 83/96

PROJECT NAME: Colchester
PROJECT NUMBER: STP 5600(9)S

FILE NAME: r97d206UTL8.dgn
PROJECT LEADER: D Bryant
DESIGNED BY: D Bryant
UTILITY PLAN SHEET 8 OF 8

PLOT DATE: 21-FEB-2013
DRAWN BY: T Kelley
CHECKED BY: D Burhans
SHEET 48 OF 74