


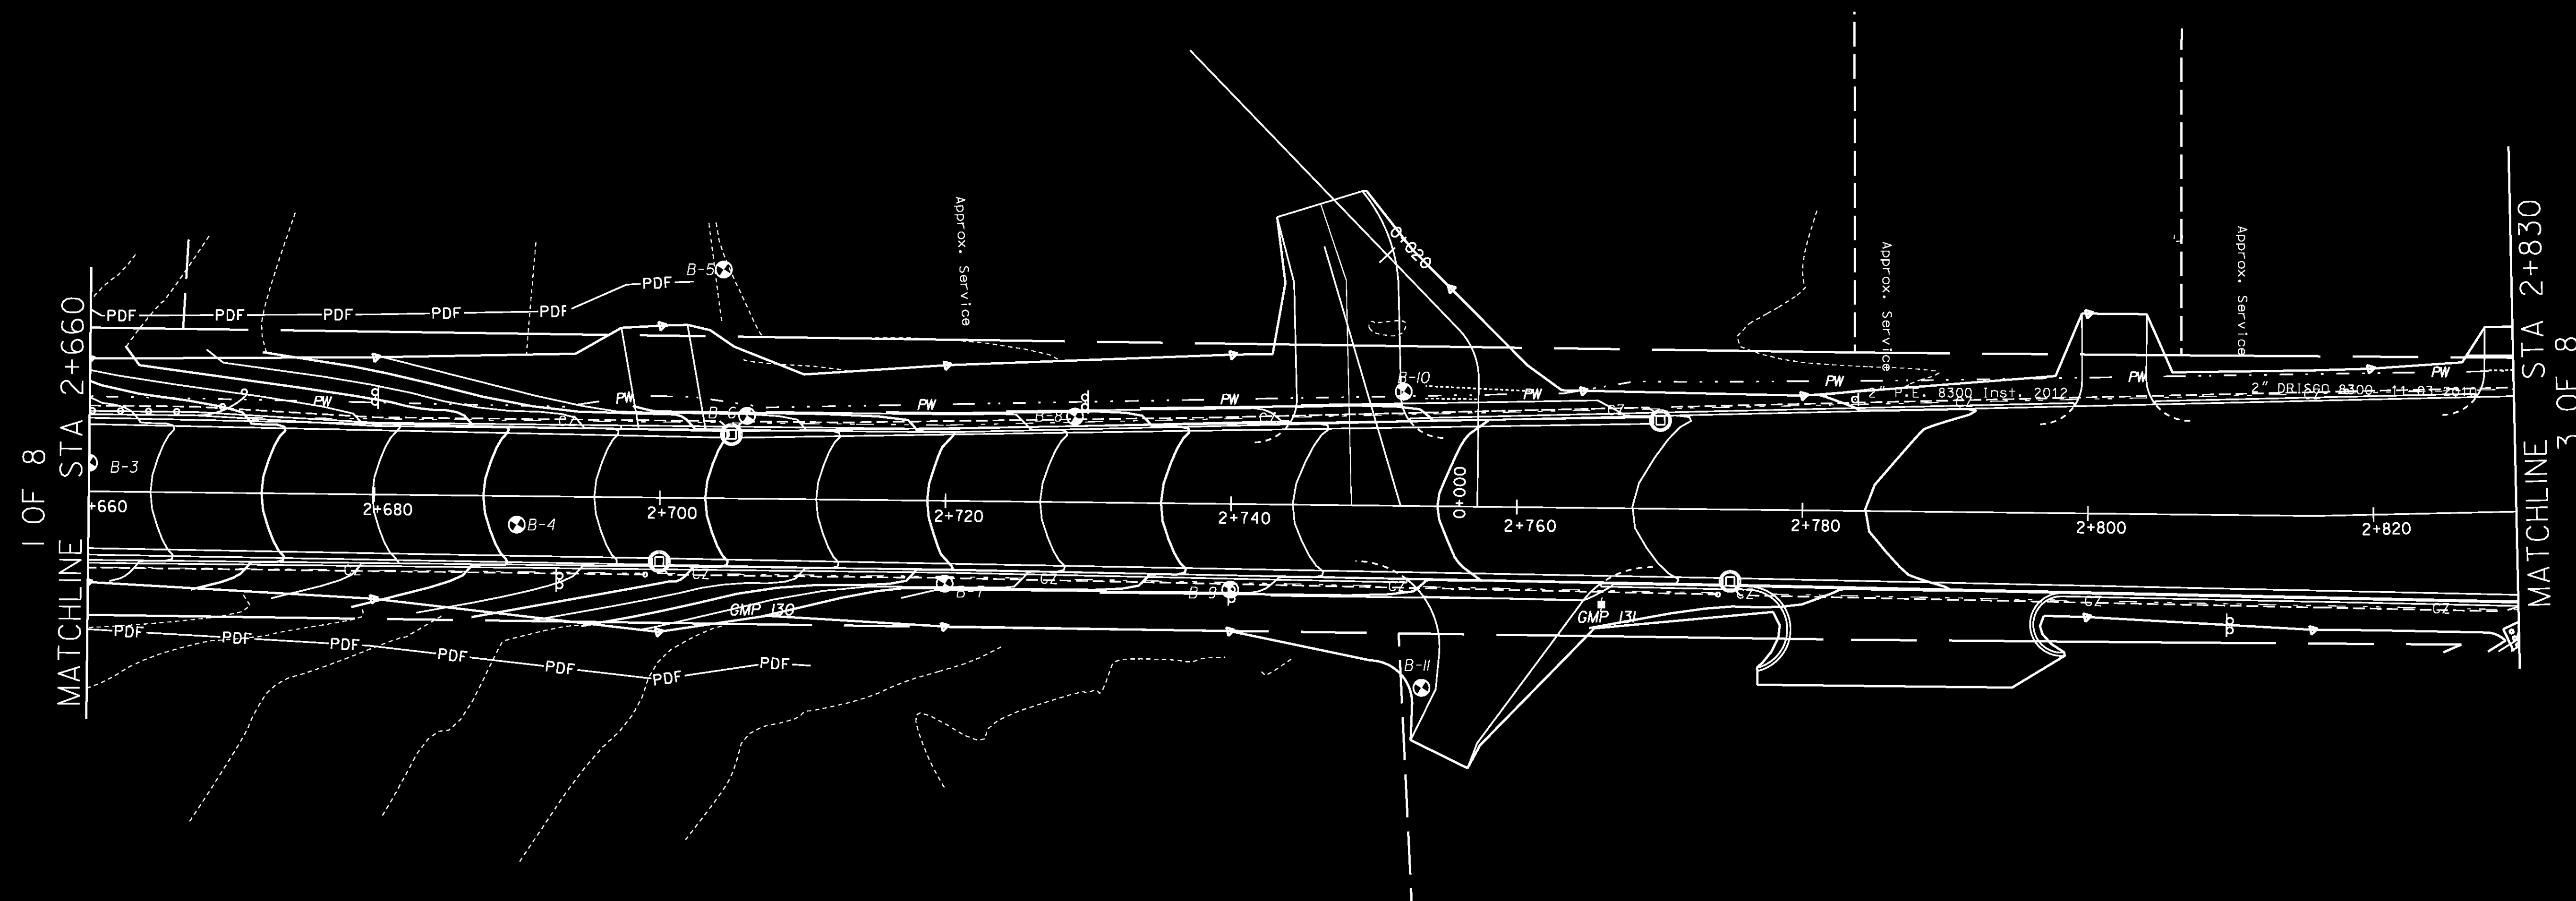

PROJECT DEMARCATION FENCE (METERS)
2+660.000 LT ~ 2+700.251 LT = 40.8 m
2+660.000 RT ~ 2+710.675 RT = 50.9 m

CURB INLET PROTECTION
2+700.000, 4.5 m LT - IEA
2+700.000, 4.5 m RT - IEA
2+770.000, 6.2 m LT - IEA
2+775.000, 5.0 m RT - IEA



DATUM	
VERTICAL	NAVD 88
HORIZONTAL	NAD 83/96

LEGEND:	
	WETLAND - CLASS II
	WETLAND - CLASS III
	EROSION MATTING
	SILT FENCE
	STONE CHECK DAM
	PROJECT DEMARCATION FENCE
	INLET PROTECTION
	CURB INLET PROTECTION



PROJECT NAME:	Colchester
PROJECT NUMBER:	STP 5600(9)S
FILE NAME:	r97d206ER02.dgn
PROJECT LEADER:	D Bryant
DESIGNED BY:	D Bryant
EPSC CONSTRUCTION	SHEET 2 OF 8
PLOT DATE:	21-FEB-2013
DRAWN BY:	T Kelley
CHECKED BY:	D Burhans
SHEET	50 OF 74