




CURB INLET PROTECTION
22+270.000, 4.3 m LT - IEA

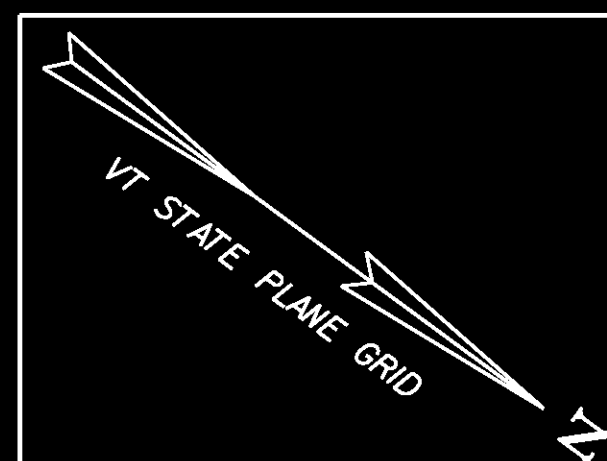

DATUM	
VERTICAL	NAVD 88
HORIZONTAL	NAD 83/96

PROJECT NAME:	Colchester
PROJECT NUMBER:	STP 5600(9)S
FILE NAME:	r97d206ER07.dgn
PROJECT LEADER:	D Bryant
DESIGNED BY:	D Bryant
EPSC CONSTRUCTION	SHEET 7 OF 8
PLOT DATE:	21-FEB-2013
DRAWN BY:	T Kelley
CHECKED BY:	D Burhans
	SHEET 55 OF 74