



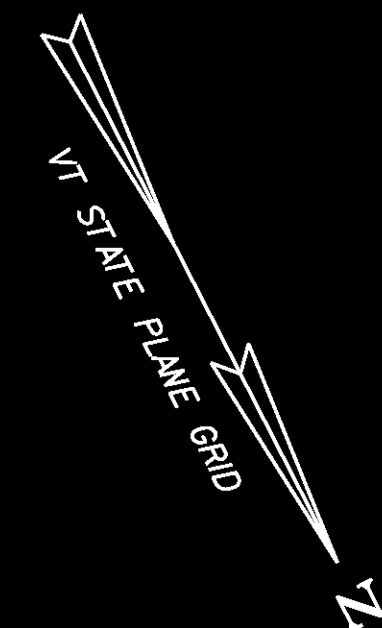

INLET PROTECTION
32+071.973, 13.1 m LT - IEA

CURB INLET PROTECTION
32+071.973, 7.5 m LT - IEA

PROJECT DEMARCATION FENCE
32+040.000 LT ~ 32+085.737 LT = 47.0 m

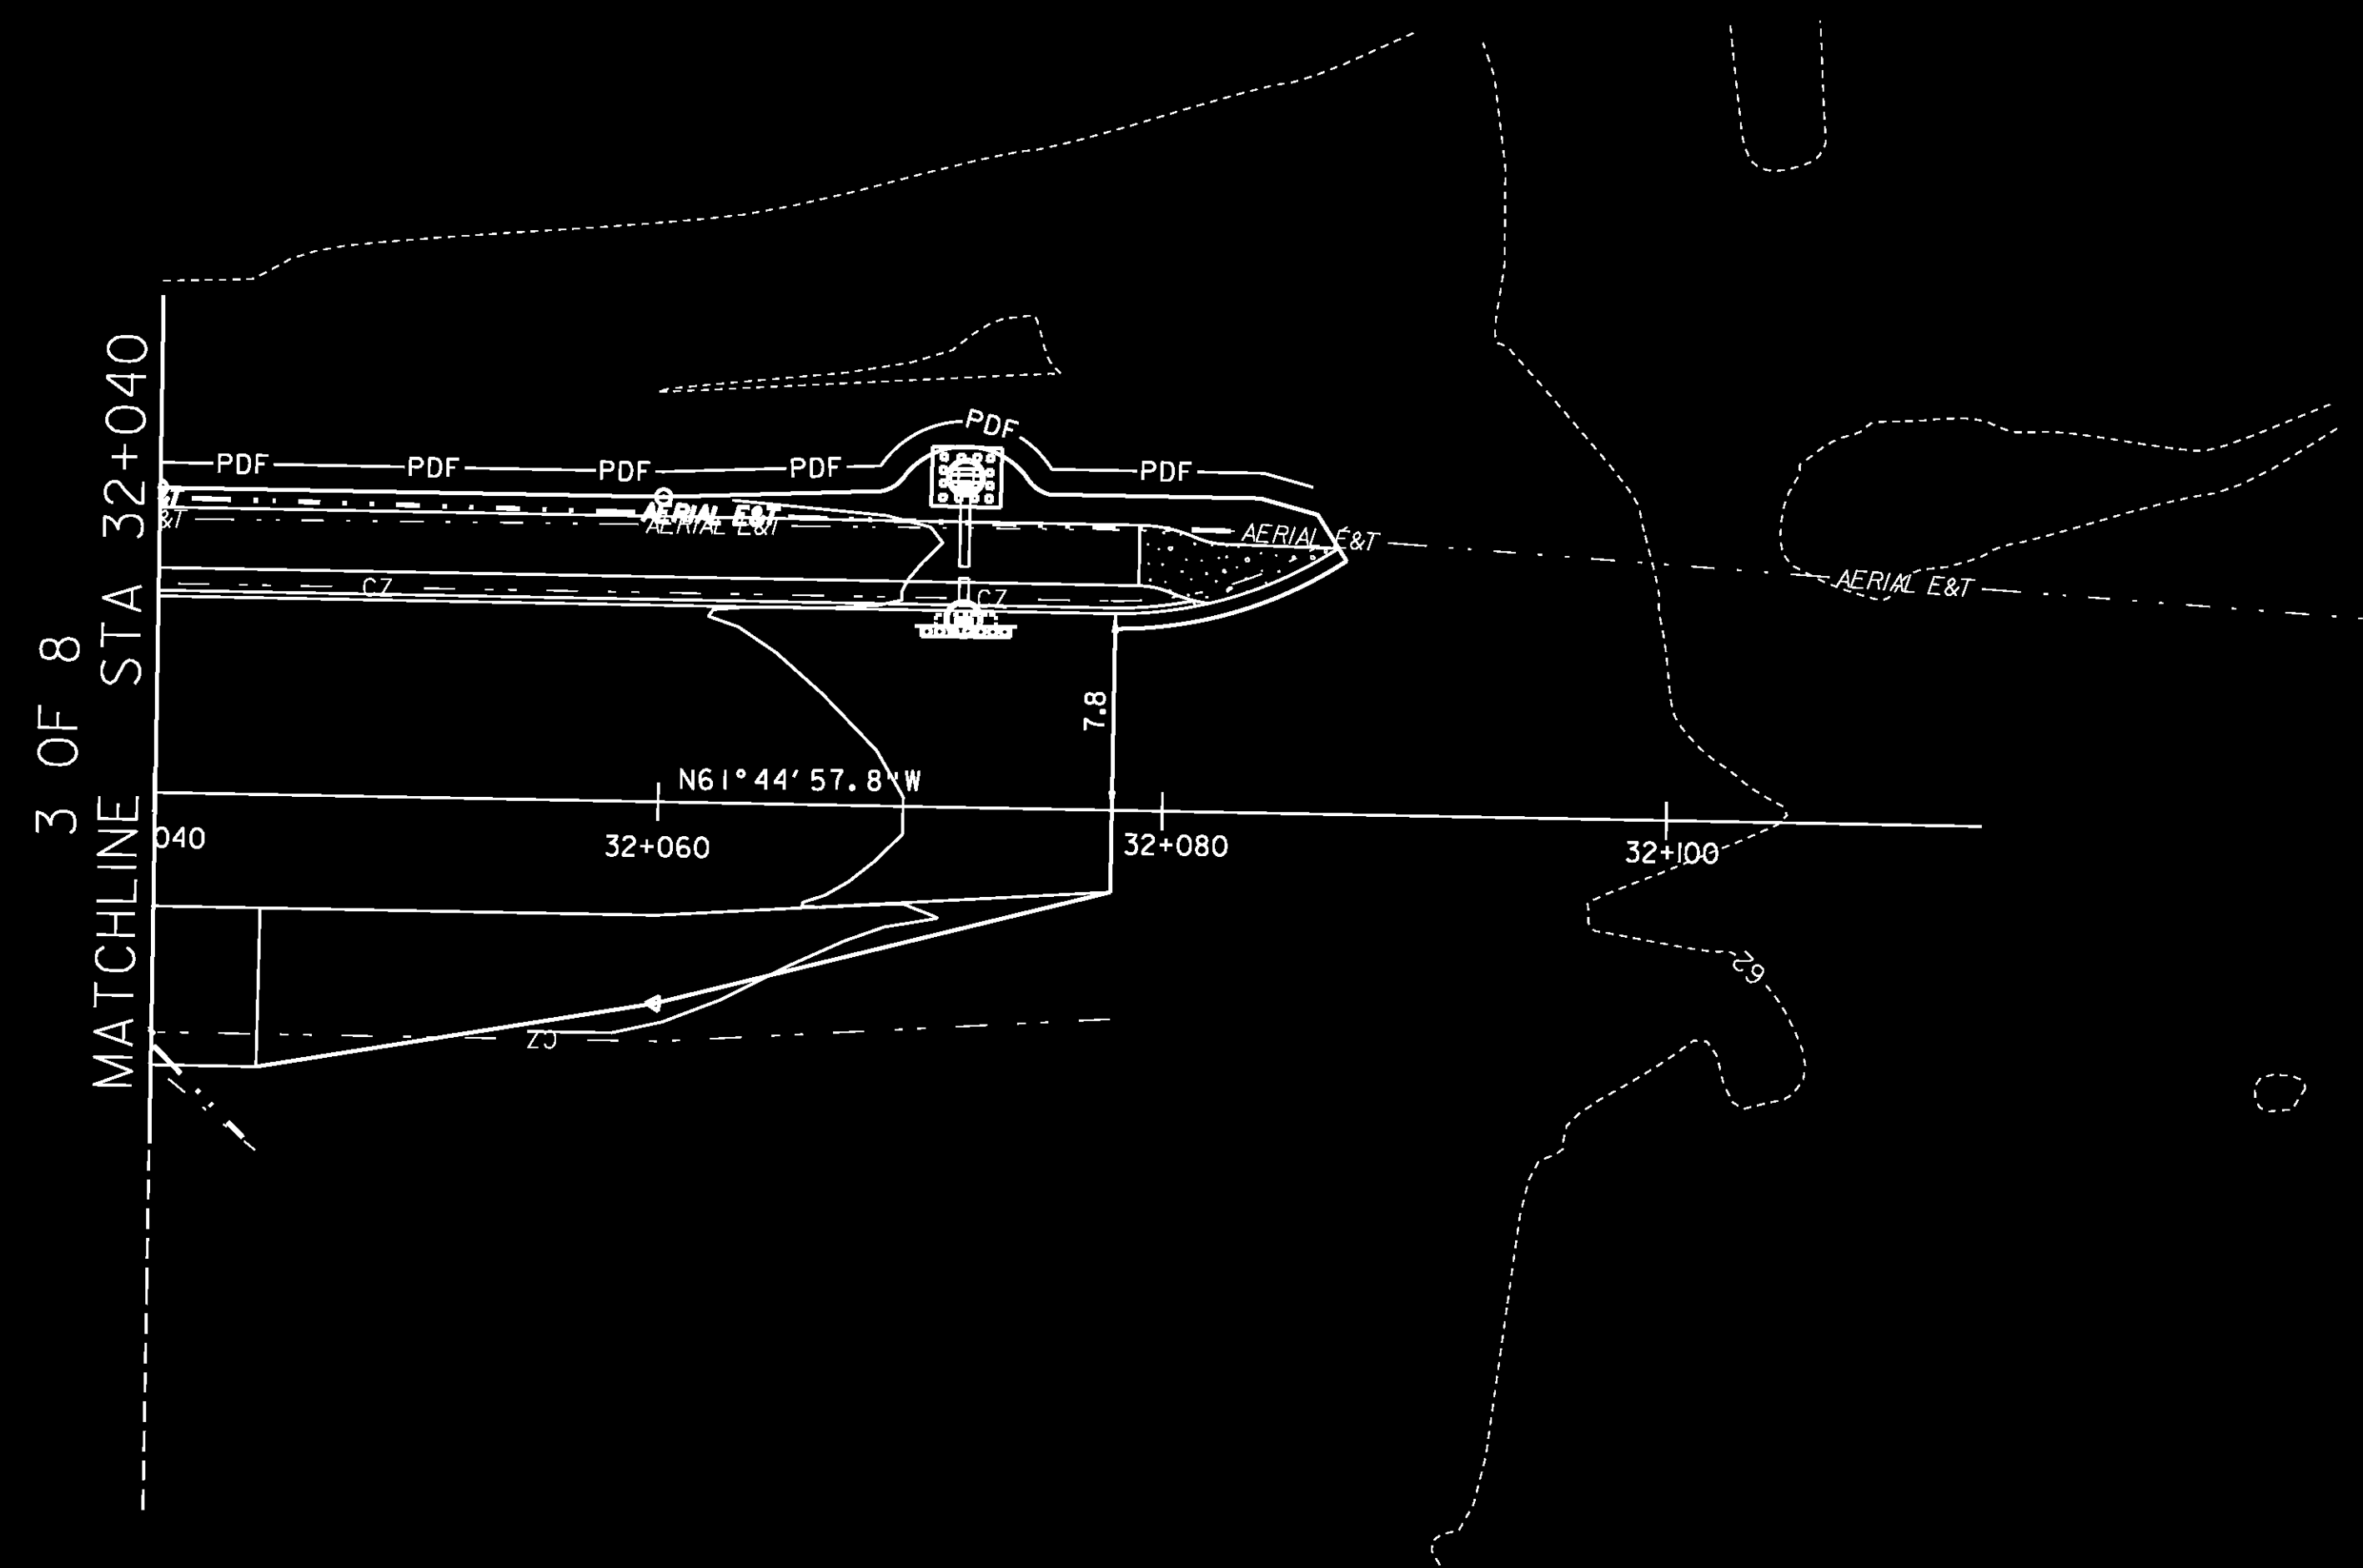

LEGEND:

-  WETLAND - CLASS II
-  WETLAND - CLASS III
-  EROSION MATTING
-  SILT FENCE
-  STONE CHECK DAM
-  PDF PROJECT DEMARCATION FENCE
-  INLET PROTECTION
-  CURB INLET PROTECTION



DATUM
VERTICAL NAVD 88
HORIZONTAL NAD 83/96

PROJECT NAME: Colchester
PROJECT NUMBER: STP 5600(9)S

FILE NAME: r97d206ER08.dgn
PROJECT LEADER: D Bryant
DESIGNED BY: D Bryant
EPSC CONSTRUCTION SHEET 8 OF 8

PLOT DATE: 21-FEB-2013
DRAWN BY: T Kelley
CHECKED BY: D Burhans
SHEET 56 OF 74