


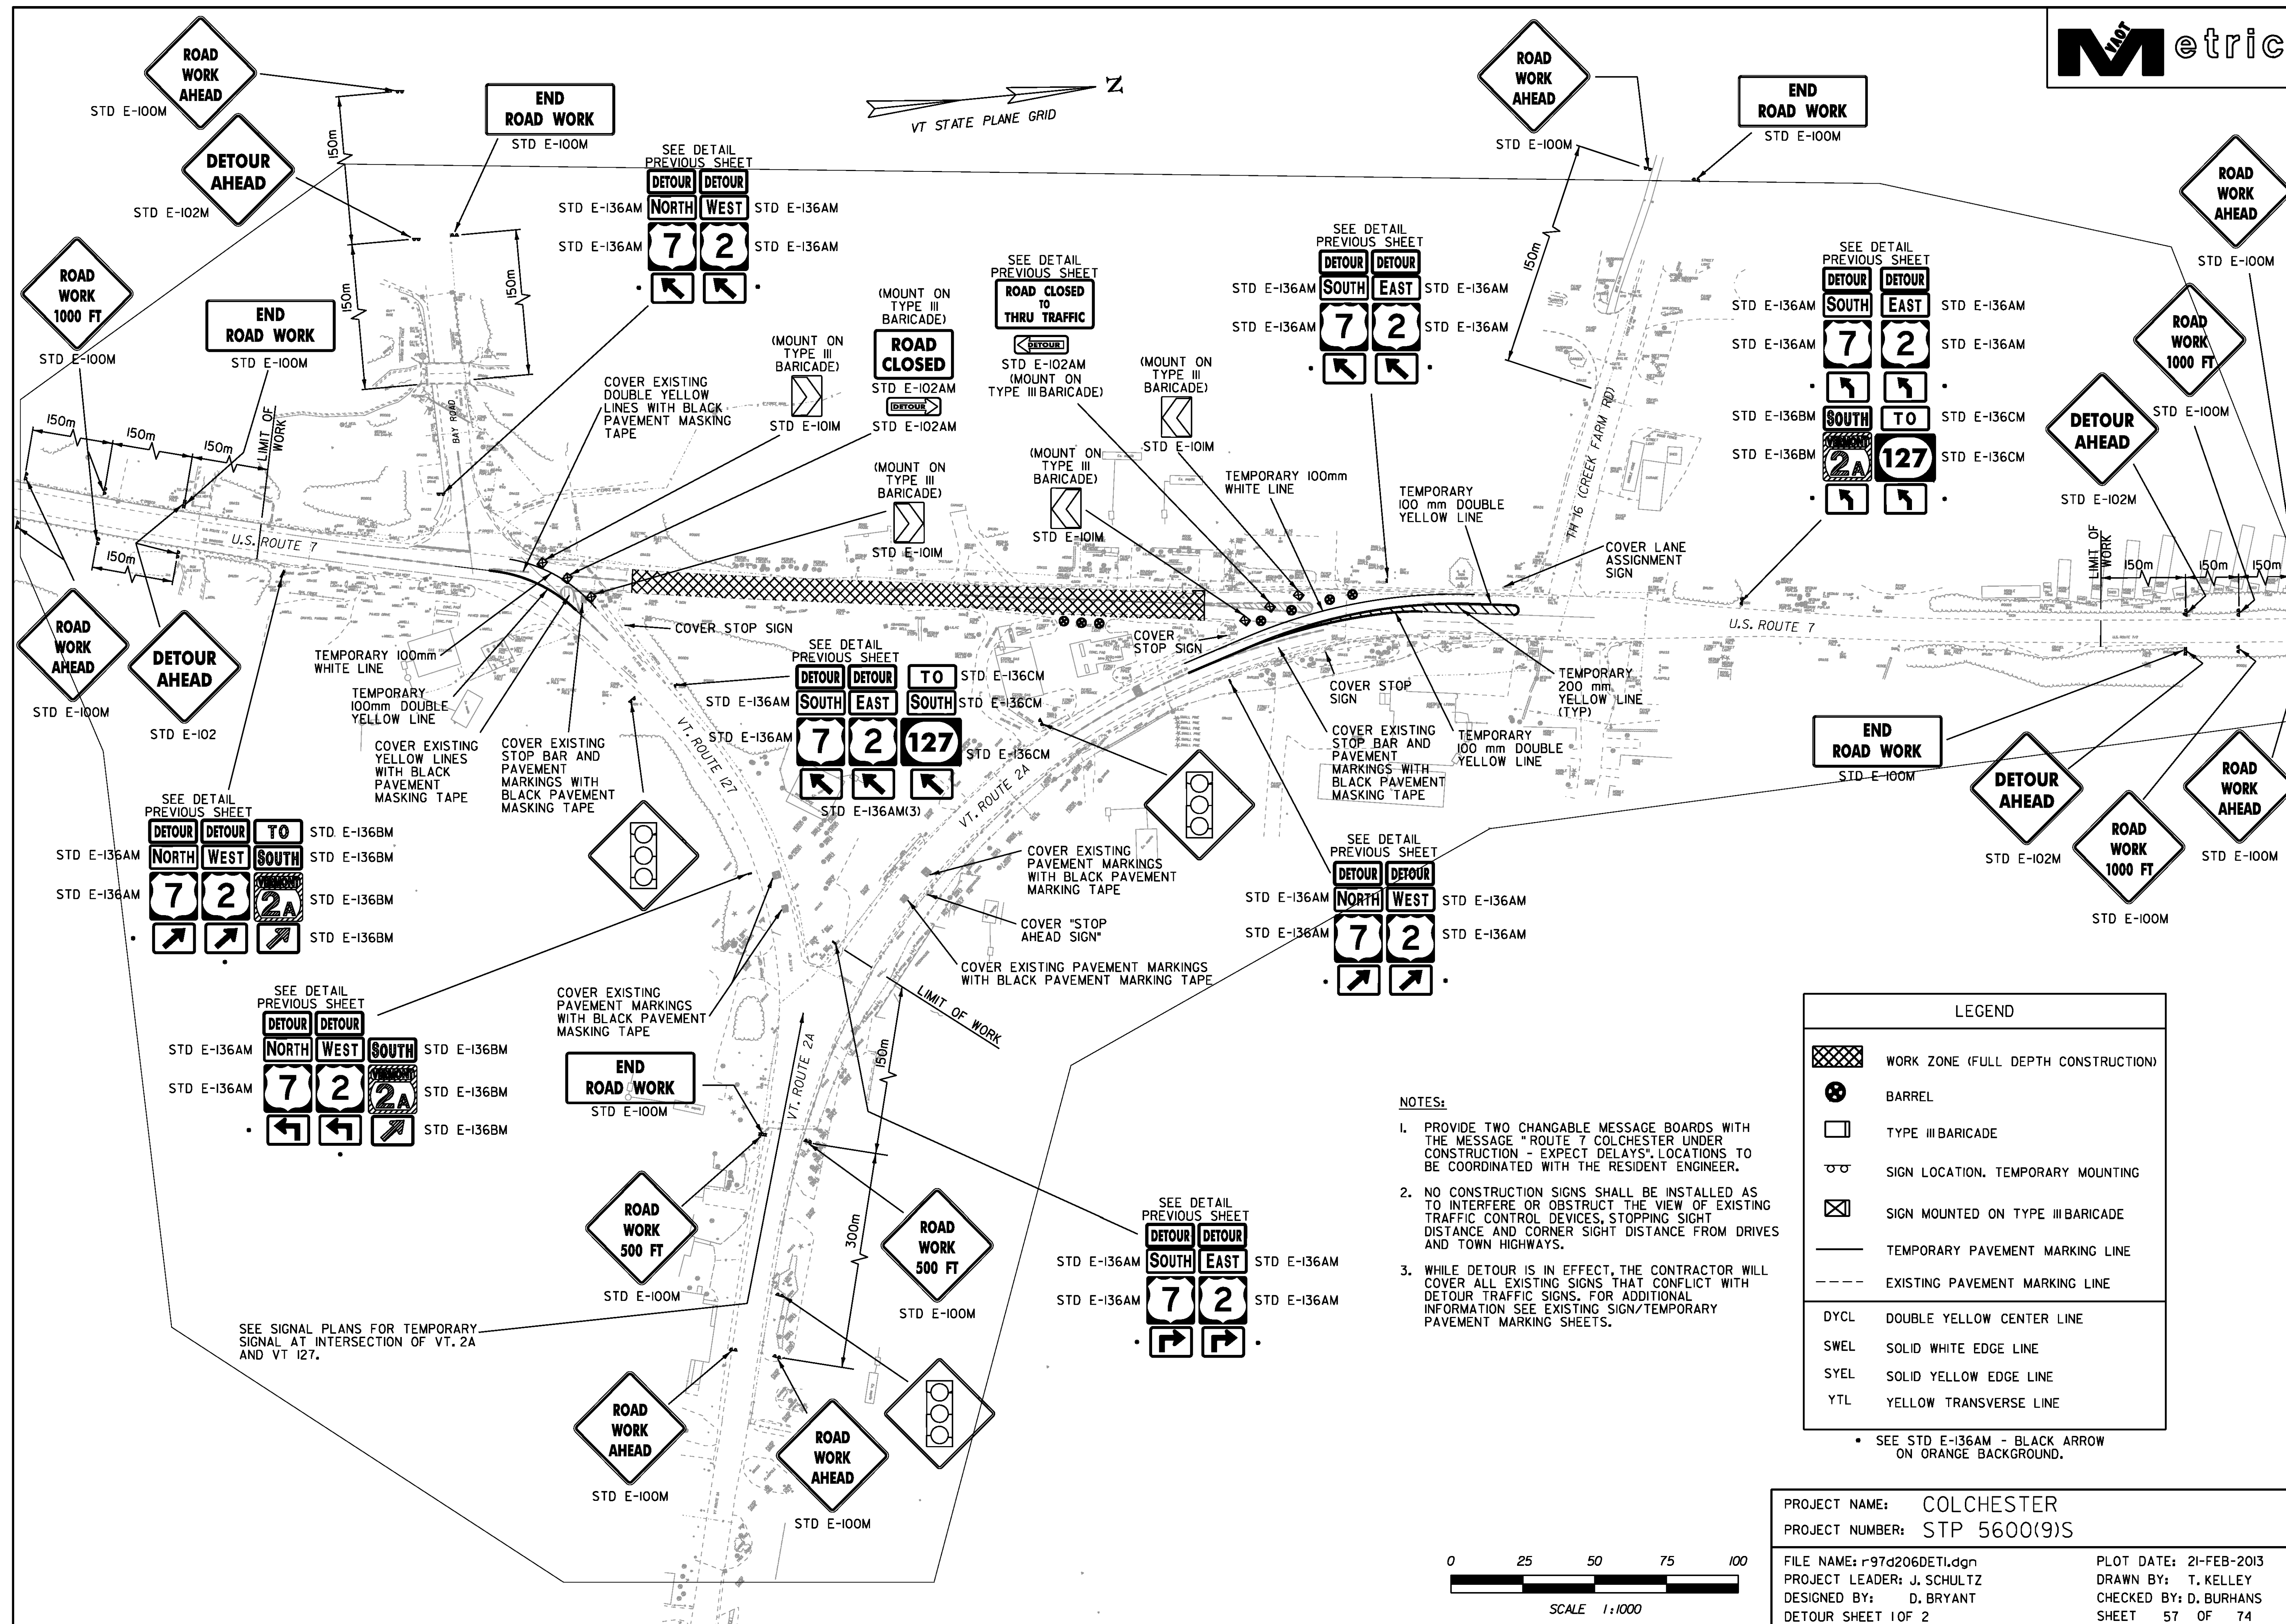

NOTES:

1. PROVIDE TWO CHANGABLE MESSAGE BOARDS WITH THE MESSAGE "ROUTE 7 COLCHESTER UNDER CONSTRUCTION - EXPECT DELAYS". LOCATIONS TO BE COORDINATED WITH THE RESIDENT ENGINEER.
2. NO CONSTRUCTION SIGNS SHALL BE INSTALLED AS TO INTERFERE OR OBSTRUCT THE VIEW OF EXISTING TRAFFIC CONTROL DEVICES, STOPPING SIGHT DISTANCE AND CORNER SIGHT DISTANCE FROM DRIVES AND TOWN HIGHWAYS.
3. WHILE DETOUR IS IN EFFECT, THE CONTRACTOR WILL COVER ALL EXISTING SIGNS THAT CONFLICT WITH DETOUR TRAFFIC SIGNS. FOR ADDITIONAL INFORMATION SEE EXISTING SIGN/TEMPORARY PAVEMENT MARKING SHEETS.

LEGEND

	WORK ZONE (FULL DEPTH CONSTRUCTION)
	BARREL
	TYPE III BARICADE
	SIGN LOCATION, TEMPORARY MOUNTING
	SIGN MOUNTED ON TYPE III BARICADE
	TEMPORARY PAVEMENT MARKING LINE
	EXISTING PAVEMENT MARKING LINE
DYCL	DOUBLE YELLOW CENTER LINE
SWEL	SOLID WHITE EDGE LINE
SYEL	SOLID YELLOW EDGE LINE
YTL	YELLOW TRANSVERSE LINE

• SEE STD E-136AM - BLACK ARROW ON ORANGE BACKGROUND.

PROJECT NAME: COLCHESTER
PROJECT NUMBER: STP 5600(9)S

FILE NAME: r97d206DET1.dgn
PROJECT LEADER: J. SCHULTZ
DESIGNED BY: D. BRYANT
DETOUR SHEET 1 OF 2

PLOT DATE: 21-FEB-2013
DRAWN BY: T. KELLEY
CHECKED BY: D. BURHANS
SHEET 57 OF 74

