


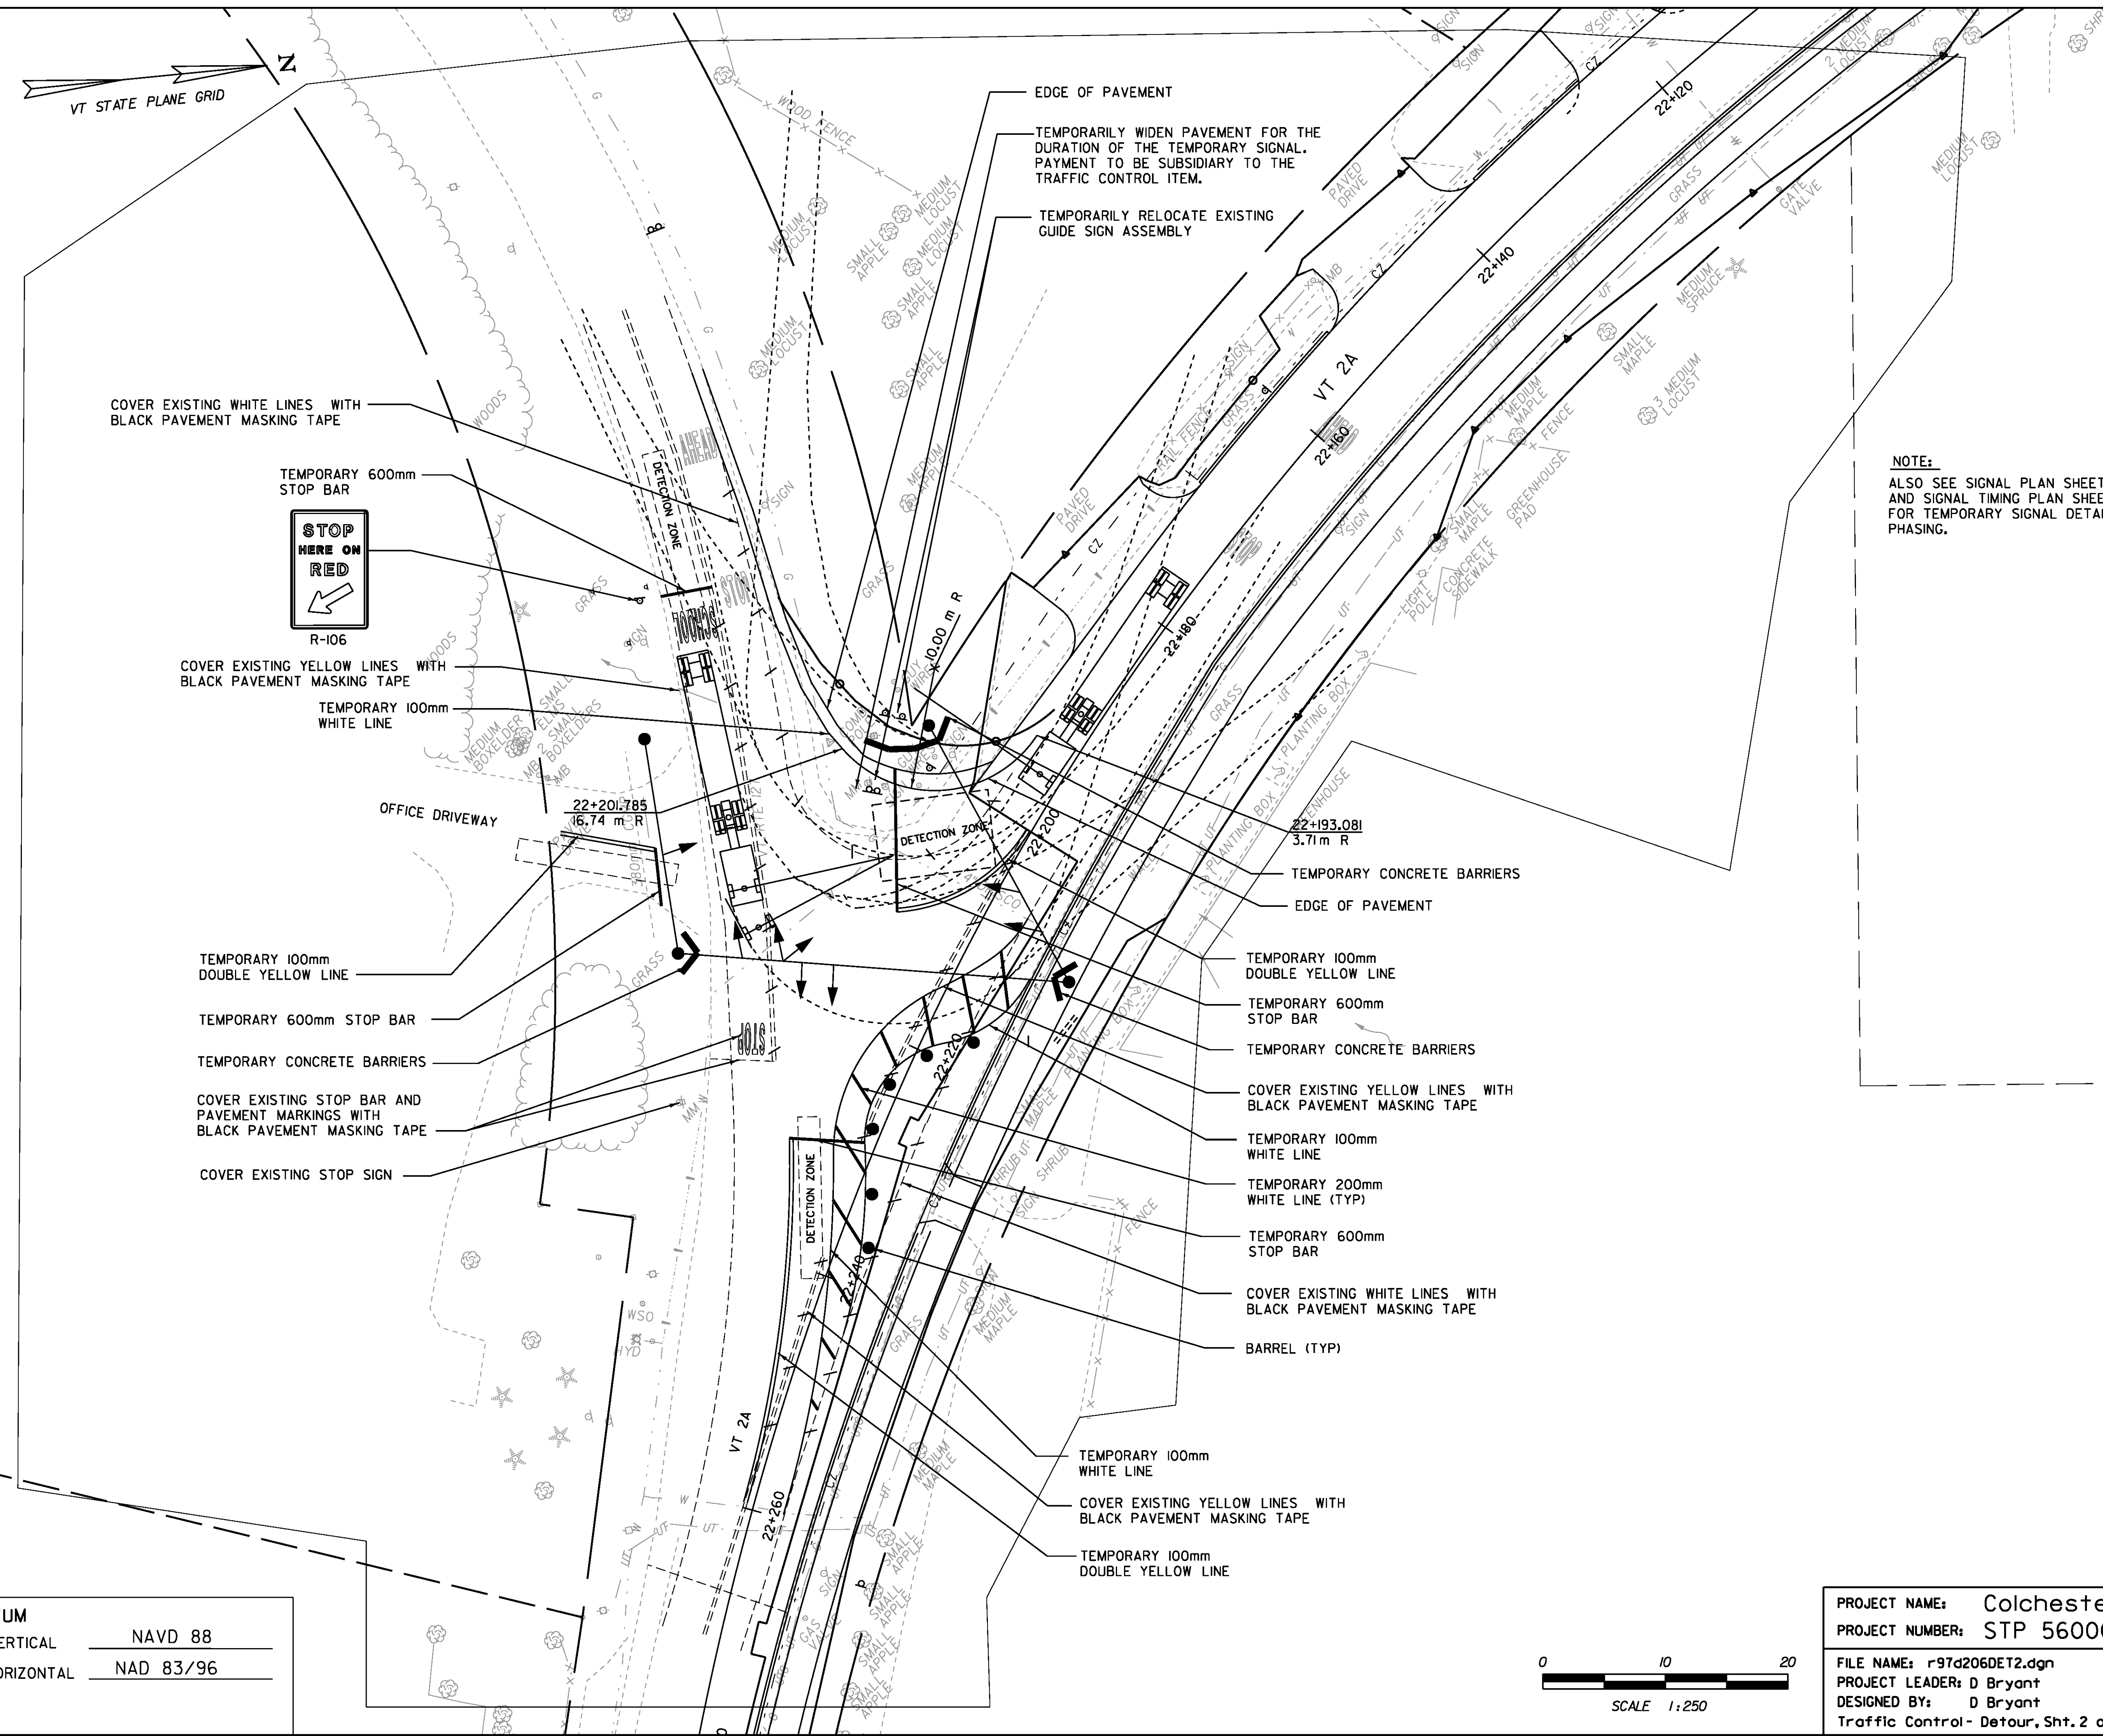

ALSO SEE SIGNAL PLAN SHEET 3 OF 3
AND SIGNAL TIMING PLAN SHEET 3 OF 3
FOR TEMPORARY SIGNAL DETAILS AND
PHASING.

FILE NAME: r97d206DET2.dgn	PLOT DATE: 21-FEB-2013
PROJECT LEADER: D Bryant	DRAWN BY: T Kelley
DESIGNED BY: D Bryant	CHECKED BY: D Burhans
Traffic Control - Detour, Sht. 2 of 2	SHEET 58 OF 74