

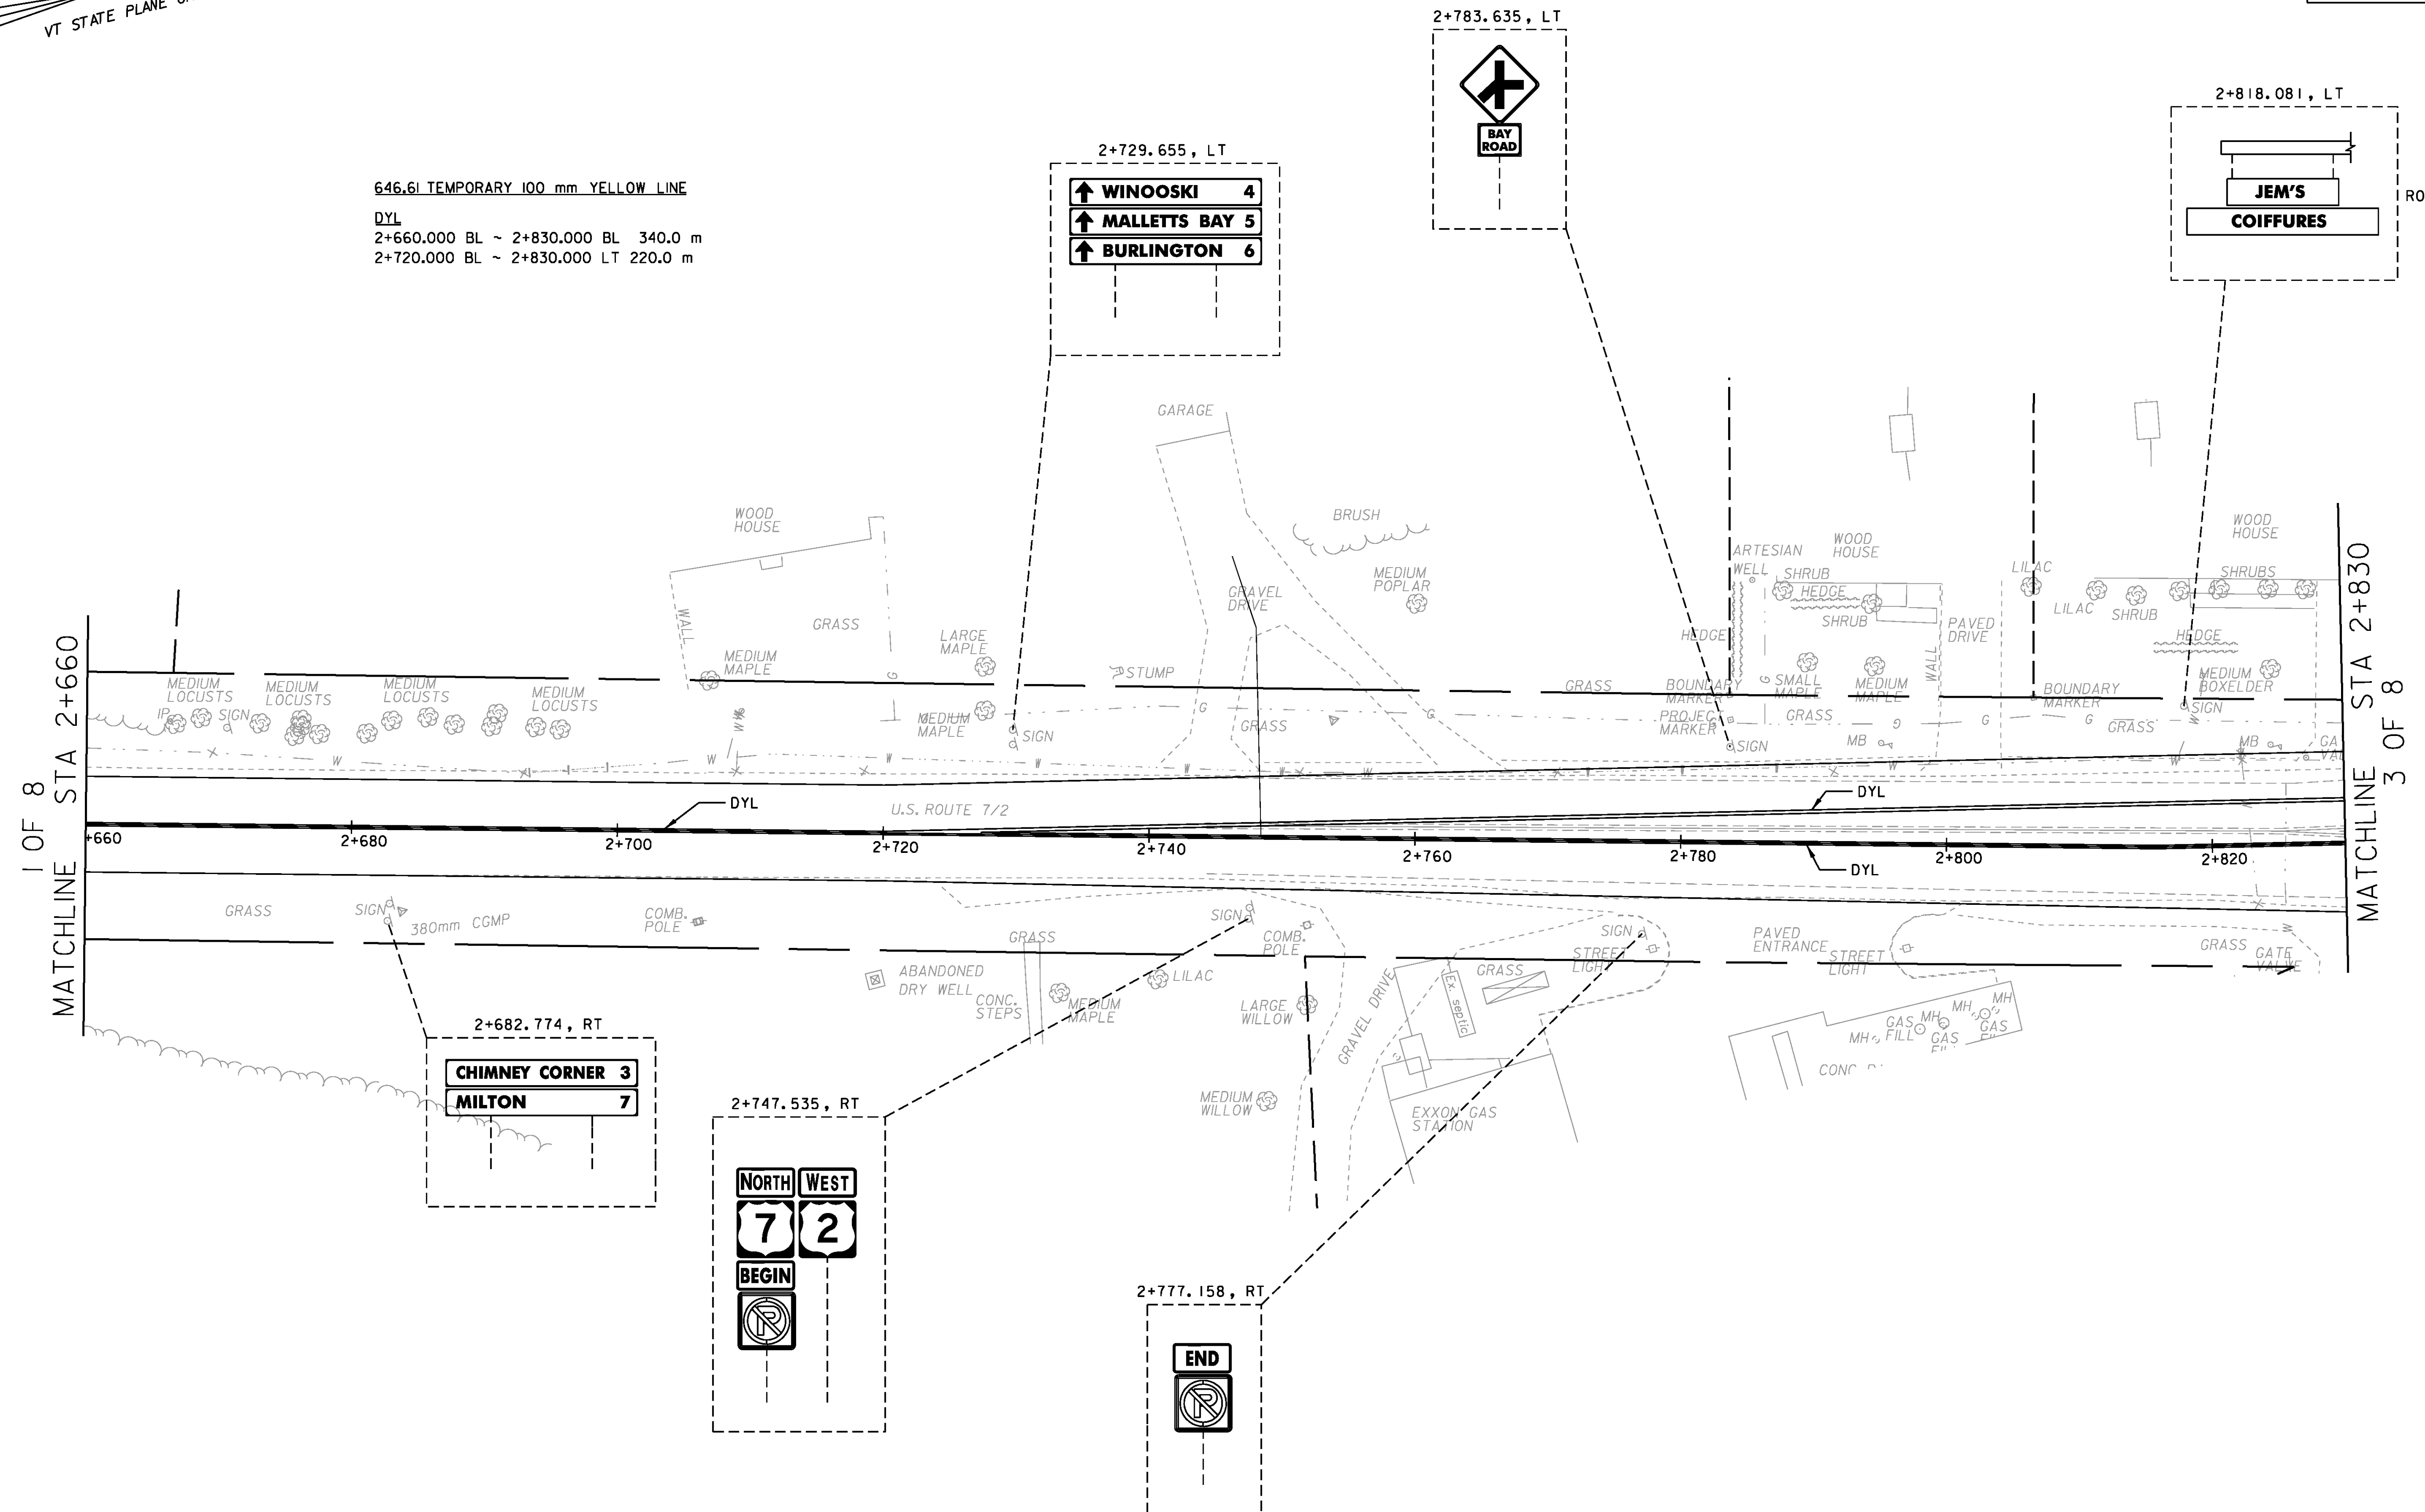


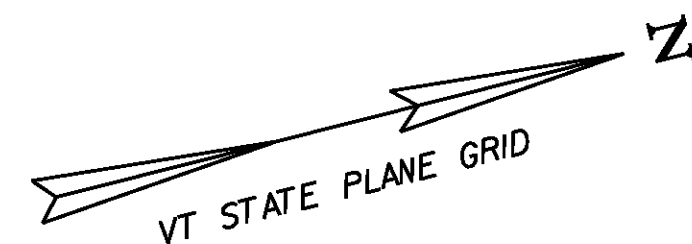

NOTES:

1. ALL SIGNS AND POSTS ARE TO BE REMOVED UNLESS OTHERWISE NOTED.
2. FOR ABBREVIATIONS, LEGENDS AND ADDITIONAL NOTES, SEE EXISTING SIGNING/PVMT MARKING SHEET 1 OF 8.
3. REFER TO PROPOSED SIGNING/PVMT MARKING SHEETS FOR PAVEMENT MARKING RELATED DIMENSIONS.

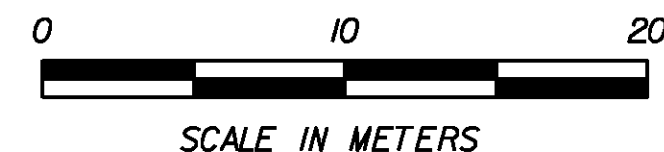

PROJECT NAME: COLCHESTER	
PROJECT NUMBER: STP 5600(9)S	
FILE NAME: r97d206SPME2.dgn	PLOT DATE: 21-FEB-2013
PROJECT LEADER: J. SCHULTZ	DRAWN BY: T. KELLEY
DESIGNED BY: D. BRYANT	CHECKED BY: D. BURHANS
EXIST SIGN/TEMP, PVMT MARK, SHEET 2 OF 8 SHEET 60 OF 74	