
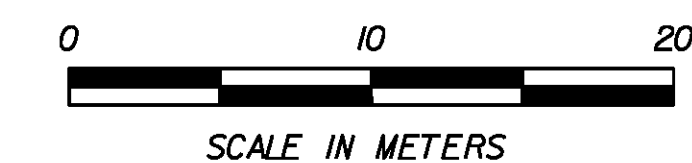


4 OF 8
MATCHLINE STA. 3+180

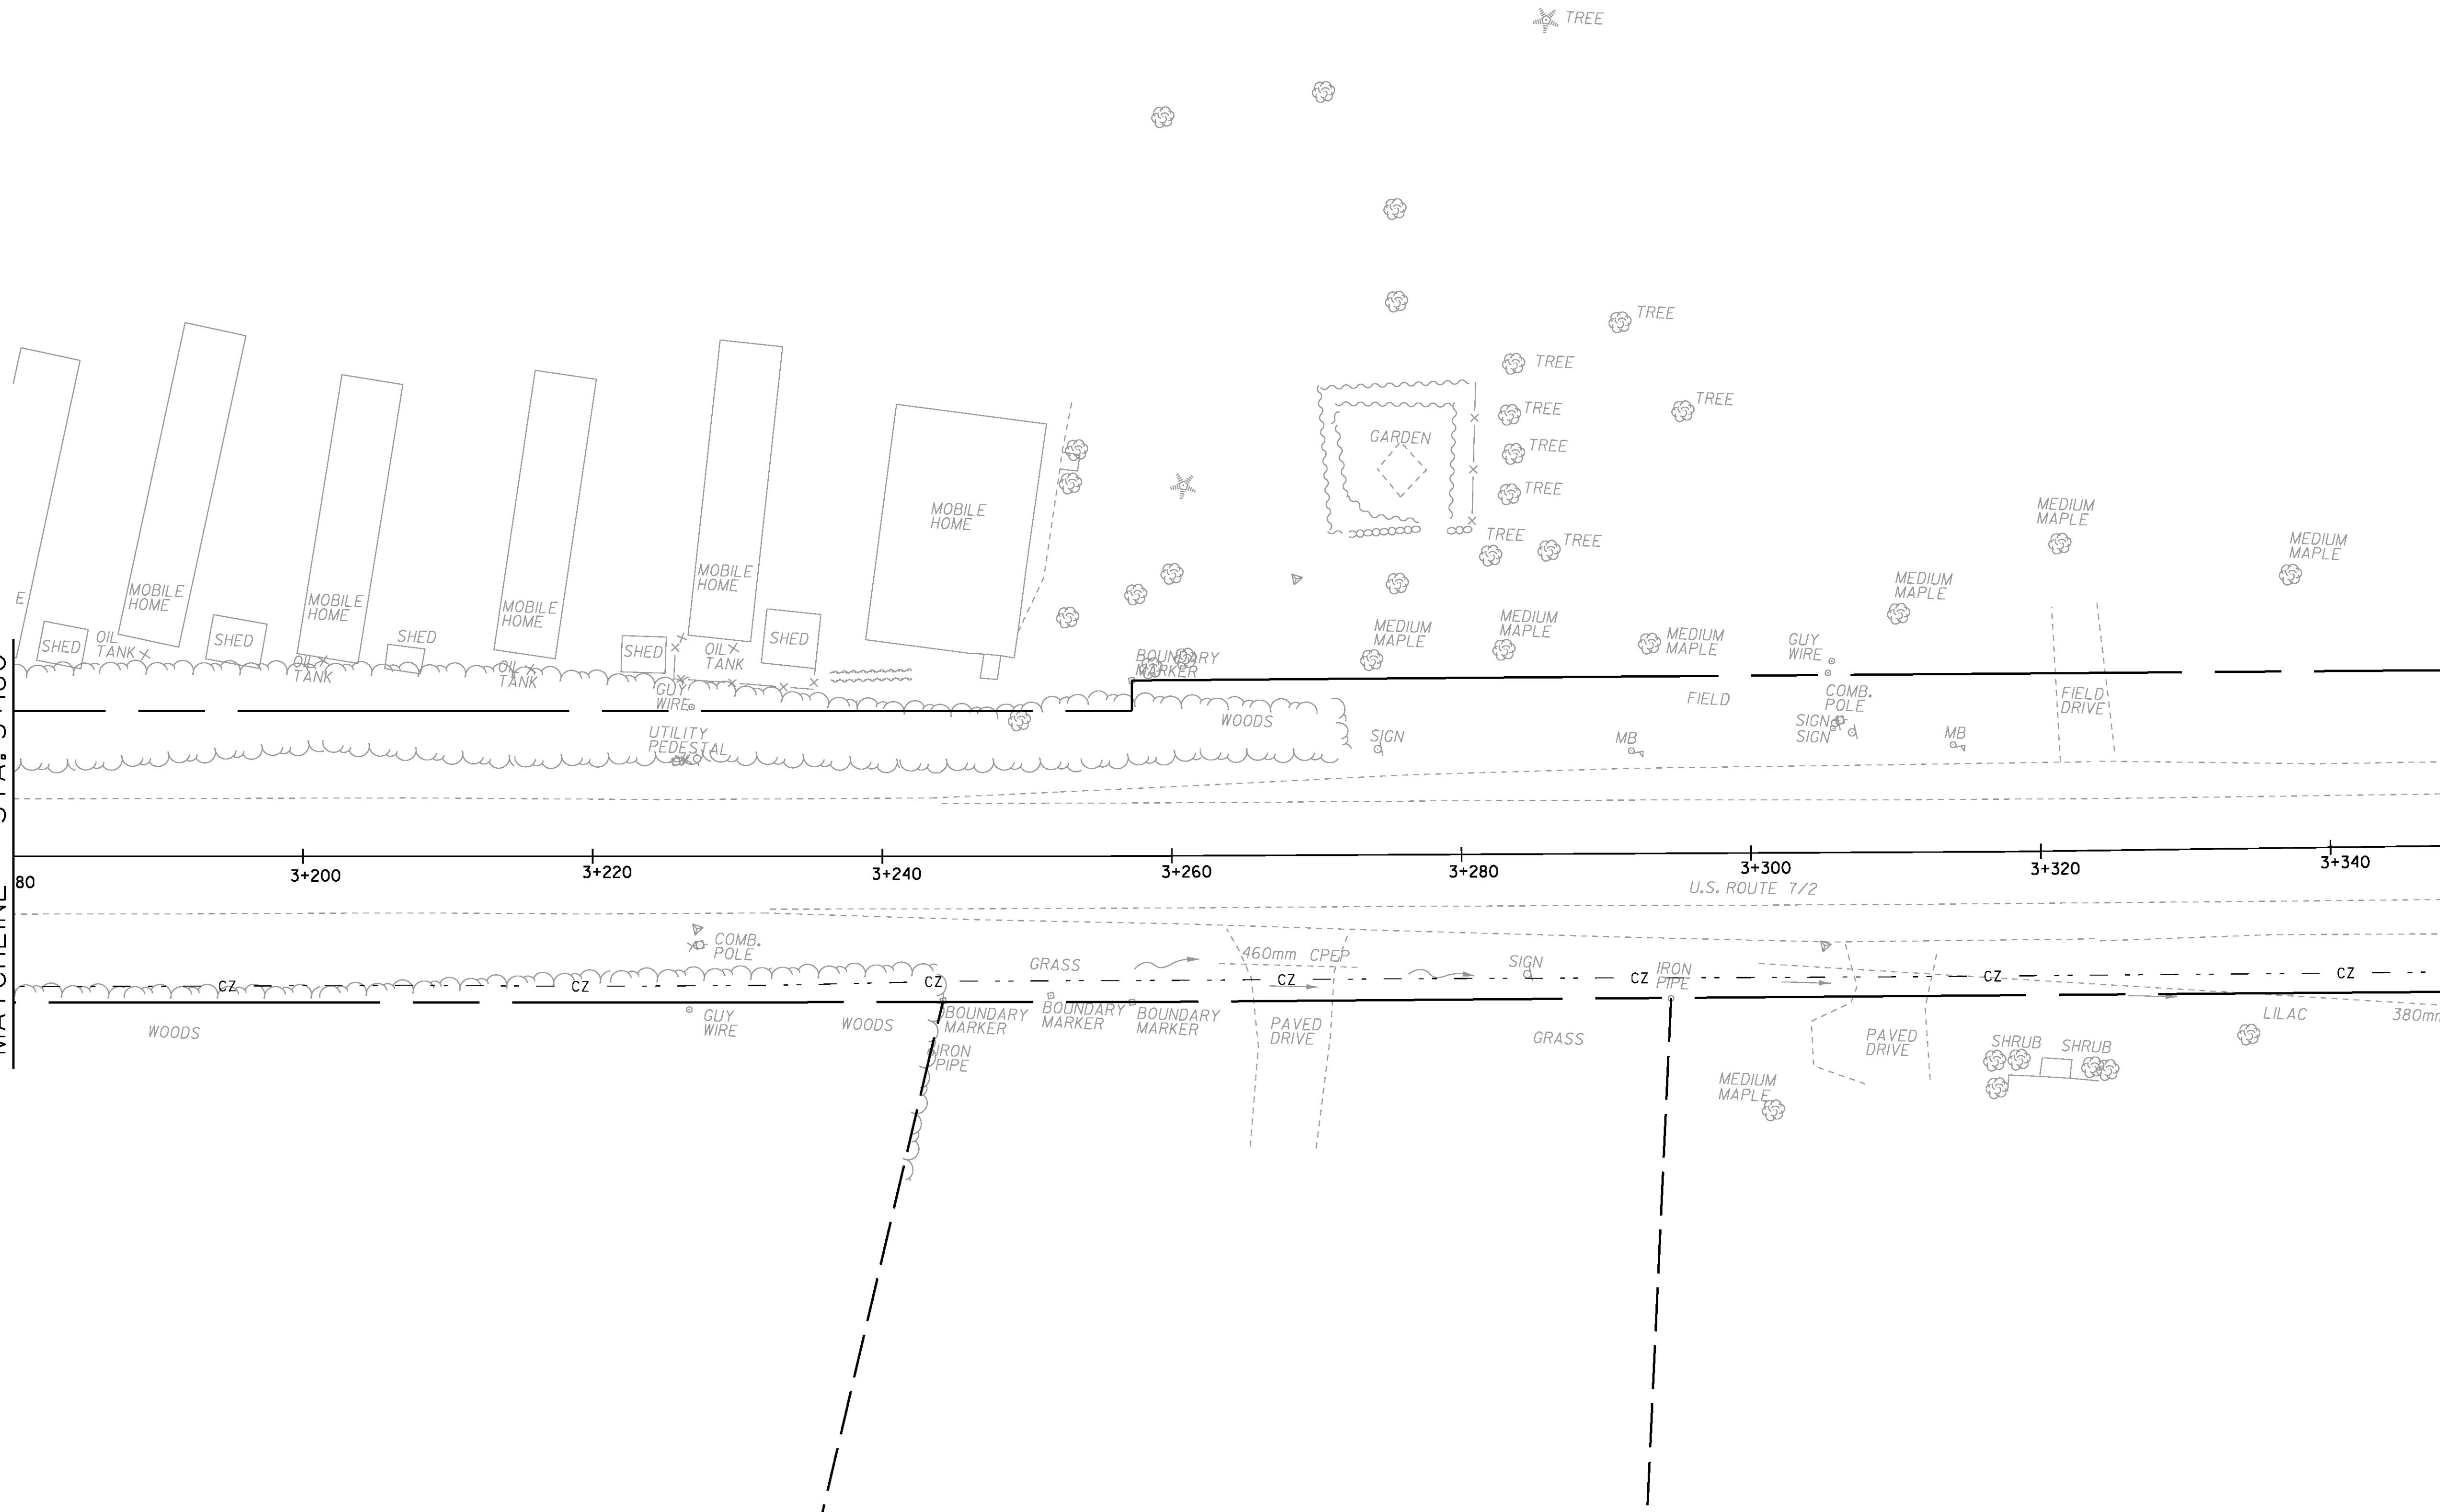

PROJECT NAME: COLCHESTER	
PROJECT NUMBER: STP 5600(9)S	
FILE NAME: r97d206SPME5.dgn	PLOT DATE: 21-FEB-2013
PROJECT LEADER: J. SCHULTZ	DRAWN BY: T. KELLEY
DESIGNED BY: D. BRYANT	CHECKED BY: D. BURHANS
EXIST SIGN/TEMP, PVMT MARK, SHEET 5 OF 8 SHEET 63 OF 74	