
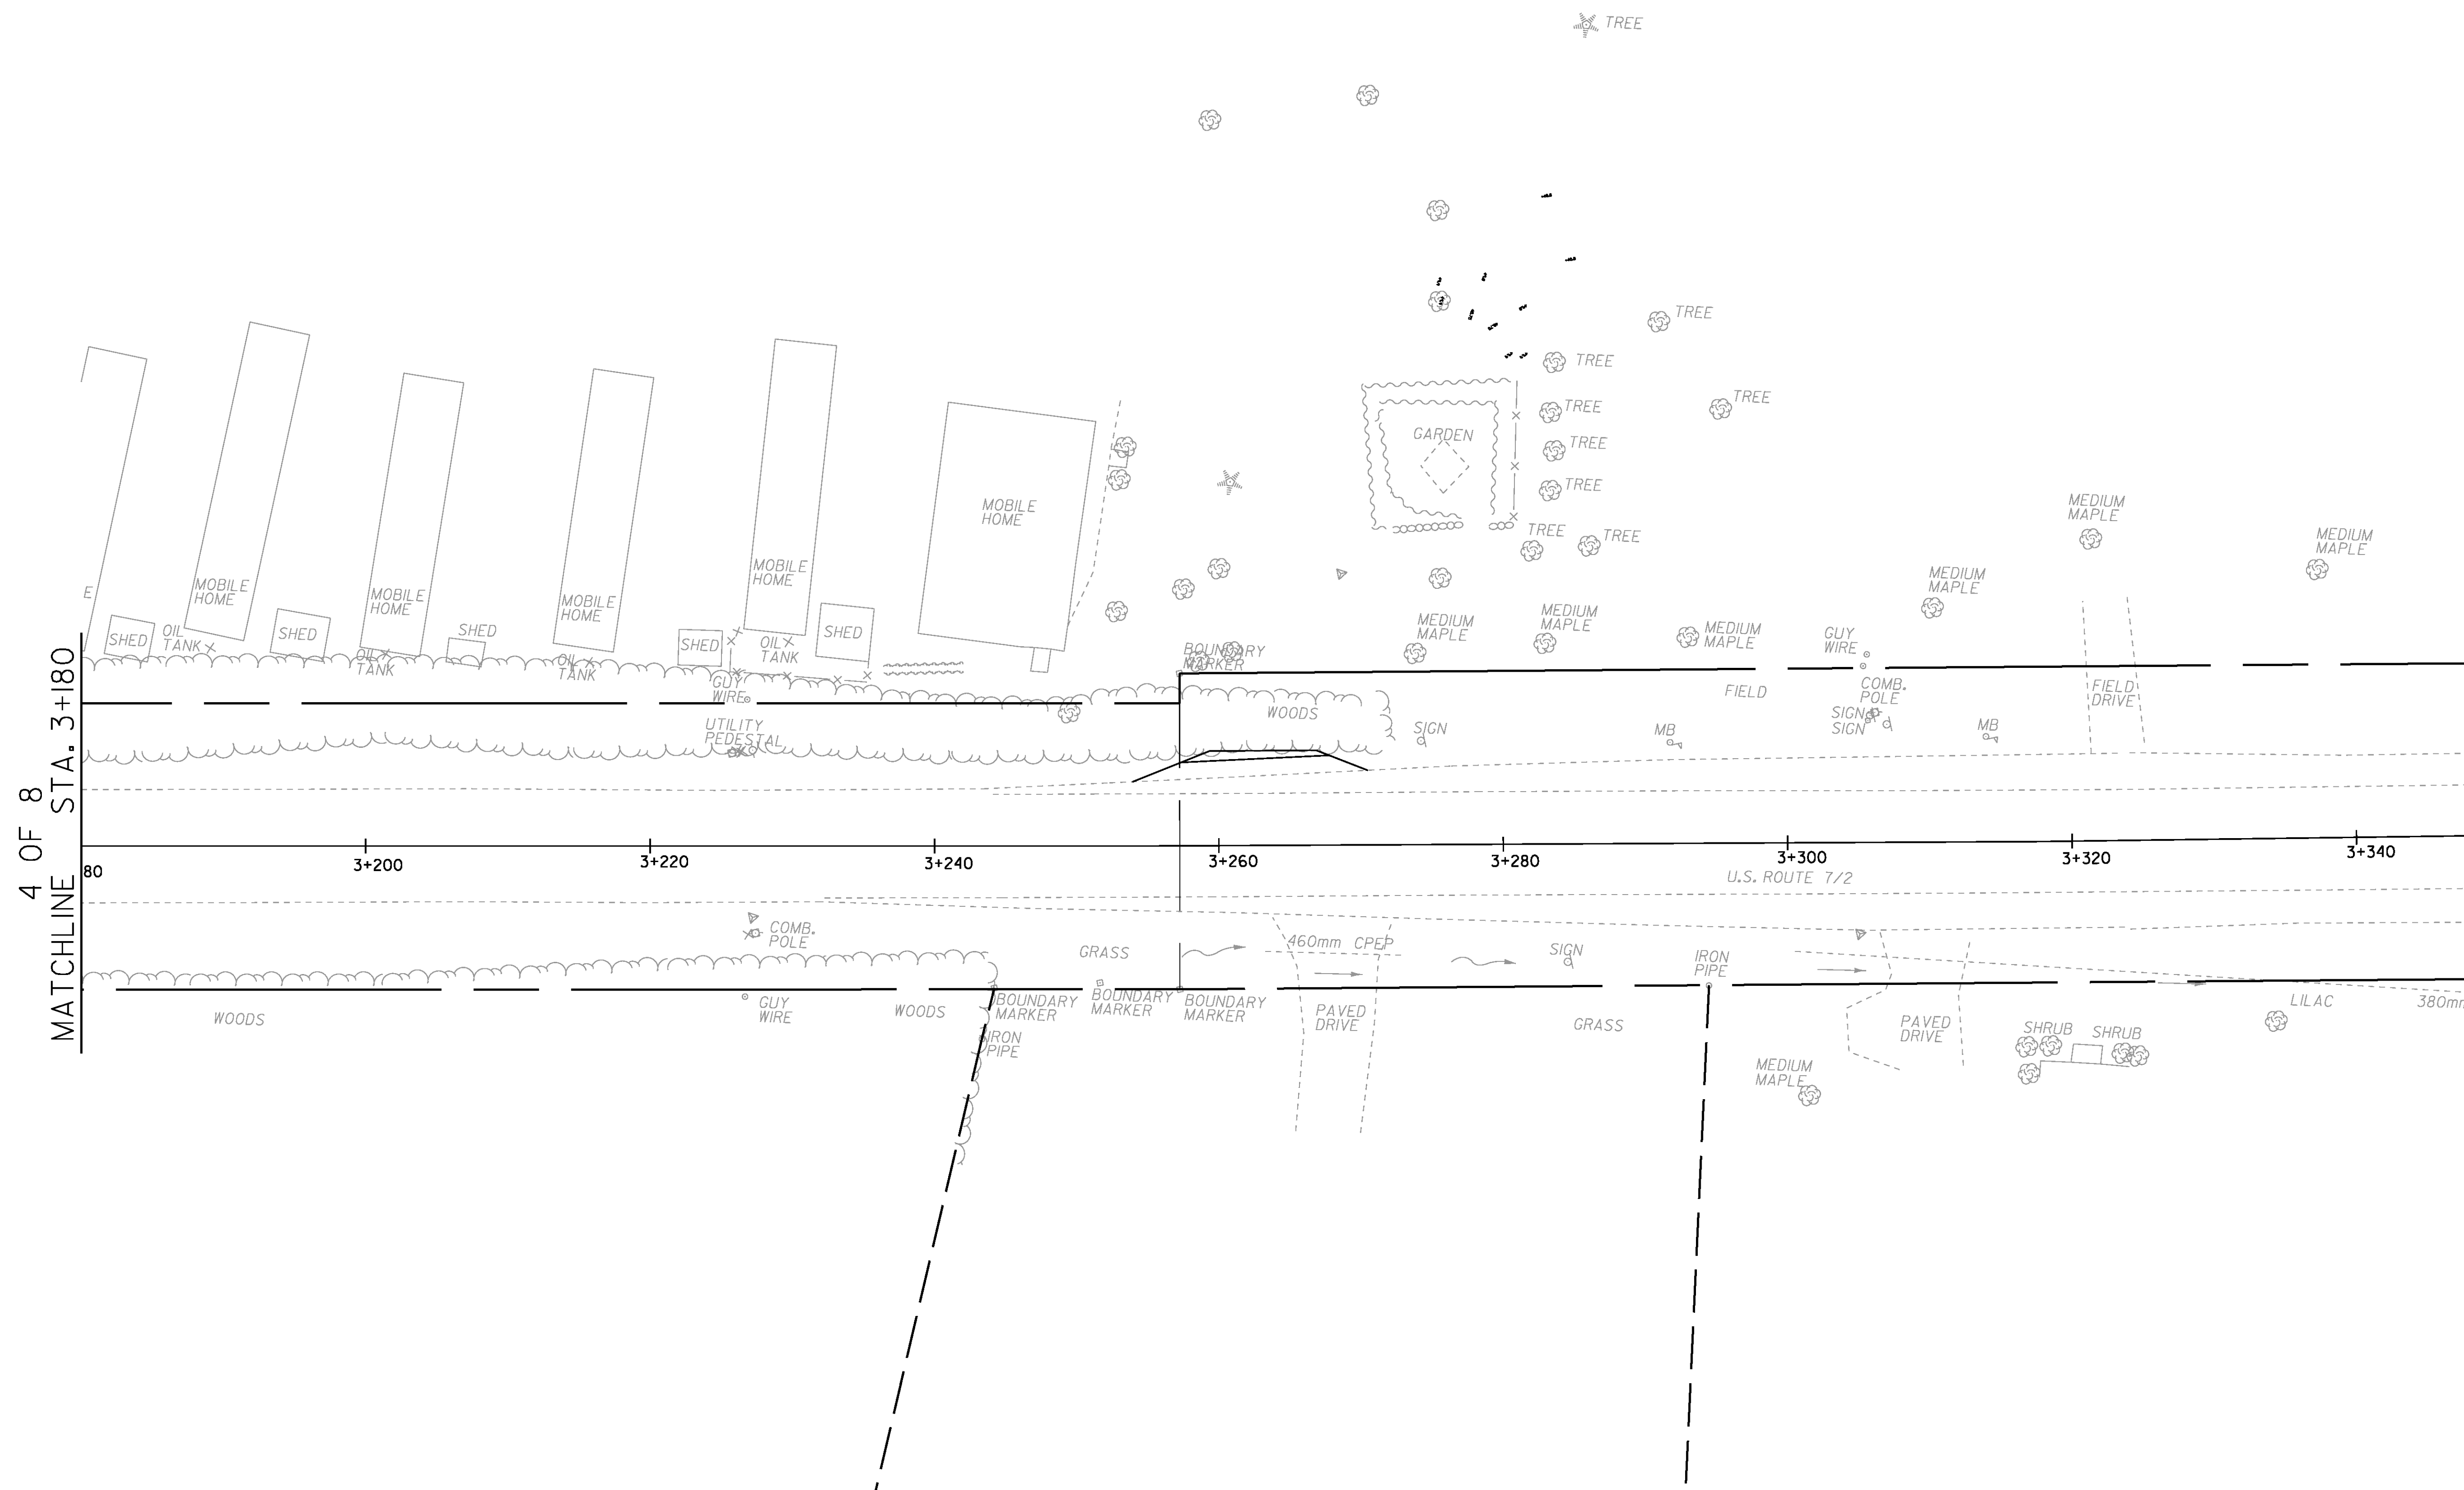


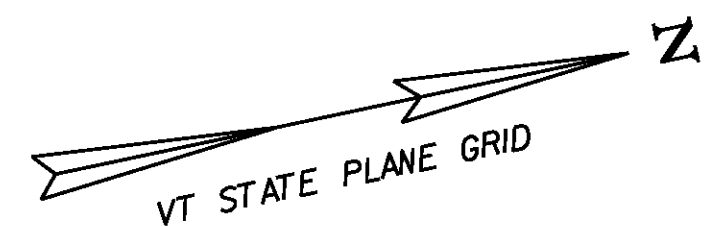

PROJECT NAME: COLCHESTER	
PROJECT NUMBER: STP 5600(9)S	
FILE NAME: r97d206SPMP5.dgn	PLOT DATE: 21-FEB-2013
PROJECT LEADER: J. SCHULTS	DRAWN BY: T. KELLEY
DESIGNED BY: D. BRYANT	CHECKED BY: D. BURHANS
PROP. SIGN/PVMT MARK, SHEET 5 OF 8	SHEET 71 OF 74