
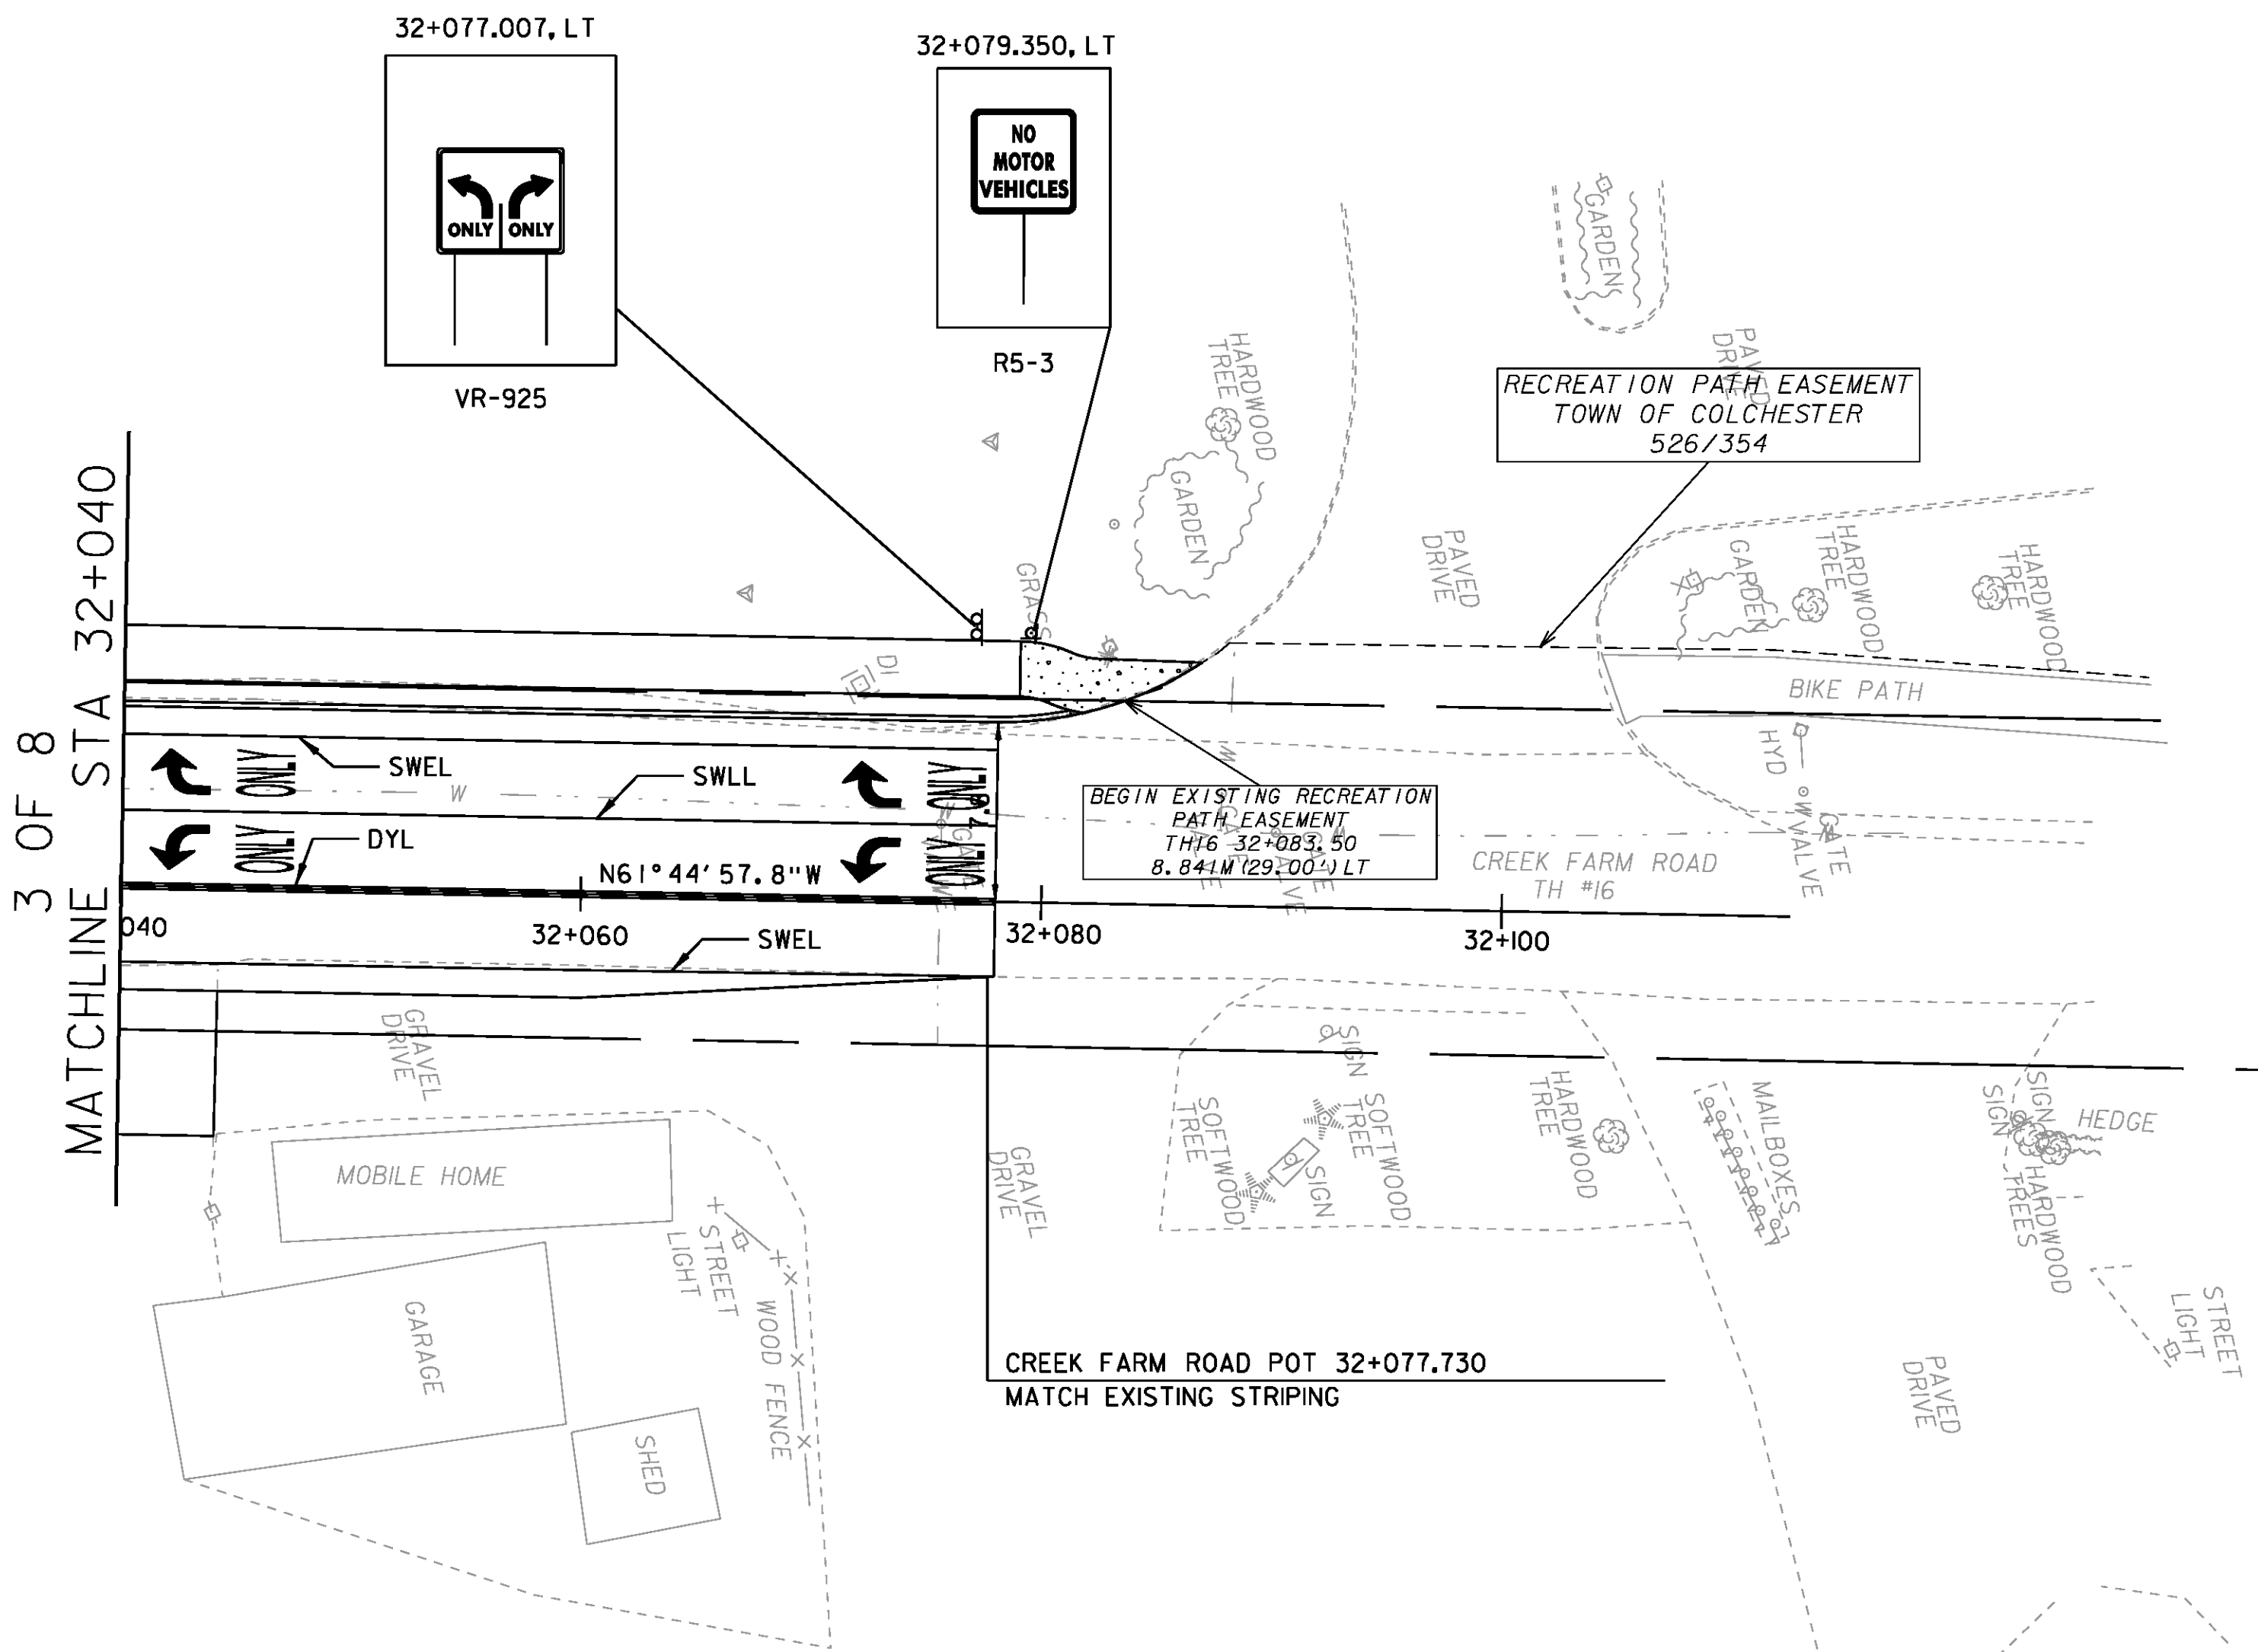


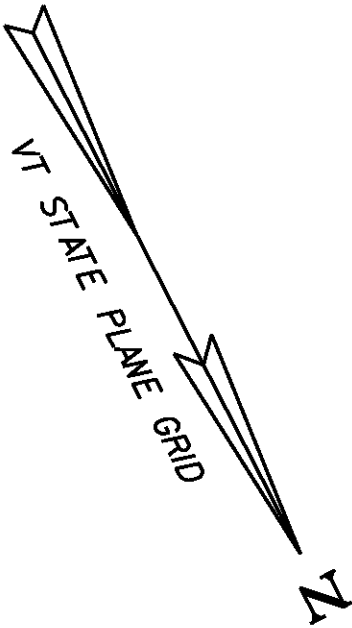


646.40 DURABLE 100 mm WHITE LINE
32+040.000 LT ~ 32+077.730 LT 37.7 m (TURN LANE)
32+040.000 RT ~ 32+077.730 RT 37.7 m (EDGE LINE)
32+040.000 LT ~ 32+077.730 LT 37.7 m (EDGE LINE)

646.41 DURABLE 100 mm YELLOW LINE
32+040.000 BL ~ 32+077.730 BL 75.4 m (CENTER LINE)

646.50 DURABLE LETTER OR SYMBOL
32+041.295 LT 2 EA (LEFT AND RIGHT ARROWS)
32+044.995 LT 8 EA (ONLY)
32+071.295 LT 2 EA (LEFT AND RIGHT ARROWS)
32+074.995 LT 8 EA (ONLY)

- NOTES:
1. ALL SIGNS AND POSTS ARE NEW UNLESS OTHERWISE NOTED.
 2. FOR ABBREVIATIONS, LEGENDS AND ADDITIONAL NOTES, SEE EXISTING SIGNING/PVMT MARKING SHEET 1 OF 8.

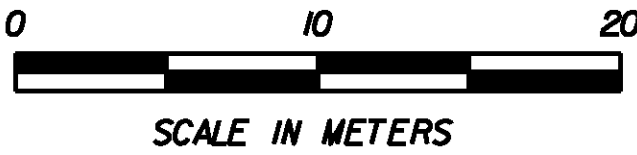

PROJECT NAME: COLCHESTER
PROJECT NUMBER: STP 5600(9)S

FILE NAME: r97d206SPMP8.dgn	PLOT DATE: 21-FEB-2013
PROJECT LEADER: J. SCHULTZ	DRAWN BY: T. KELLEY
DESIGNED BY: D. BRYANT	CHECKED BY: D. BURHANS
PROP. SIGN/PVMT MARK, SHEET 8 OF 8	SHEET 74 OF 74