


MATERIAL TOLERANCES		
PAVEMENT (TOTAL DEPTH):	±	5
SUBBASE (TOTAL DEPTH):	±	30
SAND BORROW (TOTAL DEPTH):	±	30


TYPICAL SECTIONS

NOT TO SCALE


45 SUPERPAVE BITUMINOUS CONCRETE PAVEMENT (TYPE 111S) - (1 - 45 LIFT)
 170 SUPERPAVE BITUMINOUS CONCRETE PAVEMENT (TYPE 11S) - (2 - 85 LIFTS)
 610 SUBBASE OF DENSE GRADED CRUSHED STONE
 610 SAND BORROW

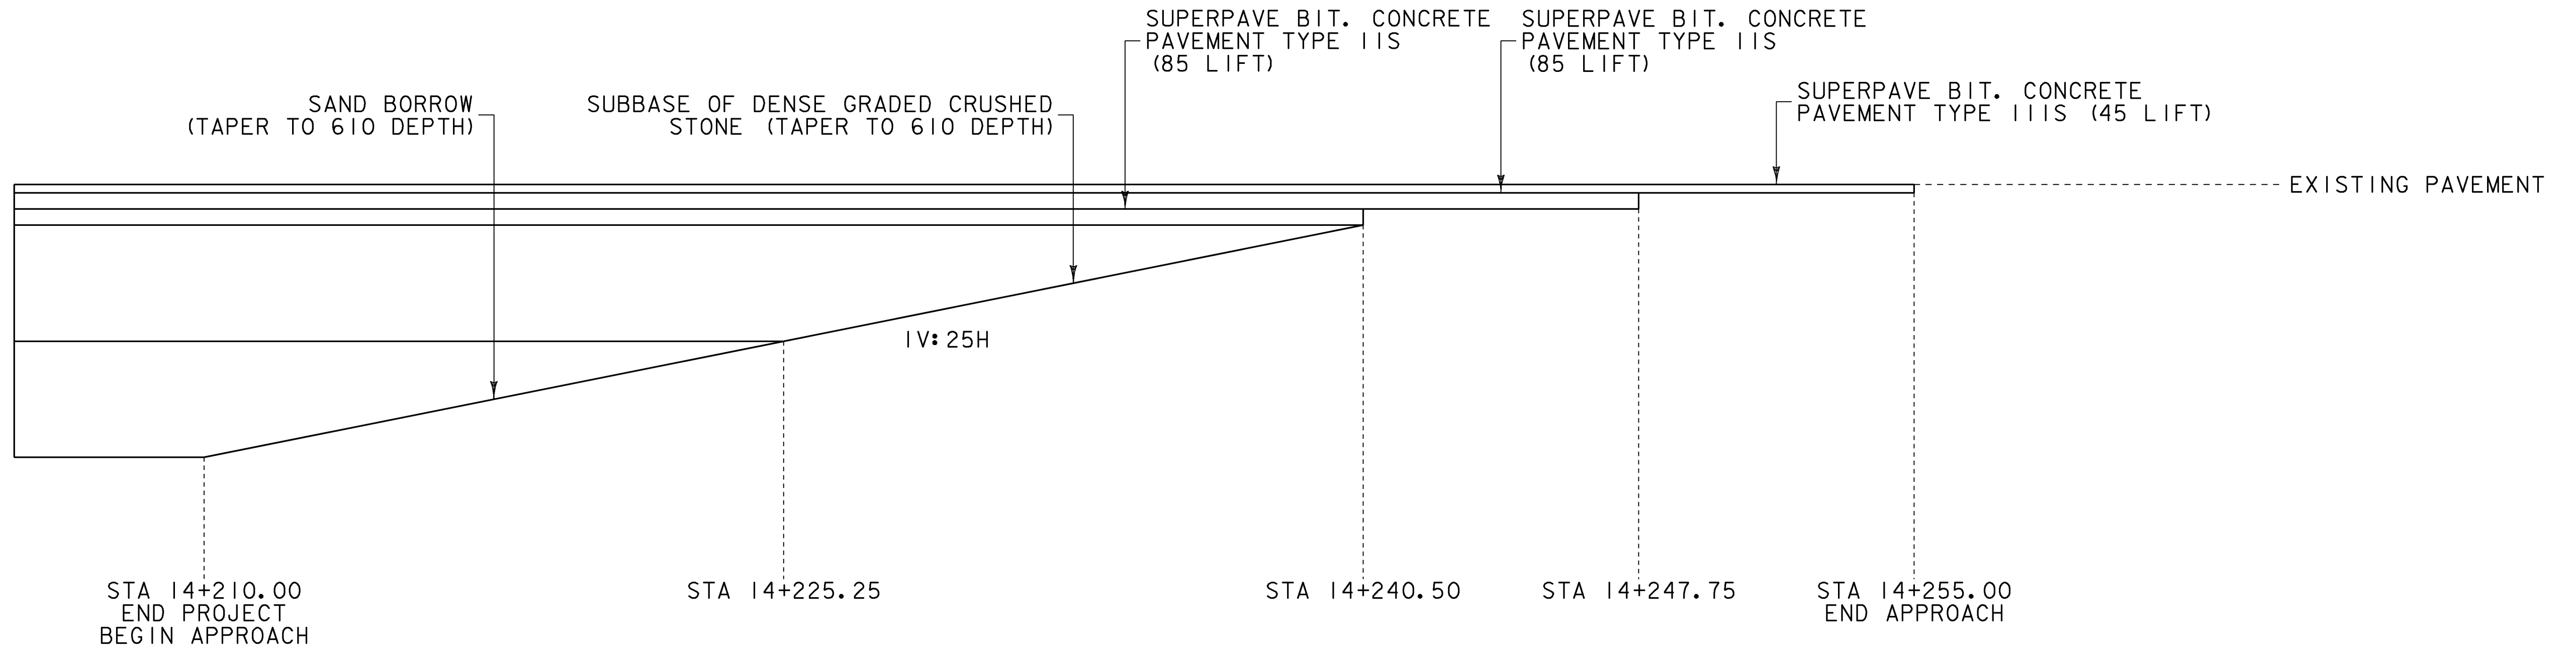

**VT ROUTE 14
 END PROJECT MATERIAL TRANSITION DETAIL**

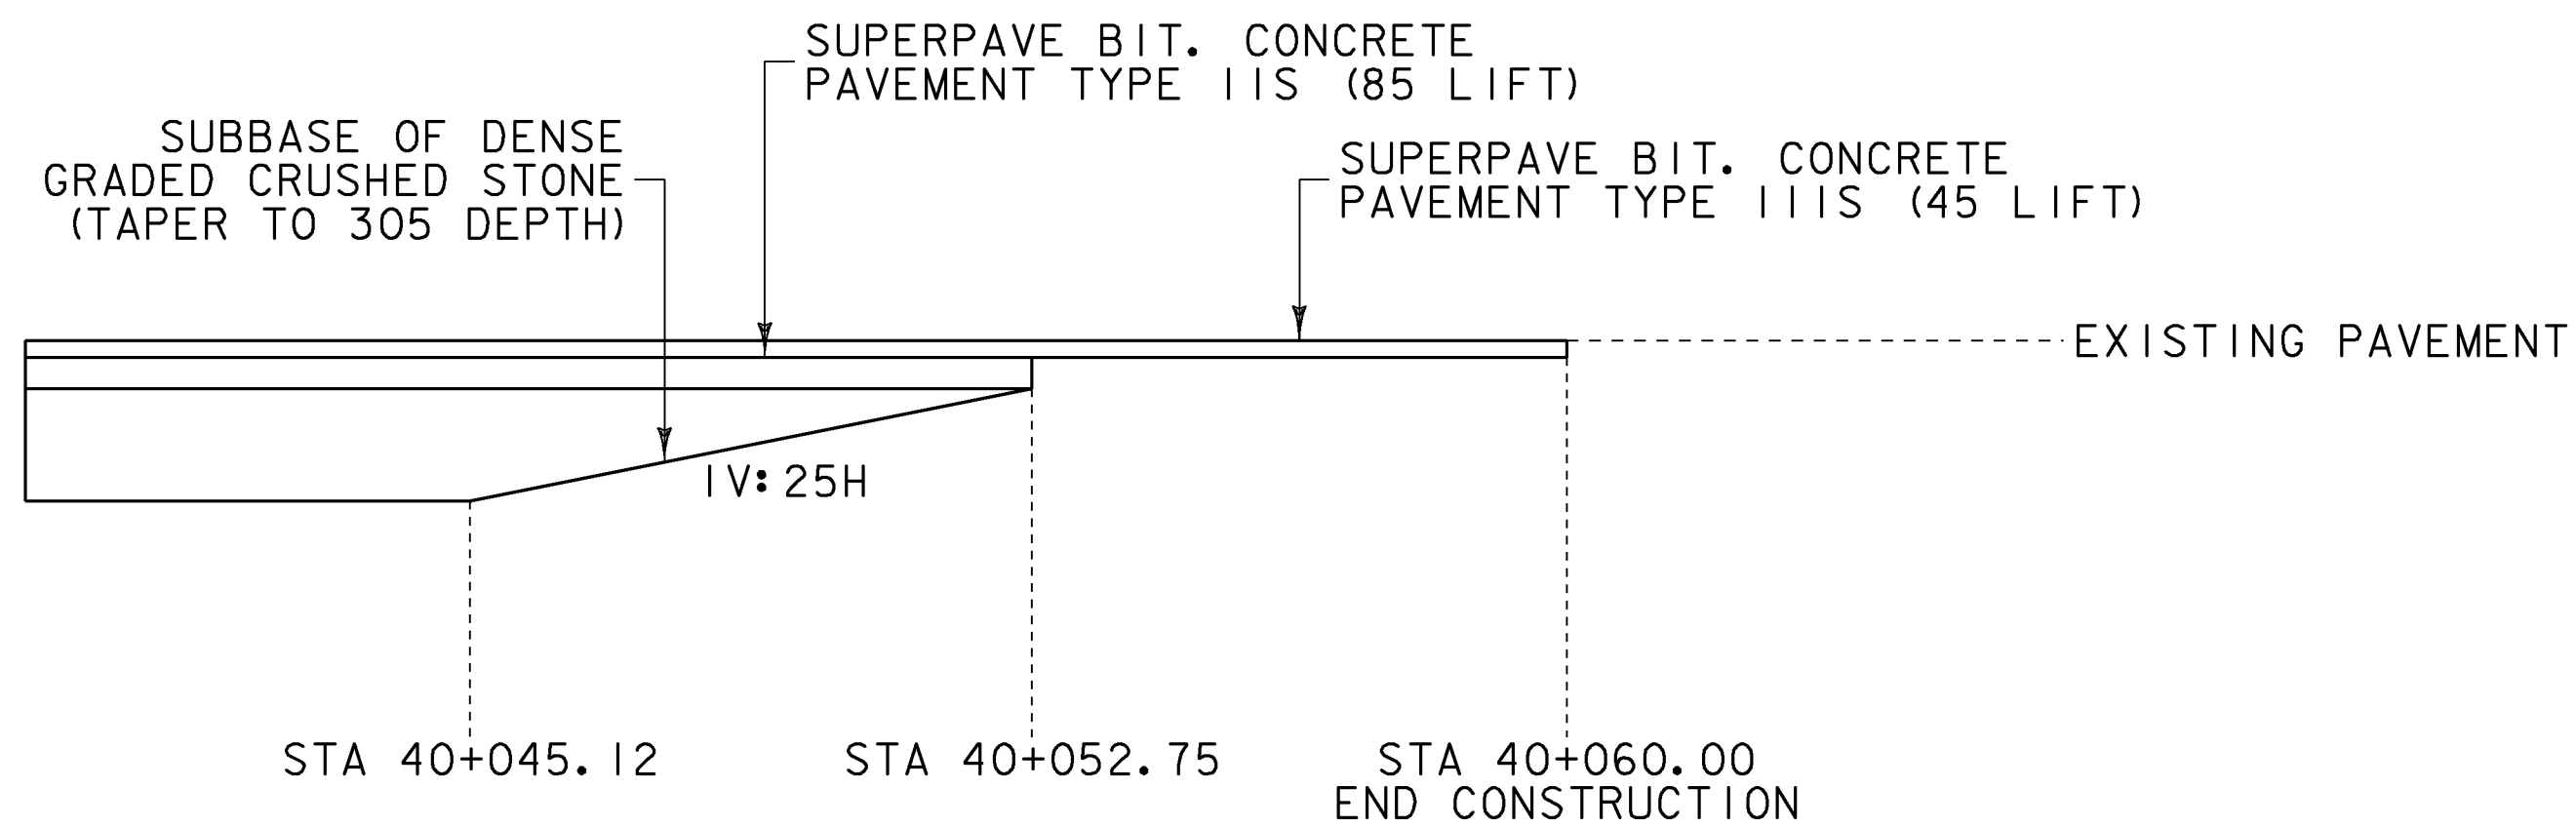

**QUAKER HILL ROAD
 END PROJECT MATERIAL TRANSITION DETAIL**

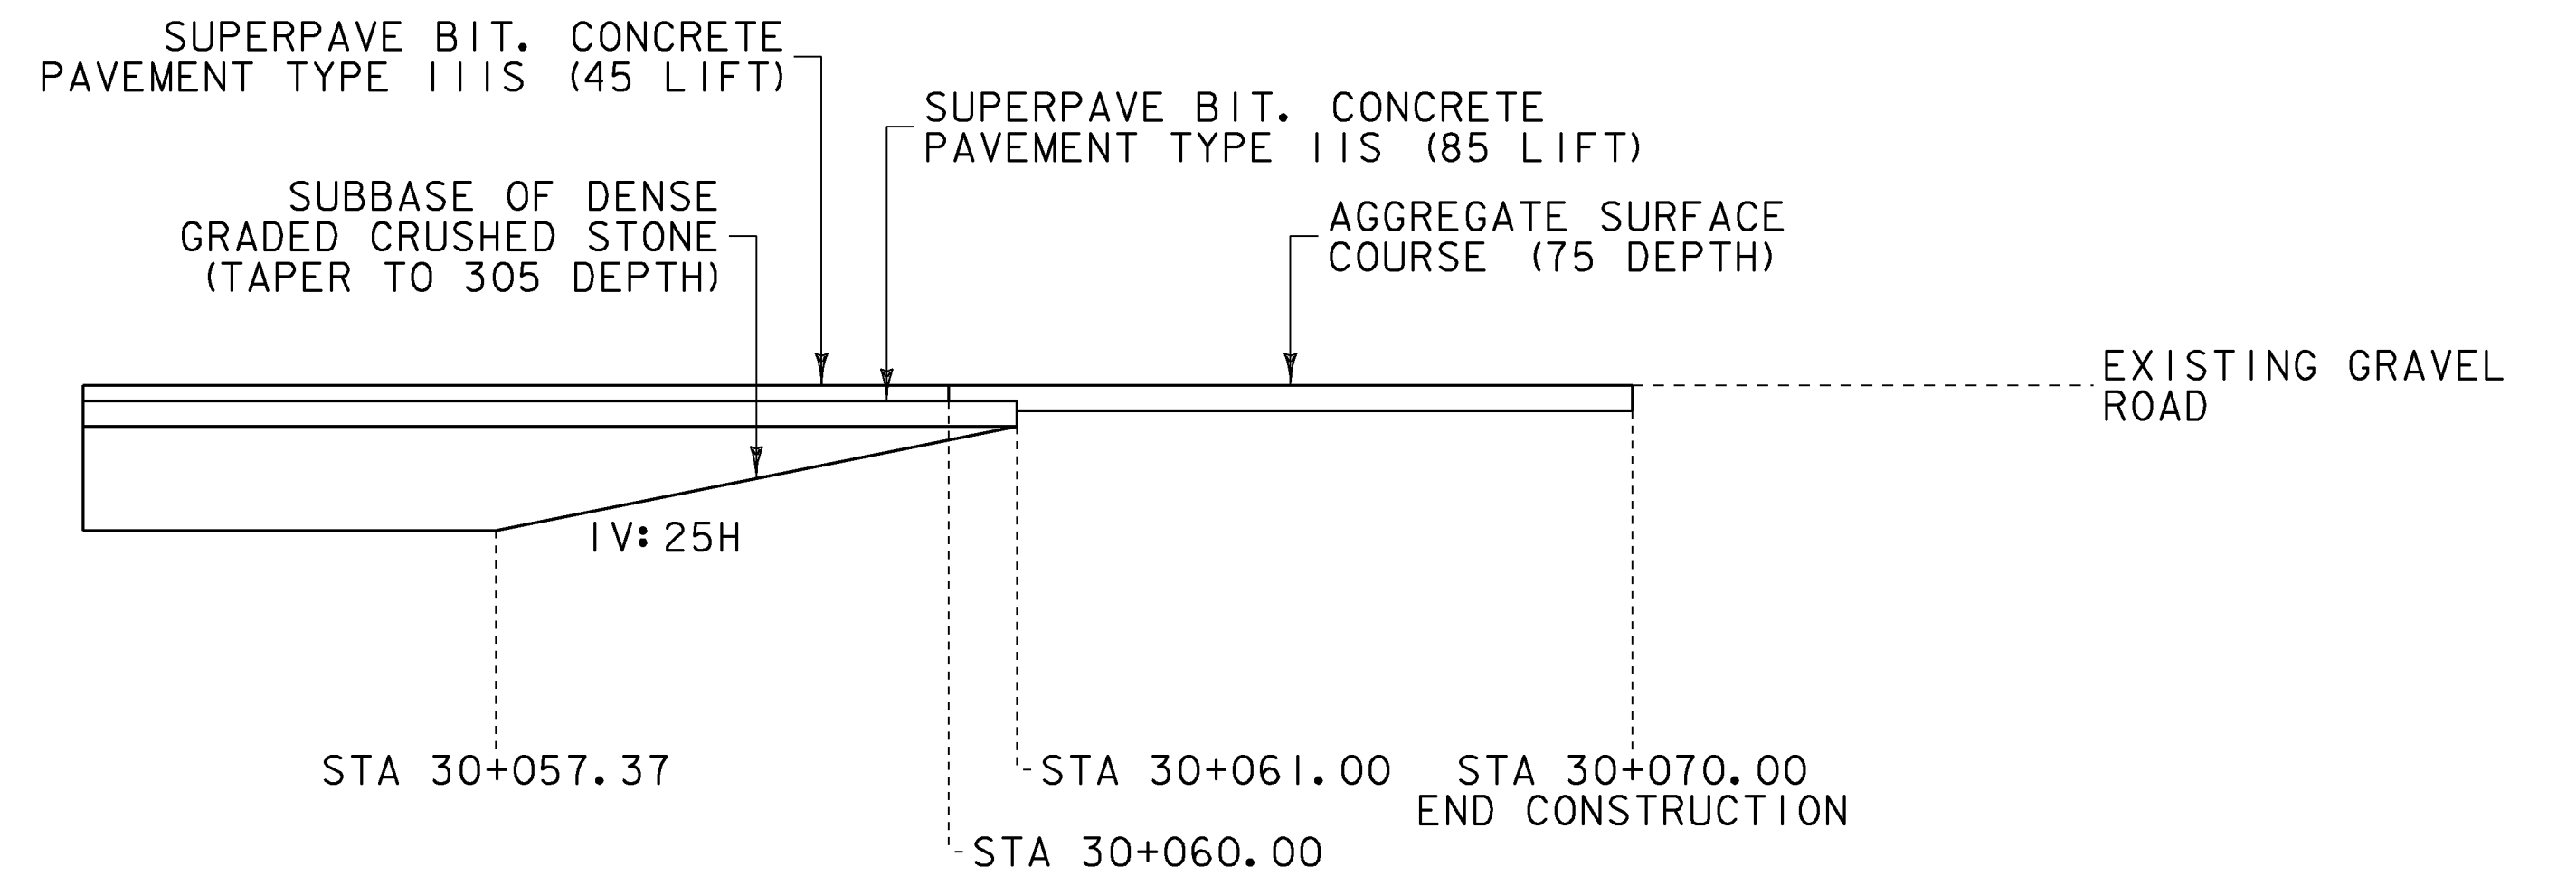

**KELTON ROAD
 END PROJECT MATERIAL TRANSITION DETAIL**

PROJECT NAME: EAST MONTPELIER	PLOT DATE: 22-MAR-2010
PROJECT NUMBER: STPG 028 - 3(35)S	DRAWN BY: I. DEGUTIS
FILE NAME: +98b028+typ.dgn	CHECKED BY: J. DEVLIN
PROJECT LEADER: J. SCHULTZ	SHEET 8 OF 142
DESIGNED BY: J. GRUCHACZ	MATERIAL TRANSITION SHEET 2