

210.10 COLD PLANING BITUMINOUS PAVEMENT
STA 40+052.75 - 40+060.00

203.28 EXCAVATION OF SURFACES AND PAVEMENTS
STA 100+082.36 RT - 100+157.58 RT
STA 100+091.40 LT - 100+155.08 RT

616.20 GRANITE SLOPED EDGING
STA 4+780.10 LT - 14+037.50 LT

616.21 VERTICAL GRANITE CURB
STA 4+710.63 LT - 40+015.38 LT (ISLAND)
STA 4+731.70 RT - 4+752.80 RT (ISLAND)
STA 4+752.80 RT - 4+810.90 RT
STA 4+812.40 RT - 4+854.94 RT
STA 4+813.80 LT - 4+861.80 LT
STA 14+037.50 RT - 4+812.30 LT
STA 14+039.00 LT - 14+042.00 LT
STA 14+039.00 RT - 14+044.90 RT
STA 40+023.40 RT - 4+780.10 LT
STA 100+082.37 RT - 100+098.30 RT
STA 100+099.80 RT - 100+103.80 RT

618.10 PORTLAND CEMENT CONCRETE SIDEWALK, 125MM
STA 40+014.54 RT - 14+039.00 LT
STA 14+039.00 RT - 4+813.80 LT
STA 4+810.90 RT - 4+856.61 RT
STA 100+082.37 RT - 100+156.58 RT

CONSTRUCT SIDEWALK RAMP WITH
618.30 DETECTABLE WARNING SURFACE
STA 4+811.65 RT - TYPE 6
STA 4+813.07 LT - TYPE 1
STA 4+854.64 RT - TYPE 1
STA 14+038.25 LT - TYPE 1
STA 14+038.25 RT - TYPE 1
STA 100+082.67 RT - TYPE 1
STA 100+099.05 RT - TYPE 6

WASHINGTON ELECTRIC CO-OP, INC.

900.675 SPECIAL PROVISION (HAND PLACED) BITUMINOUS CONCRETE (LIVES)
STA 4+723.00 RT (12.0M - PAVED)
STA 4+863.00 RT (7.3M - PAVED)
STA 4+871.00 LT (7.3M - PAVED)
STA 40+023.00 LT (12.0M - PAVED)
STA 100+076.00 RT (12.5M - PAVED)



CONSTRUCT MOUNTABLE APRON
STA 4+780.10 LT - 14+037.50 LT (PAVED)

MATCH LINE TO ROW SHEET 37 OF 37

FOR EROSION CONTROL
DETAIL SEE R O W
SHEET 13-19 OF 37

FOR DRAINAGE
DETAIL SEE R O W
SHEET 25-28 OF 37

FOR LANDSCAPE
DETAIL SEE R O W
SHEET 20-24 OF 37

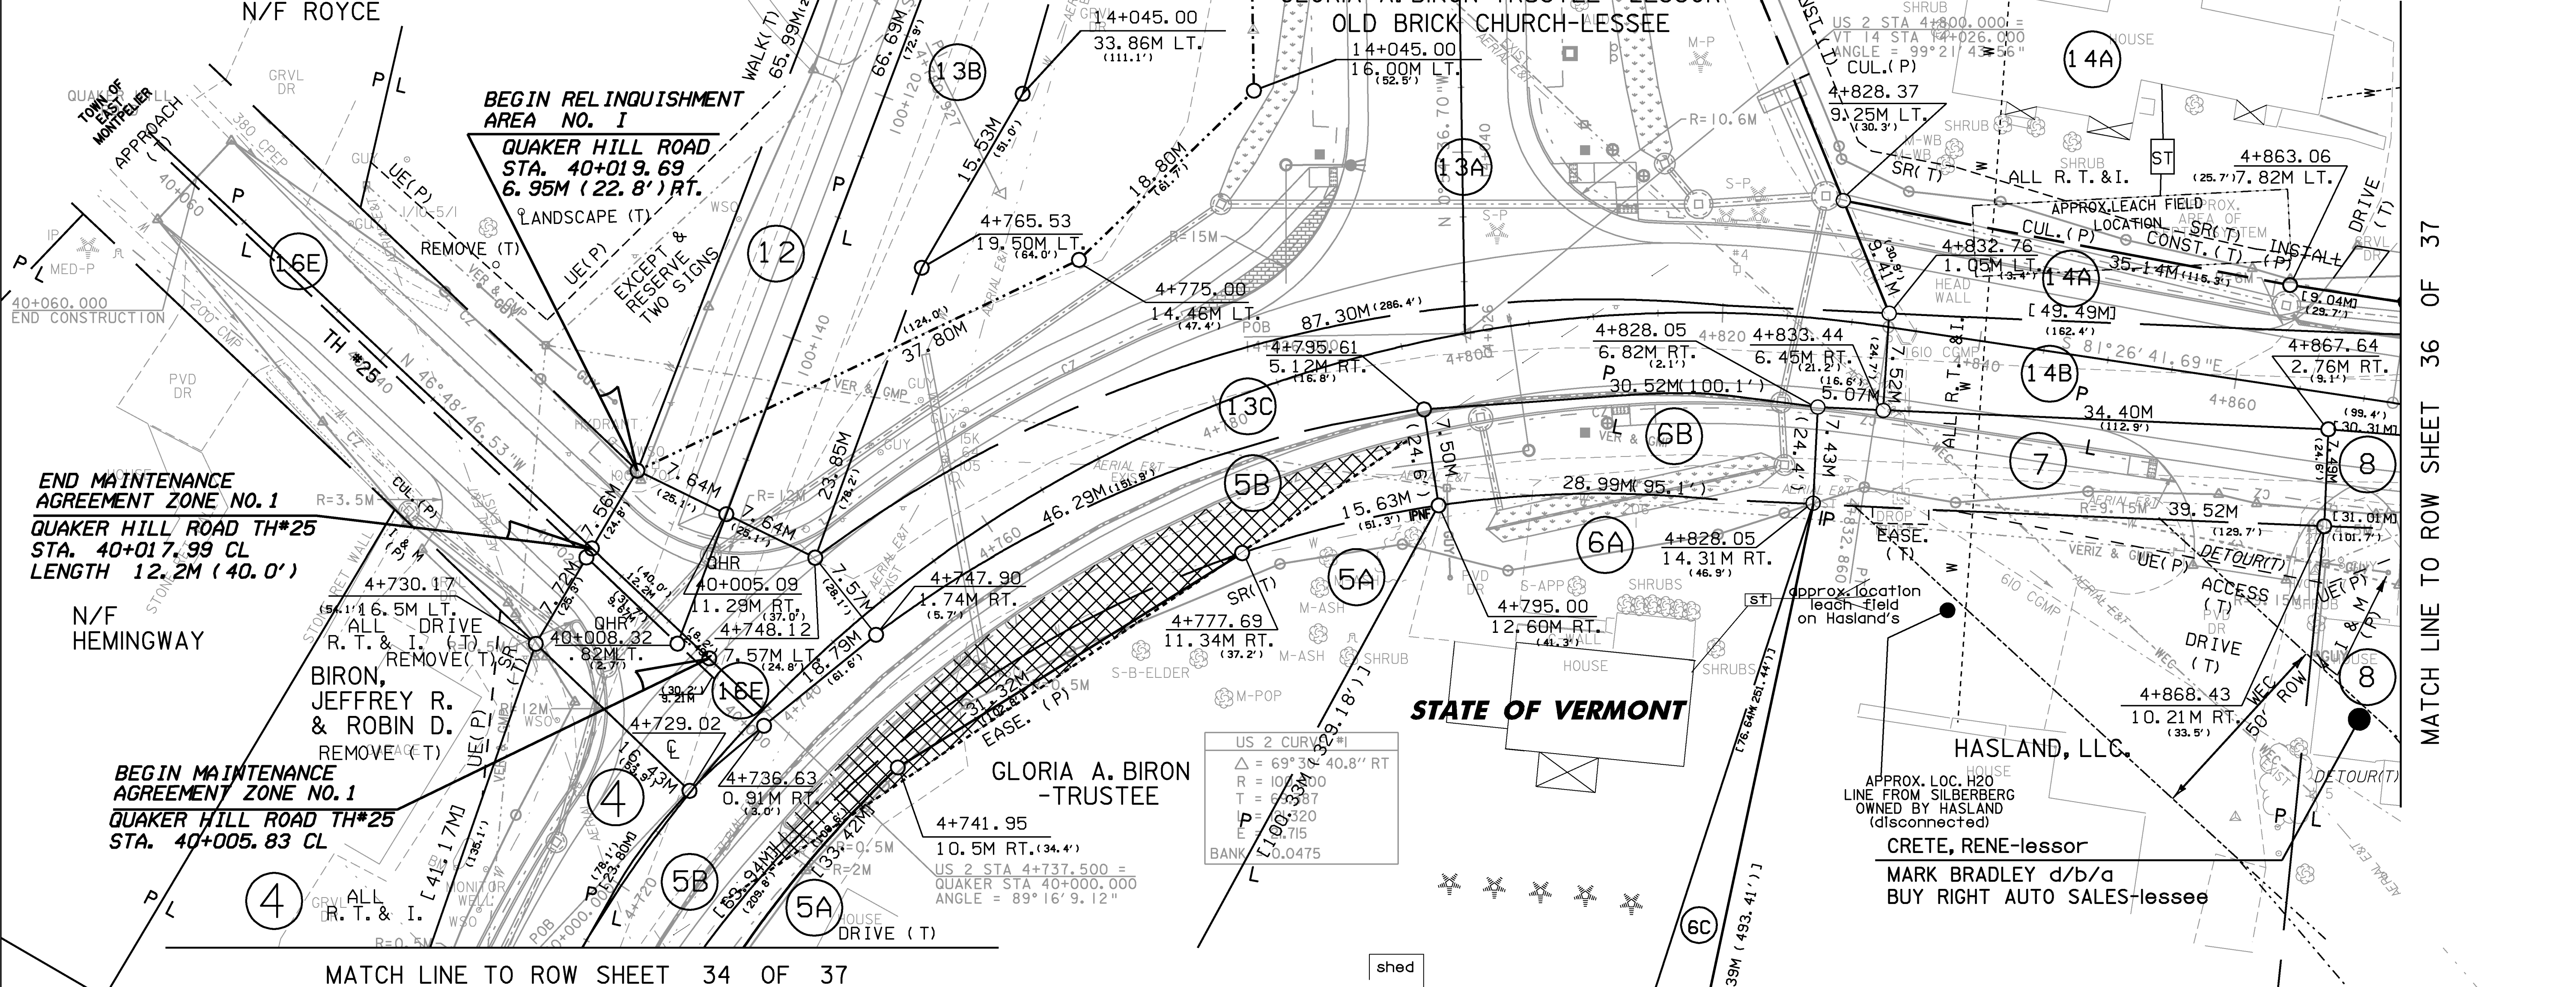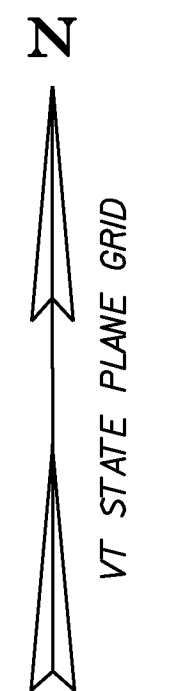

MATCH LINE TO ROW SHEET 34 OF 37

MATCH LINE TO ROW SHEET 36 OF 37



LINE SHOWN ON THIS PLAN AS EXISTING PROPERTY LINES P/L ARE BELIEVED TO BE ACCURATE BUT SHOULD NOT BE RELIED UPON FOR PURPOSES UNRELATED TO THE STATE OF VERMONT'S ACQUISITION OF LAND AND RIGHTS FOR THIS PROJECT.

PROJECT NAME: EAST MONTPELIER
PROJECT NUMBER: STPG 028-3(35)S

FILE NAME: r98b02812.dgn
PROJECT LEADER: J. SCHULTZ
DESIGNED BY: J. GRUCHACZ
R.O.W. LAYOUT SHEET 35 OF 37

PLOT DATE: 22-MAR-2010
DRAWN BY: R.O.W.
CHECKED BY: R.O.W.
SHEET 22 OF 142