
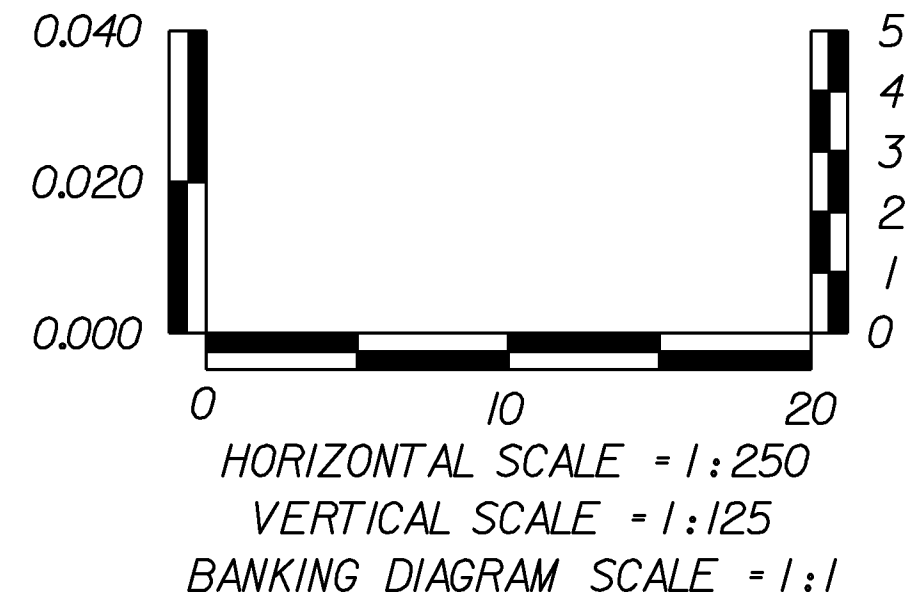


THE ELEVATIONS SHOWN TO THE NEAREST HUNDREDTH ARE THE OLD GROUND ALONG REVISED CENTERLINE. THE ELEVATIONS SHOWN TO THE NEAREST THOUSANDTH ARE THE PROPOSED FINISHED GRADE ALONG REVISED CENTERLINE.

US ROUTE 2 PROFILE

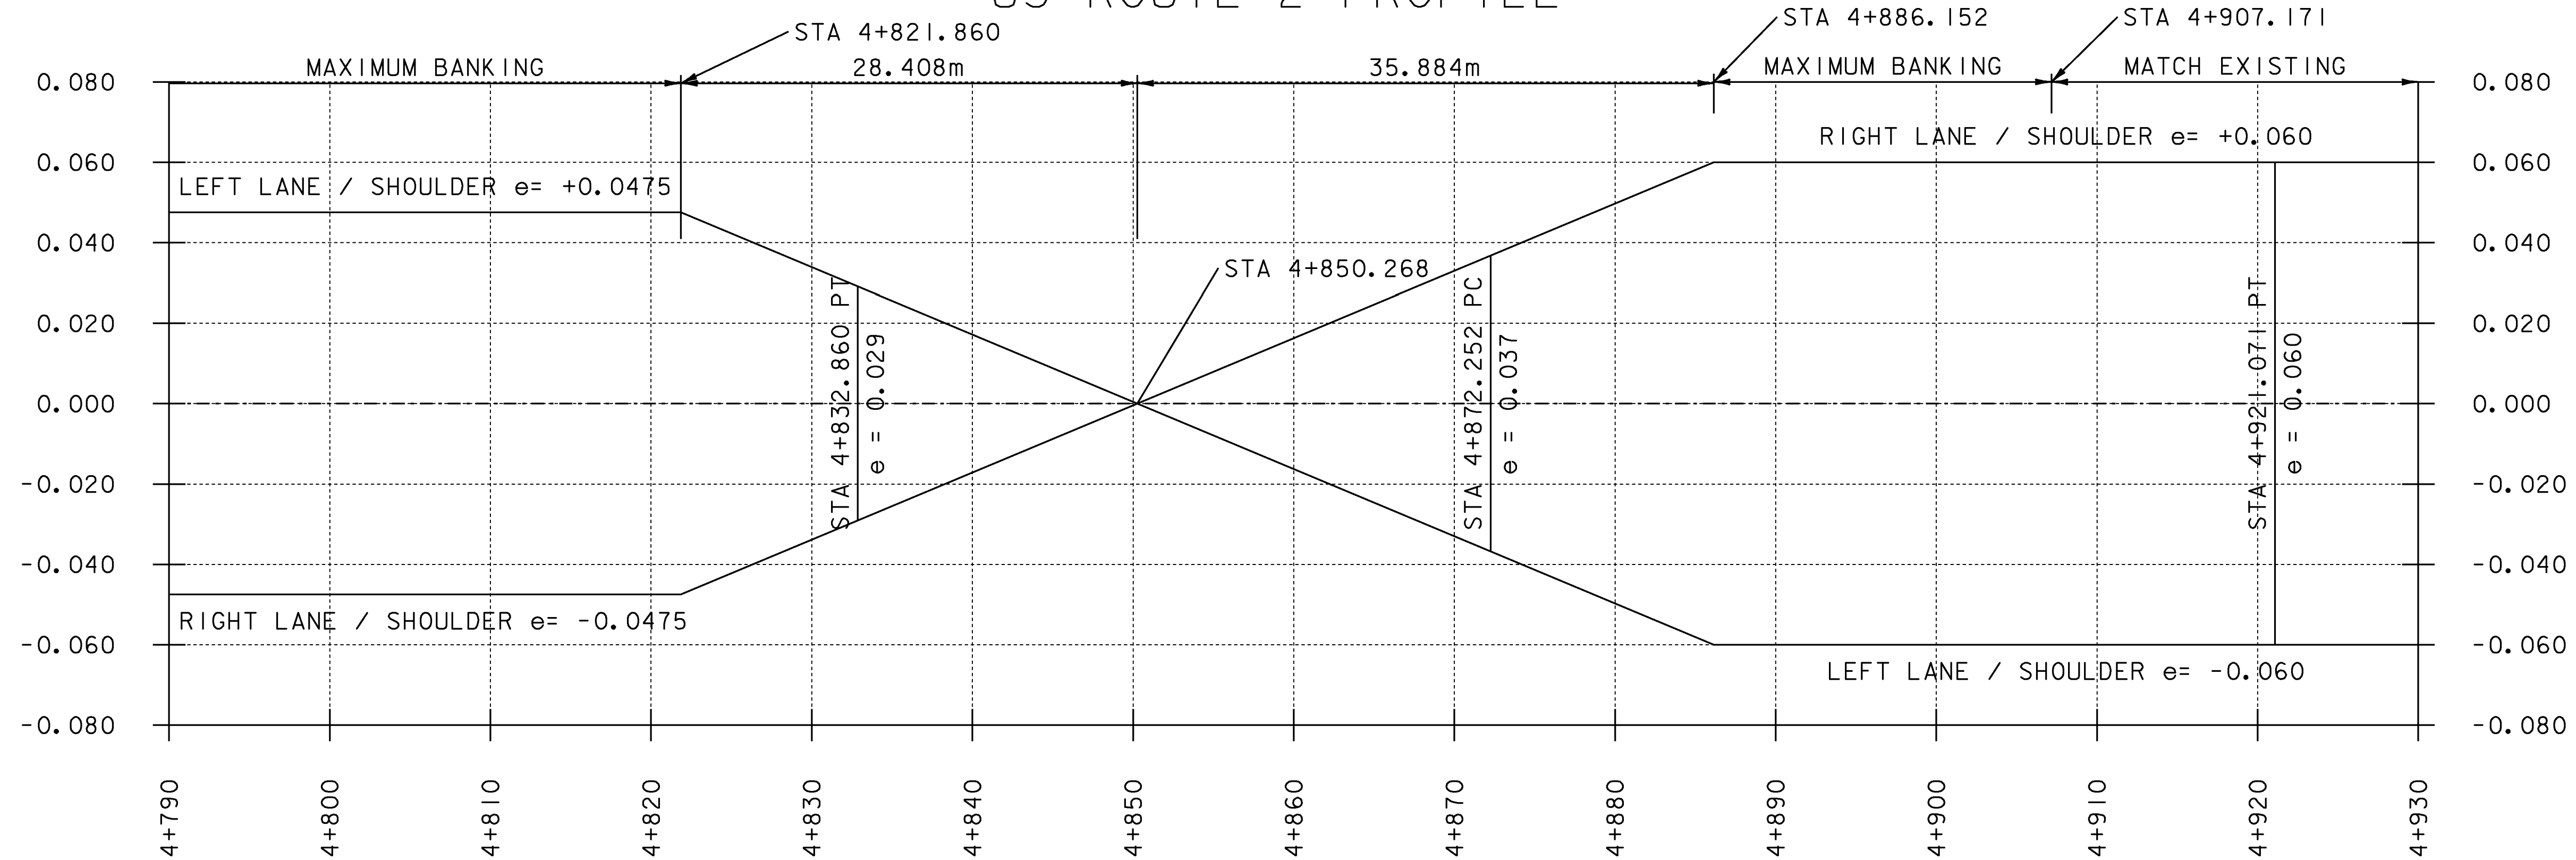

US ROUTE 2 BANKING DIAGRAM

PROJECT NAME:	EAST MONTPELIER
PROJECT NUMBER:	STPG 028 - 3(35)S
FILE NAME:	+98b028profile.dgn
PROJECT LEADER:	J.SCHULTZ
DESIGNED BY:	J. GRUCHACZ
US ROUTE 2 PROFILE SHEET 2	
PLOT DATE:	29-MAR-2010
DRAWN BY:	D. LYMAN
CHECKED BY:	J. DEVLIN
SHEET	33 OF 142