


PARKING LOT PROFILE

THE ELEVATIONS SHOWN TO THE NEAREST HUNDREDTH ARE THE OLD GROUND ALONG REVISED CENTERLINE. THE ELEVATIONS SHOWN TO THE NEAREST THOUSANDTH ARE THE PROPOSED FINISHED GRADE ALONG REVISED CENTERLINE.

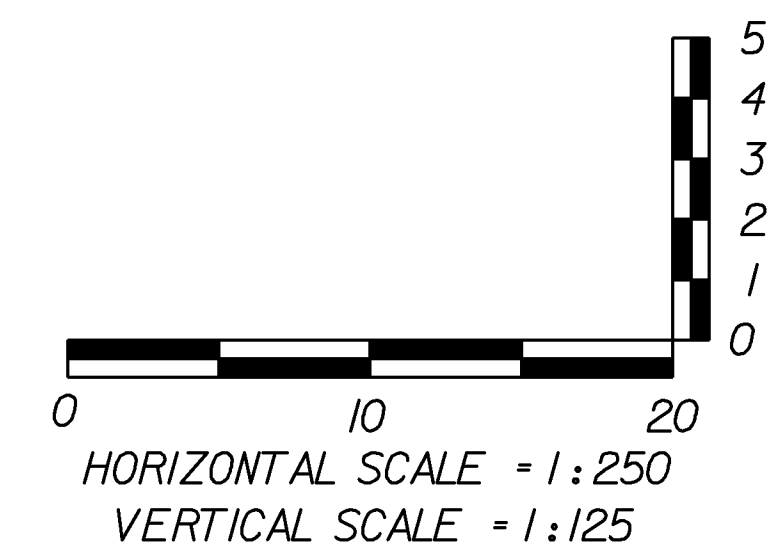

PROJECT NAME: EAST MONTEPELIER
PROJECT NUMBER: STPG 028 - 3(35)S

FILE NAME: +98b028profile.dgn
PROJECT LEADER: J.SCHULTZ
DESIGNED BY: J. GRUCHACZ
PARKING LOT PROFILE SHEET

PLOT DATE: 29-MAR-2010
DRAWN BY: D. LYMAN
CHECKED BY: J. DEVLIN
SHEET 37 OF 142