


LEGEND	
	EXISTING WOODLAND
	PROPOSED DECIDUOUS TREE
	PROPOSED EVERGREEN TREE
	PROPOSED SHRUBS
	CLEAR ZONE
	AER E&T OVERHEAD UTILITY ROUTE
	TPZ TREE PROTECTION ZONE
	EXISTING TREE/SHRUB
	TREE OR STUMP REMOVAL

NOTE: SEE LANDSCAPE AND LIGHTING NOTES SHEET FOR TREE KEY AND WIRED CONDUIT SCHEDULE

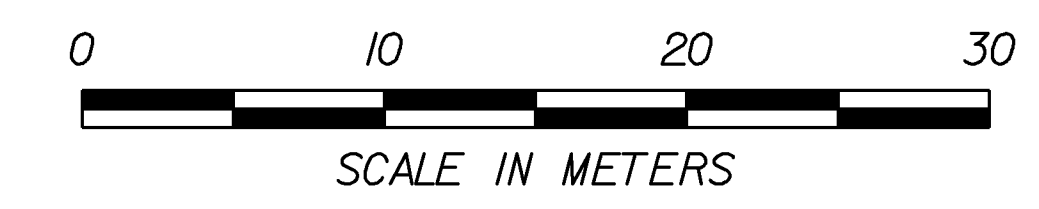

PROJECT NAME:	EAST MONTPELIER
PROJECT NUMBER:	STPG 028 - 3(35)S
FILE NAME:	+98b028landscapebdr.dgn
PROJECT LEADER:	J. SCHULTZ
DESIGNED BY:	J. GRUCHACZ
LANDSCAPE AND LIGHTING LAYOUT SHEET I	
PLOT DATE:	22-MAR-2010
DRAWN BY:	D. LYMAN
CHECKED BY:	J. DEVLIN
LANDSCAPE AND LIGHTING LAYOUT SHEET I	SHEET 64 OF 142