


MAST ARM #3
LOOKING SOUTH ON
VT ROUTE 14



NOTE: FOUNDATION DEPTHS ARE
NOT TO SCALE (TYP).

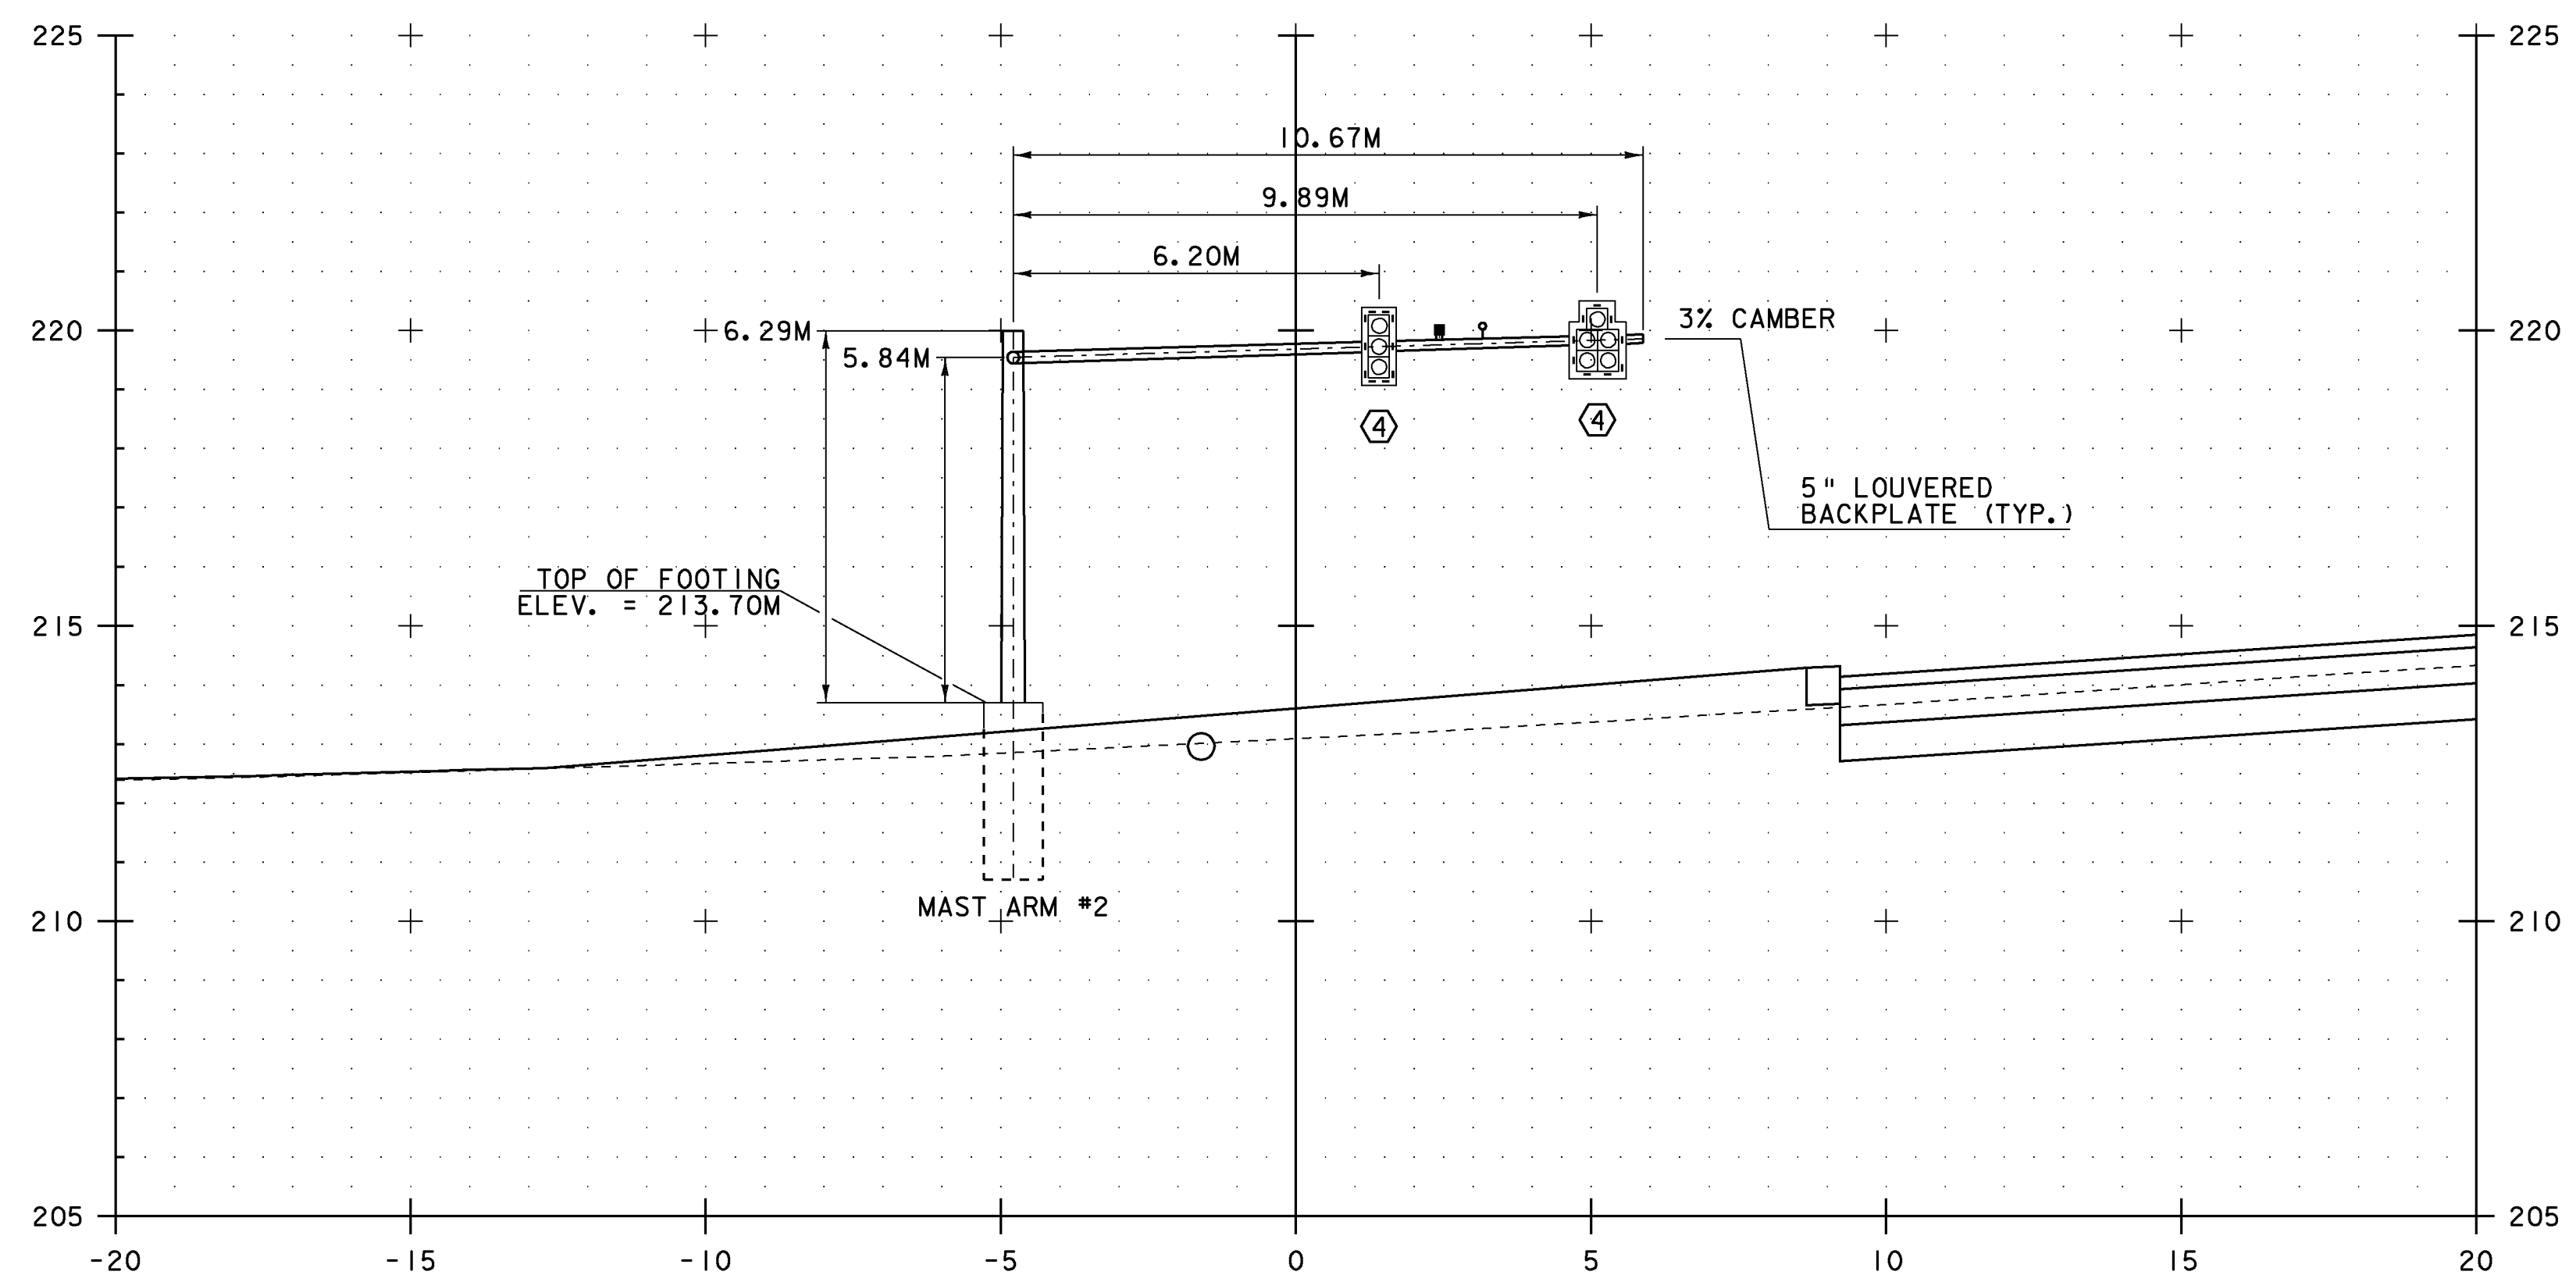

PROJECT NAME:	EAST MONTPELIER	FILE NAME:	+98b028traf.dgn	PLOT DATE:	22-MAR-2010
PROJECT NUMBER:	STPG 028 - 3(35)S	PROJECT LEADER:	J. SCHULTZ	DRAWN BY:	D. LYMAN
		DESIGNED BY:	J. GRUCHACZ	CHECKED BY:	J. DEVLIN
		MAST ARM CROSS SECTION SHEET 2		SHEET	74 OF 142