

646.404 - DURABLE 100MM WHITE LINE, POLYUREA Δ
 STA 100+033.60 LT - 100+033.60 LT (SOLID)
 STA 100+036.80 LT - 100+036.53 LT (SOLID)
 STA 100+039.95 LT - 100+039.91 LT (SOLID)
 STA 100+043.04 LT - 100+043.62 LT (SOLID)
 STA 100+046.25 LT - 100+046.56 LT (SOLID)
 STA 100+049.45 LT - 100+049.48 LT (SOLID)
 STA 100+052.25 LT - 100+052.25 LT (SOLID)
 STA 100+057.75 LT - 100+057.75 LT (SOLID)
 STA 100+060.50 LT - 100+060.50 LT (SOLID)
 STA 100+063.25 LT - 100+063.25 LT (SOLID)
 STA 100+066.00 LT - 100+066.00 LT (SOLID)

646.406 - DURABLE 100MM WHITE LINE, RECESSED POLYUREA
 STA 14+091.71 LT - 100+009.26 LT (SOLID)
 STA 14+092.75 LT - 14+110.00 LT (DOTTED)
 STA 14+093.85 CL - 14+110.00 CL (DOTTED)
 STA 14+110.00 CL - 14+135.00 CL (SOLID)
 STA 14+095.02 RT - 14+255.00 RT (SOLID)
 STA 100+009.25 LT - 30+036.85 LT (SOLID)
 STA 30+036.85 RT - 14+255.00 LT (SOLID)

646.416 - DURABLE 100MM YELLOW LINE, RECESSED POLYUREA
 STA 14+093.23 LT - 14+135.00 LT (SOLID-DOUBLE)
 STA 14+148.23 LT - 14+221.00 LT (SOLID-DOUBLE, 2)
 STA 14+221.00 LT - 14+255.00 CL (SOLID-DOUBLE)
 STA 30+010.00 CL - 30+015.34 CL (SOLID-DOUBLE)
 STA 100+009.00 CL - 100+029.00 CL (SOLID-DOUBLE)

646.456 - DURABLE 200MM YELLOW LINE, RECESSED POLYUREA
 STA 14+150.00 LT - 14+153.66 LT (SOLID, DIAG.)
 STA 14+152.34 LT - 14+155.79 LT (SOLID, DIAG.)
 STA 14+154.47 LT - 14+157.93 LT (SOLID, DIAG.)
 STA 14+156.55 LT - 14+160.06 LT (SOLID, DIAG.)
 STA 14+158.74 LT - 14+162.18 LT (SOLID, DIAG.)
 STA 14+160.92 LT - 14+164.33 LT (SOLID, DIAG.)
 STA 14+163.16 LT - 14+166.46 LT (SOLID, DIAG.)
 STA 14+165.41 LT - 14+168.58 LT (SOLID, DIAG.)
 STA 14+167.65 LT - 14+170.70 LT (SOLID, DIAG.)
 STA 14+169.89 LT - 14+172.81 LT (SOLID, DIAG.)
 STA 14+172.14 LT - 14+174.93 LT (SOLID, DIAG.)
 STA 14+174.38 LT - 14+177.05 LT (SOLID, DIAG.)
 STA 14+176.62 LT - 14+179.16 LT (SOLID, DIAG.)
 STA 14+178.87 LT - 14+181.28 LT (SOLID, DIAG.)
 STA 14+181.11 LT - 14+183.40 LT (SOLID, DIAG.)
 STA 14+183.36 LT - 14+185.52 LT (SOLID, DIAG.)
 STA 14+185.61 LT - 14+187.63 LT (SOLID, DIAG.)
 STA 14+187.85 LT - 14+189.75 LT (SOLID, DIAG.)
 STA 14+190.10 LT - 14+191.87 LT (SOLID, DIAG.)
 STA 14+192.34 LT - 14+193.99 LT (SOLID, DIAG.)
 STA 14+194.59 LT - 14+196.10 LT (SOLID, DIAG.)
 STA 14+196.84 LT - 14+198.22 LT (SOLID, DIAG.)
 STA 14+199.05 LT - 14+200.34 LT (SOLID, DIAG.)
 STA 14+201.30 LT - 14+202.45 LT (SOLID, DIAG.)
 STA 14+203.55 LT - 14+204.57 LT (SOLID, DIAG.)
 STA 14+205.80 LT - 14+206.69 LT (SOLID, DIAG.)
 STA 14+208.05 LT - 14+208.81 LT (SOLID, DIAG.)
 STA 14+210.30 LT - 14+210.93 LT (SOLID, DIAG.)
 STA 14+212.57 LT - 14+213.06 LT (SOLID, DIAG.)

646.481 - DURABLE 600MM STOP BAR, TYPE I TAPE Δ
 STA 30+010.00 LT - 30+010.00 LT
 STA 100+009.00 LT - 100+009.00 LT

646.491 - DURABLE LETTER OR SYMBOL, TYPE I TAPE Δ
 STA 14+108.17 LT (SYMBOL - LEFT ARROW)
 STA 14+120.37 LT (LETTERS - ONLY)
 STA 14+132.56 LT (SYMBOL - LEFT ARROW)
 STA 14+183.90 LT (LETTERS - AHEAD)
 STA 14+196.10 LT (LETTERS - SIGNAL)
 STA 30+012.44 LT (LETTERS - STOP)
 STA 100+011.44 LT (LETTERS - STOP)

646.600 - TEMPORARY 100MM WHITE LINE
 STA 14+091.71 LT - 100+009.26 LT (SOLID)
 STA 14+092.75 LT - 14+110.00 LT (DOTTED)
 STA 14+093.85 CL - 14+110.00 CL (DOTTED)
 STA 14+110.00 CL - 14+135.00 CL (SOLID)
 STA 14+095.02 RT - 14+255.00 RT (SOLID)
 STA 100+009.25 LT - 30+036.85 LT (SOLID)
 STA 30+036.85 RT - 14+255.00 LT (SOLID)

646.610 - TEMPORARY 100MM YELLOW LINE
 STA 14+093.23 LT - 14+135.00 LT (SOLID-DOUBLE)
 STA 14+148.23 LT - 14+221.00 LT (SOLID-DOUBLE, 2)
 STA 14+221.00 LT - 14+255.00 CL (SOLID-DOUBLE)
 STA 30+010.00 CL - 30+015.34 CL (SOLID-DOUBLE)
 STA 100+009.00 CL - 100+029.00 CL (SOLID-DOUBLE)


646.680 - TEMPORARY 600MM STOP BAR
 STA 30+010.00 LT - 30+010.00 LT
 STA 100+009.00 LT - 100+009.00 LT

646.690 - TEMPORARY LETTER OR SYMBOL
 STA 14+108.17 LT (SYMBOL - LEFT ARROW)
 STA 14+120.37 LT (LETTERS - ONLY)
 STA 14+132.56 LT (SYMBOL - LEFT ARROW)
 STA 14+183.90 LT (LETTERS - AHEAD)
 STA 14+196.10 LT (LETTERS - SIGNAL)
 STA 30+012.44 LT (LETTERS - STOP)
 STA 100+011.44 LT (LETTERS - STOP)

TYPE I TAPE SHALL BE
 Δ ATM 400 EXTENDED GRADE TAPE OR
 DIRECTOR 60-HP OR STAMARK HIGH
 PERFORMANCE TAPE SERIES 3801

Δ REVISED ITEM

SSWL = SINGLE SOLID WHITE LINE
 DSYL = DOUBLE SOLID YELLOW LINE

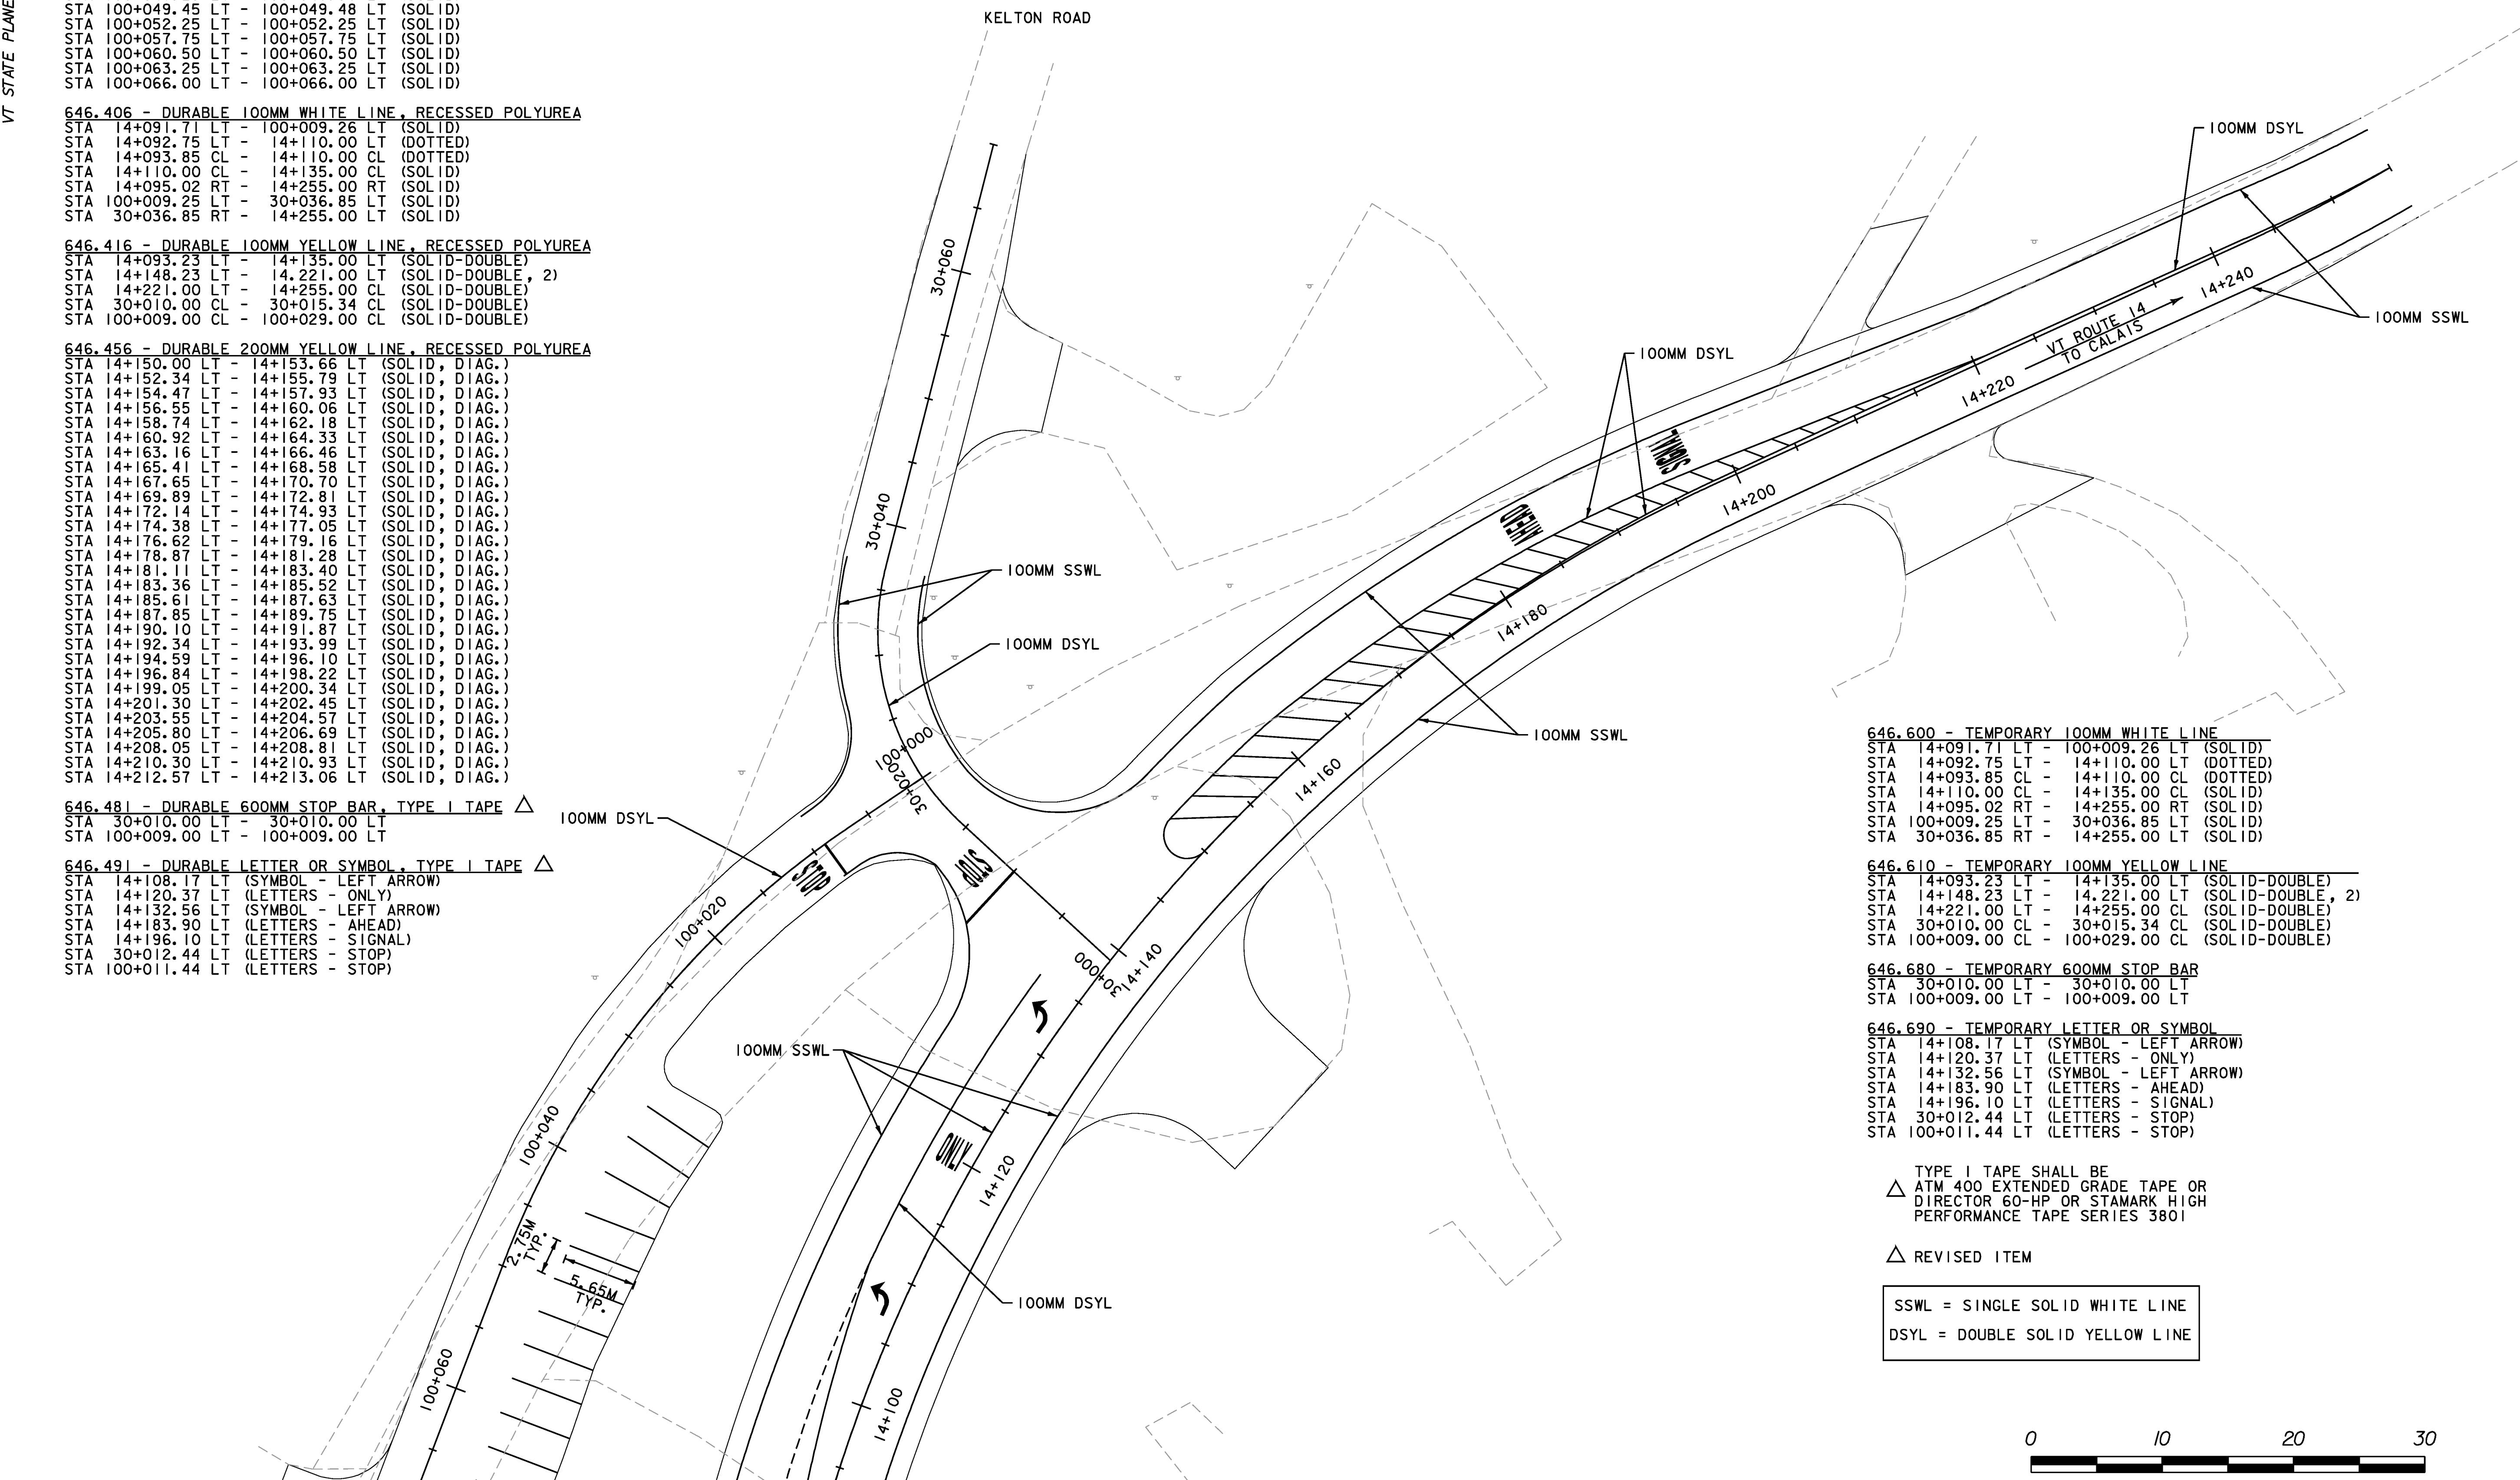

MATCH LINE STA 100+67.63 MATCH LINE STA 14+093.85



PROJECT NAME:	EAST MONTPELIER
PROJECT NUMBER:	STPG 028-3(35)S
FILE NAME:	+98b028+spmbdr.dgn
PROJECT LEADER:	J. SCHULTZ
DESIGNED BY:	J. GRUCHACZ
PAVEMENT MARKING LAYOUT SHEET 4	
PLOT DATE:	11-MAY-2010
DRAWN BY:	D. LYMAN
CHECKED BY:	J. DEVLIN
SHEET	78 OF 142