


MATCH LINE STA 4+714.33

675.50 - REMOVING SIGNS  
AS SHOWN - II



SIGN LEGEND	
R	= REMOVE
S	= SALVAGE
N	= NEW
RET	= RETAIN
EX	= BACK TO BACK
EXISTING	= - - - - -
NEW	= _____

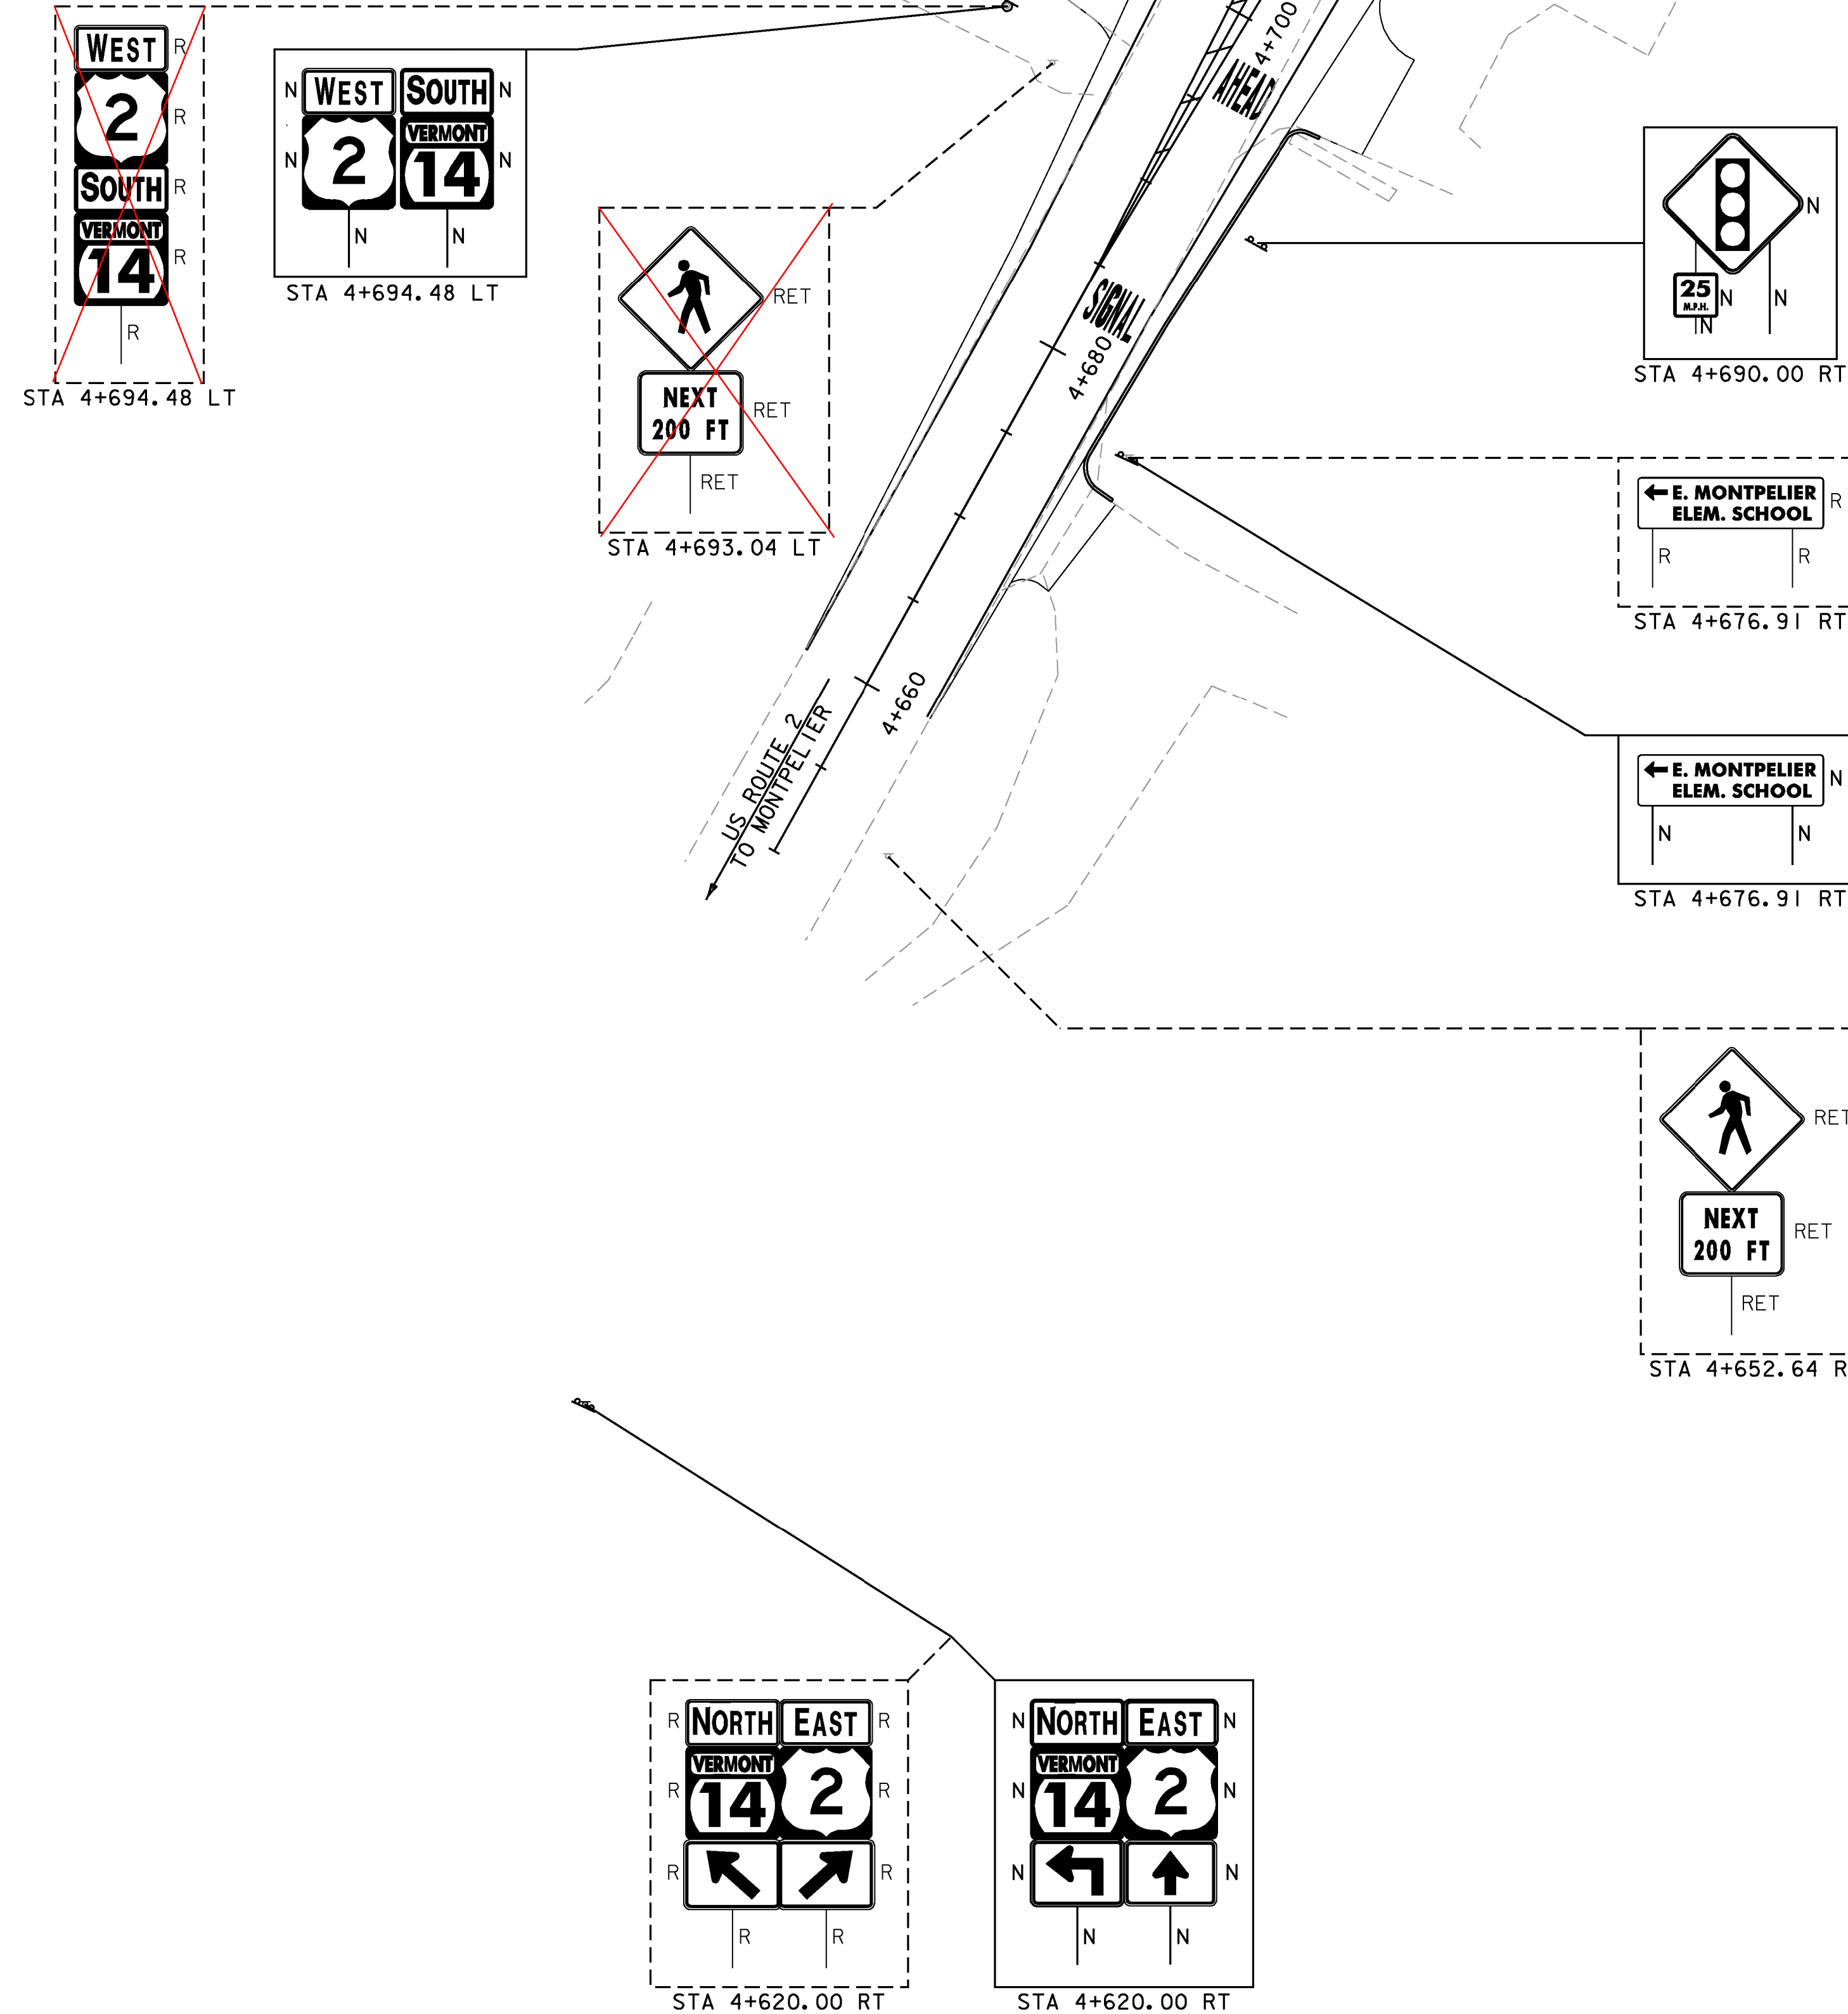

PROJECT NAME: EAST MONTPELIER  
PROJECT NUMBER: STPG 028-3(35)S

FILE NAME: +98b028+spmbdr.dgn  
PROJECT LEADER: J. SCHULTZ  
DESIGNED BY: J. GRUCHACZ  
TRAFFIC SIGNS LAYOUT SHEET I

PLOT DATE: 22-MAR-2010  
DRAWN BY: D. LYMAN  
CHECKED BY: J. DEVLIN  
SHEET 79 OF 142