


STA 100+081.42 LT. MATCH LINE STA 100+67.63 MATCH LINE STA 14+093.85

- 675.50 - REMOVING SIGNS AS SHOWN - 35
- 675.60 - ERECTING SALVAGED SIGNS AS SHOWN - 5
- 675.61 - SETTING SALVAGED POSTS AS SHOWN - 4

NO LONGER A VALID FIRE STATION (MOVED TO US 2 EAST)

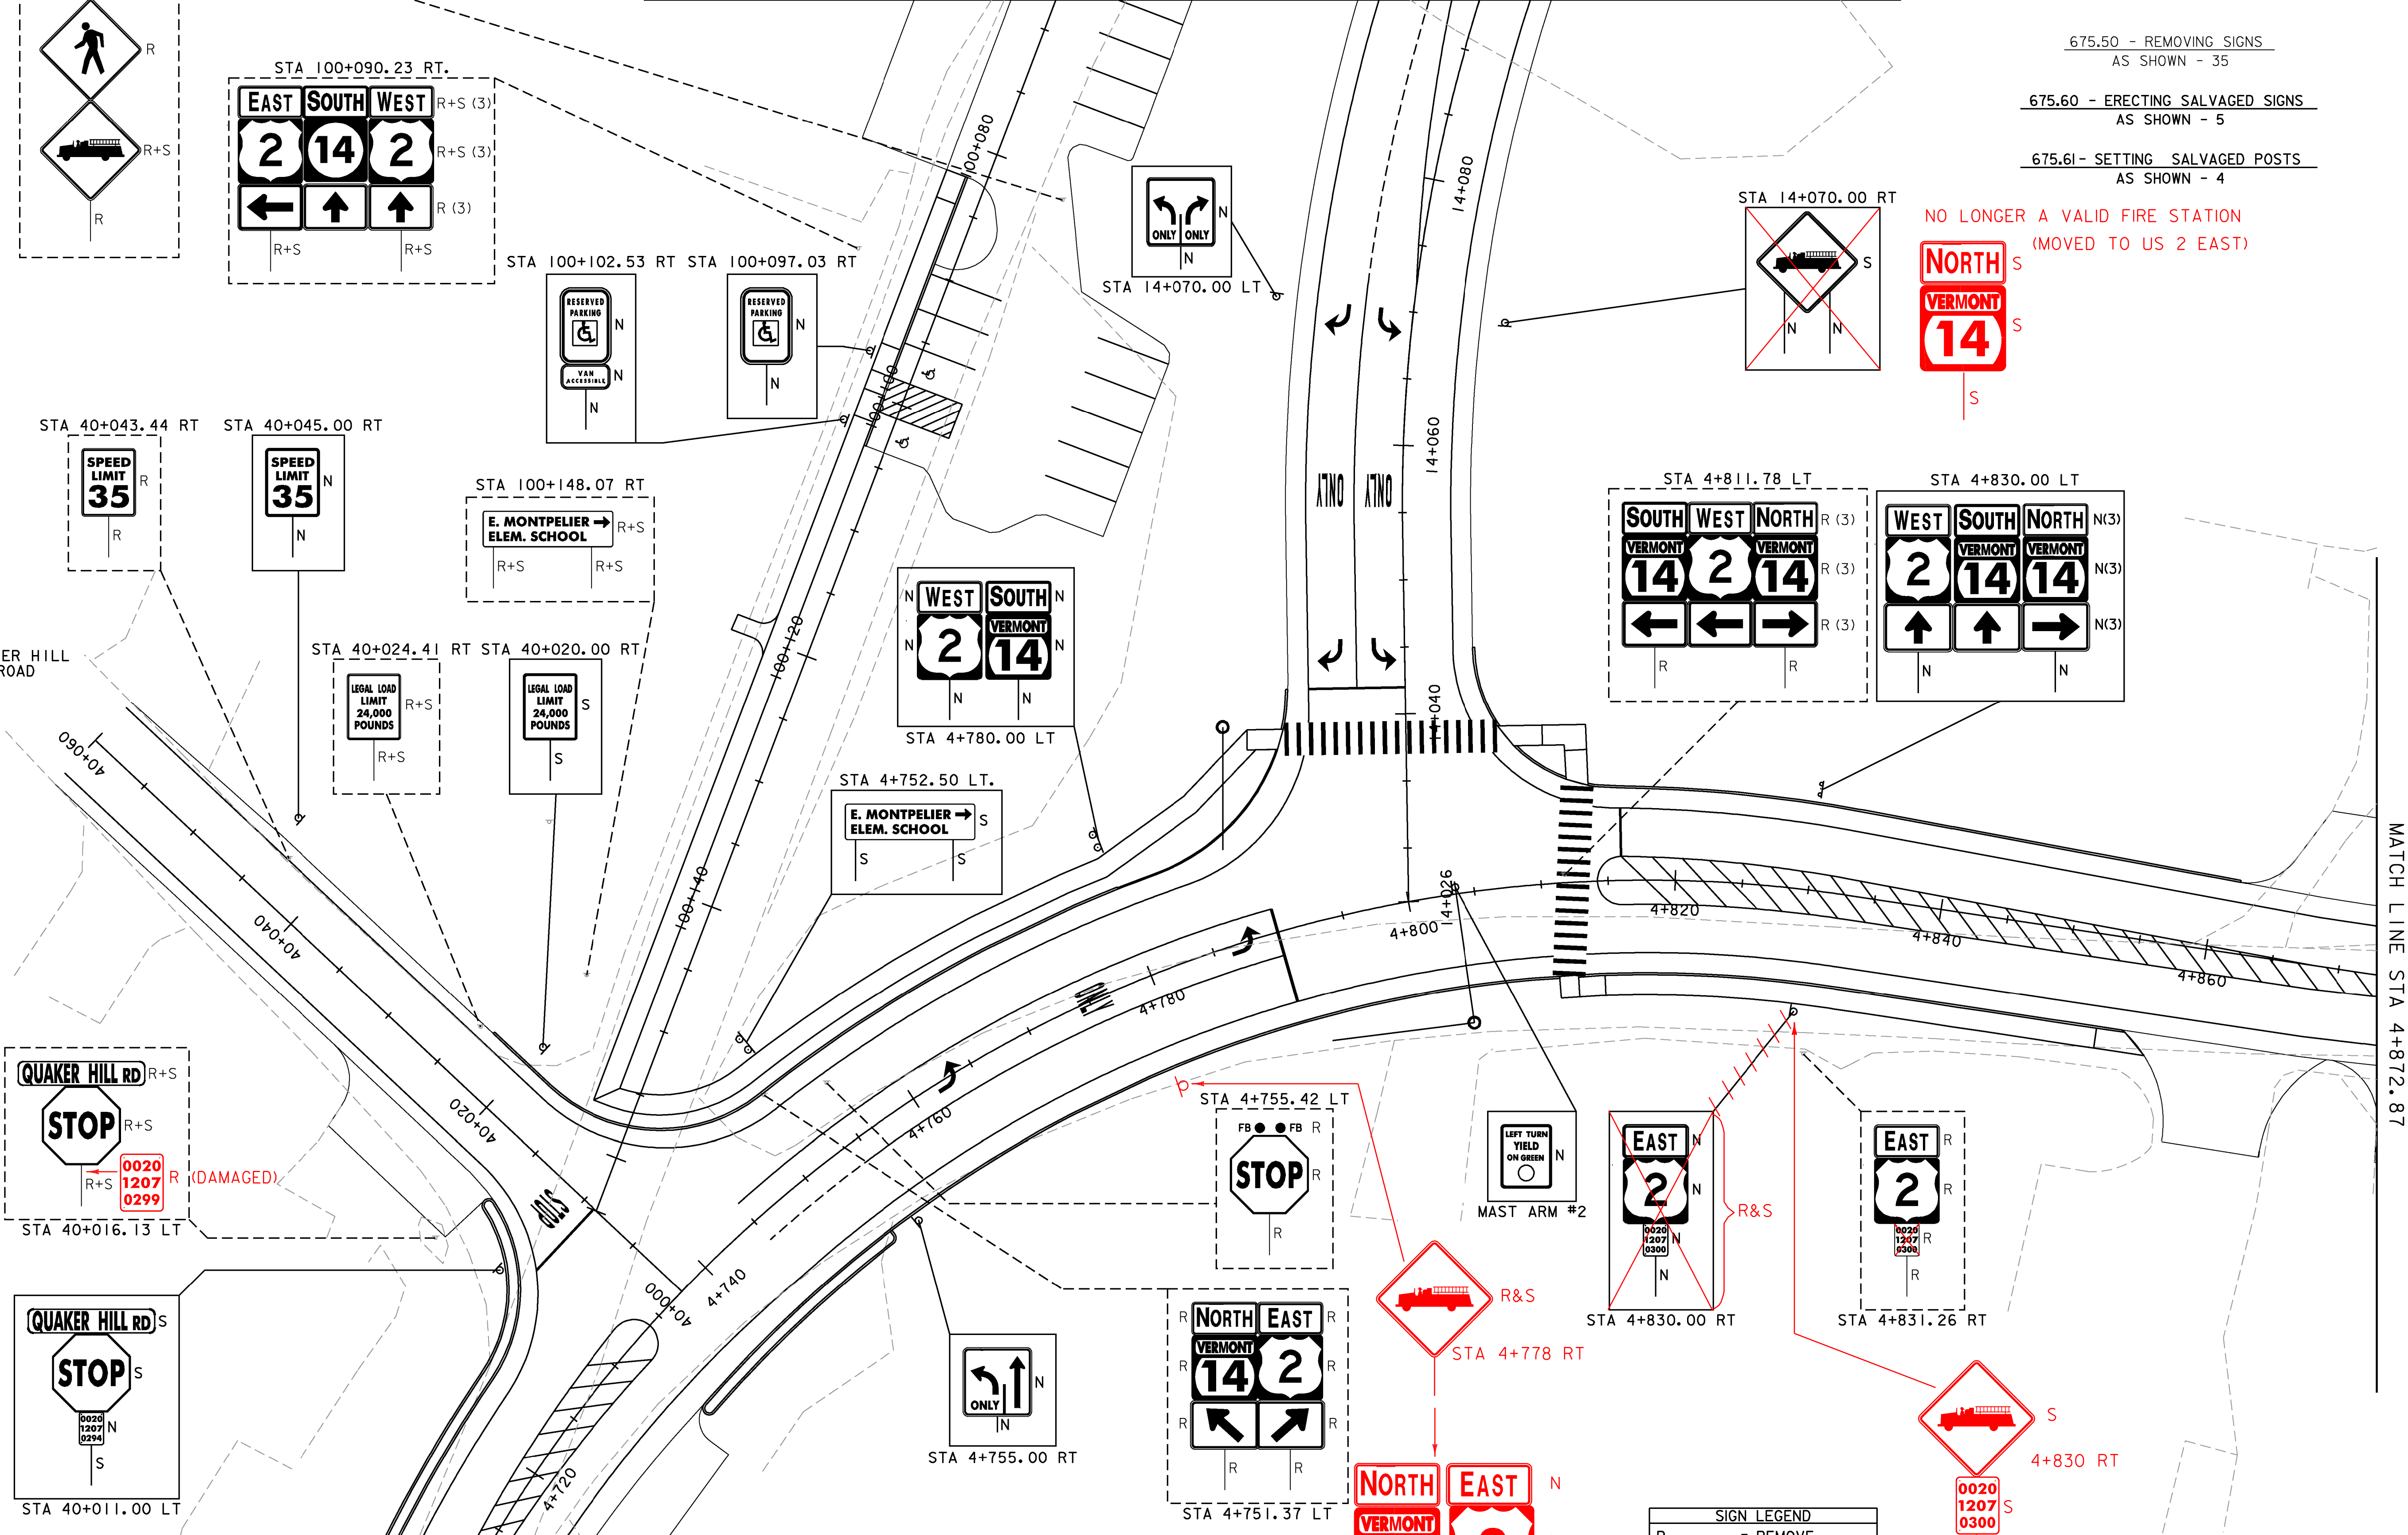


SIGN LEGEND	
R	= REMOVE
S	= SALVAGE
N	= NEW
RET	= RETAIN
B-B	= BACK TO BACK
EXISTING	= EXISTING
NEW	= NEW



PROJECT NAME: EAST MONTPELIER
 PROJECT NUMBER: STPG 028-3(35)S
 FILE NAME: +98b028+spmbdr.dgn
 PROJECT LEADER: J. SCHULTZ
 DESIGNED BY: J. GRUCHACZ
 TRAFFIC SIGNS LAYOUT SHEET 2

PLOT DATE: 22-MAR-2010
 DRAWN BY: D. LYMAN
 CHECKED BY: J. DEVLIN
 SHEET 80 OF 142

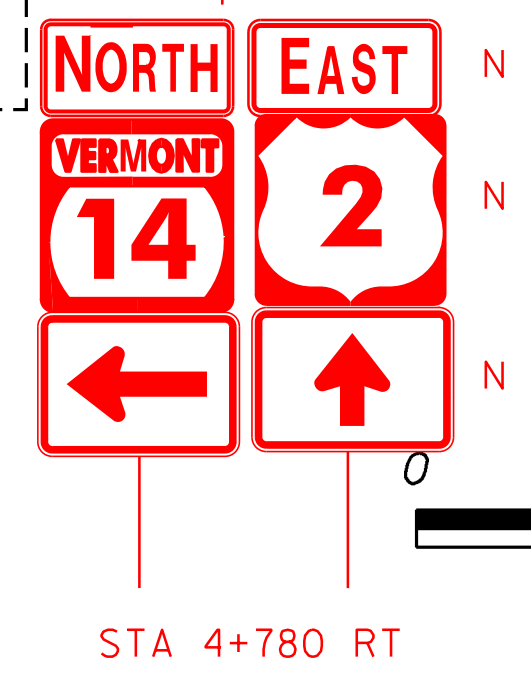

STA 4+780 RT