


675.50 - REMOVING SIGNS
AS SHOWN - 10



SIGN LEGEND	
R	= REMOVE
S	= SALVAGE
N	= NEW
RET	= RETAIN
B-B	= BACK TO BACK
EXISTING	=
NEW	=

MATCH LINE STA 4+872.87

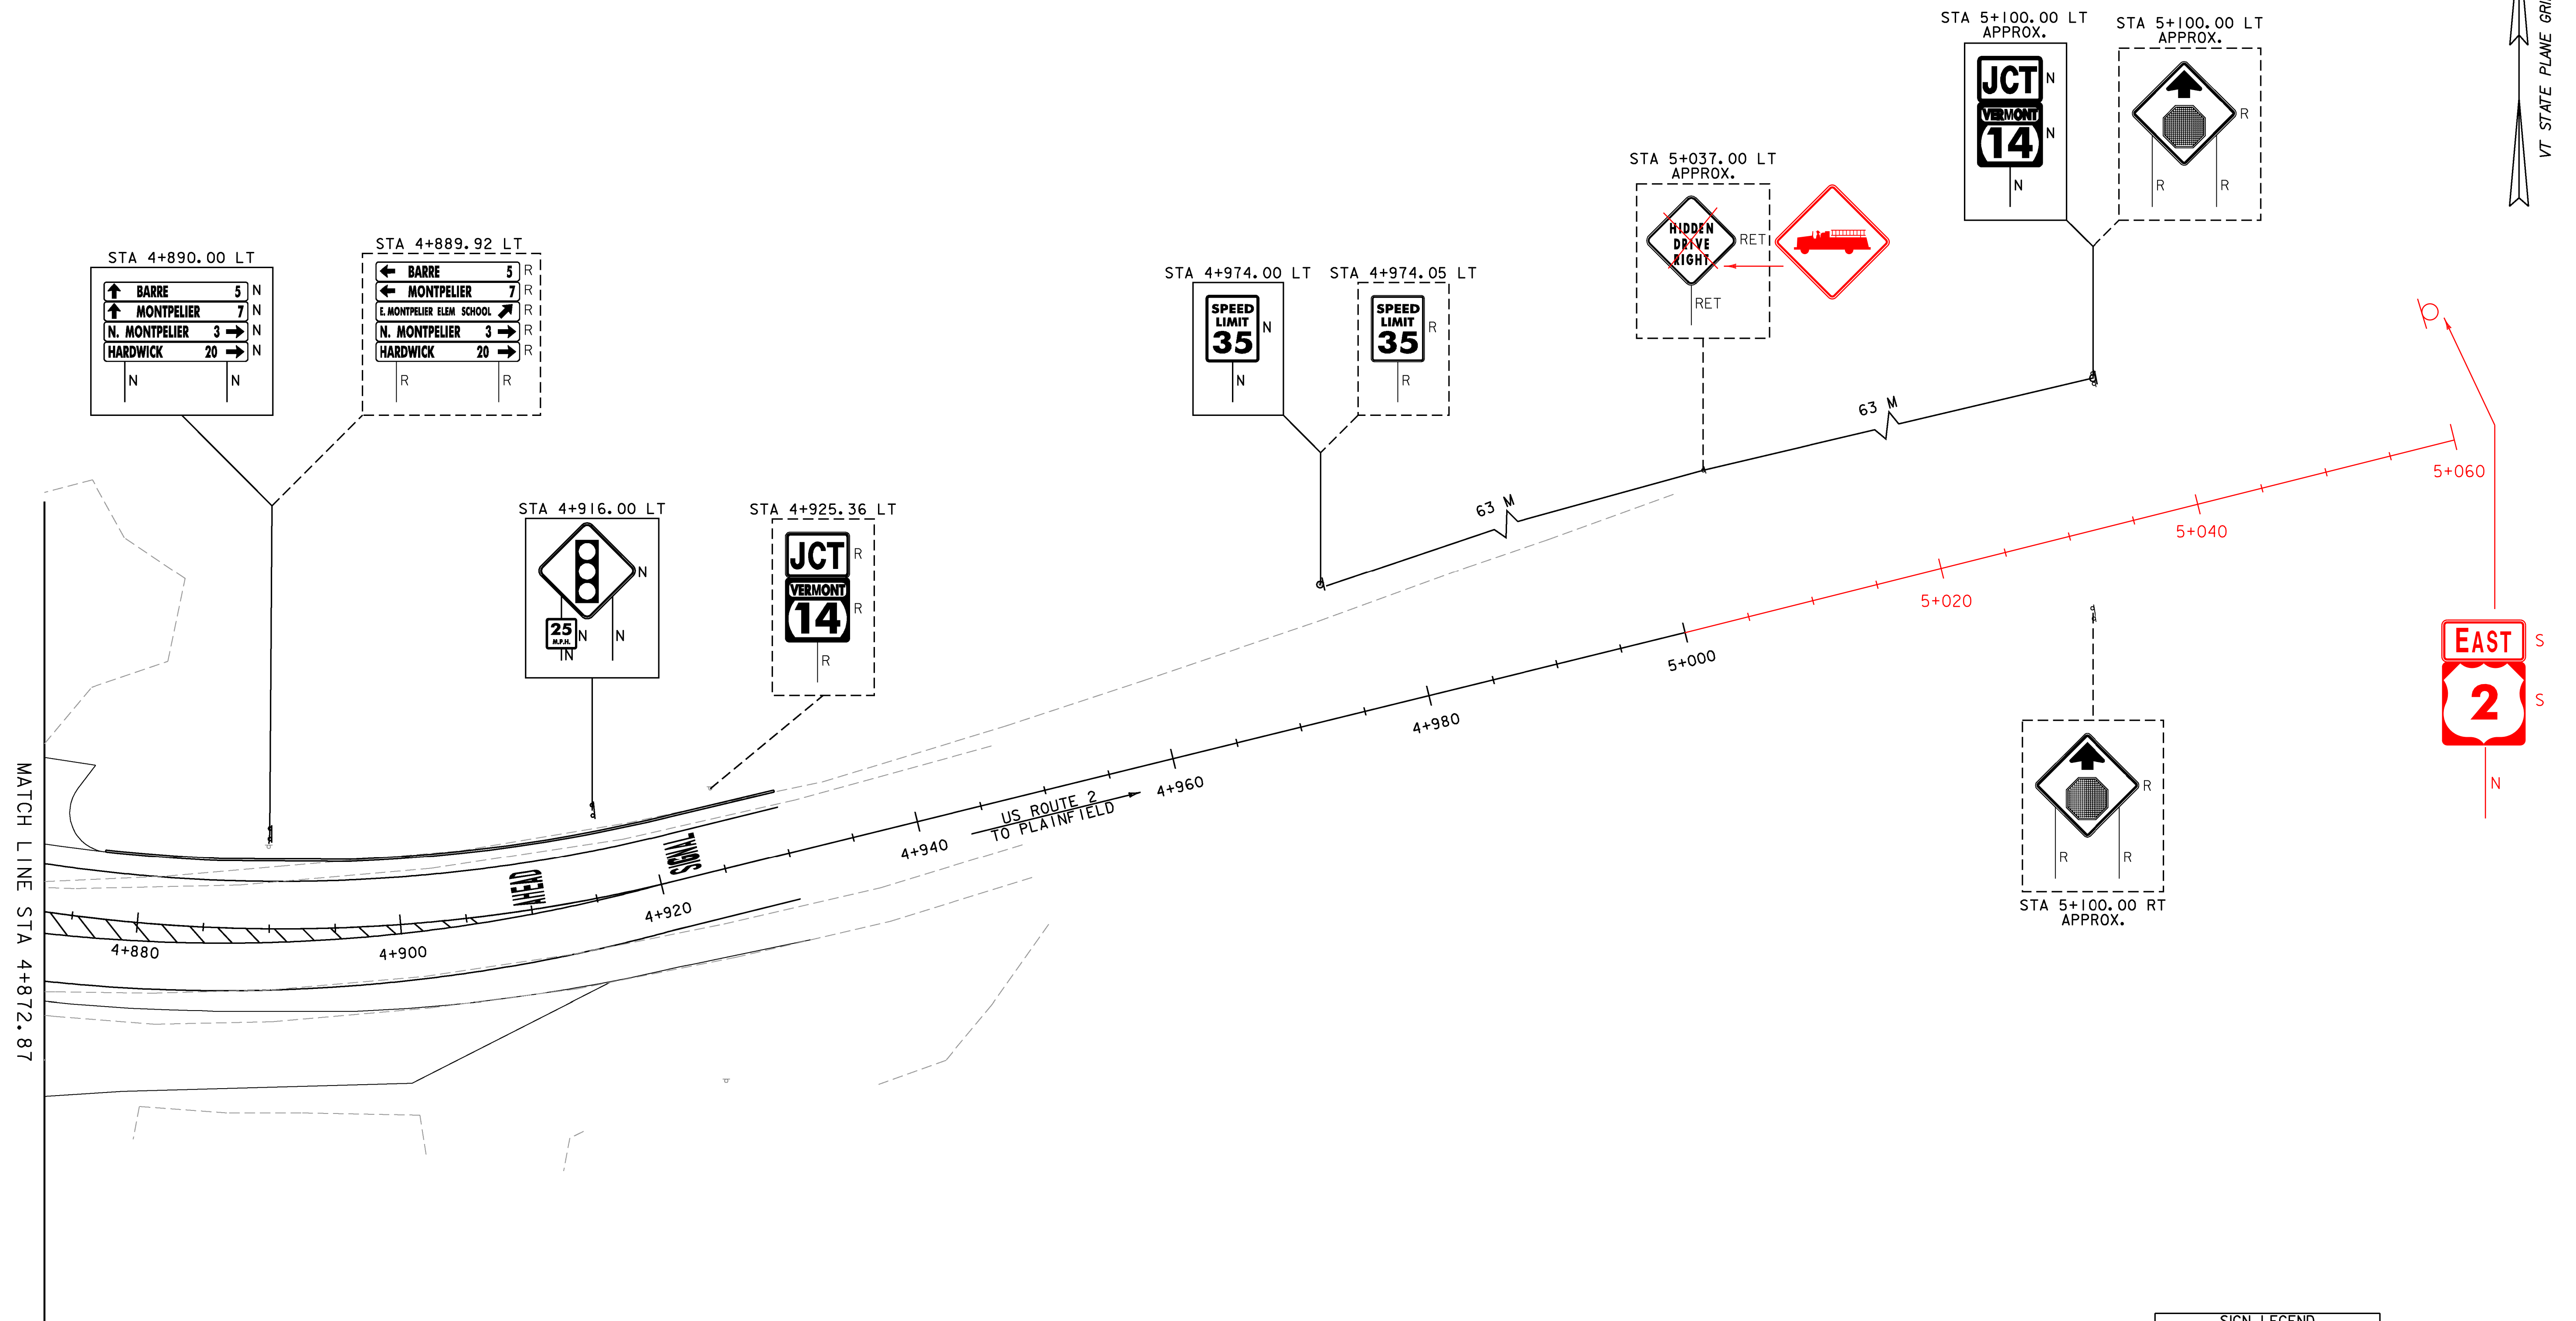

PROJECT NAME:	EAST MONTPELIER	FILE NAME:	+98b028+spmbdr.dgn	PLOT DATE:	22-MAR-2010
PROJECT NUMBER:	STPG 028-3(35)S	PROJECT LEADER:	J. SCHULTZ	DRAWN BY:	D. LYMAN
		DESIGNED BY:	J. GRUCHACZ	CHECKED BY:	J. DEVLIN
		TRAFFIC SIGNS LAYOUT SHEET 3		SHEET	81 OF 142