


INDEX OF SHEETS
SEE SHEET 2

STATE OF VERMONT AGENCY OF TRANSPORTATION

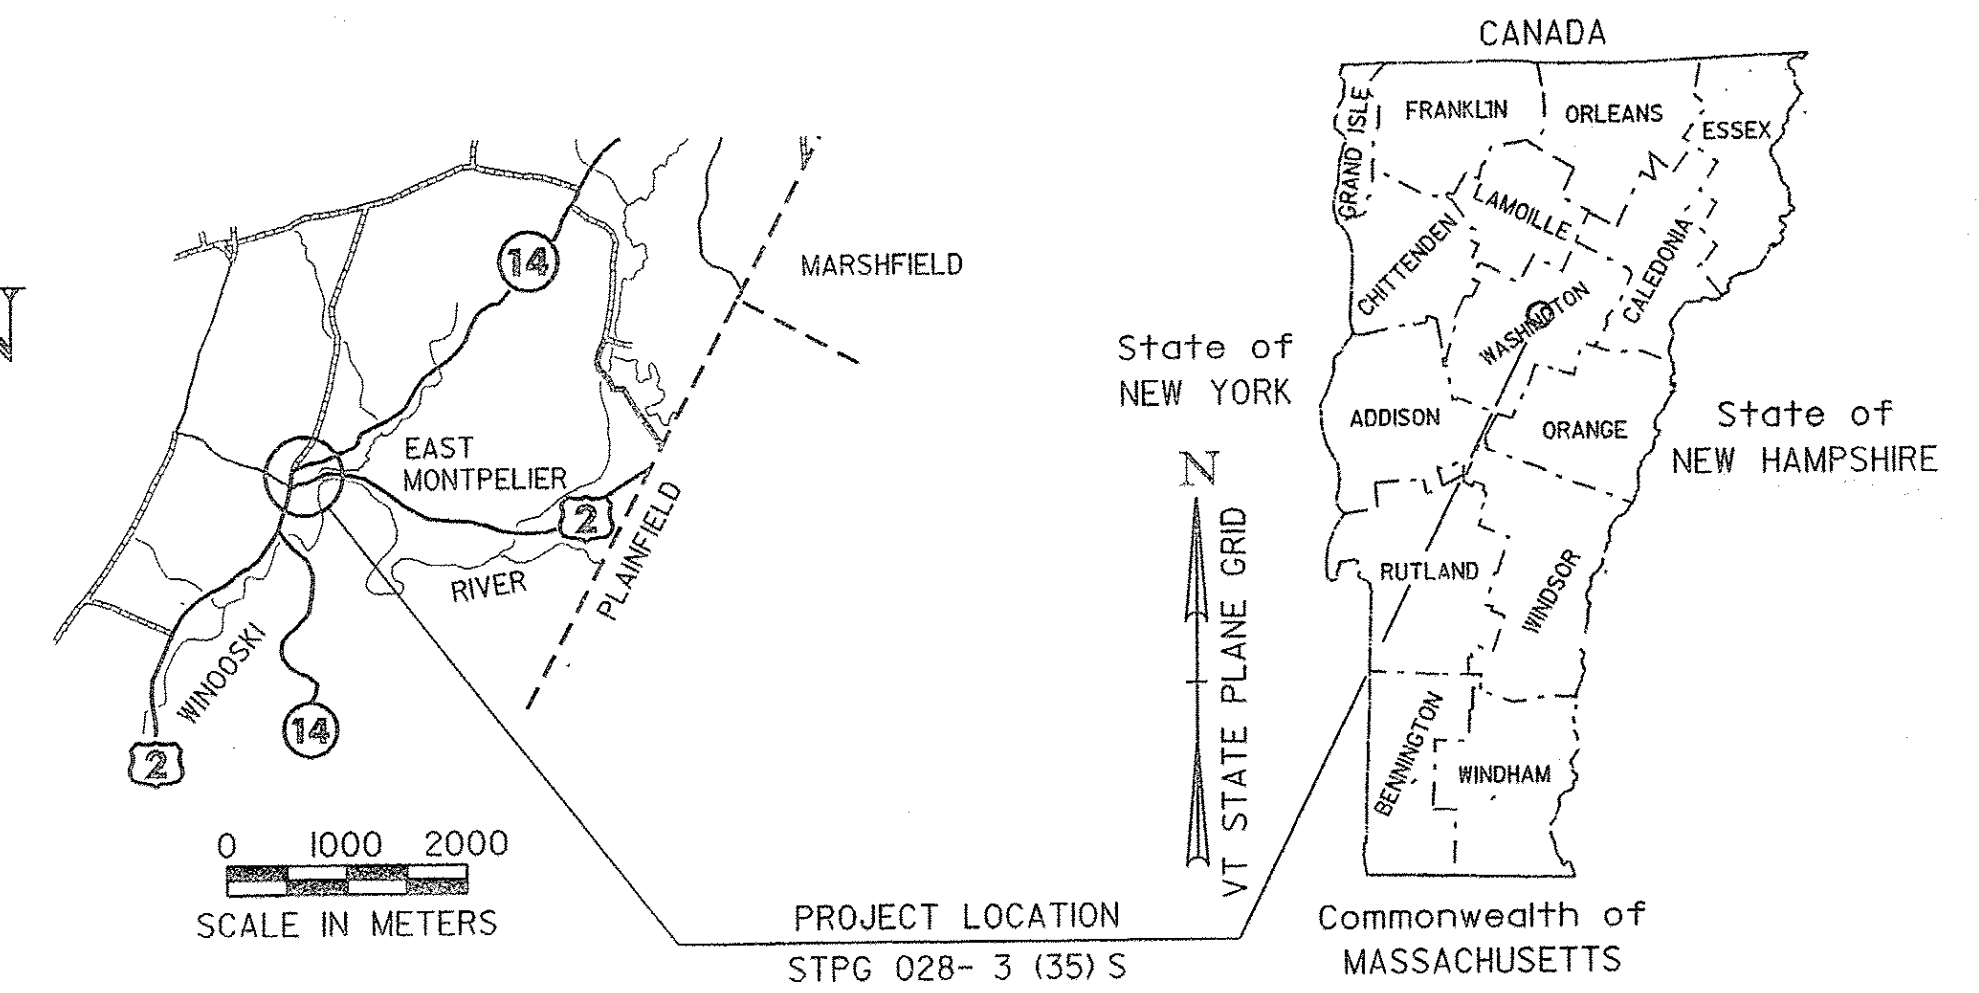

RECORD PLANS

CONTRACTOR: J. HUTCHINS, INC. - RICHMOND, VT

RESIDENT ENGINEER: PETE HODGSON

CONSTRUCTION BEGAN: AUGUST 10, 2010

CONSTRUCTION COMPLETE: JULY 3, 2011

RECORD PLANS BY: PETE HODGSON & JENNA HYDE

I HEREBY CERTIFY THAT ALL THE CONSTRUCTION REQUIRED BY THIS SET OF DRAWINGS HAS BEEN ACCOMPLISHED AS INDICATED HEREIN.

BY: *Pete Hodgson* RESIDENT ENGINEER

DATE: *12/23/10*

NOTE: Any further information concerning final quantities, amounts or other details relative to this project may be found at Central Files in the electronic archives.

PROPOSED IMPROVEMENT TOWN OF EAST MONTPELIER COUNTY OF WASHINGTON US ROUTE 2 - PRINCIPLE ARTERIAL & VT ROUTE 14 - MINOR ARTERIAL

BEGINNING AT A POINT ON US ROUTE 2, APPROXIMATELY 4.720 KILOMETERS EAST OF THE BARRE/EAST MONTPELIER TOWN LINE AND EXTENDING EASTERLY 0.180 KILOMETERS. WORK SHALL ALSO INCLUDE THE RELOCATION OF VT ROUTE 14, BEGINNING AT STATION 4+800.00 ON US ROUTE 2 AND EXTENDING NORTHERLY 0.184 KILOMETERS.

LENGTH OF ROADWAY, US ROUTE 2 = 0.180 KILOMETERS
 LENGTH OF ROADWAY, VT ROUTE 14 = 0.184 KILOMETERS
 LENGTH OF ROADWAY, QUAKER HILL ROAD = 0.060 KILOMETERS
 LENGTH OF ROADWAY, KELTON ROAD = 0.070 KILOMETERS
 TOTAL LENGTH OF ROADWAY = 0.494 KILOMETERS
 TOTAL LENGTH OF PROJECT = 0.364 KILOMETERS


TRAFFIC DATA

LOCATION	ADT		DHV	ADTT	%T	%D	ESALS	ESALS	V
	2010	2030	2030	2030	2030	2030	(2010-2030)	(2010-2050)	
US ROUTE 2 EAST	6,800	8,300	930	830	7.5	62	3,508,000	8,177,000	60 KPH
US ROUTE 2 WEST	11,000	13,400	1,500	1,500	11.3	69	7,693,000	19,354,000	60 KPH
VT ROUTE 14	4,500	5,500	610	640	4.1	71	3,151,000	8,193,000	60 KPH

**BITUMINOUS CONCRETE PAVEMENT
SUPERPAVE MIXTURE DESIGN CRITERIA**

DESIGN LANE / DESIGN LIFE ESAL	7,693,000
DESIGN NUMBER OF GYRATIONS	65
PERFORMANCE GRADE ASPHALT BINDER	SEE SECTION 490 GENERAL SPECIAL PROVISIONS

WORK TO BE PERFORMED UNDER THIS PROJECT INCLUDES THE REALIGNMENT AND RECONSTRUCTION OF THE US ROUTE 2 AND VT ROUTE 14 INTERSECTION. ADDITIONAL WORK SHALL INCLUDE NEW DRAINAGE, SUBBASE, PAVEMENT, TRAFFIC CONTROL SIGNAL SYSTEM, PARKING AREA, PAVEMENT MARKINGS, AND MISCELLANEOUS ROADWAY ITEMS.

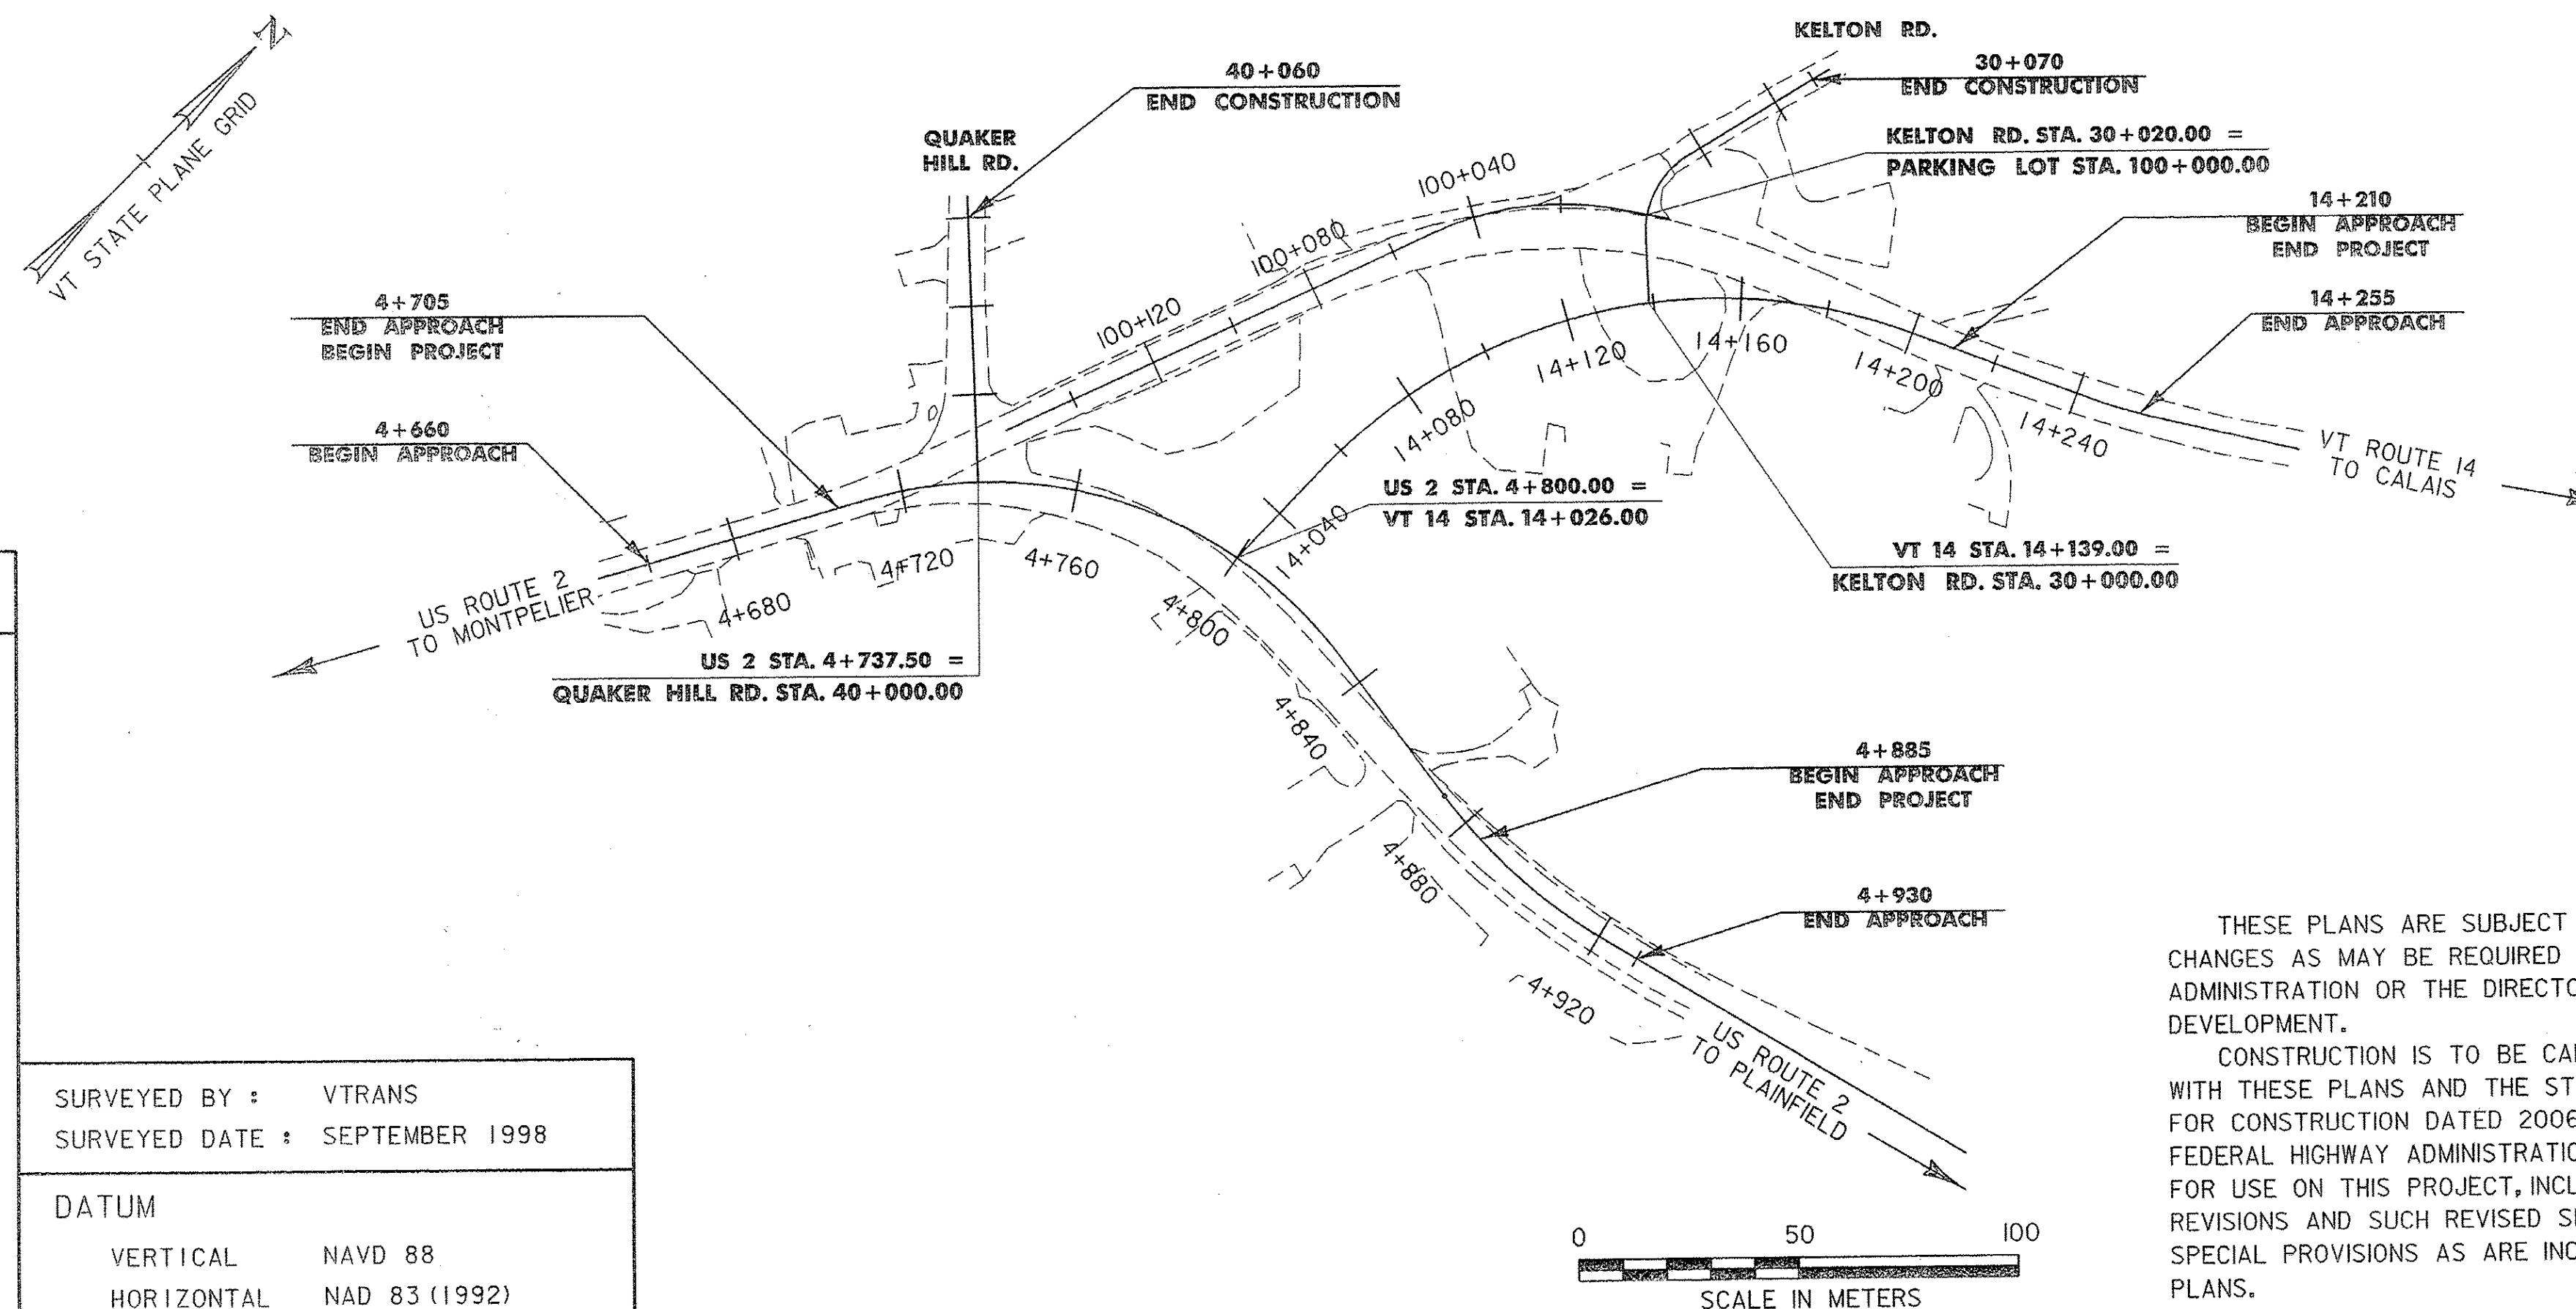

CONVENTIONAL SYMBOLS

COUNTY LINE	
TOWN LINE	
LIMITS OF ACCESS	
POINT OF ACCESS	
FENCE LINE	
STONE WALL	
TRAVELED WAY	
GUARD RAIL	
RAILROAD	
SURVEY LINE	
CULVERT	
POWER POLE	
TELEPHONE POLE	
TREES	
CONTROL OF ACCESS	
PROPERTY LINE	
R.O.W. TAKING LINE	
SLOPE RIGHTS	
TOP OF CUT	
TOE OF SLOPE	

SURVEYED BY : VTRANS
 SURVEYED DATE : SEPTEMBER 1998

DATUM
 VERTICAL NAVD 88
 HORIZONTAL NAD 83 (1992)

THESE PLANS ARE SUBJECT TO SUCH ENGINEERING CHANGES AS MAY BE REQUIRED BY THE FEDERAL HIGHWAY ADMINISTRATION OR THE DIRECTOR OF PROJECT DEVELOPMENT.

CONSTRUCTION IS TO BE CARRIED ON IN ACCORDANCE WITH THESE PLANS AND THE STANDARD SPECIFICATIONS FOR CONSTRUCTION DATED 2006, AS APPROVED BY THE FEDERAL HIGHWAY ADMINISTRATION ON JUNE 15, 2006 FOR USE ON THIS PROJECT, INCLUDING ALL SUBSEQUENT REVISIONS AND SUCH REVISED SPECIFICATIONS AND SPECIAL PROVISIONS AS ARE INCORPORATED IN THESE PLANS.



UNLESS NOTED OTHERWISE
 STATIONS ARE IN KILOMETERS
 ELEVATIONS ARE IN METERS
 DIMENSIONS ARE IN MILLIMETERS

DIRECTOR OF PROJECT DEVELOPMENT
 APPROVED: *Richard Stewart* DATE: *3/23/10*

PROJECT MANAGER : JOSHUA SCHULTZ

PROJECT NAME : EAST MONTPELIER
 PROJECT NUMBER : STPG 028-3 (35) S

SHEET 1 OF 142 SHEETS

INDEX OF SHEETS

INDEX OF SHEETS

1	TITLE SHEET
2	INDEX OF SHEETS
3-5	TYPICAL SHEETS
6	DRAINAGE STRUCTURE DETAIL SHEET
7-8	MATERIAL TRANSITION SHEETS
9-12	QUANTITY SHEETS
13	ITEM DETAIL SHEET
14	DRAINAGE DETAIL SHEET
15	EARTHWORKS SHEET
16-20	R.O.W. DETAIL SHEETS
21-24	R.O.W. LAYOUT SHEETS
25	TIE SHEET
26	CONSTRUCTION APPROACH SIGNS SHEET
27	CONSTRUCTION SIGNS DETAIL SHEET
28-31	LAYOUT SHEETS
32-33	US ROUTE 2 PROFILE SHEETS
34-35	VT ROUTE 14 PROFILE SHEETS
36	QUAKER HILL & KELTON RD PROFILE SHEET
37	PARKING LOT PROFILE SHEET
38-41	DRAINAGE LAYOUT SHEETS
42-46	DRAINAGE PROFILE SHEETS
47	STORMWATER TREATMENT DETAIL SHEET
48	EPSC NARRATIVE
49-52	EPSC EXISTING CONDITIONS SHEETS
53-56	EPSC CONSTRUCTION SHEETS
57-60	EPSC FINAL CONDITIONS SHEETS
61-63	EPSC DETAILS SHEETS
64-67	LANDSCAPE AND LIGHTING LAYOUT SHEETS
68	LANDSCAPE AND LIGHTING NOTES SHEET
69	LANDSCAPE DETAIL SHEET
70	TRAFFIC LAYOUT SHEET
71	TRAFFIC SIGNAL NOTES
72	TRAFFIC GENERAL NOTES
73-74	MAST ARM CROSS SECTION SHEETS
75-78	PAVEMENT MARKING LAYOUT SHEETS
79-82	TRAFFIC SIGNS LAYOUT SHEETS
83-85	TRAFFIC SIGN SUMMARY SHEETS
86	TRAFFIC CONTROL TYPICAL SHEET
87-90	TC PHASE 1 LAYOUT SHEETS
91-94	TC PHASE 2 LAYOUT SHEETS
95-98	TC PHASE 3 LAYOUT SHEETS
99-115	US ROUTE 2 CROSS SECTION SHEETS
116-126	VT ROUTE 14 CROSS SECTION SHEETS
127-131	QUAKER HILL ROAD CROSS SECTION SHEETS
132-136	KELTON ROAD CROSS SECTION SHEETS
137-142	PARKING LOT CROSS SECTION SHEETS

STANDARDS LIST

B-5	SLOPE GRADING, EMBANKMENTS, MUCK	6/1/1994
B-12	SIDE ROAD INTERSECTION, DEPRESSED RAMP	6/1/1994
B-71	STANDARD FOR RESIDENTIAL AND COMMERCIAL DRIVES	7/8/2005
C-2A	PORTLAND CEMENT CONCRETE SIDEWALK DRIVE ENTRANCES WITH SIDEWALK ADJACENT TO CURB	10/14/2005
C-2B	PORTLAND CEMENT CONCRETE SIDEWALK DRIVE ENTRANCES WITH SIDEWALK AND GREEN STRIP	10/14/2005
C-3A	SIDEWALK RAMPS	3/10/2008
C-3B	SIDEWALK RAMPS AND MEDIAN ISLANDS	3/10/2008
C-10	CURBING	2/8/2008
D-3	TREATED GUTTERS	6/1/1994
D-11	STEEL OR IRON GRATES & COVERS (TYPE A)	6/1/1994
D-15	PRECAST REINF CONC. MH-GRATES, CAST IRON GRATE WITH FRAME, TYPE D & E	6/1/1994
D-16	DRAINAGE DETAILS INCLUDING DROP INLETS, IRON GRATE TYPE B&C, CONC END SECTIONS, ETC.	6/1/1994
D-20	HIGHWAY CROSSING FOR UNDERGROUND UTILITIES	3/3/2003
D-30	UNDERDRAIN CONSTRUCTION DETAILS	8/13/2007
D-33	REINFORCED CONCRETE STRAIGHT HEADWALL	3/12/2007
E-100	CONSTRUCTION APPROACH SIGNS	1/2/2004
E-100A	SIDE ROAD CONSTRUCTION - APPROACH SIGNS	1/2/2004
E-101	CONSTRUCTION SIGN DETAILS	5/30/2003
E-102	CONSTRUCTION SIGN DETAILS	6/30/2003
E-102A	CONSTRUCTION SIGN DETAILS	5/1/2004
E-106	TRAFFIC CONTROL - MISCELLANEOUS DETAILS	3/1/2004
E-107	DELINEATION, BARRICADES AND DETOURS FOR CONSTRUCTION AREAS	6/30/2003
E-107A	BREAKAWAY BARRICADE DETAILS	6/8/2009
E-108	CONSTRUCTION ZONE LONGITUDINAL DROP OFFS	6/8/2009
E-108A	CONSTRUCTION ZONE LONGITUDINAL DROP OFFS FOR PAVING	6/8/2009

E-110	MAJOR MAINTENANCE OPERATION LANE CLOSURE	8/8/1995
E-111	MINOR MAINTENANCE OPERATIONS	3/11/1997
E-119	UTILITY WORK ZONE	3/1/2004
E-121	STANDARD SIGN PLACEMENT - CONVENTIONAL ROAD	8/8/1995
E-123	GUIDE SIGN PLACEMENT - MISCELLANEOUS DETAILS	3/16/2004
E-125	TRAVEL INFORMATION COUNCIL SIGNS	8/8/1995
E-127	ROUTE MARKINGS AT RURAL INTERSECTIONS	8/8/1995
E-136A	U.S. ROUTE MARKER SIGN DETAILS	8/8/1995
E-136B	STATE ROUTE MARKER SIGN DETAILS	8/8/1995
E-138	MILE MARKER DETAILS - STATE & TOWN HIGHWAYS	5/30/2003
E-140	REGULATORY SIGN DETAILS	8/30/1996
E-141	REGULATORY SIGN DETAILS	9/20/1995
E-142	REGULATORY SIGN DETAILS	9/20/1995
E-143	REGULATORY SIGN DETAILS	6/15/2004
E-144	REGULATORY SIGN DETAILS	3/29/1999
E-145A	REGULATORY SIGN DETAILS - LANE USE CONTROL SIGNS	12/23/1994
E-145B	REGULATORY SIGN DETAILS - LANE USE CONTROL SIGNS	12/23/1994
E-150	WARNING SIGN DETAILS	5/1/2004
E-151	WARNING SIGN DETAILS	5/1/2004
E-152	WARNING SIGN DETAILS	5/1/2004
E-153	WARNING SIGN DETAILS	5/1/2004
E-154	WARNING SIGN DETAILS	5/1/2004
E-155	WARNING SIGN DETAILS	5/1/2004
E-164	SQUARE STEEL SIGN POST	6/8/2009
E-170	TRAFFIC CONTROL SIGNALS PEDESTAL POST MOUNTED	11/4/1999
E-171A	TRAFFIC CONTROL SIGNALS GENERAL NOTES & DETAILS	8/9/1995
E-171B	TRAFFIC CONTROL SIGNALS MISC. DETAILS	8/9/1995
E-171C	TRAFFIC CONTROL SIGNALS CANTILEVER MOUNTING DETAILS	8/9/1995
E-173	PULL BOXES AND JUNCTION BOXES	8/9/1995
E-175	POWER DROP STANCHIONS	6/8/2009
E-180A	STREET LIGHTING DETAILS	8/9/1995
E-180B	STREET LIGHTING DETAILS	8/9/1995
E-191	PAVEMENT MARKING DETAILS	2/1/1999
E-192	PAVEMENT MARKING DETAILS	10/12/2000
E-193	PAVEMENT MARKING DETAILS	8/18/1995
G-1	STEEL BEAM GUARDRAIL DETAILS (POST, DELINEATOR, TYPICALS)	1/3/2000
G-1D	STEEL BEAM GUARDRAIL DETAILS (END TERMINAL, ANCHOR, MEDIATE)	1/3/2000
G-17A	MODIFIED ECCENTRIC LOADER TERMINAL (MELT)	9/27/2002
G-17B	MODIFIED ECCENTRIC LOADER TERMINAL (MELT)	9/27/2002
G-19	GENERIC GRADING PLANS FOR GUARDRAIL END TERMINALS	11/15/2002

PROJECT NAME: EAST MONTPELIER
PROJECT NUMBER: STPG 028 - 3(35)S


FILE NAME: +98b028fr.m.dgn	PLOT DATE: 16-APR-2010
PROJECT LEADER: J. SCHULTZ	DRAWN BY: I. DEGUTIS
DESIGNED BY: J. GRUCHACZ	CHECKED BY: J. DEVLIN
INDEX OF SHEETS	SHEET 2 OF 142

MATERIAL TOLERANCES		
PAVEMENT (TOTAL DEPTH):	±	5
SUBBASE (TOTAL DEPTH):	±	30
SAND BORROW (TOTAL DEPTH):	±	30


TYPICAL SECTIONS

NOT TO SCALE


45 SUPERPAVE BITUMINOUS CONCRETE PAVEMENT (TYPE IIIIS) - (1 - 45 LIFT)
 170 SUPERPAVE BITUMINOUS CONCRETE PAVEMENT (TYPE IIS) - (2 - 85 LIFTS)
 610 SUBBASE OF DENSE GRADED CRUSHED STONE
 610 SAND BORROW

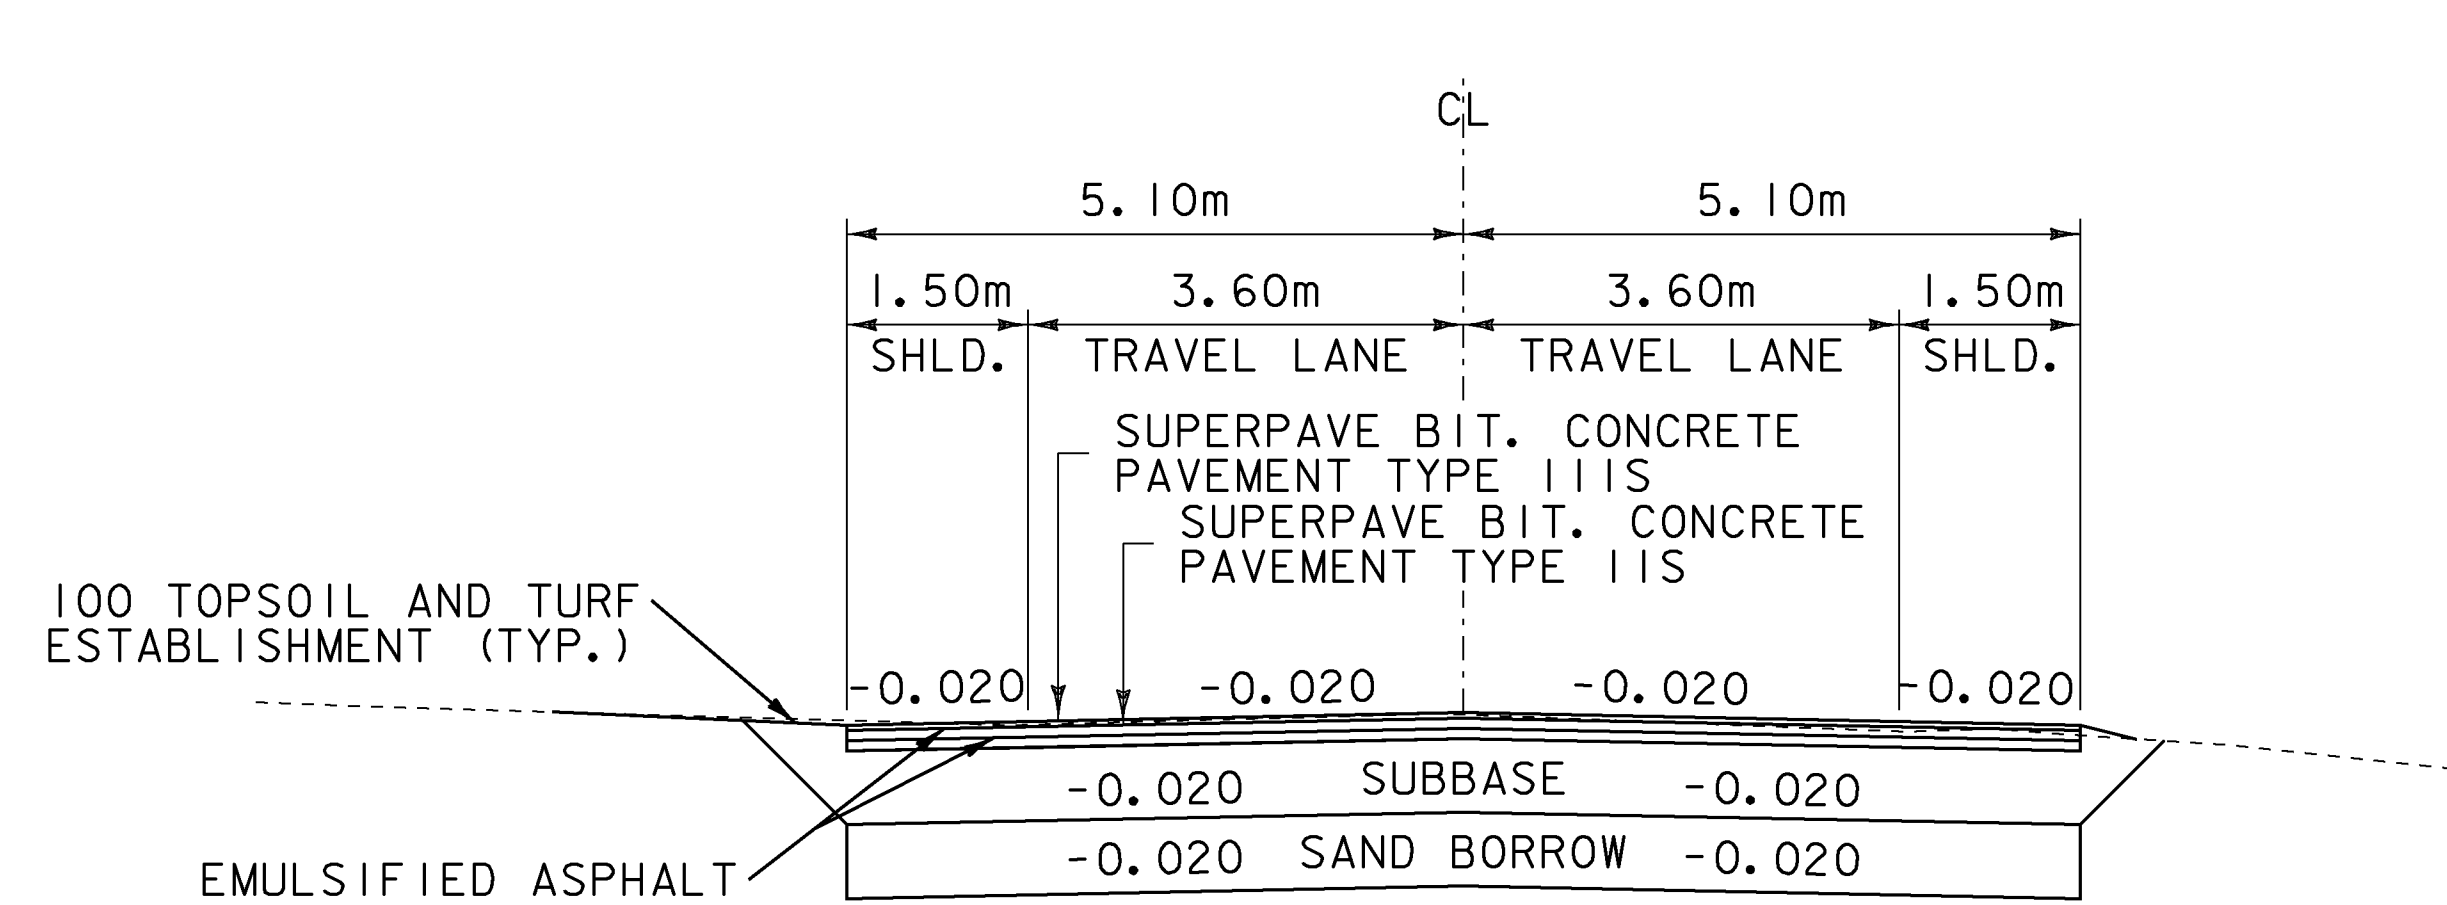

**2-LANE TYPICAL SECTION
US ROUTE 2 AND VT ROUTE 14**

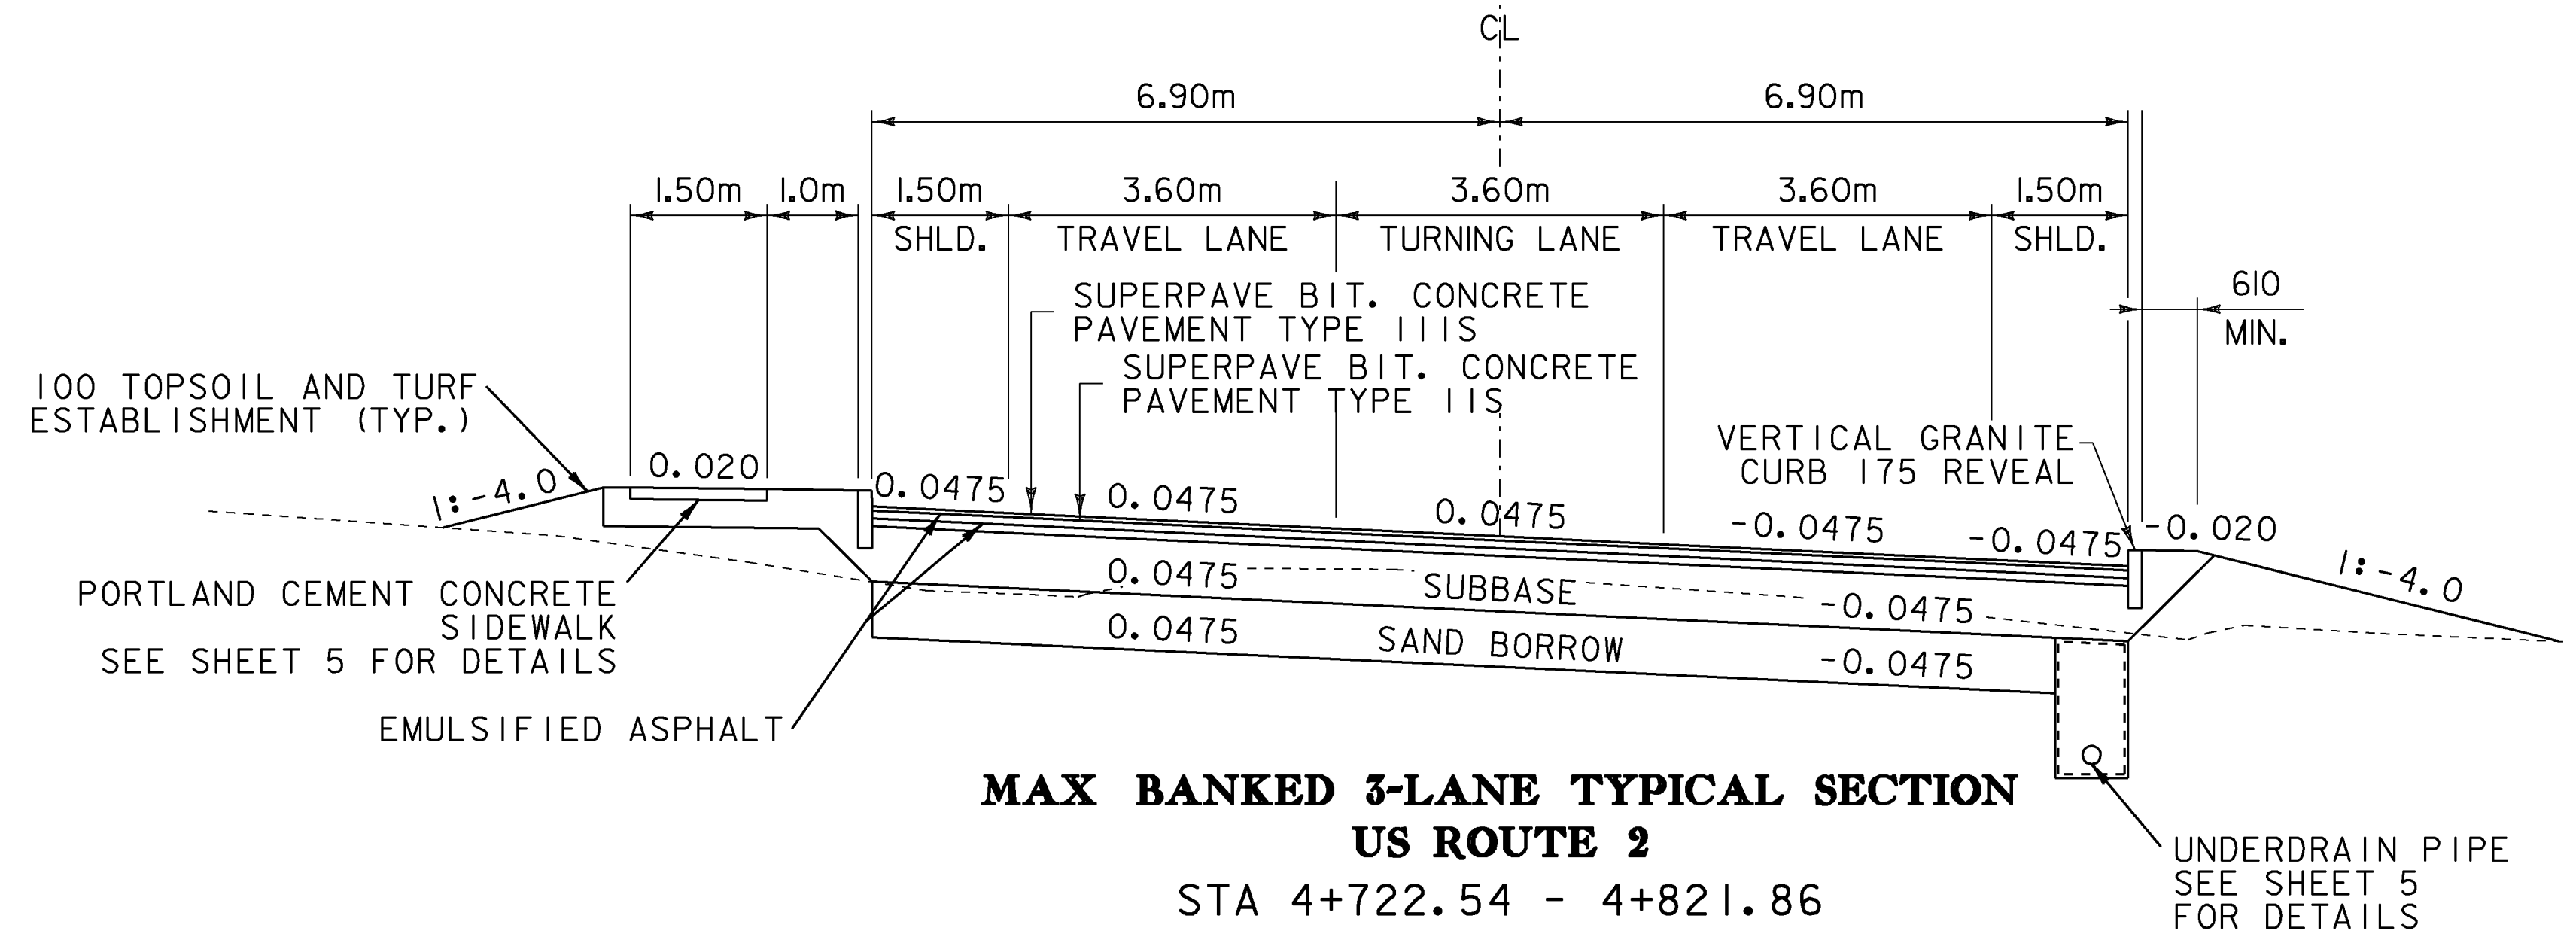

**MAX BANKED 3-LANE TYPICAL SECTION
US ROUTE 2
STA 4+722.54 - 4+821.86**

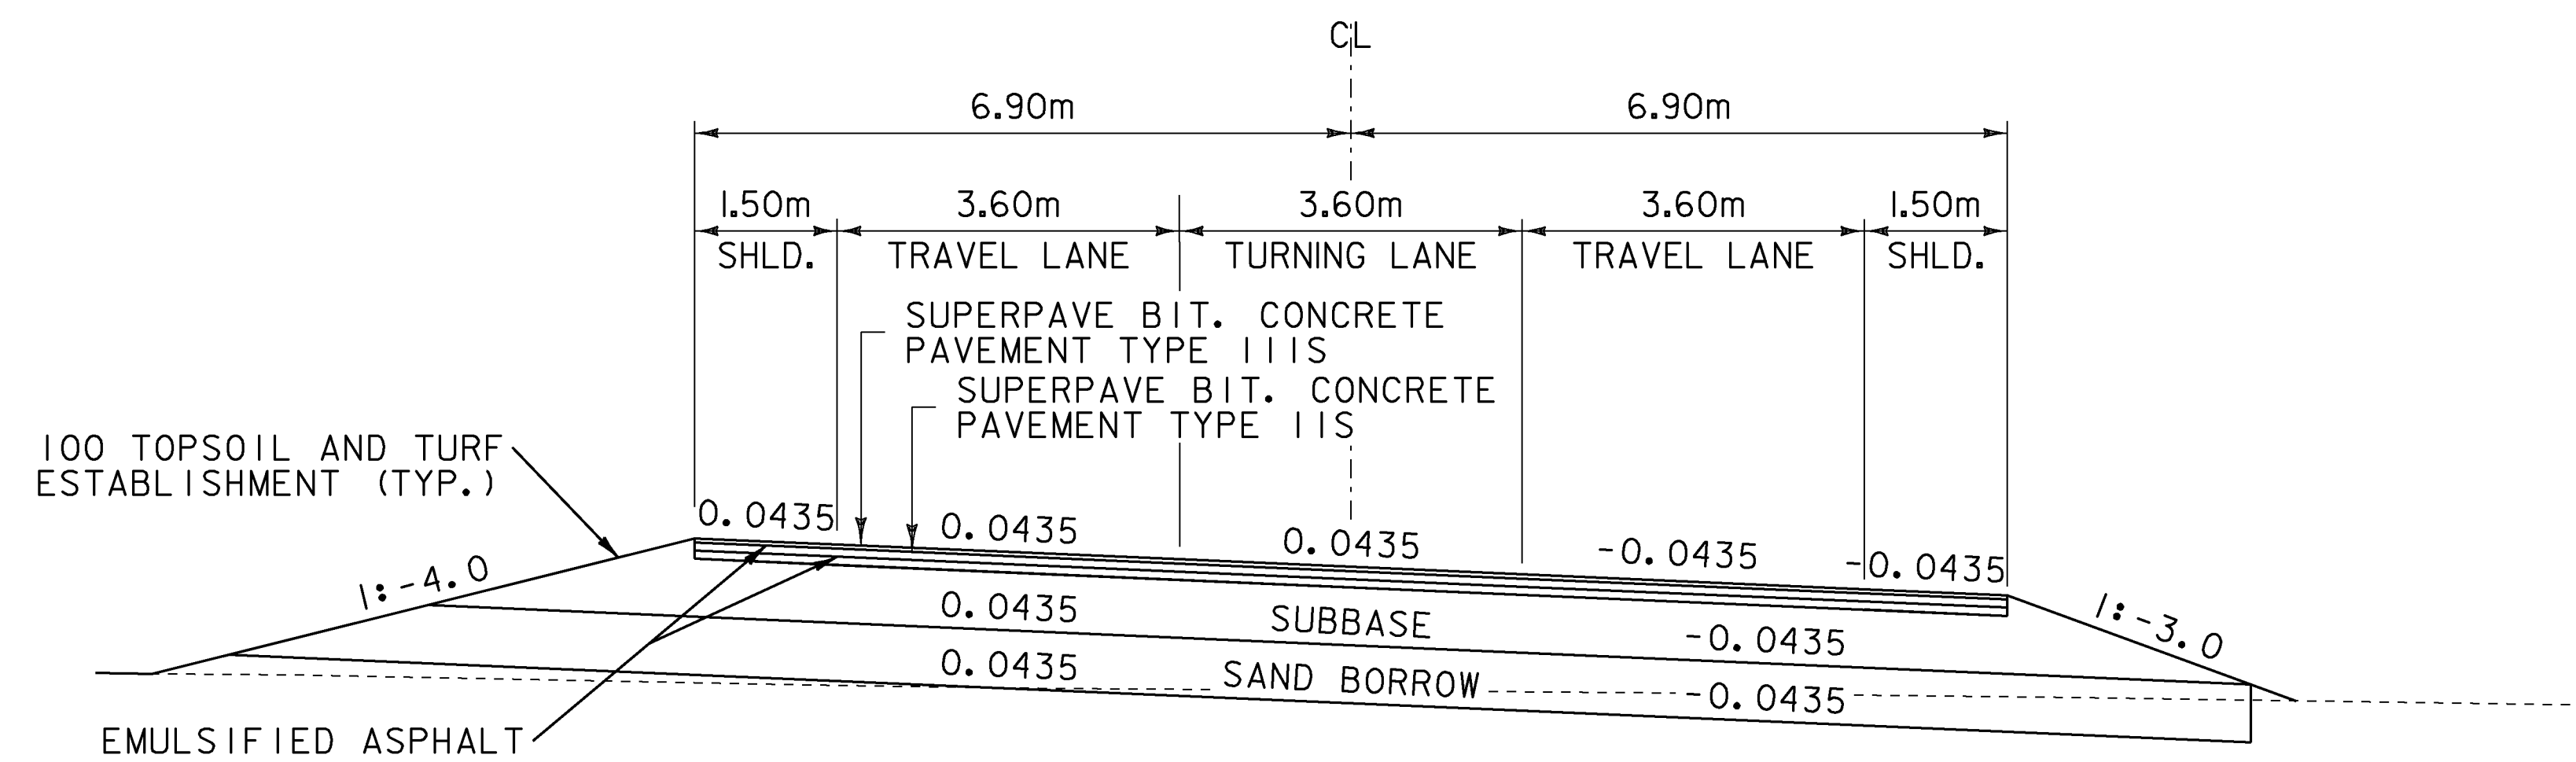

**MAX BANKED 3-LANE TYPICAL SECTION
VT ROUTE 14
STA 14+063.80 - 14+188.51**

CLEAR ZONE TABLE	
APPROACH	DISTANCE (M)
US ROUTE 2 3-LANE TYPICAL SECTION	4.88*
US ROUTE 2 CURBED TYPICAL SECTION	0.45**
VT ROUTE 14 3-LANE TYPICAL SECTION	4.27*

* DISTANCE MEASURED FROM EDGE OF TRAVELED LANE
 ** DISTANCE MEASURED FROM THE FACE CURB

PROJECT NAME: EAST MONTPELIER	PLOT DATE: 22-MAR-2010
PROJECT NUMBER: STPG 028 - 3(35)S	DRAWN BY: I. DEGUTIS
FILE NAME: +98b028+typ.dgn	CHECKED BY: J. DEVLIN
PROJECT LEADER: J.SCHULTZ	SHEET 3 OF 142
DESIGNED BY: J. GRUCHACZ	TYPICAL SHEET 1

MATERIAL TOLERANCES		
PAVEMENT	(TOTAL DEPTH):	± 5
SUBBASE	(TOTAL DEPTH):	± 30

PARKING LOT
PAVEMENT SAME AS KELTON ROAD
4S TYPE IIIS I-LIFT
8S TYPE IIS I-LIFT


SEEDING FORMULA

SEE EPSC DETAILS SHEET 2 FOR THE SEEDING FORMULA.

TYPICAL SECTIONS


NOT TO SCALE

45 SUPERPAVE BITUMINOUS CONCRETE PAVEMENT (TYPE IIIS) - (1 - 45 LIFT)
 85 SUPERPAVE BITUMINOUS CONCRETE PAVEMENT (TYPE IIS) - (1 - 85 LIFT)
 305 SUBBASE OF DENSE GRADED CRUSHED STONE

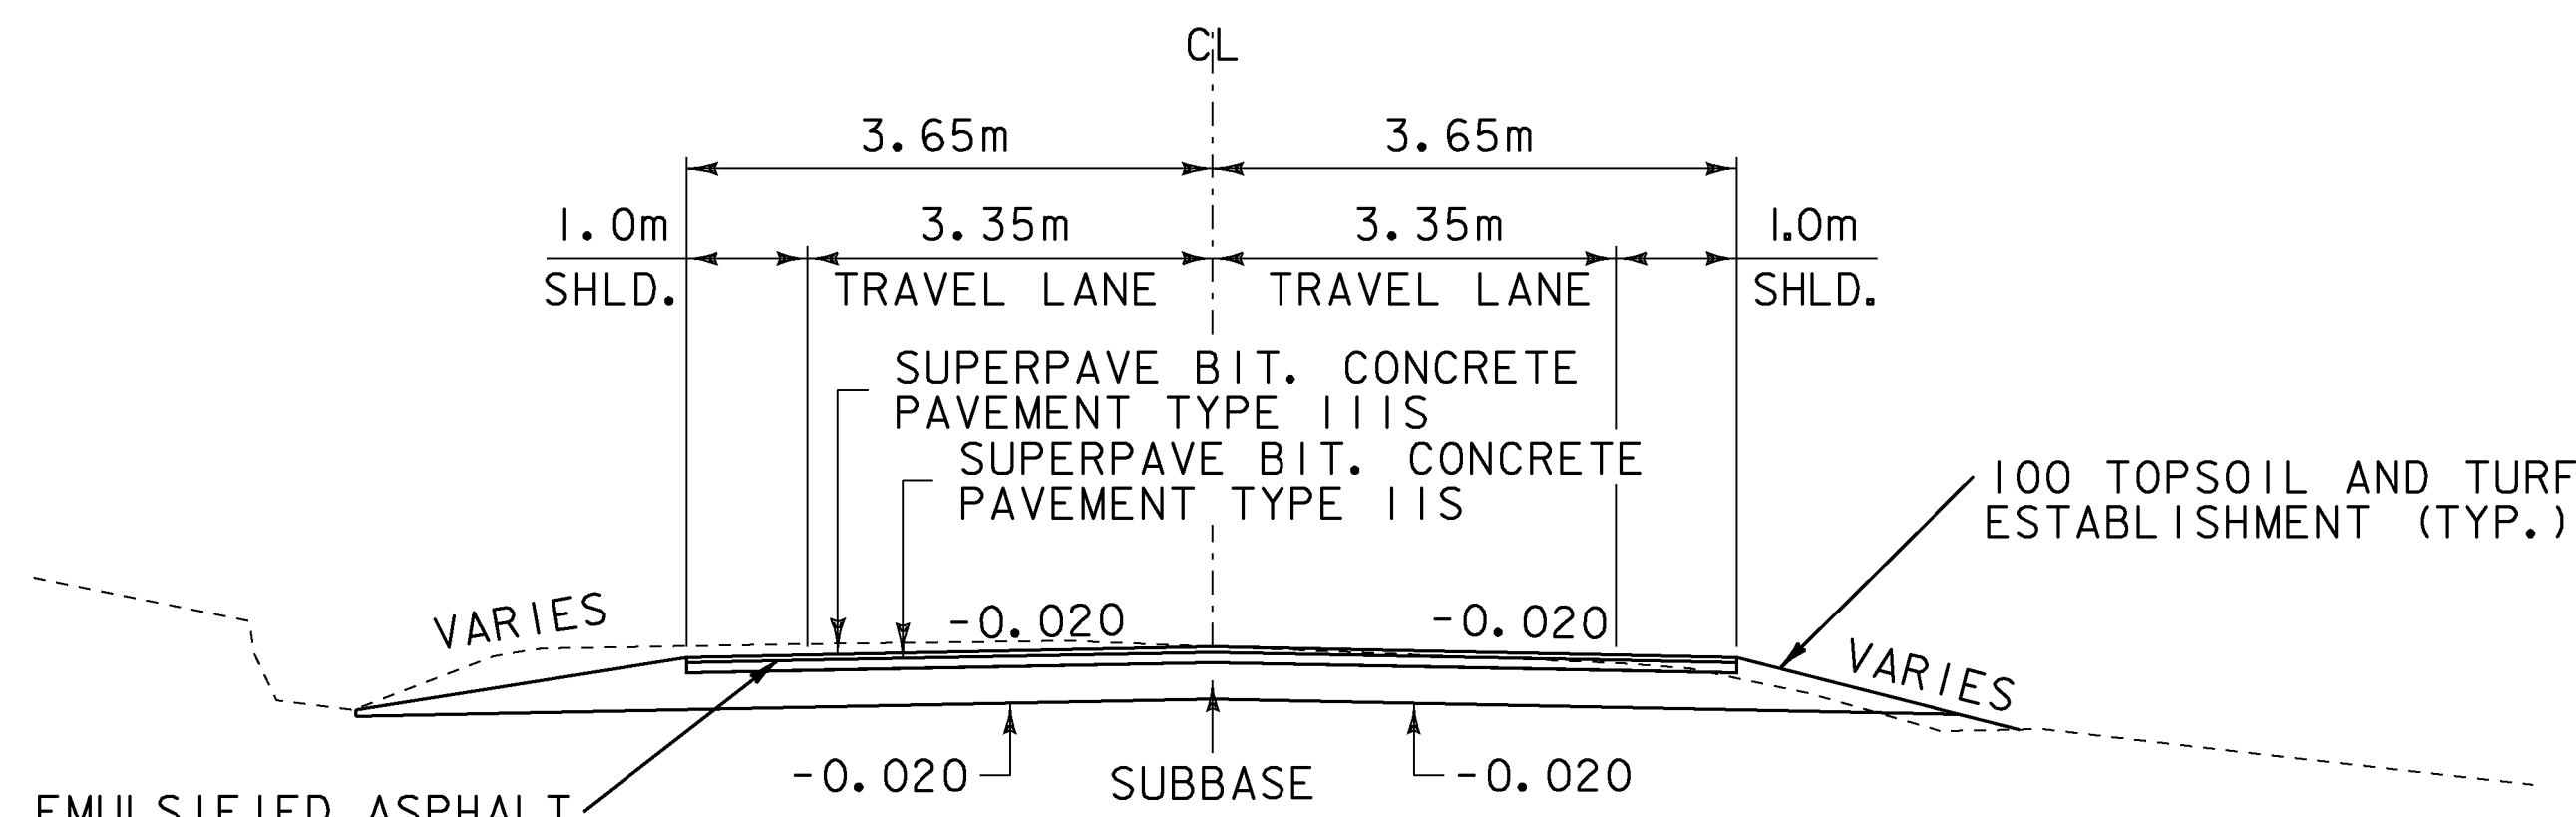

**TYPICAL SECTION
 QUAKER HILL ROAD**

STA 40+006.00 - 40+045.00

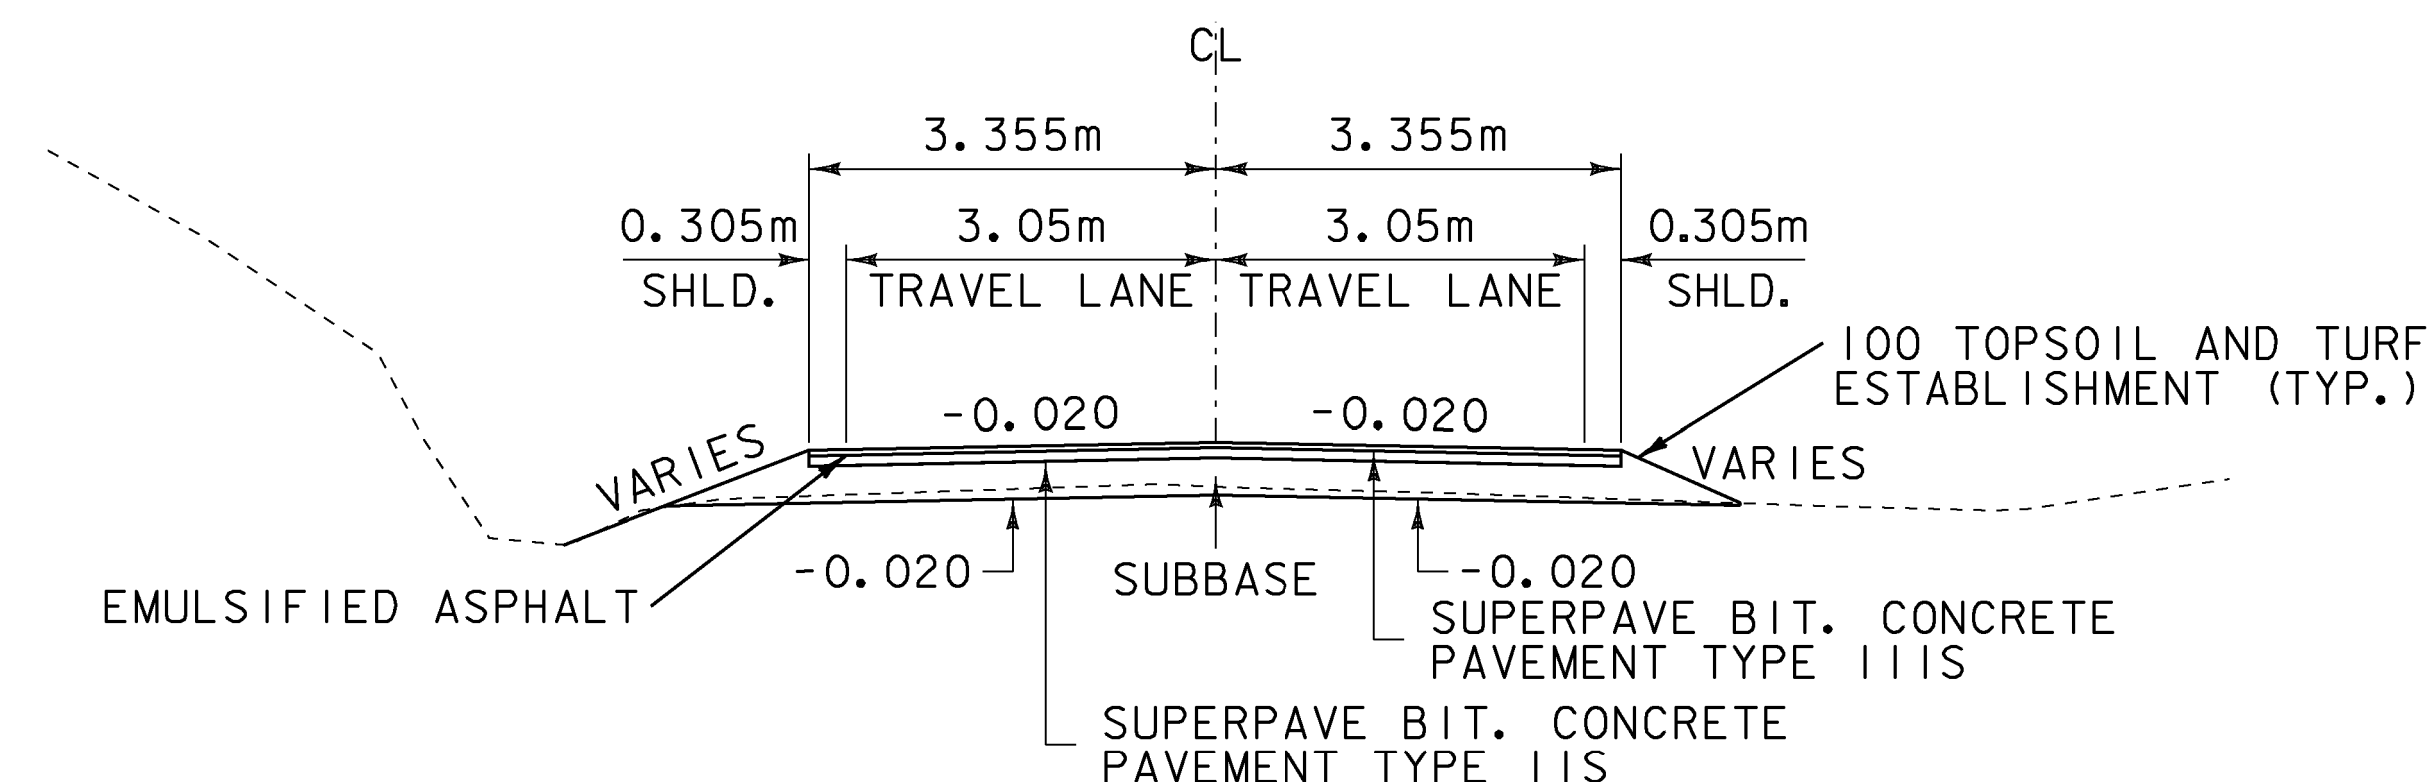

**TYPICAL SECTION
 KELTON ROAD**

STA 30+008.00 - 30+060.00

- GENERAL NOTES**
- ALL MATERIALS AND CONSTRUCTION PRACTICES SHALL CONFORM TO THE STATE OF VERMONT AGENCY OF TRANSPORTATION'S 2006 STANDARD SPECIFICATIONS FOR CONSTRUCTION AND IT'S LATEST REVISIONS.
 - TACK COAT: EMULSIFIED ASPHALT IS TO BE APPLIED AT THE RATE OF 0.012 L/SM BETWEEN SUCCESSIVE COURSES OF PAVEMENT AS DIRECTED BY THE ENGINEER.
 - MARKER POSTS: TO BE PLACED AS INDICATED OR AS DIRECTED BY THE ENGINEER.
 - SLOPE ROUNDING: ALL CUT SLOPES TO BE ROUNDED IN ACCORDANCE WITH STANDARD B-5.
 - ALL BURIED UTILITIES ARE EXISTING, THE LOCATIONS ARE APPROXIMATE AND ARE TO REMAIN UNDISTURBED. THE CONTRACTOR SHALL BE RESPONSIBLE FOR COORDINATING WITH THE UTILITY COMPANIES INVOLVED AND SHALL DIG TEST PITS AS REQUIRED TO VERIFY LOCATIONS. THE CONTRACTOR SHALL NOTIFY "DIG SAFE" PRIOR TO ANY EXCAVATION. THE CONTRACTOR SHALL VERIFY LOCATION, ELEVATIONS AND DIMENSIONS OF THE EXISTING WATER LINES PRIOR TO CONSTRUCTION. THERE WILL BE NO EXTRA COMPENSATION PAID TO THE CONTRACTOR FOR ANY INCONVENIENCE CAUSED BY WORKING AROUND AND WITH THE UTILITY COMPANIES.
 - THE CONTRACTOR SHALL BE RESPONSIBLE FOR MAKING ALL ARRANGEMENTS FOR ANCHORING, SUPPORTING AND/OR RELOCATING AND PROTECTING ALL UTILITIES DURING CONSTRUCTION. ALL COSTS SHALL BE INCLUDED IN THE UNIT PRICES BID. IN THE CASE OF DAMAGE, THE CONTRACTOR SHALL BE RESPONSIBLE FOR THE COST OF ALL REPAIRS.
 - THE CONTRACTOR IS RESPONSIBLE FOR THE PROTECTION OF THE EXISTING FEATURES AND STRUCTURES WITHIN AND ADJACENT TO THE WORK. IN THE CASE OF DAMAGE, THE REPAIRS OR REPLACEMENT SHALL BE COMPLETED AT THE CONTRACTOR'S EXPENSE AS APPROVED BY THE ENGINEER.
 - ALL WORK MUST COMPLY WITH FEDERAL, STATE AND LOCAL REGULATIONS AND IN THE CASE THERE ARE CONFLICTING REGULATIONS THE MORE CONSERVATIVE OR STRICTER REGULATION WILL TAKE PRECEDENCE.
 - ANY DISCREPANCIES BETWEEN THESE DRAWINGS AND ACTUAL FIELD CONDITIONS SHALL BE BROUGHT TO THE ATTENTION OF THE ENGINEER BEFORE PROCEEDING WITH THE WORK.
 - THESE CONTRACT DOCUMENTS DO NOT INCLUDE THE NECESSARY COMPONENTS FOR CONSTRUCTION SAFETY. CARE OF ADJACENT PROPERTIES DURING CONSTRUCTION AND COMPLIANCE WITH STATE AND FEDERAL REGULATIONS REGARDING SITE SAFETY SHALL SOLELY BE THE CONTRACTOR'S RESPONSIBILITY.
 - FOR ITEM 301.35 - SUBBASE OF DENSE GRADED CRUSHED STONE WHEN IN EXCESS OF 950 CM, THE CONTRACTOR IS RESPONSIBLE FOR DETERMINING THE MAXIMUM DRY DENSITY OF THE SUBBASE MATERIAL IN ACCORDANCE WITH VTRANS SPECIFICATION AOT-MRD 54.
 - THE CONTRACTOR IS RESPONSIBLE FOR LOCATING ANY EXISTING STRUCTURES OR PIPES, WHICH CONNECT TO PIPES THAT ARE SPECIFIED TO BE PLUGGED, FILLED OR ABANDONED. IN THE EVENT THAT ADJOINING STRUCTURES OR PIPES ARE FOUND IT SHALL BE BROUGHT TO THE ATTENTION OF THE ENGINEER BEFORE PROCEEDING WITH THE WORK.


CLEAR ZONE TABLE	
APPROACH	DISTANCE (M)
QUAKER HILL ROAD 2-LANE TYPICAL SECTION	3.05*
KELTON ROAD 2-LANE TYPICAL SECTION	3.05*

* DISTANCE MEASURED FROM EDGE OF TRAVELED LANE

PROJECT NAME: EAST MONTPELIER
 PROJECT NUMBER: STPG 028 - 3(35)S


FILE NAME: +98b028+yp.dgn	PLOT DATE: 29-MAR-2010
PROJECT LEADER: J. SCHULTZ	DRAWN BY: I. DEGUTIS
DESIGNED BY: J. GRUCHACZ	CHECKED BY: J. DEVLIN
TYPICAL SHEET 2	SHEET 4 OF 142

**TYPICAL SECTION
DETAILS**
NOT TO SCALE

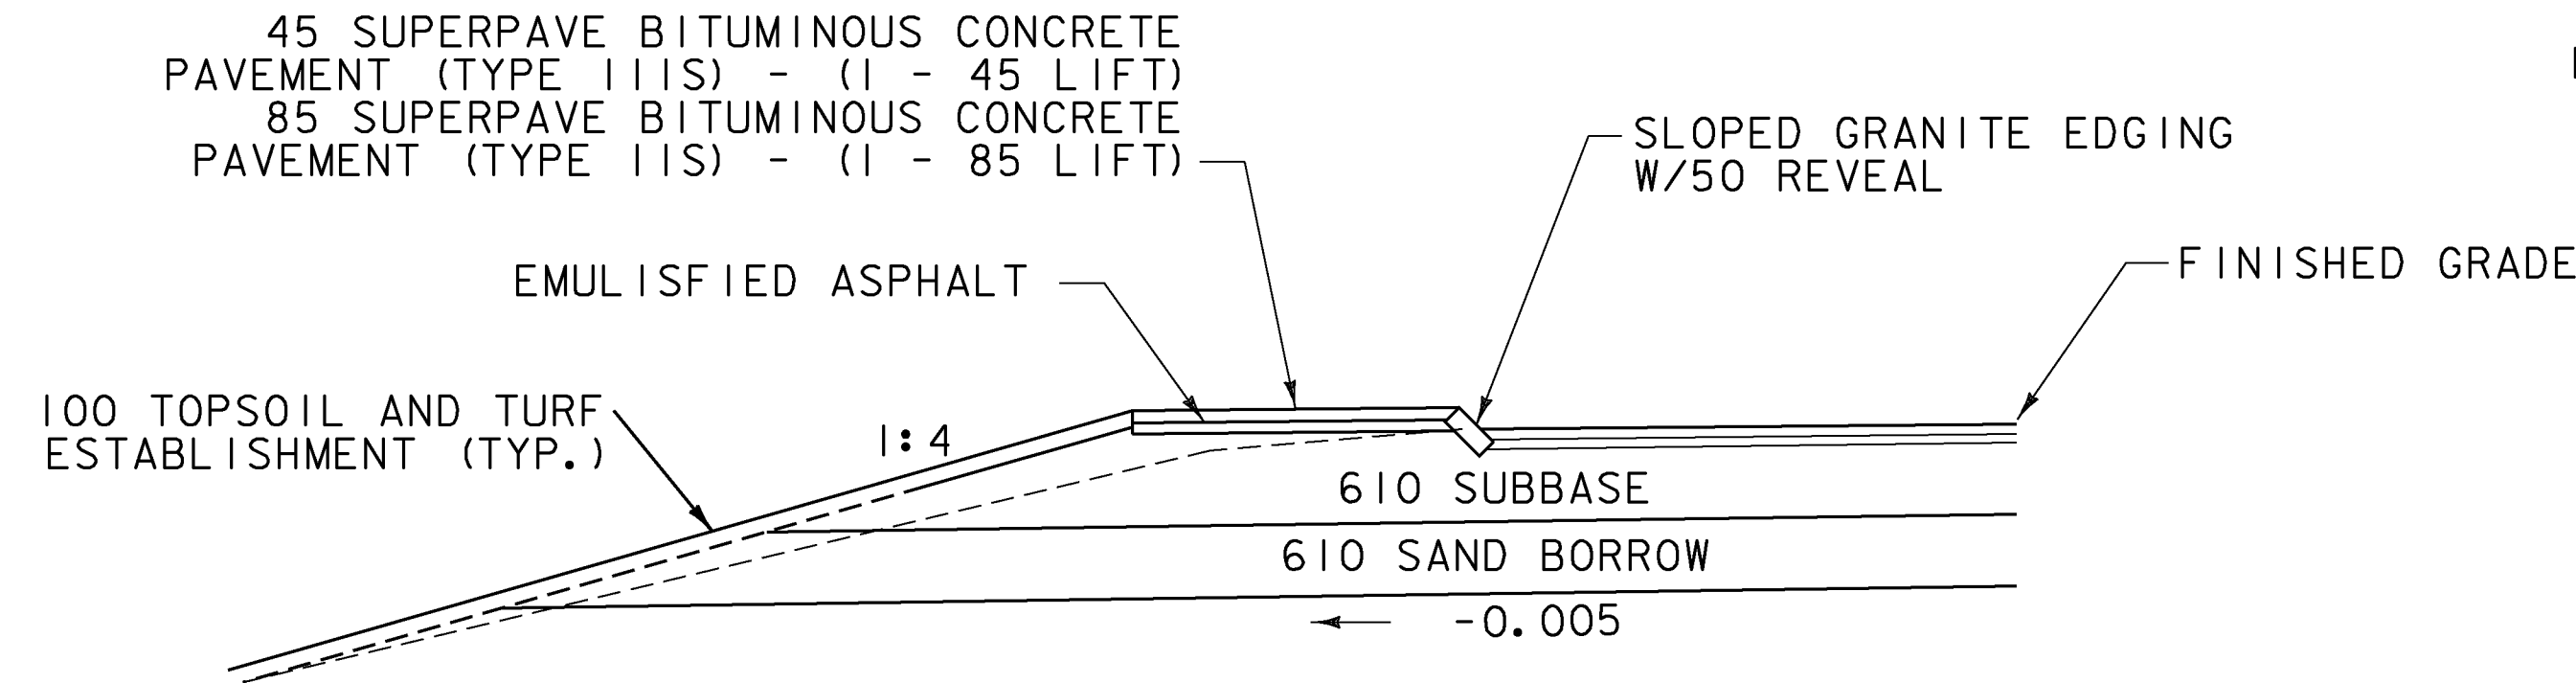


**APRON WITH MOUNTABLE
CURB DETAIL**

4+780.1 LT - 14+037.5 LT

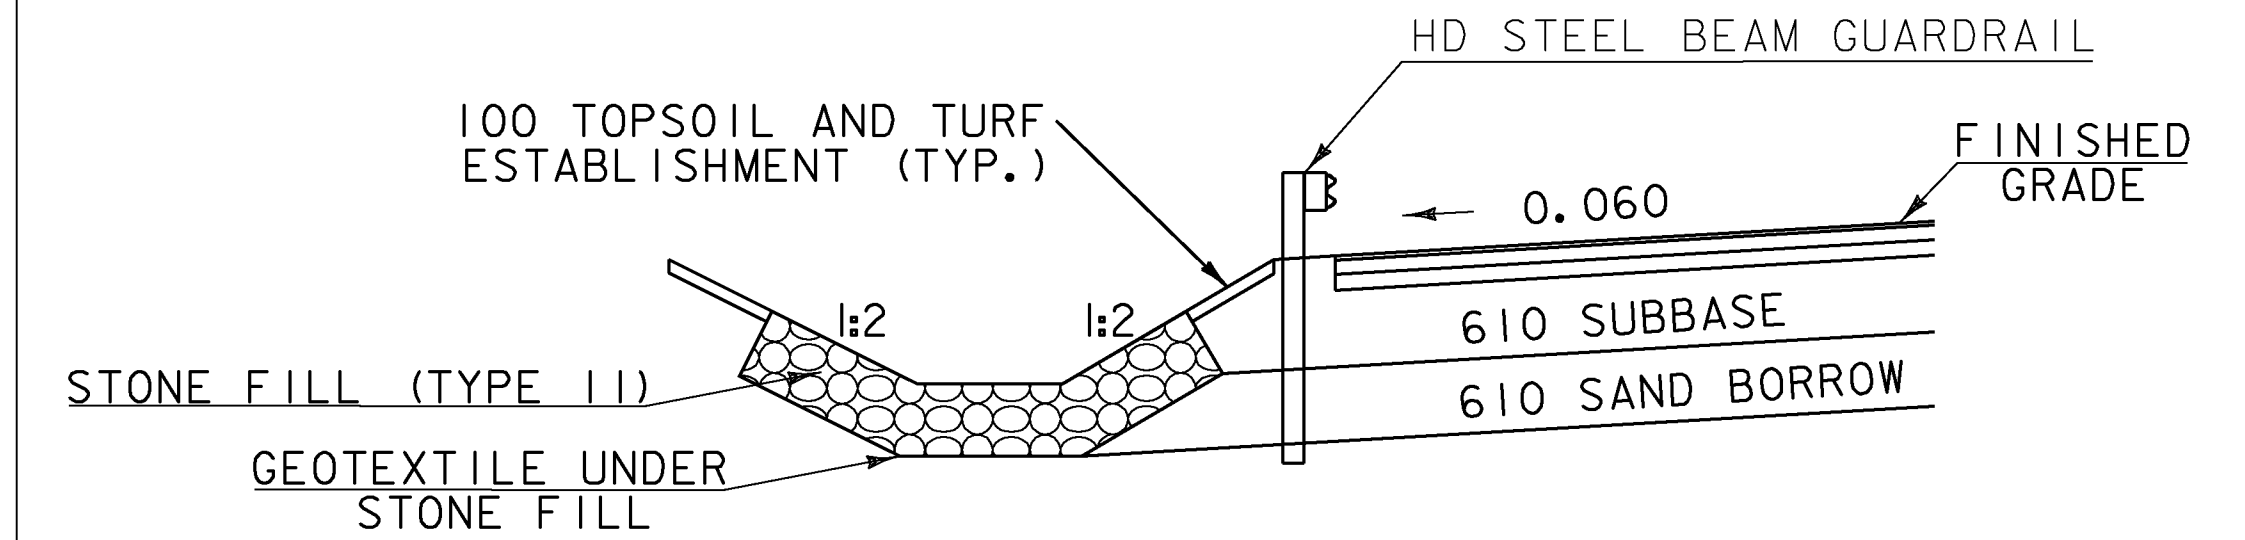


GUARDRAIL - DITCH SECTION DETAIL
US ROUTE 2

STA 4+932.00 LT - 4+985.32 LT

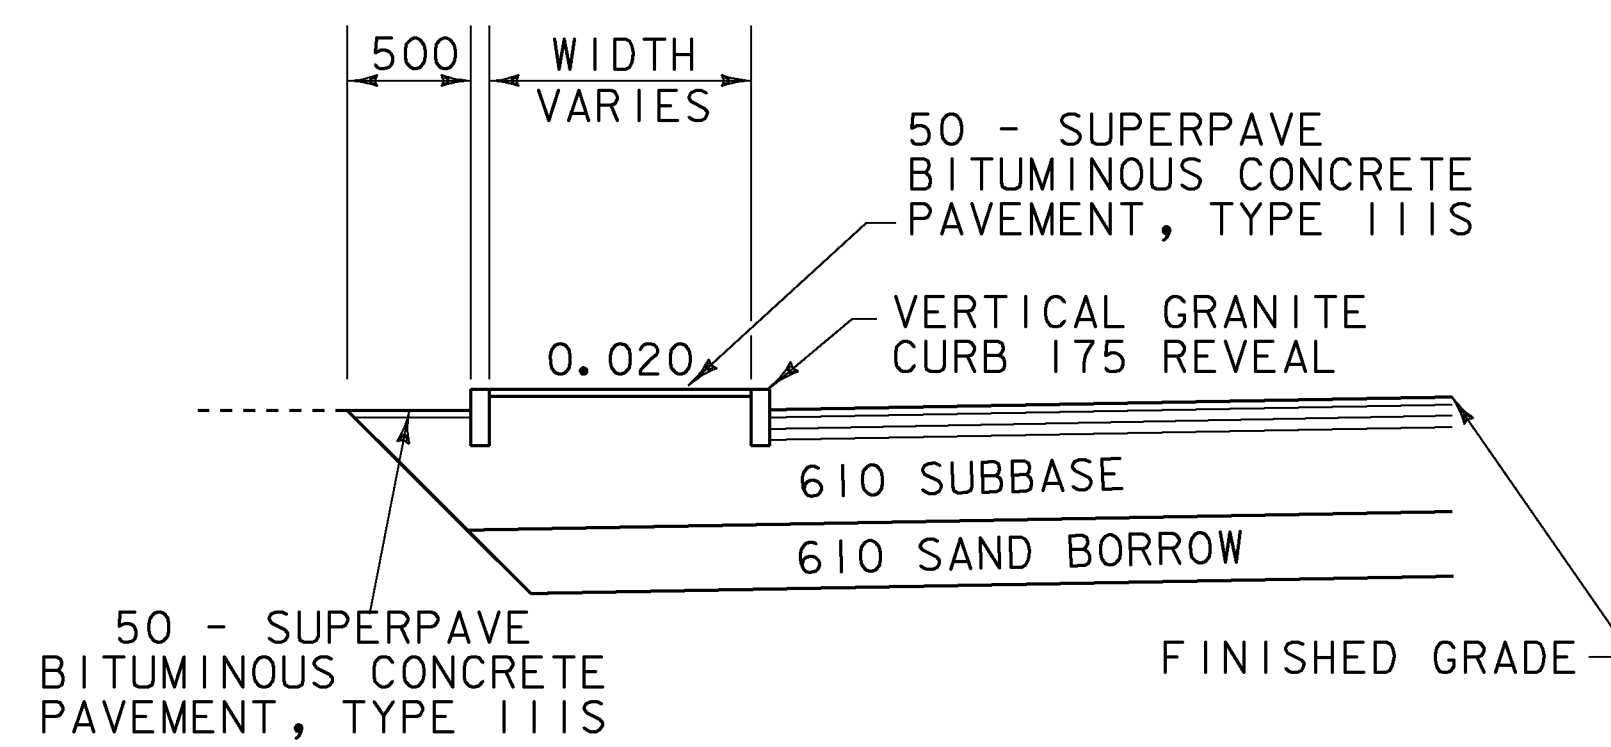


ISLAND - PAVED LT

4+709.00 LT - 40+015.38 LT

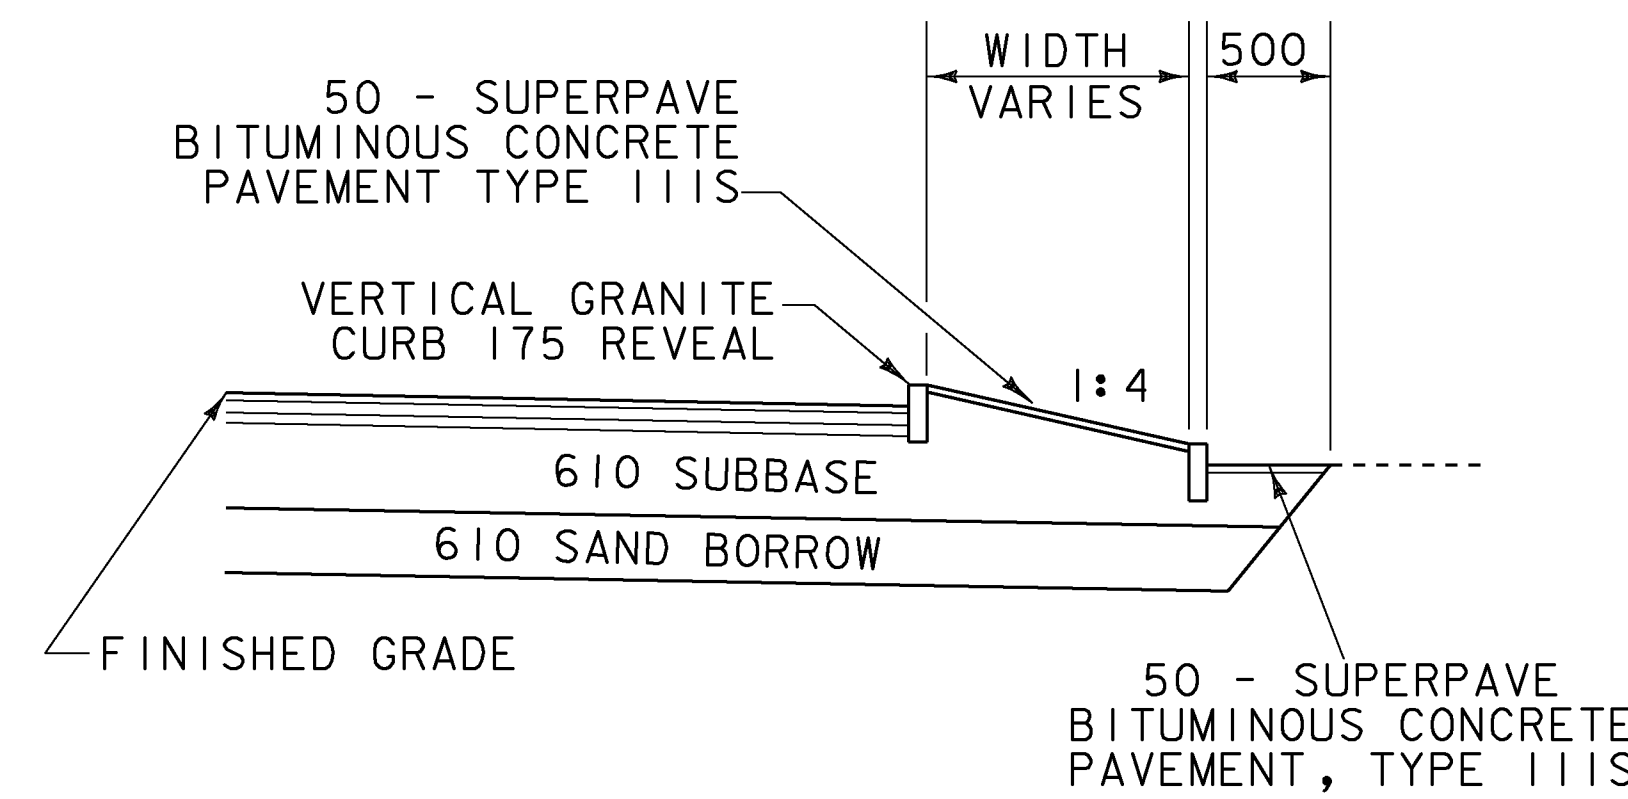


ISLAND - PAVED RT

4+704.72 RT - 4+717.10 RT
4+731.70 RT - 4+752.80 RT

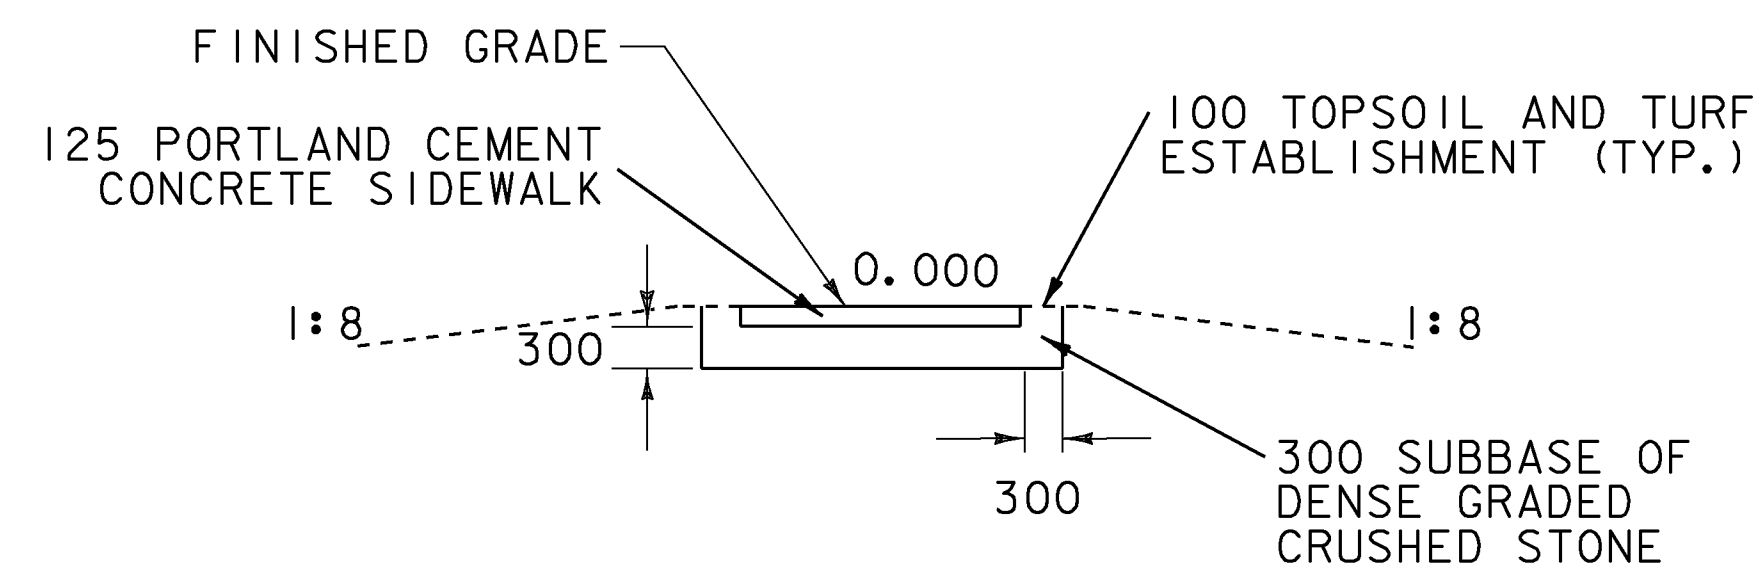


SIDEWALK IN LAWN AREA

100+082.37 RT - 100+156.58 RT

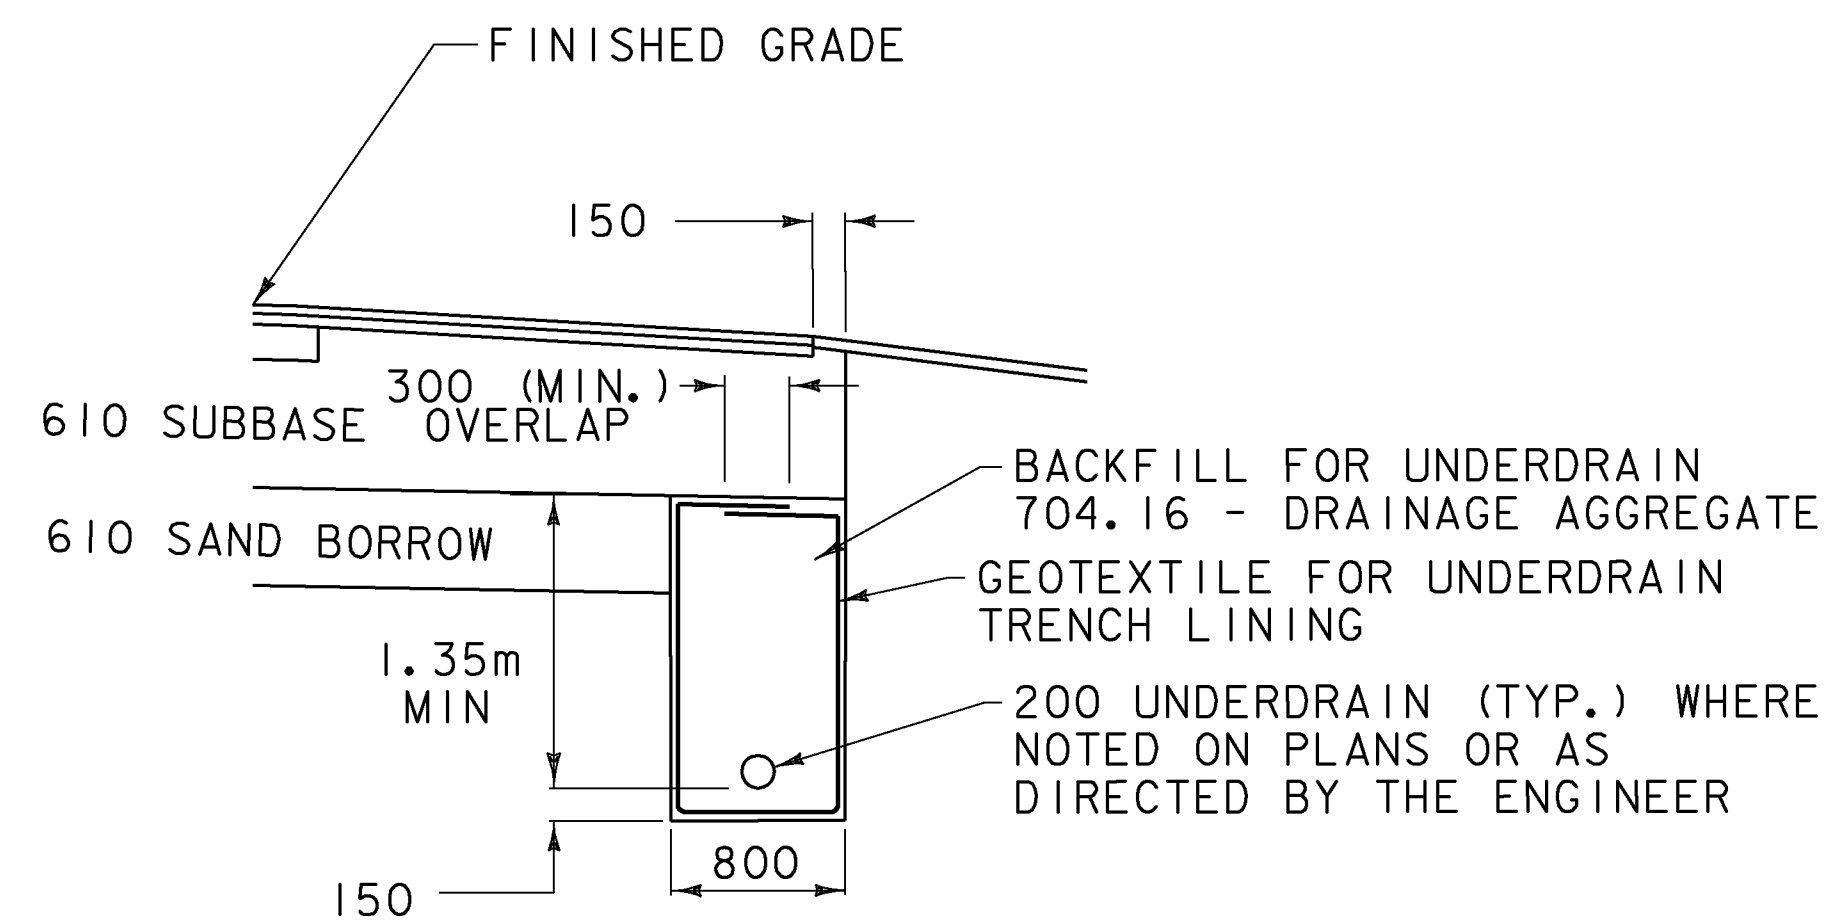

UNDERDRAIN DETAIL

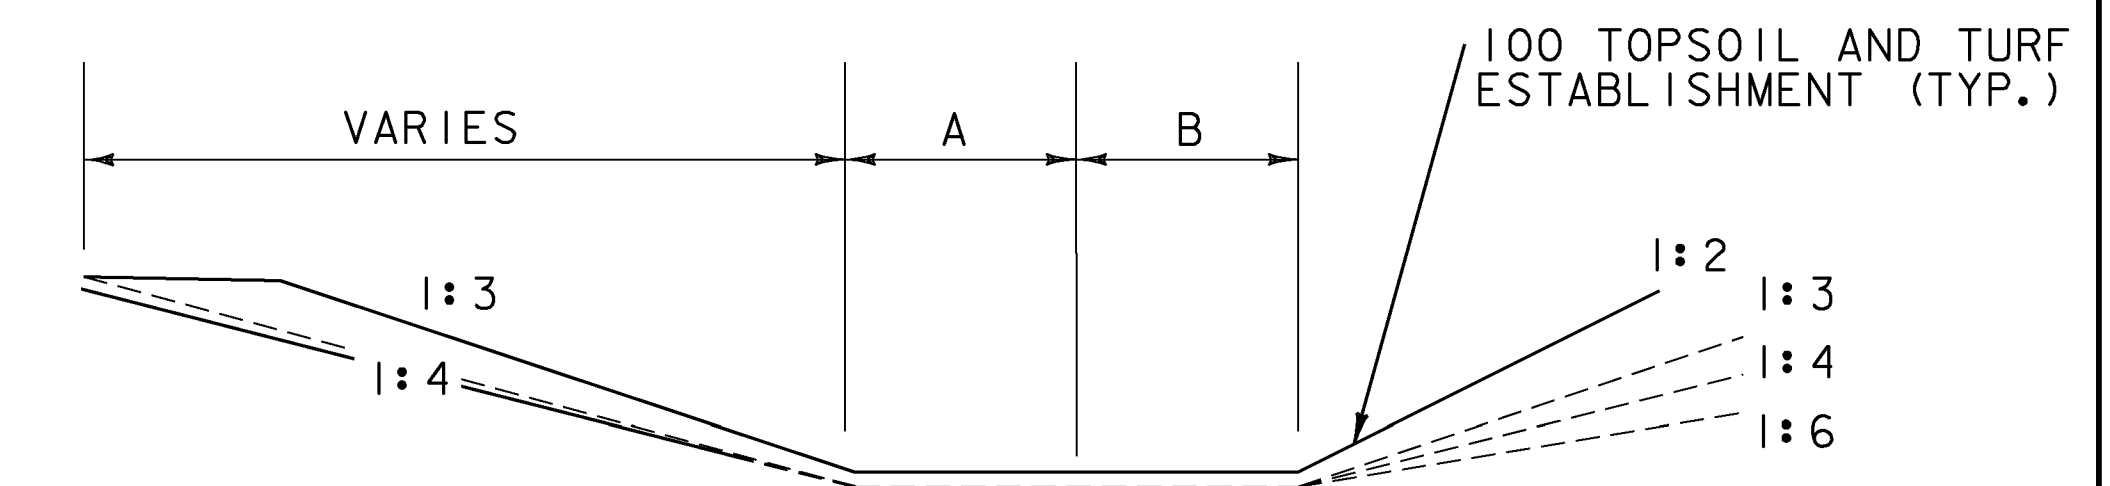

	A	B	STATION
GRASS CHANNEL 1-A	1220	1220	14+150 RT - 14+205 RT
GRASS CHANNEL 1-B	915	915	14+045 LT - 14+091 LT
GRASS CHANNEL 1-C	1220	1220	14+040 RT - 14+071 RT


GRASS CHANNEL
VT ROUTE 14

FOR TURF ESTABLISHMENT DETAILS
SEE EPSC DETAILS SHEET 2


PROJECT NAME: EAST MONTPELIER
PROJECT NUMBER: STPG 028 - 3(35)S

FILE NAME: +98b028+typ.dgn
PROJECT LEADER: J. SCHULTZ
DESIGNED BY: J. GRUCHACZ
TYPICAL SHEET 3


PLOT DATE: 22-MAR-2010
DRAWN BY: I. DEGUTIS
CHECKED BY: J. DEVLIN
SHEET 5 OF 142

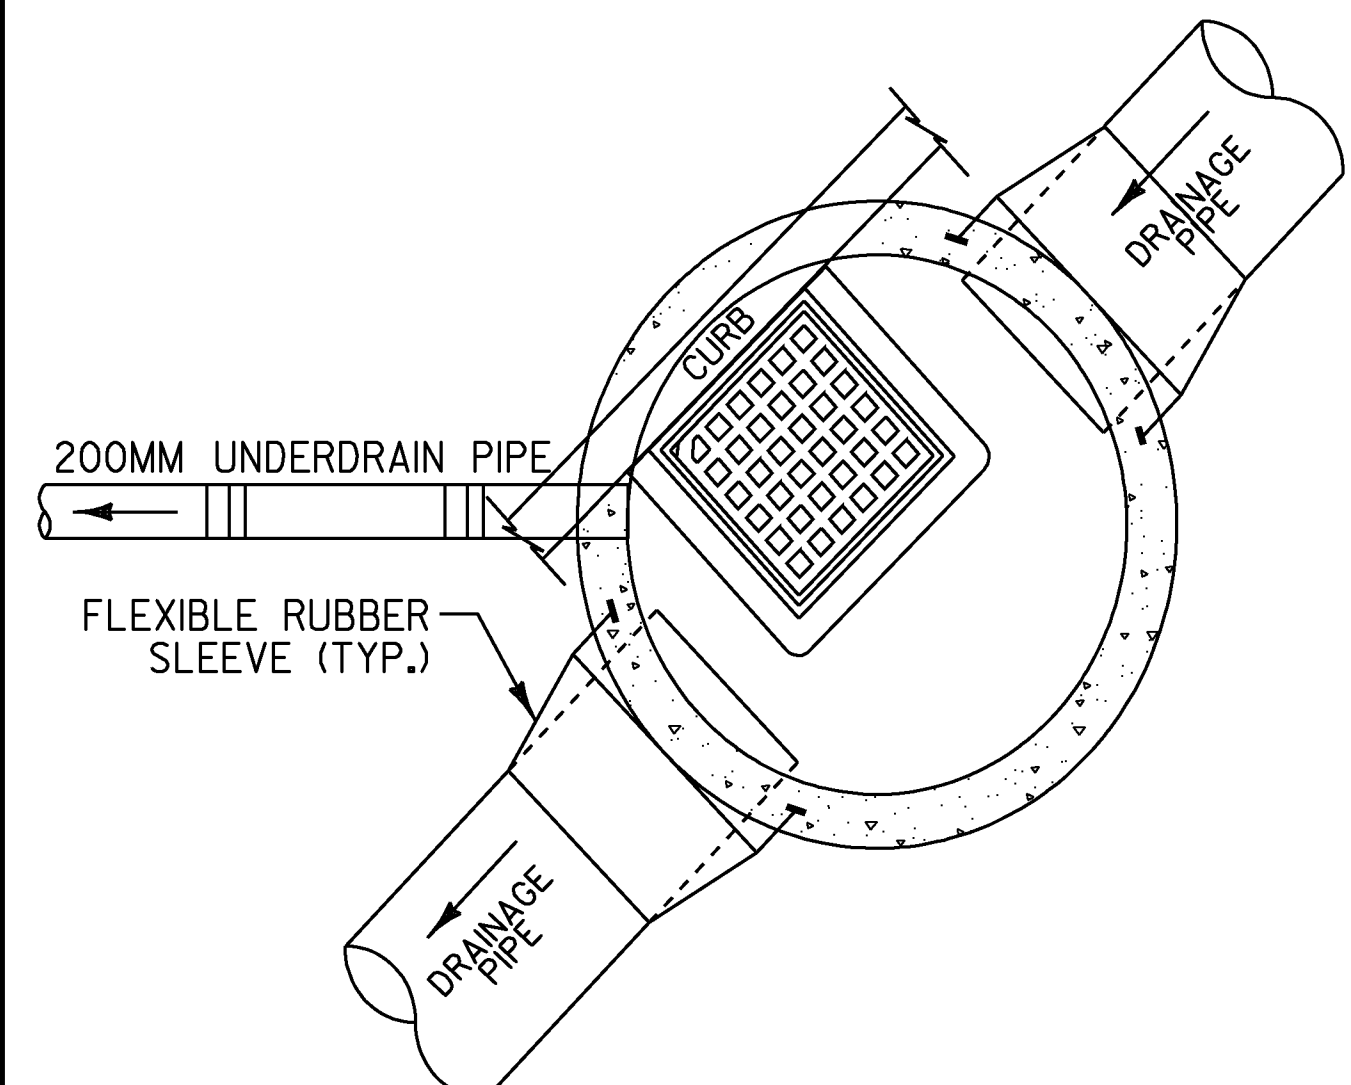


**CATCH BASIN (PLAN)
WITH UNDERDRAIN**
NOT TO SCALE

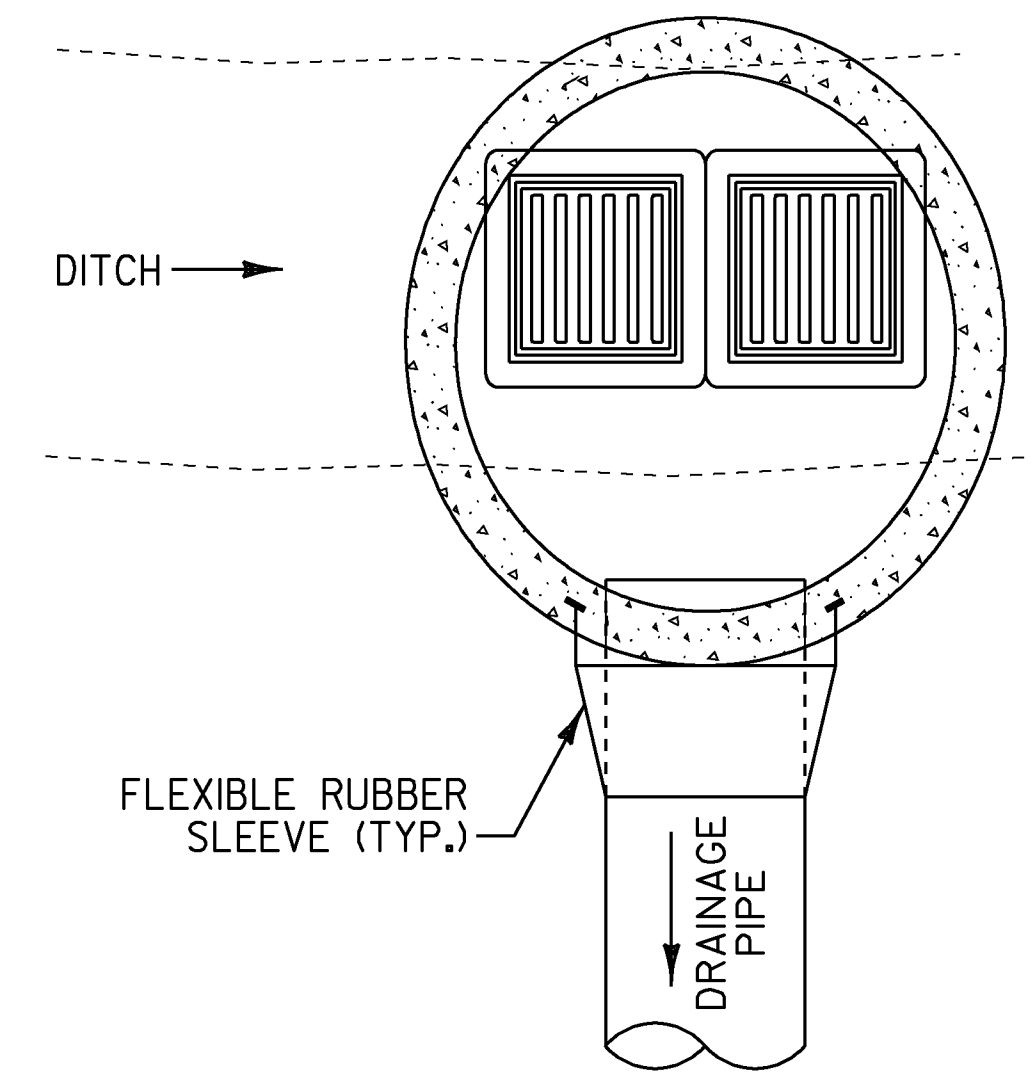


DOUBLE GRATE CATCH BASIN (PLAN)
NOT TO SCALE

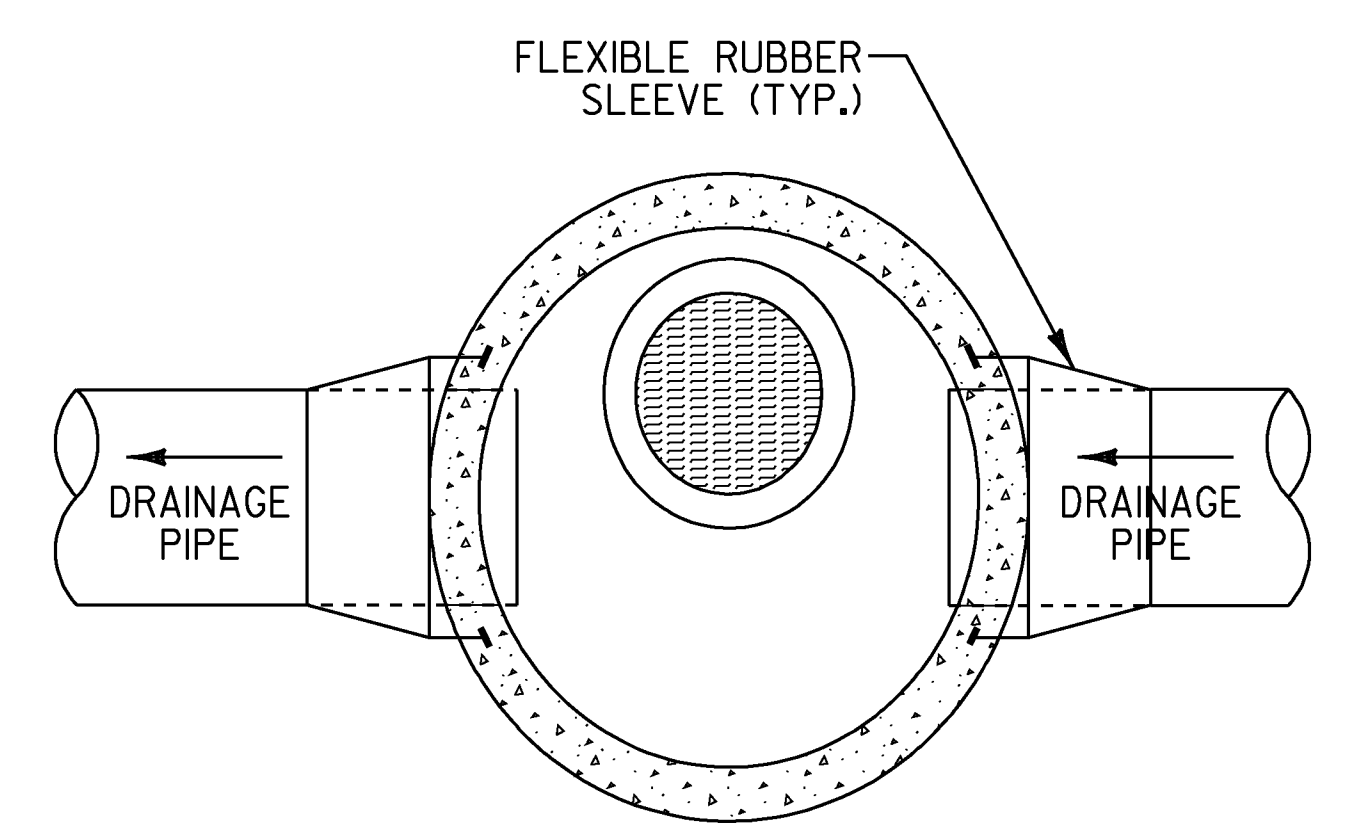


MANHOLE (PLAN)
NOT TO SCALE

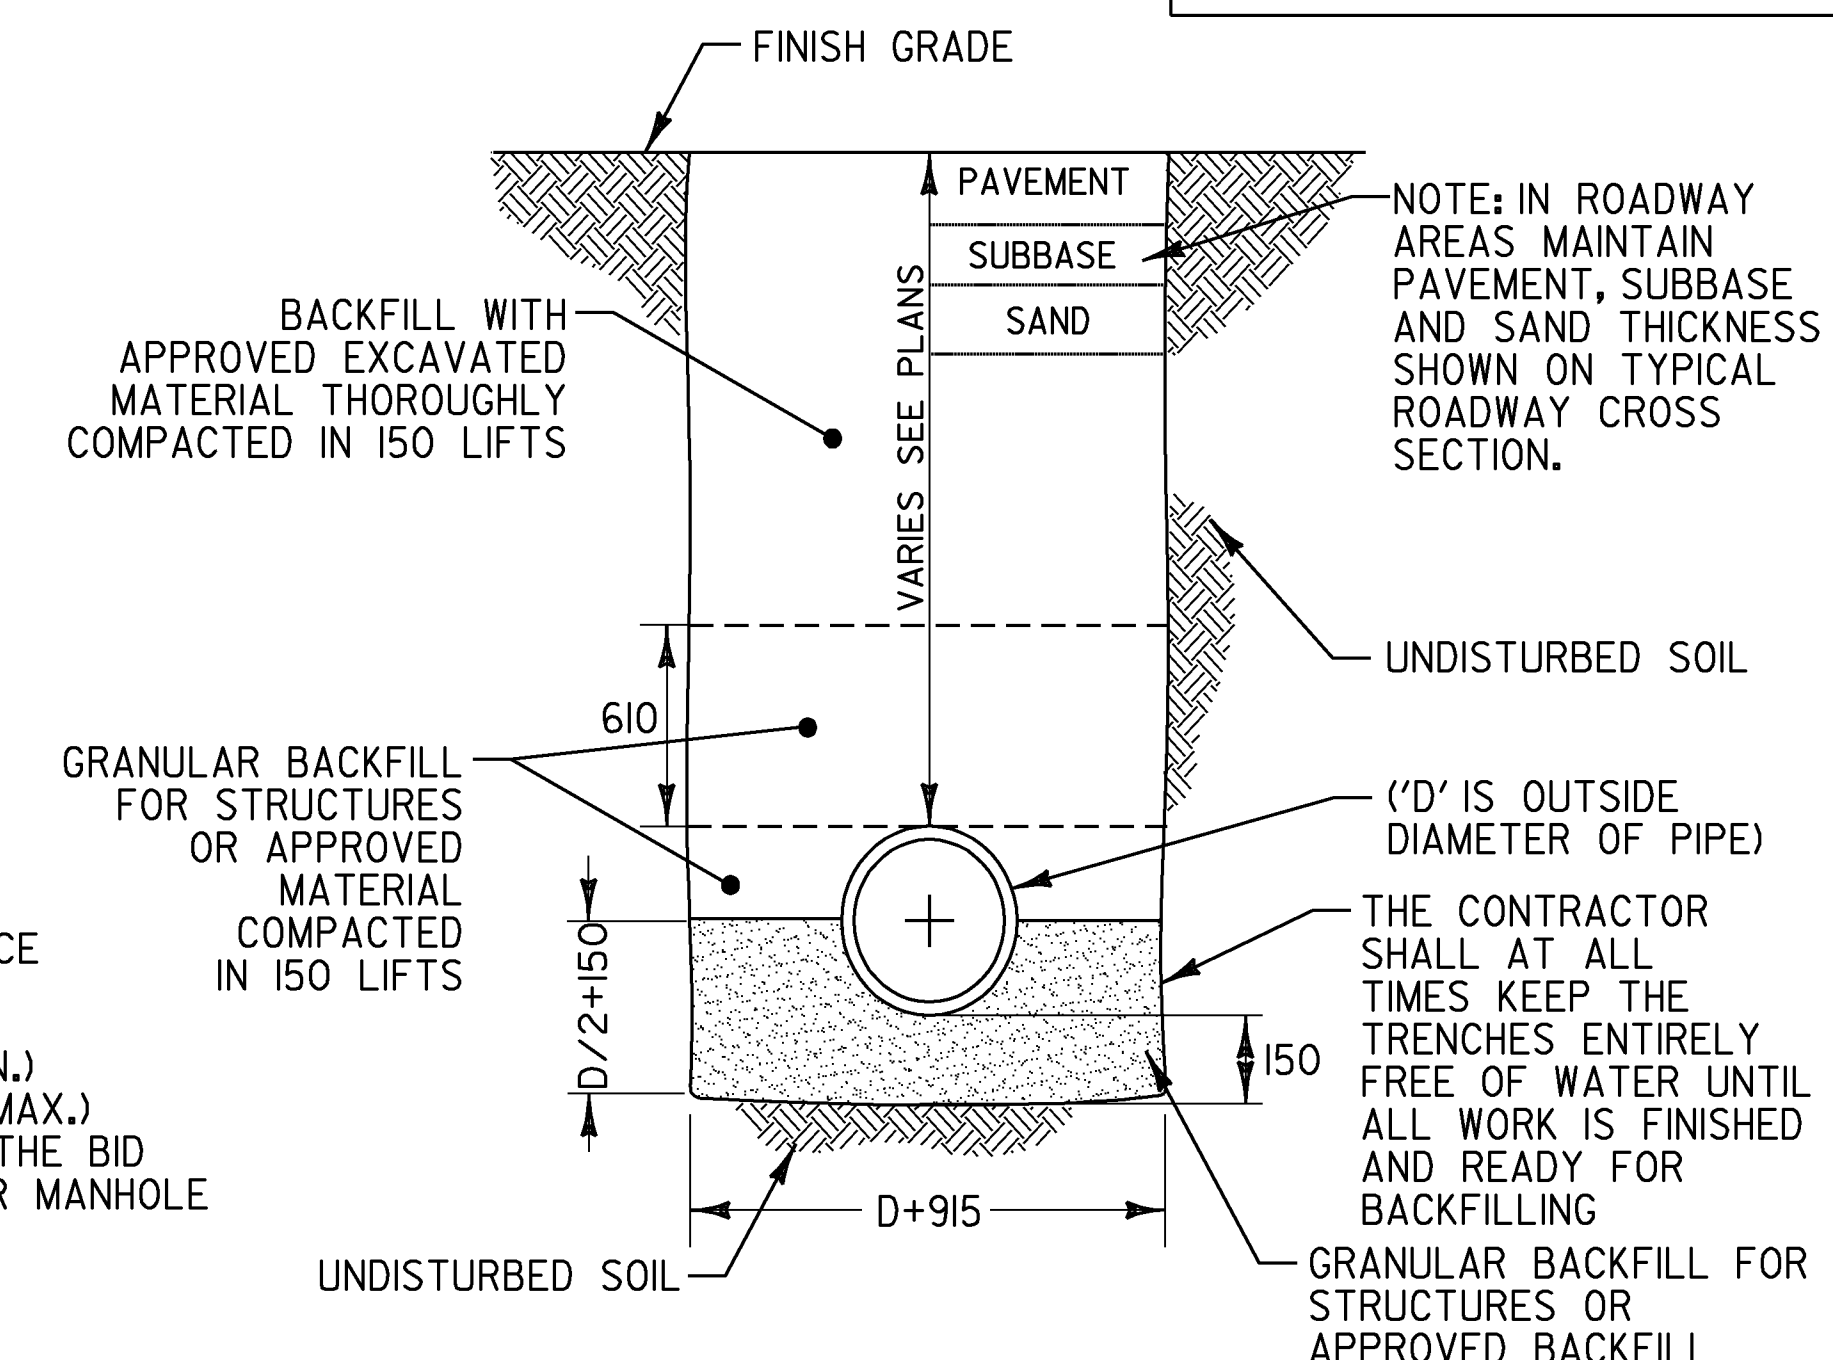


**TYPICAL STORM DRAIN
AND PIPE SLEEVE TRENCH**
NOT TO SCALE

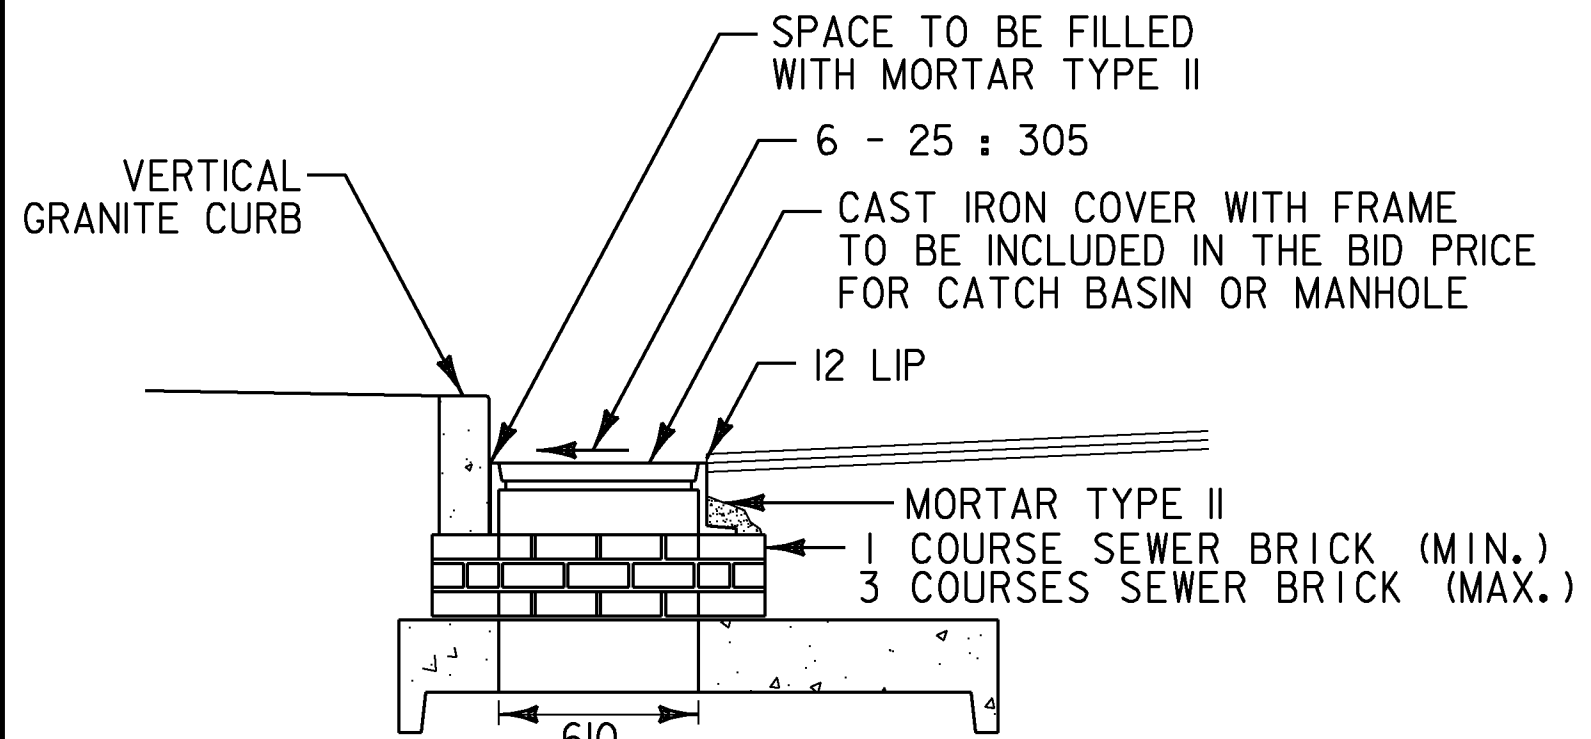


**TYPICAL GRATE INSTALLATION WITH
VERTICAL GRANITE CURB (ELEVATION)**
NOT TO SCALE

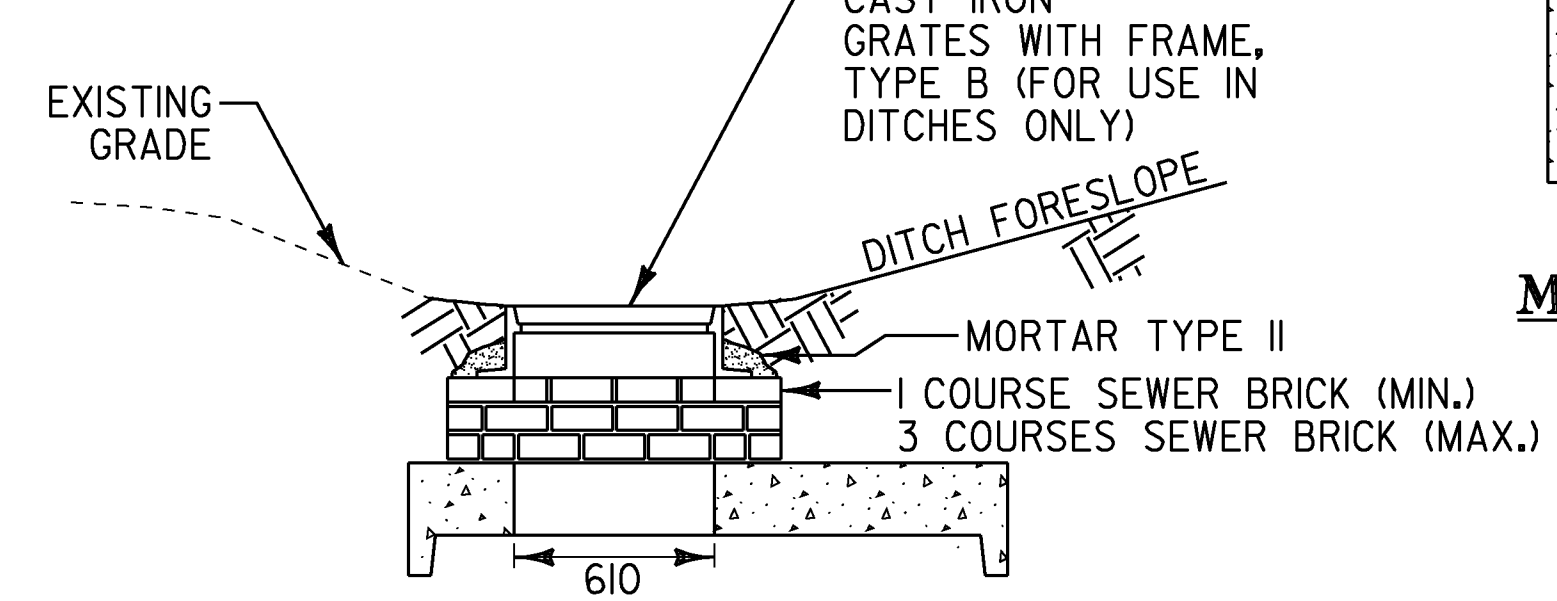


**TYPICAL GRATE INSTALLATION
IN DITCH (ELEVATION)**
NOT TO SCALE

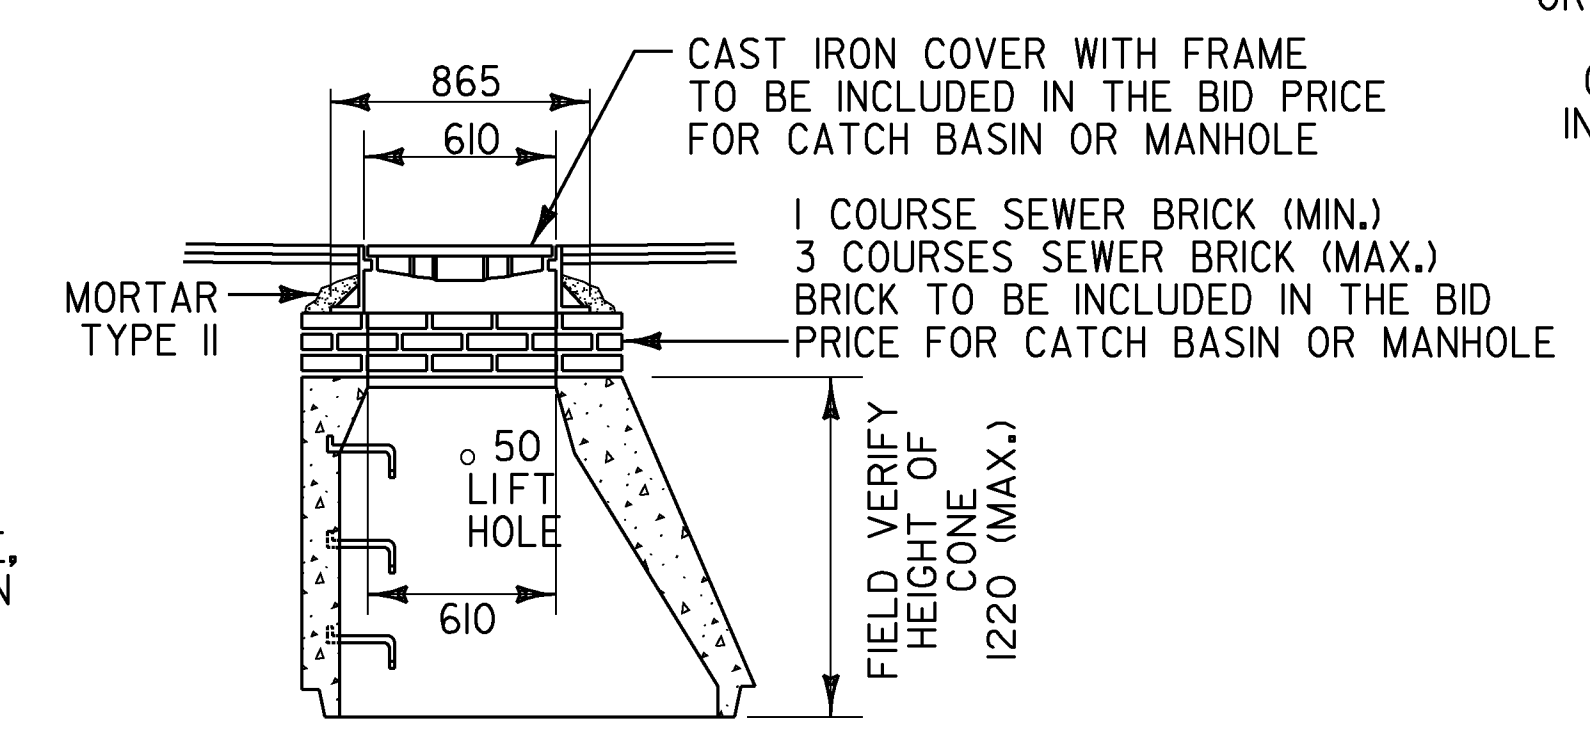

MANHOLE CONE SECTION
NOT TO SCALE

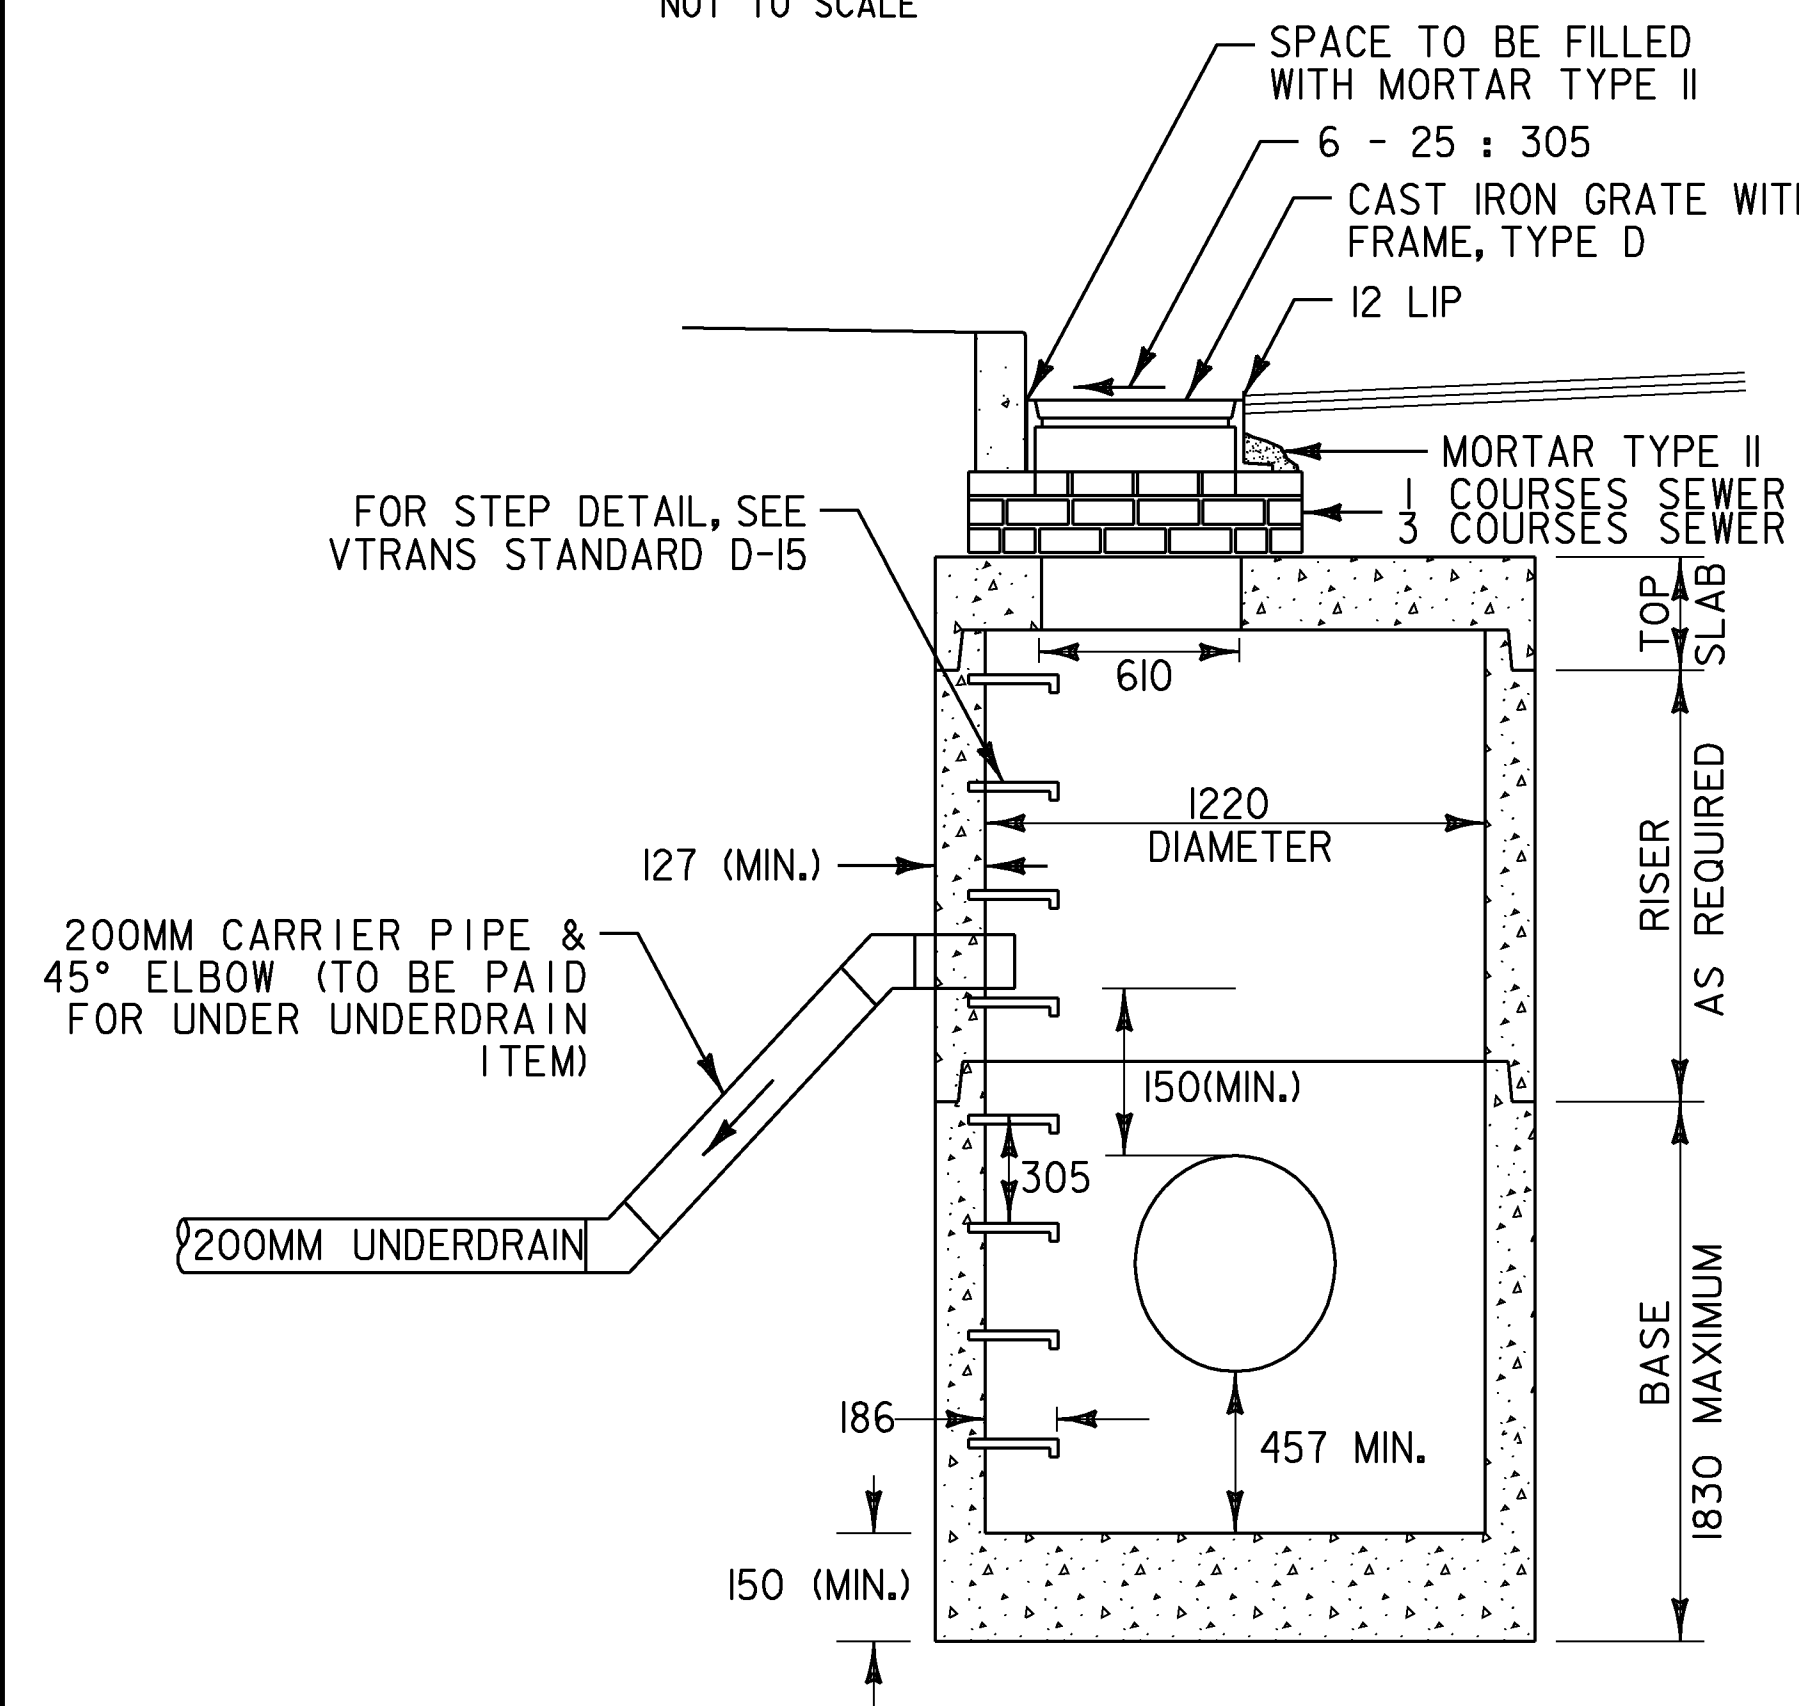

ELEVATION VIEW

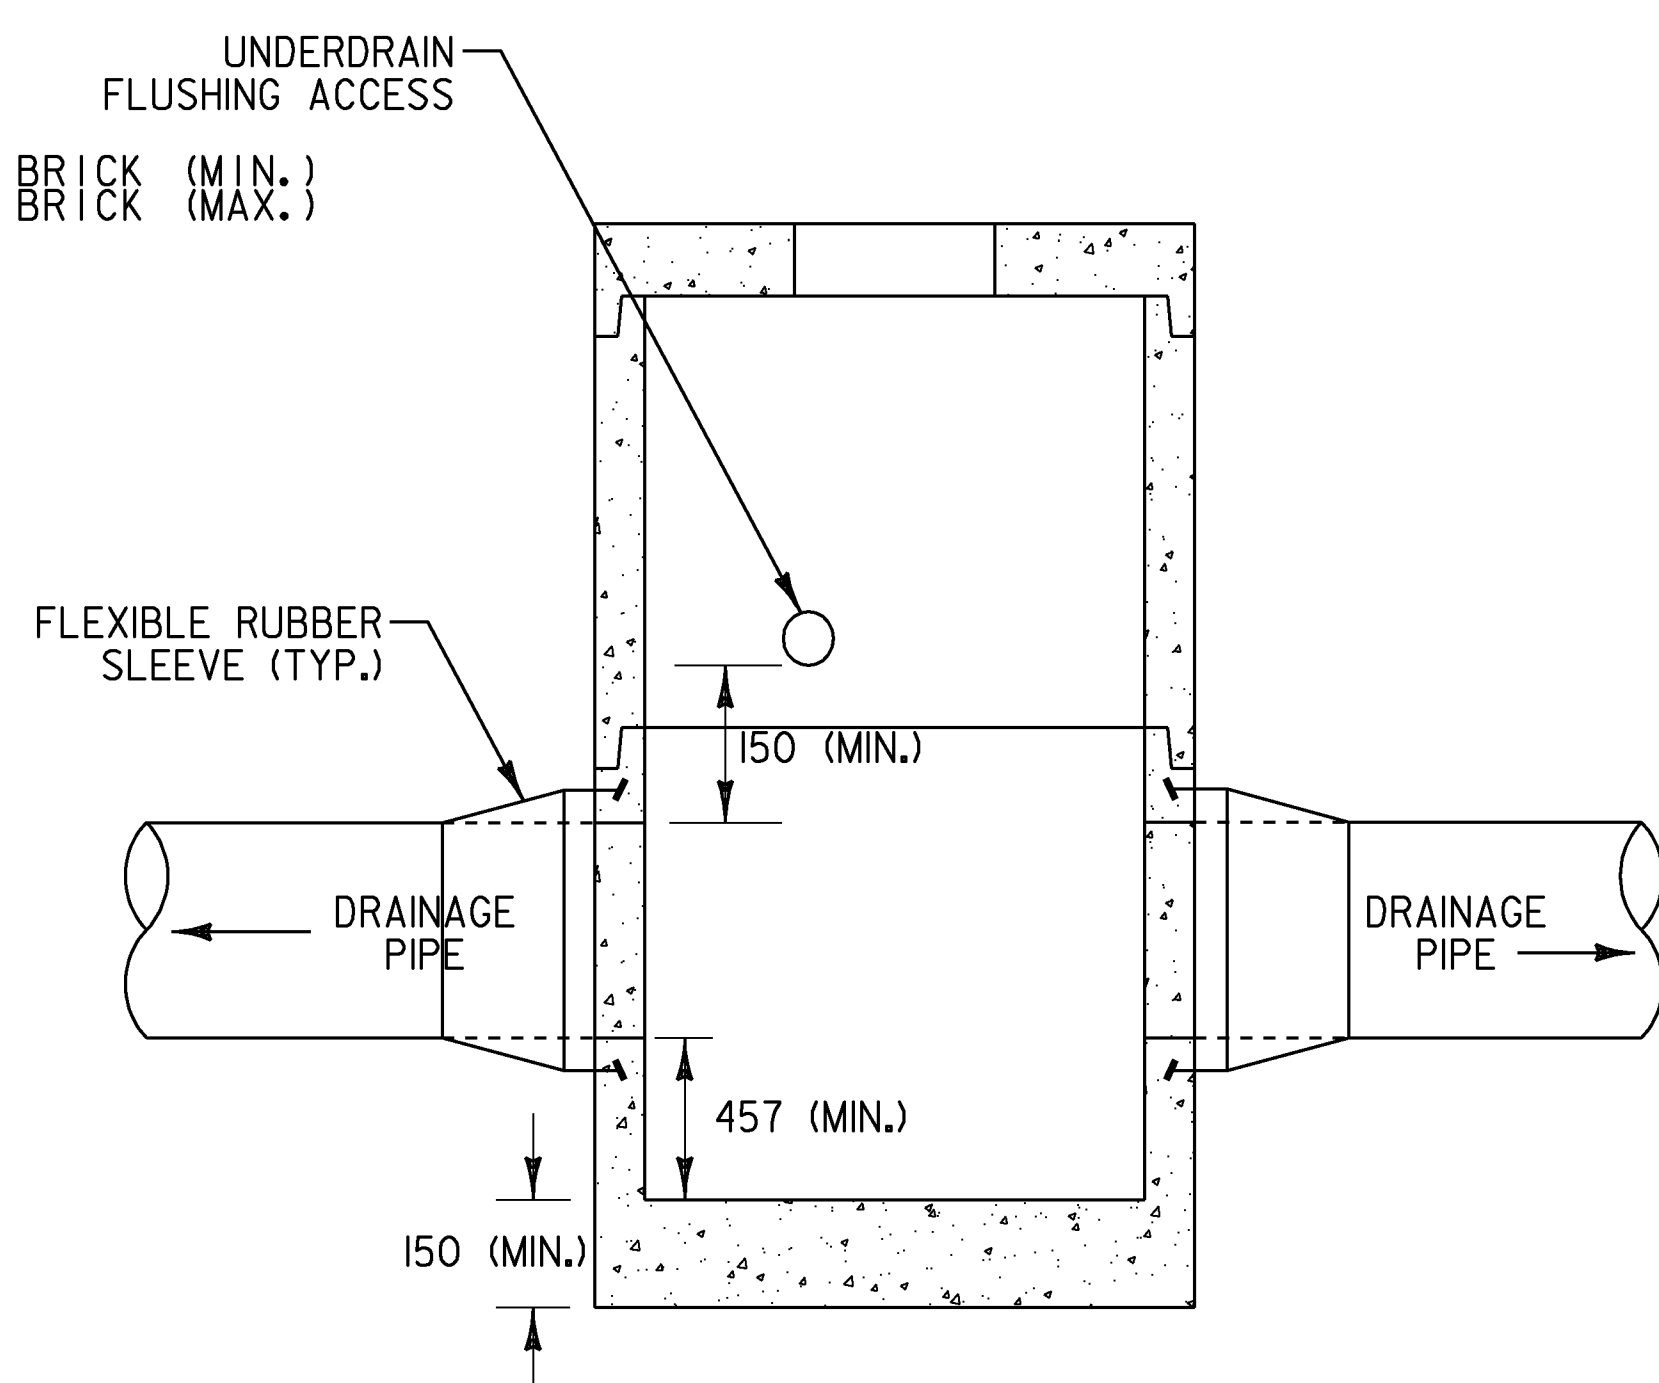

SIDE VIEW

**TYPICAL PRECAST CATCH BASIN OR MANHOLE
WITH UNDERDRAIN FLUSHING ACCESS**

NOT TO SCALE

PRECAST REINFORCED CONCRETE CATCH BASIN NOTES:

1. PRECAST CONCRETE SECTIONS SHALL CONFORM TO SECTION 705.04 OF THE STANDARD SPECIFICATIONS.
2. MINIMUM CONCRETE COMPRESSIVE STRENGTH: 4,000 PSI AT 28-DAYS
3. STEEL REINFORCING SHALL CONFORM TO SECTION 713.01 OF THE STANDARD SPECIFICATIONS.
4. MANHOLE STEPS SHALL BE 356 WIDE STEEL REINFORCED COPOLYMER POLYPROPYLENE PLASTIC CONFORMING TO SECTION 705.04 OF THE STANDARD SPECIFICATIONS AND SHALL BE CAST INTO MANHOLE SECTIONS BY THE PRECAST CONCRETE MANUFACTURER.
5. FACE OF PIPE SHALL NOT PROJECT MORE THAN 50 OR LESS THAN 25 FROM INSIDE WALL OF STRUCTURE.
6. ALL STRUCTURES WITH MULTIPLE PIPES SHALL HAVE A MINIMUM OF 305 OF OUTSIDE SURFACE BETWEEN HOLES, NO MORE THAN 75% OF A HORIZONTAL CROSS-SECTION SHALL BE HOLES, AND THERE SHALL BE NO HOLES CLOSER THAN 75 TO JOINTS.
7. FITTING FRAME TO FINAL GRADE MAY BE DONE WITH BRICK OR PRECAST CONCRETE GRADE RINGS OF APPROPRIATE THICKNESS (3 COURSES MAX).
8. FLAT SLAB TOPS SHALL BE USED FOR ALL CATCH BASINS UNLESS OTHERWISE PERMITTED BY THE ENGINEER.
9. ALL PIPE INVERTS AND PENETRATION ANGLES SHALL BE FIELD VERIFIED PRIOR TO PRECASTING.
10. PRECAST SECTIONS SHALL HAVE A TONGUE AND GROOVE JOINT AND BE ASSEMBLED USING A BUTYL RUBBER OR APPROVED EQUAL SEALANT.
11. PROVIDE FLEXIBLE RUBBER SLEEVES CONFORMING TO ASTM C-923, RESILIENT, OF SIZE REQUIRED, FOR EACH PIPE CONNECTING TO STRUCTURE. SLEEVES SHALL BE CAST INTO PRECAST STRUCTURE BY THE MANUFACTURER FOR ALL PIPE PENETRATIONS.
12. PAYMENT FOR INSTALLATION OF THE CATCH BASINS SHALL BE MADE UNDER THE PRECAST REINFORCED CONCRETE CATCH BASIN WITH CAST IRON GRATE ITEM (604.20).

PROJECT NAME: EAST MONTPELIER
PROJECT NUMBER: STPG 028 - 3(35)S

FILE NAME: +98b028+yp.dgn
PROJECT LEADER: J. SCHULTZ
DESIGNED BY: J. GRUCHACZ
DRAINAGE STRUCTURE DETAIL SHEET


PLOT DATE: 22-MAR-2010
DRAWN BY: D. LYMAN
CHECKED BY: J. DEVLIN
SHEET 6 OF 142

MATERIAL TOLERANCES		
PAVEMENT (TOTAL DEPTH):	±	5
SUBBASE (TOTAL DEPTH):	±	30
SAND BORROW (TOTAL DEPTH):	±	30


TYPICAL SECTIONS

NOT TO SCALE

45 SUPERPAVE BITUMINOUS CONCRETE PAVEMENT (TYPE 111S) - (1 - 45 LIFT)
 170 SUPERPAVE BITUMINOUS CONCRETE PAVEMENT (TYPE 11S) - (2 - 85 LIFTS)
 610 SUBBASE OF DENSE GRADED CRUSHED STONE
 610 SAND BORROW

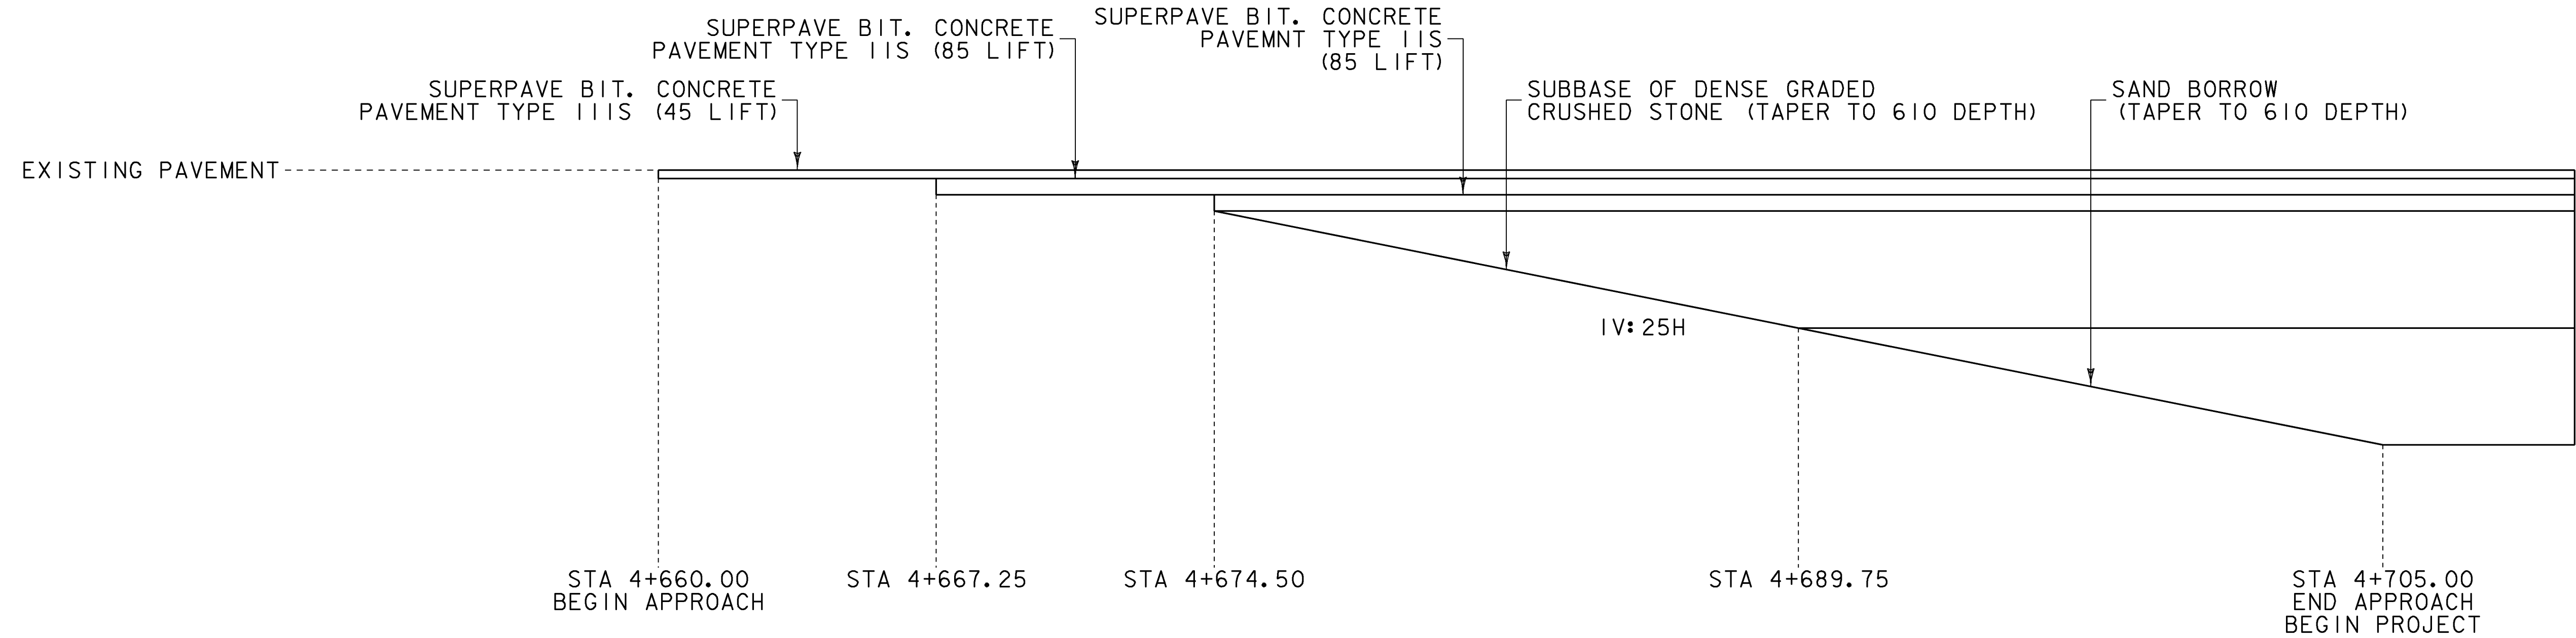

**US ROUTE 2
 BEGIN PROJECT MATERIAL TRANSITION DETAIL**

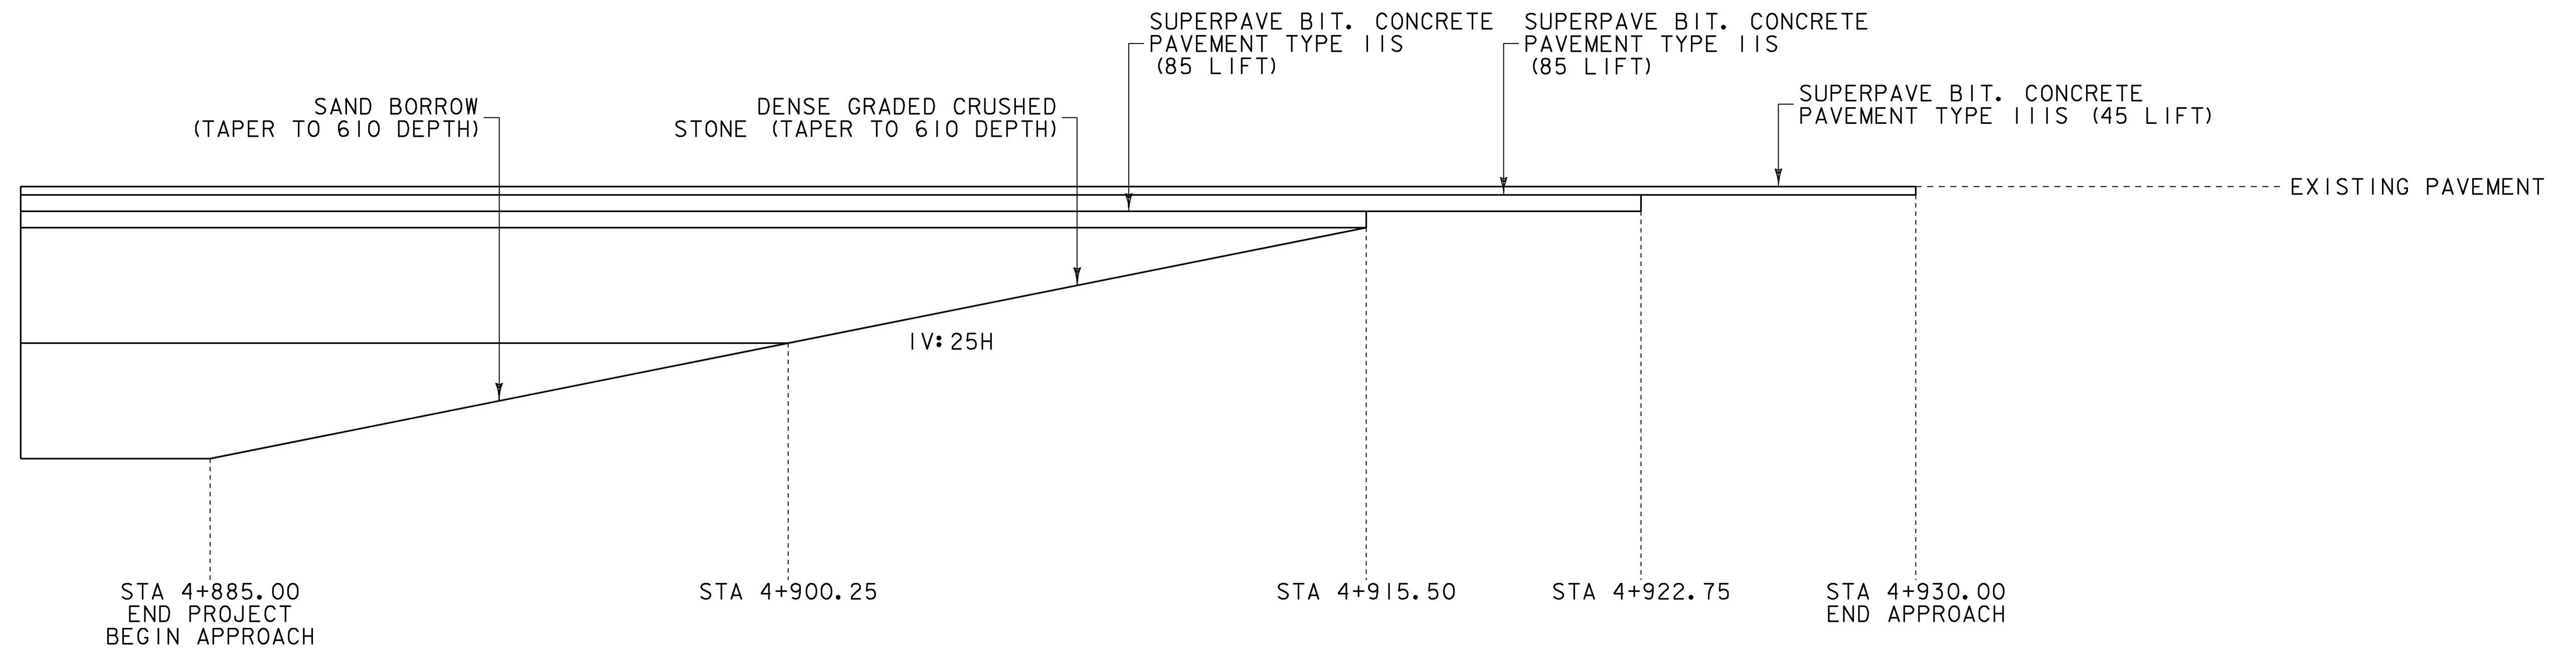

**US ROUTE 2
 END PROJECT MATERIAL TRANSITION DETAIL**

PROJECT NAME: EAST MONTPELIER
 PROJECT NUMBER: STPG 028 - 3(35)S

FILE NAME: +98b028+typ.dgn
 PROJECT LEADER: J. SCHULTZ
 DESIGNED BY: J. GRUCHACZ
 MATERIAL TRANSITION SHEET 1


PLOT DATE: 22-MAR-2010
 DRAWN BY: I. DEGUTIS
 CHECKED BY: J. DEVLIN
 SHEET 7 OF 142

MATERIAL TOLERANCES		
PAVEMENT (TOTAL DEPTH):	±	5
SUBBASE (TOTAL DEPTH):	±	30
SAND BORROW (TOTAL DEPTH):	±	30


TYPICAL SECTIONS

NOT TO SCALE


45 SUPERPAVE BITUMINOUS CONCRETE PAVEMENT (TYPE 111S) - (1 - 45 LIFT)
 170 SUPERPAVE BITUMINOUS CONCRETE PAVEMENT (TYPE 11S) - (2 - 85 LIFTS)
 610 SUBBASE OF DENSE GRADED CRUSHED STONE
 610 SAND BORROW

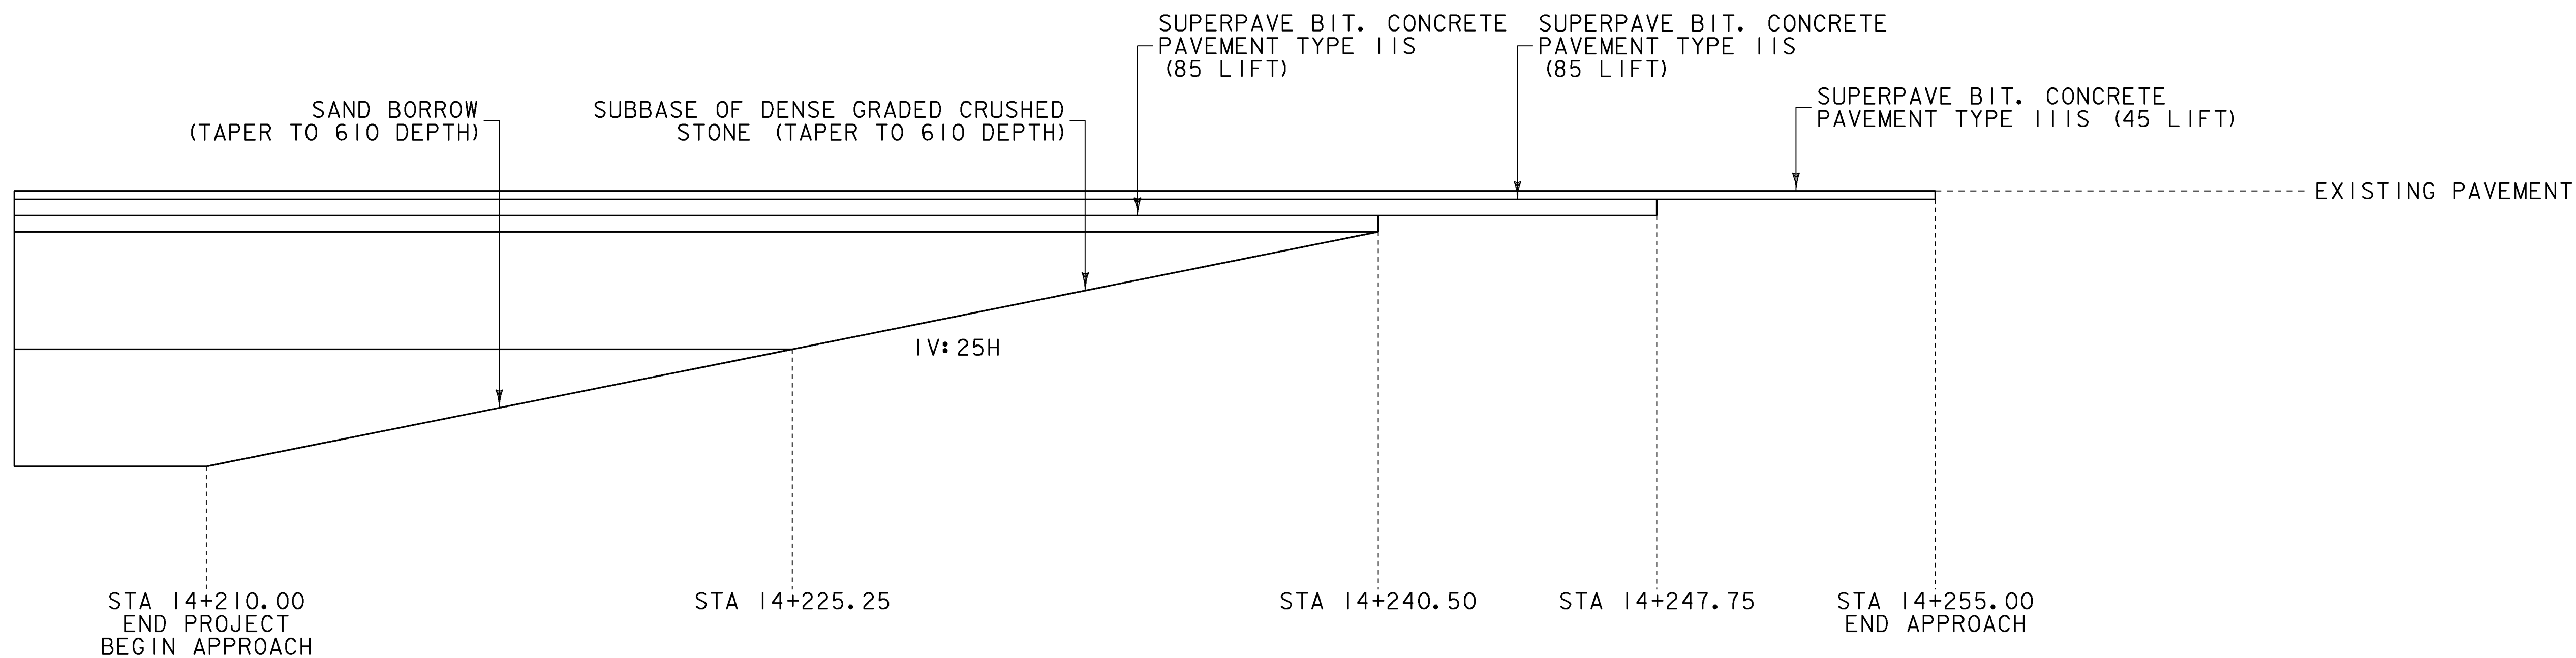

**VT ROUTE 14
 END PROJECT MATERIAL TRANSITION DETAIL**

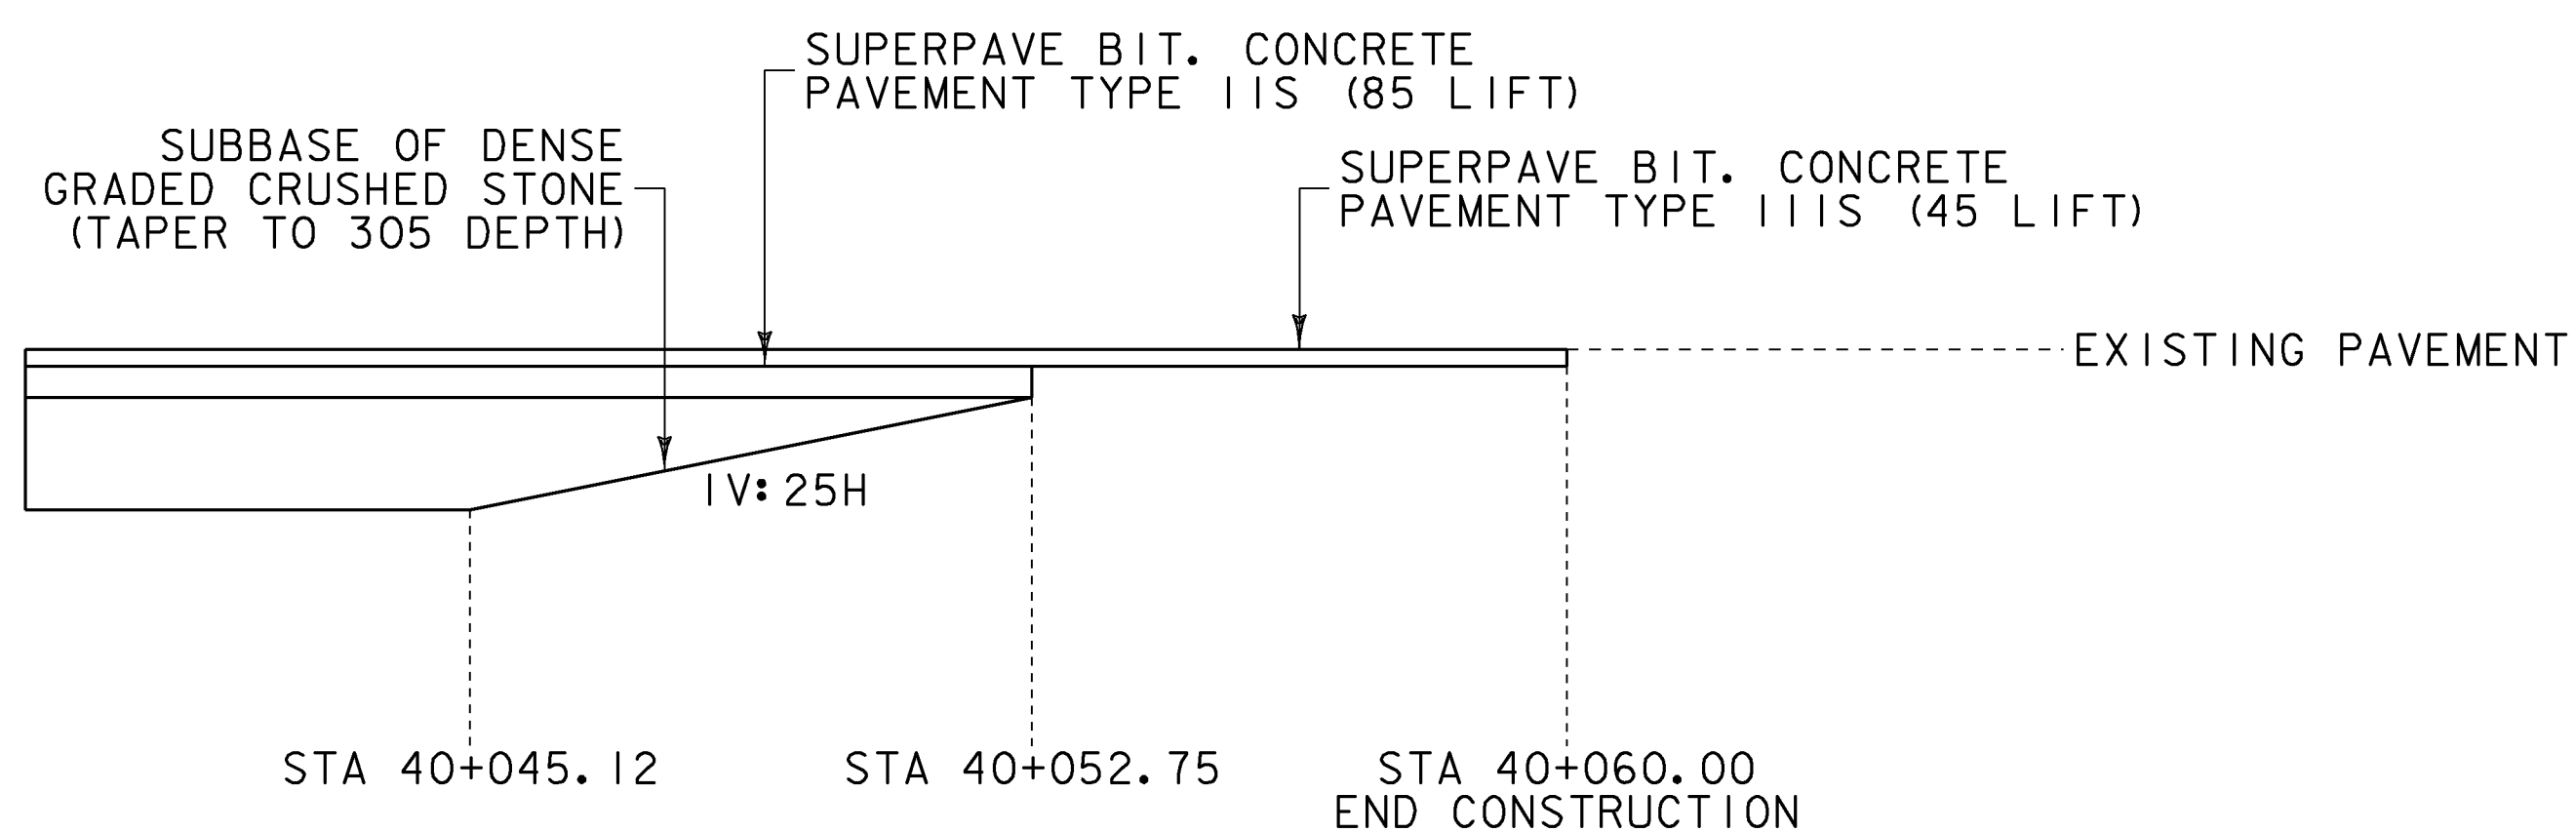

**QUAKER HILL ROAD
 END PROJECT MATERIAL TRANSITION DETAIL**

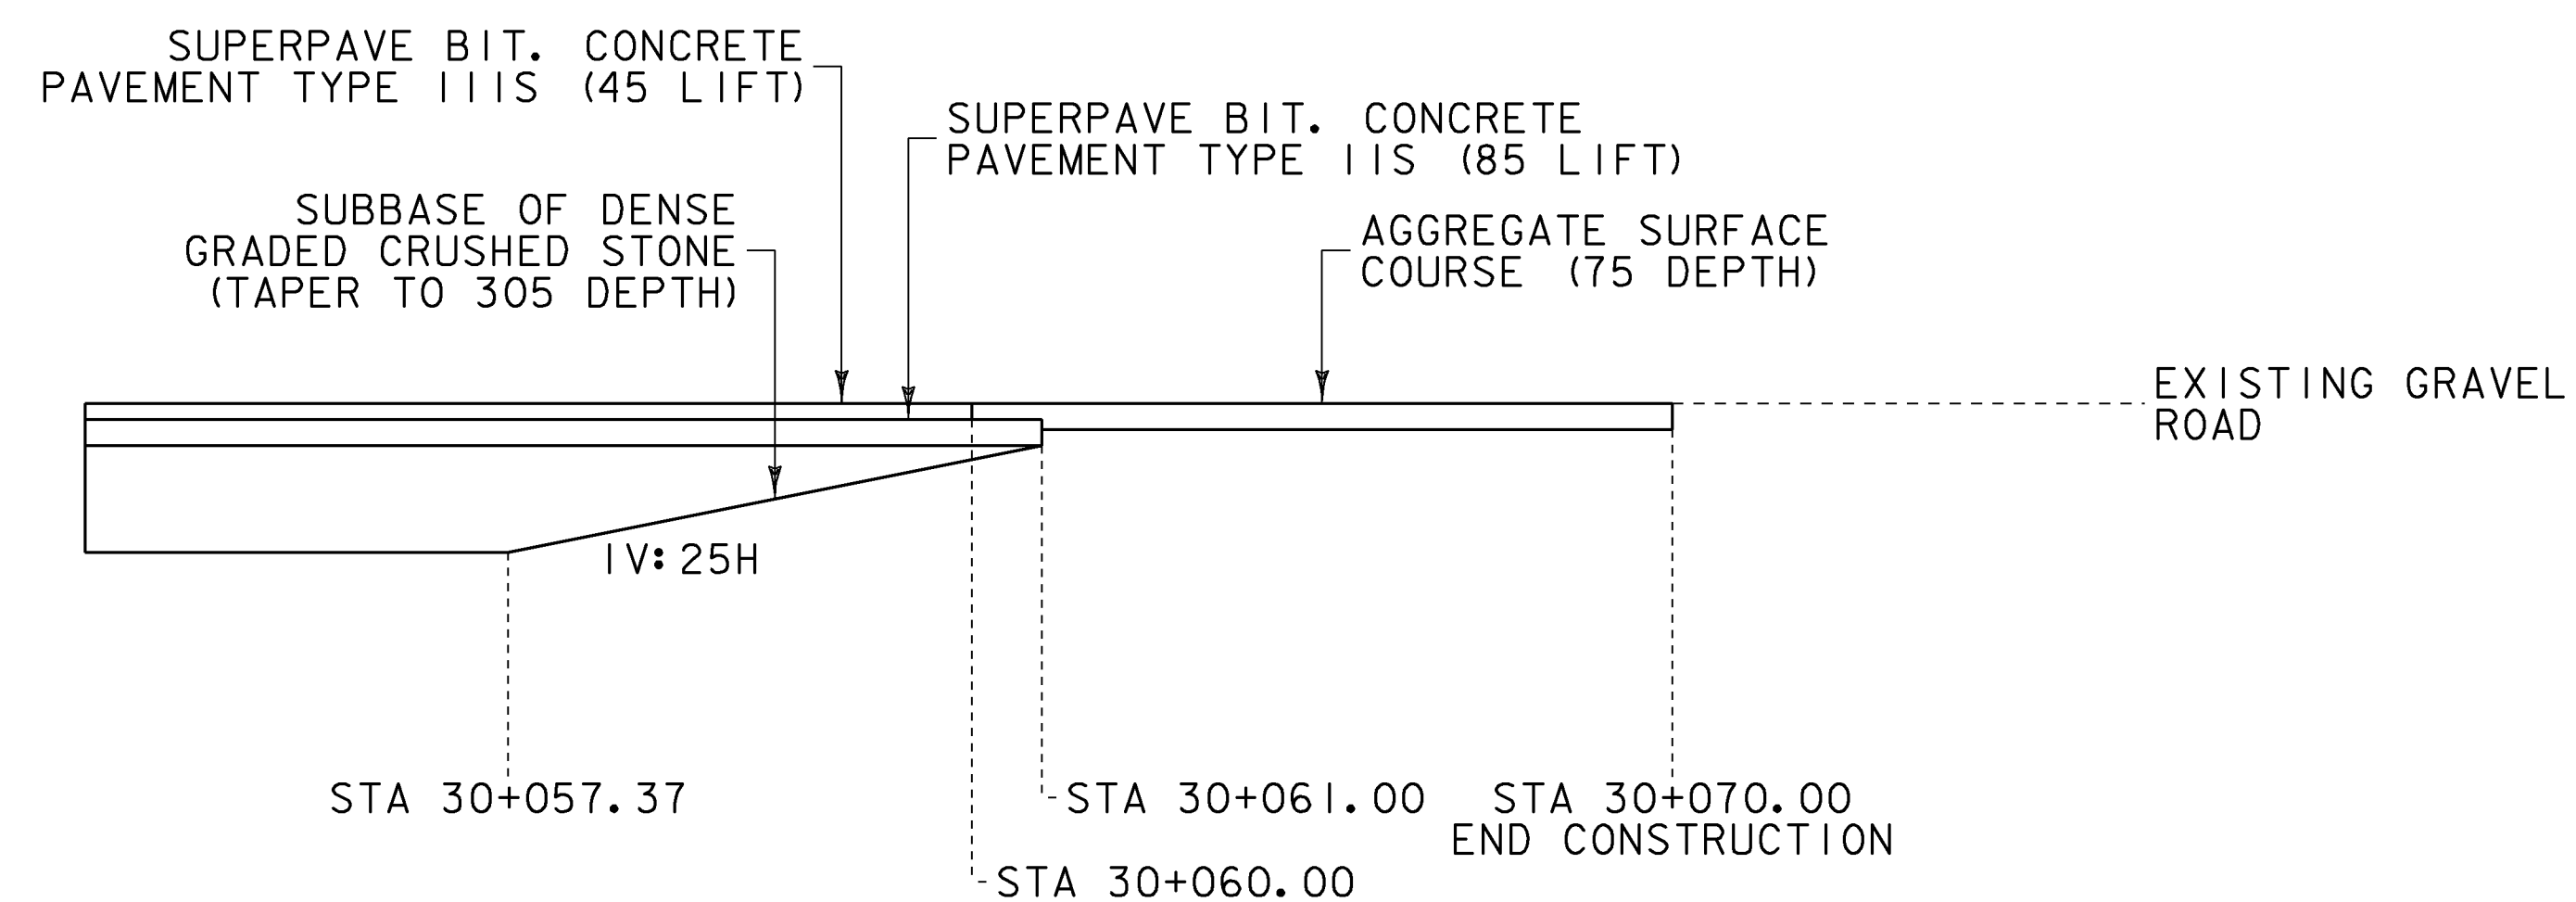

**KELTON ROAD
 END PROJECT MATERIAL TRANSITION DETAIL**

PROJECT NAME: EAST MONTPELIER
 PROJECT NUMBER: STPG 028 - 3(35)S

FILE NAME: +98b028+typ.dgn
 PROJECT LEADER: J. SCHULTZ
 DESIGNED BY: J. GRUCHACZ
 MATERIAL TRANSITION SHEET 2
 PLOT DATE: 22-MAR-2010
 DRAWN BY: I. DEGUTIS
 CHECKED BY: J. DEVLIN
 SHEET 8 OF 142

STATE OF VERMONT
AGENCY OF TRANSPORTATION

QUANTITY SHEET 1

SUMMARY OF ESTIMATED QUANTITIES										TOTALS		DESCRIPTIONS				DETAILED SUMMARY OF QUANTITIES		
ROADWAY	TRAINING	LANDSCAPING	EROSION CONTROL	UTILITIES - BOTTLENECKS (NO FEDERAL/STATE PARTICIPATION)	FULL CE ITEMS	GRAND TOTAL	FINAL	UNIT	ITEMS	ITEM NUMBER	ROUND	QUANTITIES	UNIT	ITEMS				
1						1	1	LS	CLEARING AND GRUBBING, INCLUDING INDIVIDUAL TREES AND STUMPS	201.10	-	203.15 COMMON EXCAVATION						
1						1	1	EACH	DEMOLITION AND DISPOSAL OF BUILDING	202.10	-	3746	CM	US ROUTE 2				
7000						7000	7287.29	CM	COMMON EXCAVATION	203.15	122	2369	CM	VT ROUTE 14				
415						415	334.2	CM	SOLID ROCK EXCAVATION	203.16	7	249	CM	QUAKER HILL ROAD				
22						22	303.562	CM	EXCAVATION OF SURFACES AND PAVEMENTS	203.16	7	81	CM	KELTON ROAD				
3675						3675	3801.5	CM	SAND BORROW	203.28	1	208	CM	PARKING LOT				
2650						2650	2224.93	CM	TRENCH EXCAVATION OF EARTH	203.16	7	225	CM	DRIVES				
20						20	15.04	CM	TRENCH EXCAVATION OF ROCK	203.28	1	6878	CM	SUB TOTAL				
1						1	0	CM	TRENCH EXCAVATION OF EARTH, EXPLORATORY (N.A.B.I.)	203.31	54	122	CM	ROUNDING				
500						500	1004.08	CM	GRANULAR BACKFILL FOR STRUCTURES	204.20	53	7000	CM	TOTAL				
500						500	1980.6	SM	COLD PLANING, BITUMINOUS PAVEMENT	204.21	1	203.31 SAND BORROW						
5000						5000	5598.68	CM	SUBBASE OF DENSE GRADED CRUSHED STONE	204.22	-	1563	CM	US ROUTE 2				
28						28	10.75	CM	AGGREGATE SURFACE COURSE	204.30	12	2058	CM	VT ROUTE 14				
1740						1740	2432.8	KG	EMULSIFIED ASPHALT	204.30	12	3621	CM	SUB TOTAL				
1						1	1093.05	LU	PRICE ADJUSTMENT, ASPHALT CEMENT (N.A.B.I.)	210.10	36	54	CM	ROUNDING				
4000						4000	3689.21	T	SUPERPAVE BITUMINOUS CONCRETE PAVEMENT	301.35	148	3675	CM	TOTAL				
1						1	5497.85	LU	AIR VOIDS PAY ADJUSTMENT (N.A.B.I.)	401.10	1.4	210.10 COLD PLANING, BITUMINOUS PAVEMENT						
1						1	772.92	LU	MAT DENSITY PAY ADJUSTMENT (N.A.B.I.)	401.10	1.4	276	SM	US ROUTE 2				
370						370	363	KG	REINFORCNG STEEL	404.65	30	127	SM	VT ROUTE 14				
5						5	4.3	CM	CONCRETE, CLASS B	406.50	-	61	SM	QUAKER HILL ROAD				
23						23	33.7	M	375 CPEP(SL)	490.30	119	464	SM	SUB TOTAL				
23						23	--	M	375 RCP CLASS III	490.31	-	36	SM	ROUND				
250						250	240	M	450 CPEP(SL)	490.32	-	500	SM	TOTAL				
250						250	--	M	450 RCP CLASS III	507.15	7	301.35 SUBBASE OF DENSE GRADED CRUSHED STONE						
120						120	118.3	M	600 CPEP(SL)	541.25	0.7	1916	CM	US ROUTE 2				
120						120	--	M	600 RCP CLASS III	601.2610	-	1985	CM	VT ROUTE 14				
109						109	107	M	900 CPEP(SL)	601.0810	-	160	CM	QUAKER HILL ROAD				
109						109	--	M	900 RCP CLASS III	601.0815	-	115	CM	KELTON ROAD				
9.1						9.1	9.1	M	900 CPEP	601.2620	-	472	CM	PARKING LOT				
13						13	14	EACH	PRECAST REINFORCED CONCRETE CATCH BASIN WITH CAST IRON GRATE (1200MM)	601.2630	-	204	CM	DRIVES				
2						2	2	EACH	PRECAST REINFORCED CONCRETE CATCH BASIN WITH CAST IRON GRATE (1500MM)	601.2610	-	4852	CM	SUB TOTAL				
5						5	5	EACH	PRECAST REINFORCED CONCRETE CATCH BASIN WITH CAST IRON GRATE (1800MM)	601.0815	-	148	CM	ROUNDING				
						0	2	EACH	REHAB DI, CATCH BASIN, MANHOLES, CLASS II SA/CO #13 9-19-II	604.20	-	5000	CM	TOTAL				

PROJECT NAME: EAST MONTPELIER
 PROJECT NUMBER: STPG 028 - 3(35)S
 FILE NAME: t98b028frm.dgn
 PROJECT LEADER: J. SCHULTZ
 DESIGNED BY: J. GRUCHACZ
 QUANTITY SHEET 1
 PLOT DATE: 29-MAR-2010
 DRAWN BY: I. DEGUTIS
 CHECKED BY: J. DEVLIN
 SHEET 9 OF 142

STATE OF VERMONT
AGENCY OF TRANSPORTATION

QUANTITY SHEET 2

SUMMARY OF ESTIMATED QUANTITIES										TOTALS		DESCRIPTIONS				DETAILED SUMMARY OF QUANTITIES			
										GRAND TOTAL	FINAL	UNIT	ITEMS	ITEM NUMBER	ROUND	QUANTITIES	UNIT	ITEMS	
										160	127	M	200 MM UNDERDRAIN PIPE	605.11	3				
										7	6	M	200 MM UNDERDRAIN CARRIER PIPE	605.21	1				
										1	1	EACH	UNDERDRAIN FLUSHING BASIN	605.95	-				
										1000	43.1	CM	DUST CONTROL WITH WATER	609.10	6				
										0.7	0	T	DUST AND ICE CONTROL WITH CALCIUM CHLORIDE	609.15	0.1				
										70	394.302	CM	STONE FILL, TYPE II	613.11	2				
										17	15.6	M	GRANITE SLOPE EDGING	616.20	1				
										440	440.9	M	VERTICAL GRANITE CURB	616.21	7				
										285	281.01	SM	PORTLAND CEMENT CONCRETE SIDEWALK, 125 MM	618.10	4				
										6.5	5.18	SM	DETECTABLE WARNING SURFACE	618.30	0.2				
										6	0	M	REMOVAL OF EXISTING FENCE	620.55	0.5				
										40	41.9	M	HD STEEL BEAM GUARDRAIL, GALVANIZED	621.21	2				
										1	1	EACH	MANUFACTURED TERMINAL SECTION, TANGENT	621.51	-				
										7	6	EACH	ENERGY ABSORPTION ATTENUATOR	621.56	-				
										8	12	M	REMOVAL AND DISPOSAL OF GUARDRAIL	621.80	0.4				
										220	190.2	M	TEMPORARY TRAFFIC BARRIER	621.90	12.8				
										240	2009.34	M	REMOVE AND RESET TEMPORARY TRAFFIC BARRIER	621.95	8.8				
										16.5	13.9	M	SLEEVES FOR UTILITIES (1 X 600MM)	625.10	2.4				
										6	7	EACH	ADJUST ELEVATION OF VALVE BOX	629.20	-				
										800	812	HR	UNIFORMED TRAFFIC OFFICERS	630.10	73				
										2400	3478	HR	FLAGGERS	630.15	133				
											1	1	LS	FIELD OFFICE, ENGINEERS	631.10	-			
											1	1	LS	TESTING EQUIPMENT, CONCRETE	631.16	-			
											1	1	LS	TESTING EQUIPMENT, BITUMINOUS	631.17	-			
											3000	3000	DL	FIELD OFFICE TELEPHONE (N.A.B.I.)	631.26	-			
											520	520	HR	EMPLOYEE TRAINEESHIP	634.10	-			
											0	1	LS	MOBILIZATION/DEMOBILIZATION SA/CO #9 6-24-II	635.11	-			
											1	1	LS	MOBILIZATION/DEMOBILIZATION	635.11	-			
											0	1	LS	MOBILIZATION/DEMOBILIZATION SA/CO #II 9-19-II	635.11	-			
											1	1	LS	TRAFFIC CONTROL	641.10	-			
											0	1	LS	TRAFFIC CONTROL SA/CO #14 7-6-12	641.10	-			
											3	3	EACH	PORTABLE CHANGEABLE MESSAGE SIGN	641.15	-			
											165	163.1	M	DURABLE 100 MM WHITE LINE, POLYUREA	646.404	3			
											1225	1434.2	M	DURABLE 100 MM WHITE LINE, RECESSED POLYUREA	646.406	22			
											1530	1705	M	DURABLE 100 MM YELLOW LINE, RECESSED POLYUREA	646.416	27			
											270	242	M	DURABLE 200 MM YELLOW LINE, RECESSED POLYUREA	646.456	5			
											33	34	M	DURABLE 600 MM STOP BAR, TYPE I TAPE	646.481	0.5			
											71	79	EACH	DURABLE LETTER OR SYMBOL, TYPE I TAPE	646.491	-			
											32	31.5	M	DURABLE CROSSWALK MARKING, TYPE I TAPE	646.501	0.8			
											2450	1898	M	TEMPORARY 100 MM WHITE LINE	646.600	43			
											3050	3742.8	M	TEMPORARY 100 MM YELLOW LINE	646.610	44			
											66	90.7	M	TEMPORARY 600 MM STOP BAR	646.680	1			
											142	87	EACH	TEMPORARY LETTER OR SYMBOL	646.690	-			
											0	31.3	M	TEMPORARY CROSSWALK SA/CO #5 5-5-II	646.70	-			

Δ REVISED ITEM - 5/10/10

PROJECT NAME: EAST MONTPELIER
PROJECT NUMBER: STPG 028 - 3(35)S

FILE NAME: +98b028frm.dgn
PROJECT LEADER: J. SCHULTZ
DESIGNED BY: J. GRUCHACZ
QUANTITY SHEET 2

PLOT DATE: 11-MAY-2010
DRAWN BY: I. DEGUTIS
CHECKED BY: J. DEVLIN
SHEET 10 OF 142

STATE OF VERMONT
AGENCY OF TRANSPORTATION

QUANTITY SHEET 3

SUMMARY OF ESTIMATED QUANTITIES										TOTALS		DESCRIPTIONS				DETAILED SUMMARY OF QUANTITIES			
					ROADWAY	TRAINING	LANDSCAPING	EROSION CONTROL	UTILITIES - B&B ITEMS (NO FEDERAL/STATE PARTICIPATION)	FULL CE ITEMS	GRAND TOTAL	FINAL	UNIT	ITEMS	ITEM NUMBER	ROUND	QUANTITIES	UNIT	ITEMS
					13						13	0	SM	REMOVAL OF EXISTING PAVEMENT MARKINGS	646.85	0.7			
					170						170	939.2	SM	GEOTEXTILE UNDER STONE FILL	649.31	5			
								30			30	43.6	SM	GEOTEXTILE FOR SILT FENCE	649.51	1			
							45				45	76.985	KG	SEED	651.15	1			
							3				3	0	KG	SEED, WINTER RYE	651.17	-			
							360				360	557.73	KG	FERTILIZER	651.18	5			
							3				3	4.177	T	AGRICULTURAL LIMESTONE	651.20	0.1			
							3				3	4.049	T	HAYMULCH	651.25	0.1			
							640				640	973.57	CM	TOPSOIL	651.35	6			
							1				1	1	LS	EPSC PLAN	652.10	-			
							65				65	33	HR	MONITORING EPSC PLAN	652.20	-			
							1				1	1,166	LU	MAINTENANCE OF EPSC PLAN (N.A.B.I.)	652.30	-			
							1730				1730	3953.41	SM	TEMPORARY EROSION MATTING	653.20	18			
							7				7	2.45	CM	TEMPORARY STONE CHECK DAM, TYPE I	653.25	0.6			
							20				20	19	EACH	INLET PROTECTION DEVICE, TYPE I	653.40	-			
							12				12	15	EACH	EVERGREEN TREES (PICEA GLAUCA)(B&B)(2.1-2.4M HT)	656.20	-			
							3				3	3	EACH	DECIDUOUS TREES (ACER FREMANII X AUTUMN BLAZE) (B&B)(0.050 - 0.065 M CAL.)	656.30	-			
							3				3	3	EACH	DECIDUOUS TREES (AMELANCHIER "AUTUMN BRILLIANCE") (B&B)(0.045 - 0.050 M CAL.)	656.30	-			
							7				7	7	EACH	DECIDUOUS TREES (BELTA NIGRA "HERITAGE") (B&B)(0.050 - 0.065 M CAL.)	656.30	-			
							3				3	3	EACH	DECIDUOUS TREES (FRAXINUS PENNSYLVANICA "SUMMIT") (B&B)(0.050 - 0.065 M CAL.)	656.30	-			
							2				2	2	EACH	DECIDUOUS TREES (GLEDITSIA TRIACANTHOS INERMIS "SHADEMASTER") (B&B)(0.050 - 0.065 M CAL.)	656.30	-			
							2				2	2	EACH	DECIDUOUS TREES (MAGNOLIA X LOEBNERI "LEONARD-MESSEL") (B&B)(0.045 - 0.050 M CAL.)	656.30	-			
							2				2	2	EACH	DECIDUOUS TREES (MALUS "ADAMS") (B&B)(0.045 - 0.050 M CAL.)	656.30	-			
							2				2	3	EACH	DECIDUOUS TREES (MALUS "DONALD WYMAN") (B&B)(0.045 - 0.050 M CAL.)	656.30	-			
							2				2	4	EACH	DECIDUOUS TREES (MALUS "HARVEST GOLD") (B&B)(0.045 - 0.050 M CAL.)	656.30	-			
							1				1	1	EACH	DECIDUOUS TREES (MALUS "PRAIRIE FIRE") (B&B)(0.045 - 0.050 M CAL.)	656.30	-			
							3				3	3	EACH	DECIDUOUS TREES (MALUS "SUGAR TYME") (B&B)(0.045 - 0.050 M CAL.)	656.30	-			
							1				1	1	EACH	DECIDUOUS TREES (QUERCUS MACROCARPA) (B&B)(0.050 - 0.065 M CAL.)	656.30	-			
							6				6	6	EACH	DECIDUOUS TREES (QUERCUS RUBRA) (B&B)(0.050 - 0.065 M CAL.)	656.30	-			
							7				7	7	EACH	DECIDUOUS TREES (SYRINGA RETICULATA "IVORY SILK") (B&B)(0.045 - 0.050 M CAL.)	656.30	-			
							1				1	1	EACH	DECIDUOUS TREES (TILIA CORDATA "GREENSPIRE") (B&B)(0.050 - 0.065 M CAL.)	656.30	-			
							8				8	8	EACH	DECIDUOUS TREES (ULMUS AMERICANA "PRINCETON") (B&B)(0.050 - 0.065 M CAL.)	656.30	-			

PROJECT NAME: EAST MONTPELIER
PROJECT NUMBER: STPG 028 - 3(35)S

FILE NAME: +98b028frm.dgn
PROJECT LEADER: J. SCHULTZ
DESIGNED BY: J. GRUCHACZ
QUANTITY SHEET 3

PLOT DATE: 29-MAR-2010
DRAWN BY: I. DEGUTIS
CHECKED BY: J. DEVLIN
SHEET 11 OF 142

STATE OF VERMONT
AGENCY OF TRANSPORTATION

QUANTITY SHEET 4

SUMMARY OF ESTIMATED QUANTITIES										TOTALS		DESCRIPTIONS				DETAILED SUMMARY OF QUANTITIES			
						ROADWAY	TRAINING	LANDSCAPING	EROSION CONTROL	FULL CE ITEMS	GRAND TOTAL	FINAL	UNIT	ITEMS	ITEM NUMBER	ROUND	QUANTITIES	UNIT	ITEMS
								3			3	3	EACH	DECIDUOUS TREES (ULMUS AMERICANA "VALLEY FORGE") (B&B)(0.050 - 0.065 M CAL.)	656.30	-			
								10			10	10	EACH	DECIDUOUS SHRUBS (CLETHRA ALNIFOLIA "HUMMINGBIRD") (CONT.) (0.45 M HT)	656.35	-			
								12			12	12	EACH	DECIDUOUS SHRUBS (CLETHRA ALNIFOLIA "RUBY SPICE") (CONT.) (0.60 M HT)	656.35	-			
								16			16	16	EACH	DECIDUOUS SHRUBS (HYDRANGEA ARBORESCENS "ANNABELLE") (CONT.) (0.60 M HT)	656.35	-			
								14			14	14	EACH	DECIDUOUS SHRUBS (ILEX VERTICILATA "AFTERGLOW") (CONT.) (0.90 M HT)	656.35	-			
								4			4	4	EACH	DECIDUOUS SHRUBS (ILEX VERTICILATA "JIM DANDY") (CONT.) (0.90 M HT)	656.35	-			
								18			18	18	EACH	DECIDUOUS SHRUBS (SPIREA X "GOLD MOUND") (CONT.) (0.45 M HT)	656.35	-			
								12			12	24	EACH	DECIDUOUS SHRUBS (SPIREA X BULMALDA "GOLD FLAME") (CONT.) (0.60 M HT)	656.35	-			
								3			3	3	EACH	DECIDUOUS SHRUBS (SYRINGA VULGARIS) (CONT.) (0.90 M HT)	656.35	-			
								625			625	15.52	CM	LANDSCAPE WATERING	656.65	8.5			
								-9125			-9125	66.19	CM	LANDSCAPE BACKFILL, TRUCK MEASUREMENT	656.80	0.6			SEE MEMO DATED 4-25-11 FOR REVISED QUANTITY
								1			1	1	LS	TREE PROTECTION	656.85	-			
						19.5					19.5	20.13	SM	TRAFFIC SIGNS, TYPE A	675.20	0.6			
						140					140	147.59	M	SQUARE TUBE SIGN POST AND ANCHOR	675.341	2.7			
						68					68	58	EACH	REMOVING SIGNS	675.50	-			
						21					21	28	EACH	ERECTING SALVAGED SIGNS	675.60	-			
						14					14	12	EACH	SETTING SALVAGED POSTS	675.61	-			
						1					1	1	EACH	TRAFFIC CONTROL SIGNAL SYSTEM, INTERSECTION	678.15	-			
						315					315	297.1	M	WIRED CONDUIT (50 MM)(PVC)(SCH 80)	678.23	9.1			
						7					7	7	EACH	PULL BOX, STANDARD	678.25	-			
						67					67	667	M	ELECTRICAL CONDUIT SLEEVE (200MM)(PVC)(SCH 80)	678.30	1			
						4					4	4	EACH	LIGHT POLE BASE	679.21	-			
						4					4	4	EACH	BREAKAWAY FEATURE FOR LIGHT POLE	679.23	-			
						4					4	4	EACH	LIGHT POLE	679.45	-			
						1					1	1	EACH	BRACKET ARM	679.47	-			
						5					5	5	EACH	LUMNAIRE	679.50	-			
						1					1	1	EACH	POWER DROP STANCHION, STREET LIGHTING	679.55	-			900.675 SPECIAL PROVISION (HAND PLACED BITUMINOUS CONCRETE MATERIAL, DRIVES)
						1					1	9084.85	LU	PRICE ADJUSTMENT, FUEL (N.A.B.I.)	690.50	-			
						25					25	21	M	SA/CO #2 3-8-II REMOVAL & DISPOSAL OF CONTAMINATED SOIL SPECIAL PROVISION (150MM UNDERDRAIN PIPE, DRY SWALE)	900.545	-			704 SM DRIVES 75 SM PAVED ISLANDS 17 SM MOUNTABLE APRON
						1					1	1	LS	SPECIAL PROVISION (TEMPORARY ROADWAY)	900.645	-			796 SM SUBTOTAL 24 SM ROUNDING
						820					820	534.37	SM	SPECIAL PROVISION (HAND PLACED BITUMINOUS CONCRETE MATERIAL, DRIVES)	900.675	24			820 SM TOTAL
											0	1		SA/CO #3 3-8-II WASHINGTON ELECTRIC SLEEVE	900.545				
											0	1		SA/CO #4 5-15-II CORE & SEAL BOOT, CPEP ADAPTER	900.545				
											0	1		SA/CO #6 5-11-II SAFETY GRATE AT DRAIN STRUCTURE #9	900.545				
											0	1		SA/CO #7 5-15-II REWORK EMFD DRIVE AT 4+860, RT	900.545				
											0	1	LS	SA/CO #12 9-19-II FLASH FLOOD REPAIR-LABOR & EQUIP. HRS	900.545				

PROJECT NAME: EAST MONTPELIER
PROJECT NUMBER: STPG 028 - 3(35)S

FILE NAME: +98b028frm.dgn
PROJECT LEADER: J. SCHULTZ
DESIGNED BY: J. GRUCHACZ
QUANTITY SHEET 4

PLOT DATE: 22-MAR-2010
DRAWN BY: I. DEGUTIS
CHECKED BY: J. DEVLIN
SHEET 12 OF 142

STATE OF VERMONT
AGENCY OF TRANSPORTATION

EARTHWORKS

																														SUMMARY AND BALANCES																
		TOTAL EXCAVATION EARTH AND ROCK		ROCK EXCAVATION		EMBANKMENT						TOTAL EXCAVATION EARTH AND ROCK		ROCK EXCAVATION		EMBANKMENT						TOTAL EXCAVATION EARTH AND ROCK		ROCK EXCAVATION		EMBANKMENT						STATION TO STATION		TOT EXC. EARTH & ROCK	ROCK EXCAV	EMBANK	EXCESSES		ACUMULATIVE EXCESSES							
STATION	DIST	AREA	VOLUME	AREA	VOLUME	AREA	VOLUME	AREA	VOLUME	STATION	DIST	AREA	VOLUME	AREA	VOLUME	AREA	VOLUME	AREA	VOLUME	STATION	DIST	AREA	VOLUME	AREA	VOLUME	AREA	VOLUME	AREA	VOLUME	STATION	DIST	km + m	km + m	m ³	m ³	m ³	CUT	FILL	CUT	FILL						
km + m	m	m ²	m ³	m ²	m ³	m ²	m ³	m ²	m ³	km + m	m	m ²	m ³	m ²	m ³	m ²	m ³	m ²	m ³	km + m	m	m ²	m ³	m ²	m ³	m ²	m ³	km + m	m	km + m	km + m	m ³	m ³	m ³												
U.S ROUTE 2										KELTON ROAD																				U.S ROUTE 2																
4+660	20	0	33	0	17	0	4			30+000	15	1	8	0	0	0	59														4+660	4+975	3746	408	425	3459	0	3459	0							
4+680	20	3	155	2	34	0	4			30+015	5	4	13	0	0	8	25																													
4+700	20	12	302	2	34	0	6			30+020	20	1	49	0	0	3	32																													
4+720	20	18	376	2	34	1	8			30+040	20	0	9	0	0	0	3																													
4+740	20	20	330	2	34	0	39			30+060	10	0	2	0	0	0	2																													
4+760	20	13	273	2	34	4	60			30+070				0	0	0																														
4+780	20	14	262	2	34	2	61			PARKING LOT																																				
4+800	20	12	241	2	34	4	117			100+000	7	0	0	0	0	0	27																													
4+820	20	12	267	2	34	8	103			100+007	13	0	0	0	0	8	119																													
4+840	20	15	334	2	34	2	24			100+020	20	0	0	0	0	10	217																													
4+860	20	18	393	2	34	0	0			100+040	20	0	0	0	0	12	259																													
4+880	20	21	305	2	34	0	1			100+060	20	0	2	0	0	14																														
4+900	20	10	100	2	17	0	2			100+080	20	3	27	0	0	7	209																													
4+920	10	0	2	0	0	0	1			100+100	20	2	43	0	0	6	122																													
4+930	10	0	139	0	0	0	0			100+120	20	2	37	0	0	4	94																													
4+940	10	28	170	0	0	0	0			100+140	20	8	99	0	0	0	39																													
4+950	10	6	39	0	0	0	0			100+160	20	0	79	0	0	0	1																													
4+960	15	2	25	0	0	0	0																																							
4+975	15	2	25	0	0	0	0																																							
VT ROUTE 14																																														
14+026	9	13	60	0	0	0	27																																							
14+035	5	13	65	0	0	6	32																																							
14+040	20	21	338	0	0	7	87																																							
14+060	20	9	306	0	0	2	37																																							
14+080	20	5	141	0	0	2	26																																							
14+100	20	3	78	0	0	1	15																																							
14+120	20	1	39	0	0	1	26																																							
14+140	20	13	138	0	0	2	35																																							
14+160	20	23	360	0	0	18	1990																																							
14+180	20	19	425	0	0	0	0																																							
14+200	20	10	293	0	0	0	7																																							
14+220	20	2	115	0	0	1	14																																							
14+240	15	0	12	0	0	1	5																																							
14+255				0	0	0																																								
QUAKER HILL ROAD																																														
40+000	11	8	44	0	0	1																																								
40+011	9	4	56	0	0	2																																								
40+020	20	5	97	0	0	3																																								
40+040	20	0	52	0	0	1																																								
40+060				0	0	0																																								

REMARKS	
EARTH AND ROCK EXCAVATION	6733 CM
SOLID ROCK EXCAVATION	408 CM
EARTH EXCAVATION	6325 CM
PLANIMETERED FILL	1970 CM
LESS FACTORED SOLID ROCK	202 CM
TRENCH BACKFILL MATERIAL	800 CM
NET PLANIMETERED FILL	2972 CM
FACTOR	1.15
PLANIMETERED FILL INCLUDING FACTOR	3418 CM
MATERIALS AVAILABLE FOR FILLS	
EARTH EXCAVATION	6325 CM
TRENCH EXCAVATION (EARTH AND ROCK) X 60%	1602 CM
DRIVE EXCAVATION	225 CM
EXCAVATION OF SURFACES AND PAVEMENTS	22 CM
TOTAL MATERIAL AVAILABLE FOR FILL	8174 CM
TOTAL FILL INCLUDING FACTOR	3418 CM
TOTAL MATERIAL FOR FILL	8174 CM
BORROW	0 CM
EXCESS EXCAVATION	4756 CM

PROJECT NAME: EAST MONTPELIER
 PROJECT NUMBER: STPG 028 - 3(35)S
 FILE NAME: +98b028frm.dgn
 PROJECT LEADER: J. SCHULTZ
 DESIGNED BY: J. GRUCHACZ
 EARTHWORKS SHEET
 PLOT DATE: 22-MAR-2010
 DRAWN BY: L. DEGUTIS
 CHECKED BY: J. DEVLIN
 SHEET 15 OF 142

RIGHT - OF - WAY DETAIL SHEET



TABLE OF PROPERTY ACQUISITION

PARCEL NO.	PROPERTY OWNER	SHEET NO.	BEGINNING STATION	ENDING STATION	TAKE	REMAINDER	RIGHT			RECORDING DATA				REMARKS	
					AREA ±	AREA ±	TYPE	(TY)(P)	AREA ±	TITLE	DATE	TOWN / CITY	BOOK		PAGE
1	LAMB, DURWARD D. & LINDA L.	34	4+646.45 RT. 4+672.00 RT.	4+676.03 RT.	220.1 SM		ALL R.T. & I.			WD	4/3/2009	EAST MONTPELIER	106	037-38	US RTE 2 & VT 14; 2369 SF± (HWY. EASE.) DRIVE GRAVEL 6.1M (20') MM 0291
2	BIRON, JEFFREY R. & ROBIN D. & GLORIA A. BIRON, TRUSTEE OF THE GLORIA A. BIRON LIVING TRUST - LESSORS J.R. BIRON, INC.-LESSEE	34	4+646.45 LT. 4+676.00 LT. 4+647.22 LT.	4+692.50 LT. 4+682.71 RT. 4+656.45 LT.	347.2 SM		ALL R.T. & I.								US RTE 2 & VT 14; 3737 SF± (HWY. EASE.) DRIVE 32.0M (105') PAVED MM 0291 EXCEPT & RESERVE, GAS PUMP ISLAND
3	MOREY, ROBERT W. & GROVER-MOREY, DEBRA	34	4+676.03 RT. 4+676.03 RT. 4+687.48 RT. 4+695.00 RT. 4+699.00 RT. 4+679.56 RT.	4+705.27 RT. 4+682.71 RT. 4+696.49 RT. 4+695.00 RT. 4+681.10 RT.	219.5 SM±		ALL R.T. & I. UTILITY EASE. SLOPE REMOVE DRIVE INSTALL & MANT.	(P) (T) (T) (T) (T) (P)	8.1 SM 4.4 SM	WD	10/16/2009	EAST MONTPELIER	108	511-512	US RTE 2 & VT 14; 2363 SF± (HWY. EASE.) 87 SF± 47 SF± FENCE 5.8M(19') GRAVEL MM0293 GUY WIRE & ANCHOR
4	BIRON, JEFFREY R. & ROBIN D.	34,35	4+692.50 RT. 4+702.00 LT. 4+719.83 LT. 4+714.50 LT. 4+728.11 LT. TH25 40+023.00 LT. TH25 40+030.00 LT. 4+729.02 LT. 4+729.44 LT. 4+714.50 LT.	4+736.63 RT. 4+730.37 LT. 4+717.00 LT. 4+729.88 LT. TH25 40+020.00 LT. 4+717.00 LT.	0.06HA		ALL R.T. & I. DRIVE UTILITY EASE. ALL R.T. & I. REMOVE DRIVE INSTALL & MANT. ALL R.T. & I. SLOPE REMOVE	(T) (P) (T) (T) (P) (T) (T)	21.8 SM						US RT 2&VT 14&TH25, 0.15A± (HWY. EASE.) 10.5M(34') GRAVEL MM 0293 235 SF± PUMP ISLAND SIGN BASE 10.0M(33') GRAVEL DROP INLET SIGN BASE 29 SF± PUMP ISLAND
5A	GLORIA A. BIRON, TRUSTEE OF THE GLORIA A. BIRON LIVING TRUST	34,35	4+705.13 RT. 4+723.00 RT. 4+764.27 RT. 4+735.92 RT.	4+777.69 RT. 4+795.00 RT. 4+777.69 RT.	125 SM		DRIVE SLOPE EASE.	(T) (T) (P)	29.6 SM 20.7 SM						1345 SF± 11.5M(38') GRAVEL MM 0294 319 SF± SIGHT RESTRICTION AREA(223 SF±)
5B		34,35	4+705.17 RT.	4+795.61 RT.	0.07HA		ALL R.T. & I.								US RTE. 2 & VT. 14 0.17A± (HWY. EASE.)
6A	STATE OF VERMONT	34,35	4+795.00 RT.	4+828.05 RT.	0.40HA	0				WD	8/9/2007	East Montpelier	99	127-132	TOTAL TAKE .99A± FORMERLY-LAPERLE, MAURICE A. & LUCILLE M., LIFE ESTATE; LAPERLE, ALAN LAPERLE, GARY BROWN, JODI LYNN LAPERLE, MARK
6B		35	4+795.00 RT.	4+828.05 RT.	226 SM		ALL R.T. & I.								US RTE. 2 2433 SF±
6C		34,35	4+644.83 RT.	4+828.05 RT.	0.20HA		ALL R.T. & I.								FORMERLY LAPERLE (0.50A±)
7	HASLAND, LLC	35	4+828.05 RT. 4+833.62 RT. 4+838.96 LT. 4+863.00 RT. 4+840.16 RT. 4+848.20 RT. 4+863.00 RT.	4+868.43 RT. 4+838.26 RT. 4+840.16 RT. 4+868.62 RT. 4+868.43 RT.	294.5 SM		ALL R.T. & I. EASE. ALL R.T. & I. DRIVE UTILITY EASE. DETOUR ACCESS	(T) (T) (P) (T) (T) (T)	5.3 SM 60.1 SM 26.5 SM	WD	5/11/2009	East Montpelier	106	354-356	US RTE. 2 3170 SF± (HWY. EASE.) REMOVE DI & PLUG 57 SF± WATER LINE CROSSING US RTE. 2 7.3M(24') GRAVEL MM0303 647 SF± 285 SF± INGRESS & EGRESS TO DETOUR

TABLE OF REVISIONS


REVISION NO.	SHEET NO.	DESCRIPTION	DATE
1	10,15,16	PARCEL NO. 6, LAPERLE, CHANGE NAME TO LAPERLE, MAURICE A & LUCILLE M., LIFE ESTATE. LAPERLE, ALAN, LAPERLE, GARY, BROWN, JODI LYNN. LAPERLE, MARK. PER C.O. 9480 MADE BY: JAB APPROVED BY: HP	10/19/2006
2	21,32,37	PARCEL NO. 17, LAPERLE, REMOVE THE TWO TREES NEAR THE SOUTHWEST BOUNDARY FROM THE PLANS. THE OWNERS DO NOT WANT TREES PLANTED THERE. MADE BY: MT APPROVED BY: HP	6/11/2008
3	29	PARCEL NO. 5, BIRON, CORRECTED CALCULATION OF SM AND SF FOR EASE. (P) MADE BY: MT APPROVED BY: HP	1/26/2009
4	29,34,35	PARCEL NO. 6 STATE OF VERMONT. ACQUIRED FROM LAPERLE, MAURICE A. & LUCILLE M., LIFE ESTATE. PER C.O. 9566 MADE BY: MR APPROVED BY: HP	9/15/2009

PLAN LEGEND

- — — — — EXISTING RIGHT-OF-WAY
- — — — — TAKING WITH ACCESS
- — — — — TAKING WITHOUT ACCESS
- - - - - CZ CLEAR ZONE
- P — — — — — PROPERTY LINE
- — ○ — ○ — TOE OF SLOPE
- △ — △ — △ — TOP OF CUT
- — SR (P) — ○ — SLOPE RIGHT
- — — — — CONST. (T) — — — — — CONSTRUCTION RIGHT
- PDF — — — — — PDF PROJECT DEMARCATION FENCE
- (P) -PERMANENT
- (T) -TEMPORARY
- DR. -DRAINAGE RIGHT
- DIT. -DITCHING RIGHT
- CH. -CHANNEL RIGHT
- DRIVE -DRIVE RIGHT
- CUL. -CULVERT RIGHT
- C&T -CLEARING & TRIMMING RIGHT
- SR -SLOPE RIGHT
- UE -UTILITY EASEMENT

APPROVED: HARRY PETROVS DATE: 07-07-08
CHIEF, PLANS & TITLES

PROJECT NAME: **EAST MONTPELIER**
 PROJECT NUMBER: **STPG 028-3(35)S**
 FILE NAME: r98b028.xls PLOT DATE:
 PROJECT LEADER: J. SCHULTZ DRAWN BY: MT
 DESIGNED BY: J. GRUCHACZ CHECKED BY: FM
 R.O.W. DETAIL SHEET 29 OF 37 SHEET 16 OF 142

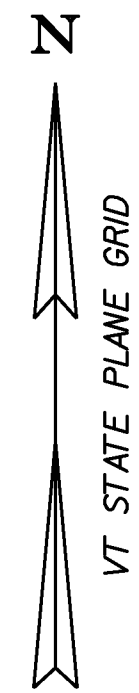

MATCH LINE TO ROW SHEET 35 OF 37

BIRON, JEFFREY R. & ROBIN D.
 & GLORIA A. BIRON -TRUSTEE
 of The GLORIA A. BIRON LIVING TRUST-LESSORS
 AND J.R. BIRON, INC.-LESSEE

- 210.10 COLD PLANING BITUMINOUS PAVEMENT
 STA 4+660.00 - 4+674.50
- 616.21 VERTICAL GRANITE CURB
 STA 4+674.49 RT - 4+696.44 RT
 STA 4+704.72 RT - 4+717.10 RT (ISLAND)
 STA 4+709.00 LT - 4+710.63 LT (ISLAND)
- 620.55 REMOVAL OF EXISTING FENCE
 STA 4+694.96 RT - 4+695.03 RT
- 900.675 SPECIAL PROVISION
 (HAND PLACED BITUMINOUS CONCRETE MATERIAL, DRIVES)
 STA 4+660.00 LT - 4+692.00 LT (PAVED DRIVE APRON)
 STA 4+672.00 RT (6.1M - PAVED)
 STA 4+699.00 RT (5.8M - PAVED)
 STA 4+702.00 LT (12.0M - PAVED)


LINE SHOWN ON THIS PLAN AS EXISTING
 PROPERTY LINES P/L ARE BELIEVED TO
 BE ACCURATE BUT SHOULD NOT BE RELIED
 UPON FOR PURPOSES UNRELATED TO THE
 STATE OF VERMONT'S AQUISITION OF LAND
 AND RIGHTS FOR THIS PROJECT.

BEGIN R. O. W. PROJECT
 STPG 028-3(35) S
 STA. 4+646.45 CL

- FOR EROSION CONTROL
 DETAIL SEE R O W
 SHEETS 13-19 OF 37
- FOR LANDSCAPE
 DETAIL SEE R O W
 SHEETS 20-24 OF 37
- FOR DRAINAGE
 DETAIL SEE R O W
 SHEETS 25-28 OF 37



PROJECT NAME: EAST MONTPELIER
 PROJECT NUMBER: STPG 028 - 3(35)S
 FILE NAME: r98b028li.dgn
 PROJECT LEADER: J. SCHULTZ
 DESIGNED BY: J. GRUCHACZ
 R.O.W. LAYOUT SHEET 34 OF 37
 PLOT DATE: 22-MAR-2010
 DRAWN BY: R.O.W.
 CHECKED BY: R.O.W.
 SHEET 21 OF 142

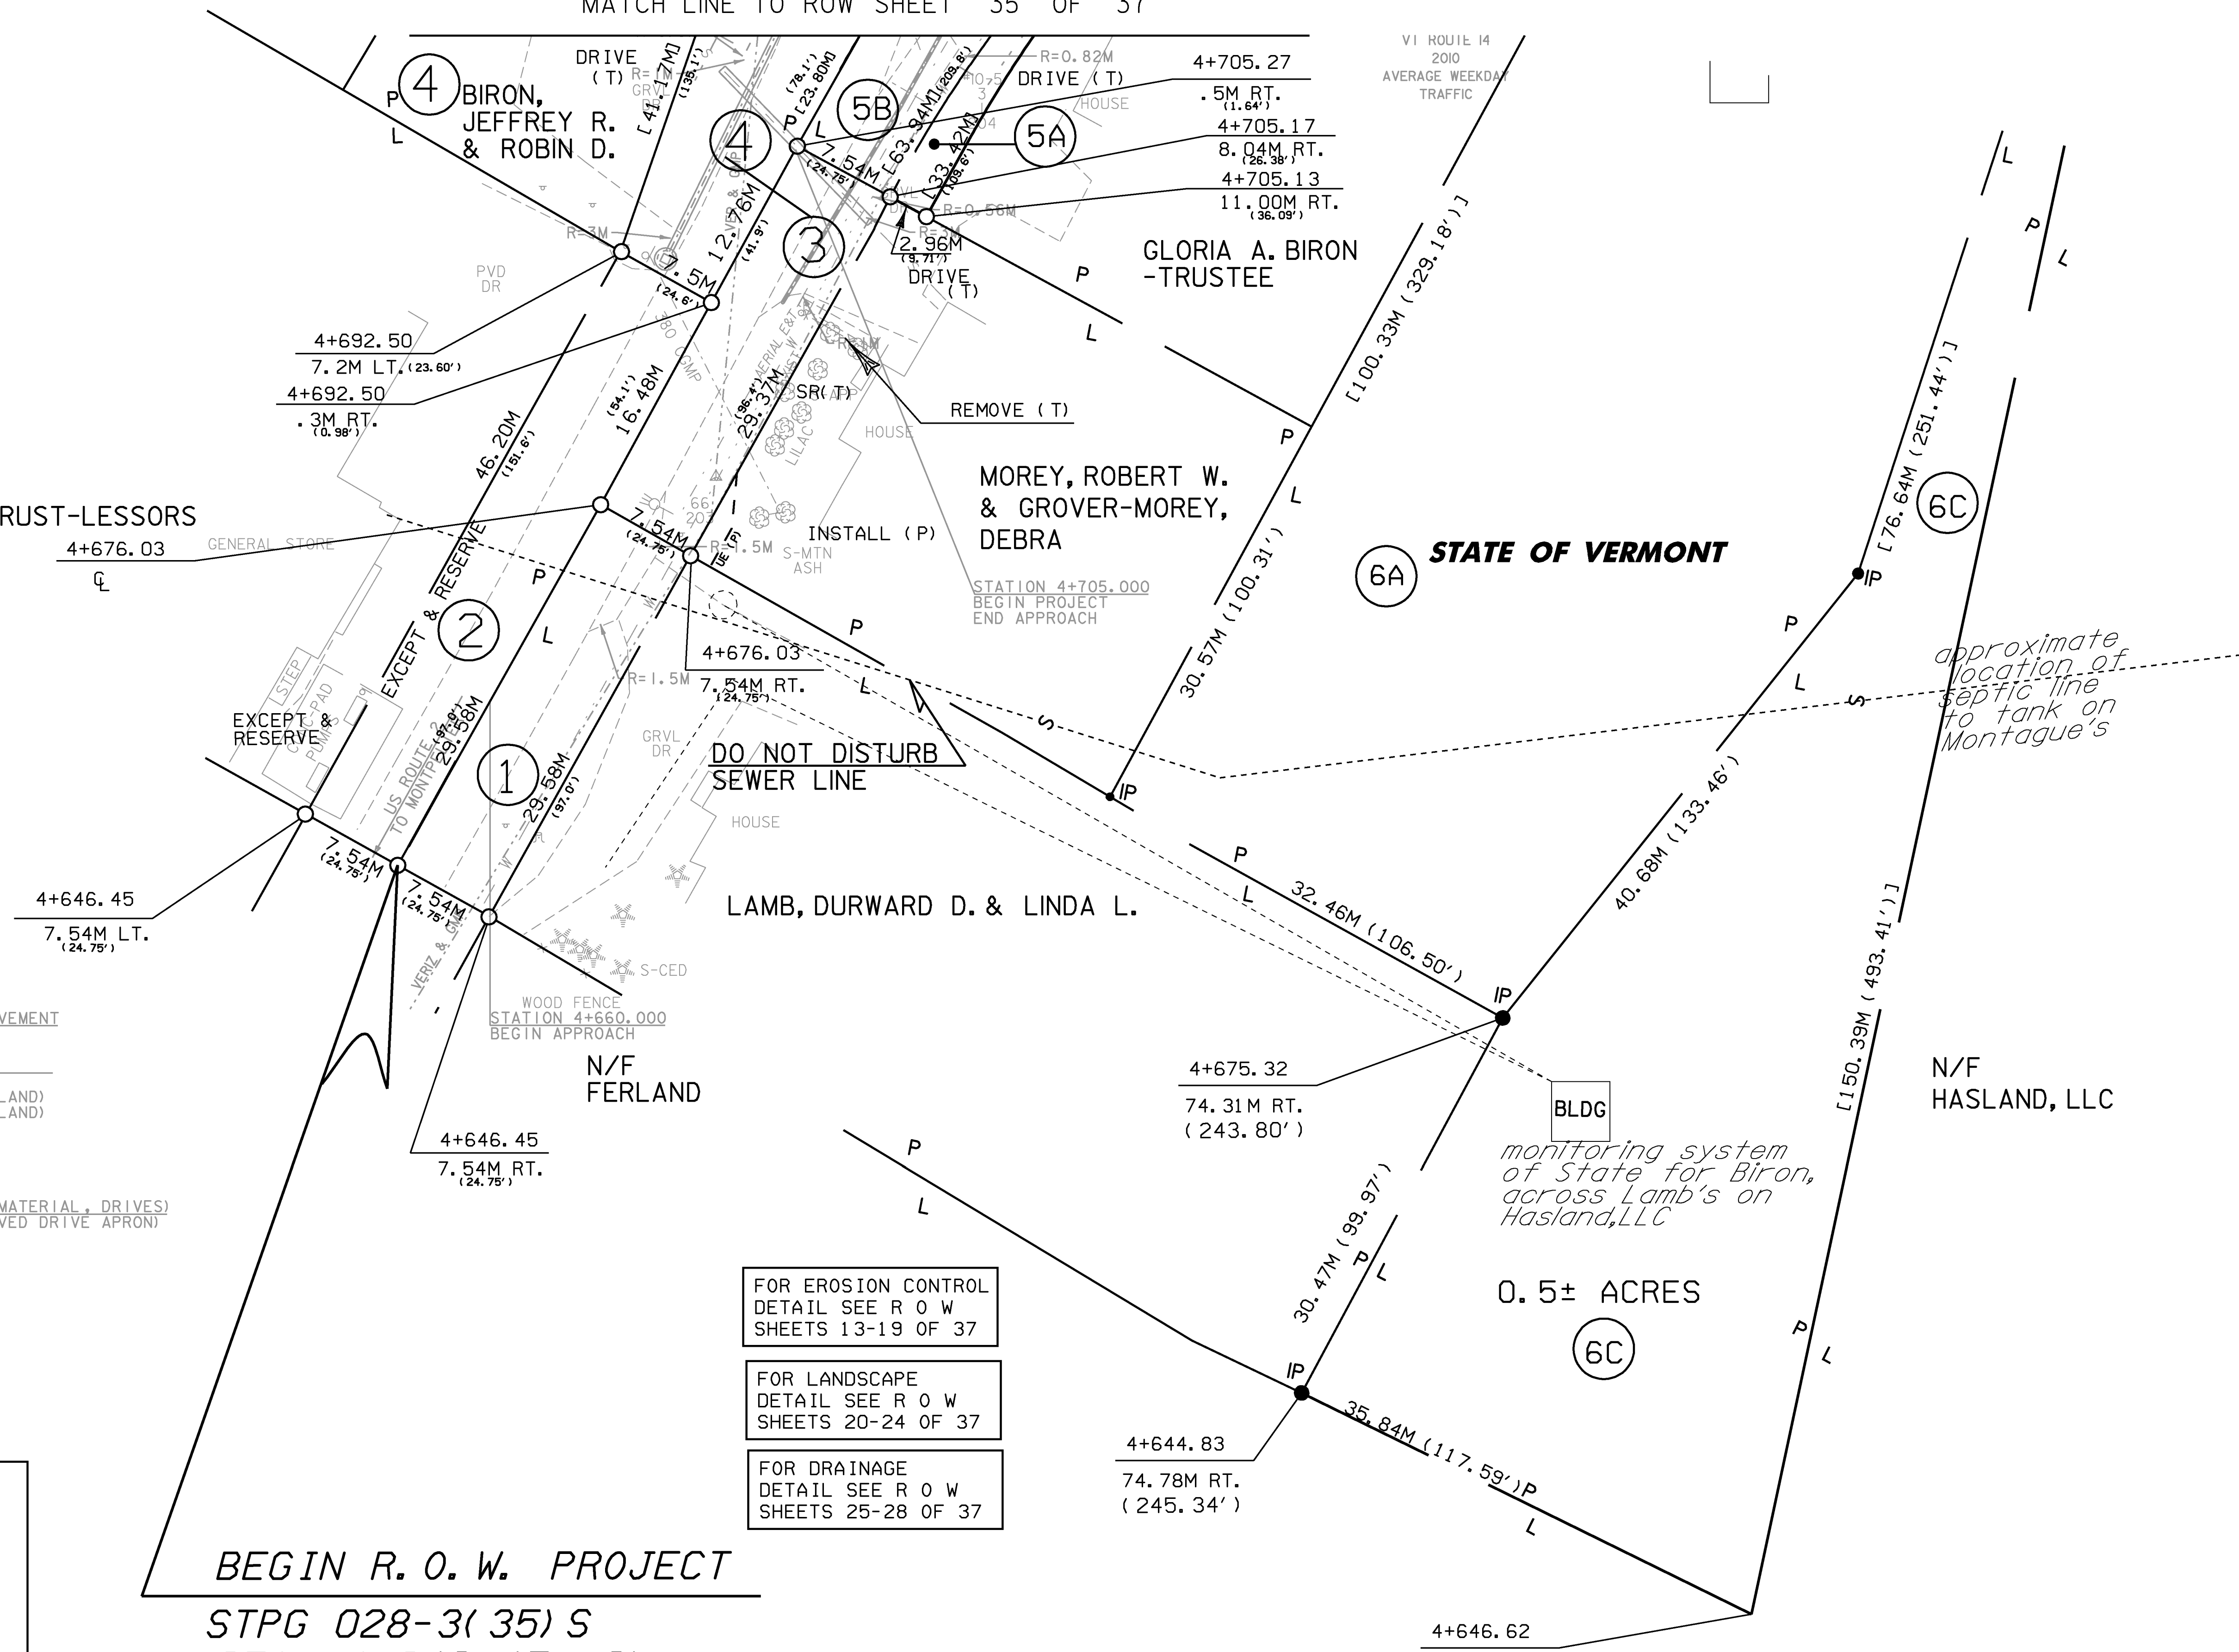

210.10 COLD PLANING BITUMINOUS PAVEMENT
STA 40+052.75 - 40+060.00

203.28 EXCAVATION OF SURFACES AND PAVEMENTS
STA 100+082.36 RT - 100+157.58 RT
STA 100+091.40 LT - 100+155.08 RT

616.20 GRANITE SLOPED EDGING
STA 4+780.10 LT - 14+037.50 LT

616.21 VERTICAL GRANITE CURB
STA 4+710.63 LT - 40+015.38 LT (ISLAND)
STA 4+731.70 RT - 4+752.80 RT (ISLAND)
STA 4+752.80 RT - 4+810.90 RT
STA 4+812.40 RT - 4+854.94 RT
STA 4+813.80 LT - 4+861.80 LT
STA 14+037.50 RT - 4+812.30 LT
STA 14+039.00 LT - 14+042.00 LT
STA 14+039.00 RT - 14+044.90 RT
STA 40+023.40 RT - 4+780.10 LT
STA 100+082.37 RT - 100+098.30 RT
STA 100+099.80 RT - 100+103.80 RT

618.10 PORTLAND CEMENT CONCRETE SIDEWALK, 125MM
STA 40+014.54 RT - 14+039.00 LT
STA 14+039.00 RT - 4+813.80 LT
STA 4+810.90 RT - 4+856.61 RT
STA 100+082.37 RT - 100+156.58 RT

CONSTRUCT SIDEWALK RAMP WITH
618.30 DETECTABLE WARNING SURFACE
STA 4+811.65 RT - TYPE 6
STA 4+813.07 LT - TYPE 1
STA 4+854.64 RT - TYPE 1
STA 14+038.25 LT - TYPE 1
STA 14+038.25 RT - TYPE 1
STA 100+082.67 RT - TYPE 1
STA 100+099.05 RT - TYPE 6

WASHINGTON ELECTRIC CO-OP, INC.

900.675 SPECIAL PROVISION (HAND PLACED) BITUMINOUS CONCRETE (LIVES)
STA 4+723.00 RT (12.0M - PAVED)
STA 4+863.00 RT (7.3M - PAVED)
STA 4+871.00 LT (7.3M - PAVED)
STA 40+023.00 LT (12.0M - PAVED)
STA 100+076.00 RT (12.5M - PAVED)



CONSTRUCT MOUNTABLE APRON
STA 4+780.10 LT - 14+037.50 LT (PAVED)

MATCH LINE TO ROW SHEET 37 OF 37

FOR EROSION CONTROL
DETAIL SEE R O W
SHEET 13-19 OF 37

FOR DRAINAGE
DETAIL SEE R O W
SHEET 25-28 OF 37

FOR LANDSCAPE
DETAIL SEE R O W
SHEET 20-24 OF 37

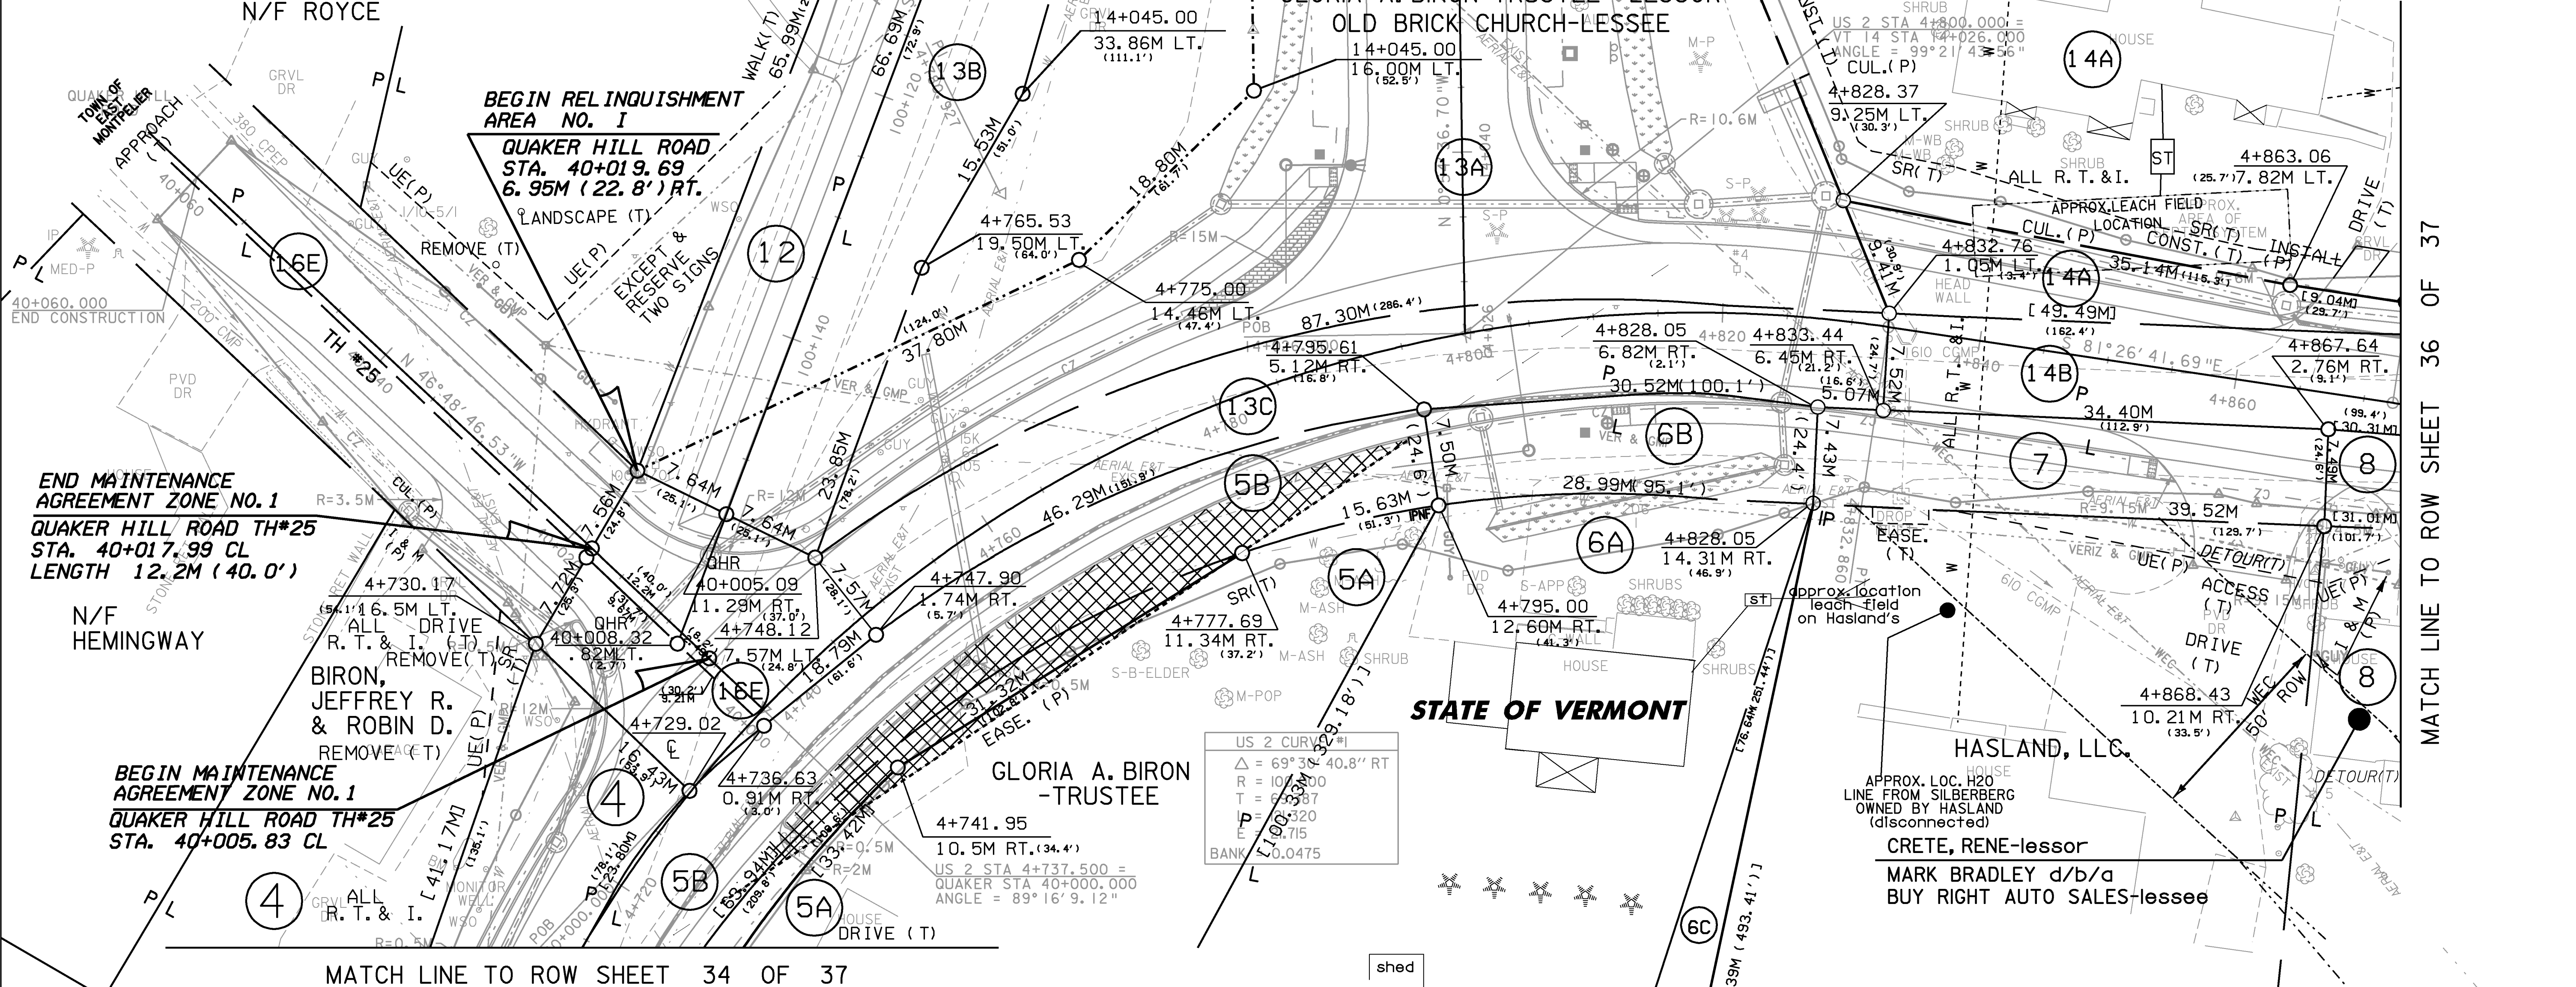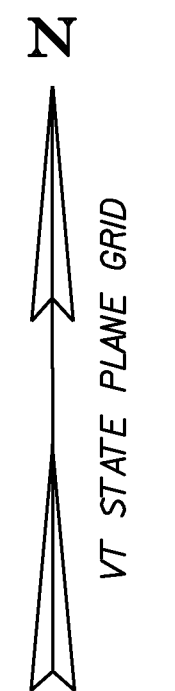


END MAINTENANCE AGREEMENT ZONE NO. 1
QUAKER HILL ROAD TH#25
STA. 40+017.99 CL
LENGTH 12.2M (40.0')

BEGIN MAINTENANCE AGREEMENT ZONE NO. 1
QUAKER HILL ROAD TH#25
STA. 40+005.83 CL

MATCH LINE TO ROW SHEET 34 OF 37

MATCH LINE TO ROW SHEET 36 OF 37


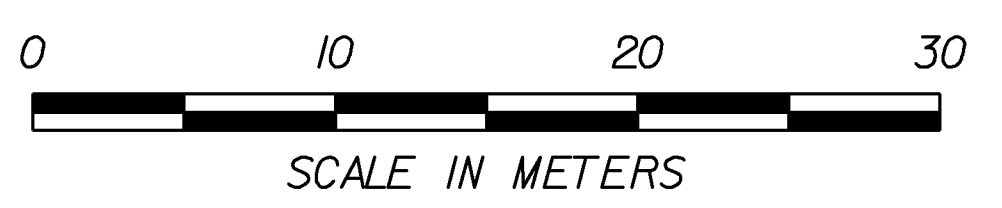


LINE SHOWN ON THIS PLAN AS EXISTING PROPERTY LINES P/L ARE BELIEVED TO BE ACCURATE BUT SHOULD NOT BE RELIED UPON FOR PURPOSES UNRELATED TO THE STATE OF VERMONT'S ACQUISITION OF LAND AND RIGHTS FOR THIS PROJECT.

PROJECT NAME: EAST MONTPELIER
PROJECT NUMBER: STPG 028-3(35)S

FILE NAME: r98b02812.dgn
PROJECT LEADER: J. SCHULTZ
DESIGNED BY: J. GRUCHACZ
R.O.W. LAYOUT SHEET 35 OF 37

PLOT DATE: 22-MAR-2010
DRAWN BY: R.O.W.
CHECKED BY: R.O.W.
SHEET 22 OF 142

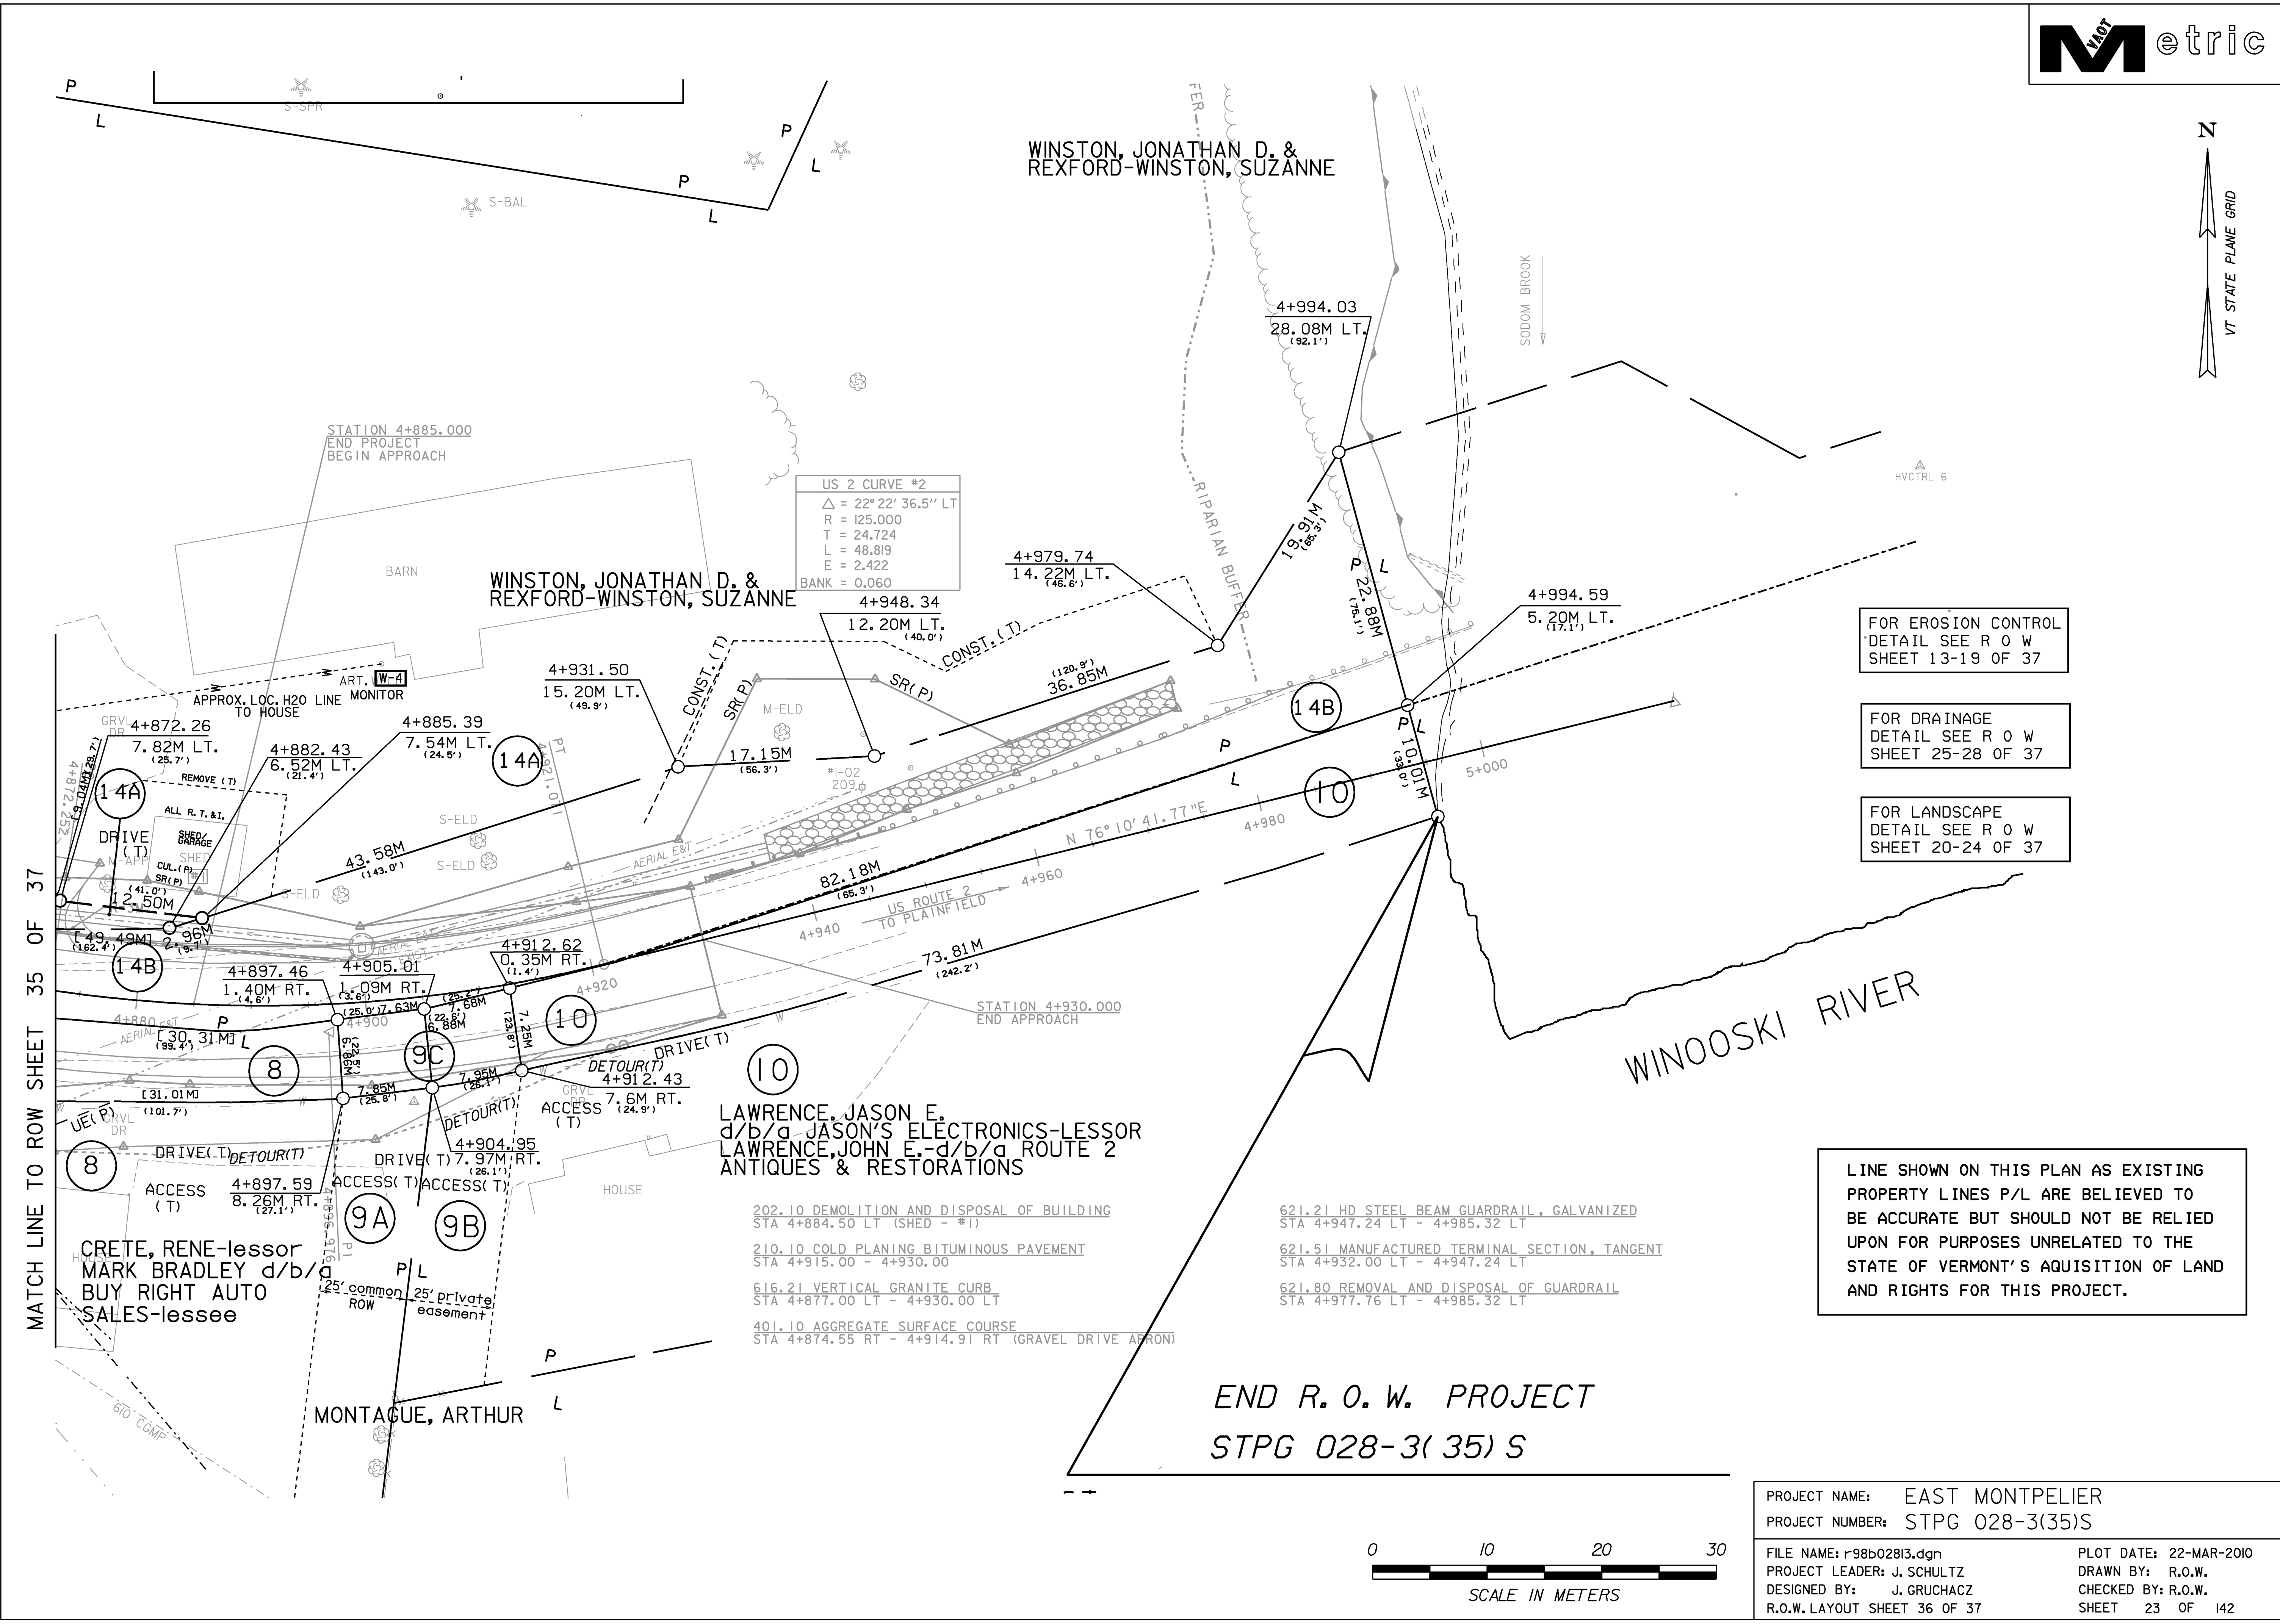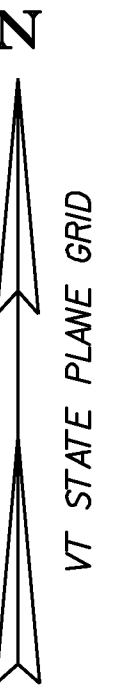

US 2 CURVE #2
 $\Delta = 22^\circ 22' 36.5''$ LT
 R = 125.000
 T = 24.724
 L = 48.819
 E = 2.422
 BANK = 0.060

FOR EROSION CONTROL
 DETAIL SEE R O W
 SHEET 13-19 OF 37

FOR DRAINAGE
 DETAIL SEE R O W
 SHEET 25-28 OF 37

FOR LANDSCAPE
 DETAIL SEE R O W
 SHEET 20-24 OF 37

LINE SHOWN ON THIS PLAN AS EXISTING
 PROPERTY LINES P/L ARE BELIEVED TO
 BE ACCURATE BUT SHOULD NOT BE RELIED
 UPON FOR PURPOSES UNRELATED TO THE
 STATE OF VERMONT'S ACQUISITION OF LAND
 AND RIGHTS FOR THIS PROJECT.

LAWRENCE, JASON E.
 d/b/a JASON'S ELECTRONICS-LESSOR
 LAWRENCE, JOHN E. -d/b/a ROUTE 2
 ANTIQUES & RESTORATIONS

- 202.10 DEMOLITION AND DISPOSAL OF BUILDING
 STA 4+884.50 LT (SHED - #1)
- 210.10 COLD PLANING BITUMINOUS PAVEMENT
 STA 4+915.00 - 4+930.00
- 616.21 VERTICAL GRANITE CURB
 STA 4+877.00 LT - 4+930.00 LT
- 401.10 AGGREGATE SURFACE COURSE
 STA 4+874.55 RT - 4+914.91 RT (GRAVEL DRIVE APRON)


- 621.21 HD STEEL BEAM GUARDRAIL, GALVANIZED
 STA 4+947.24 LT - 4+985.32 LT
- 621.51 MANUFACTURED TERMINAL SECTION, TANGENT
 STA 4+932.00 LT - 4+947.24 LT
- 621.80 REMOVAL AND DISPOSAL OF GUARDRAIL
 STA 4+977.76 LT - 4+985.32 LT

END R. O. W. PROJECT
 STPG 028-3(35) S



PROJECT NAME:	EAST MONTPELIER	FILE NAME:	r98b02813.dgn	PLOT DATE:	22-MAR-2010
PROJECT NUMBER:	STPG 028-3(35)S	PROJECT LEADER:	J. SCHULTZ	DRAWN BY:	R.O.W.
		DESIGNED BY:	J. GRUCHACZ	CHECKED BY:	R.O.W.
		R.O.W. LAYOUT SHEET	36 OF 37	SHEET	23 OF 142

MATCH LINE TO ROW SHEET 35 OF 37

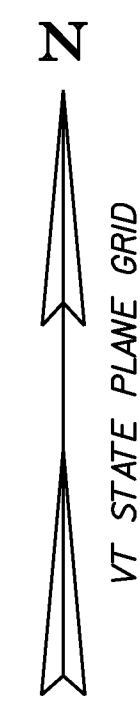

FOR EROSION CONTROL
DETAIL SEE R O W
SHEET 13-19 OF 37

FOR DRAINAGE
DETAIL SEE R O W
SHEET 25-28 OF 37

FOR LANDSCAPE
DETAIL SEE R O W
SHEET 20-24 OF 37

210.10 COLD PLANING BITUMINOUS PAVEMENT
STA 14+240.50 - 14+255.00

203.28 EXCAVATION OF SURFACES AND PAVEMENTS
STA 14+093.41 LT - 14+136.70 LT
STA 14+143.52 LT - 14+177.43 LT
STA 100+019.55 RT - 30+032.38 LT

401.10 AGGREGATE SURFACE COURSE
STA 14+201.00 LT (4.8M - GRAVEL DRIVE)
STA 30+053.00 RT (7.0M - GRAVEL DRIVE)
STA 30+060.00 - 30+070.00 (KELTON ROAD)

900.675 SPECIAL PROVISION
(HAND PLACED BITUMINOUS CONCRETE MATERIAL, DRIVES)
STA 14+137.00 RT (10.5M - PAVED)
STA 14+217.00 RT (9.1M - PAVED)

LINE SHOWN ON THIS PLAN AS EXISTING
PROPERTY LINES P/L ARE BELIEVED TO
BE ACCURATE BUT SHOULD NOT BE RELIED
UPON FOR PURPOSES UNRELATED TO THE
STATE OF VERMONT'S ACQUISITION OF LAND
AND RIGHTS FOR THIS PROJECT.

END RELINQUISHMENT
AREA NO. 1
STA. 14+145.86
13.63M LT. (34.7')

END MAINTENANCE
AGREEMENT ZONE NO. 2
KELTON ROAD TH #39
STA. 30+015.84 CL
LENGTH 8.3M (27.2')

WASHINGTON ELECTRIC
CO-OP, INC.

NEW PARKING CURVE
 $\Delta = 35^\circ 11' 36.5''$ LT
R = 70.000
T = 22.225
L = 43.041
E = 3.444
BANK = 0.0025

GLORIA A. BIRON-TRUSTEE
-LESSOR
OLD BRICK CHURCH-LESSEE

KELTON CURVE
 $\Delta = 6^\circ 38' 25.9''$ RT
R = 20.000
T = 1.932
L = 2.517
E = 3.289
BANK = NC

VT 14 CURVE #2
 $\Delta = 7^\circ 31' 53.0''$ LT
R = 125.000
T = 8.227
L = 16.431
E = 0.270
BANK = 0.0435

O'VITT, DAVID P.

TOWN OF
EAST MONTPELIER


TOWN OF
EAST MONTPELIER
(town clerks
office)

WASHINGTON ELECTRIC
CO-OP, INC.

LAPERLE, NORMAN A. & CLAIRE

BEGIN MAINTENANCE
AGREEMENT ZONE NO. 2
KELTON ROAD TH #39
STA. 30+007.51 CL

VT 14 CURVE #1
 $\Delta = 66^\circ 25' 19.5''$ RT
R = 125.000
T = 11.832
L = 14.911
E = 0.104
BANK = 0.0435

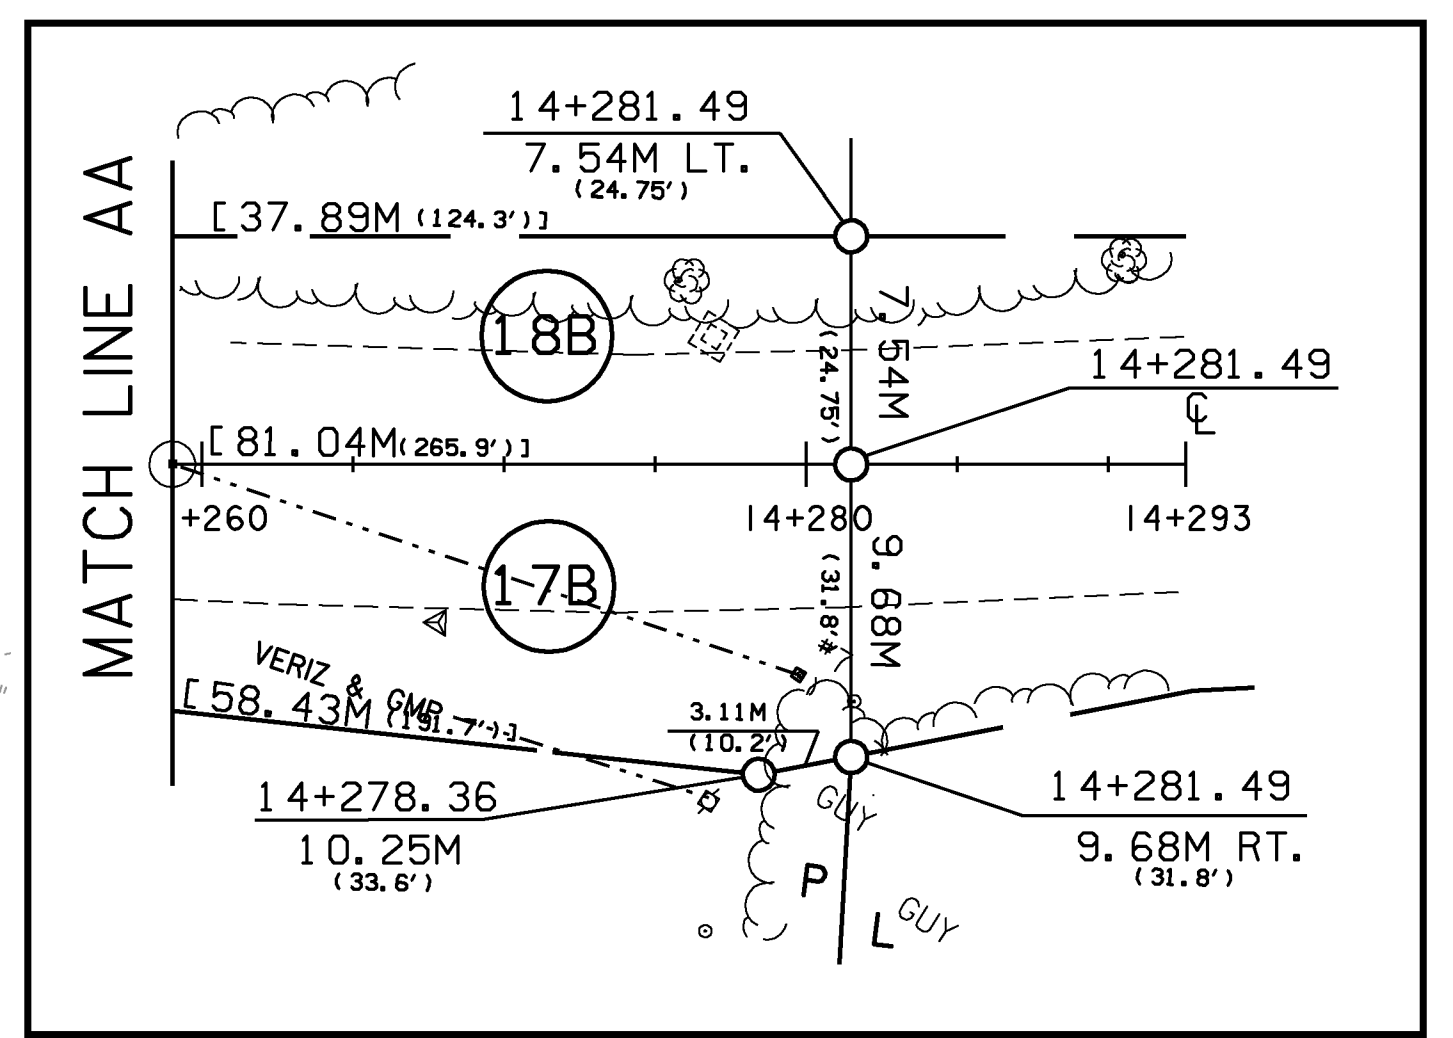

MATCH LINE TO ROW SHEET 35 OF 37

PROJECT NAME: EAST MONTPELIER
PROJECT NUMBER: STPG 028-3(35)S

FILE NAME: r98b02814.dgn
PROJECT LEADER: J. SCHULTZ
DESIGNED BY: J. GRUCHACZ
R.O.W. LAYOUT SHEET 37 OF 37

PLOT DATE: 22-MAR-2010
DRAWN BY: R.O.W.
CHECKED BY: R.O.W.
SHEET 24 OF 142

GPS CONTROL POINTS

HVCTRL # 1
 STANDARD DISK STAMPED DONNELLY
 N = 198020.4310
 E = 502632.3060
 ELEV. = 0.0000

DESCRIBED BY VERMONT AGENCY OF TRANSPORTATION 1996 (DJM) GENERAL LOCATION EAST MONTPELIER, VT. 12 MI (19.3 KM) NORTHEAST OF MONTPELIER, 30 MI (48.3 KM) EAST SOUTHEAST OF ST. JOHNSBURY AND 60 MI (96.6 KM) SOUTH OF THE CANADIAN BORDER. TO REACH FROM THE NORTH INTERSECTION OF U.S.ROUTE 2 AND VT ROUTE 14 PROCEED NORTHERLY ALONG ROUTE 14 FOR 1.2 MI (1.9 KM) TO A GRAVEL DRIVE ON THE RIGHT. PROCEED UP THE GRAVEL DRIVE FOR 0.15 MI (0.24 KM) TO A PAVED DRIVE ON THE LEFT AND A YELLOW RANCH WITH A ONE CAR GARAGE. PROCEED UP THE PAVED DRIVE TO THE YELLOW RANCH. THE MARK IS 28.8 M (94.5 FT) NORTH NORTHEAST OF AN IRON PIPE SEPERATING THE TWO ADJACENT PROPERTIES, 26.5 M (86.9 FT) NORTHWEST OF THE SOUTHWEST CORNER OF THE ADJACENT WHITE RANCH, 24.7 M (81.0 FT) WEST OF THE NORTHWEST CORNER OF THE ADJACENT WHITE RANCH, 20.2 M (66.3 FT) EAST NORTHEAST OF THE SOUTHEAST CORNER OF THE YELLOW GARAGE, AND 13.0 M (42.7 FT) EAST OF THE NORTHEAST CORNER OF THE YELLOW GARAGE.


* DESCRIPTION PROVIDED BY VERMONT AGENCY OF TRANSPORTATION GEODETIC SURVEY UNIT

HVCTRL # 2
 STANDARD DISK STAMPED BANEFIELD
 N = 194969.1220
 E = 501909.7630
 ELEV. = 0.0000

DESCRIBED BY VERMONT AGENCY OF TRANSPORTATION 1996 (DJM) GENERAL LOCATION - THE STATION IS LOCATED IN THE TOWN EAST MONTPELIER, 1.2 MI (1.9 KM) SOUTHEAST OF EAST MONTPELIER VILLAGE, 4.0 MI (6.4 KM) NORTH OF BARRE, AND 5.2 MI (8.4 KM) EAST OF THE CITY OF MONTPELIER. TO REACH FROM THE JUNCTION OF U.S.ROUTE 2 AND VERMONT ROUTE 14 SOUTH IN THE VILLAGE OF EAST MONTPELIER PROCEED SOUTH ON ROUTE 14 FOR 1.2 MI (1.9 KM) TO A DIRT ROAD ON THE LEFT. TURN LEFT ONTO DIRT ROAD AND CONTINUE FOR 0.55 MI (0.89 KM) TO A T-INTERSECTION WITH THE ROAD, TURN LEFT AT INTERSECTION (COUNTRY CLUB ROAD) AND CONTINUE FOR 0.35 MI (0.56 KM) TO A POINT WHERE THE MAIN DIRT ROAD TURNS SHARPLY RIGHT, FROM THIS POINT TURN SHARPLY LEFT ON A LESSER DIRT ROAD FOR 0.05 MI (0.08 KM) TO A DIRT DRIVE RIGHT, TURN RIGHT ONTO DRIVE, TO A TWO STORY HOUSE, AND THE SITE OF THE MARK. THE MARK IS LOCATED ON THE NORTHEAST SIDE OF THE HOUSE. THE MARK IS A STATE OF VERMONT SURVEY DISK SET IN THE TOP OF A 6X6 INCH SQUARE CONCRETE MONUMENT, FLUSH WITH THE GROUND SURFACE. IT IS LOCATED 62.5 FT (19.1 M) NORTH OF THE NORTHEAST CORNER OF HOUSE / ATTACHED GARAGE, 54 FT (16.5 M) NORTHEAST OF A QUADRUPLE WHITE BIRCH, 45.5 FT (13.9 M) NORTHWEST OF A 36 INCH OAK TREE, 17.5 FT (5.3 M) EAST OF THE SOUTHEAST CORNER OF A LARGE EXPOSED BOULDER, 10 FT (3.0 M) NORTHEAST OF THE SOUTHEAST CORNER OF A FLOWER BED, AND 0.8 FT (24.4 CM) SOUTH OF A FIBERGLASS WITNESS POST. OWNERSHIP IS MR. AND MRS. EDWARD BANFIELD.



TRAVERSE TIES


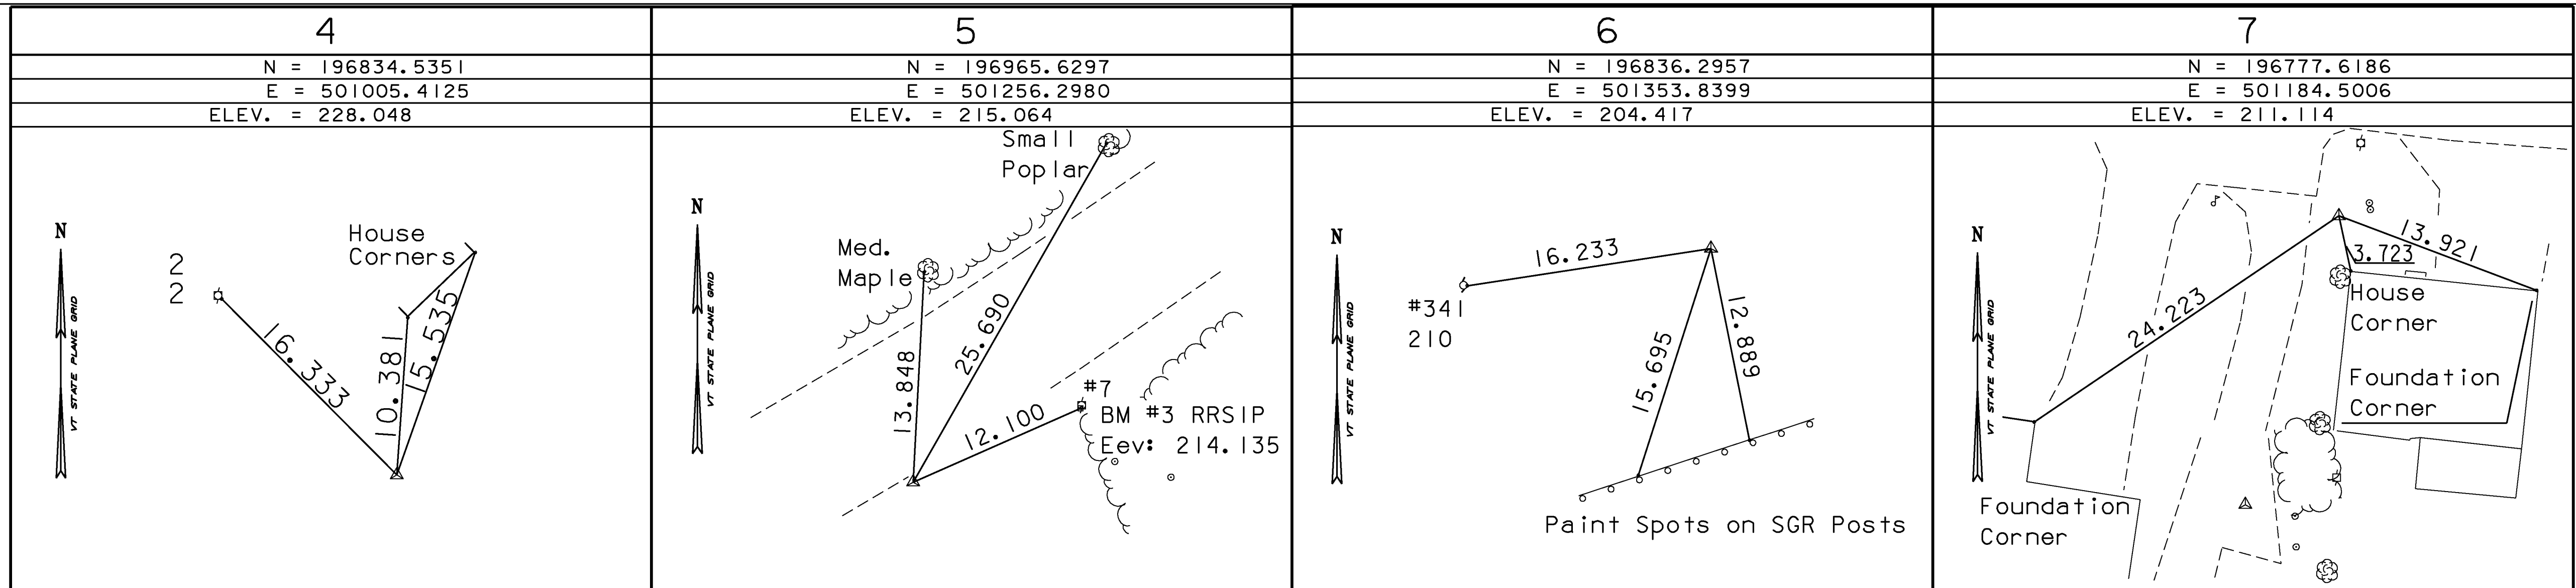


* MAIN TRAVERSE COMPLETED Sept. 24, 1998 R. Gilman P.C. T. Companion

ALIGNMENT TIES

DATUM
 VERTICAL NAVD 88
 HORIZONTAL NAD 83(92)
 ADJUSTMENT Compass

PROJECT NAME: EAST MONTPELIER
 PROJECT NUMBER: STPG 028 - 3(35)S
 FILE NAME: +98b028frm.dgn PLOT DATE: 22-MAR-2010
 PROJECT LEADER: J. SCHULTZ DRAWN BY: R. BULLOCK
 DESIGNED BY: J. GRUCHACZ CHECKED BY: P. HODGE
 TIE SHEET SHEET 25 OF 142

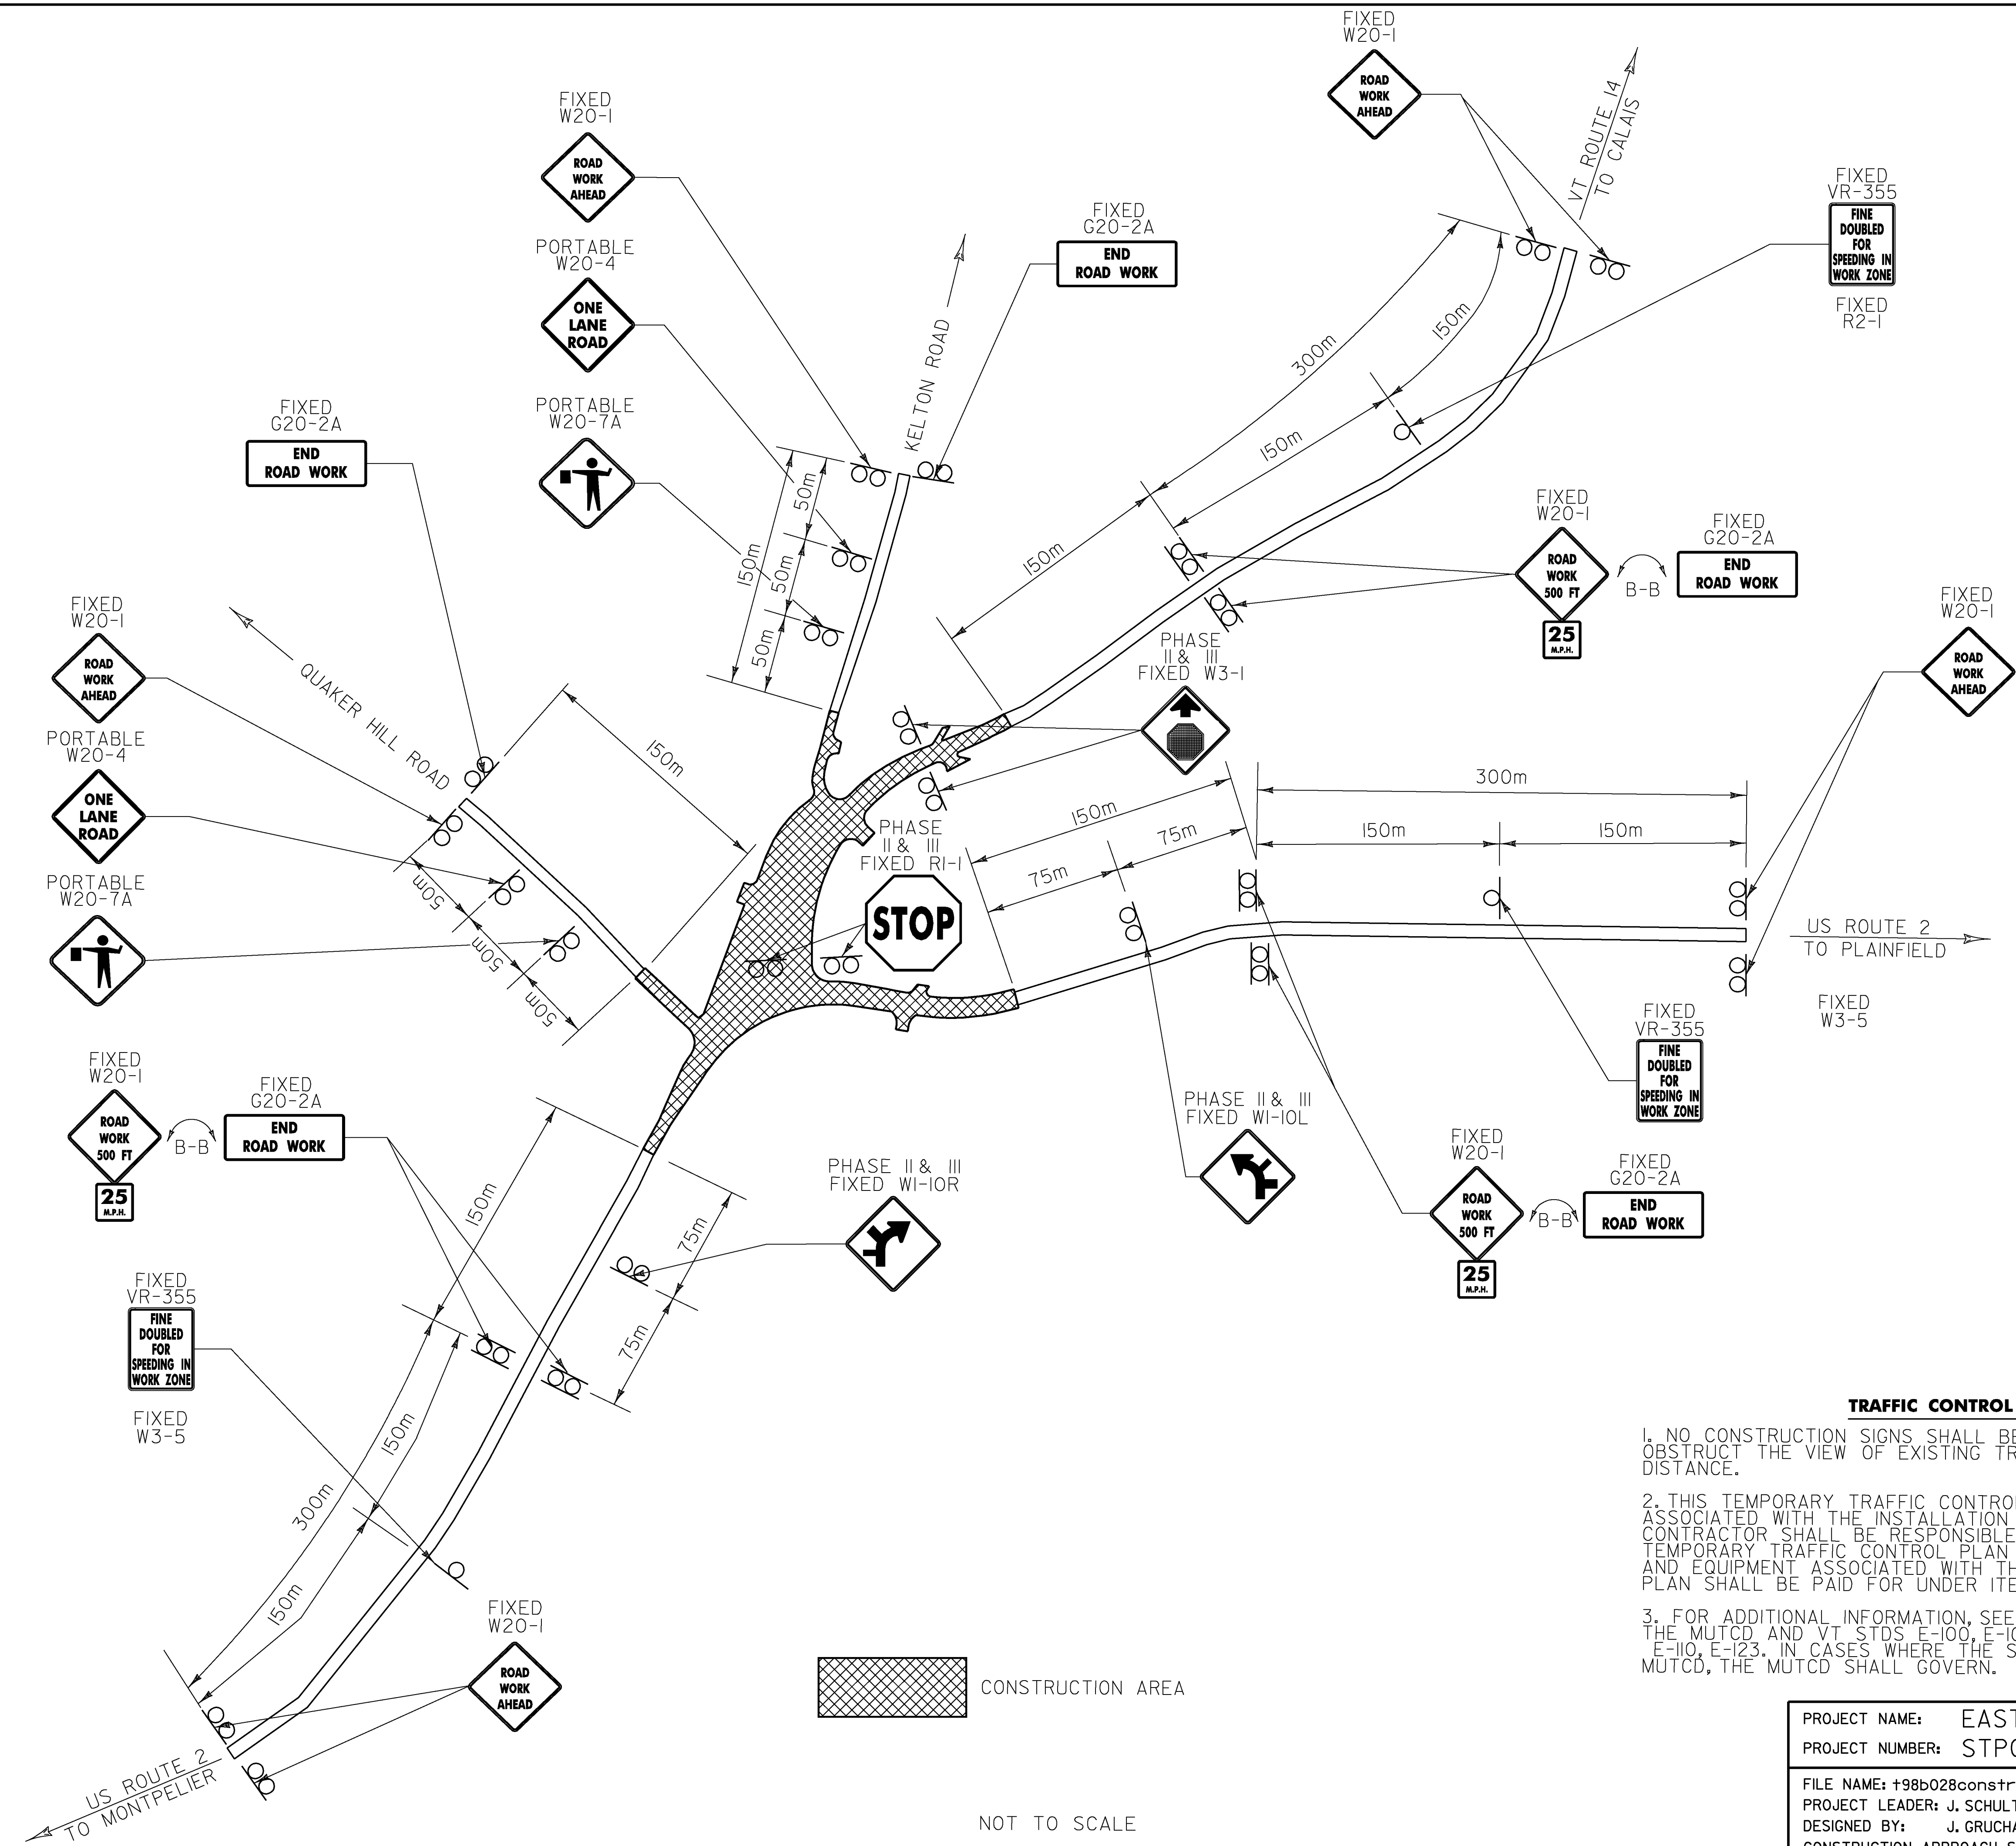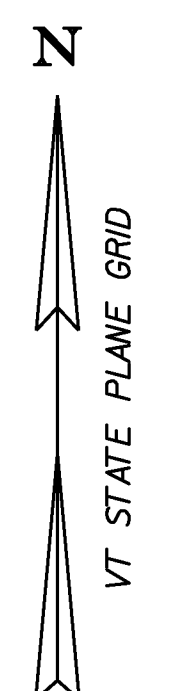


NOT TO SCALE


TRAFFIC CONTROL GENERAL NOTES

1. NO CONSTRUCTION SIGNS SHALL BE INSTALLED AS TO INTERFERE OR OBSTRUCT THE VIEW OF EXISTING TRAFFIC DEVICES AND STOPPING SIGHT DISTANCE.
2. THIS TEMPORARY TRAFFIC CONTROL SIGN SHEET COVERS WORK ASSOCIATED WITH THE INSTALLATION OF THE TRAFFIC SIGNAL. THE CONTRACTOR SHALL BE RESPONSIBLE FOR PROVIDING A SEPARATE TEMPORARY TRAFFIC CONTROL PLAN FOR ALL OTHER WORK. ALL WORK AND EQUIPMENT ASSOCIATED WITH THIS TEMPORARY TRAFFIC CONTROL PLAN SHALL BE PAID FOR UNDER ITEM 641.10 - TRAFFIC CONTROL.
3. FOR ADDITIONAL INFORMATION, SEE THE MOST CURRENT EDITION OF THE MUTCD AND VT STDS E-100, E-100A, E-101, E-102, E-106, E-107, E-107A, E-110, E-123. IN CASES WHERE THE STANDARDS CONFLICT WITH THE MUTCD, THE MUTCD SHALL GOVERN.

PROJECT NAME:	EAST MONTPELIER
PROJECT NUMBER:	STPG 028 - 3(35)S
FILE NAME:	+98b028constructionsigns.dgn
PLOT DATE:	22-MAR-2010
PROJECT LEADER:	J. SCHULTZ
DRAWN BY:	D. LYMAN
DESIGNED BY:	J. GRUCHACZ
CHECKED BY:	J. DEVLIN
CONSTRUCTION APPROACH SIGNS SHEET	SHEET 26 OF 142

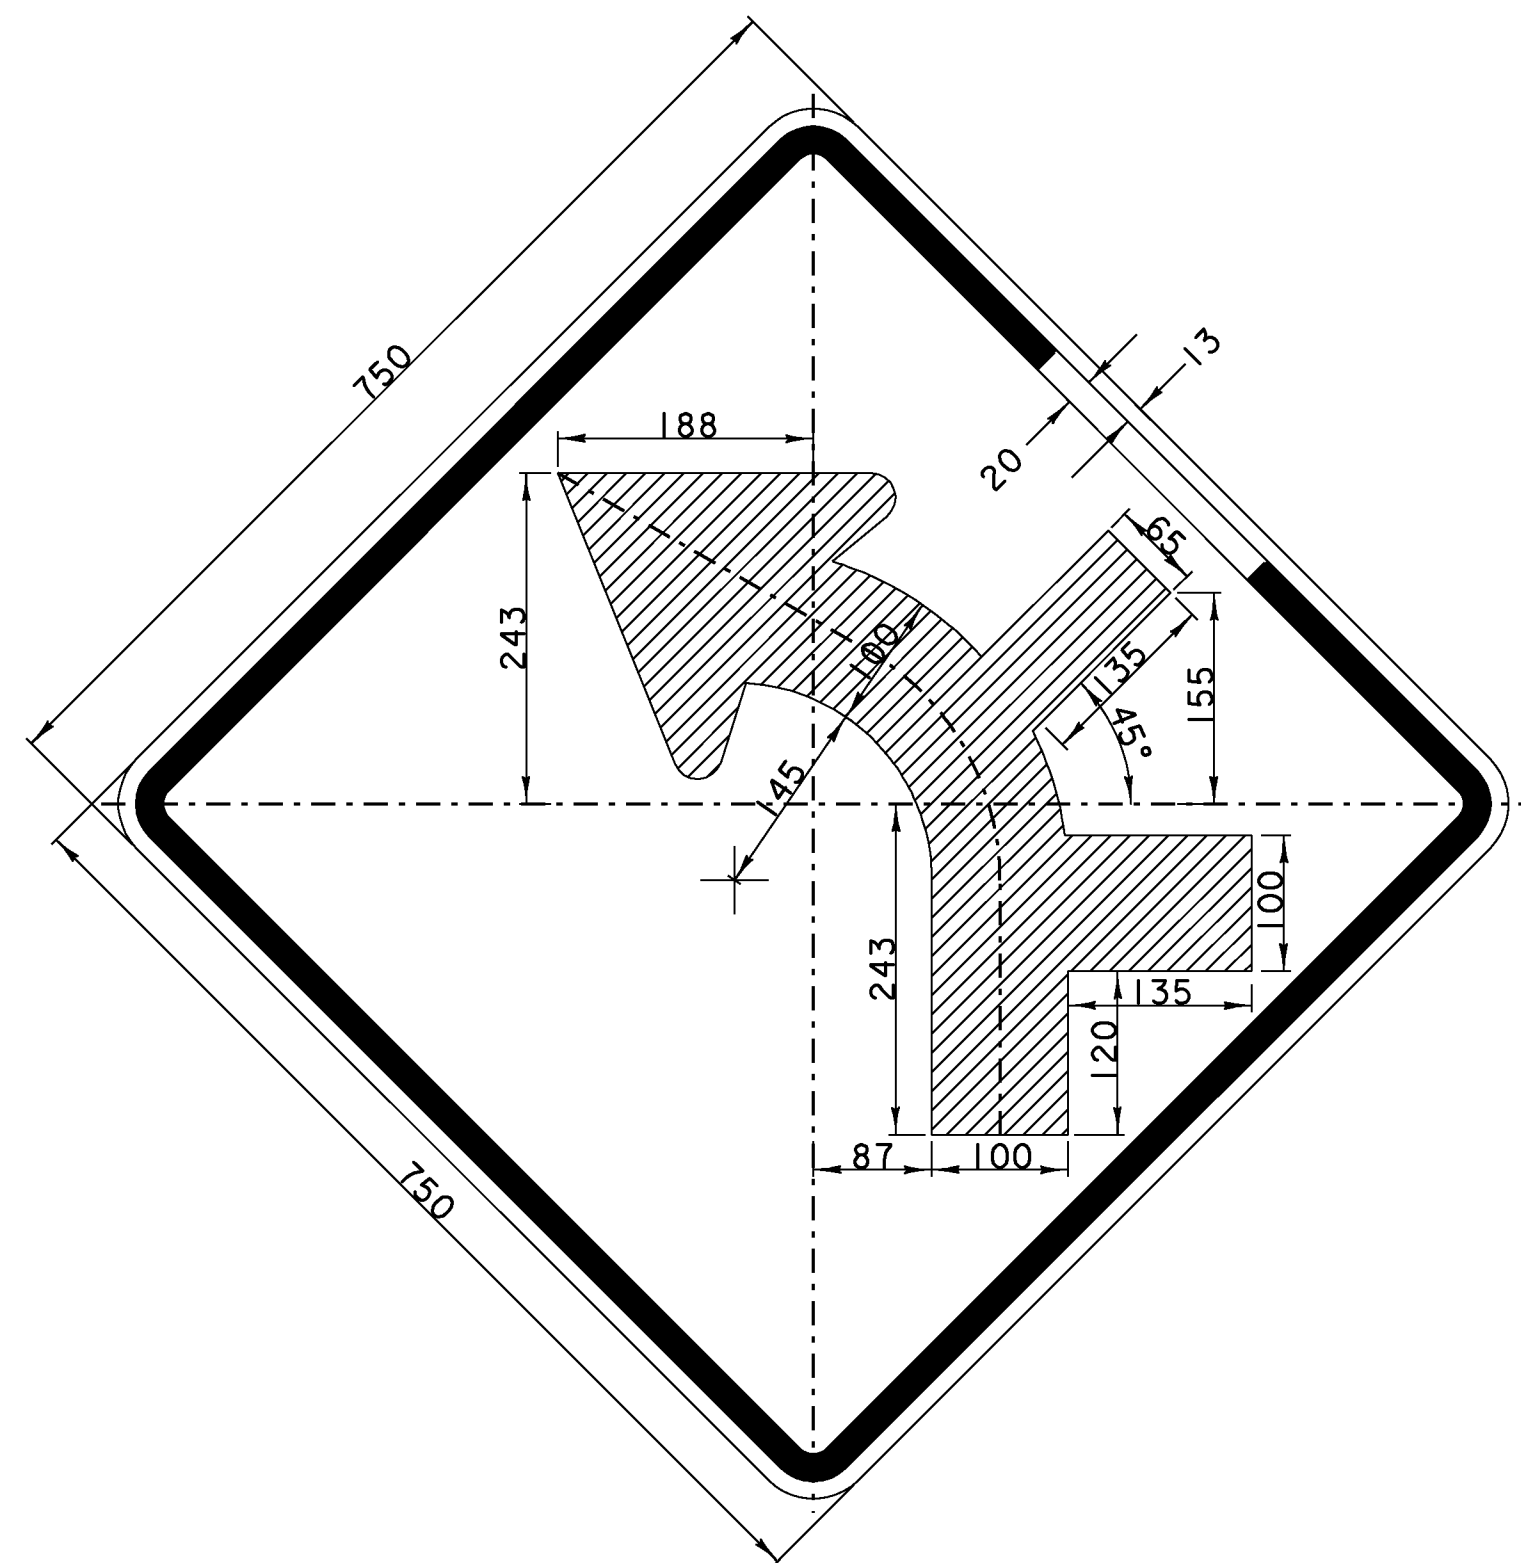



WI-10L (MOD)

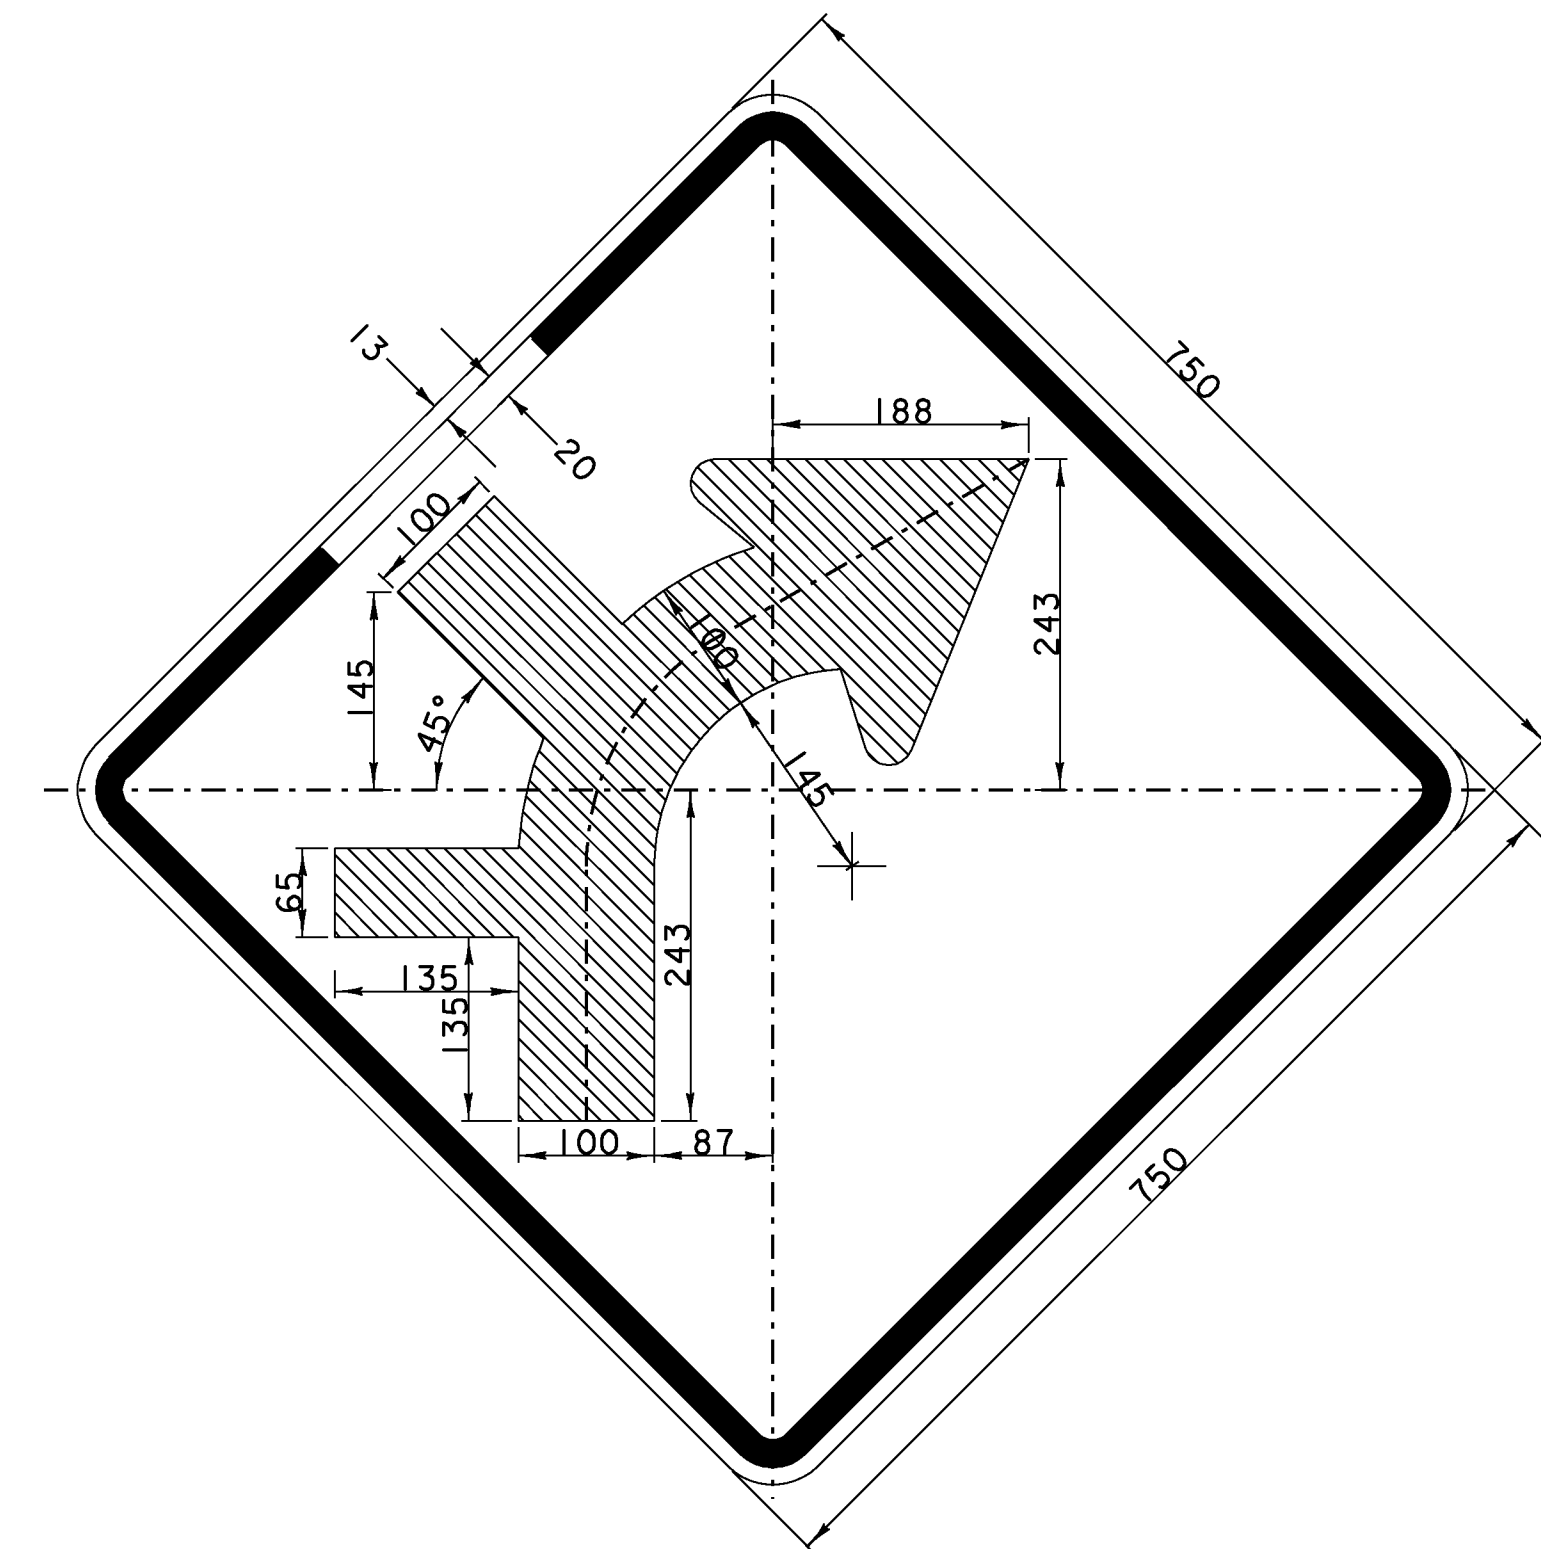

WI-10R (MOD)

PROJECT NAME: EAST MONTEPELIER
 PROJECT NUMBER: STPG 028 - 3(35)S

FILE NAME: +98b028constructionsigns.dgn PLOT DATE: 22-MAR-2010
 PROJECT LEADER: J. SCHULTZ DRAWN BY: D. LYMAN
 DESIGNED BY: J. GRUCHACZ CHECKED BY: J. DEVLIN
 CONSTRUCTION SIGNS DETAIL SHEET SHEET 27 OF 142

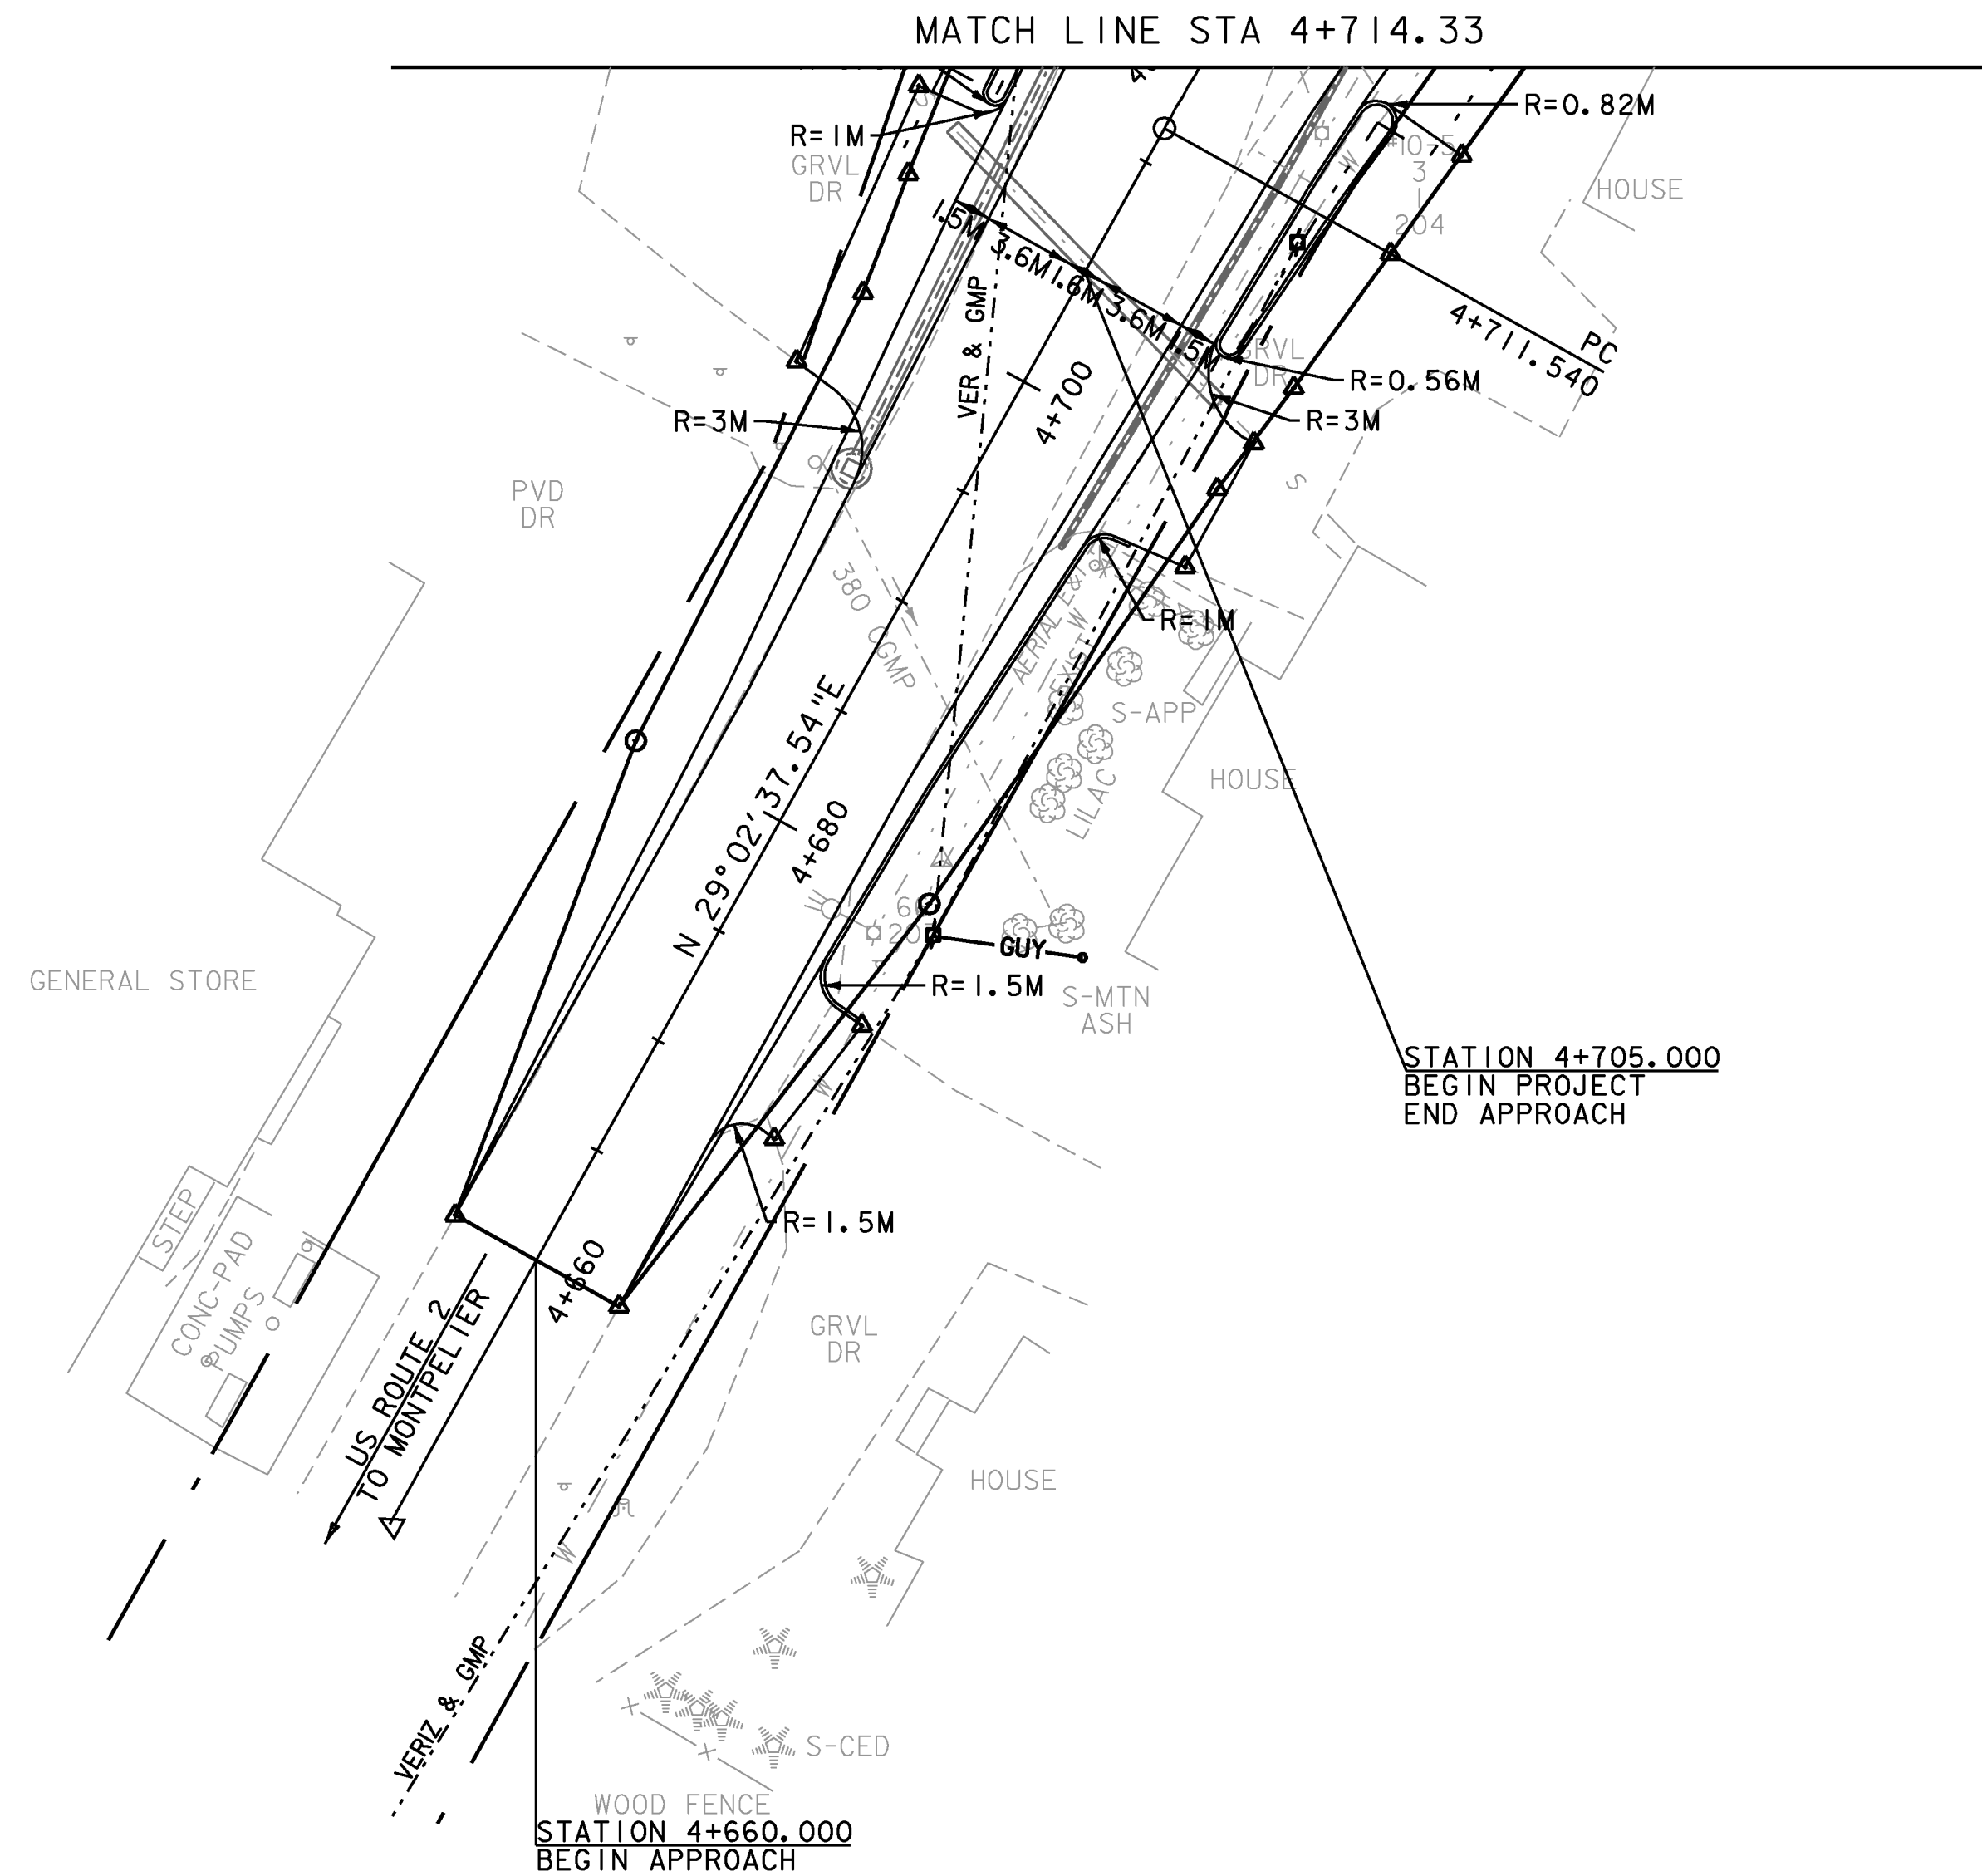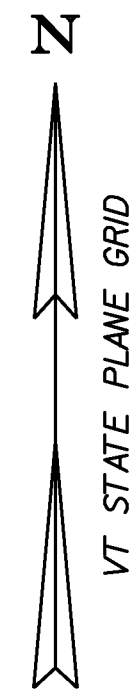

210.10 COLD PLANING BITUMINOUS PAVEMENT
 STA 4+660.00 - 4+674.50

616.21 VERTICAL GRANITE CURB
 STA 4+674.49 RT - 4+696.44 RT
 STA 4+704.72 RT - 4+717.10 RT (ISLAND)
 STA 4+709.00 LT - 4+710.63 LT (ISLAND)

620.55 REMOVAL OF EXISTING FENCE
 STA 4+694.96 RT - 4+695.03 RT

900.675 SPECIAL PROVISION
 (HAND PLACED BITUMINOUS CONCRETE MATERIAL, DRIVES)
 STA 4+660.00 LT - 4+692.00 LT (PAVED DRIVE APRON)
 STA 4+672.00 RT (6.1M - PAVED)
 STA 4+699.00 RT (5.8M - PAVED)
 STA 4+702.00 LT (12.0M - PAVED)



PROJECT NAME: EAST MONTPELIER
 PROJECT NUMBER: STPG 028 - 3(35)S

FILE NAME: +98b028bdr.dgn
 PROJECT LEADER: J. SCHULTZ
 DESIGNED BY: J. GRUCHACZ
 LAYOUT SHEET 1

PLOT DATE: 22-MAR-2010
 DRAWN BY: D. LYMAN
 CHECKED BY: J. DEVLIN
 SHEET 28 OF 142



210.10 COLD PLANING BITUMINOUS PAVEMENT
STA 40+052.75 - 40+060.00

203.28 EXCAVATION OF SURFACES AND PAVEMENTS
STA 100+082.36 RT - 100+157.58 RT
STA 100+091.40 LT - 100+155.08 RT


616.20 GRANITE SLOPED EDGING
STA 4+780.10 LT - 14+037.50 LT

616.21 VERTICAL GRANITE CURB
STA 4+710.63 LT - 40+015.38 LT (ISLAND)
STA 4+731.70 RT - 4+752.80 RT (ISLAND)
STA 4+752.80 RT - 4+810.90 RT
STA 4+812.40 RT - 4+854.94 RT
STA 4+813.80 LT - 4+861.80 LT
STA 14+037.50 RT - 4+812.30 LT
STA 14+039.00 LT - 14+042.00 LT
STA 14+039.00 RT - 14+044.90 RT
STA 40+023.40 RT - 4+780.10 LT
STA 100+082.37 RT - 100+098.30 RT
STA 100+099.80 RT - 100+103.80 RT

618.10 PORTLAND CEMENT CONCRETE SIDEWALK, 125MM
STA 40+014.54 RT - 14+039.00 LT
STA 14+039.00 RT - 4+813.80 LT
STA 4+810.90 RT - 4+856.61 RT
STA 100+082.37 RT - 100+156.58 RT

CONSTRUCT SIDEWALK RAMP WITH
618.30 DETECTABLE WARNING SURFACE
STA 4+811.65 RT - TYPE 6
STA 4+813.07 LT - TYPE 1
STA 4+854.64 RT - TYPE 1
STA 14+038.25 LT - TYPE 1
STA 14+038.25 RT - TYPE 1
STA 100+082.67 RT - TYPE 1
STA 100+099.05 RT - TYPE 6

900.675 SPECIAL PROVISION
(HAND PLACED BITUMINOUS CONCRETE MATERIAL, DRIVES)
STA 4+723.00 RT (12.0M - PAVED)
STA 4+863.00 RT (7.3M - PAVED)
STA 4+871.00 LT (7.3M - PAVED)
STA 40+023.00 LT (12.0M - PAVED)
STA 100+076.00 RT (12.5M - PAVED)
CONSTRUCT MOUNTABLE APRON
STA 4+780.10 LT - 14+037.50 LT (PAVED)

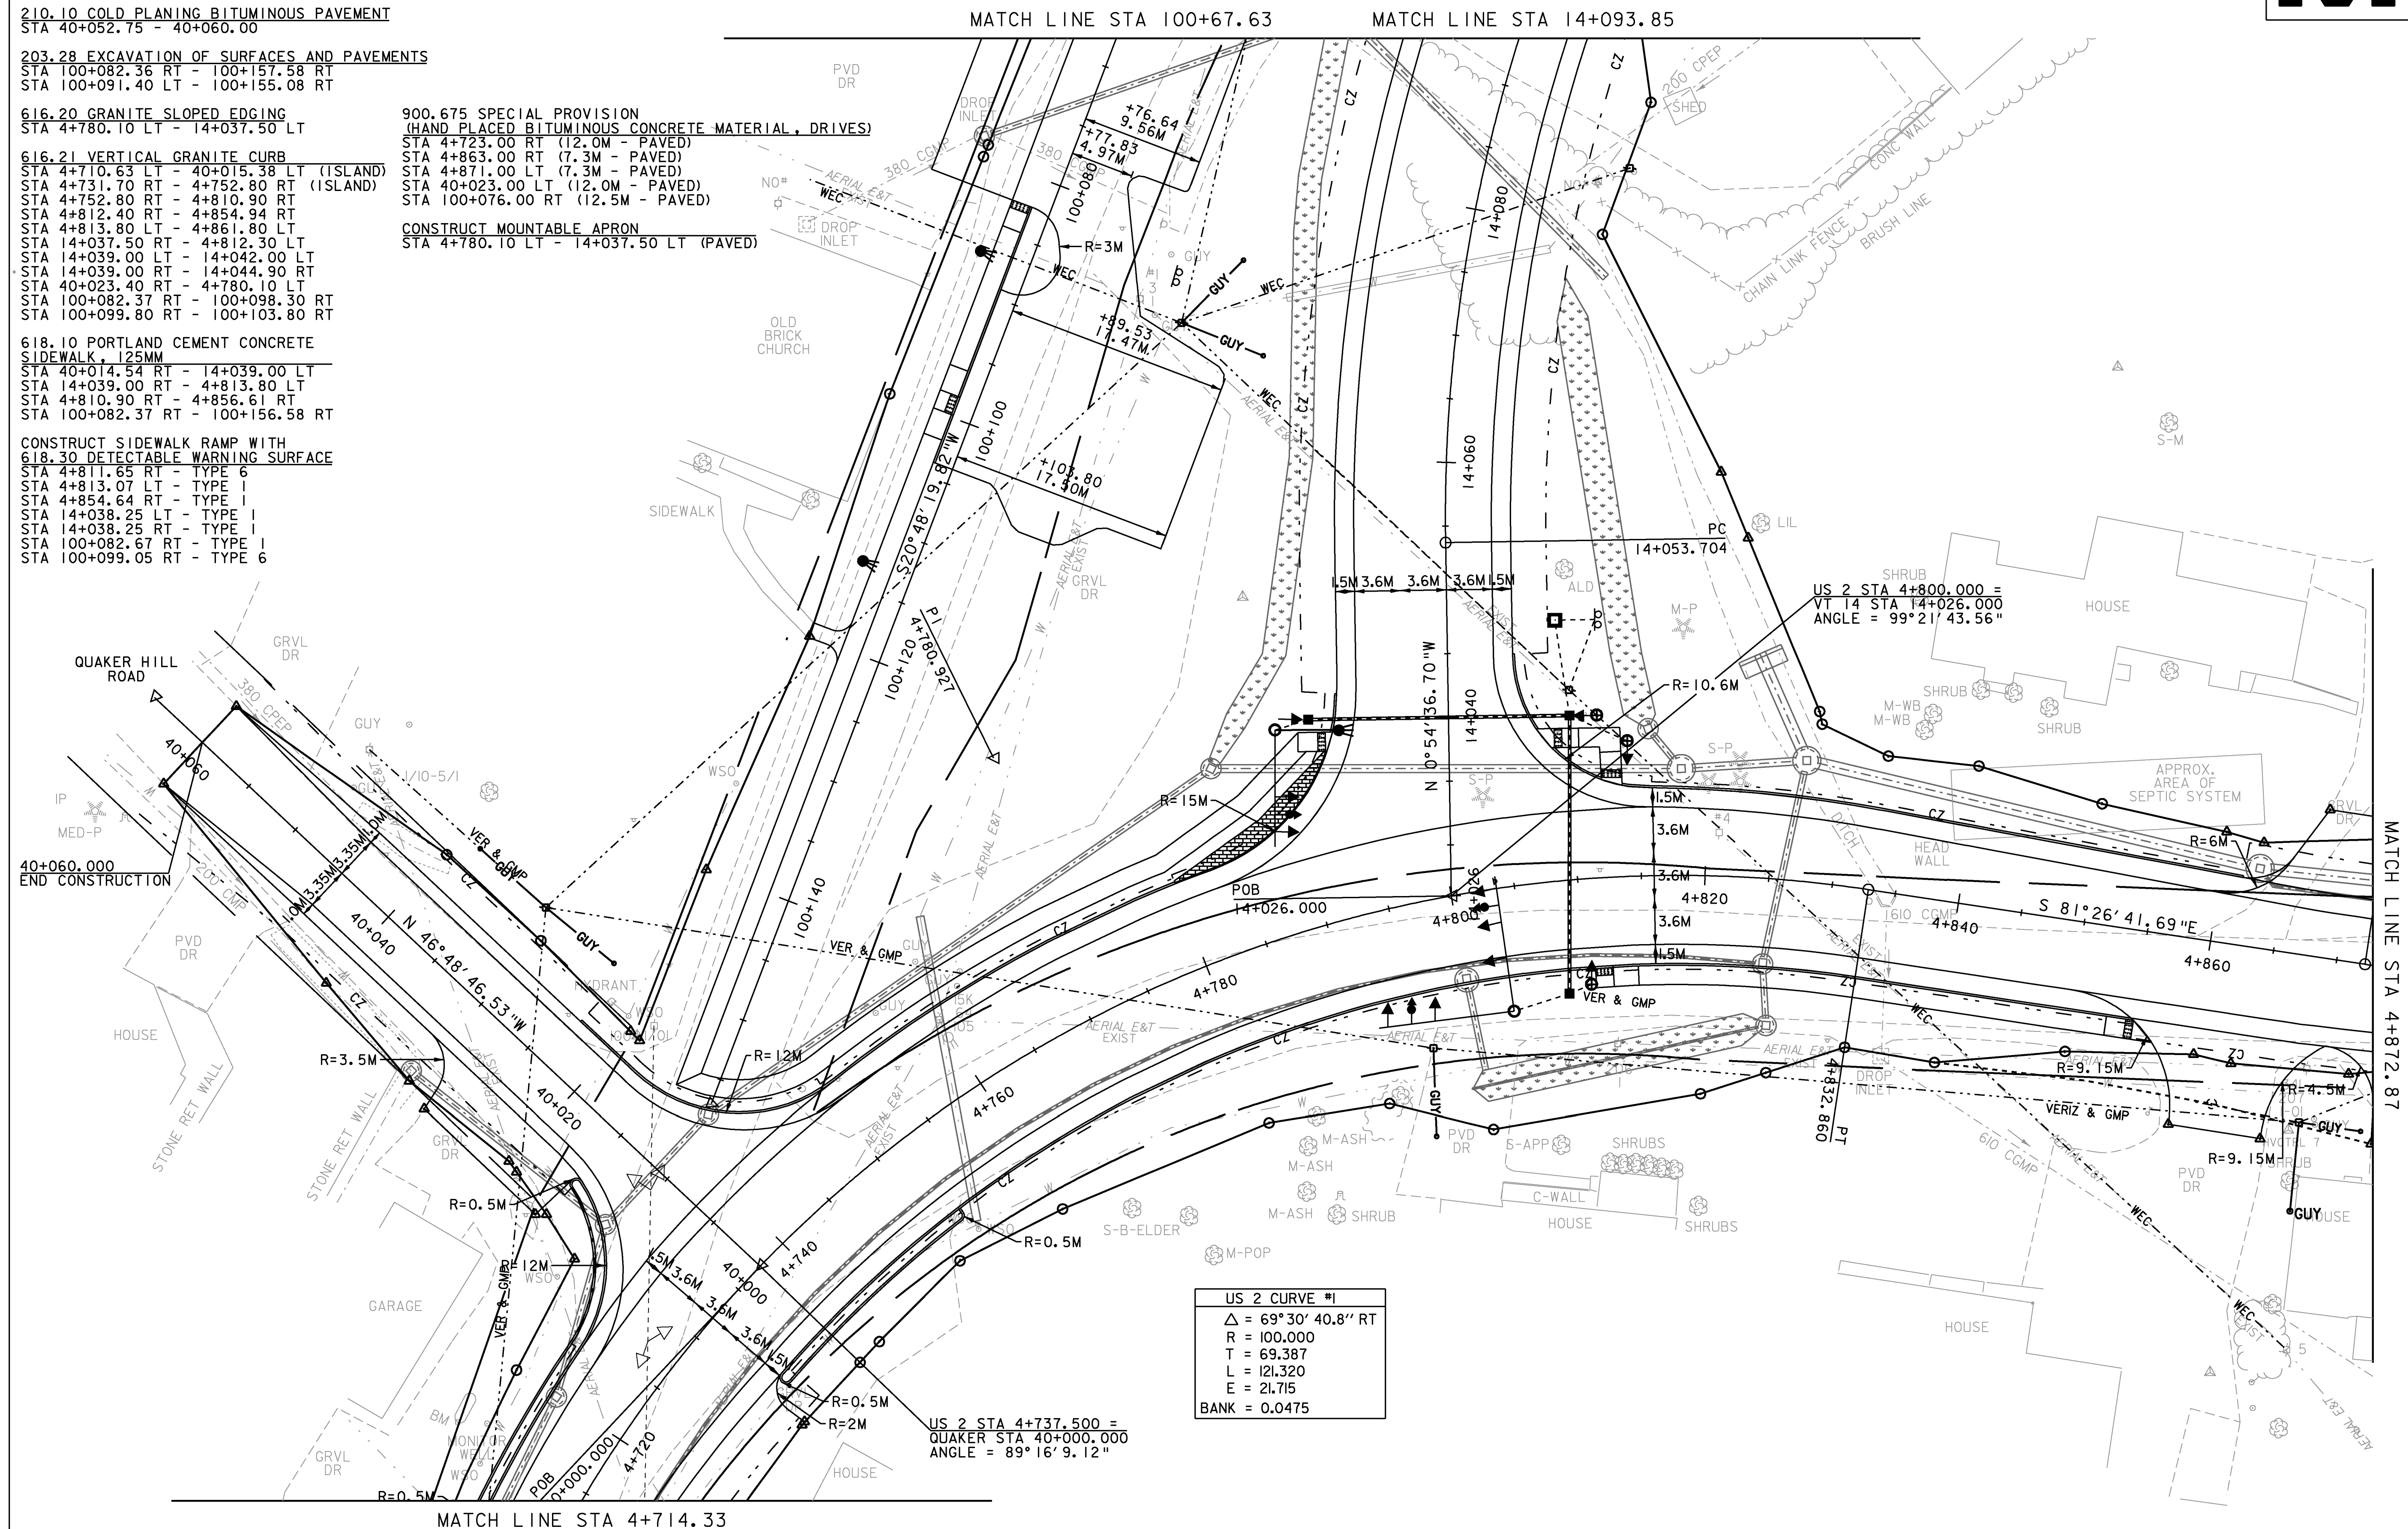


US 2 CURVE #1	
Δ	= 69°30' 40.8" RT
R	= 100.000
T	= 69.387
L	= 121.320
E	= 21.715
BANK	= 0.0475

US 2 STA 4+737.500 =
QUAKER STA 40+000.000
ANGLE = 89°16' 9.12"




PROJECT NAME: EAST MONTPELIER
PROJECT NUMBER: STPG 028-3(35)S
FILE NAME: +98b028bdr.dgn
PROJECT LEADER: J. SCHULTZ
DESIGNED BY: J. GRUCHACZ
LAYOUT SHEET 2
PLOT DATE: 22-MAR-2010
DRAWN BY: D. LYMAN
CHECKED BY: J. DEVLIN
SHEET 29 OF 142

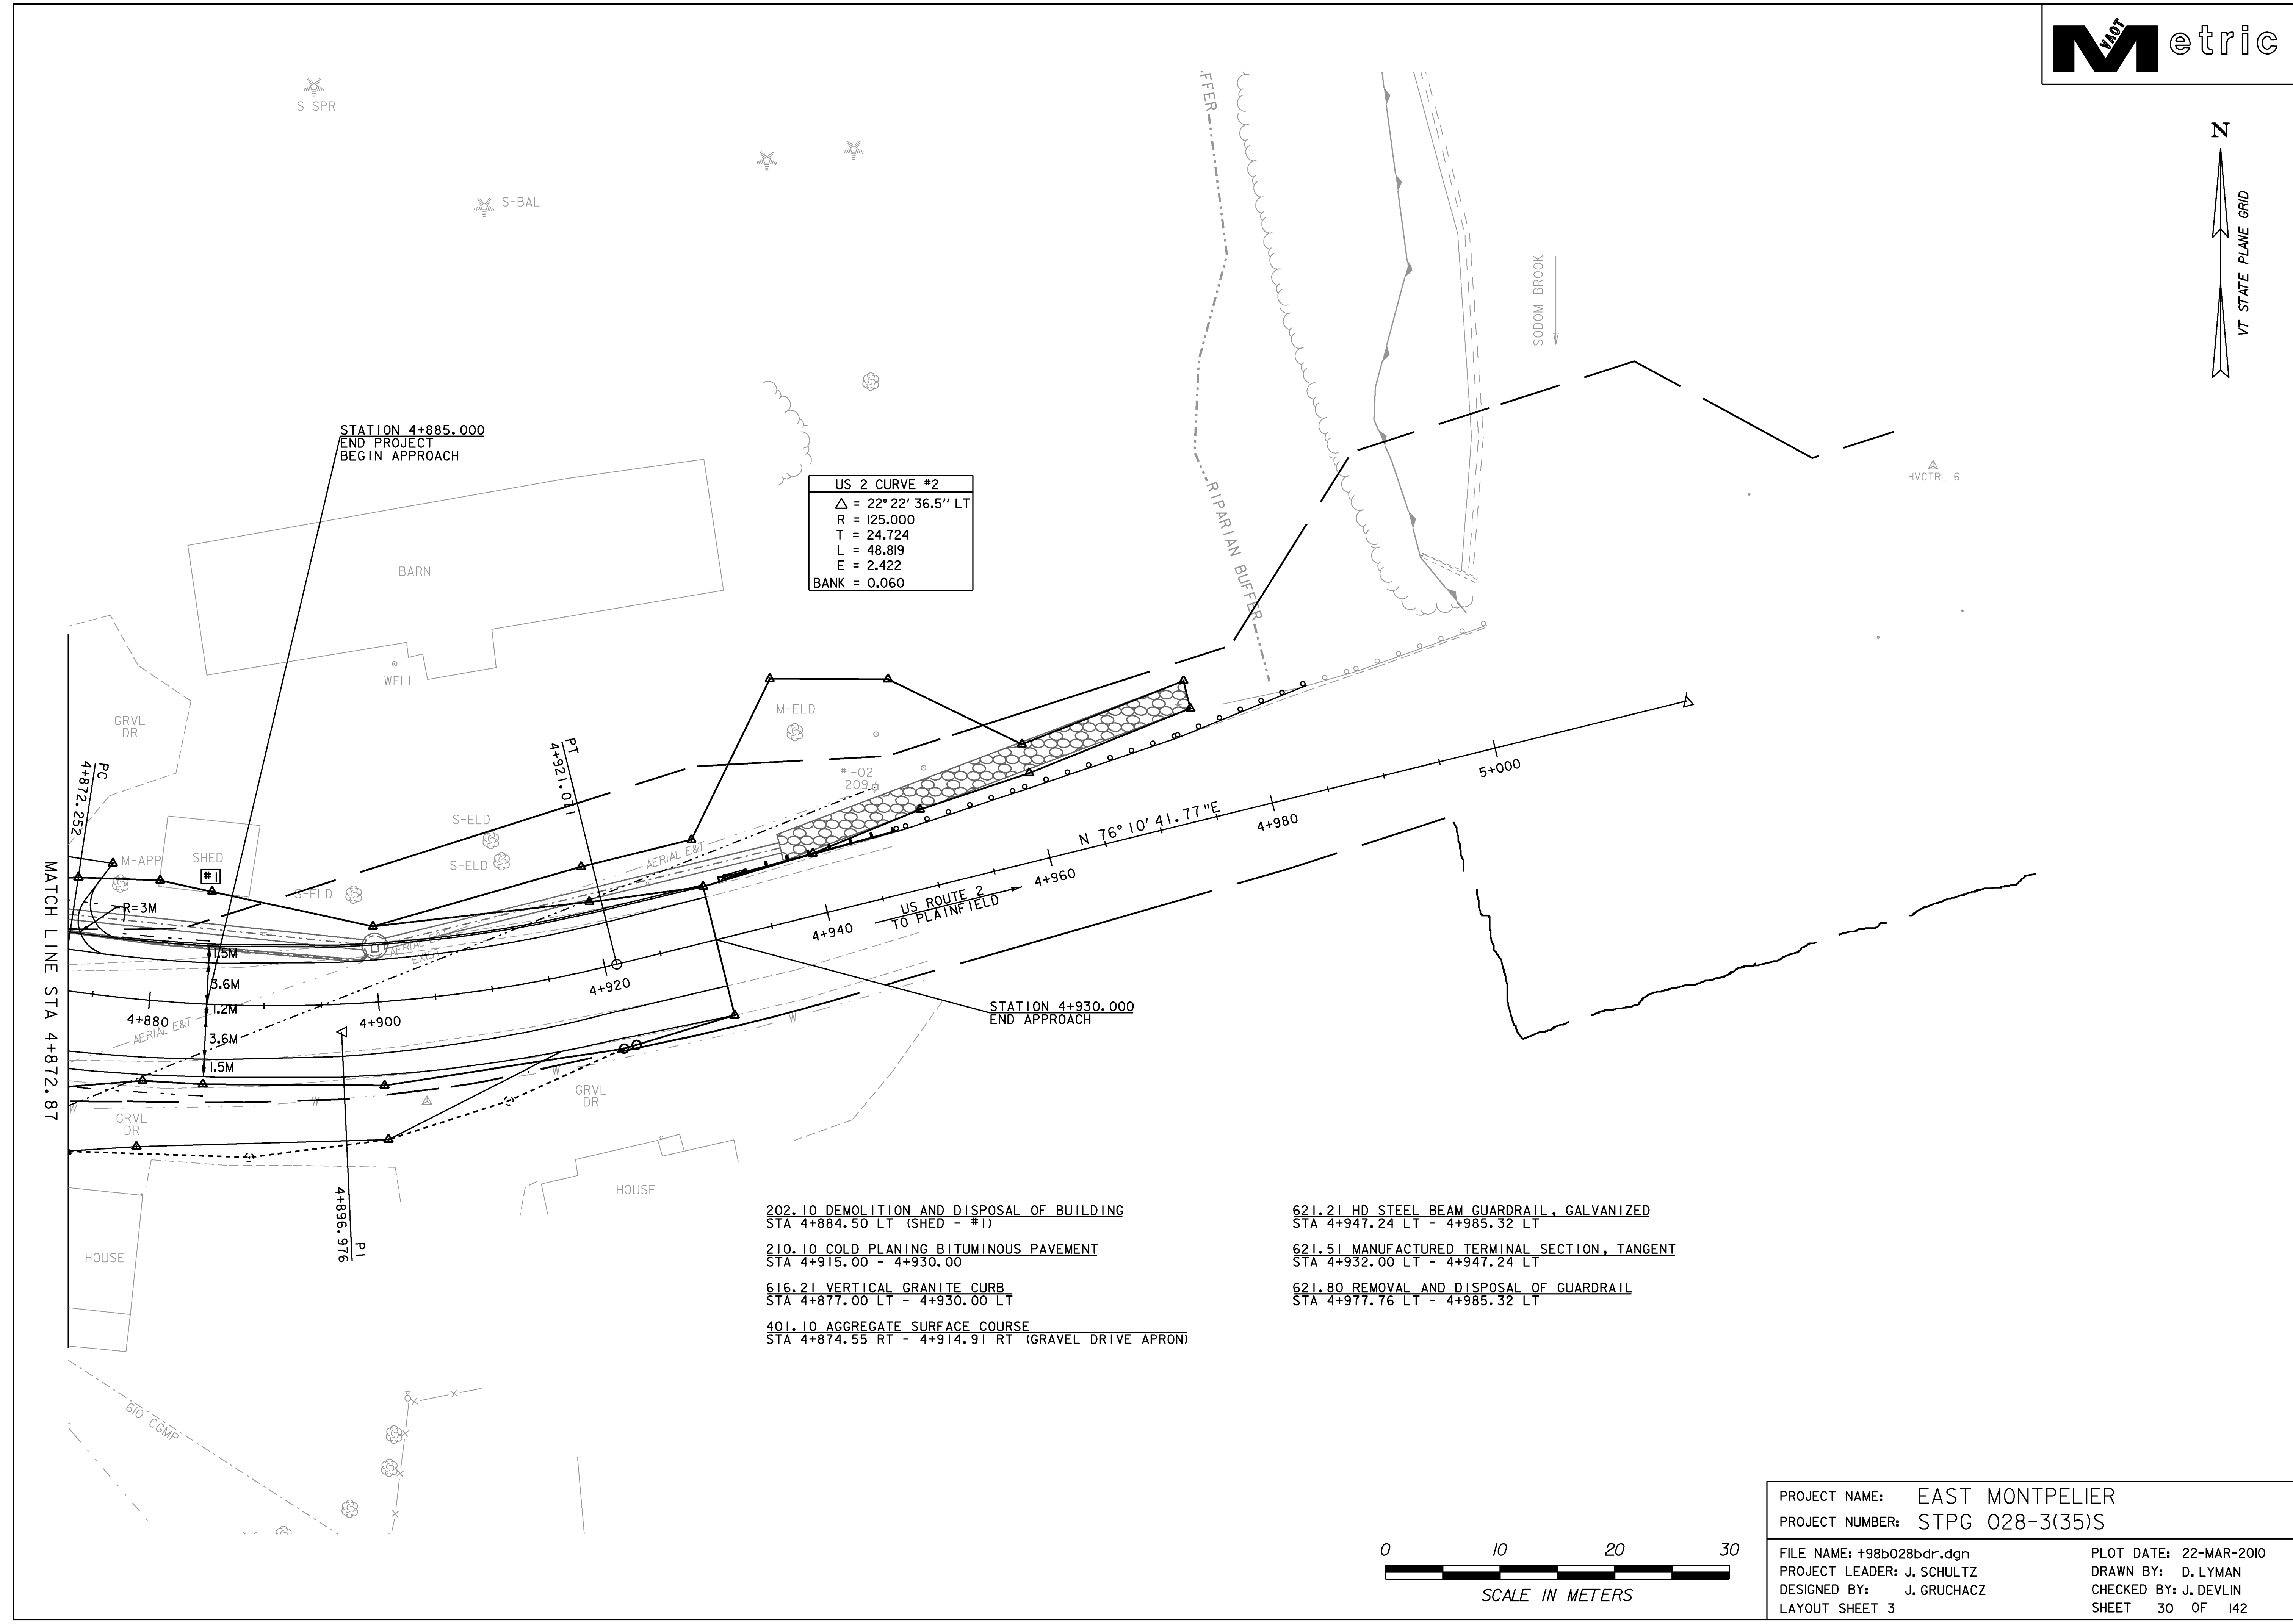

- 202.10 DEMOLITION AND DISPOSAL OF BUILDING
STA 4+884.50 LT (SHED - #1)
- 210.10 COLD PLANING BITUMINOUS PAVEMENT
STA 4+915.00 - 4+930.00
- 616.21 VERTICAL GRANITE CURB
STA 4+877.00 LT - 4+930.00 LT
- 401.10 AGGREGATE SURFACE COURSE
STA 4+874.55 RT - 4+914.91 RT (GRAVEL DRIVE APRON)

- 621.21 HD STEEL BEAM GUARDRAIL, GALVANIZED
STA 4+947.24 LT - 4+985.32 LT
- 621.51 MANUFACTURED TERMINAL SECTION, TANGENT
STA 4+932.00 LT - 4+947.24 LT
- 621.80 REMOVAL AND DISPOSAL OF GUARDRAIL
STA 4+977.76 LT - 4+985.32 LT

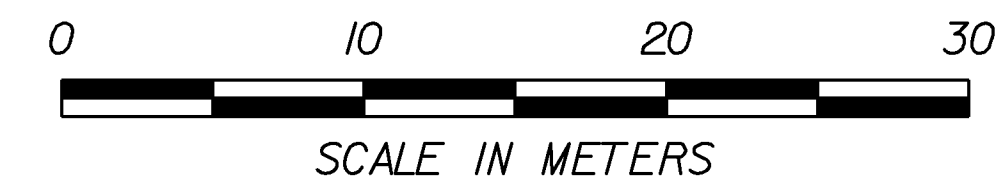


PROJECT NAME:	EAST MONTPELIER	FILE NAME:	+98b028bdr.dgn	PLOT DATE:	22-MAR-2010
PROJECT NUMBER:	STPG 028-3(35)S	PROJECT LEADER:	J. SCHULTZ	DRAWN BY:	D. LYMAN
		DESIGNED BY:	J. GRUCHACZ	CHECKED BY:	J. DEVLIN
		LAYOUT SHEET 3		SHEET	30 OF 142

VT 14 CURVE #2	
Δ	= 7° 31' 53.0" LT
R	= 125.000
T	= 8.227
L	= 16.431
E	= 0.270
BANK	= 0.0435

KELTON CURVE	
Δ	= 6° 38' 25.9" RT
R	= 20.000
T	= 11.932
L	= 21.517
E	= 3.289
BANK	= NC

VT 14 CURVE #1	
Δ	= 66° 25' 19.5" RT
R	= 125.000
T	= 81.832
L	= 144.911
E	= 24.404
BANK	= 0.0435

NEW PARKING CURVE	
Δ	= 35° 11' 36.5" LT
R	= 70.000
T	= 22.225
L	= 43.041
E	= 3.444
BANK	= 0.0025

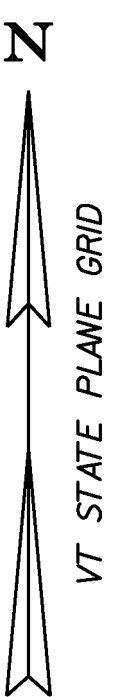

210.10 COLD PLANING, BITUMINOUS PAVEMENT
STA 14+240.50 - 14+255.00

203.28 EXCAVATION OF SURFACES AND PAVEMENTS
STA 14+093.41 LT - 14+136.70 LT
STA 14+143.52 LT - 14+177.43 LT
STA 100+019.55 RT - 30+032.38 LT

401.10 AGGREGATE SURFACE COURSE
STA 14+201.00 LT (4.8M - GRAVEL DRIVE)
STA 30+053.00 RT (7.0M - GRAVEL DRIVE)
STA 30+060.00 - 30+070.00 (KELTON ROAD)

900.675 SPECIAL PROVISION
(HAND PLACED BITUMINOUS CONCRETE MATERIAL, DRIVES)
STA 14+137.00 RT (10.5M - PAVED)
STA 14+217.00 RT (9.1M - PAVED)


KELTON STA 30+020.000 =
NEW PARKING STA 100+000.000
ANGLE = 90°


6" PVC SLEEVE FOR WEC

MATCH LINE STA 100+67.63 MATCH LINE STA 14+093.85





PROJECT NAME:	EAST MONTPELIER
PROJECT NUMBER:	STPG 028-3(35)S
FILE NAME:	+98b028bdr.dgn
PROJECT LEADER:	J. SCHULTZ
DESIGNED BY:	J. GRUCHACZ
LAYOUT SHEET	4
PLOT DATE:	29-MAR-2010
DRAWN BY:	D. LYMAN
CHECKED BY:	J. DEVLIN
SHEET	31 OF 142

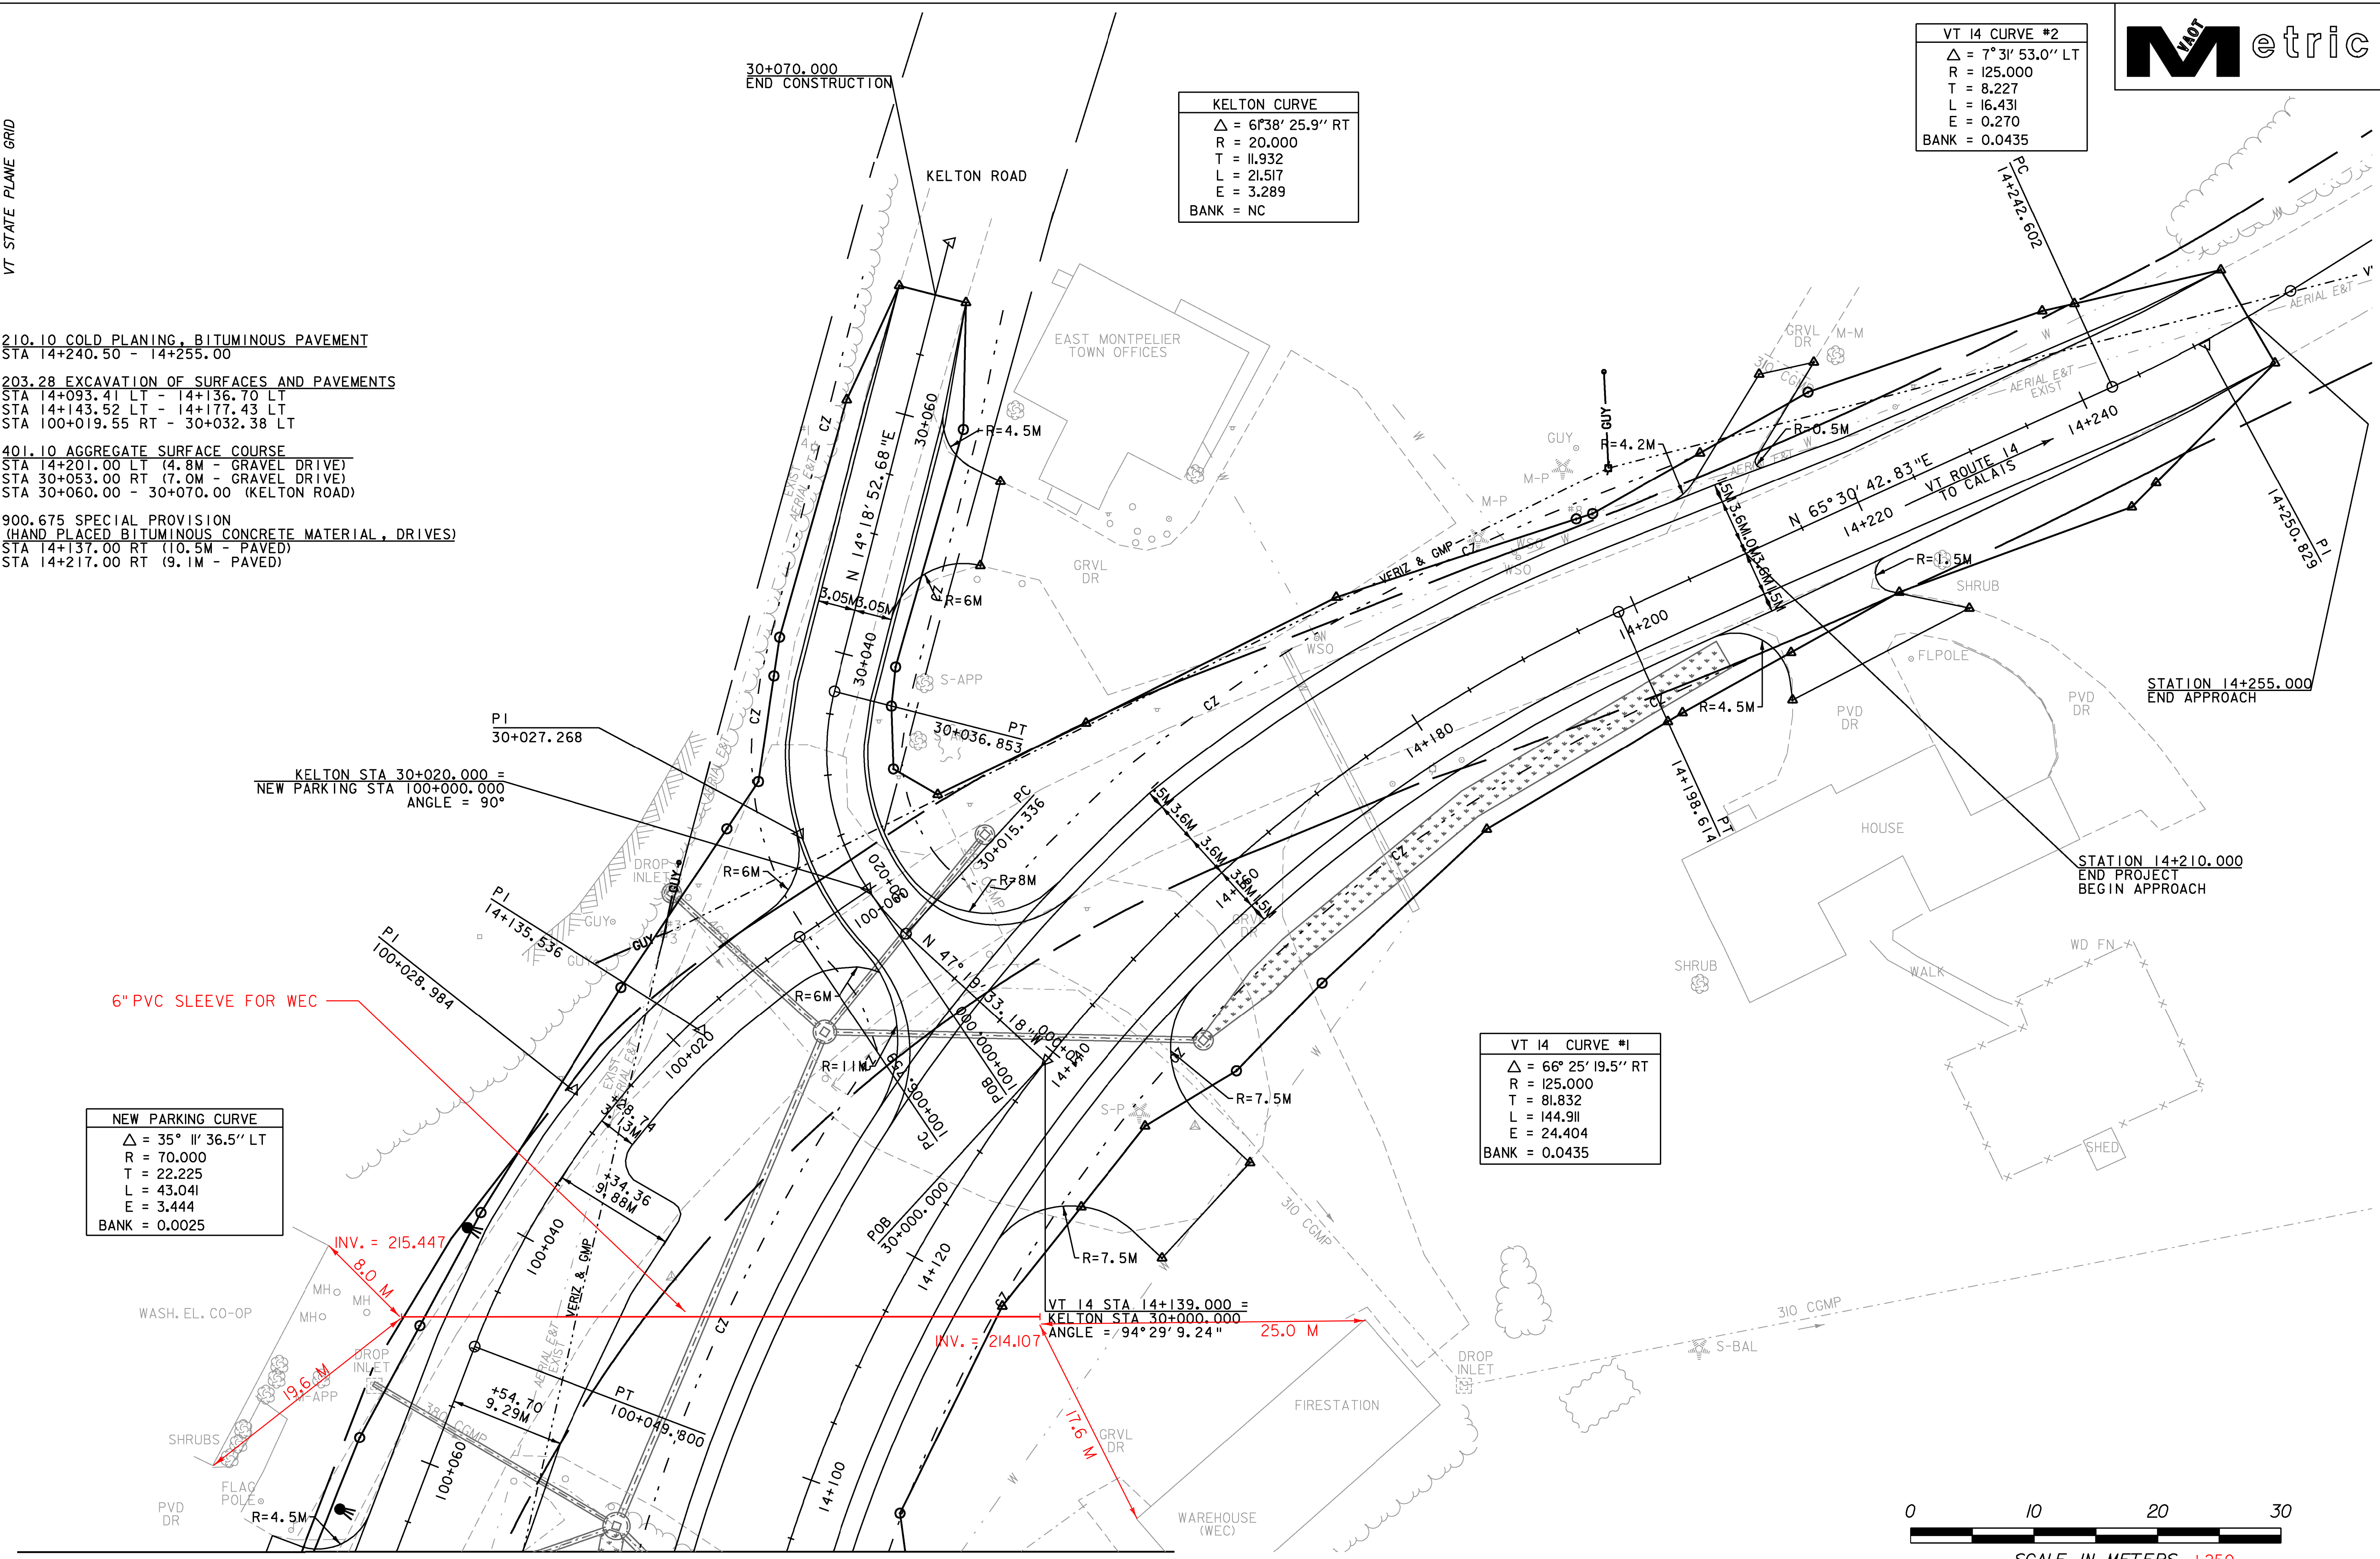

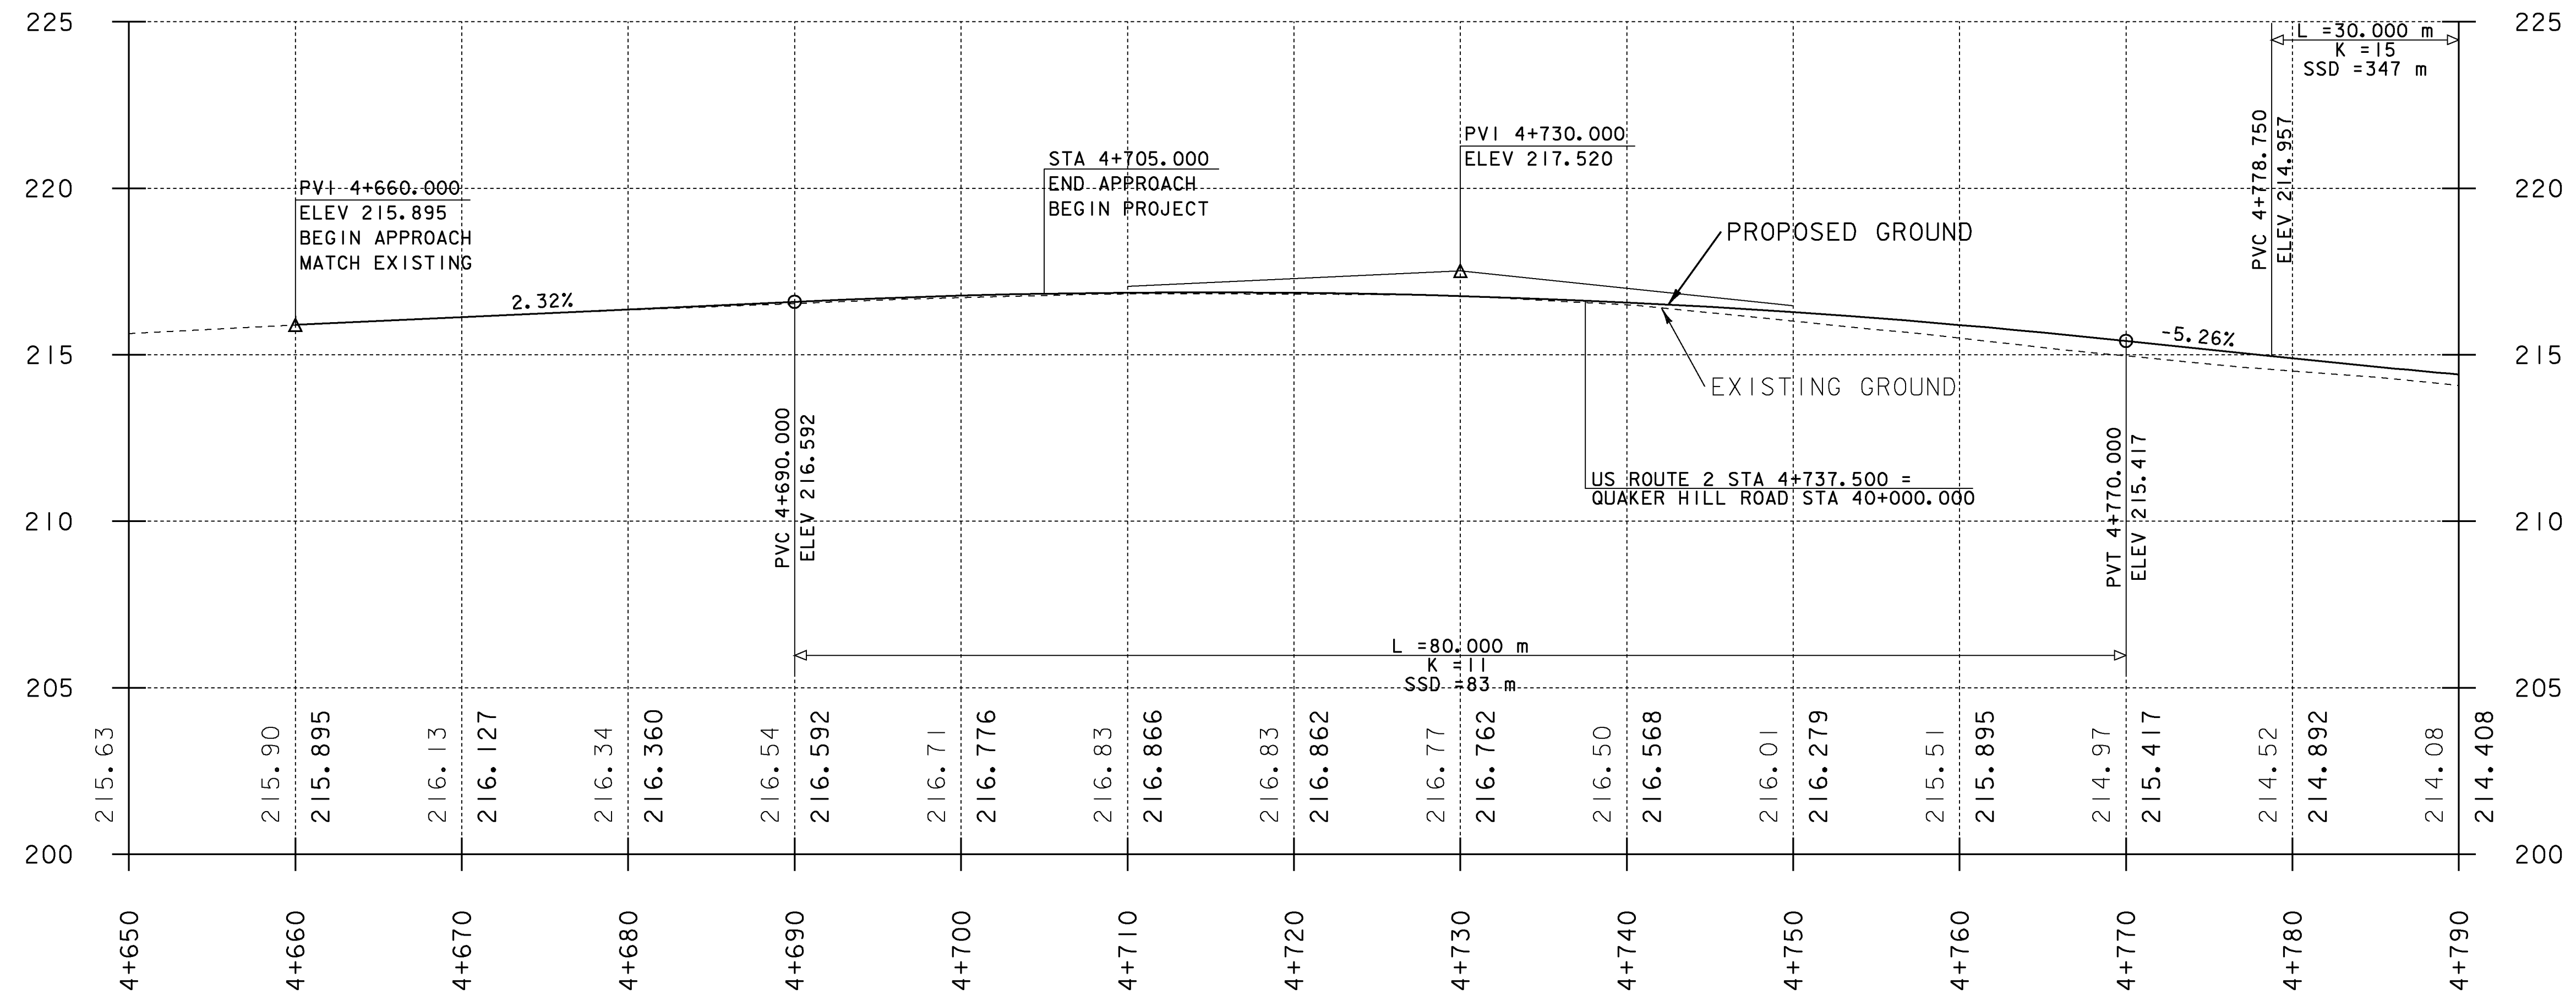


THE ELEVATIONS SHOWN TO THE NEAREST HUNDREDTH ARE THE OLD GROUND ALONG REVISED CENTERLINE. THE ELEVATIONS SHOWN TO THE NEAREST THOUSANDTH ARE THE PROPOSED FINISHED GRADE ALONG REVISED CENTERLINE.

US ROUTE 2 PROFILE

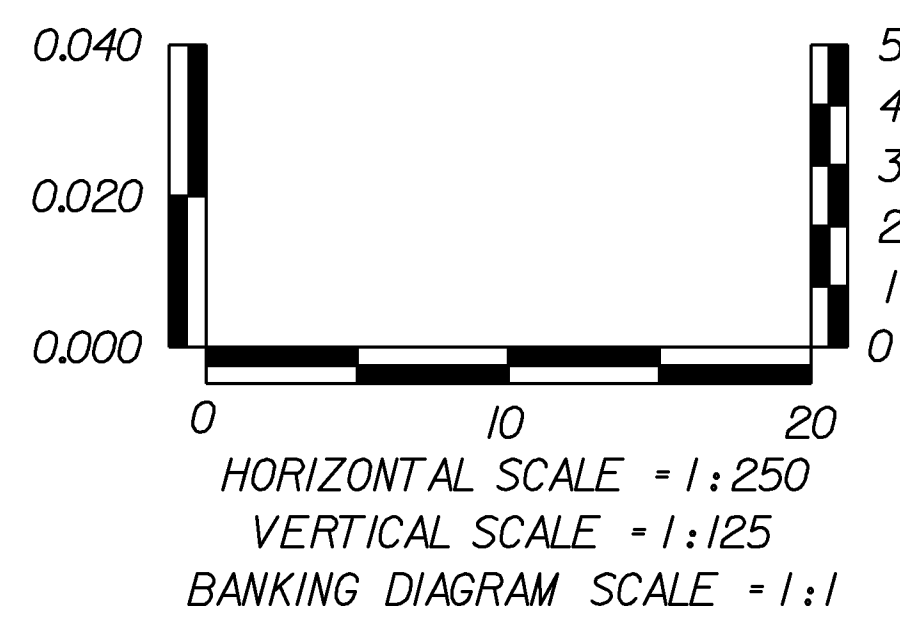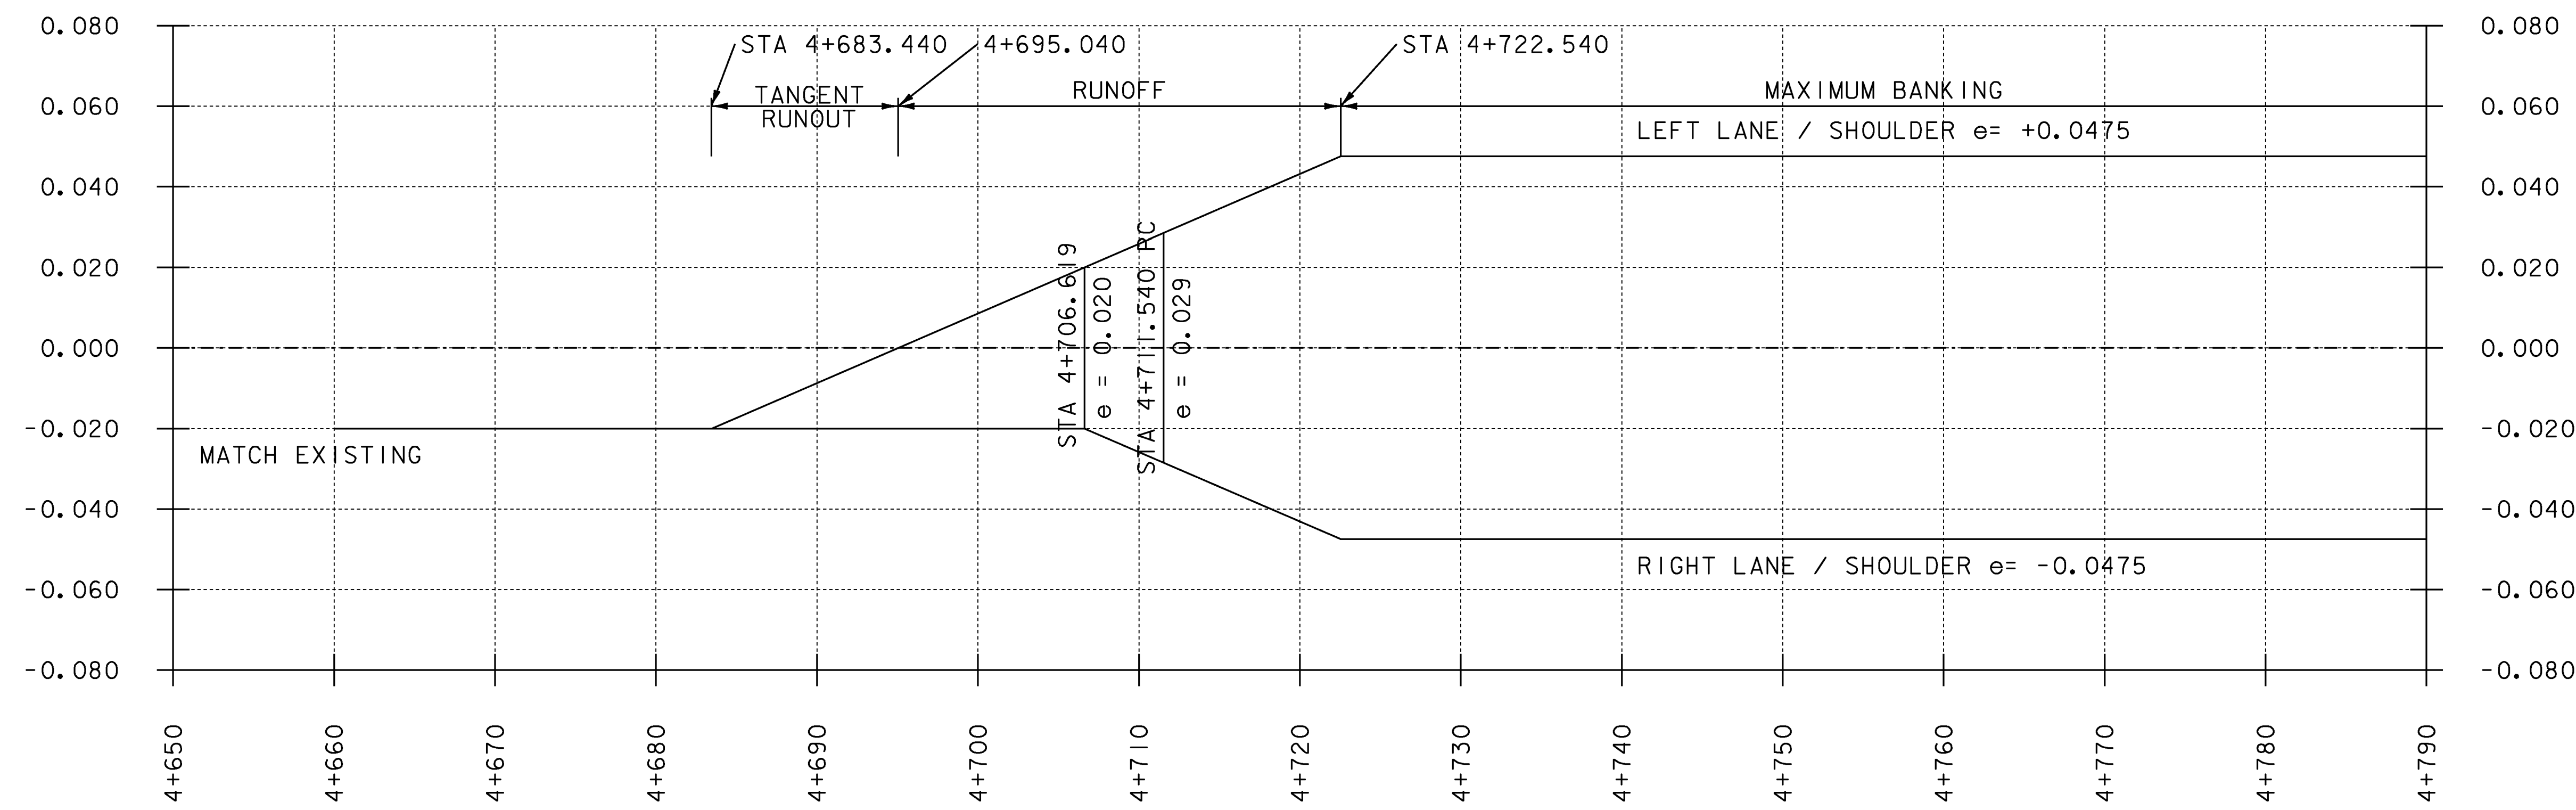



US ROUTE 2 BANKING DIAGRAM

PROJECT NAME:	EAST MONTPELIER
PROJECT NUMBER:	STPG 028 - 3(35)S
FILE NAME:	+98b028profile.dgn
PROJECT LEADER:	J.SCHULTZ
DESIGNED BY:	J. GRUCHACZ
US ROUTE 2 PROFILE SHEET 1	
PLOT DATE:	29-MAR-2010
DRAWN BY:	D. LYMAN
CHECKED BY:	J. DEVLIN
SHEET	32 OF 142

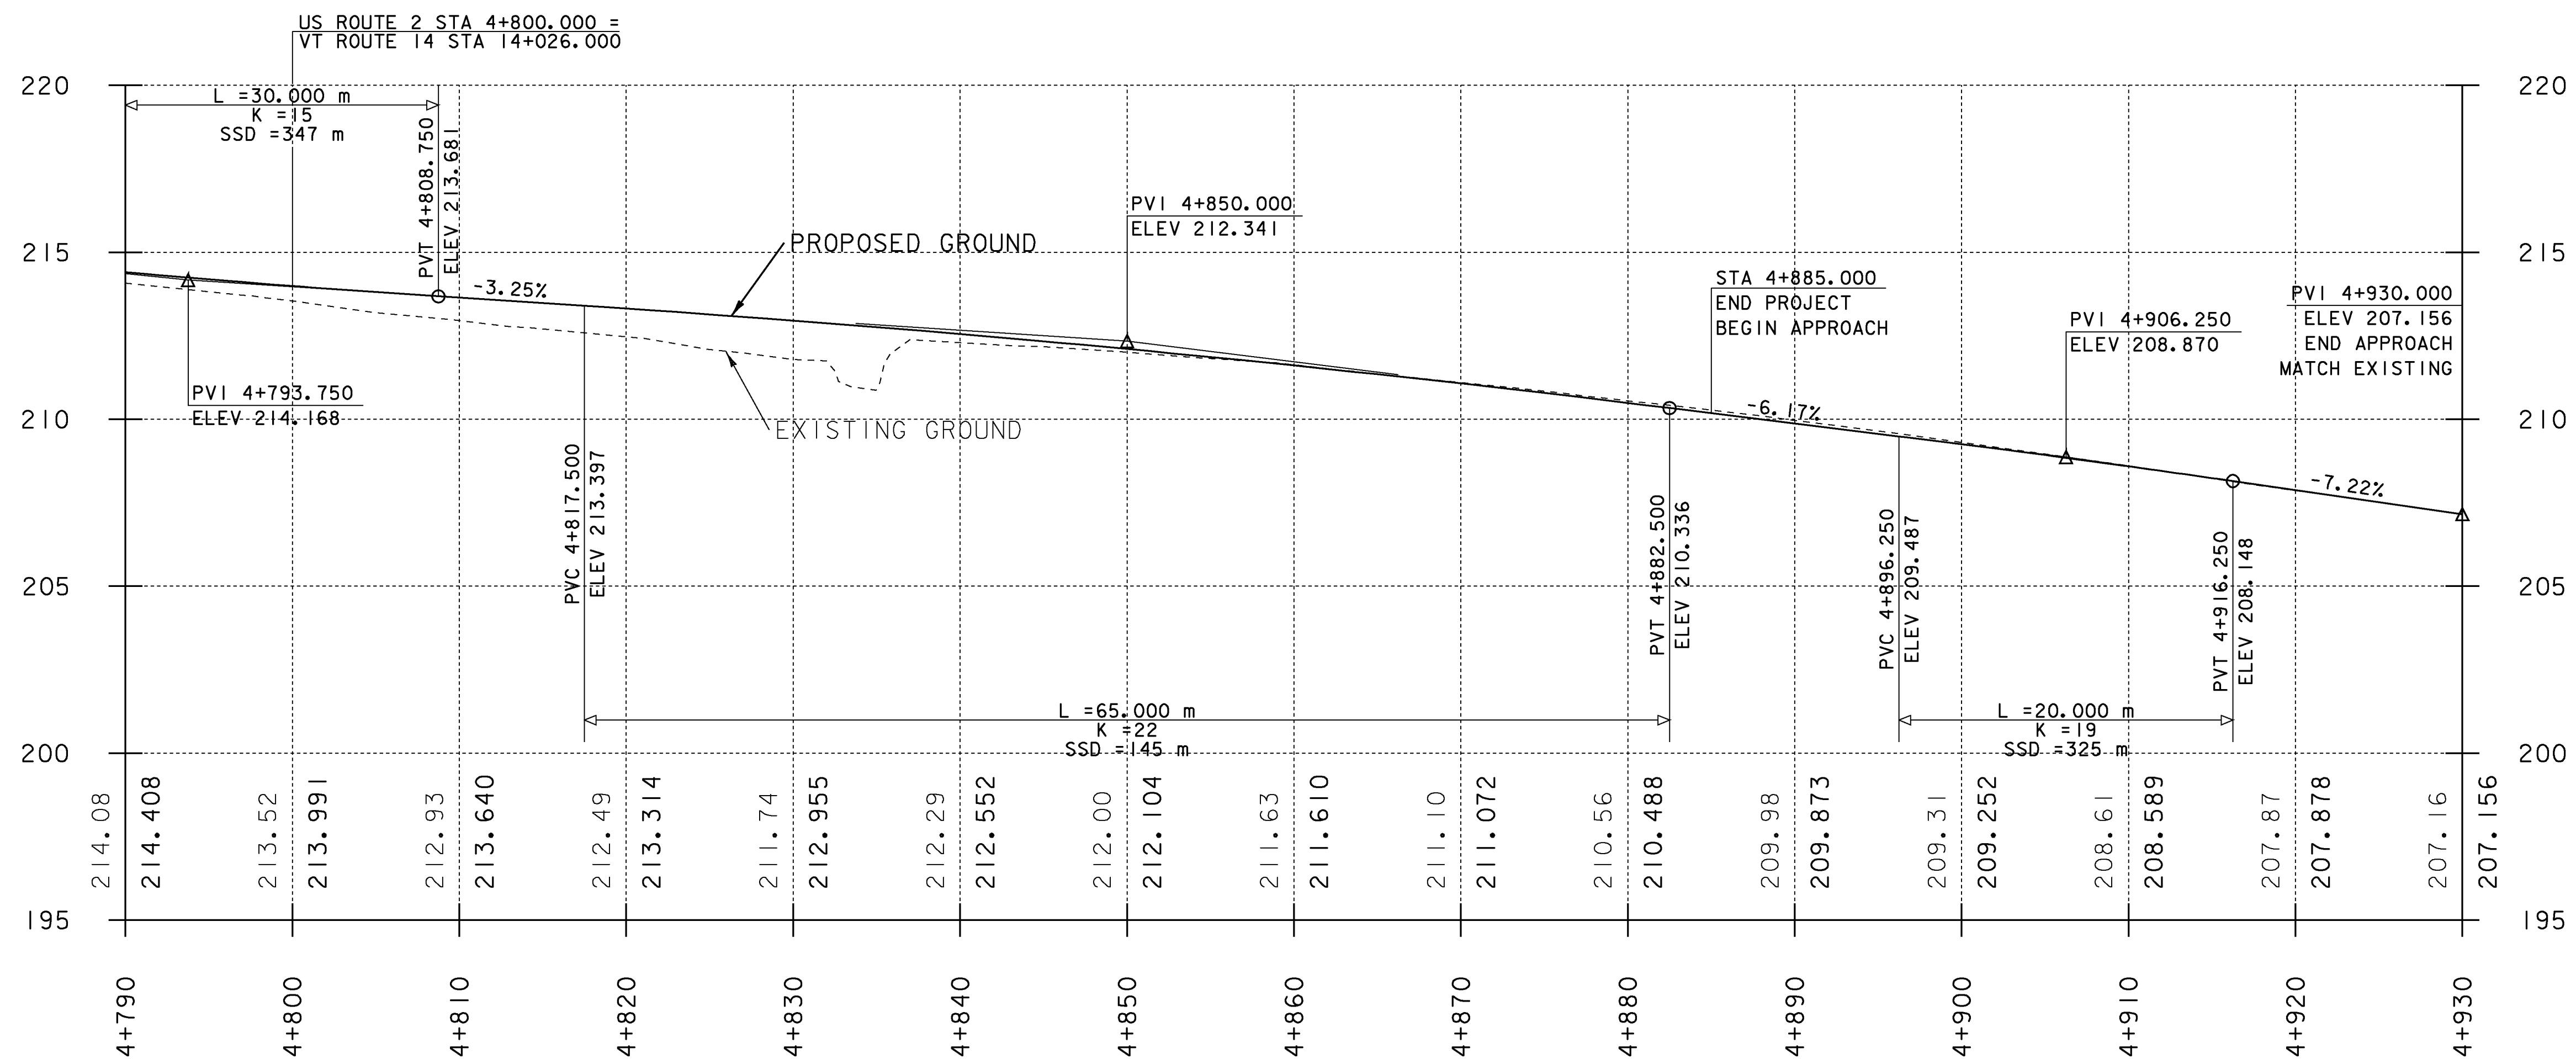


THE ELEVATIONS SHOWN TO THE NEAREST HUNDREDTH ARE THE OLD GROUND ALONG REVISED CENTERLINE. THE ELEVATIONS SHOWN TO THE NEAREST THOUSANDTH ARE THE PROPOSED FINISHED GRADE ALONG REVISED CENTERLINE.

US ROUTE 2 PROFILE

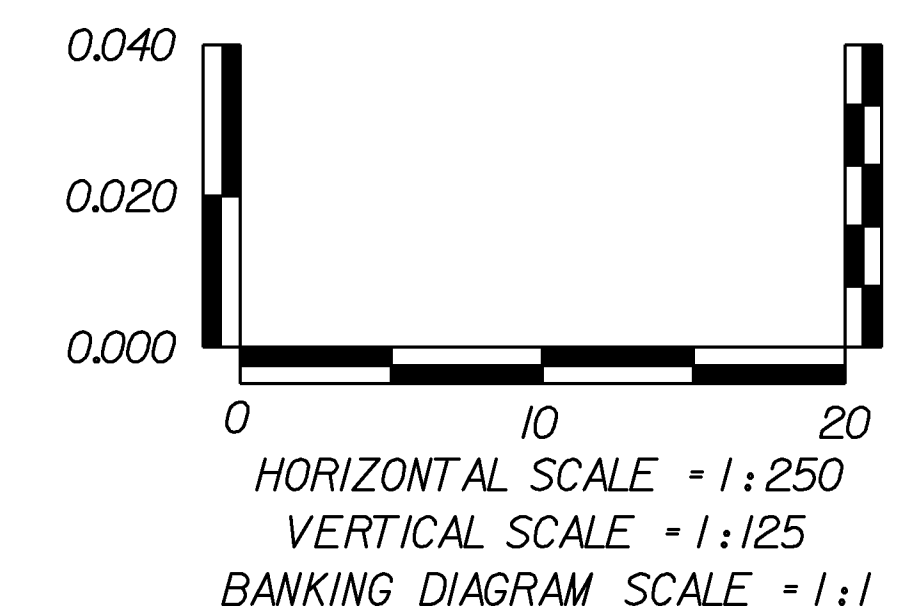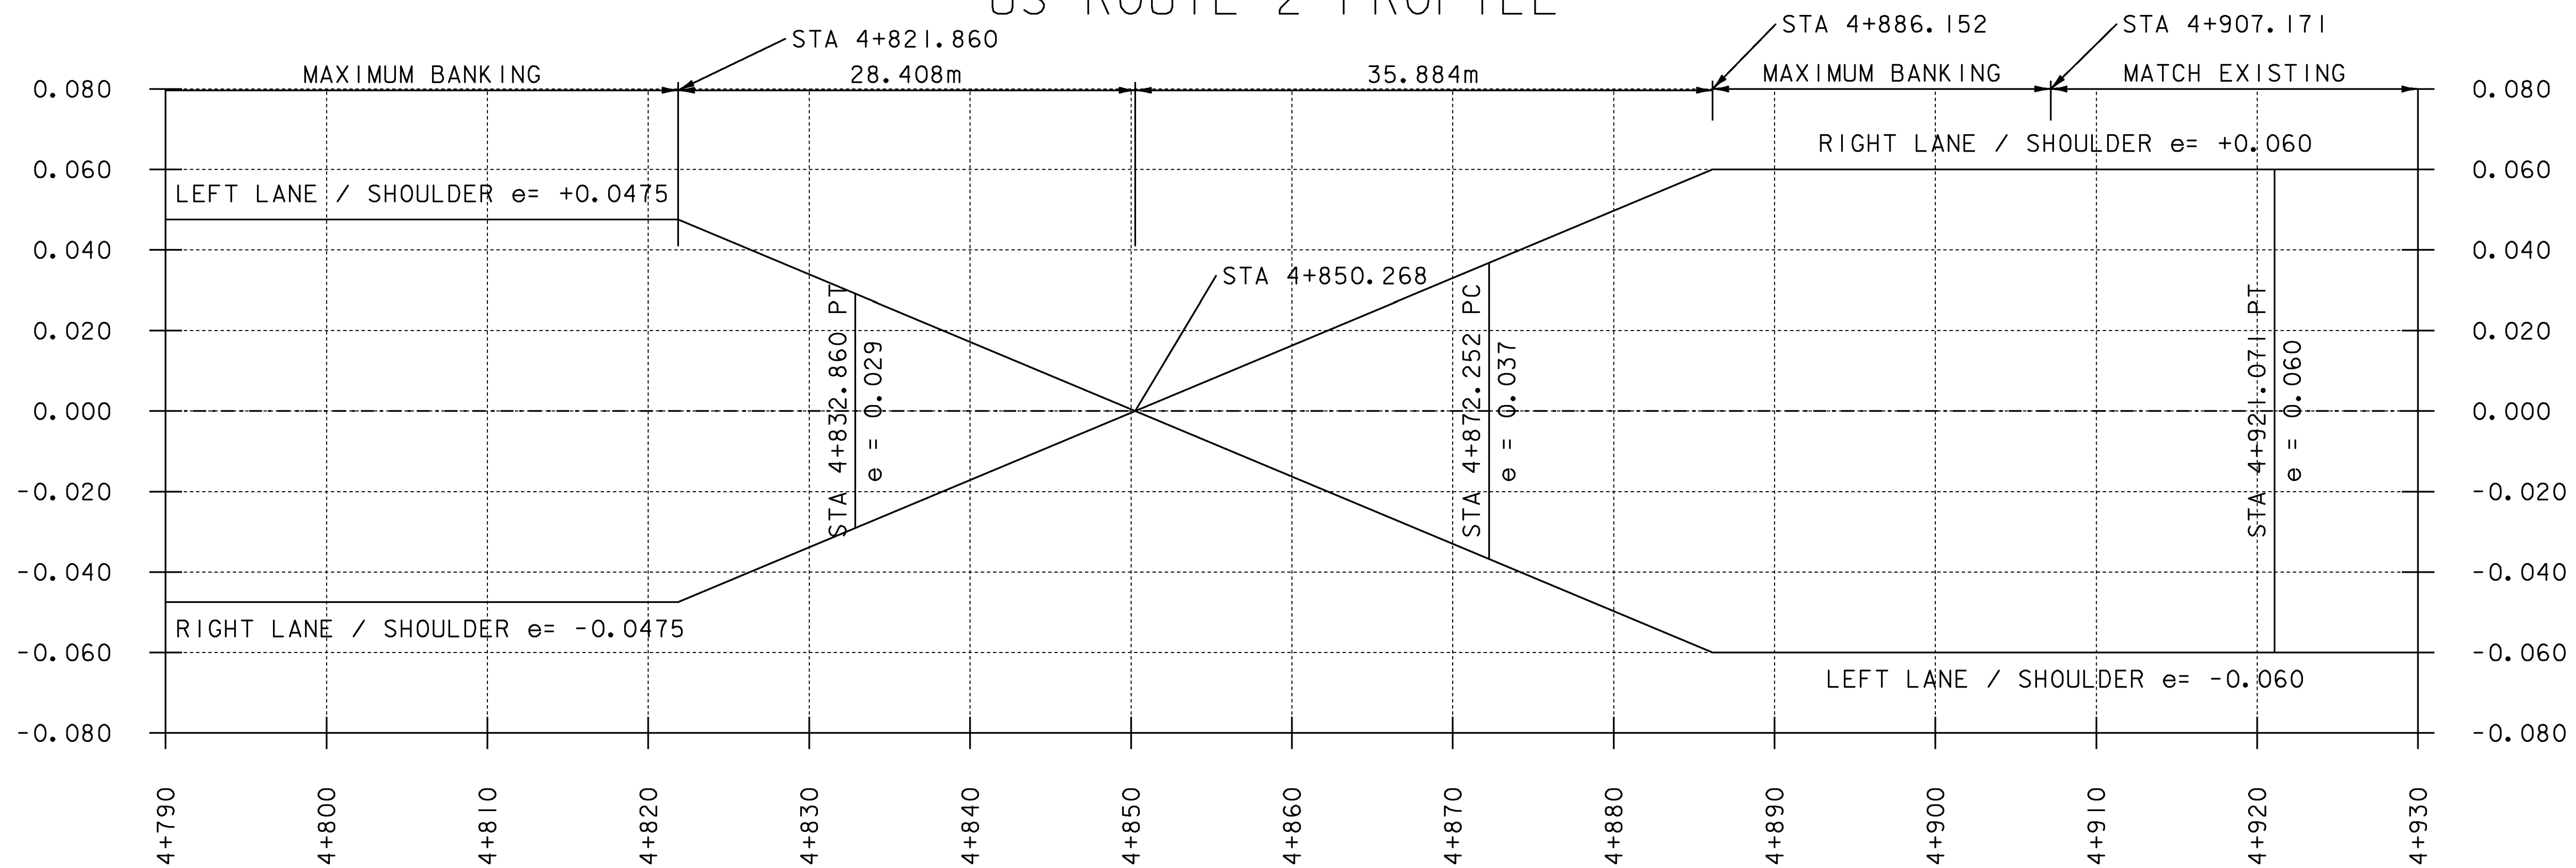



US ROUTE 2 BANKING DIAGRAM

PROJECT NAME: EAST MONTPELIER	PLOT DATE: 29-MAR-2010
PROJECT NUMBER: STPG 028 - 3(35)S	DRAWN BY: D. LYMAN
FILE NAME: +98b028profile.dgn	CHECKED BY: J. DEVLIN
PROJECT LEADER: J. SCHULTZ	SHEET 33 OF 142
DESIGNED BY: J. GRUCHACZ	
US ROUTE 2 PROFILE SHEET 2	

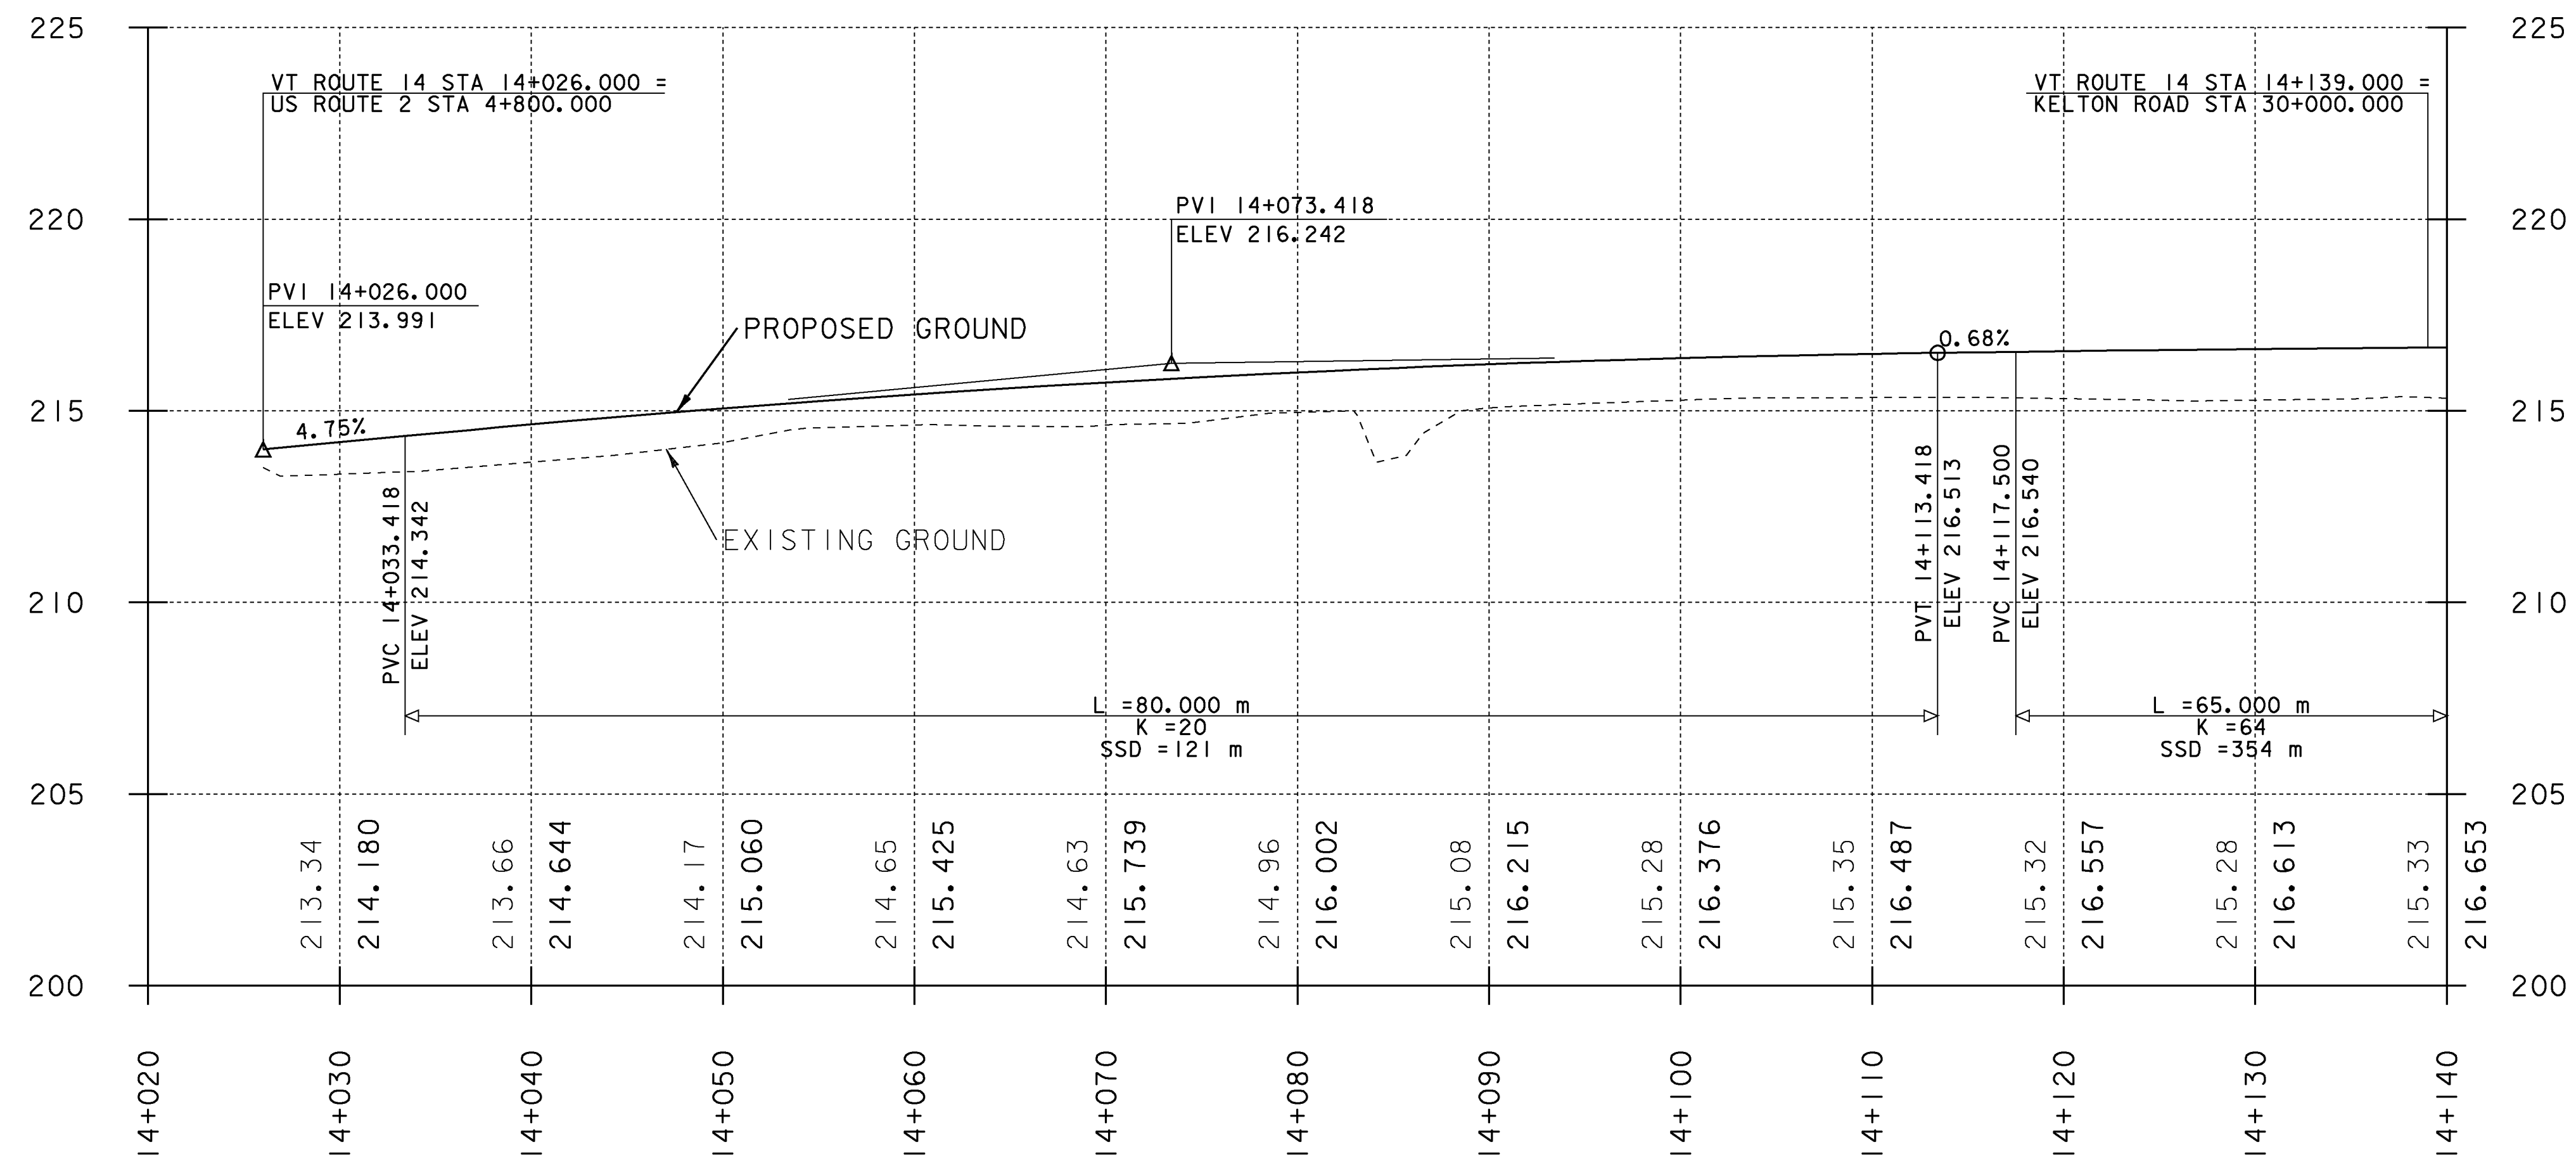


THE ELEVATIONS SHOWN TO THE NEAREST HUNDREDTH ARE THE OLD GROUND ALONG REVISED CENTERLINE. THE ELEVATIONS SHOWN TO THE NEAREST THOUSANDTH ARE THE PROPOSED FINISHED GRADE ALONG REVISED CENTERLINE.

VT ROUTE 14 PROFILE

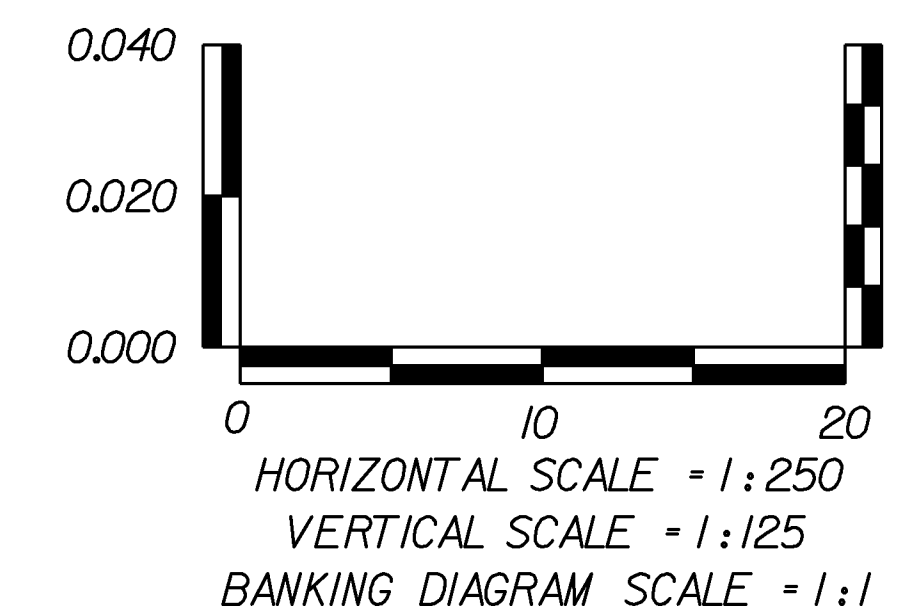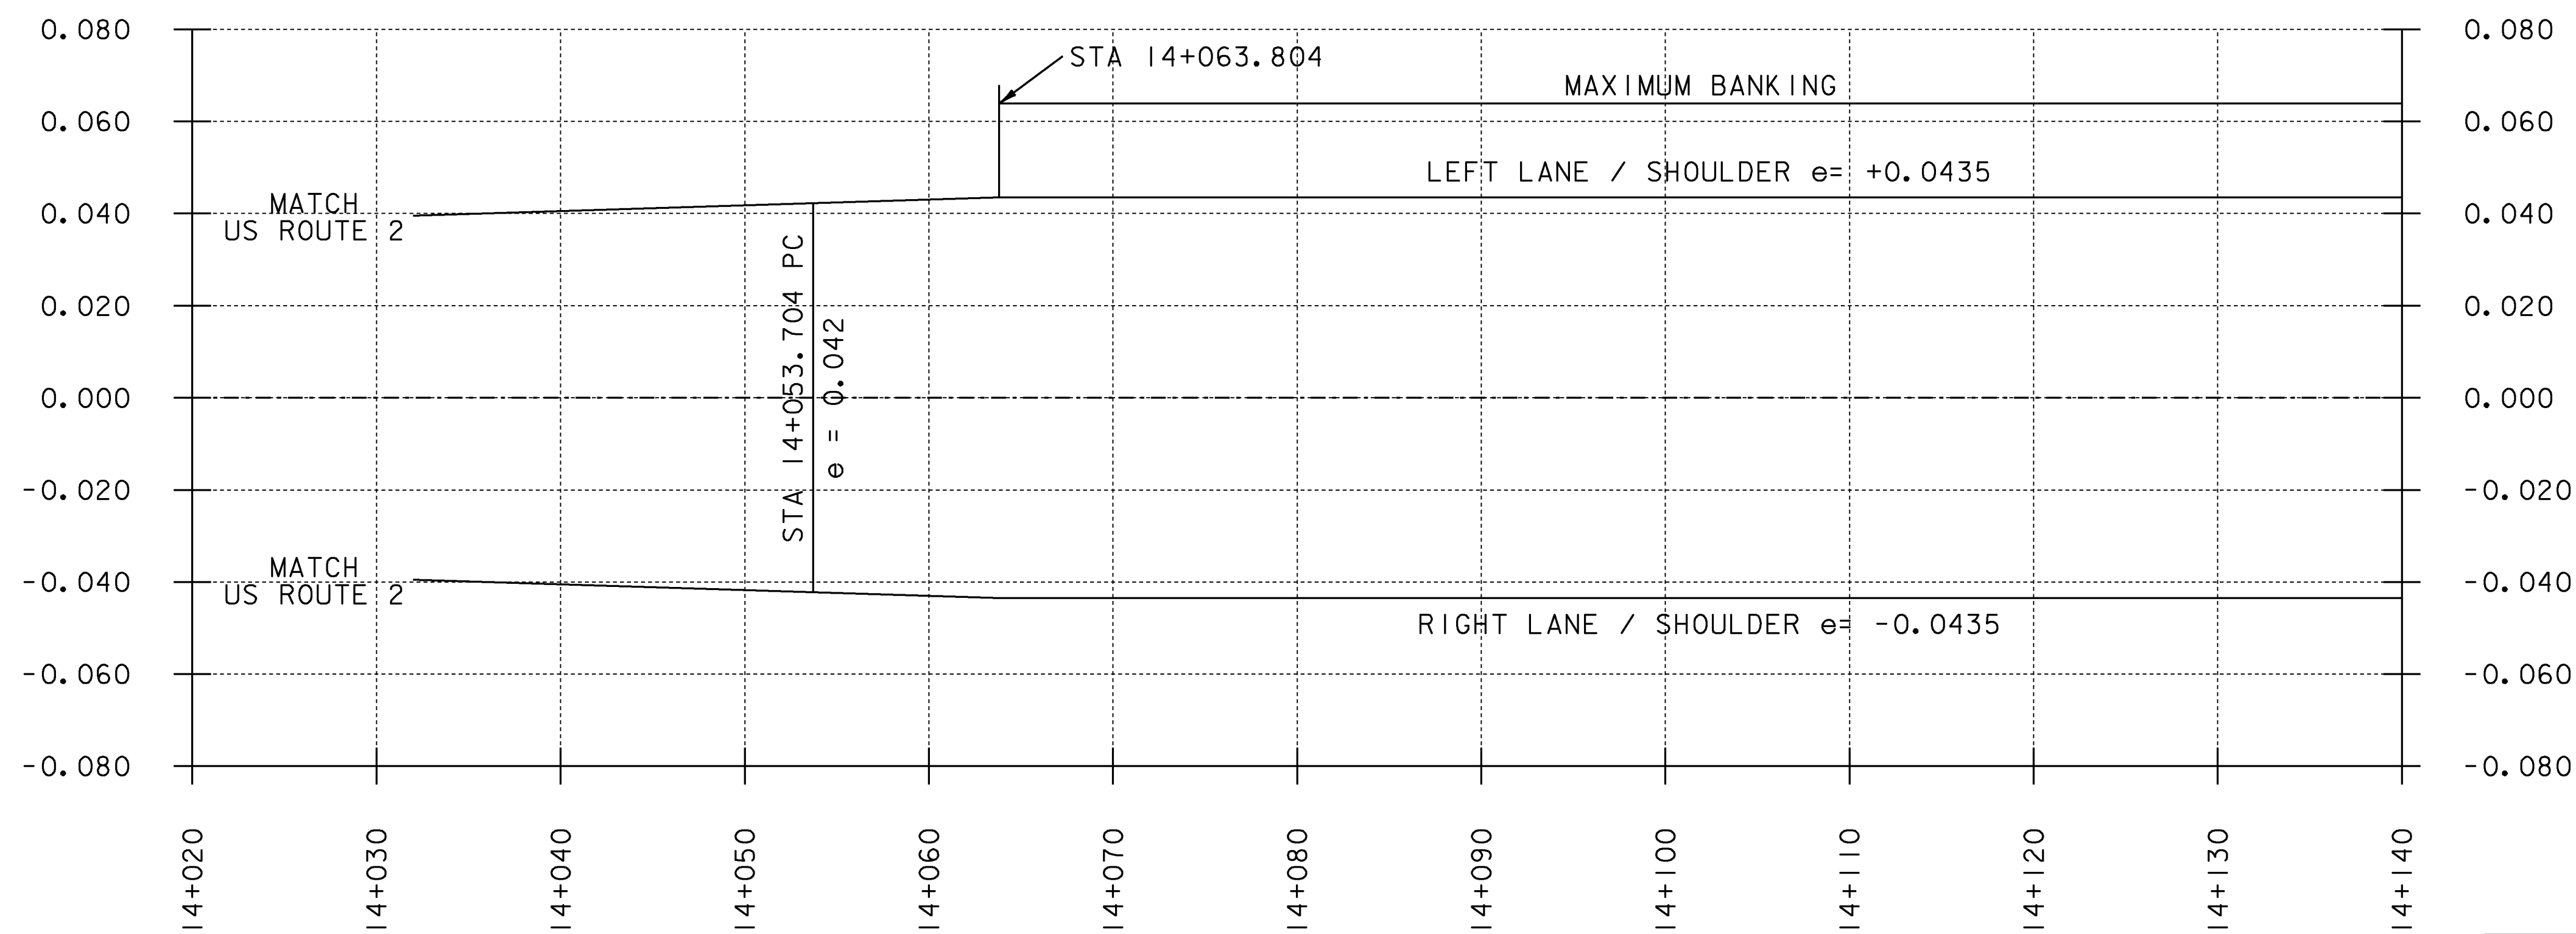



VT ROUTE 14 BANKING DIAGRAM

PROJECT NAME:	EAST MONTPELIER
PROJECT NUMBER:	STPG 028 - 3(35)S
FILE NAME:	+98b028profile.dgn
PROJECT LEADER:	J.SCHULTZ
DESIGNED BY:	J. GRUCHACZ
VT ROUTE 14 PROFILE SHEET 1	
PLOT DATE:	29-MAR-2010
DRAWN BY:	D. LYMAN
CHECKED BY:	J. DEVLIN
SHEET	34 OF 142

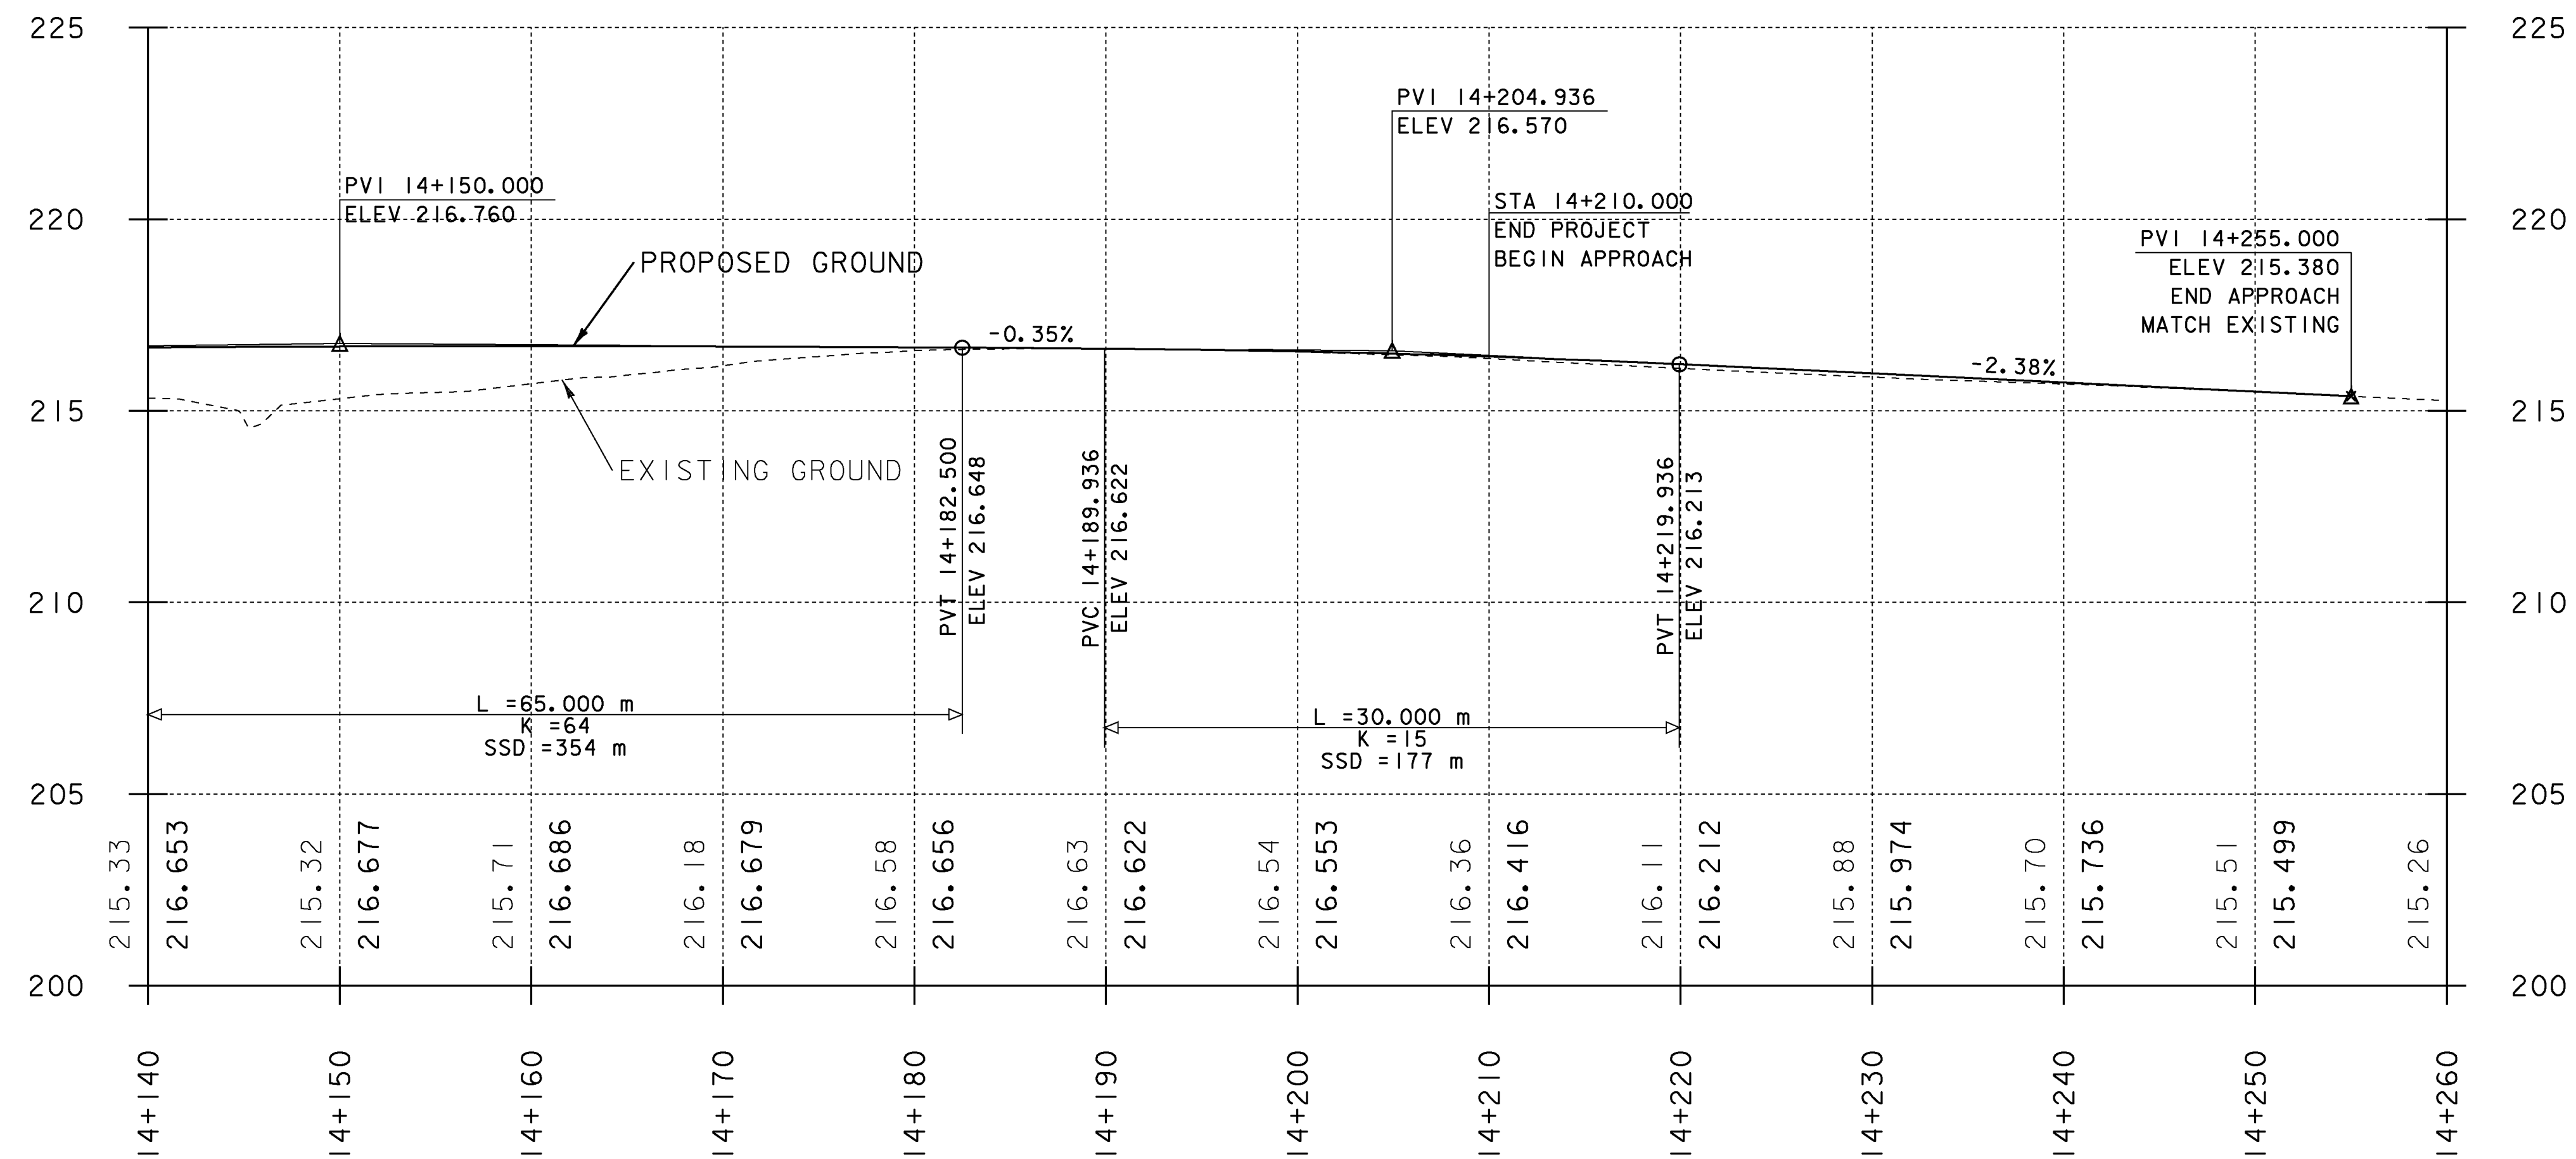


THE ELEVATIONS SHOWN TO THE NEAREST HUNDREDTH ARE THE OLD GROUND ALONG REVISED CENTERLINE. THE ELEVATIONS SHOWN TO THE NEAREST THOUSANDTH ARE THE PROPOSED FINISHED GRADE ALONG REVISED CENTERLINE.

VT ROUTE 14 PROFILE

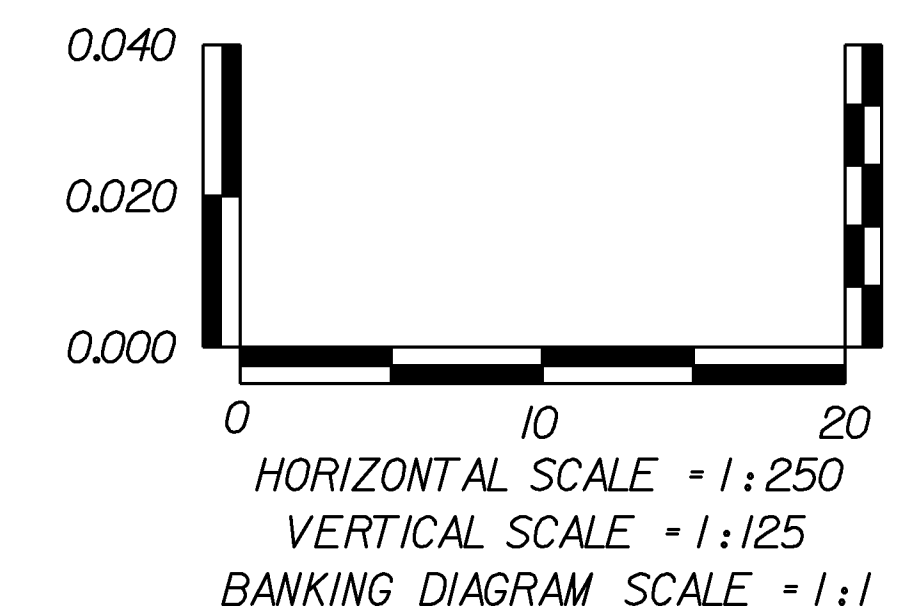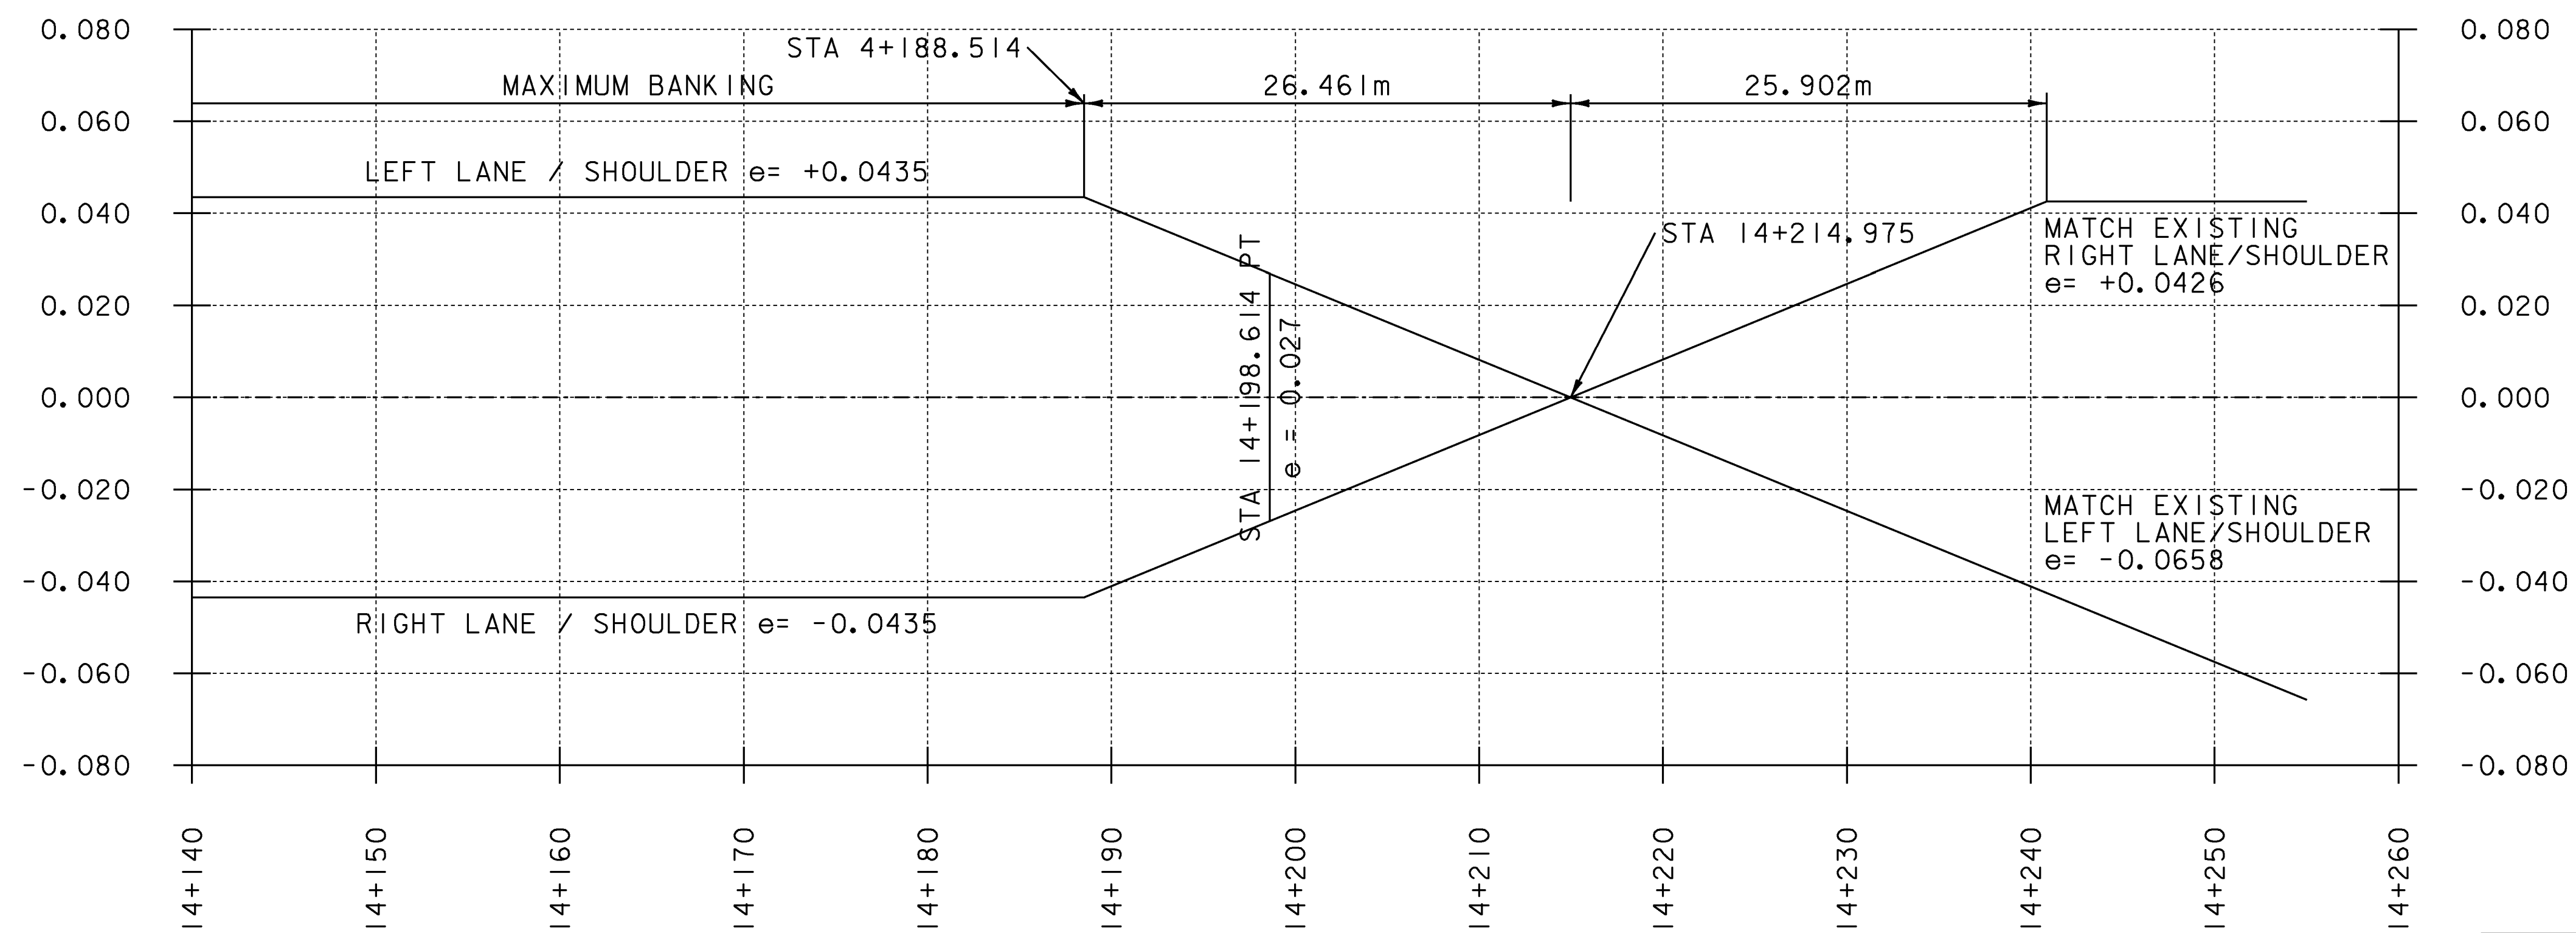


VT ROUTE 14 BANKING DIAGRAM

PROJECT NAME: EAST MONTPELIER	PLOT DATE: 29-MAR-2010
PROJECT NUMBER: STPG 028 - 3(35)S	DRAWN BY: D. LYMAN
FILE NAME: +98b028profile.dgn	CHECKED BY: J. DEVLIN
PROJECT LEADER: J.SCHULTZ	SHEET 35 OF 142
DESIGNED BY: J. GRUCHACZ	
VT ROUTE 14 PROFILE SHEET 2	

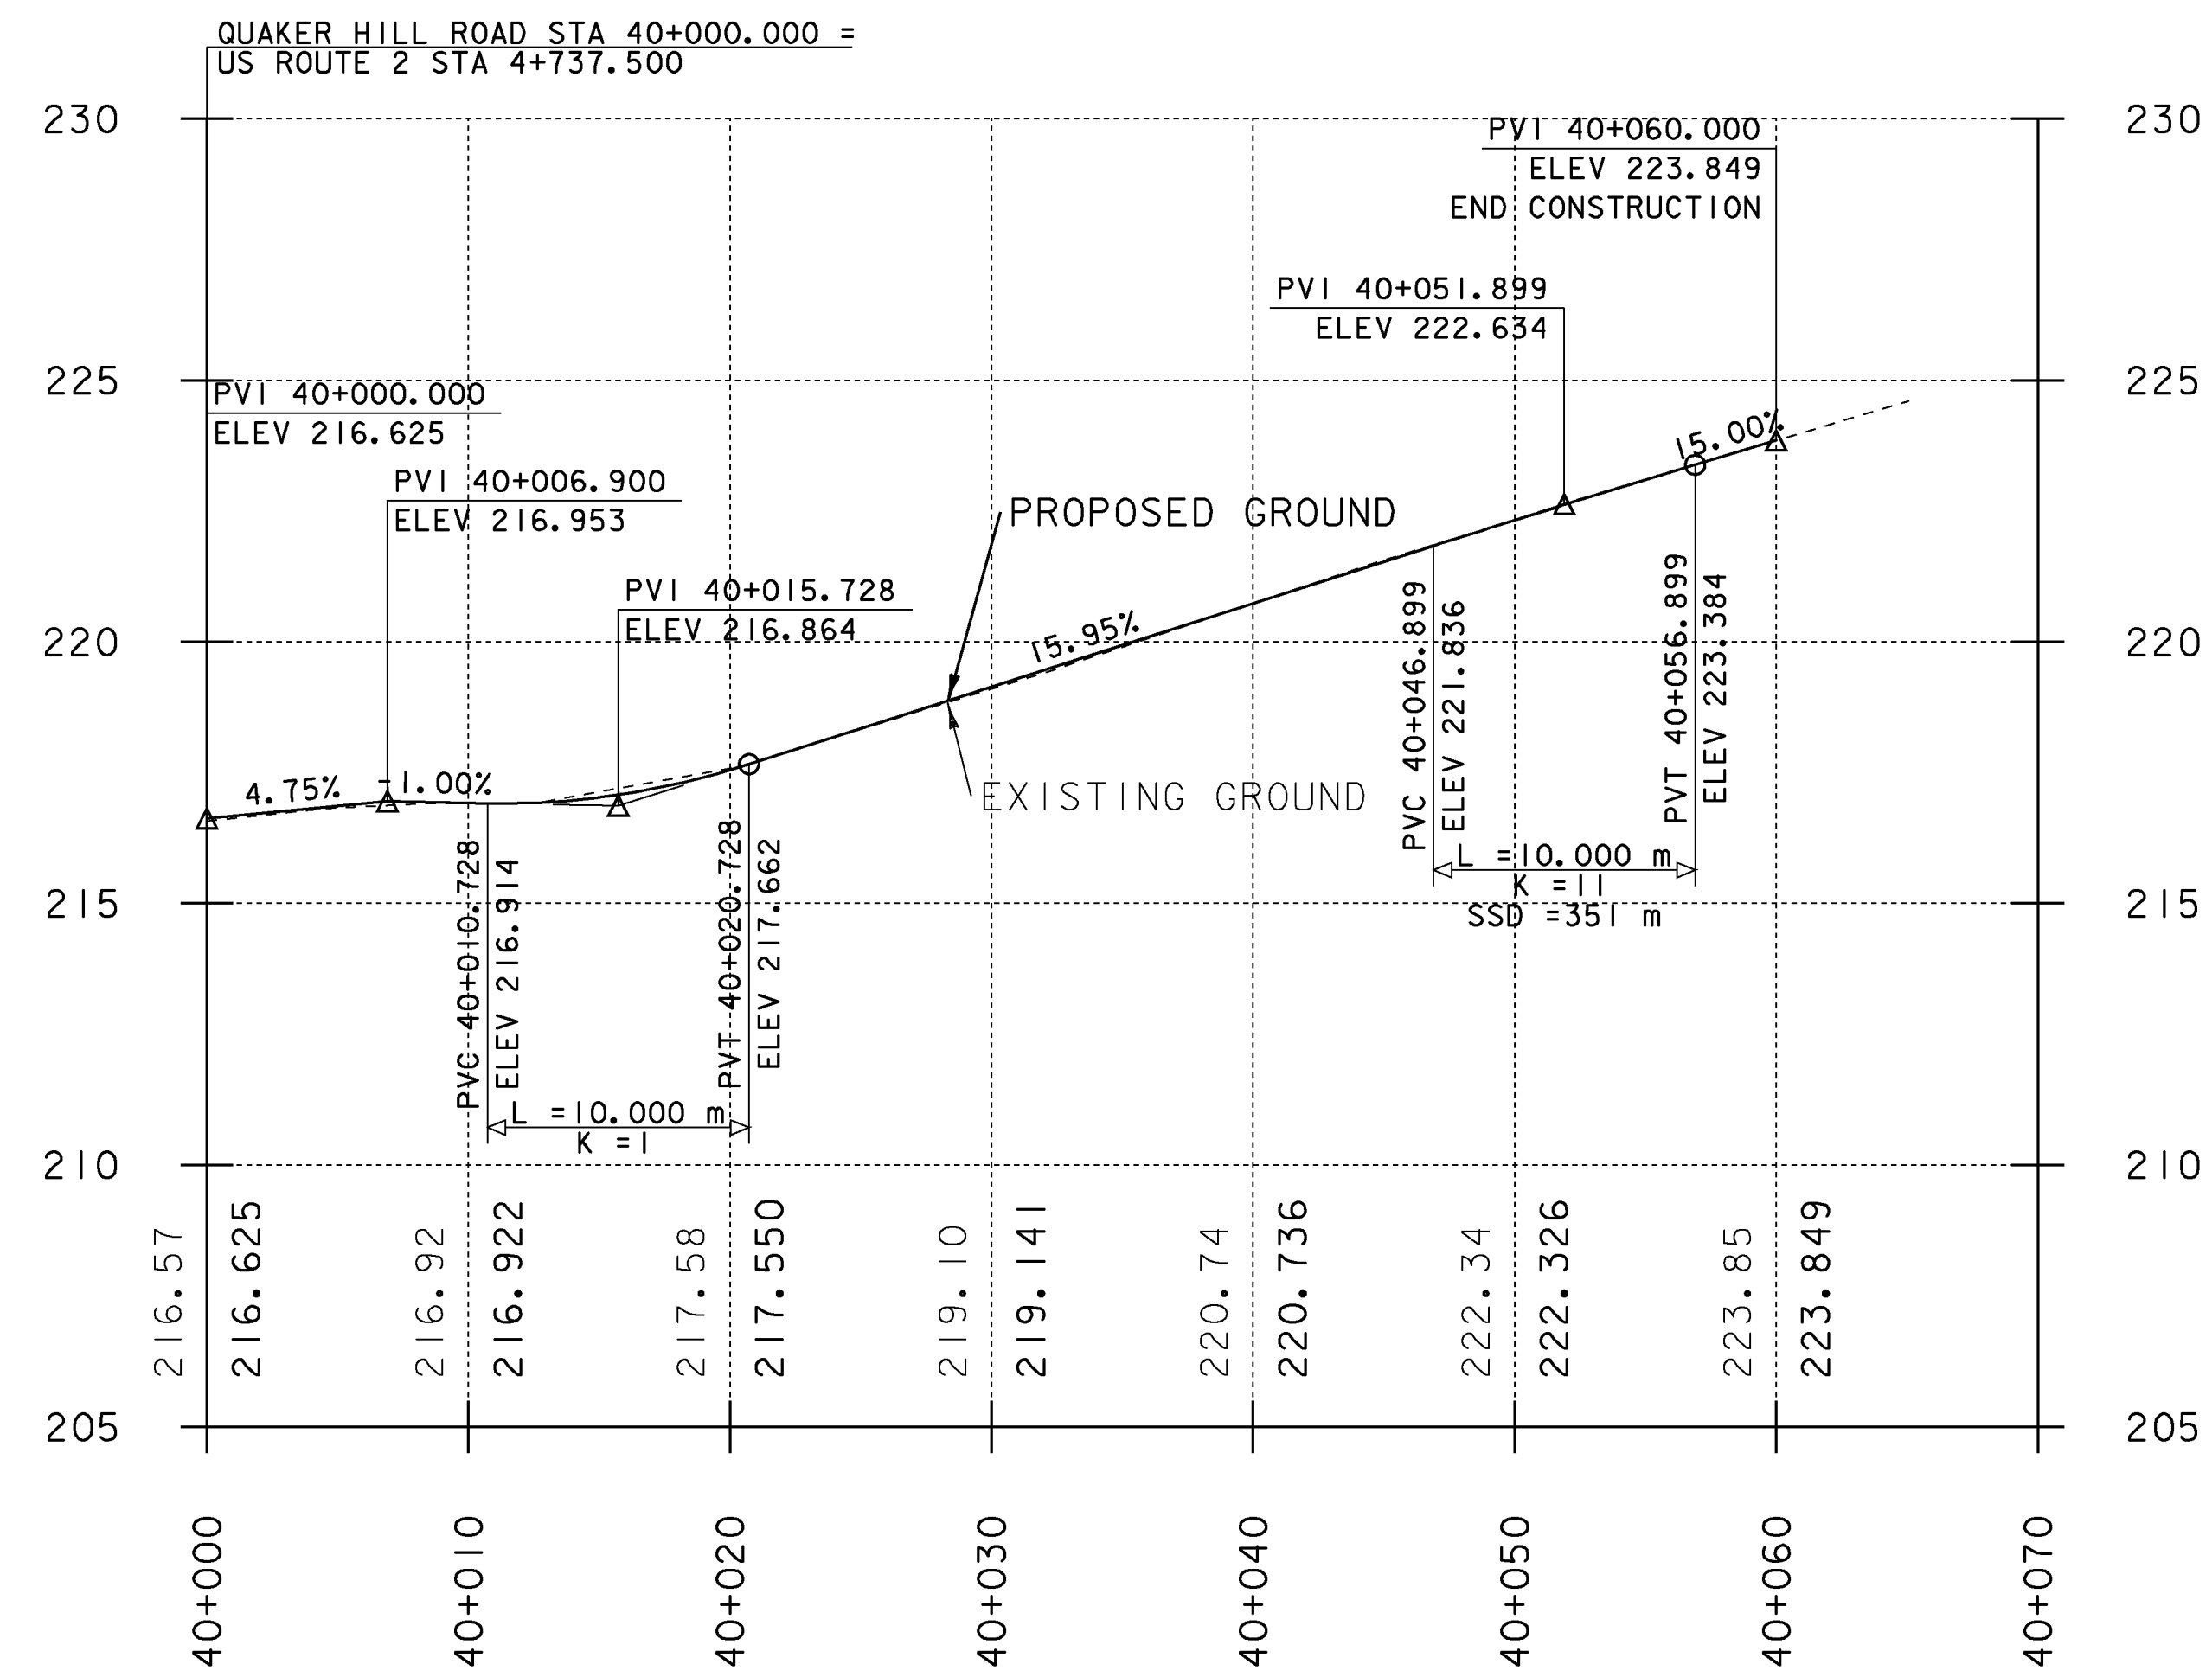


QUAKER HILL ROAD PROFILE

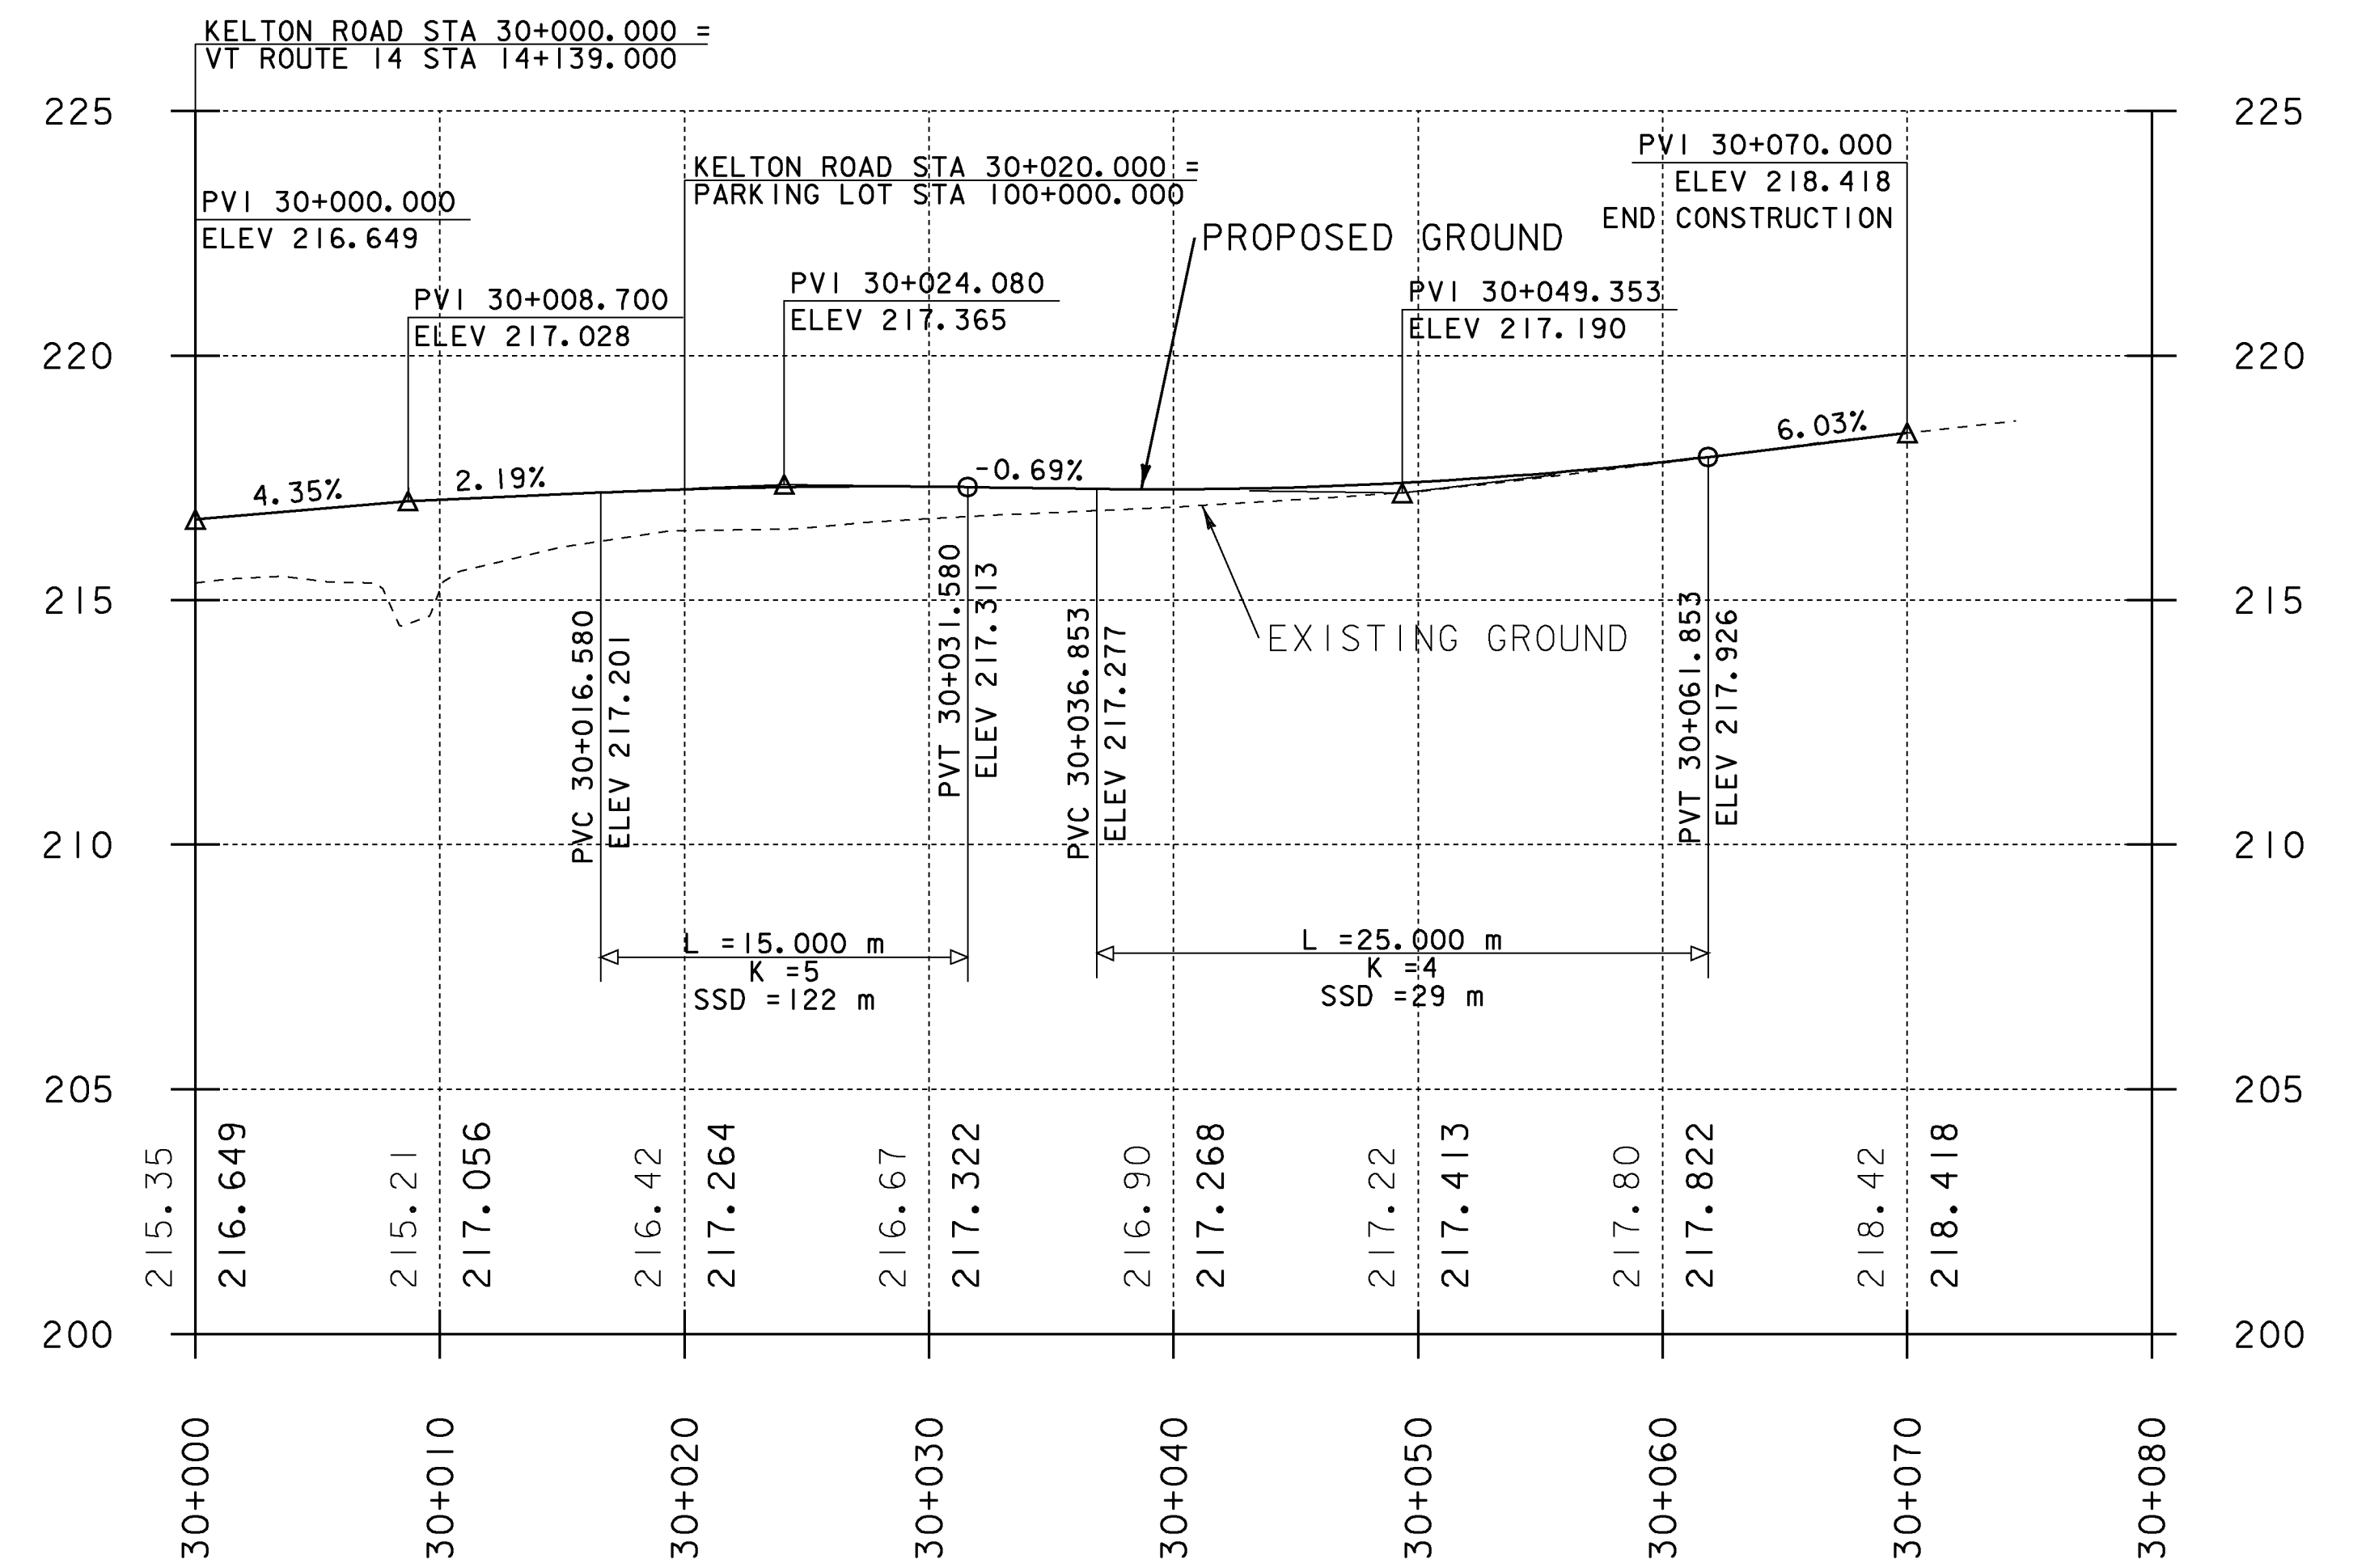

KELTON ROAD PROFILE


THE ELEVATIONS SHOWN TO THE NEAREST HUNDREDTH ARE THE OLD GROUND ALONG REVISED CENTERLINE. THE ELEVATIONS SHOWN TO THE NEAREST THOUSANDTH ARE THE PROPOSED FINISHED GRADE ALONG REVISED CENTERLINE.

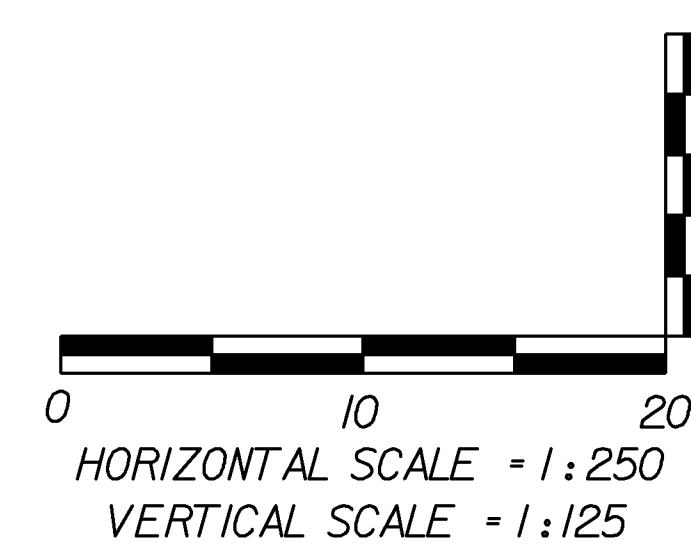

PROJECT NAME: EAST MONTPELIER
PROJECT NUMBER: STPG 028 - 3(35)S


FILE NAME: +98b028profile.dgn
PROJECT LEADER: J.SCHULTZ
DESIGNED BY: J. GRUCHACZ
QUAKER HILL & KELTON RD PROFILE SHEET

PLOT DATE: 29-MAR-2010
DRAWN BY: D. LYMAN
CHECKED BY: J. DEVLIN
SHEET 36 OF 142

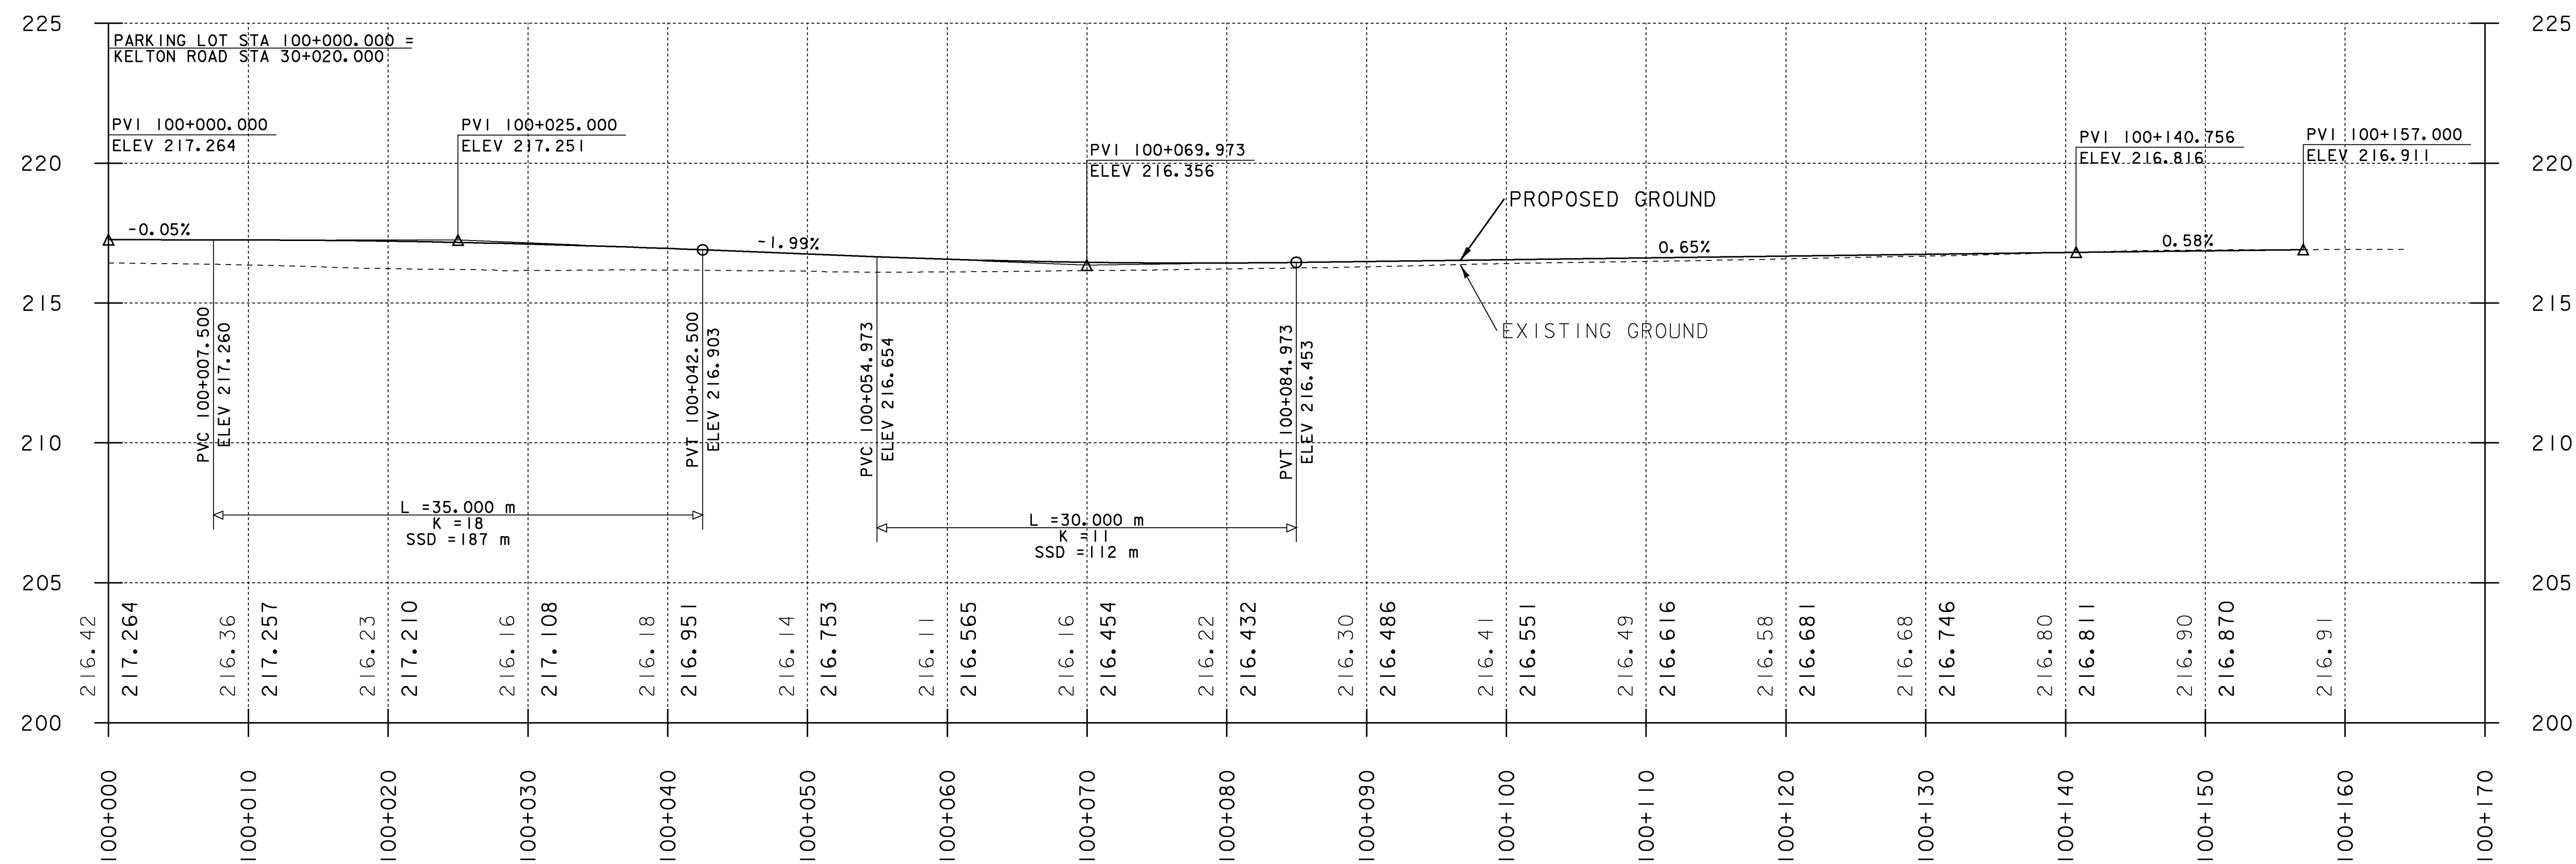

PARKING LOT PROFILE



THE ELEVATIONS SHOWN TO THE NEAREST HUNDREDTH ARE THE OLD GROUND ALONG REVISED CENTERLINE. THE ELEVATIONS SHOWN TO THE NEAREST THOUSANDTH ARE THE PROPOSED FINISHED GRADE ALONG REVISED CENTERLINE.

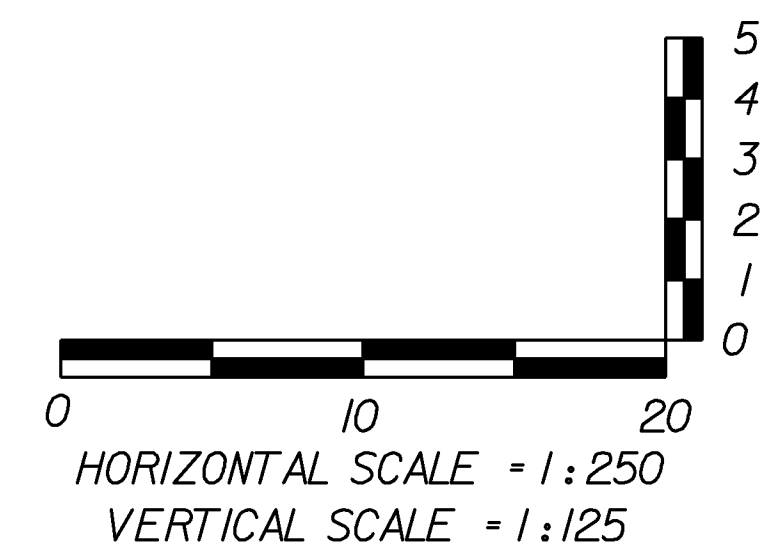

PROJECT NAME: EAST MONTPELIER
PROJECT NUMBER: STPG 028 - 3(35)S

FILE NAME: +98b028profile.dgn
PROJECT LEADER: J.SCHULTZ
DESIGNED BY: J. GRUCHACZ
PARKING LOT PROFILE SHEET

PLOT DATE: 29-MAR-2010
DRAWN BY: D. LYMAN
CHECKED BY: J. DEVLIN
SHEET 37 OF 142

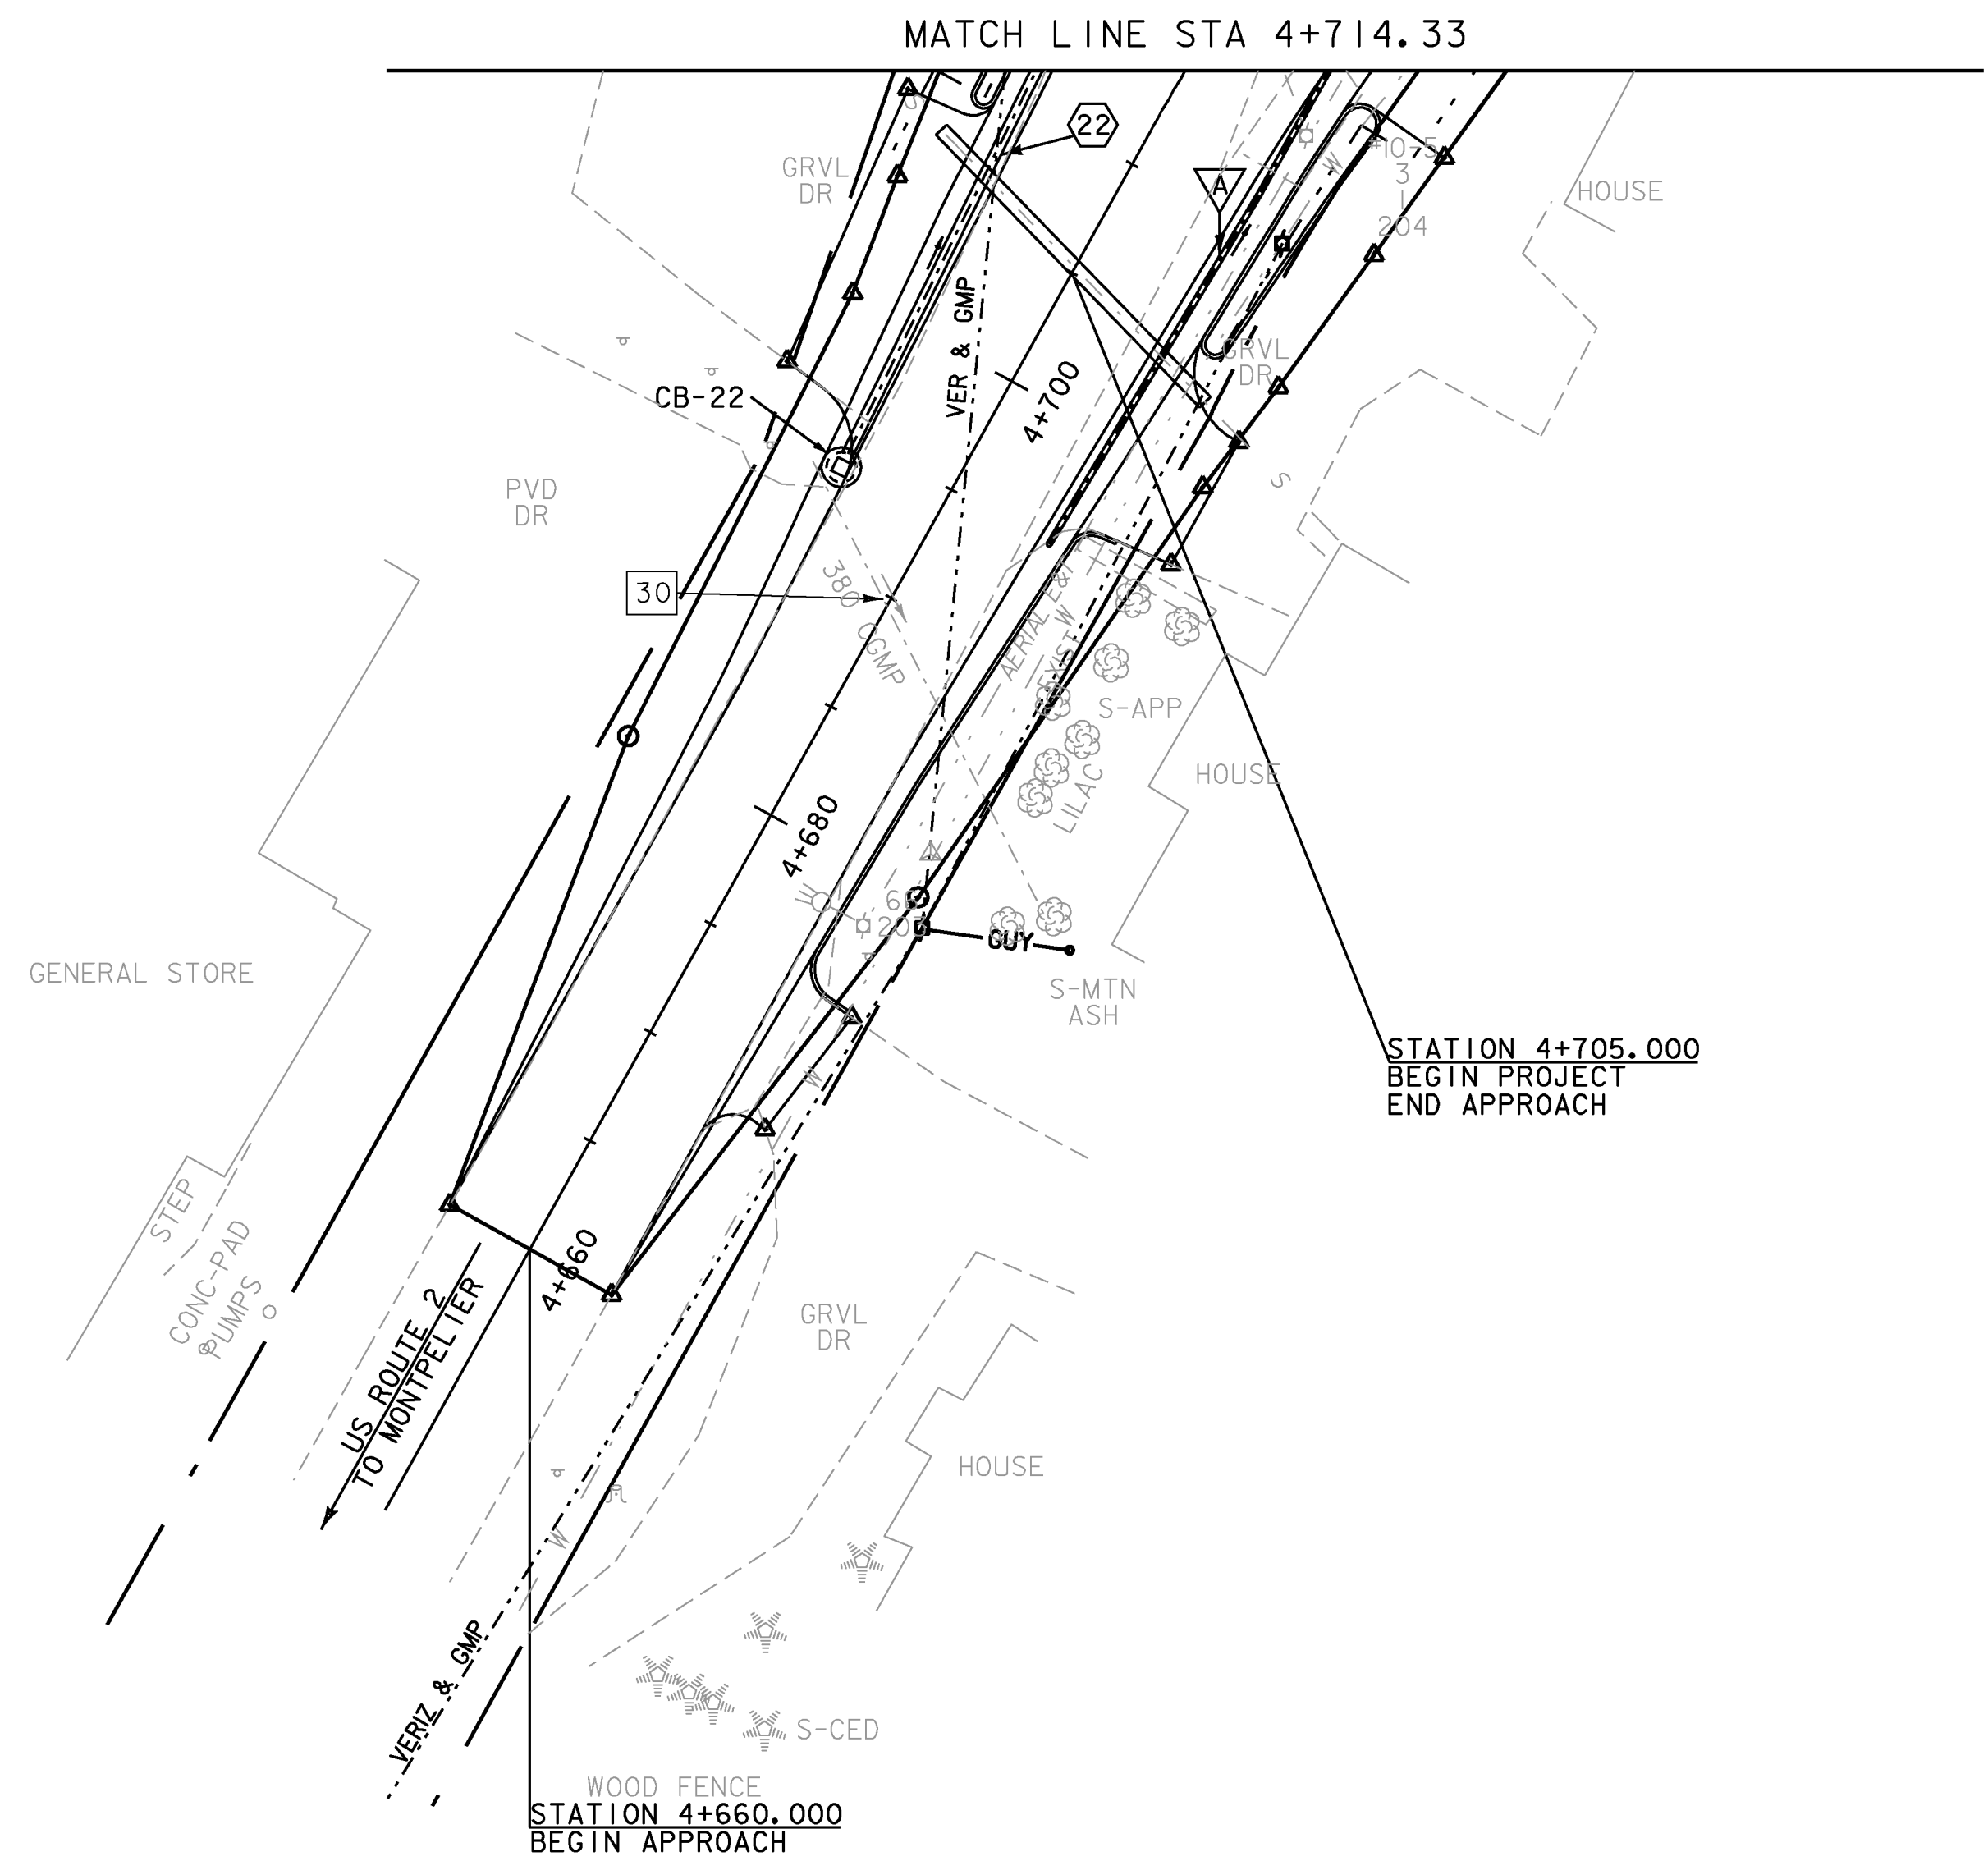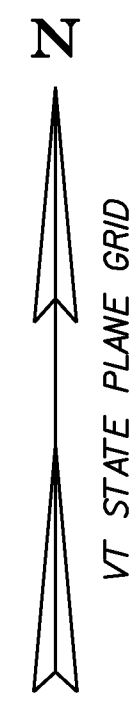

- NEW DRAINAGE
- 22 STA 4+693.66 LT - 4+720.00 LT
NEW 450MM X 26.9M RCP/CPEP (SL)
W/1200MM PRCCB @ STA 4+693.66 LT
W/GRATE TYPE D (1)
- EXISTING DRAINAGE
- 30 STA 4+693.30 LT - 4+681.77 RT
EXISTING 380MM X 20.7M CGMP = REMOVE
- 605.11 200 MM UNDERDRAIN PIPE
- A STA 4+695.00 RT - 4+825.00 RT
NEW 200MM X 123.7M UNDERDRAIN PIPE
W/FLUSHING BASIN @ STA 4+695.00 RT
- 625.10 SLEEVES FOR UTILITIES (1 X 600MM)
STA. 4+703.05 RT APPROX. - 4+707.48 LT APPROX,
NEW 600MM X 15.3M APPROX. CPEP (SL)

NOTE:
 THE EXISTING PRIVATE SEWER LINE DEPICTED AT APPROXIMATE STATION 4+700.75 RT - 4+711.00 LT IS FOR REFERENCE ONLY. SEWER LINE LOCATION, DEPTH, AND MATERIAL IS UNKNOWN. THE SELECTED CONTRACTOR SHALL EXERCISE EXTREME CAUTION WHEN WORKING IN THE GENERAL VICINITY OF THIS SEWER LINE AND SHALL INSTALL A 600MM CPEP (SL) SLEEVE ADJACENT TO THE EXISTING LINE FOR FUTURE USE. WORK SHALL BE IN ACCORDANCE WITH, AND PAYMENT MADE UNDER 625.10 SLEEVES FOR UTILITIES (1 X 600MM). ALL WORK AS DESCRIBED SHALL OCCUR WITHIN THE STATE OF VERMONT OWNED RIGHT-OF-WAY.




PROJECT NAME:	EAST MONTEPELIER	FILE NAME:	+98b028bdr.dgn	PLOT DATE:	29-MAR-2010
PROJECT NUMBER:	STPG 028-3(35)S	PROJECT LEADER:	J. SCHULTZ	DRAWN BY:	D. LYMAN
		DESIGNED BY:	J. GRUCHACZ	CHECKED BY:	J. DEVLIN
		DRAINAGE LAYOUT SHEET 1		SHEET	38 OF 142

2' Ø CMP (SEE ISD EMAIL OF 6-6-II)

MATCH LINE STA 100+67.63

MATCH LINE STA 14+093.85

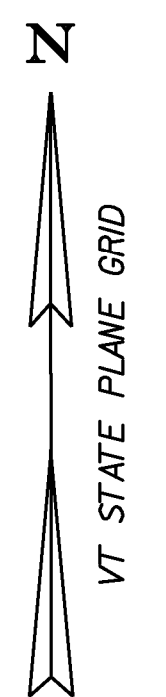


- NEW DRAINAGE**
- ① STA 40+030.43 LT - 40+011.08 LT
NEW 450MM X 19.5M RCP/CPEP (SL)
W/1200MM PRCCB @ STA 40+030.43 LT
W/GRATE TYPE D (I)
 - ② STA 40+011.08 LT - 40+011.11 RT
NEW 450MM X 11.8M RCP/CPEP (SL)
W/1200MM PRCCB @ STA 40+011.08 LT
W/GRATE TYPE D (I)
 - ③ STA 40+011.11 RT - 4+785.30 LT
NEW 450MM X 47.9M RCP/CPEP (SL)
W/1200MM PRCCB @ STA 40+011.11 RT
W/GRATE TYPE D (I)
 - ④ STA 4+785.30 LT - 4+818.12 LT
NEW 600MM X 36.9M RCP/CPEP (SL)
W/1200MM PRCCB @ STA 4+785.30 LT
W/GRATE TYPE D (I)
 - ⑤ STA 4+827.12 LT - 4+863.00 LT
NEW 900MM X 36.6M RCP/CPEP (SL)
W/1800MM PRCCB @ STA 4+827.12 LT
W/GRATE TYPE D (I)
 - ⑥ STA 4+863.00 LT - 4+900.02 LT
NEW 900MM X 35.8M RCP/CPEP (SL)
W/1800MM PRCCB @ STA 4+863.00 LT
W/GRATE TYPE D (I)
 - ⑨ STA 14+044.60 RT - 4+827.12 LT
NEW 900MM X 9.1M CPEP
W/REINFORCED CONCRETE HEADWALL
AT INLET
 - ⑩ STA 4+800.03 RT - 4+800.03 RT
NEW 450MM X 7.2M RCP/CPEP (SL)
W/1500MM PRCCB @ STA 4+800.03 RT
W/GRATE TYPE D (I)
 - ⑪ STA 4+825.68 RT - 4+824.99 RT
NEW 450MM X 4.8M RCP/CPEP (SL)
W/1200MM PRCCB @ STA 4+825.68 RT
W/GRATE TYPE D (I)

- ⑫ STA 4+824.99 RT - 4+827.12 LT
NEW 450MM X 16.3M RCP/CPEP (SL)
W/1200MM PRCCB @ STA 4+824.99 RT
W/GRATE TYPE D (I)
- ⑬ STA 14+038.87 RT - 4+818.12 LT
NEW 450MM X 4.1M RCP/CPEP (SL)
W/1200MM PRCCB @ STA 14+038.87 LT
W/GRATE TYPE D (I)
- ⑭ STA 4+818.12 LT - 4+827.12 LT
NEW 600MM X 9.9M RCP/CPEP (SL)
W/1800MM PRCCB @ STA 4+818.12 LT
W/GRATE TYPE D (I)
- ⑮ STA 14+091.93 LT - 14+076.43 RT
NEW 600MM X 29.3M RCP/CPEP (SL)
W/1800MM PRCCB @ STA 14+091.93 LT
W/GRATE TYPE D (I)
- ⑰ STA 100+078.45 RT - 14+091.93 LT
NEW 450MM X 29.8M RCP/CPEP (SL)
W/1200MM PRCCB @ STA 100+078.45 RT
W/GRATE TYPE D (I)
- ⑲ STA 4+693.66 LT - 4+720.00 LT
NEW 450MM X 26.9M RCP/CPEP (SL)
W/1200MM PRCCB @ STA 4+693.66 LT
W/GRATE TYPE D (I)
- ⑳ STA 4+720.00 LT - 40+011.08 LT
NEW 450MM X 14.1M RCP/CPEP (SL)
W/1200MM PRCCB @ STA 4+720.00 LT
W/GRATE TYPE D (I)

- EXISTING DRAINAGE**
- ⑩ STA 4+834.49 RT - 4+835.79 RT
EXISTING 610MM X 11.5M CGMP &
HEADWALL = REMOVE HEADWALL & EXISTING PIPE
 - ⑫ STA 4+835.79 RT - 4+895.89 RT
EXISTING 610MM X 75.5M CGMP & DI =
REMOVE DI AND BACKFILL EXISTING PIPE INLET
 - ⑬ STA 100+089.64 RT - 100+078.43 RT
EXISTING 380MM X 15.2M CGMP & DI = RETAIN
 - ⑭ STA 100+078.19 RT - 100+079.03 LT
EXISTING 380MM X 15.3M CGMP & DI =
REMOVE DI AND REMOVE EXISTING PIPE

625.10 SLEEVES FOR UTILITIES (1 X 600MM)
STA. 4+753.29 RT - 4+762.81 LT
NEW 600MM X 24.3M CPEP (SL)

629.20 ADJUST ELEVATION OF VALVE BOX
STA 4+712.90 LT
STA 4+752.97 LT
STA 4+753.17 RT

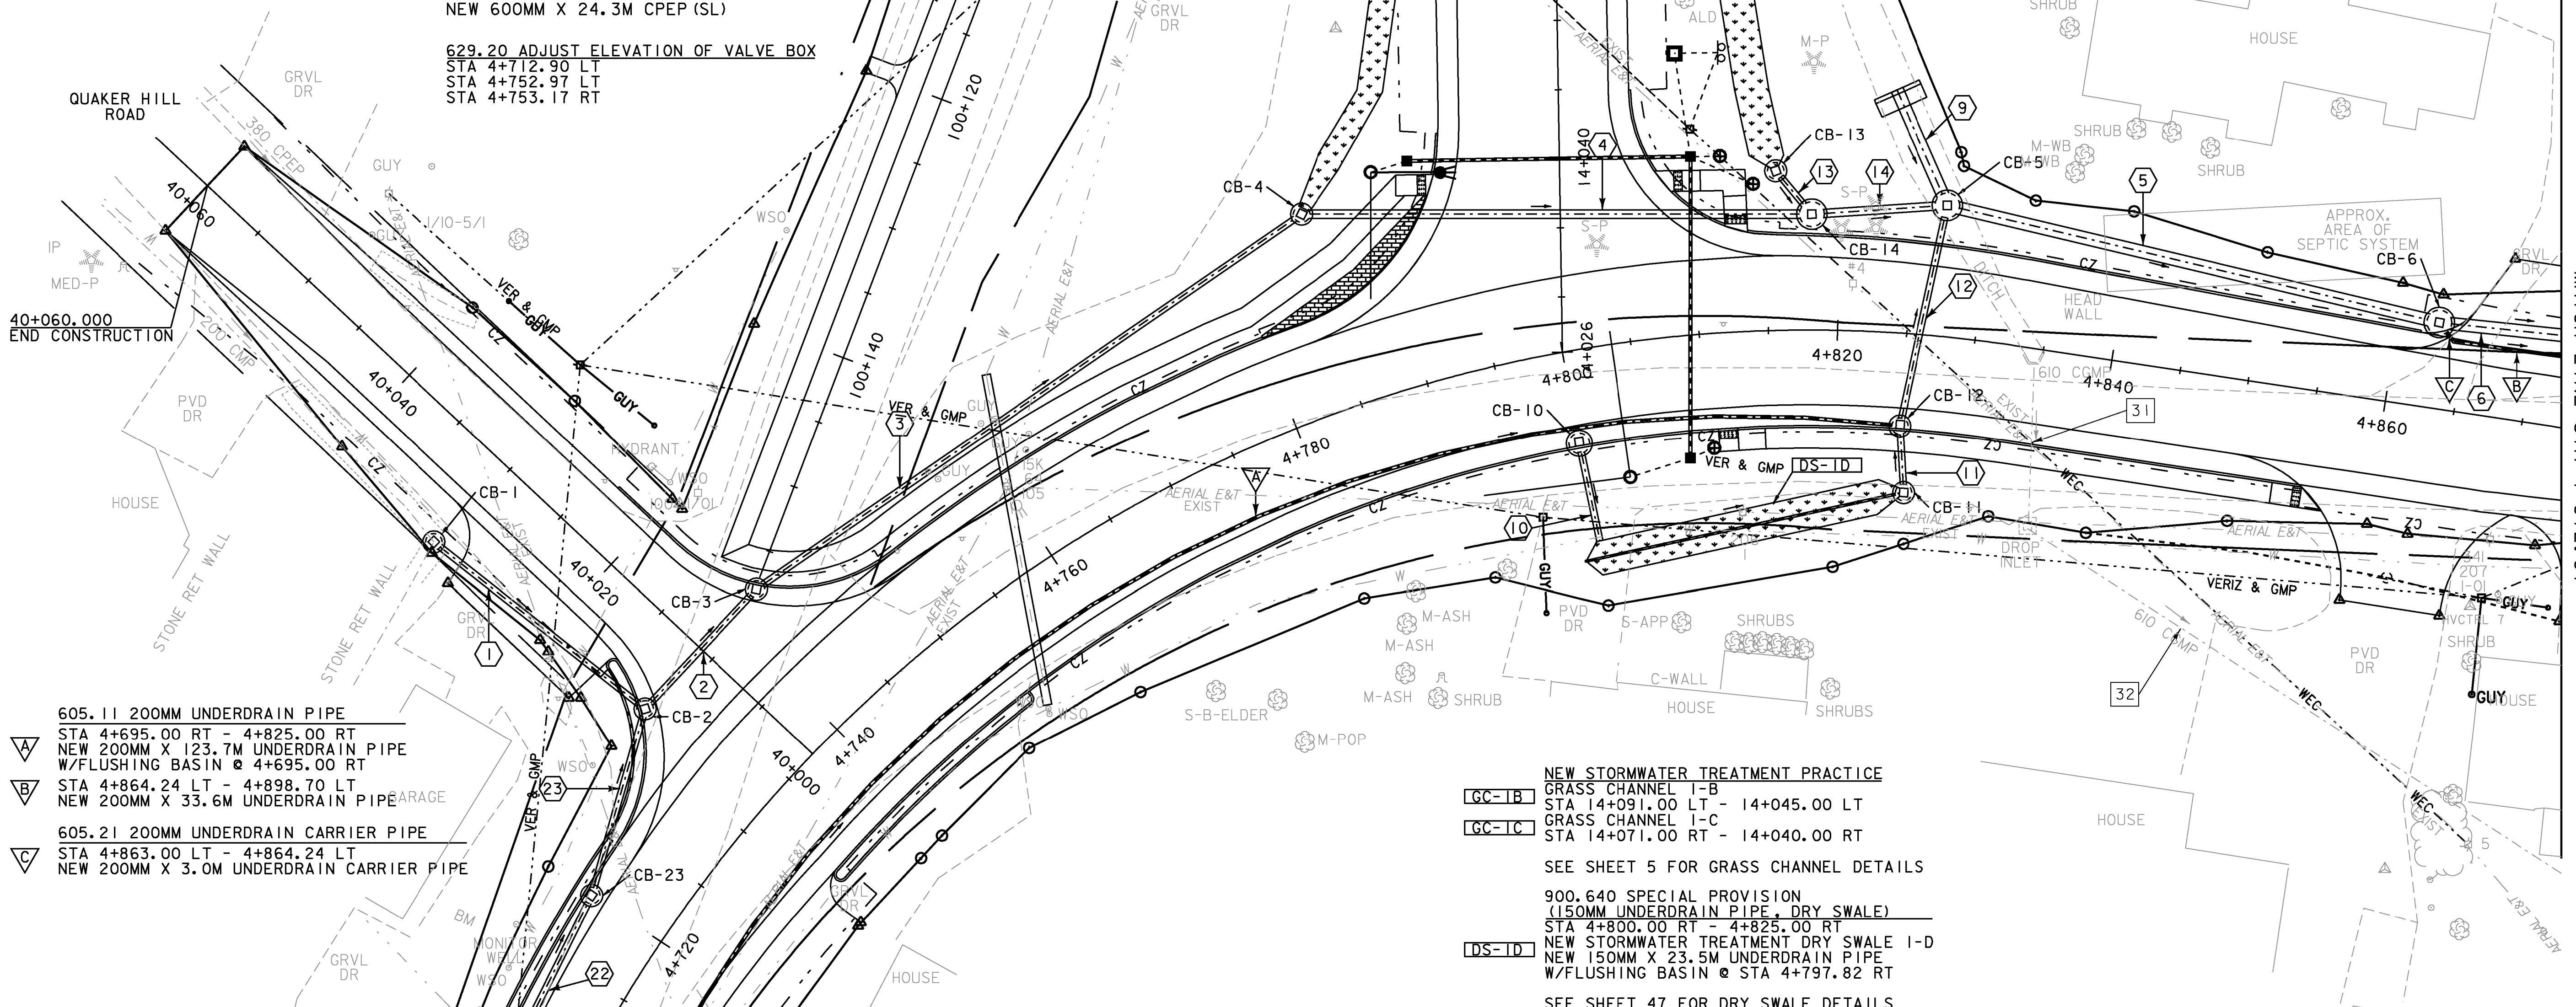

- A 605.11 200MM UNDERDRAIN PIPE
STA 4+695.00 RT - 4+825.00 RT
NEW 200MM X 123.7M UNDERDRAIN PIPE
W/FLUSHING BASIN @ 4+695.00 RT
- B STA 4+864.24 LT - 4+898.70 LT
NEW 200MM X 33.6M UNDERDRAIN PIPE
- C 605.21 200MM UNDERDRAIN CARRIER PIPE
STA 4+863.00 LT - 4+864.24 LT
NEW 200MM X 3.0M UNDERDRAIN CARRIER PIPE


- GC-1B NEW STORMWATER TREATMENT PRACTICE
GRASS CHANNEL I-B
STA 14+091.00 LT - 14+045.00 LT
- GC-1C GRASS CHANNEL I-C
STA 14+071.00 RT - 14+040.00 RT
- SEE SHEET 5 FOR GRASS CHANNEL DETAILS
- 900.640 SPECIAL PROVISION
(150MM UNDERDRAIN PIPE, DRY SWALE)
STA 4+800.00 RT - 4+825.00 RT
- DS-1D NEW STORMWATER TREATMENT DRY SWALE I-D
NEW 150MM X 23.5M UNDERDRAIN PIPE
W/FLUSHING BASIN @ STA 4+797.82 RT
- SEE SHEET 47 FOR DRY SWALE DETAILS

MATCH LINE STA 4+714.33

MATCH LINE STA 4+872.87



PROJECT NAME:	EAST MONTPELIER	FILE NAME:	+98b028bdr.dgn	PLOT DATE:	29-MAR-2010
PROJECT NUMBER:	STPG 028-3(35)S	PROJECT LEADER:	J. SCHULTZ	DRAWN BY:	D. LYMAN
		DESIGNED BY:	J. GRUCHACZ	CHECKED BY:	J. DEVLIN
		DRAINAGE LAYOUT SHEET 2		SHEET	39 OF 142

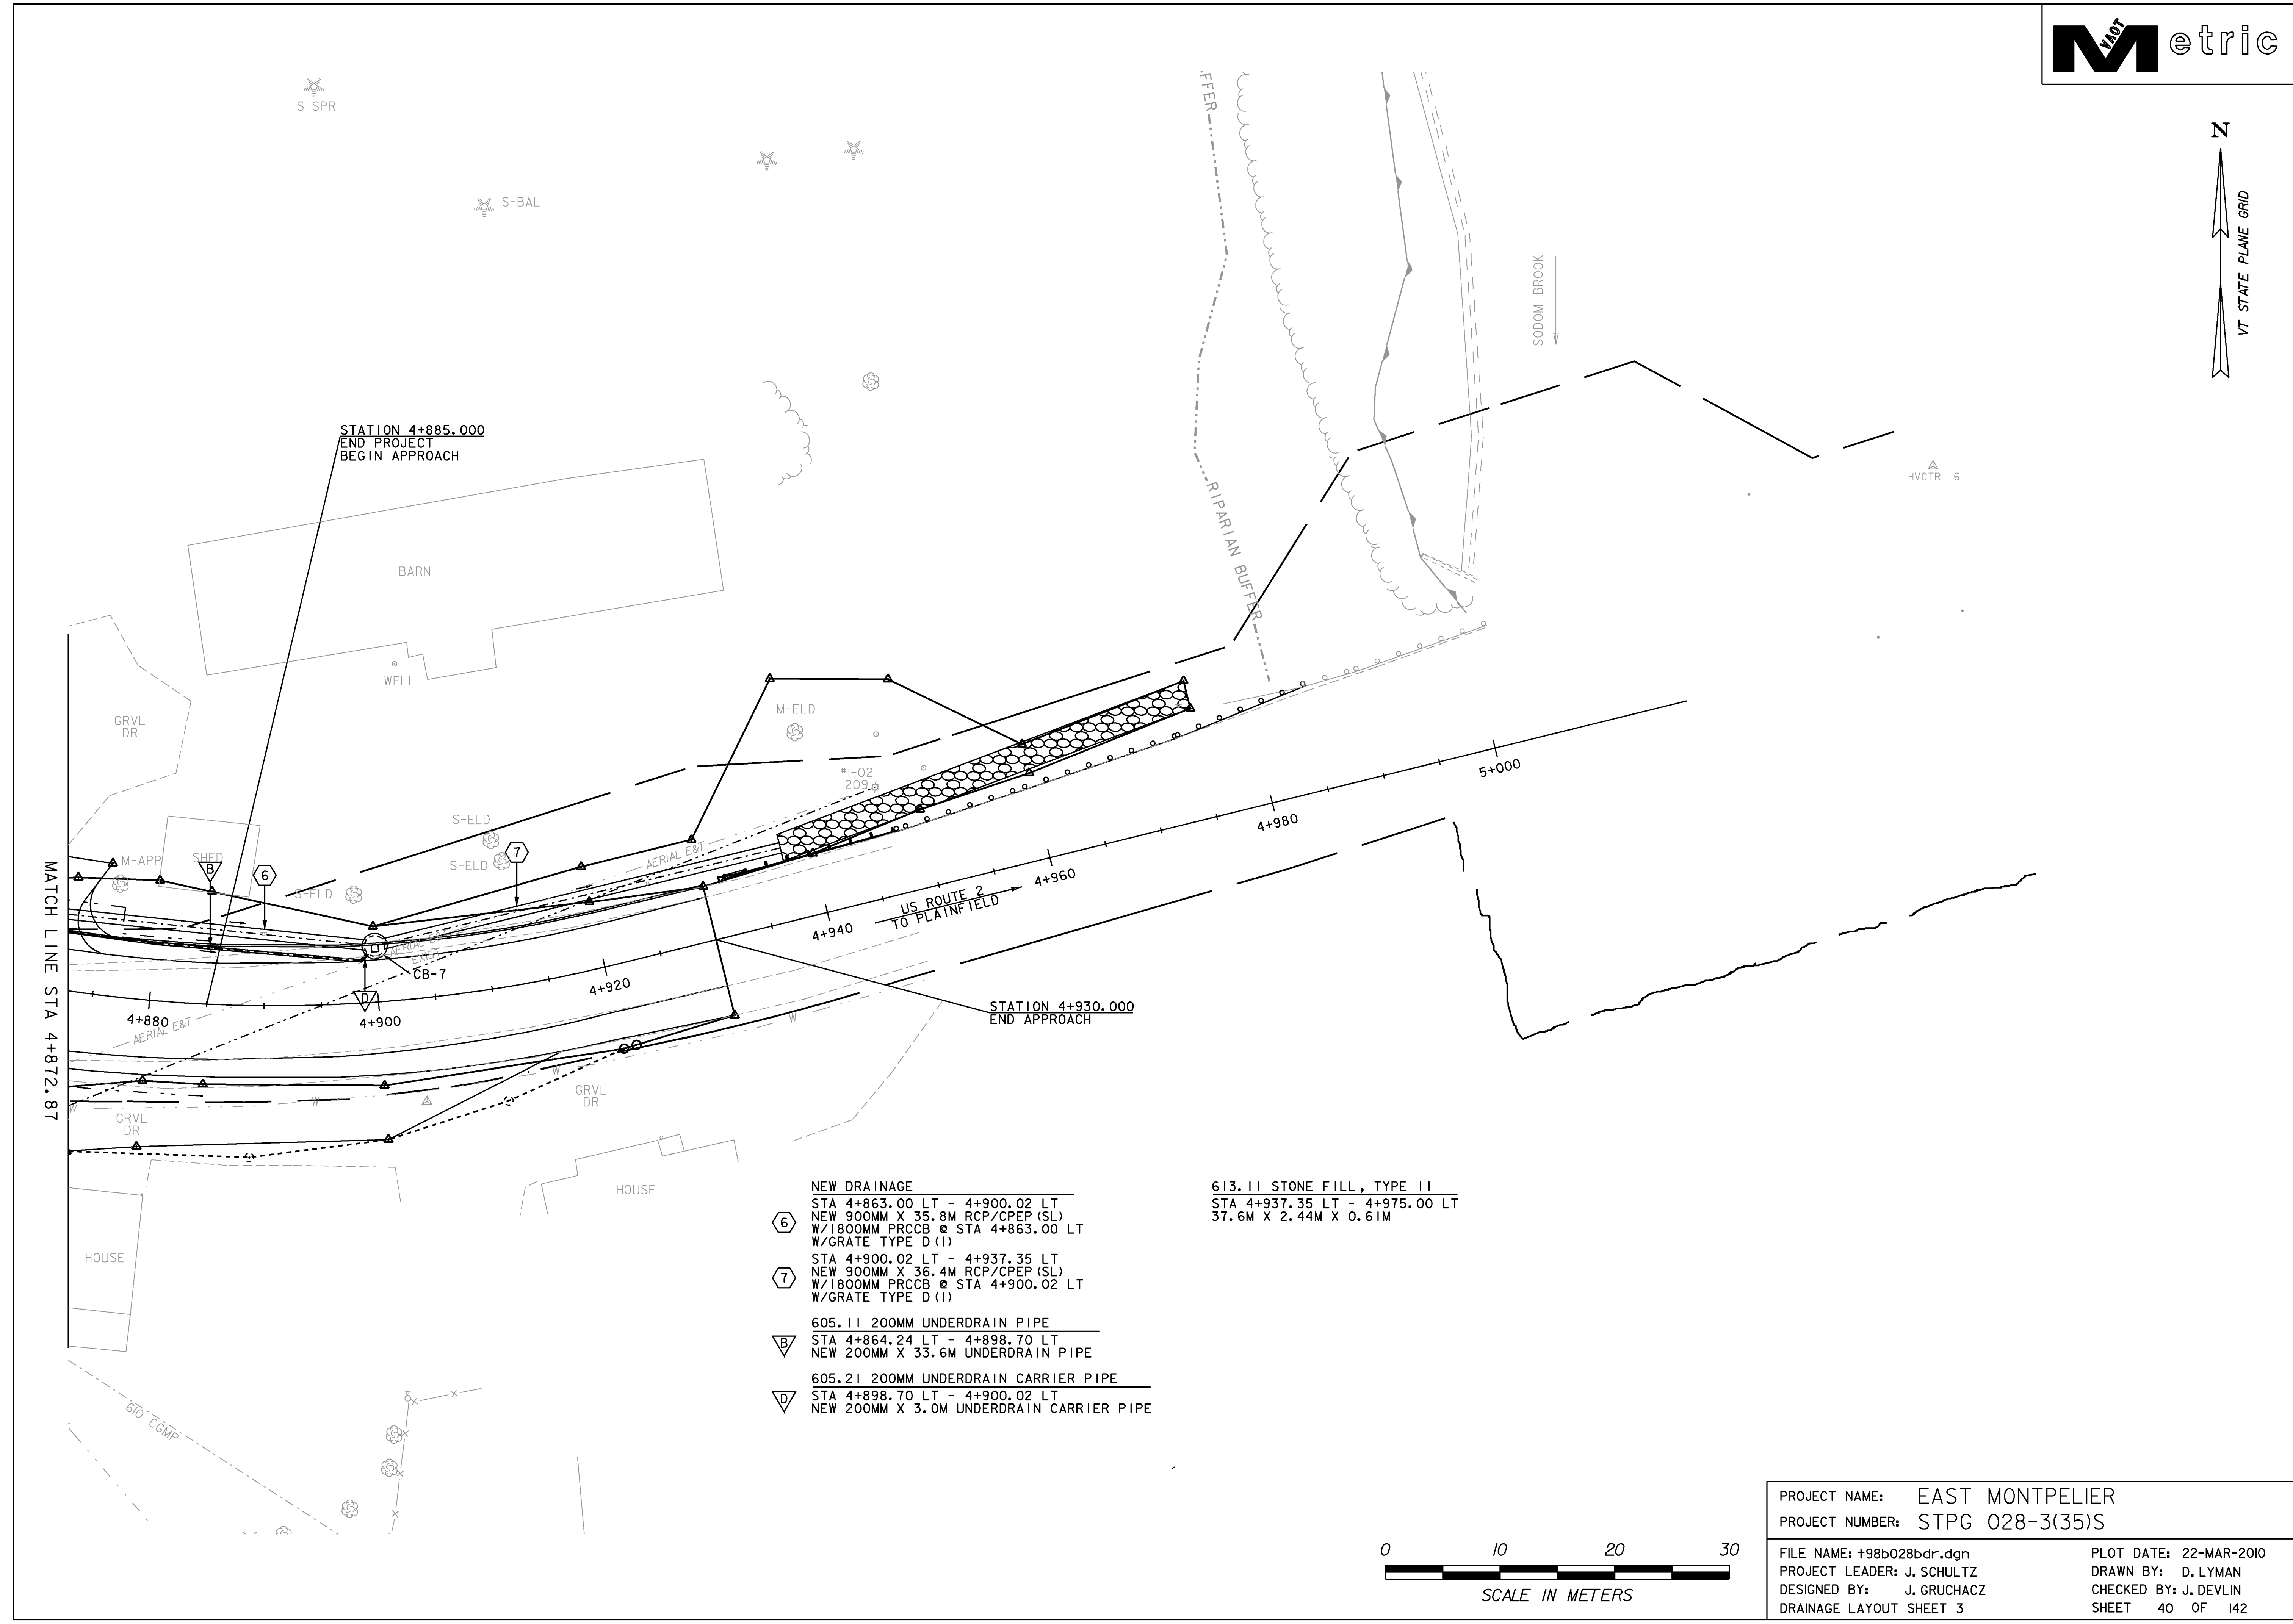

STATION 4+885.000
END PROJECT
BEGIN APPROACH

STATION 4+930.000
END APPROACH


MATCH LINE STA 4+872.87

- NEW DRAINAGE
- ⑥ STA 4+863.00 LT - 4+900.02 LT
NEW 900MM X 35.8M RCP/CPEP (SL)
W/1800MM PRCCB @ STA 4+863.00 LT
W/GRATE TYPE D (I)
- ⑦ STA 4+900.02 LT - 4+937.35 LT
NEW 900MM X 36.4M RCP/CPEP (SL)
W/1800MM PRCCB @ STA 4+900.02 LT
W/GRATE TYPE D (I)
- 605.11 200MM UNDERDRAIN PIPE
- ▽B STA 4+864.24 LT - 4+898.70 LT
NEW 200MM X 33.6M UNDERDRAIN PIPE
- 605.21 200MM UNDERDRAIN CARRIER PIPE
- ▽D STA 4+898.70 LT - 4+900.02 LT
NEW 200MM X 3.0M UNDERDRAIN CARRIER PIPE

613.11 STONE FILL, TYPE II
STA 4+937.35 LT - 4+975.00 LT
37.6M X 2.44M X 0.61M



PROJECT NAME: EAST MONTPELIER	PLOT DATE: 22-MAR-2010
PROJECT NUMBER: STPG 028-3(35)S	DRAWN BY: D. LYMAN
FILE NAME: +98b028bdr.dgn	CHECKED BY: J. DEVLIN
DESIGNED BY: J. GRUCHACZ	SHEET 40 OF 142
DRAINAGE LAYOUT SHEET 3	

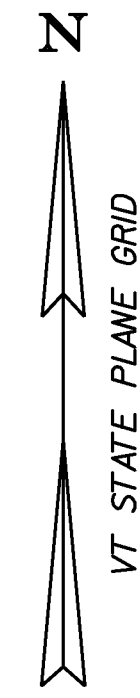


- NEW DRAINAGE**
- 15 STA 14+091.93 LT - 14+076.43 RT
NEW 600MM X 29.3M RCP/CPEP (SL)
W/1800MM PRCCB @ STA 14+091.93 LT
W/GRATE TYPE D (I)
 - 16 STA 100+055.52 RT - 14+091.93 LT
NEW 375MM X 22.8M RCP/CPEP (SL)
W/EXISTING DI @ STA 100+055.52 RT
 - 17 STA 100+078.45 RT - 14+091.93 LT
NEW 450MM X 29.8M RCP/CPEP (SL)
W/1200MM PRCCB @ STA 100+078.45 RT
W/GRATE TYPE D (I)
 - 18 STA 100+012.63 RT - 14+130.87 LT
NEW 450MM X 16.7M RCP/CPEP (SL)
W/1200MM PRCCB @ STA 100+012.63 RT
W/GRATE TYPE D (I)
 - 19 STA 14+149.19 LT - 14+130.87 LT
NEW 450MM X 20.6M RCP/CPEP (SL)
W/1200MM PRCCB @ STA 14+149.19 LT
W/GRATE TYPE D (I)
 - 20 STA 14+149.00 RT - 14+130.87 LT
NEW 450MM X 30.7M RCP/CPEP (SL)
W/1200MM PRCCB @ STA 14+149.00 RT
W/GRATE TYPE D (I)
 - 21 STA 14+130.87 LT - 14+091.93 LT
NEW 600MM X 43.4M RCP/CPEP (SL)
W/1500MM PRCCB @ STA 14+130.87 LT
W/GRATE TYPE D (I)

- EXISTING DRAINAGE**
- 35 STA 14+145.09 RT - 14+139.57 RT
EXISTING 310MM X 26.5M CGMP = REMOVE
 - 36 STA 14+139.57 RT - 14+250.24 RT
EXISTING 310MM X 96.2M CGMP = RETAIN
 - 37 STA 14+148.47 LT - 14+143.45 LT
EXISTING 380MM X 14.2M CGMP = REMOVE
 - 38 STA 100+012.63 RT - 14+128.19 LT
EXISTING 460MM X 20.3M RCP & DI =
REMOVE EXISTING PIPE AND DI
 - 39 STA 100+055.52 RT - 100+057.93 LT
EXISTING 380MM X 14.4M CGMP & DI =
RETAIN DI & REMOVE EXISTING PIPE

- NEW STORMWATER TREATMENT PRACTICE**
- GC-1A GRASS CHANNEL 1-A
STA 14+205.00 RT - 14+150.00 RT
 - GC-1B GRASS CHANNEL 1-B
STA 14+091.00 LT - 14+045.00 LT


SEE SHEET 5 FOR GRASS CHANNEL DETAILS

629.20 ADJUST ELEVATION OF VALVE BOX
STA 14+177.10 LT
STA 14+193.27 LT
STA 14+193.37 LT

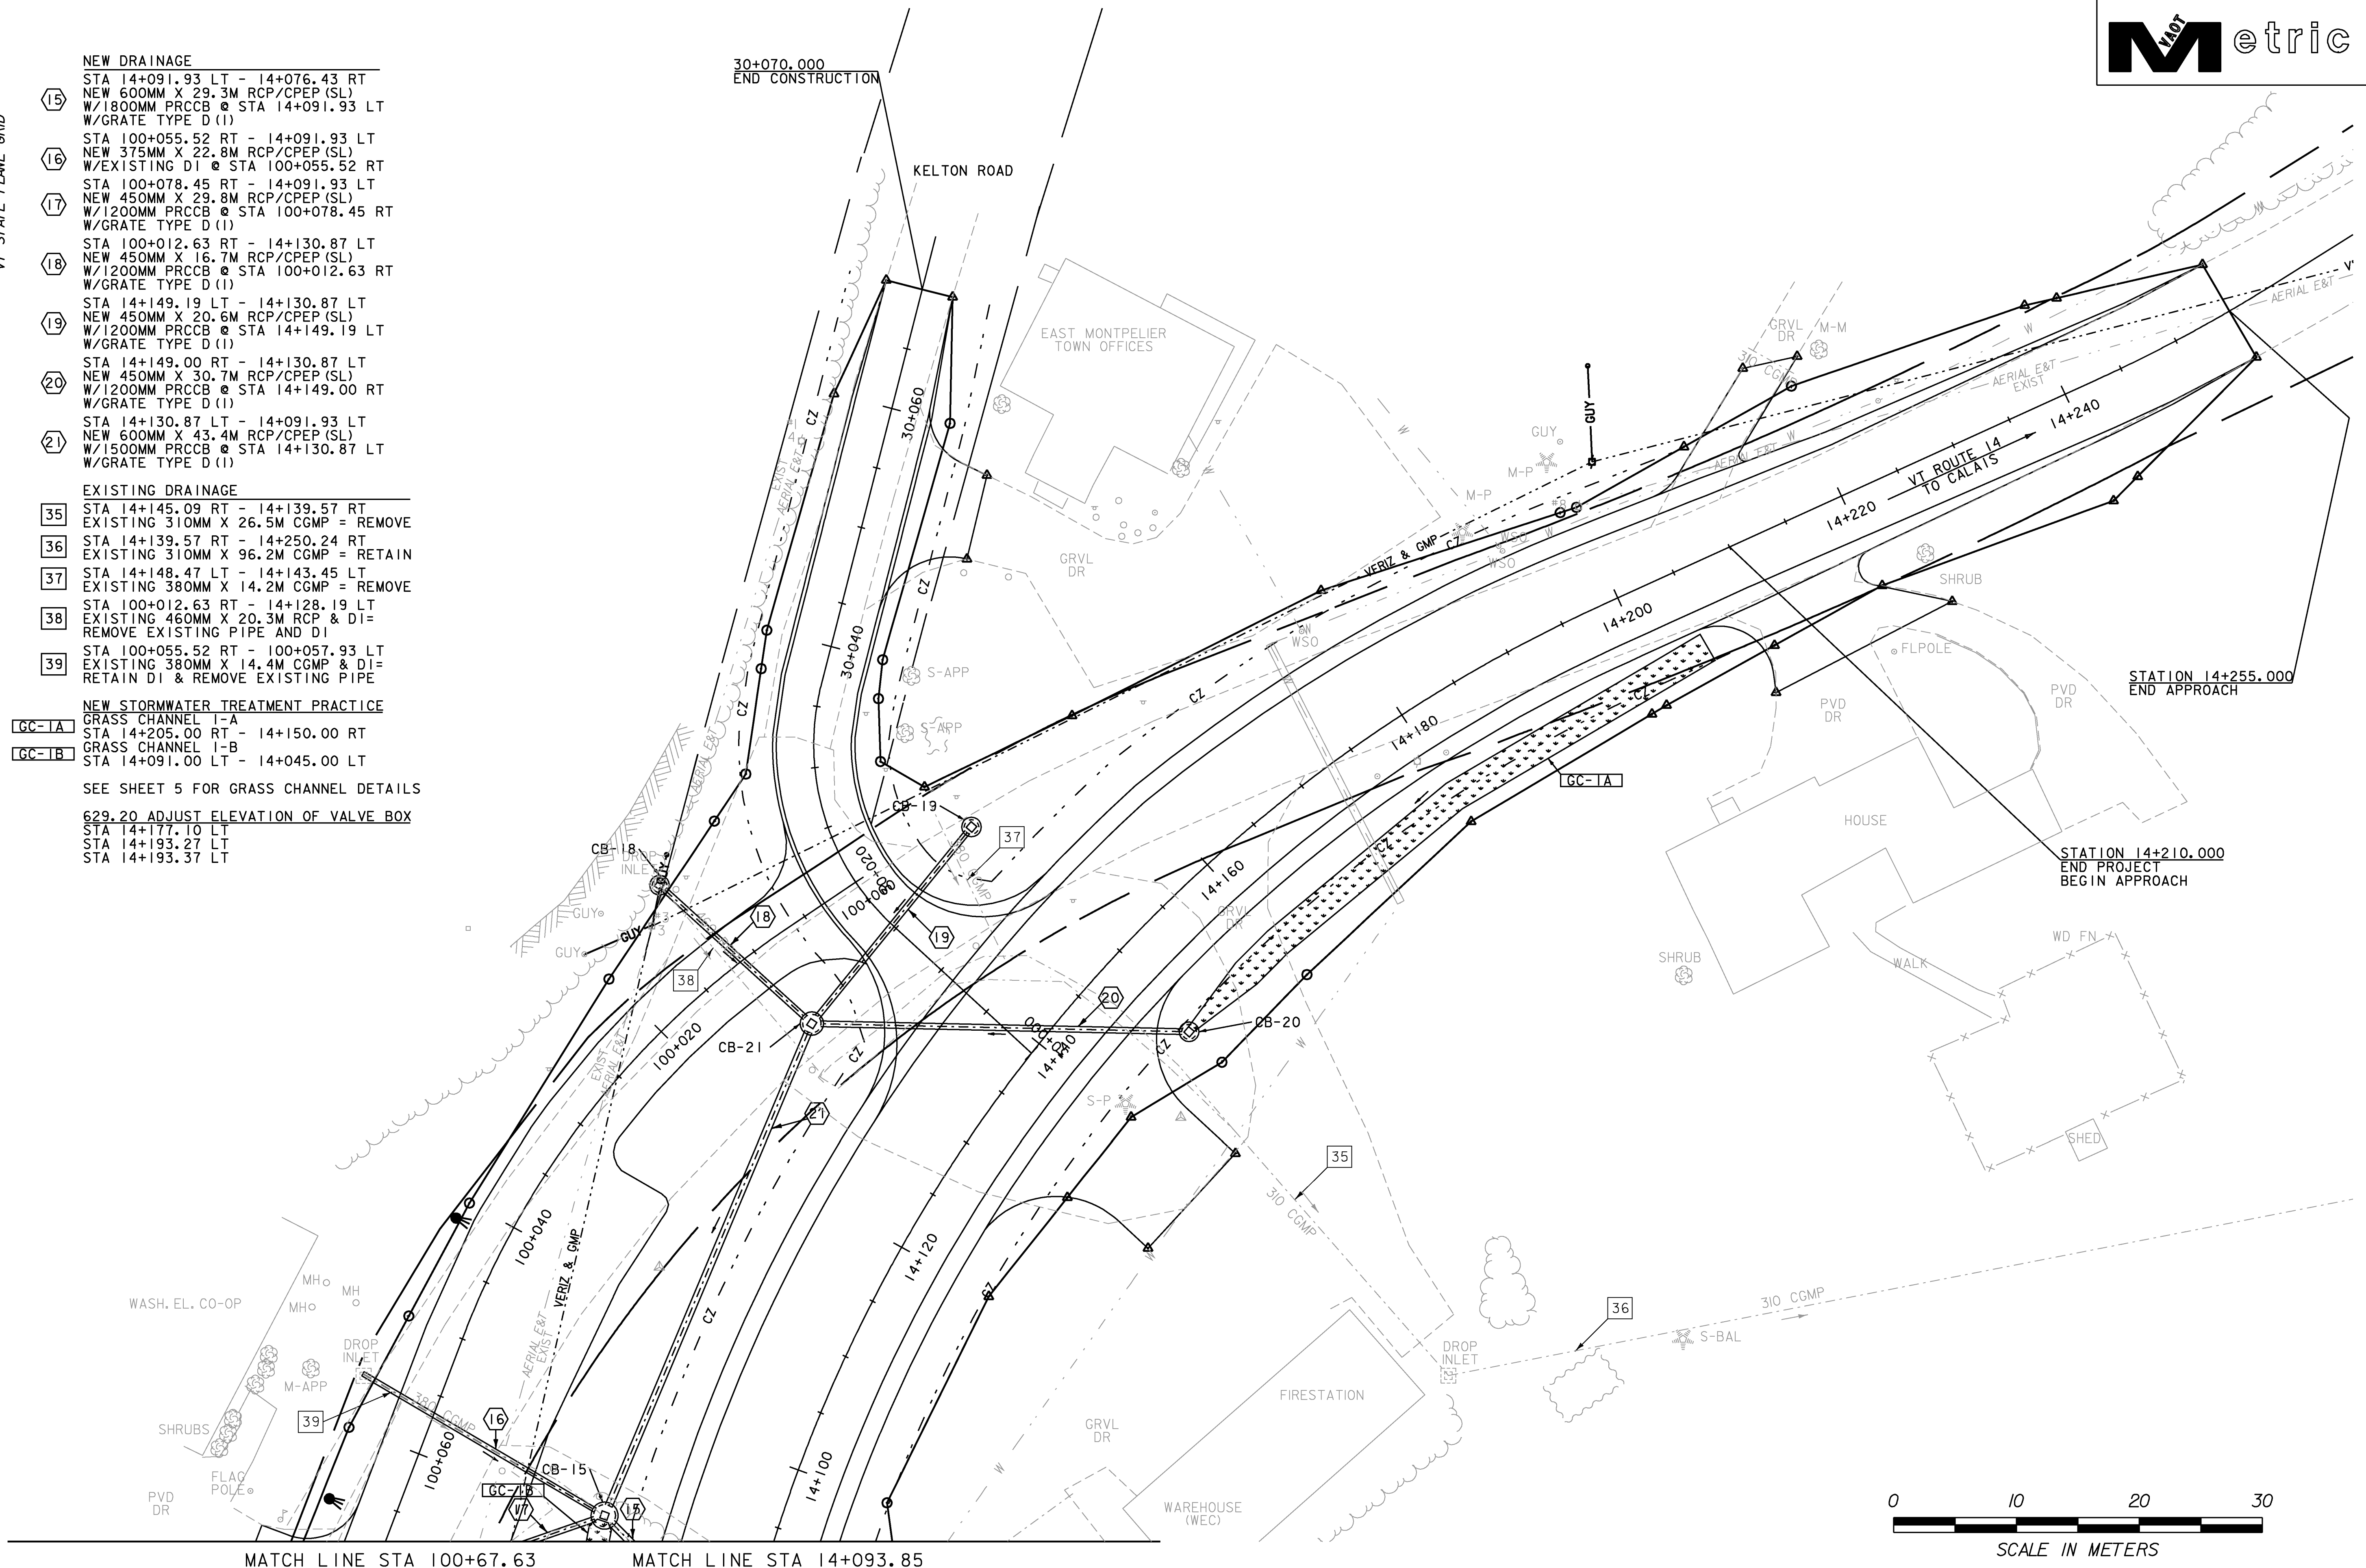

PROJECT NAME:	EAST MONTEPELIER
PROJECT NUMBER:	STPG 028-3(35)S
FILE NAME:	+98b028bdr.dgn
PROJECT LEADER:	J. SCHULTZ
DESIGNED BY:	J. GRUCHACZ
DRAINAGE LAYOUT SHEET 4	
PLOT DATE:	22-MAR-2010
DRAWN BY:	D. LYMAN
CHECKED BY:	J. DEVLIN
SHEET	41 OF 142


PIPE 1

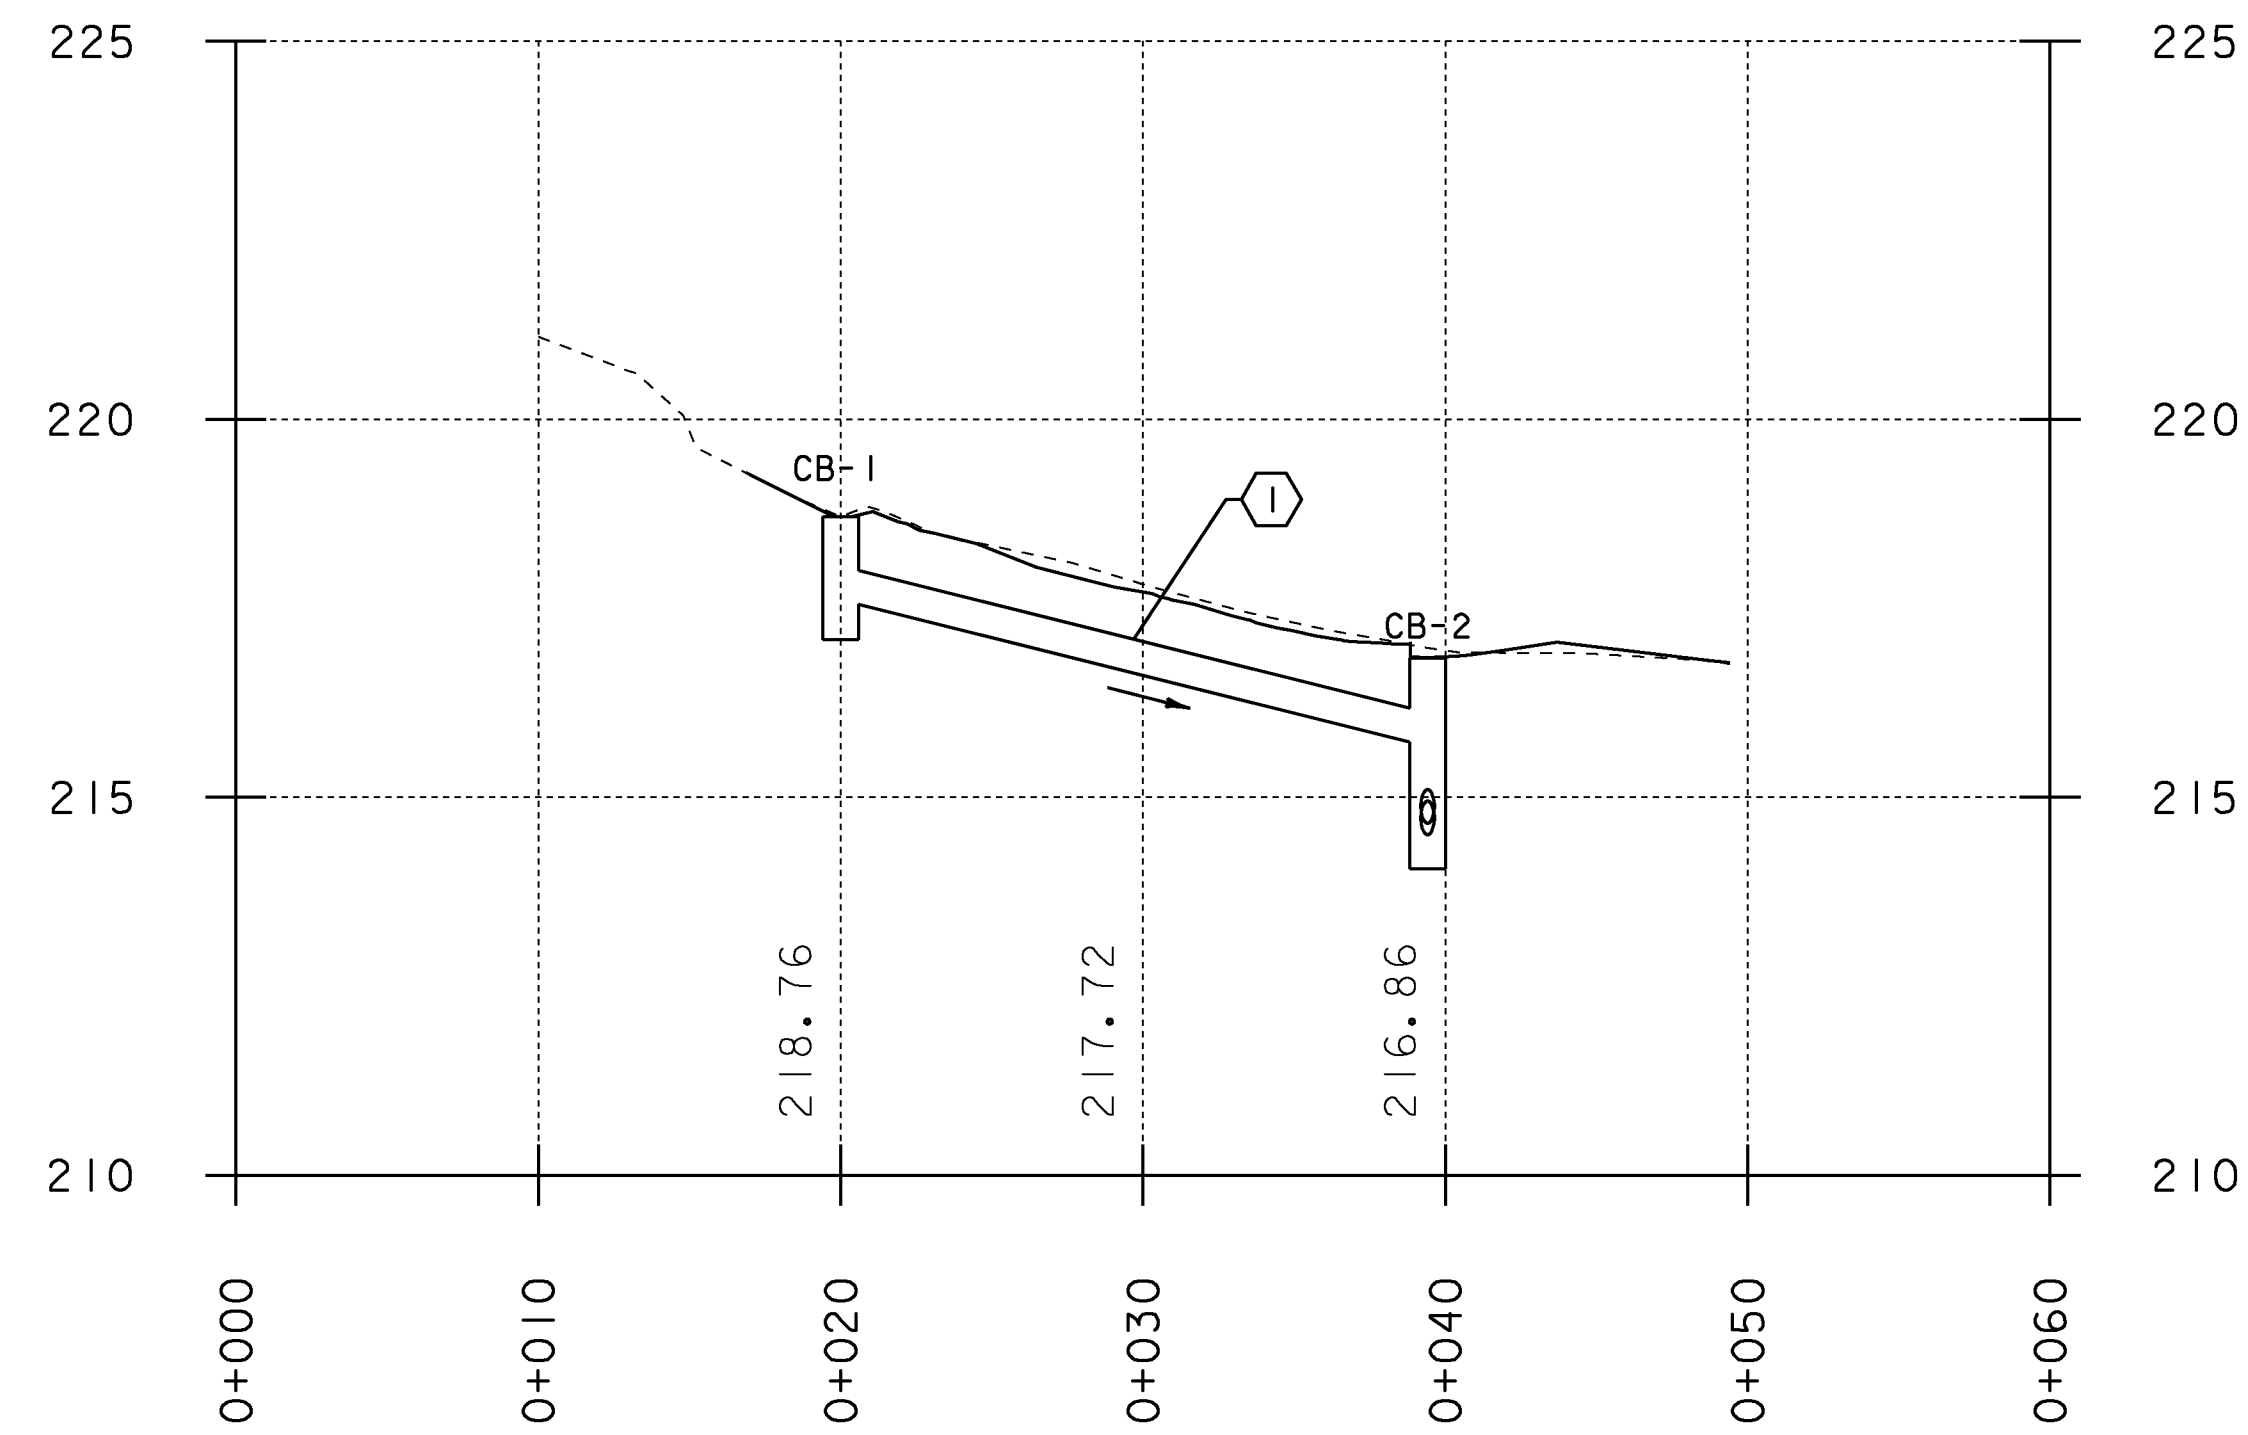

CB-1
 GRATE: TYPE D
 RIM EL = 218.71M
 DIAM. = 1200MM
 DEPTH = 1.62M

1
 SLOPE = 10.01%
 NEW PIPE
 TYPE: OPTION PIPE
 LENGTH = 19.51M
 DIAMETER = 450.00MM
 INV IN = 217.54M
 INV OUT = 215.71M


PIPE 2

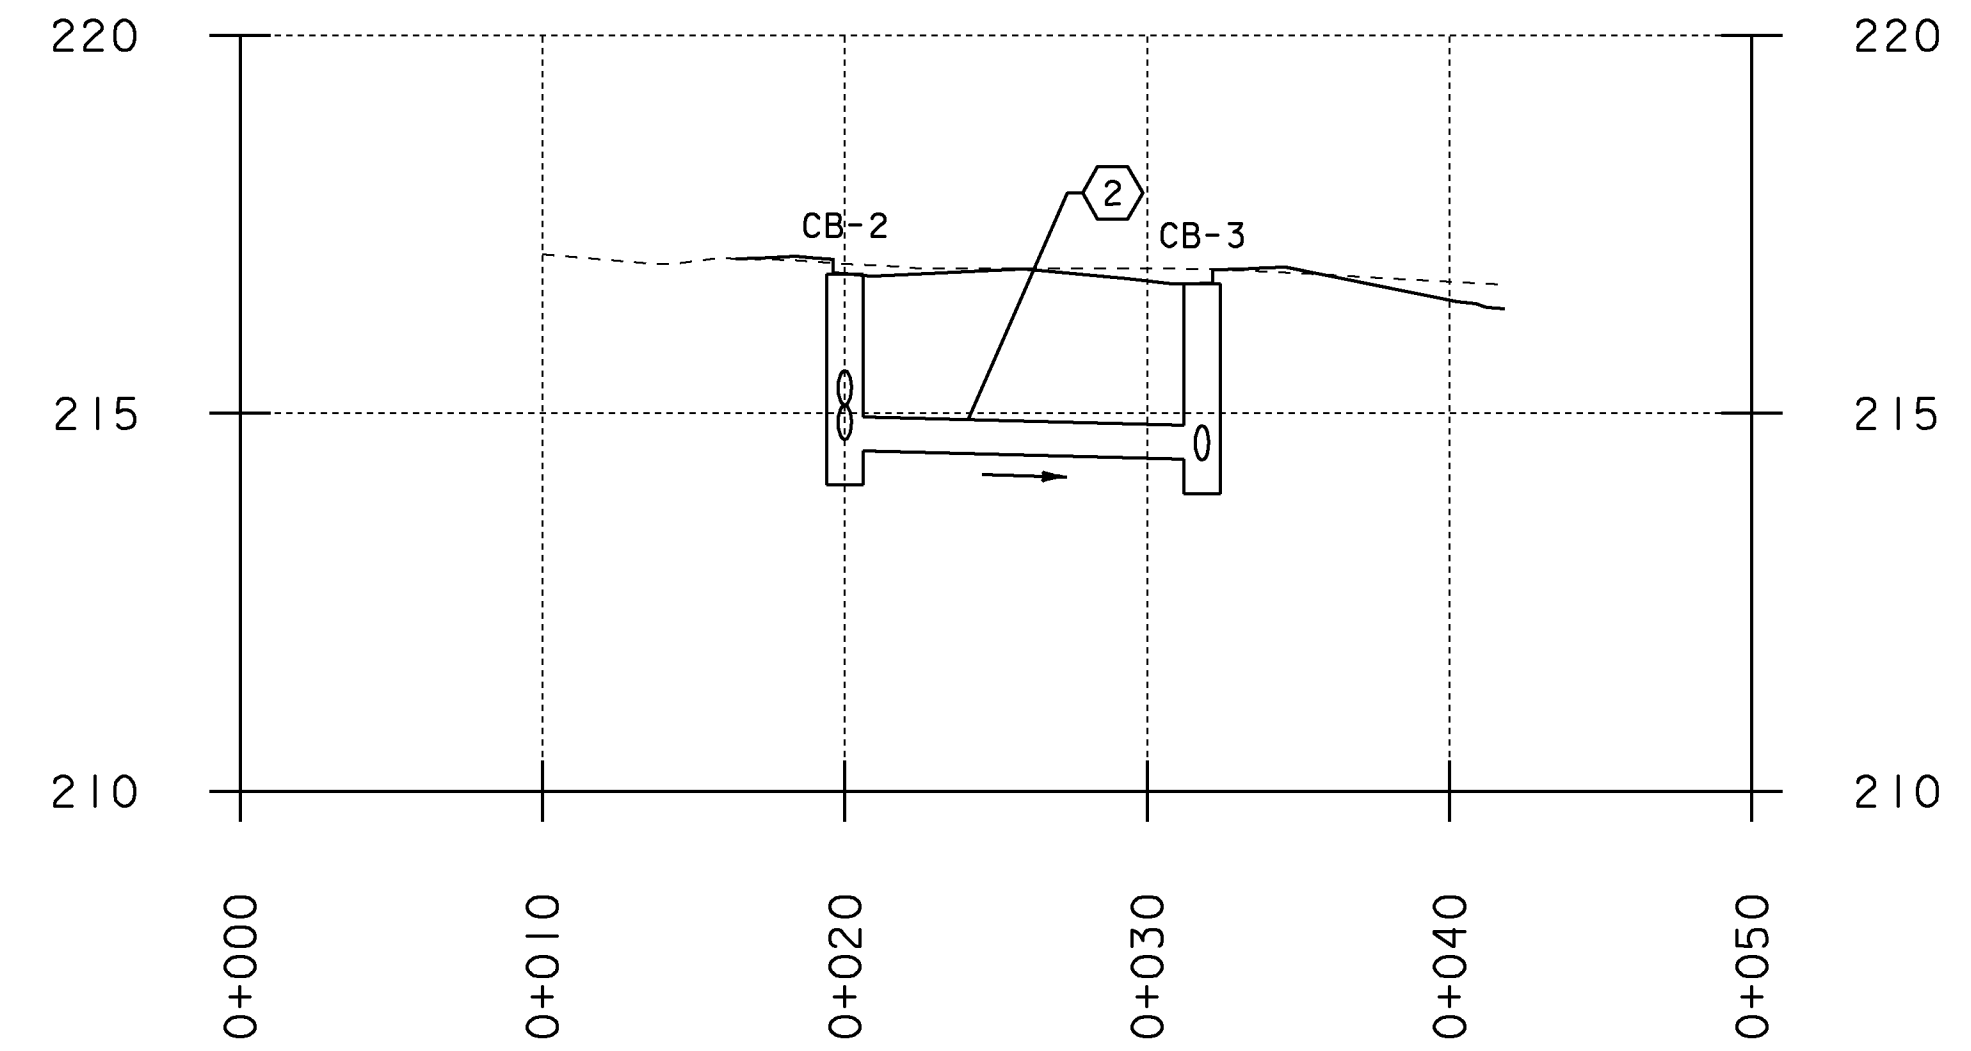

CB-2
 GRATE: TYPE D
 RIM EL = 216.84M
 DIAM. = 1200MM
 DEPTH = 2.79M

2
 SLOPE = 1.00%
 NEW PIPE
 TYPE: OPTION PIPE
 LENGTH = 11.82M
 DIAMETER = 450.00MM
 INV IN = 214.50M
 INV OUT = 214.40M


PIPE 3

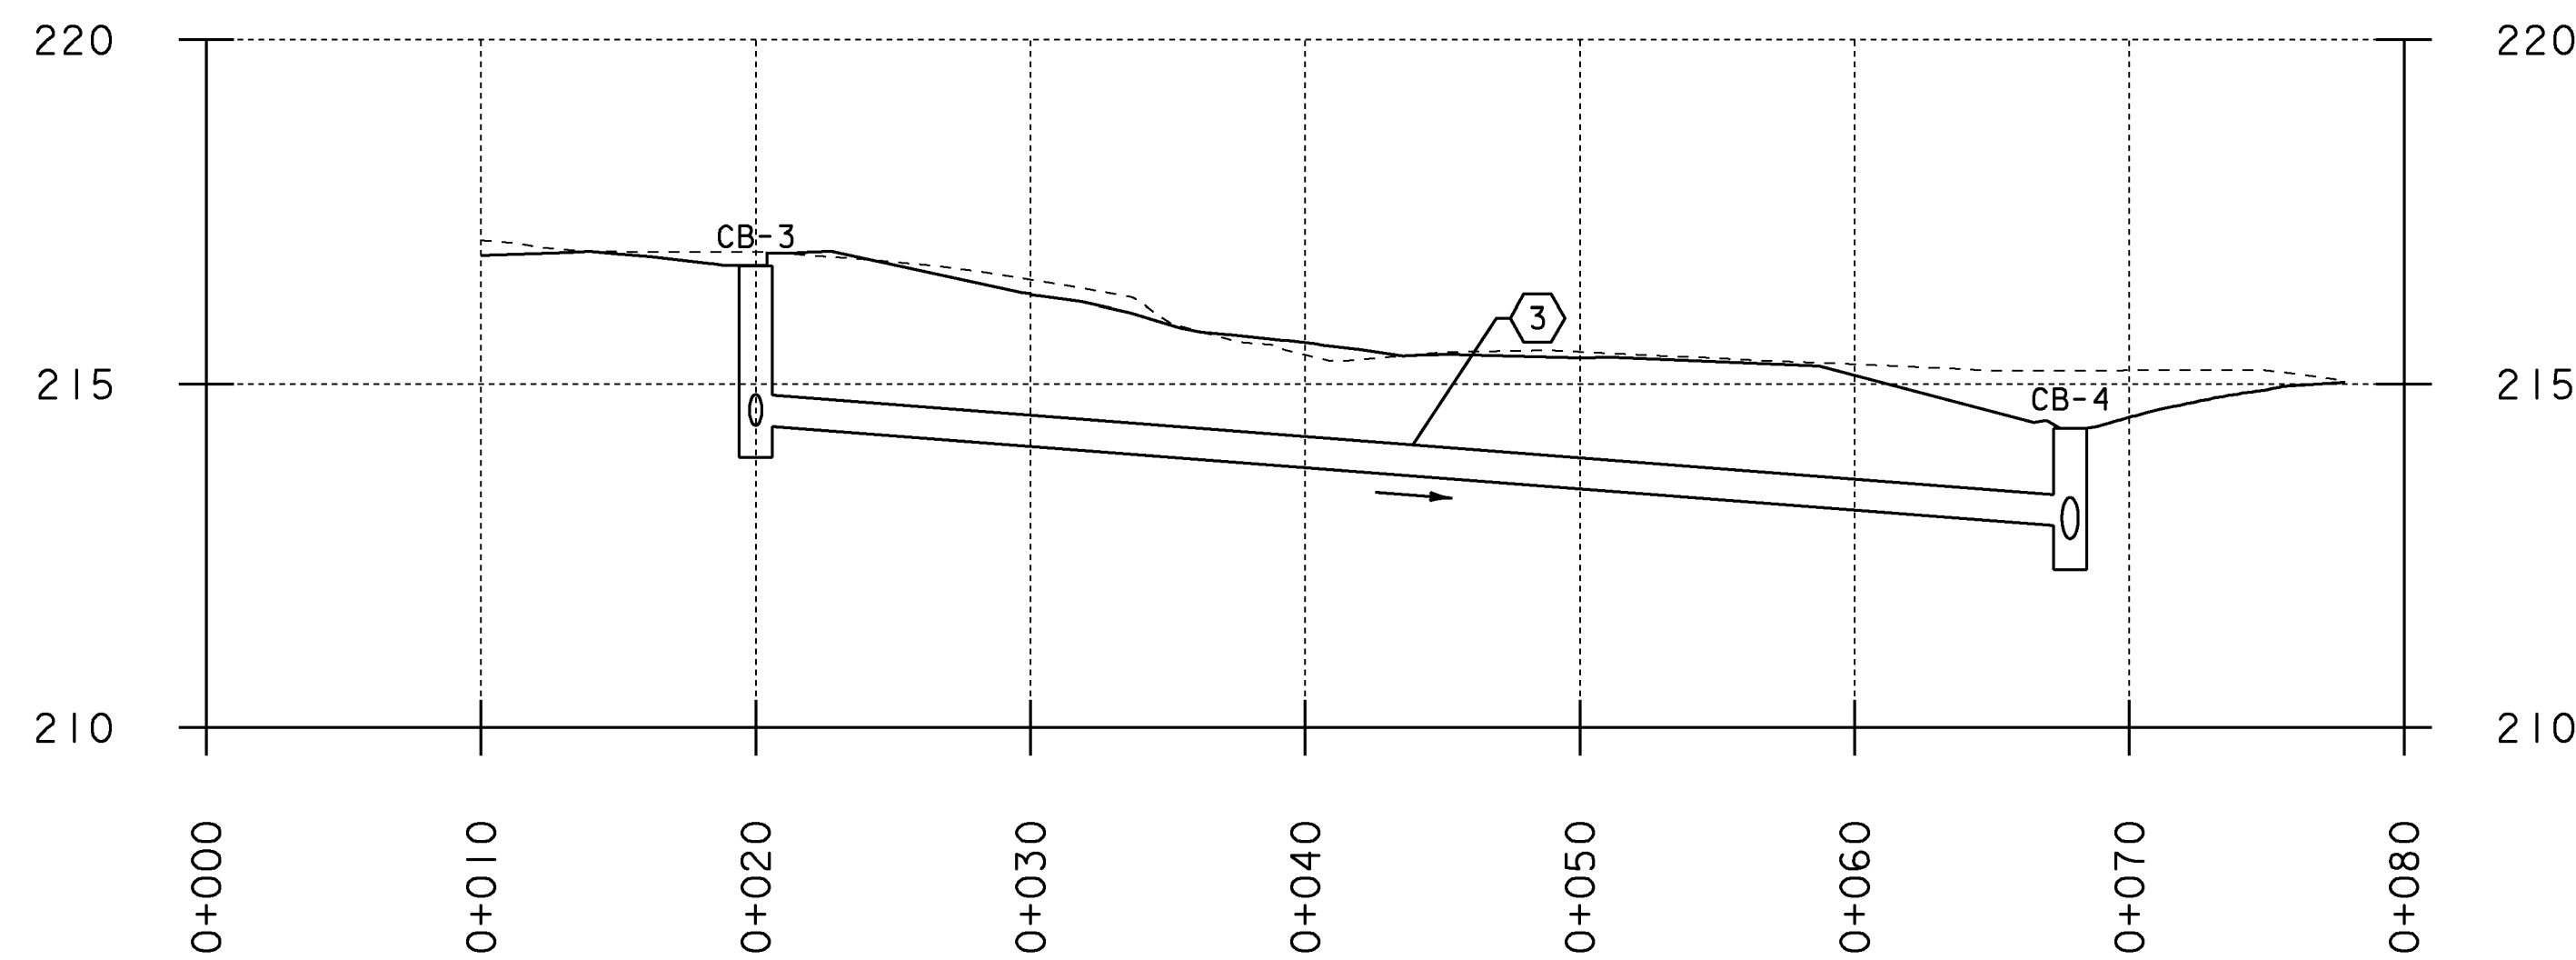

CB-3
 GRATE: TYPE D
 RIM EL = 216.71M
 DIAM. = 1200MM
 DEPTH = 2.78M


3
 SLOPE = 3.10%
 NEW PIPE
 TYPE: OPTION PIPE
 LENGTH = 47.86M
 DIAMETER = 450.00MM
 INV IN = 214.39M
 INV OUT = 212.94M

PIPE 4

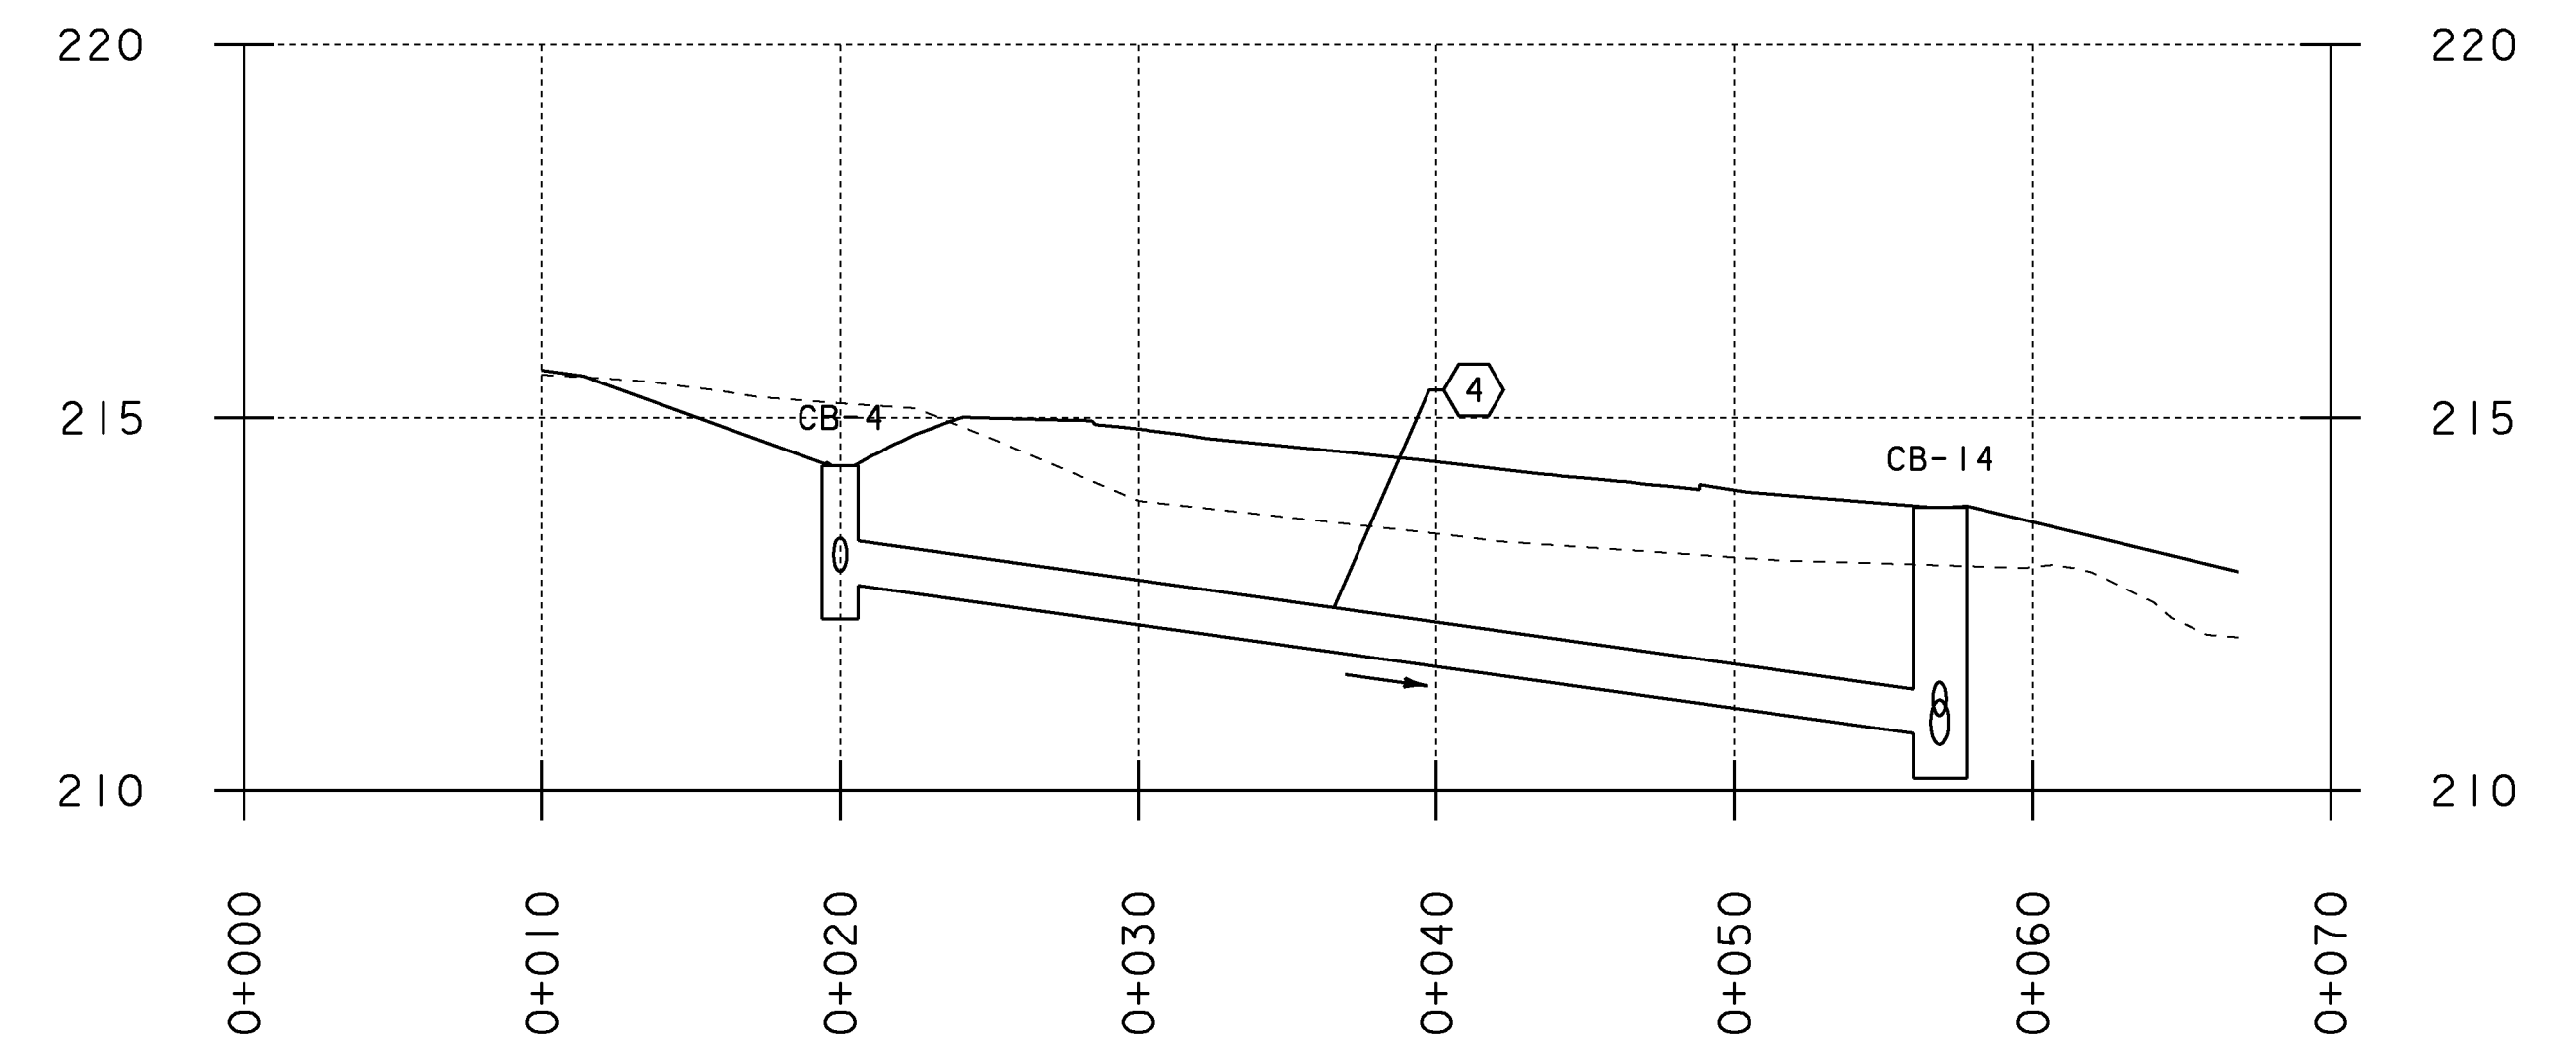


CB-4
 GRATE: TYPE D
 RIM EL = 214.35M
 DIAM. = 1200MM
 DEPTH = 2.05M

4
 SLOPE = 5.62%
 NEW PIPE
 TYPE: OPTION PIPE
 LENGTH = 36.95M
 DIAMETER = 600.00MM
 INV IN = 212.75M
 INV OUT = 210.76M

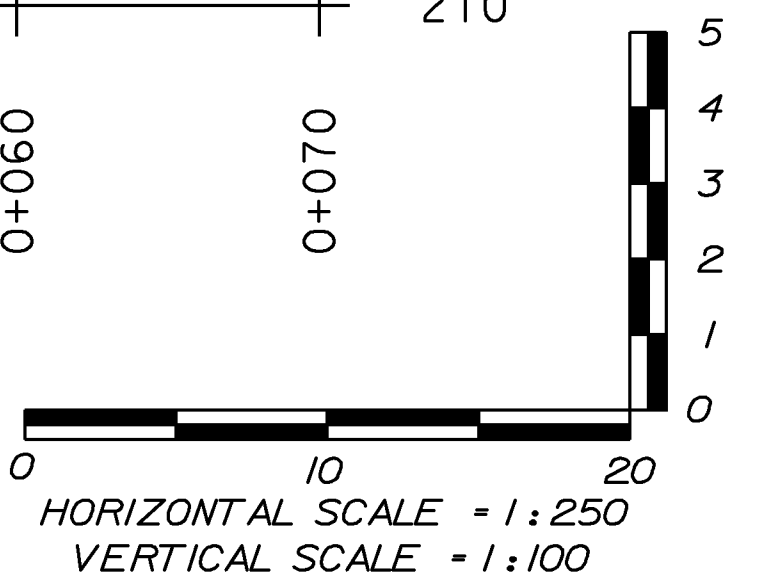

PROJECT NAME: EAST MONTPELIER	PLOT DATE: 22-MAR-2010
PROJECT NUMBER: STPG 028 - 3(35)S	DRAWN BY: D. LYMAN
FILE NAME: +98b028profile.dgn	CHECKED BY: J. DEVLIN
PROJECT LEADER: J.SCHULTZ	SHEET 42 OF 142
DESIGNED BY: J. GRUCHACZ	
DRAINAGE PROFILE SHEET 1	


PIPE 5

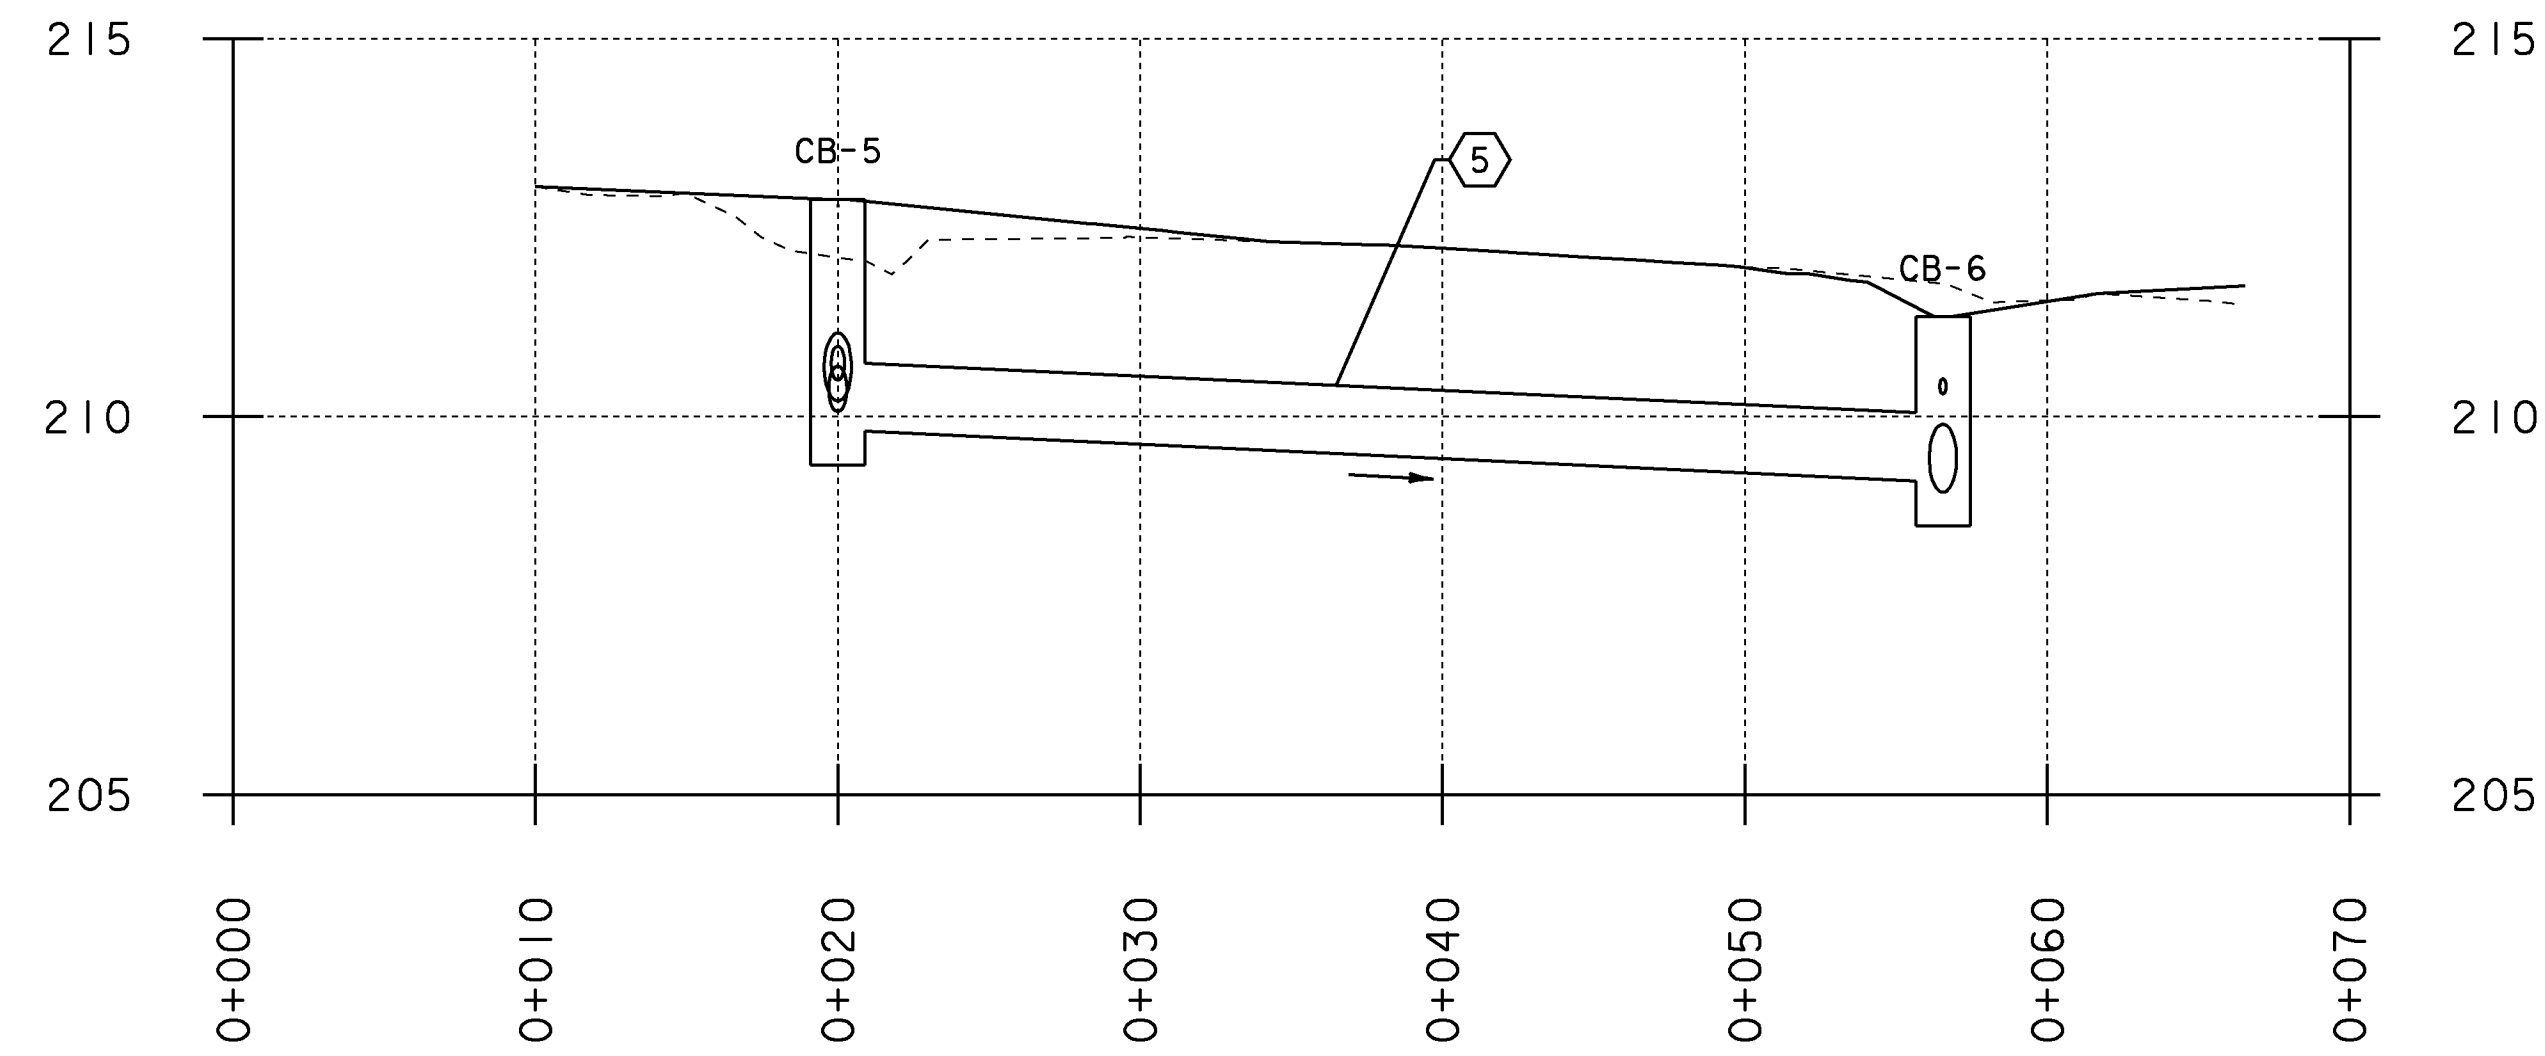

CB-5
 GRATE: TYPE D
 RIM EL = 212.88M
 DIAM. = 1800MM
 DEPTH = 3.52M

5
 SLOPE = 1.89%
 NEW PIPE
 TYPE: OPTION PIPE
 LENGTH = 36.55M
 DIAMETER = 900.00MM
 INV IN = 209.81M
 INV OUT = 209.15M


PIPE 6

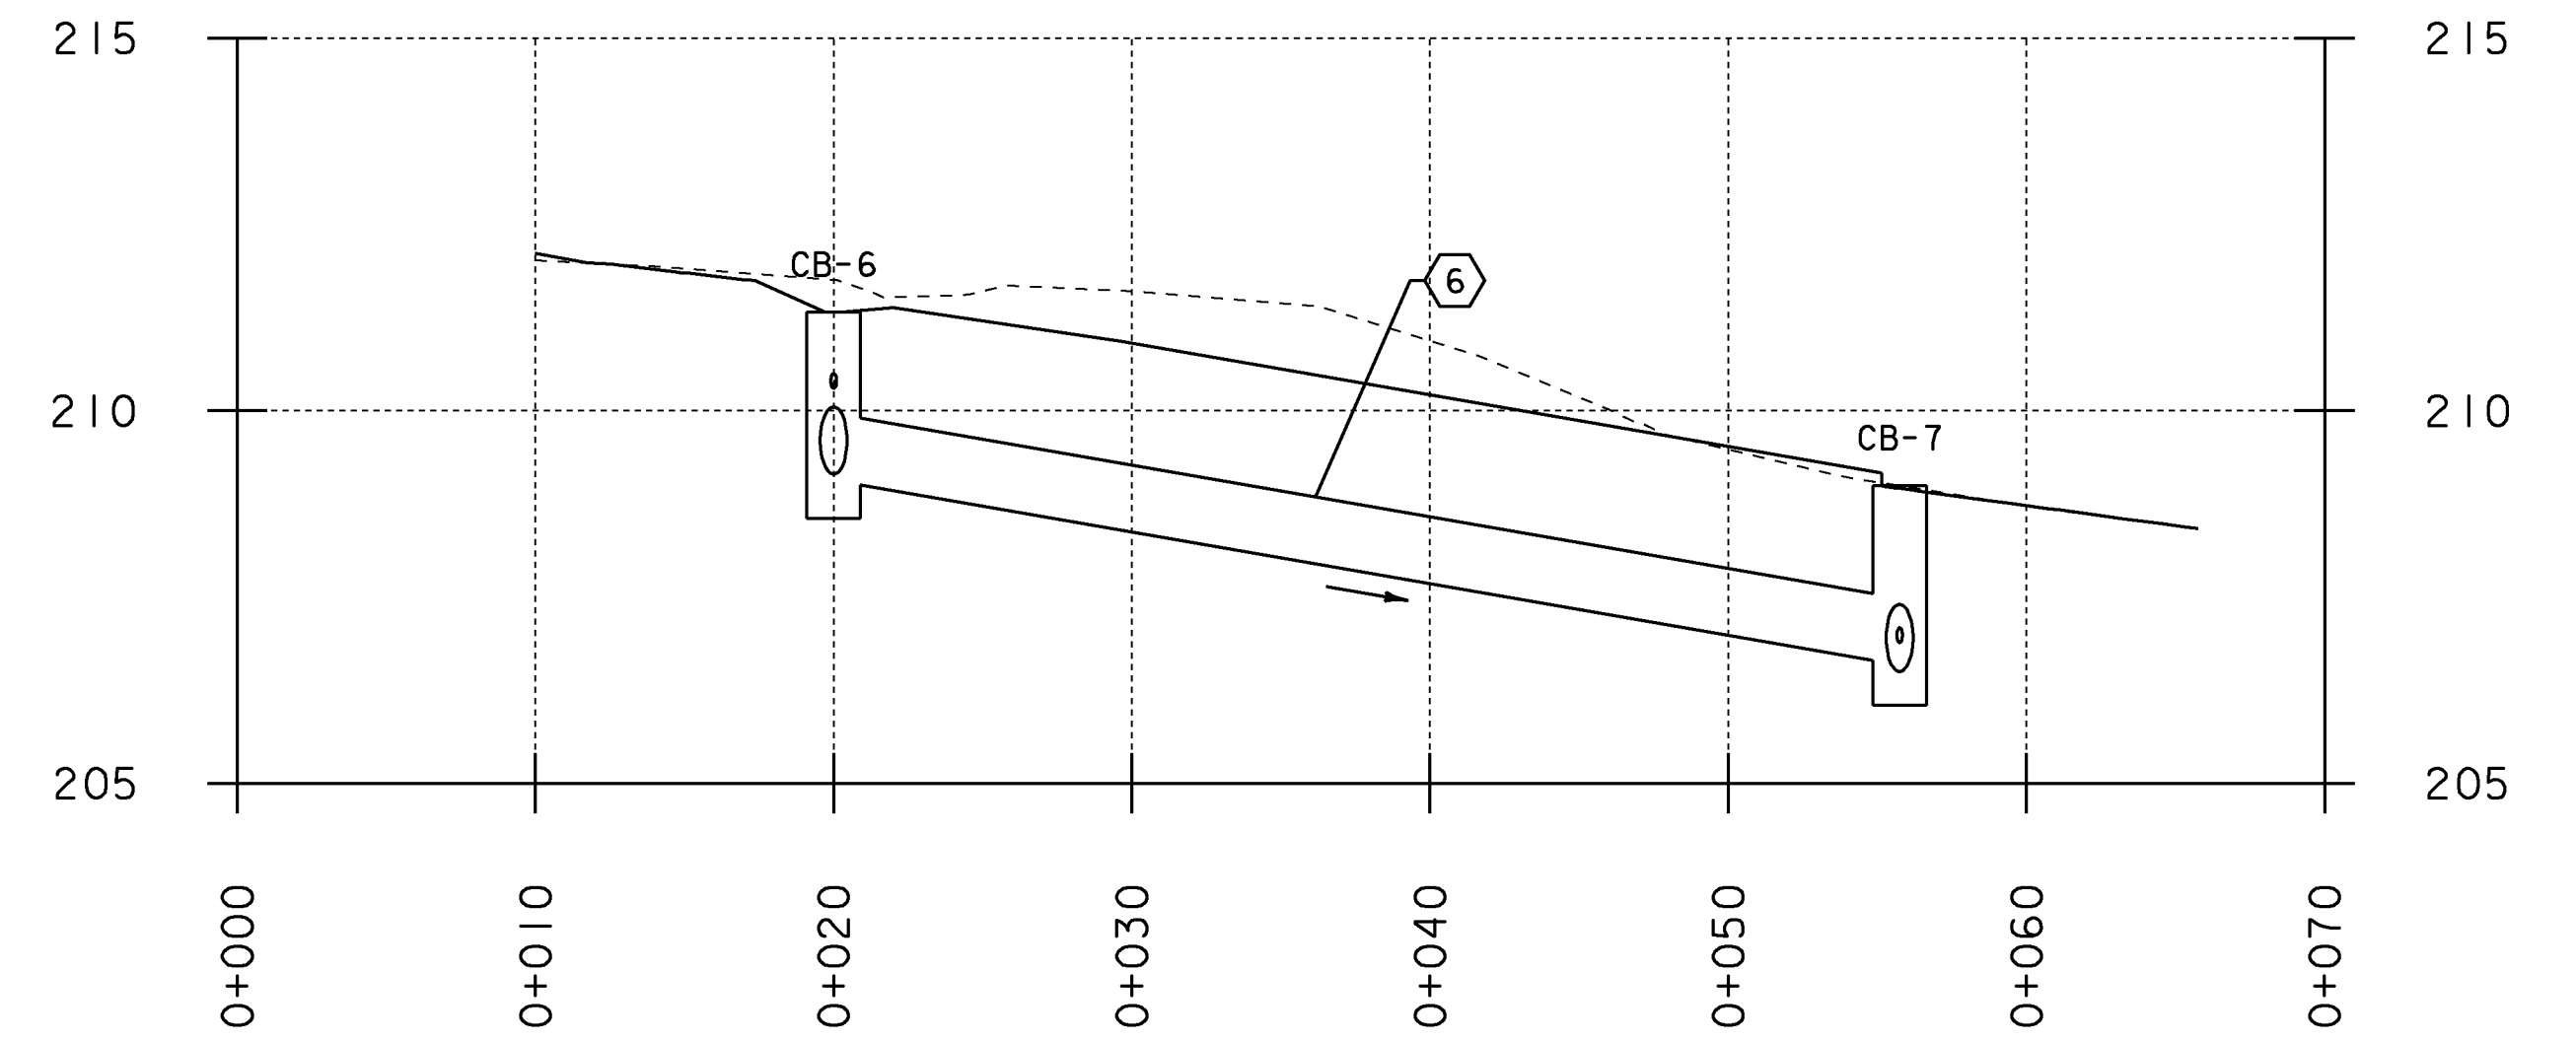

CB-6
 GRATE: TYPE D
 RIM EL = 211.32M
 DIAM. = 1800MM
 DEPTH = 2.77M

6
 SLOPE = 6.92%
 NEW PIPE
 TYPE: OPTION PIPE
 LENGTH = 35.83M
 DIAMETER = 900.00MM
 INV IN = 209.00M
 INV OUT = 206.65M


PIPE 7

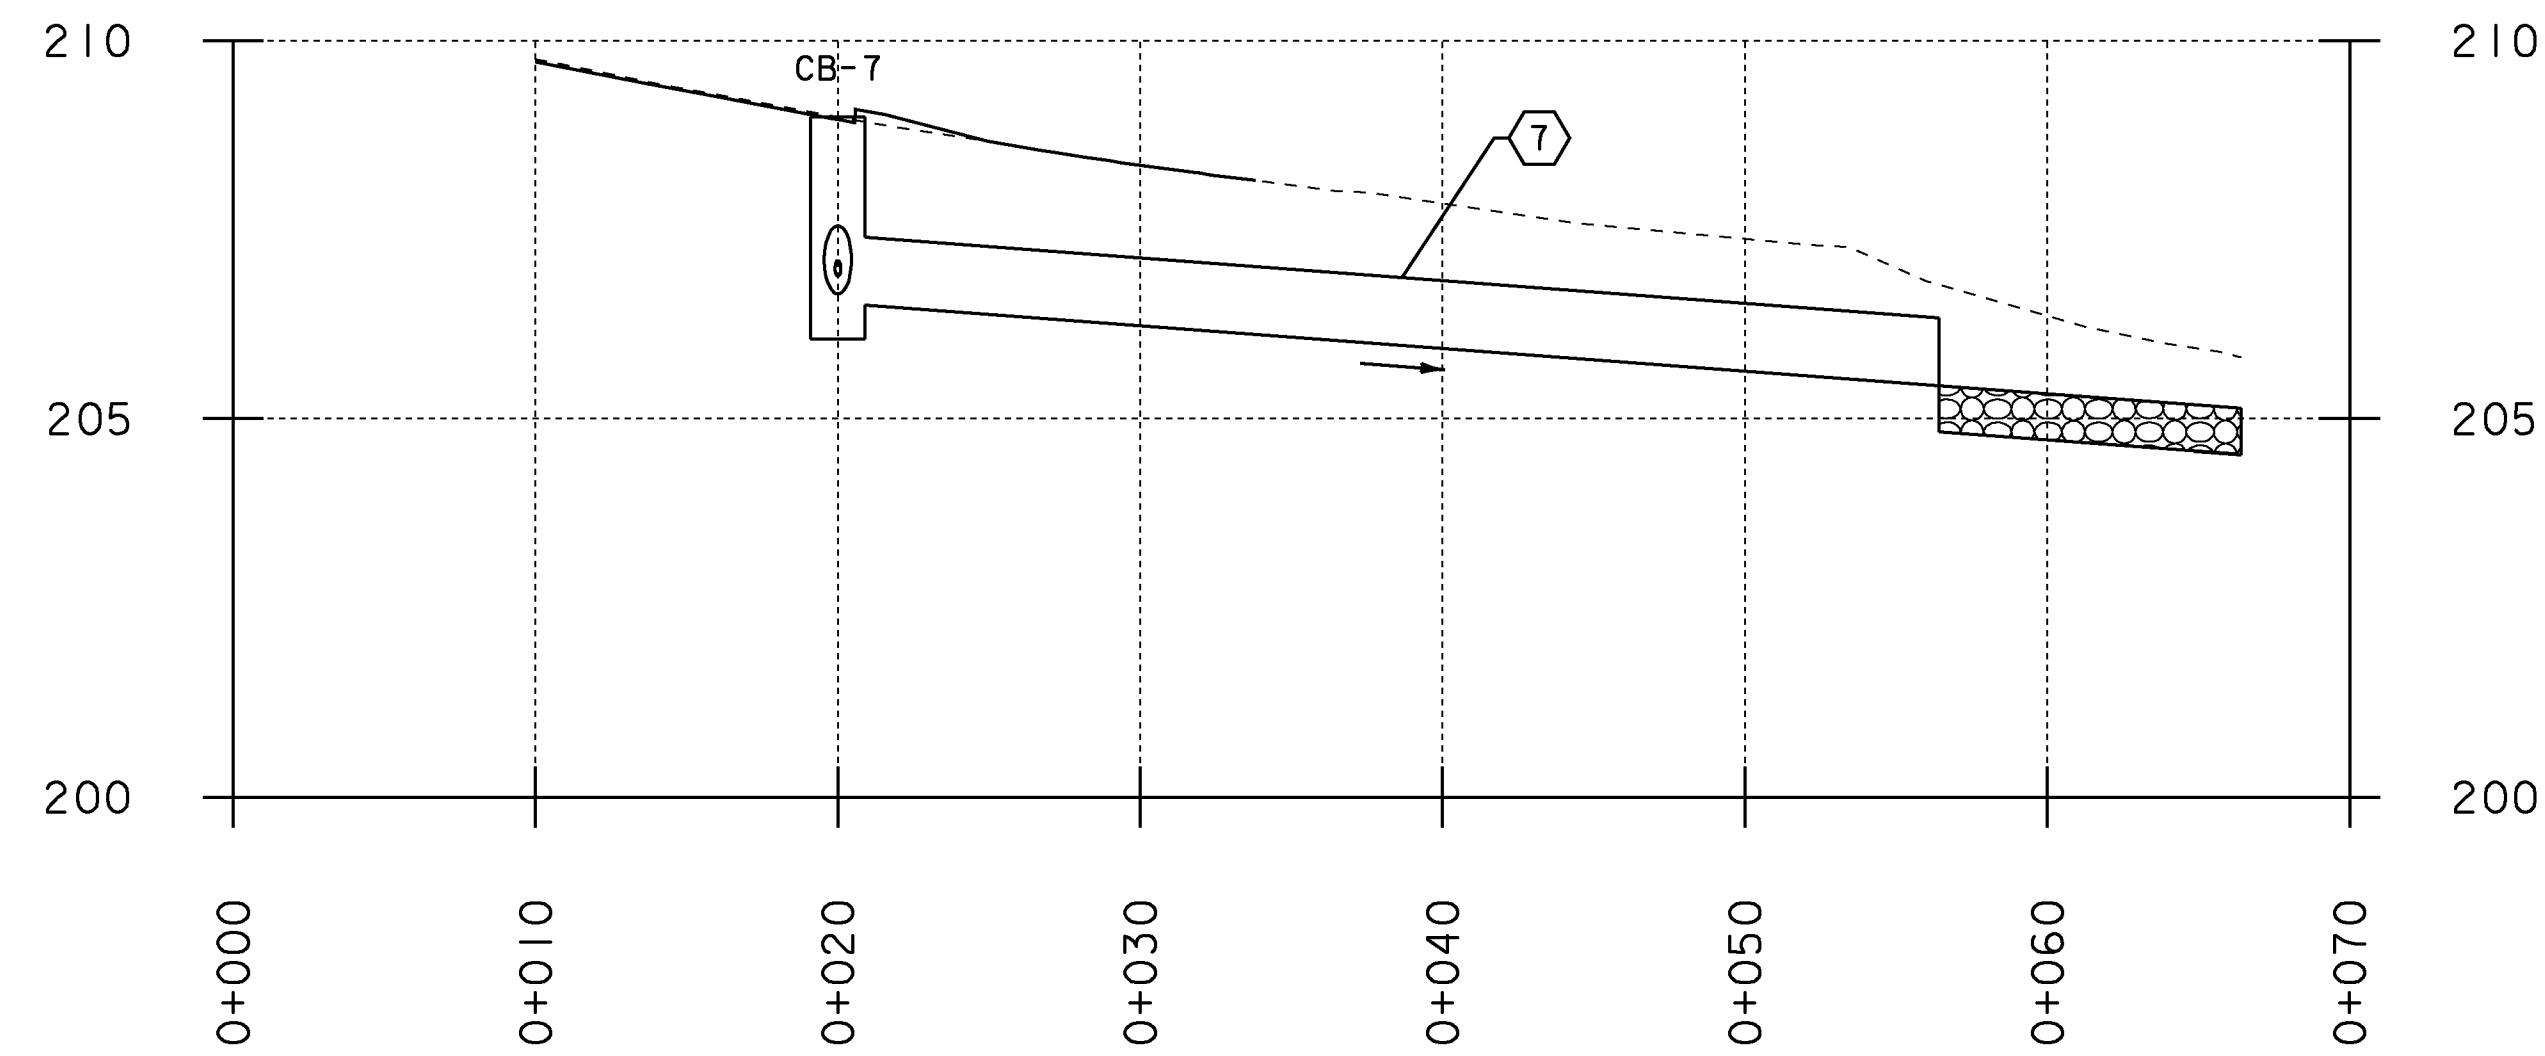


CB-7
 GRATE: TYPE D
 RIM EL = 208.99M
 DIAM. = 1800MM
 DEPTH = 2.94M

7
 SLOPE = 3.00%
 NEW PIPE
 TYPE: OPTION PIPE
 LENGTH = 36.43M
 DIAMETER = 900.00MM
 INV IN = 206.50M
 INV OUT = 205.43M

PIPE 9

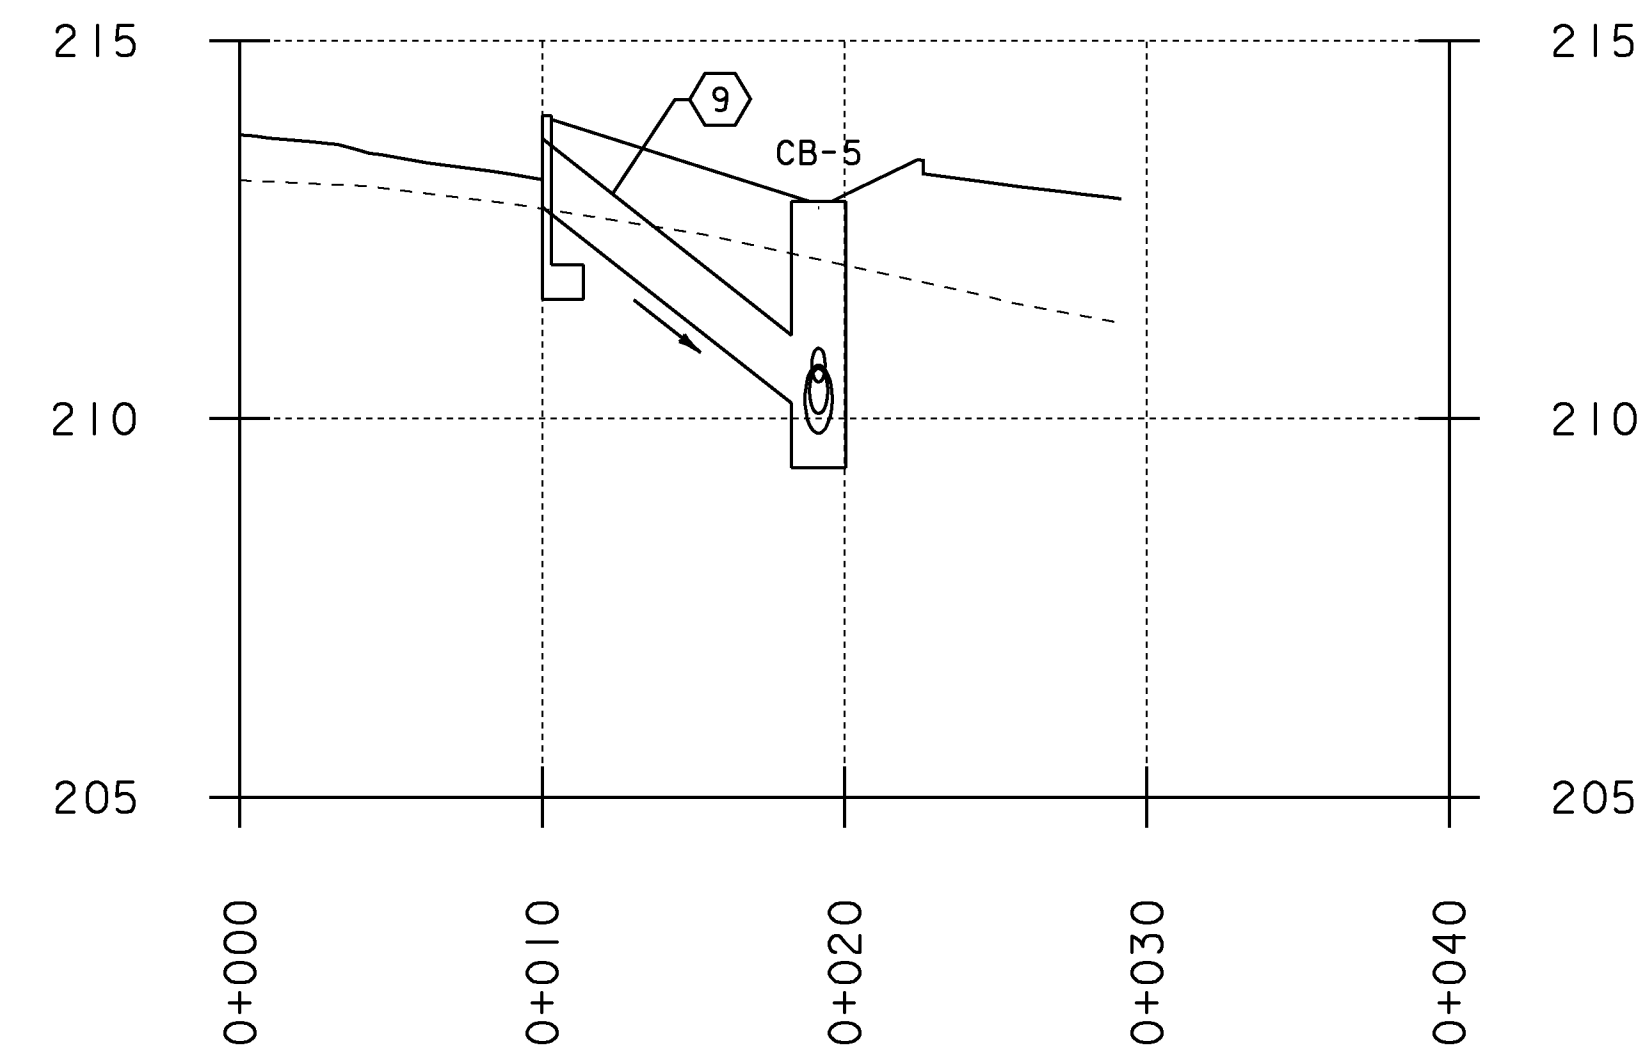


9
 SLOPE = 31.46%
 NEW PIPE
 TYPE: CPEP PIPE
 LENGTH = 9.14M
 DIAMETER = 900.00MM
 INV IN = 212.80M
 INV OUT = 210.21M

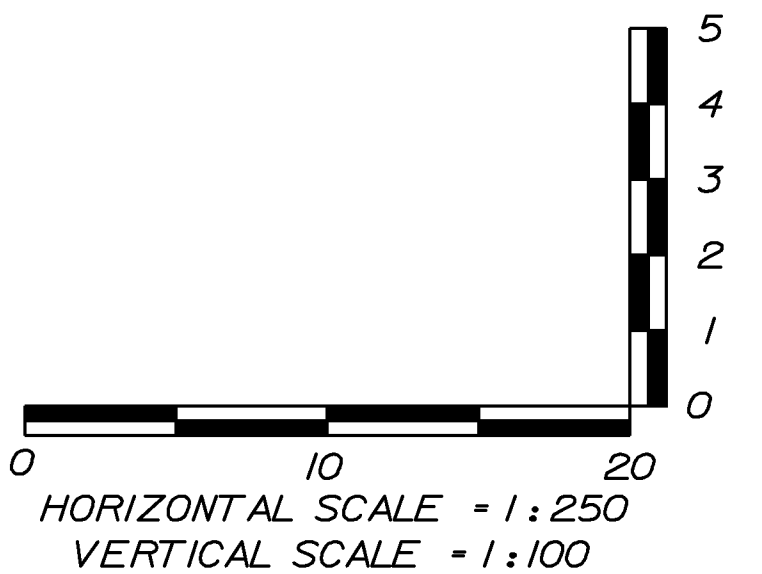

PROJECT NAME: EAST MONTPELIER	PLOT DATE: 22-MAR-2010
PROJECT NUMBER: STPG 028 - 3(35)S	DRAWN BY: D. LYMAN
FILE NAME: +98b028profile.dgn	CHECKED BY: J. DEVLIN
PROJECT LEADER: J.SCHULTZ	SHEET 43 OF 142
DESIGNED BY: J. GRUCHACZ	
DRAINAGE PROFILE SHEET 2	


PIPE 10

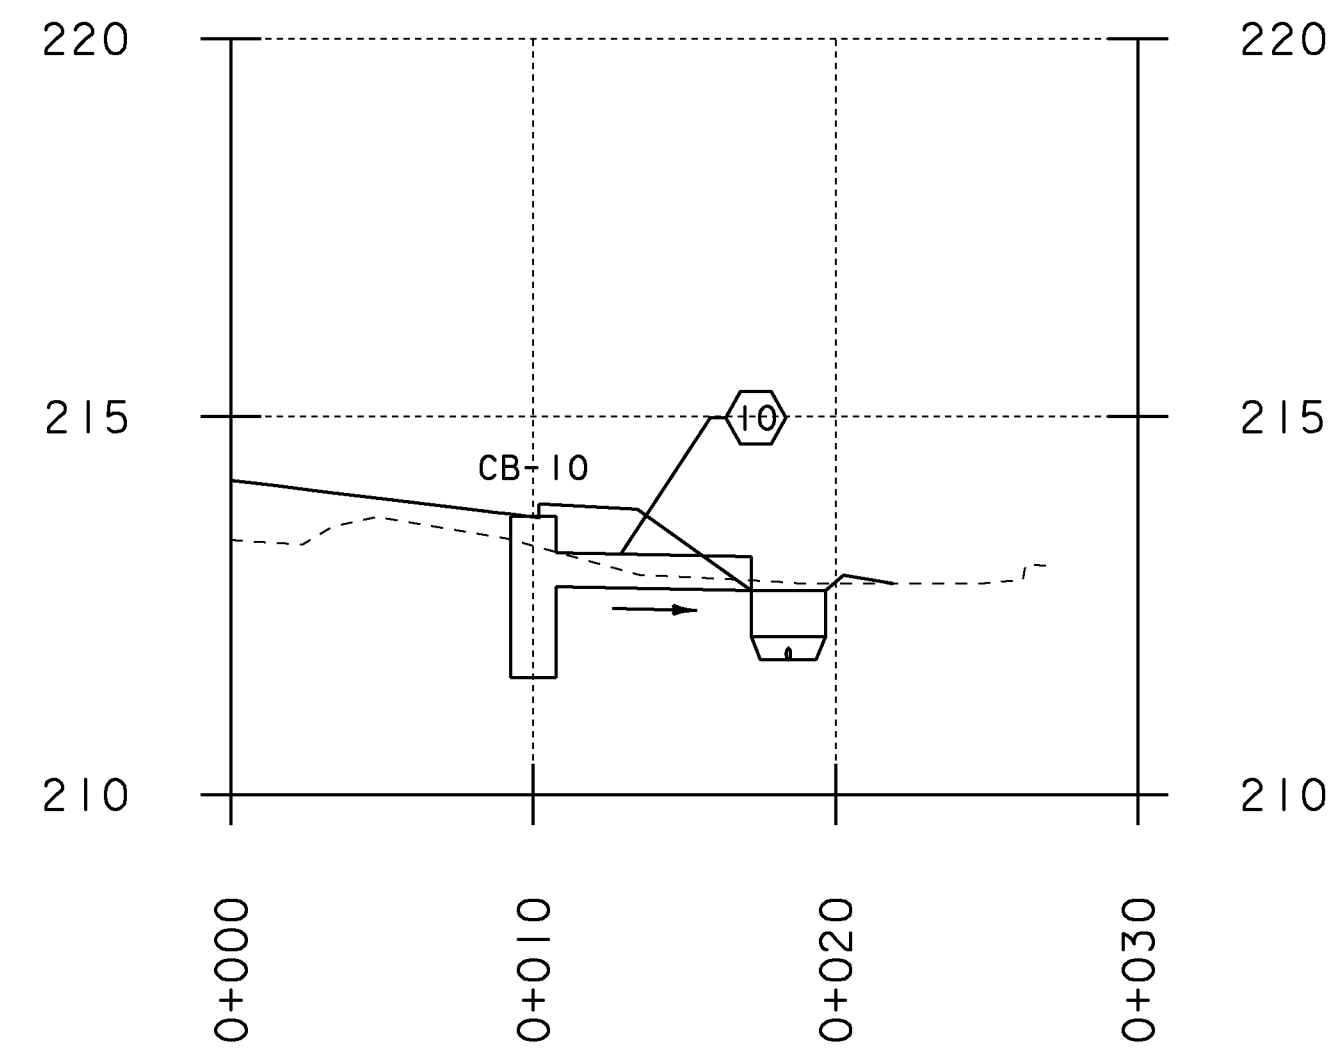

CB-10
 GRATE: TYPE D
 RIM EL = 213.68M
 DIAM. = 1500MM
 DEPTH = 2.13M

10
 SLOPE = 0.77%
 NEW PIPE
 TYPE: OPTION PIPE
 LENGTH = 7.21M
 DIAMETER = 450.00MM
 INV IN = 212.75M
 INV OUT = 212.70M


PIPE 11

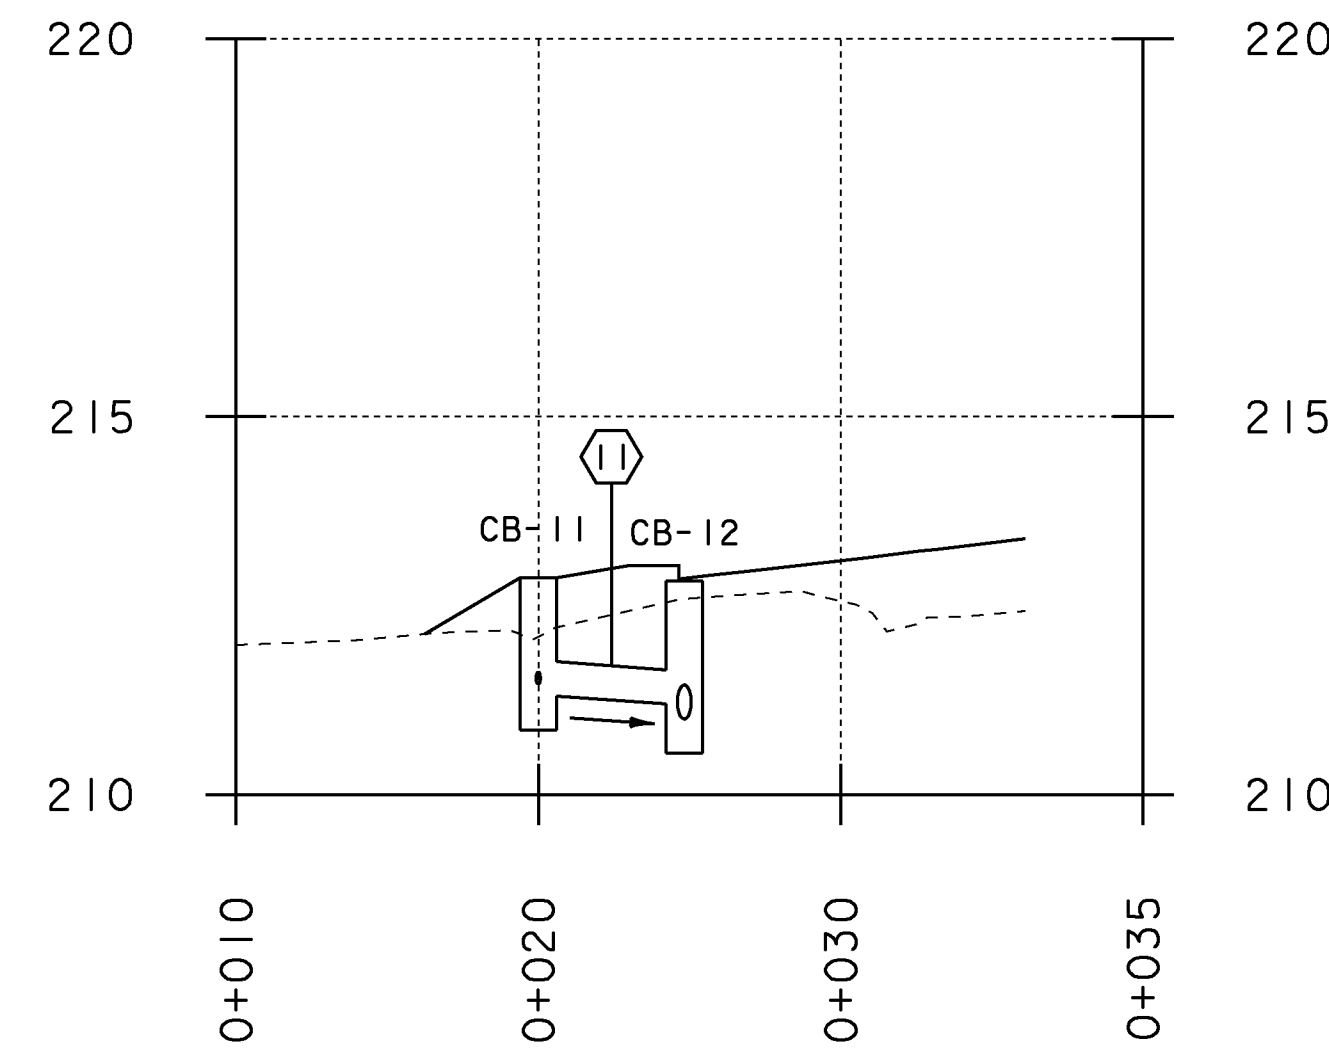

CB-11
 GRATE: TYPE D
 RIM EL = 212.87M
 DIAM. = 1200MM
 DEPTH = 2.02M

11
 SLOPE = 2.89%
 NEW PIPE
 TYPE: OPTION PIPE
 LENGTH = 4.83M
 DIAMETER = 450.00MM
 INV IN = 211.31M
 INV OUT = 211.20M


PIPE 12

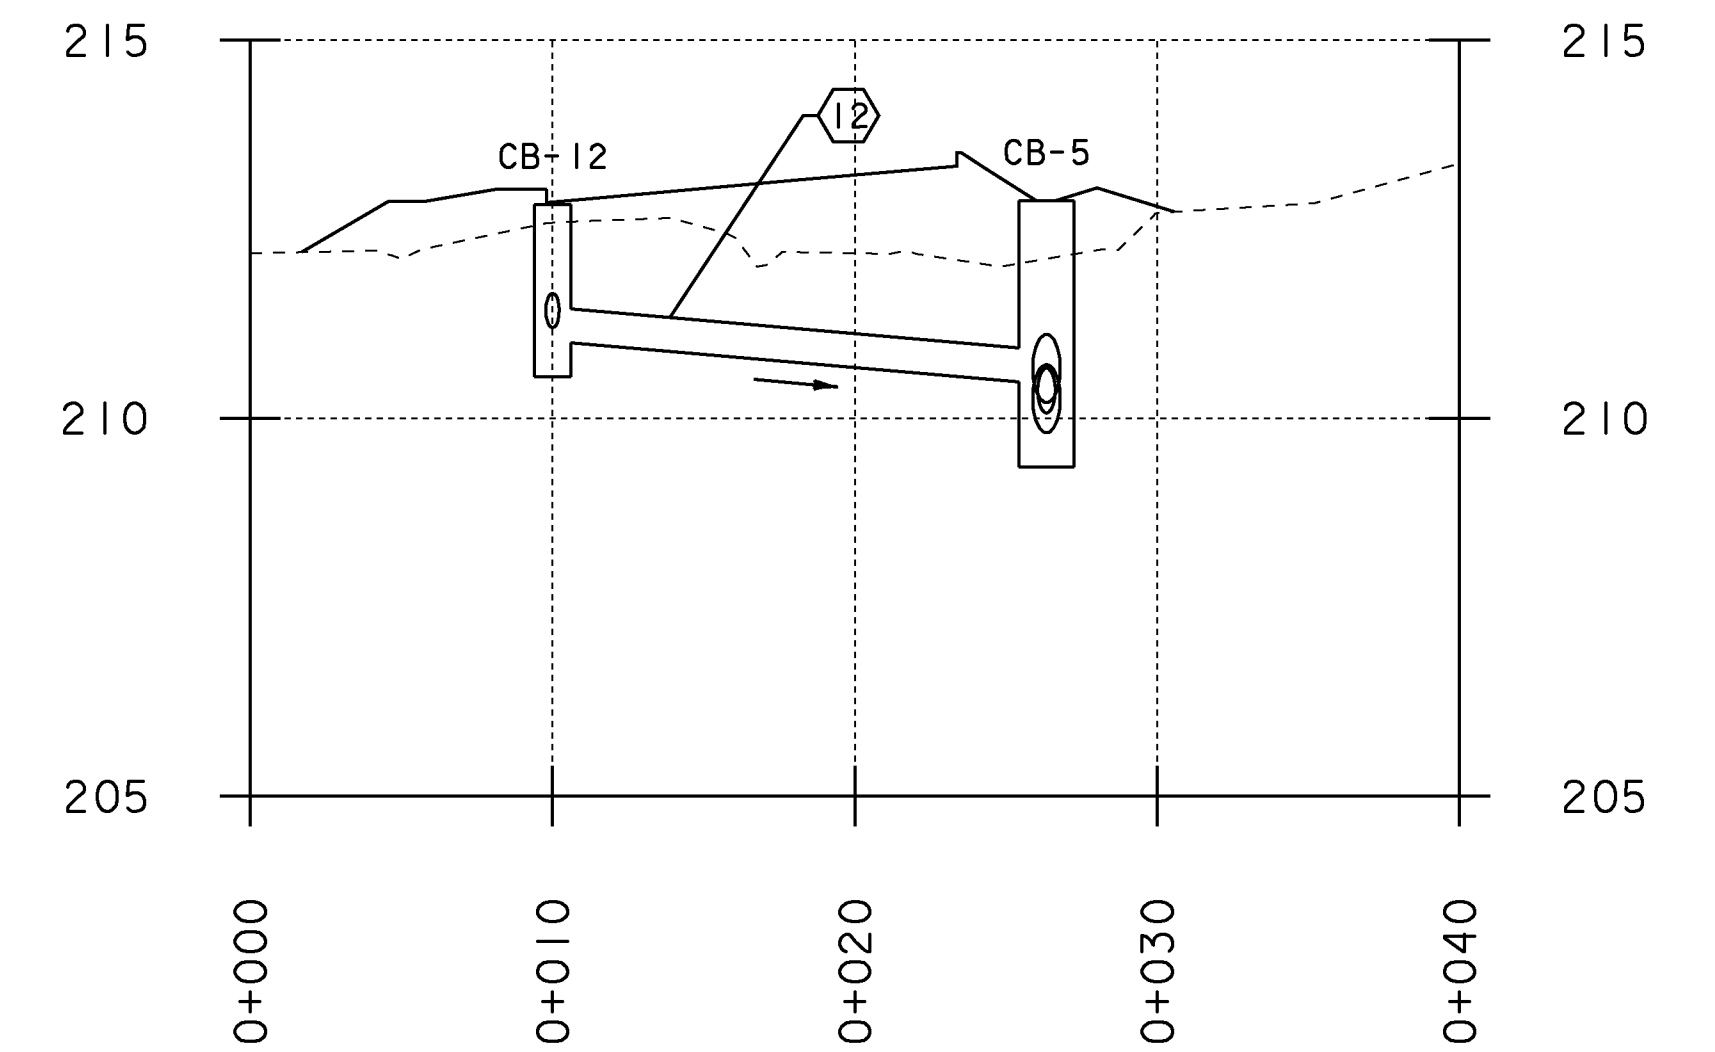

CB-12
 GRATE: TYPE D
 RIM EL = 212.82M
 DIAM. = 1200MM
 DEPTH = 2.27M

12
 SLOPE = 3.50%
 NEW PIPE
 TYPE: OPTION PIPE
 LENGTH = 16.35M
 DIAMETER = 450.00MM
 INV IN = 211.00M
 INV OUT = 210.48M


PIPE 13

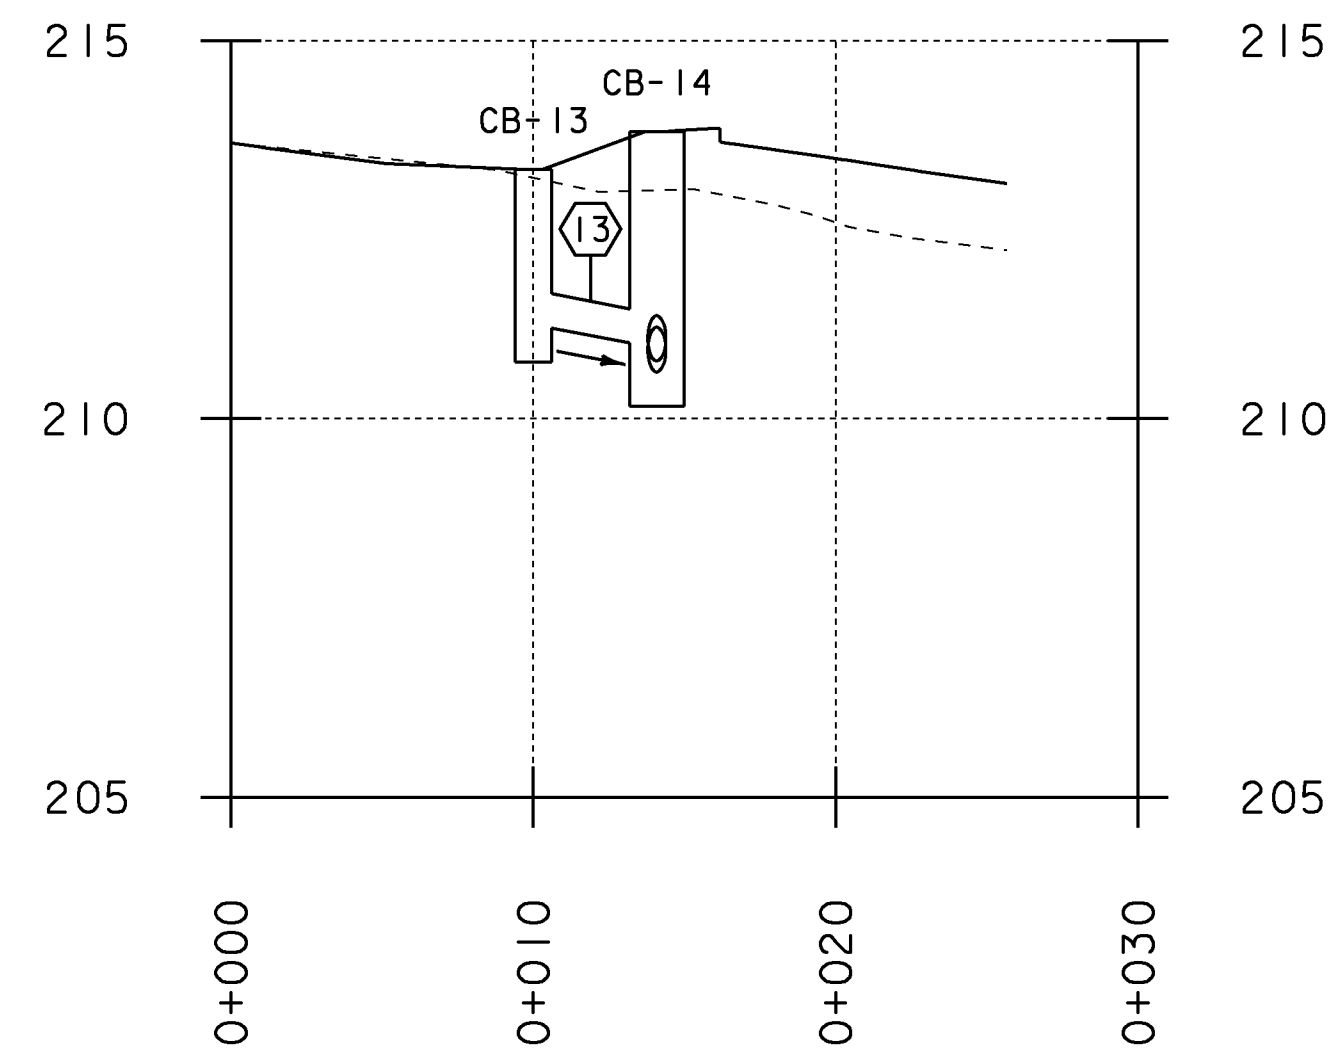

CB-13
 GRATE: TYPE D
 RIM EL = 213.30M
 DIAM. = 1200MM
 DEPTH = 2.55M

13
 SLOPE = 7.76%
 NEW PIPE
 TYPE: OPTION PIPE
 LENGTH = 4.09M
 DIAMETER = 450.00MM
 INV IN = 211.20M
 INV OUT = 211.00M


PIPE 14

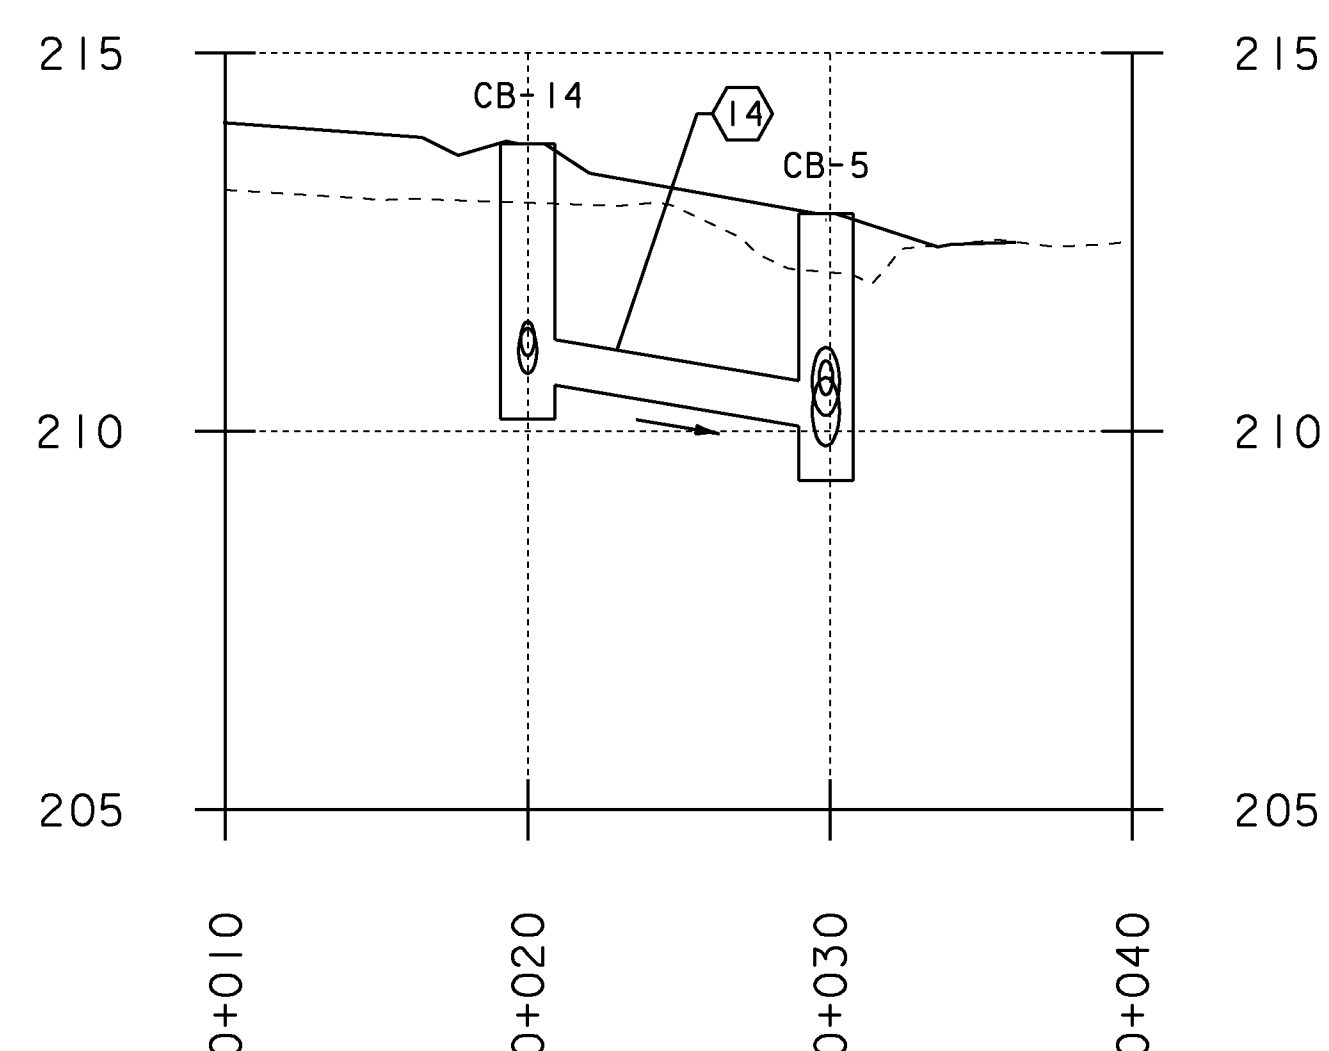

CB-14
 GRATE: TYPE D
 RIM EL = 213.80M
 DIAM. = 1800MM
 DEPTH = 3.64M


14
 SLOPE = 6.76%
 NEW PIPE
 TYPE: OPTION PIPE
 LENGTH = 9.88M
 DIAMETER = 600.00MM
 INV IN = 210.61M
 INV OUT = 210.07M

PIPE 15

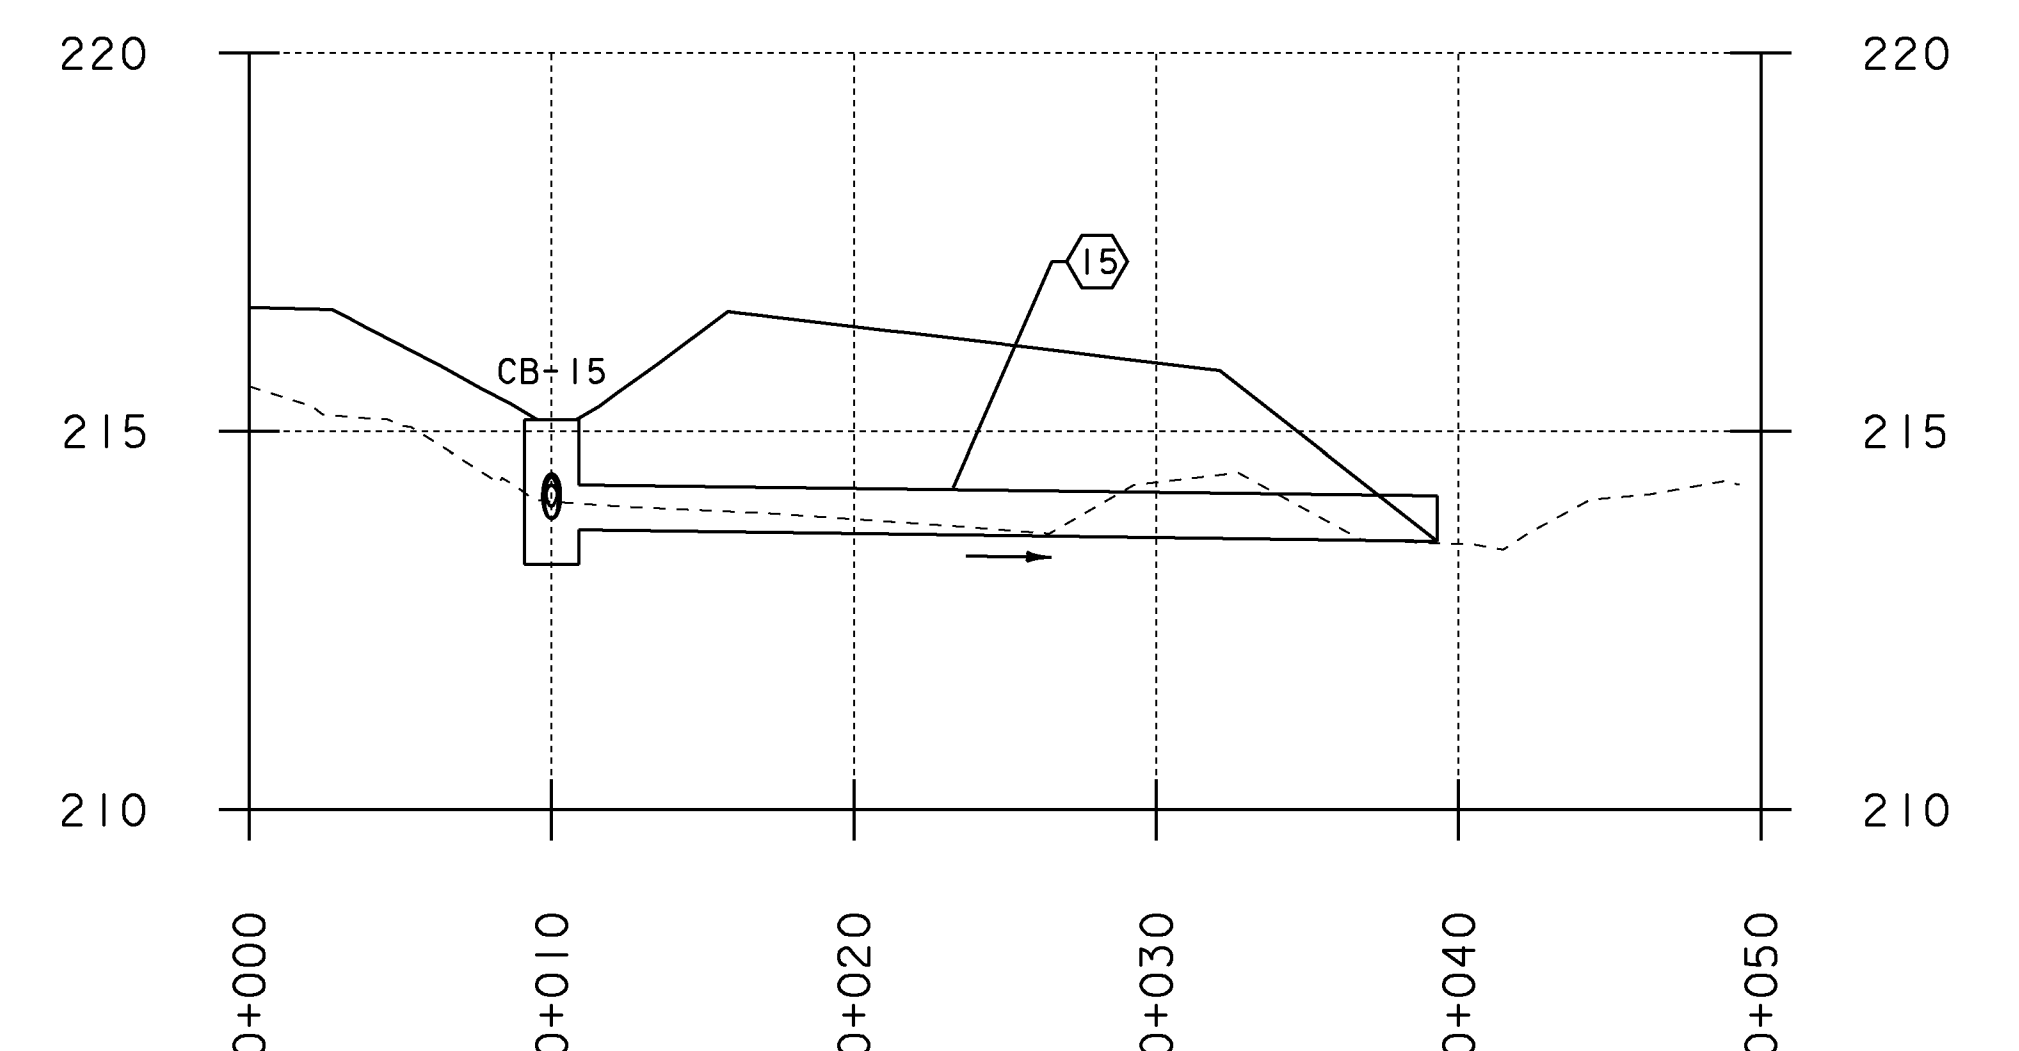

CB-15
 GRATE: TYPE D
 RIM EL = 215.15M
 DIAM. = 1800MM
 DEPTH = 1.90M

15
 SLOPE = 0.53%
 NEW PIPE
 TYPE: OPTION PIPE
 LENGTH = 29.29M
 DIAMETER = 600.00MM
 INV IN = 213.70M
 INV OUT = 213.55M

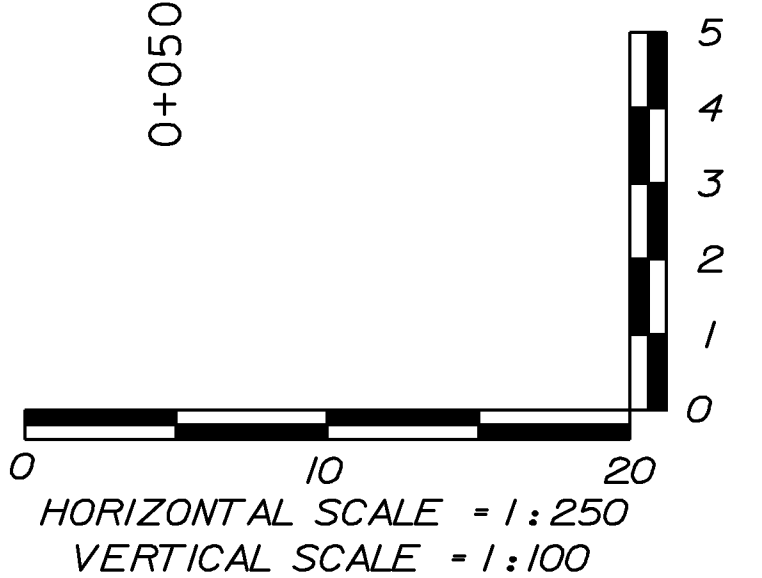



PROJECT NAME: EAST MONTPELIER
 PROJECT NUMBER: STPG 028 - 3(35)S

FILE NAME: +98b028profile.dgn
 PROJECT LEADER: J.SCHULTZ
 DESIGNED BY: J. GRUCHACZ
 DRAINAGE PROFILE SHEET 3


PLOT DATE: 22-MAR-2010
 DRAWN BY: D. LYMAN
 CHECKED BY: J. DEVLIN
 SHEET 44 OF 142


PIPE 16

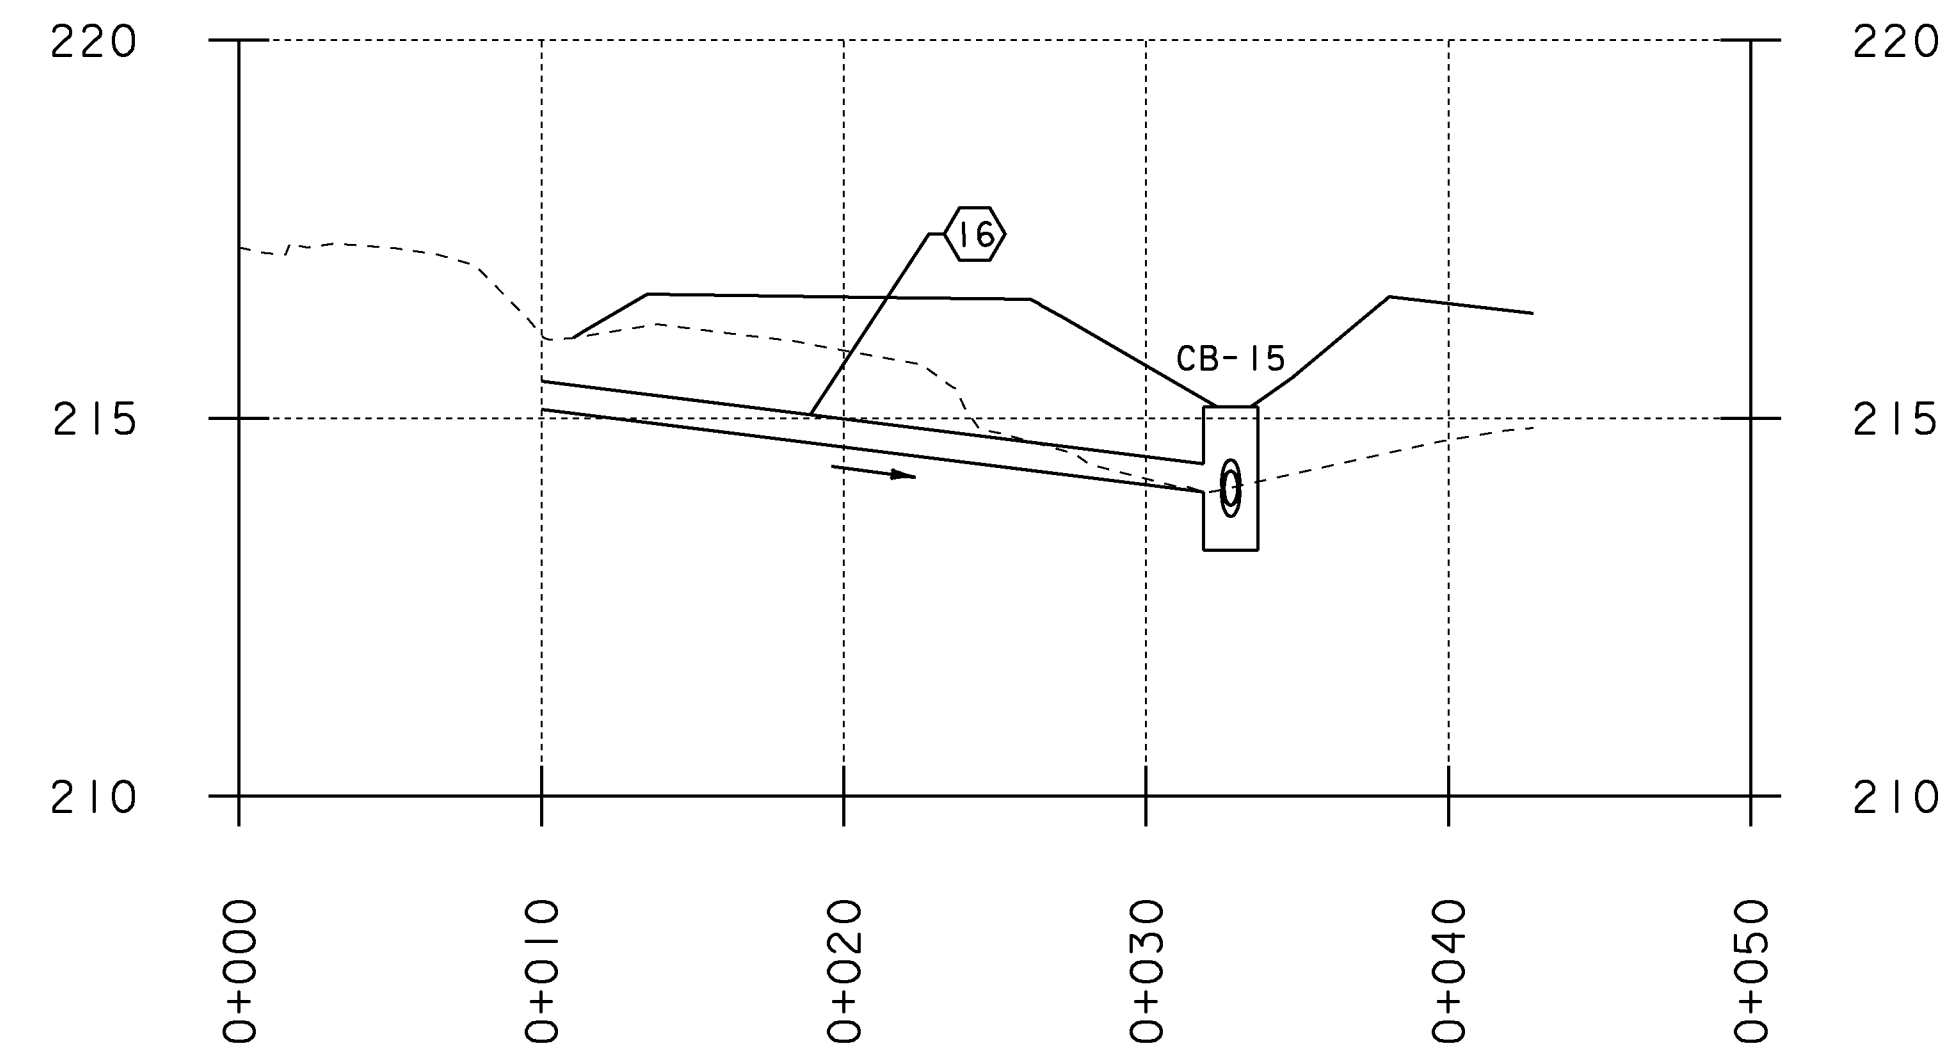

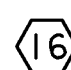

 SLOPE = 5.00%
 NEW PIPE
 TYPE: OPTION PIPE
 LENGTH = 22.83M
 DIAMETER = 375.00MM
 INV IN = 215.12M
 INV OUT = 214.02M


PIPE 17

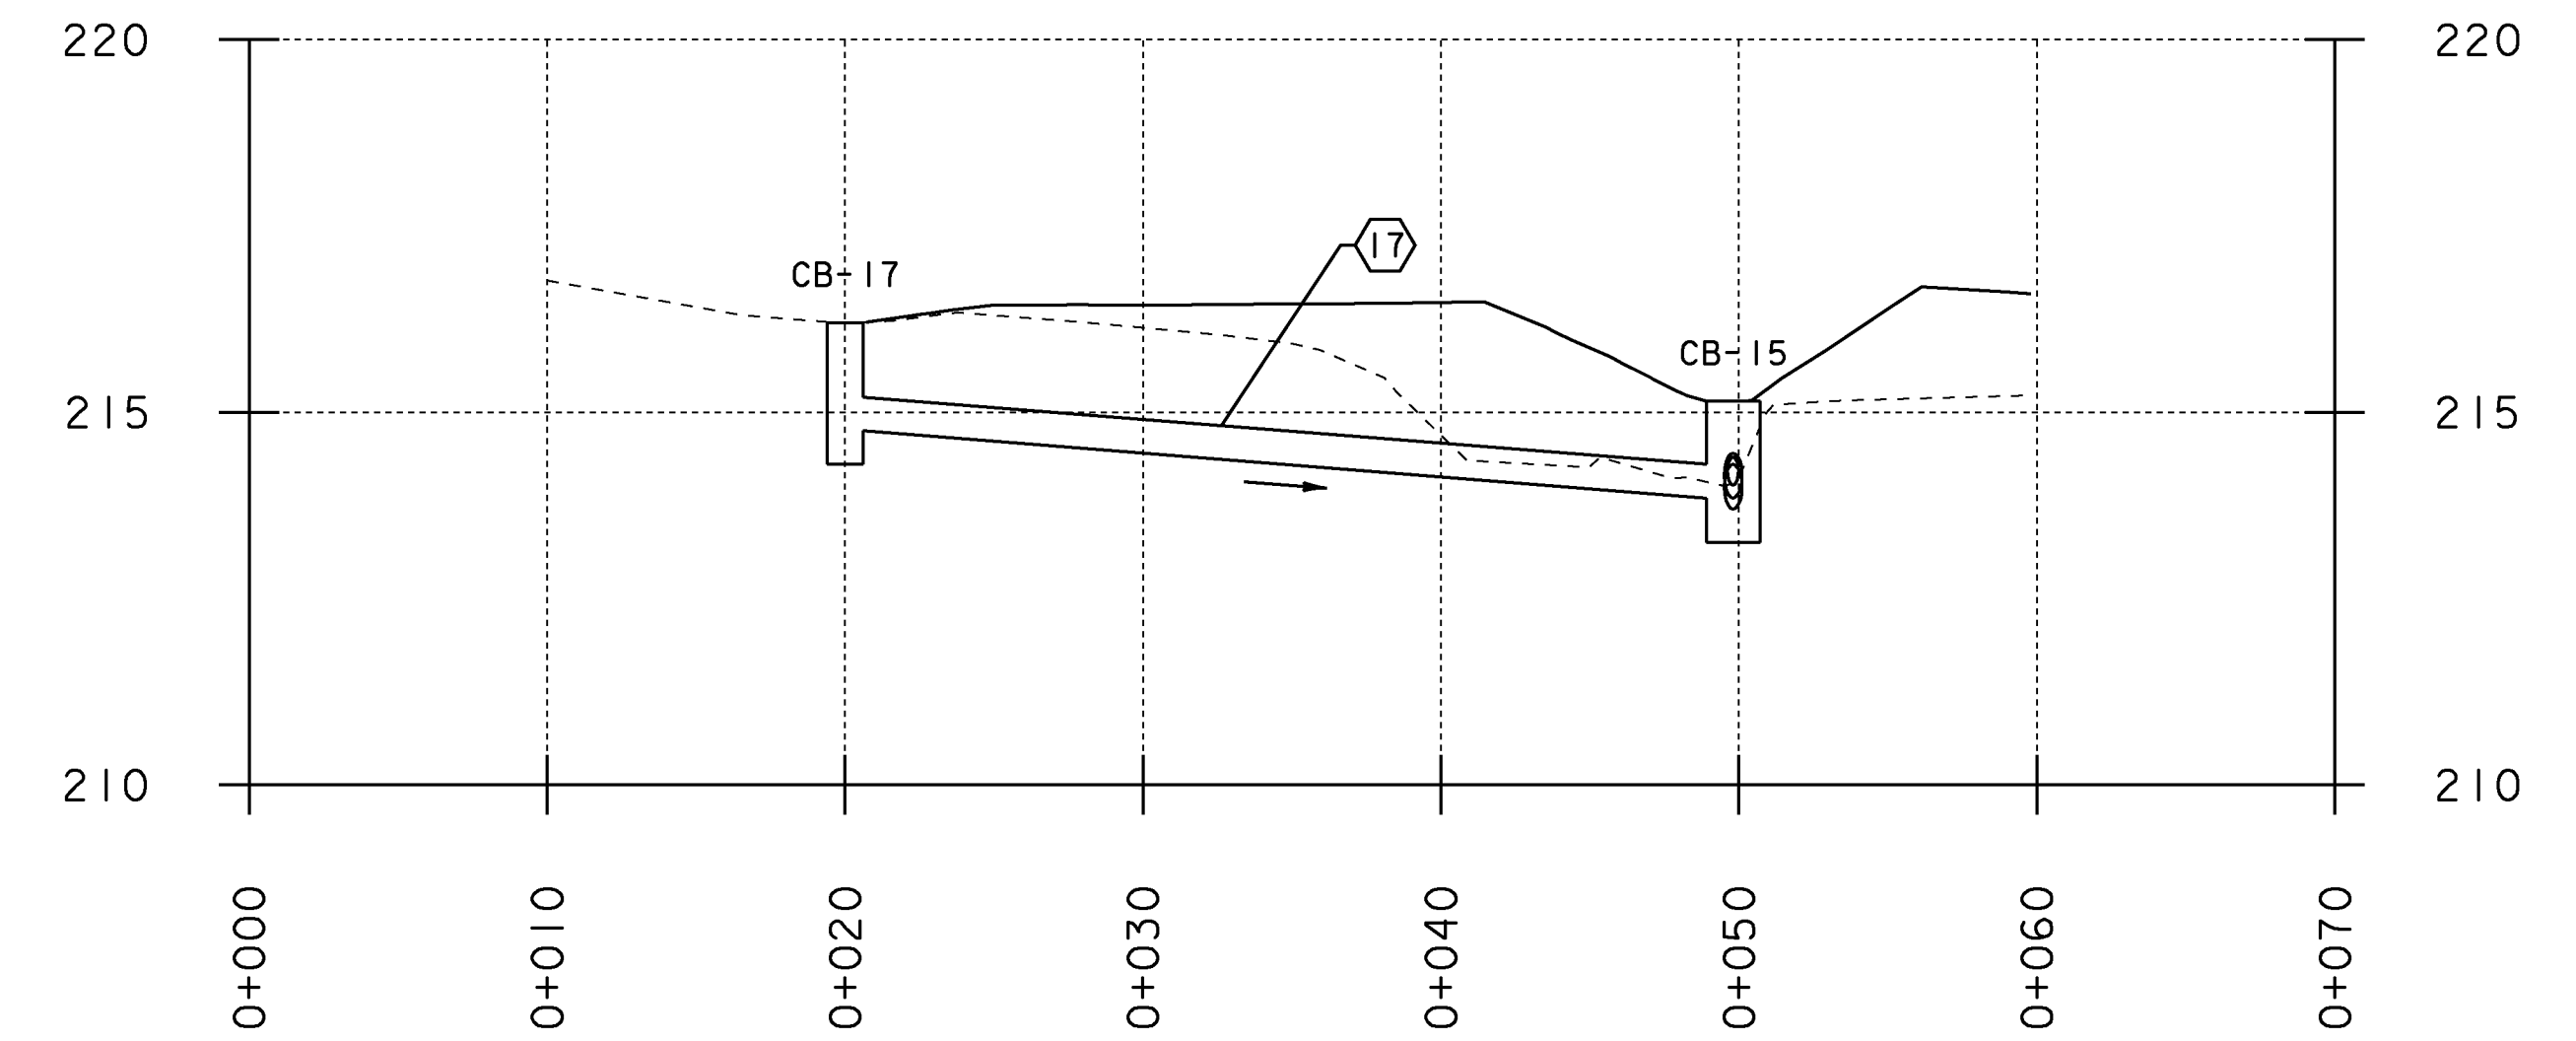

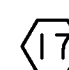
CB-17
 GRATE: TYPE D
 RIM EL = 216.20M
 DIAM. = 1200MM
 DEPTH = 1.90M

 SLOPE = 3.18%
 NEW PIPE
 TYPE: OPTION PIPE
 LENGTH = 29.82M
 DIAMETER = 450.00MM
 INV IN = 214.75M
 INV OUT = 213.85M

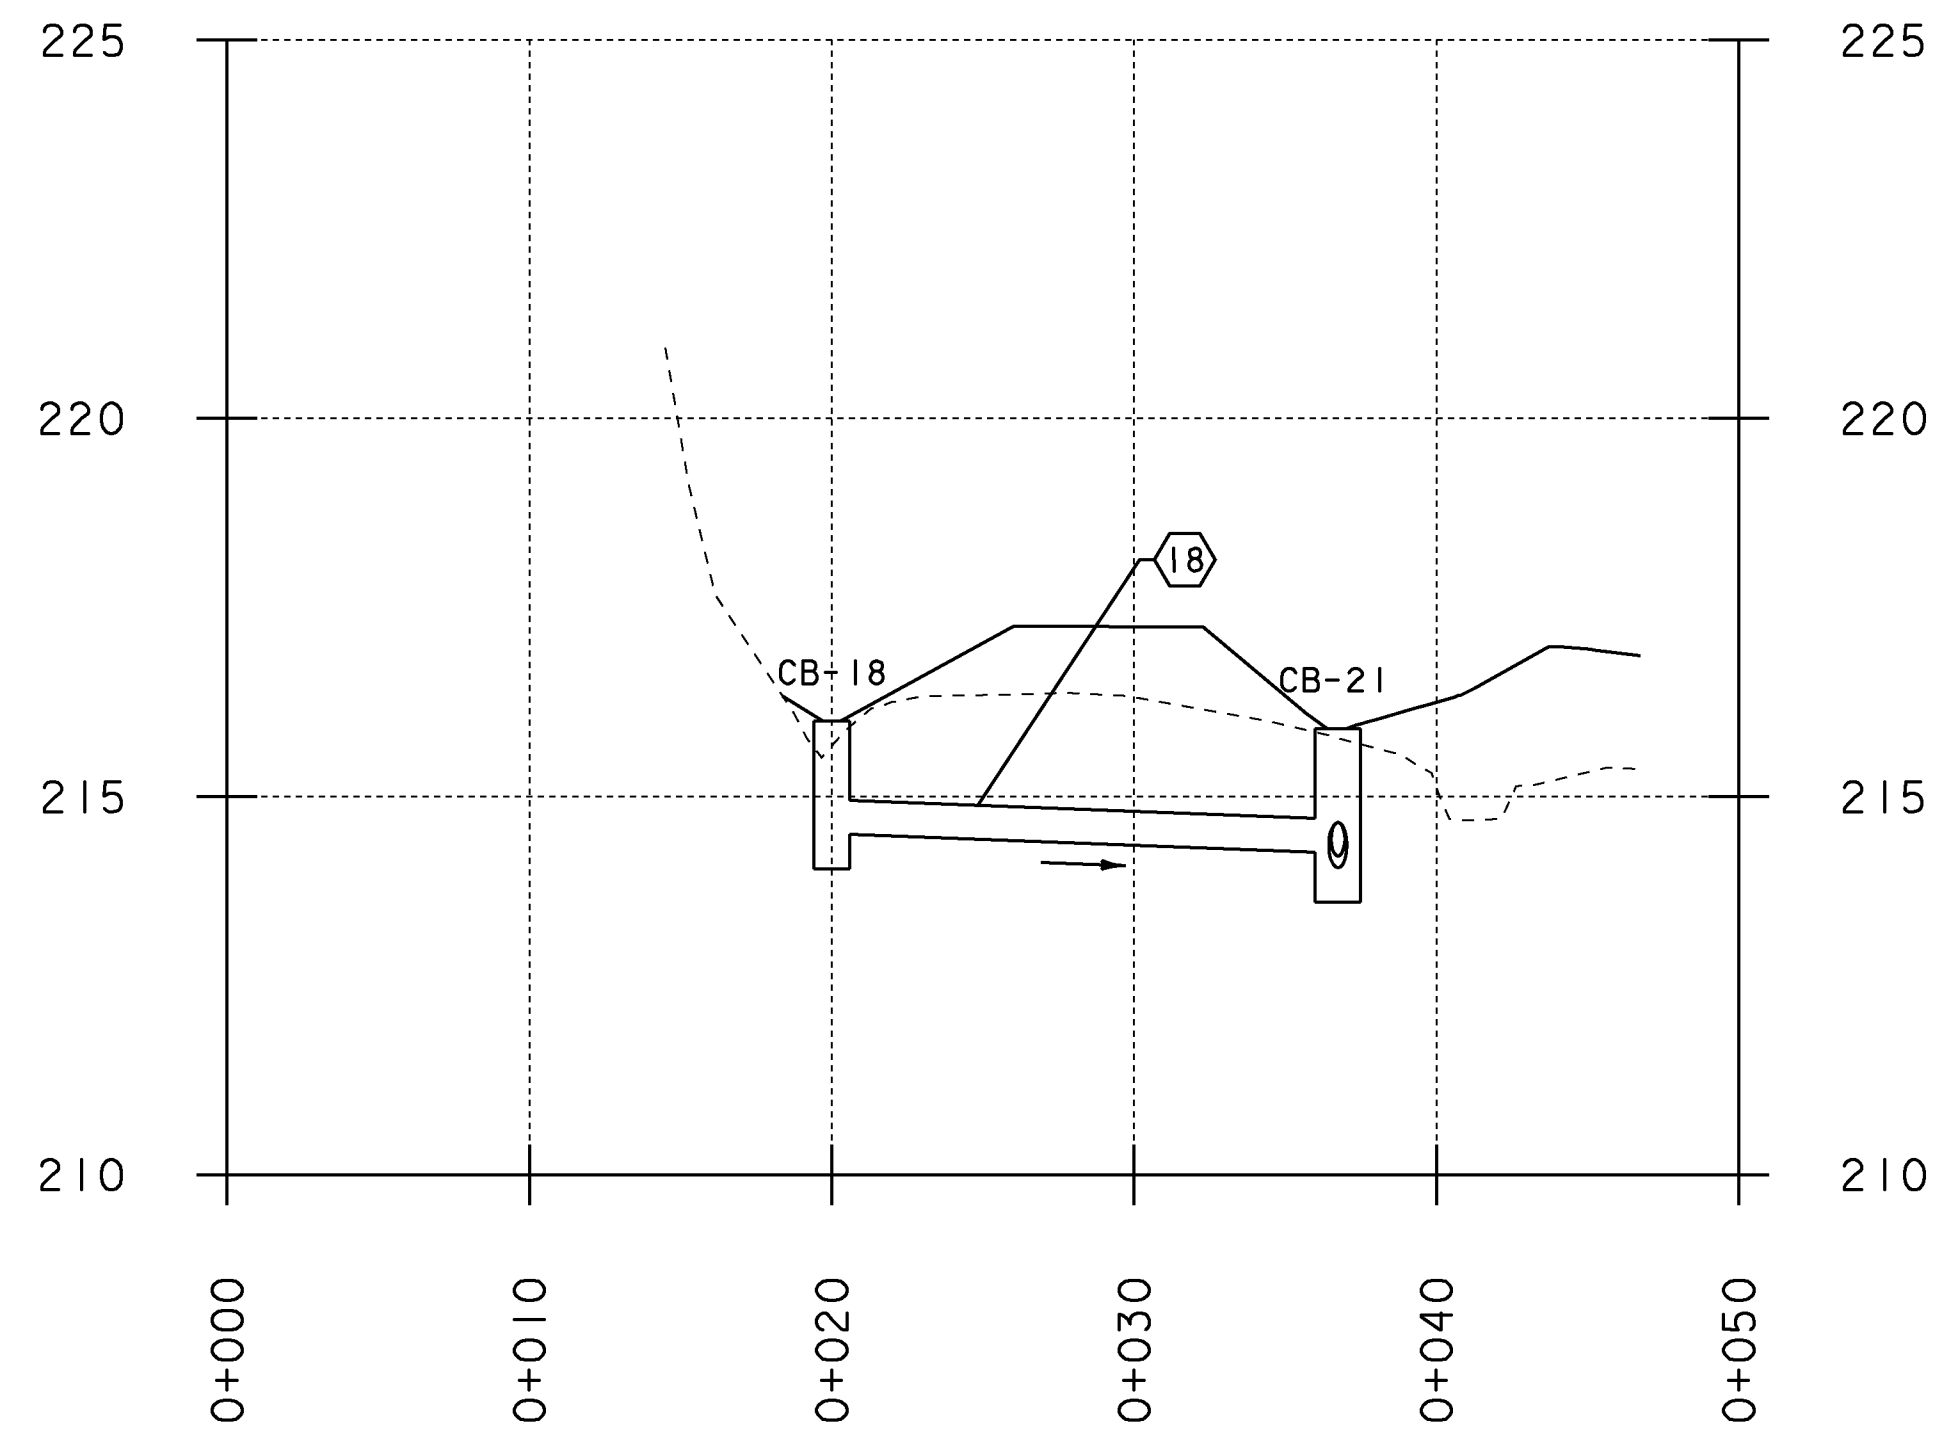
PIPE 18




CB-18
 GRATE: TYPE D
 RIM EL = 216.00M
 DIAM. = 1200MM
 DEPTH = 1.95M

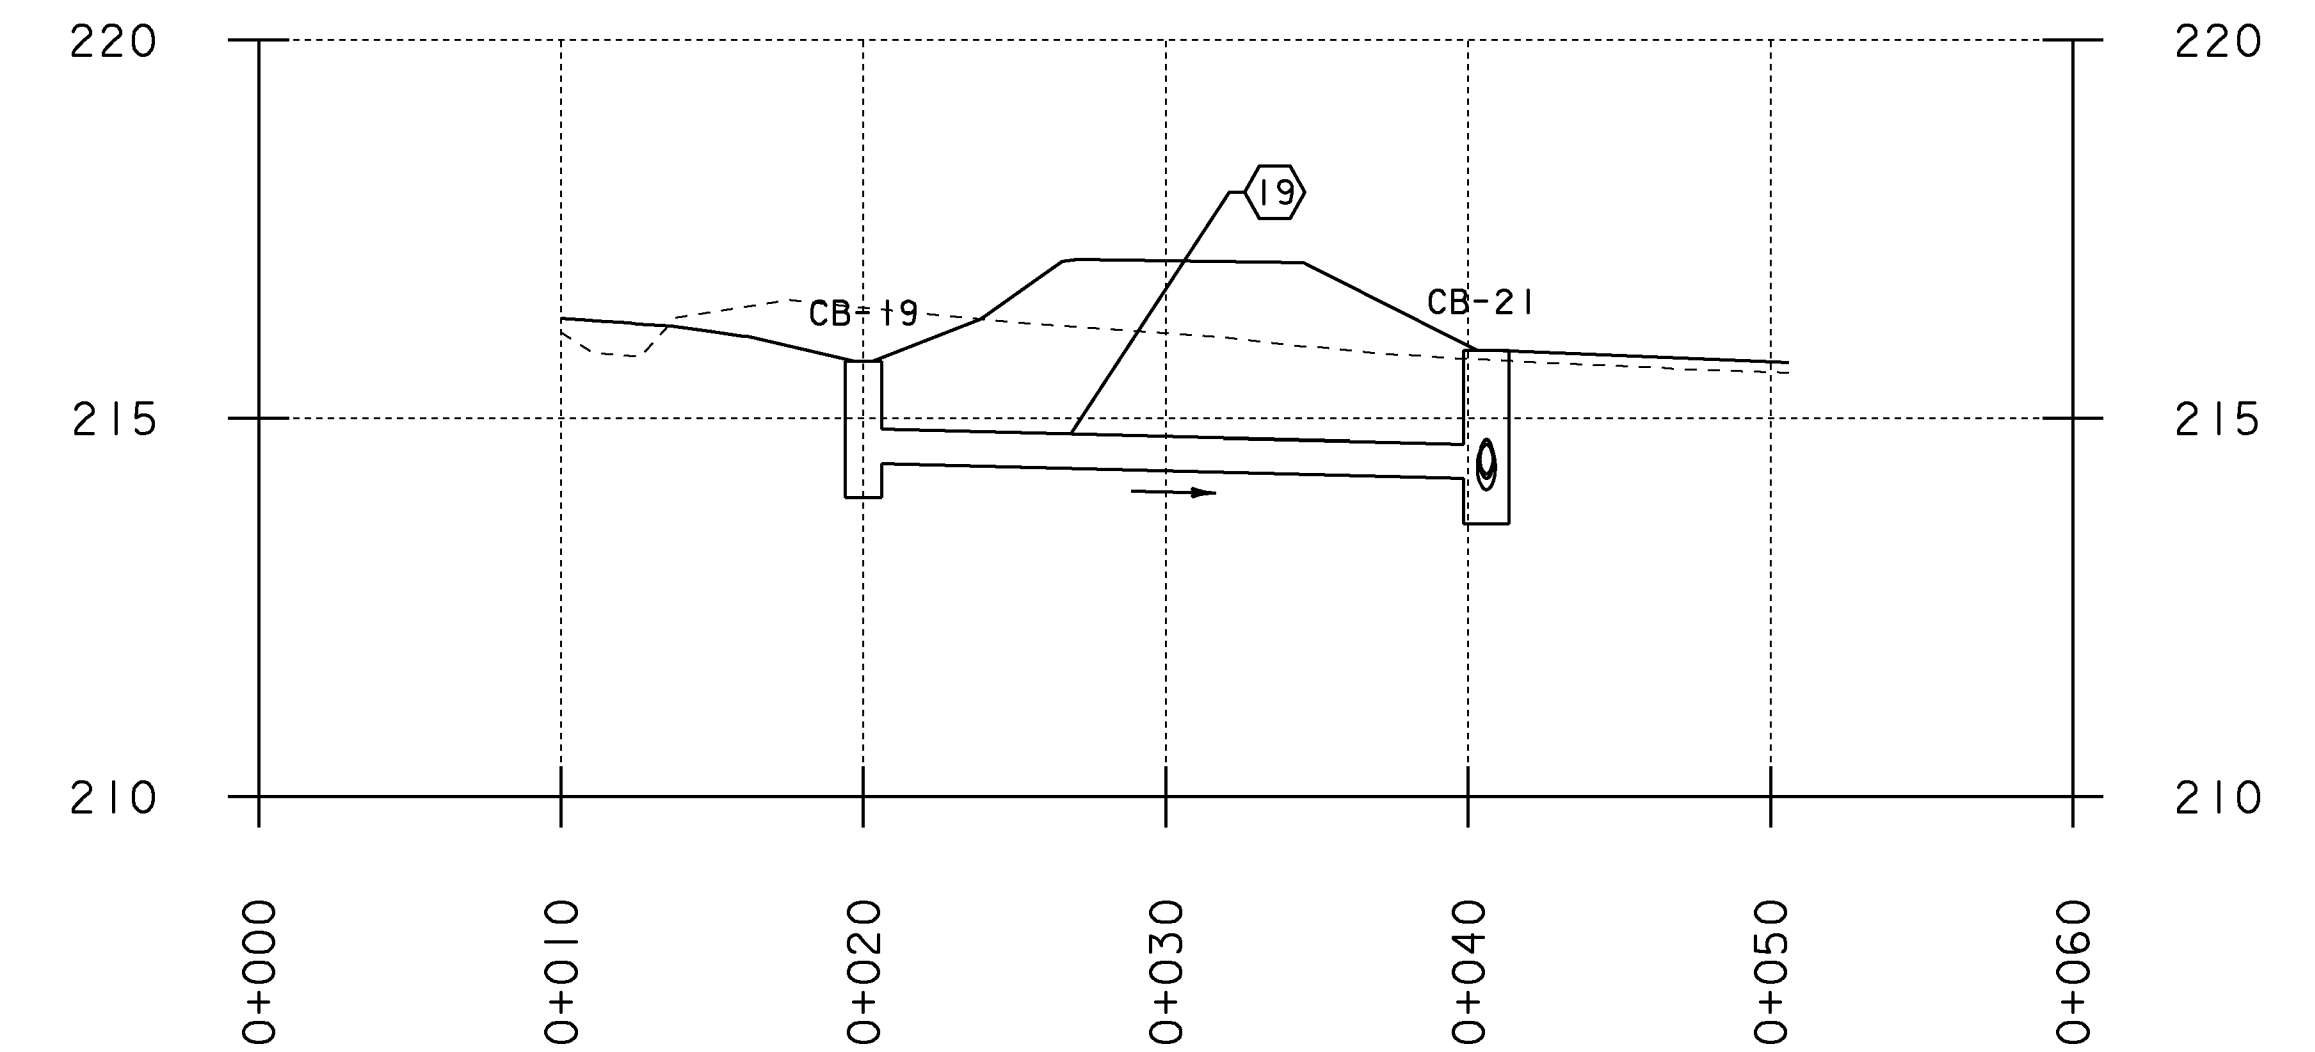 SLOPE = 1.50%
 NEW PIPE
 TYPE: OPTION PIPE
 LENGTH = 16.75M
 DIAMETER = 450.00MM
 INV IN = 214.50M
 INV OUT = 214.27M

PIPE 19

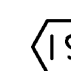

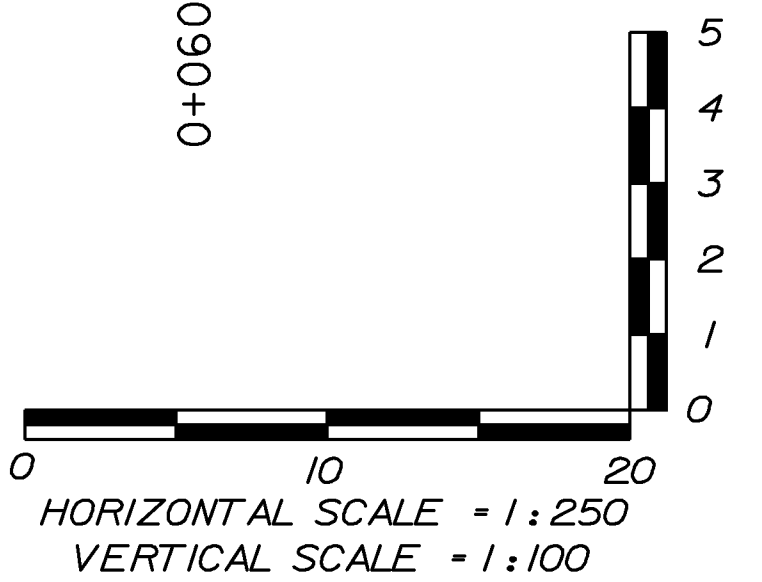
CB-19
 GRATE: TYPE D
 RIM EL = 215.75M
 DIAM. = 1200MM
 DEPTH = 1.79M

 SLOPE = 1.00%
 NEW PIPE
 TYPE: OPTION PIPE
 LENGTH = 20.61M
 DIAMETER = 450.00MM
 INV IN = 214.40M
 INV OUT = 214.21M



PROJECT NAME: EAST MONTPELIER
 PROJECT NUMBER: STPG 028 - 3(35)S

FILE NAME: +98b028profile.dgn
 PROJECT LEADER: J.SCHULTZ
 DESIGNED BY: J. GRUCHACZ
 DRAINAGE PROFILE SHEET 4
 PLOT DATE: 22-MAR-2010
 DRAWN BY: D. LYMAN
 CHECKED BY: J. DEVLIN
 SHEET 45 OF 142

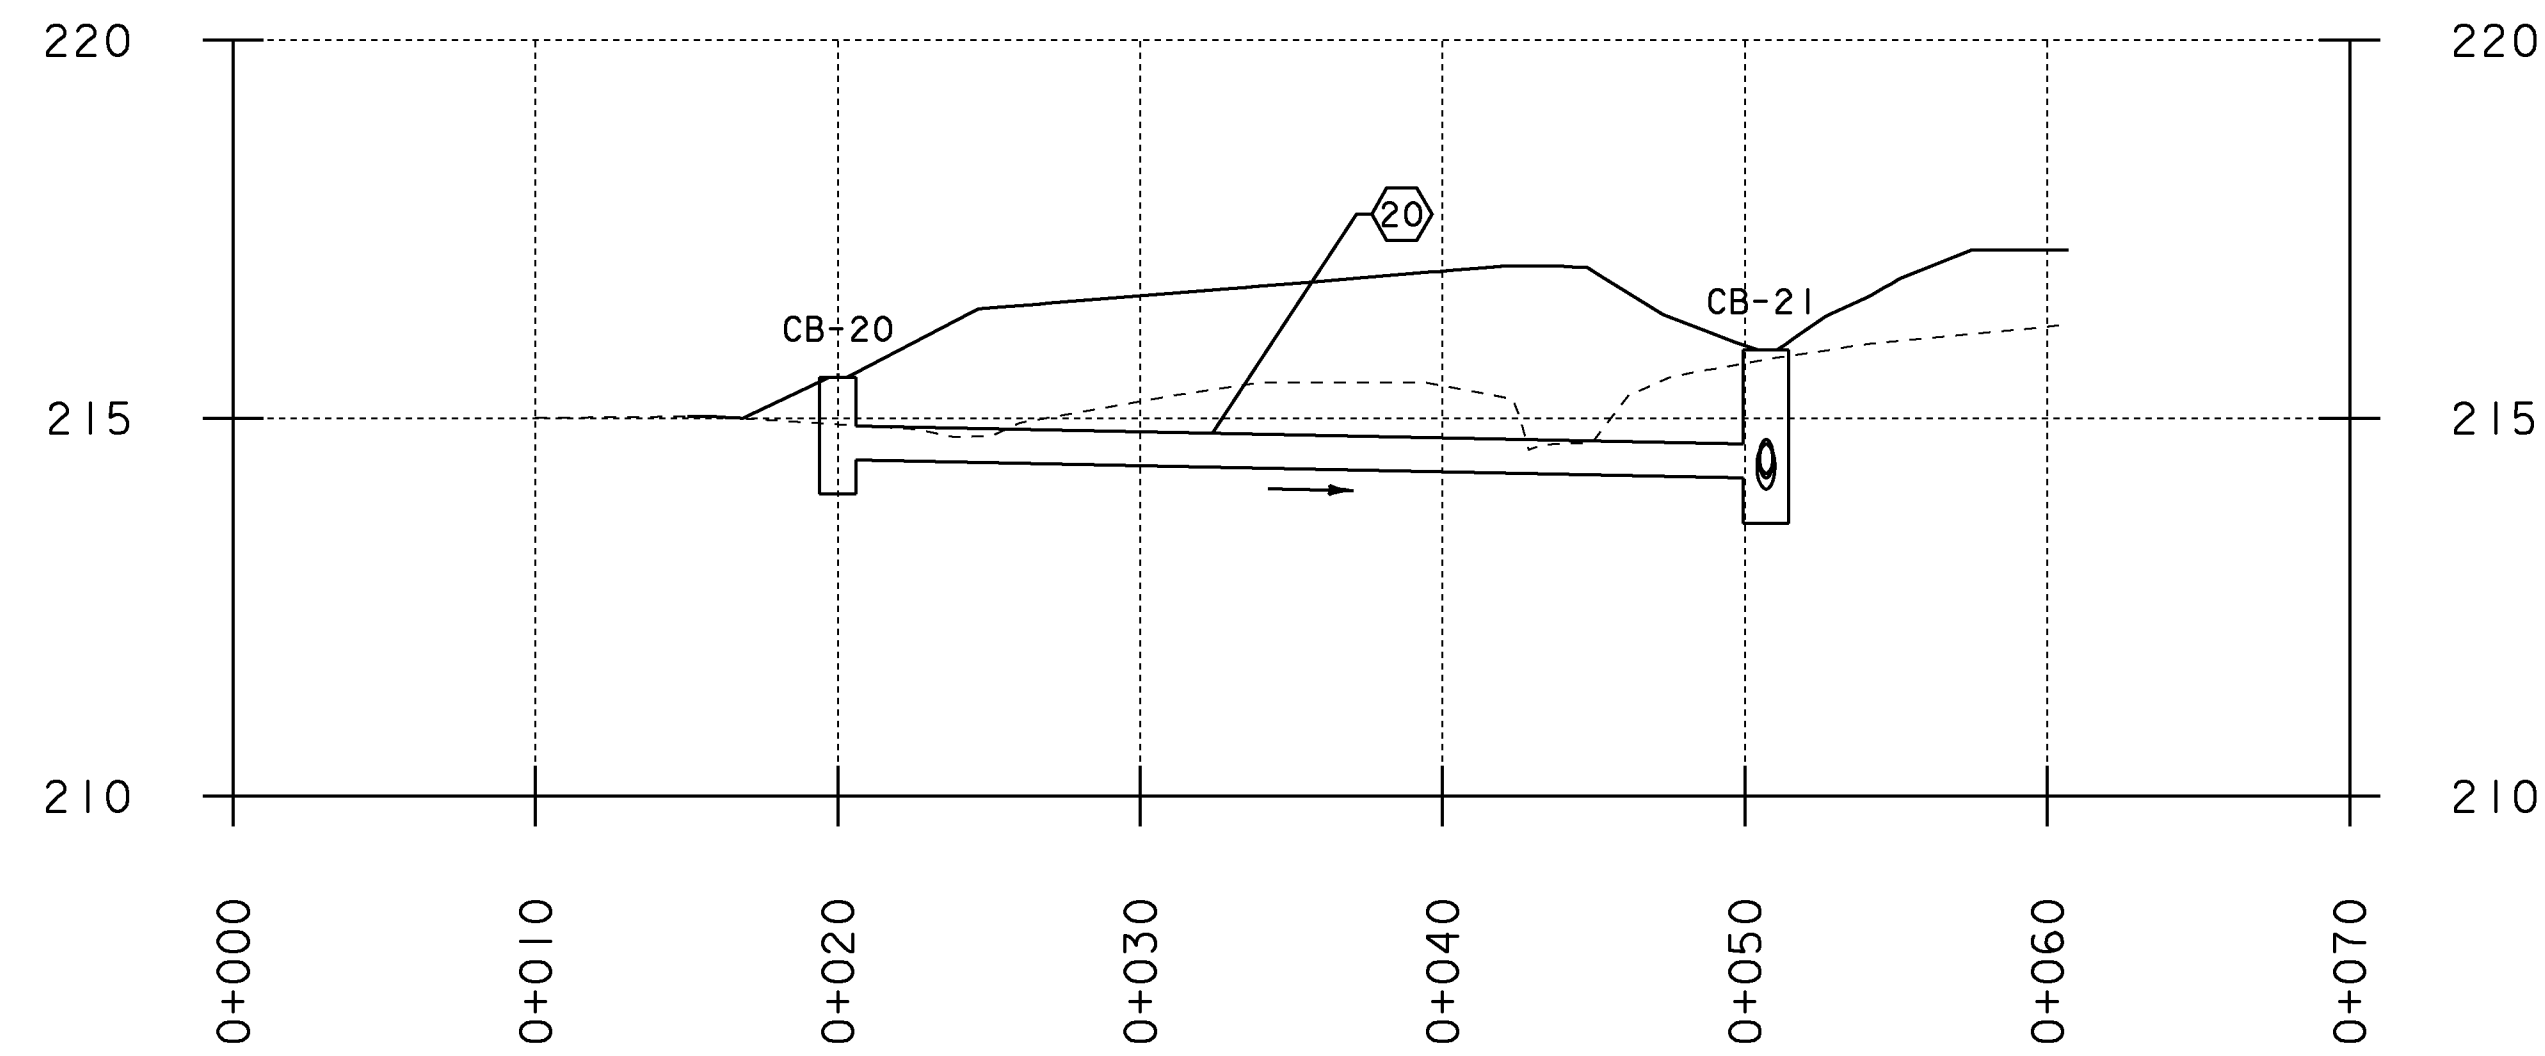
PIPE 20



CB-20
 GRATE: TYPE D
 RIM EL = 215.54M
 DIAM. = 1200MM
 DEPTH = 1.54M

20
 SLOPE = 0.81%
 NEW PIPE
 TYPE: OPTION PIPE
 LENGTH = 30.70M
 DIAMETER = 450.00MM
 INV IN = 214.45M
 INV OUT = 214.21M


PIPE 21

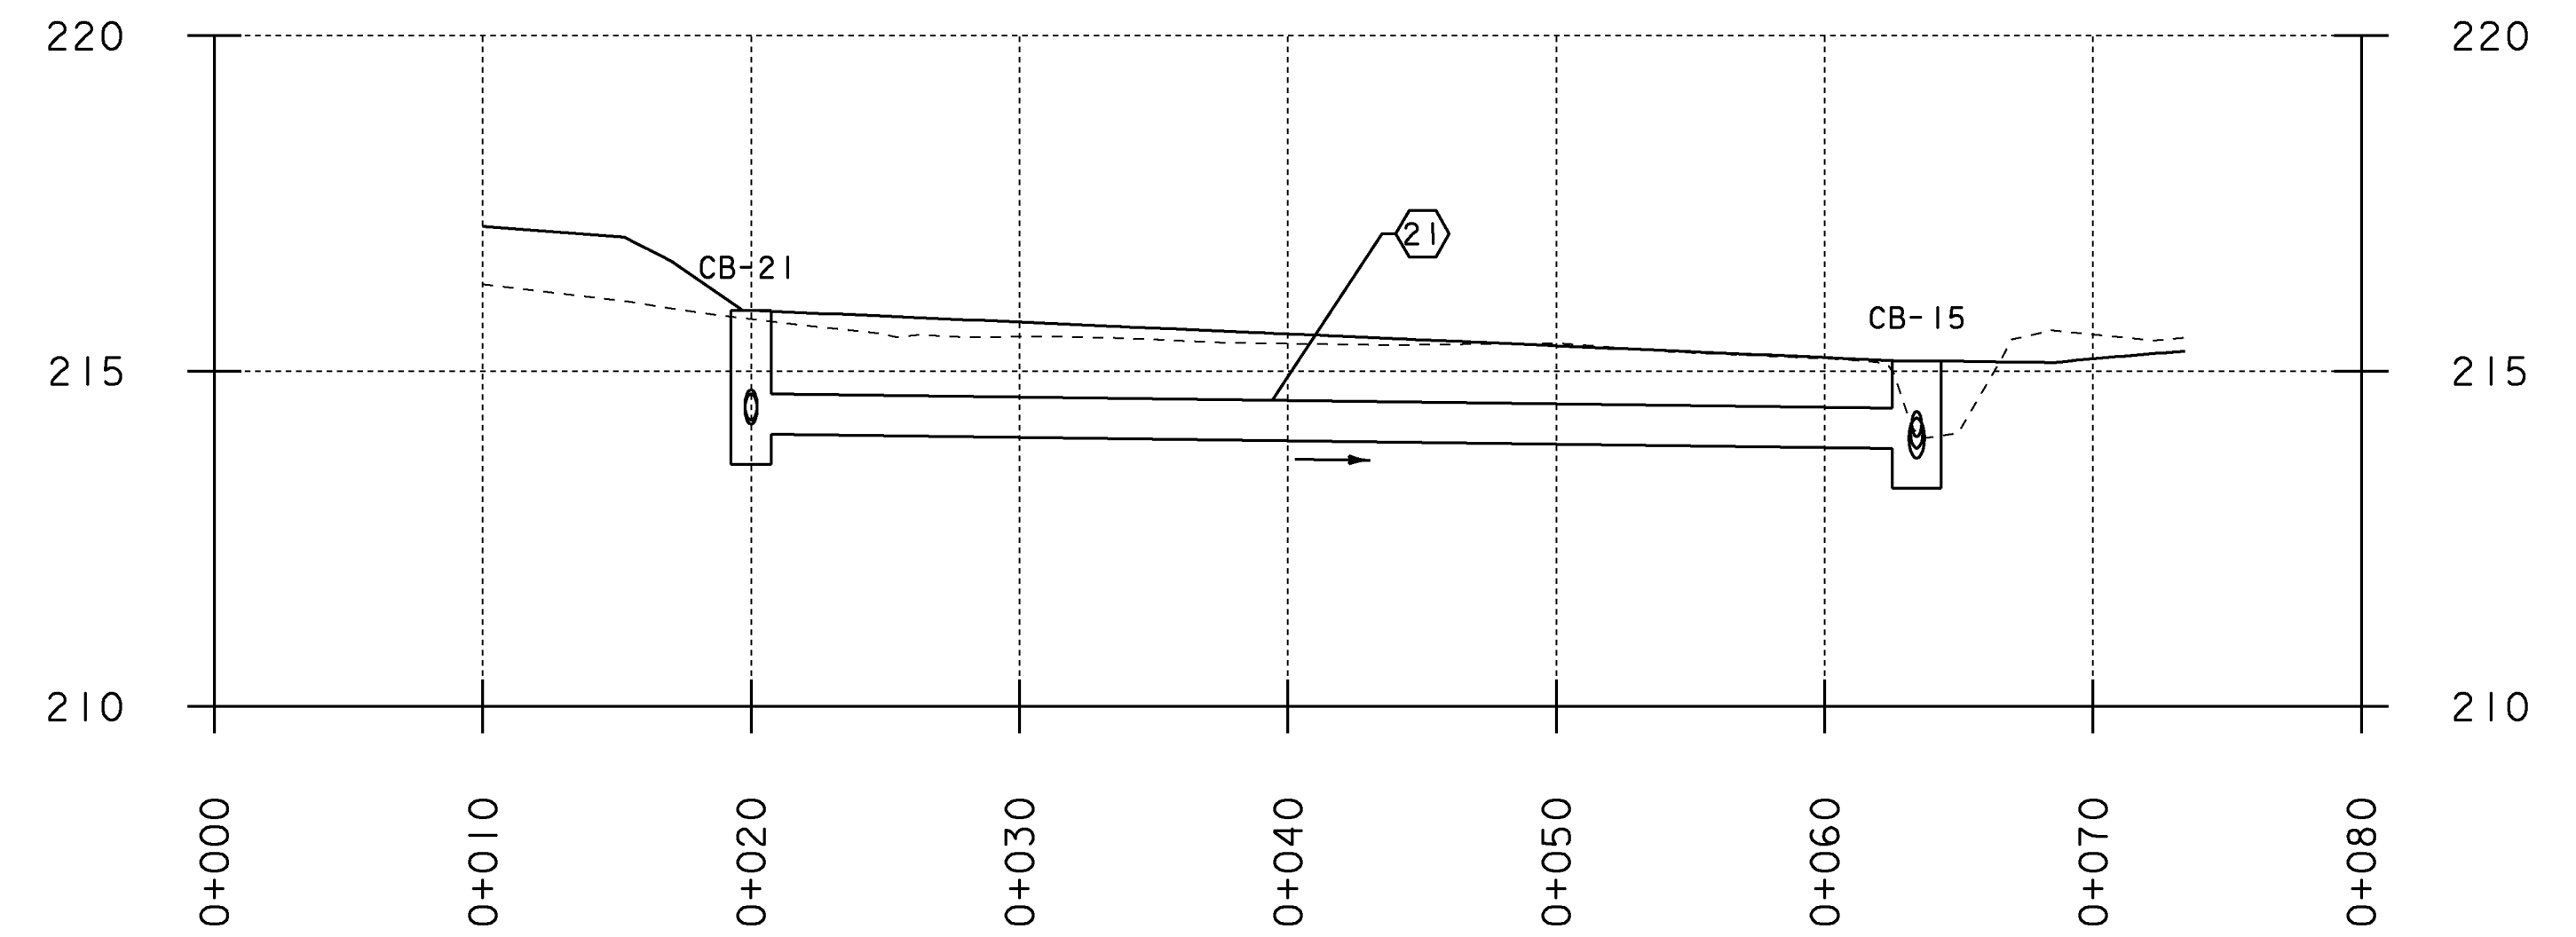

CB-21
 GRATE: TYPE D
 RIM EL = 215.90M
 DIAM. = 1500M
 DEPTH = 2.29M

21
 SLOPE = 0.50%
 NEW PIPE
 TYPE: OPTION PIPE
 LENGTH = 43.43M
 DIAMETER = 600.00MM
 INV IN = 214.06M
 INV OUT = 213.85M


PIPE 22

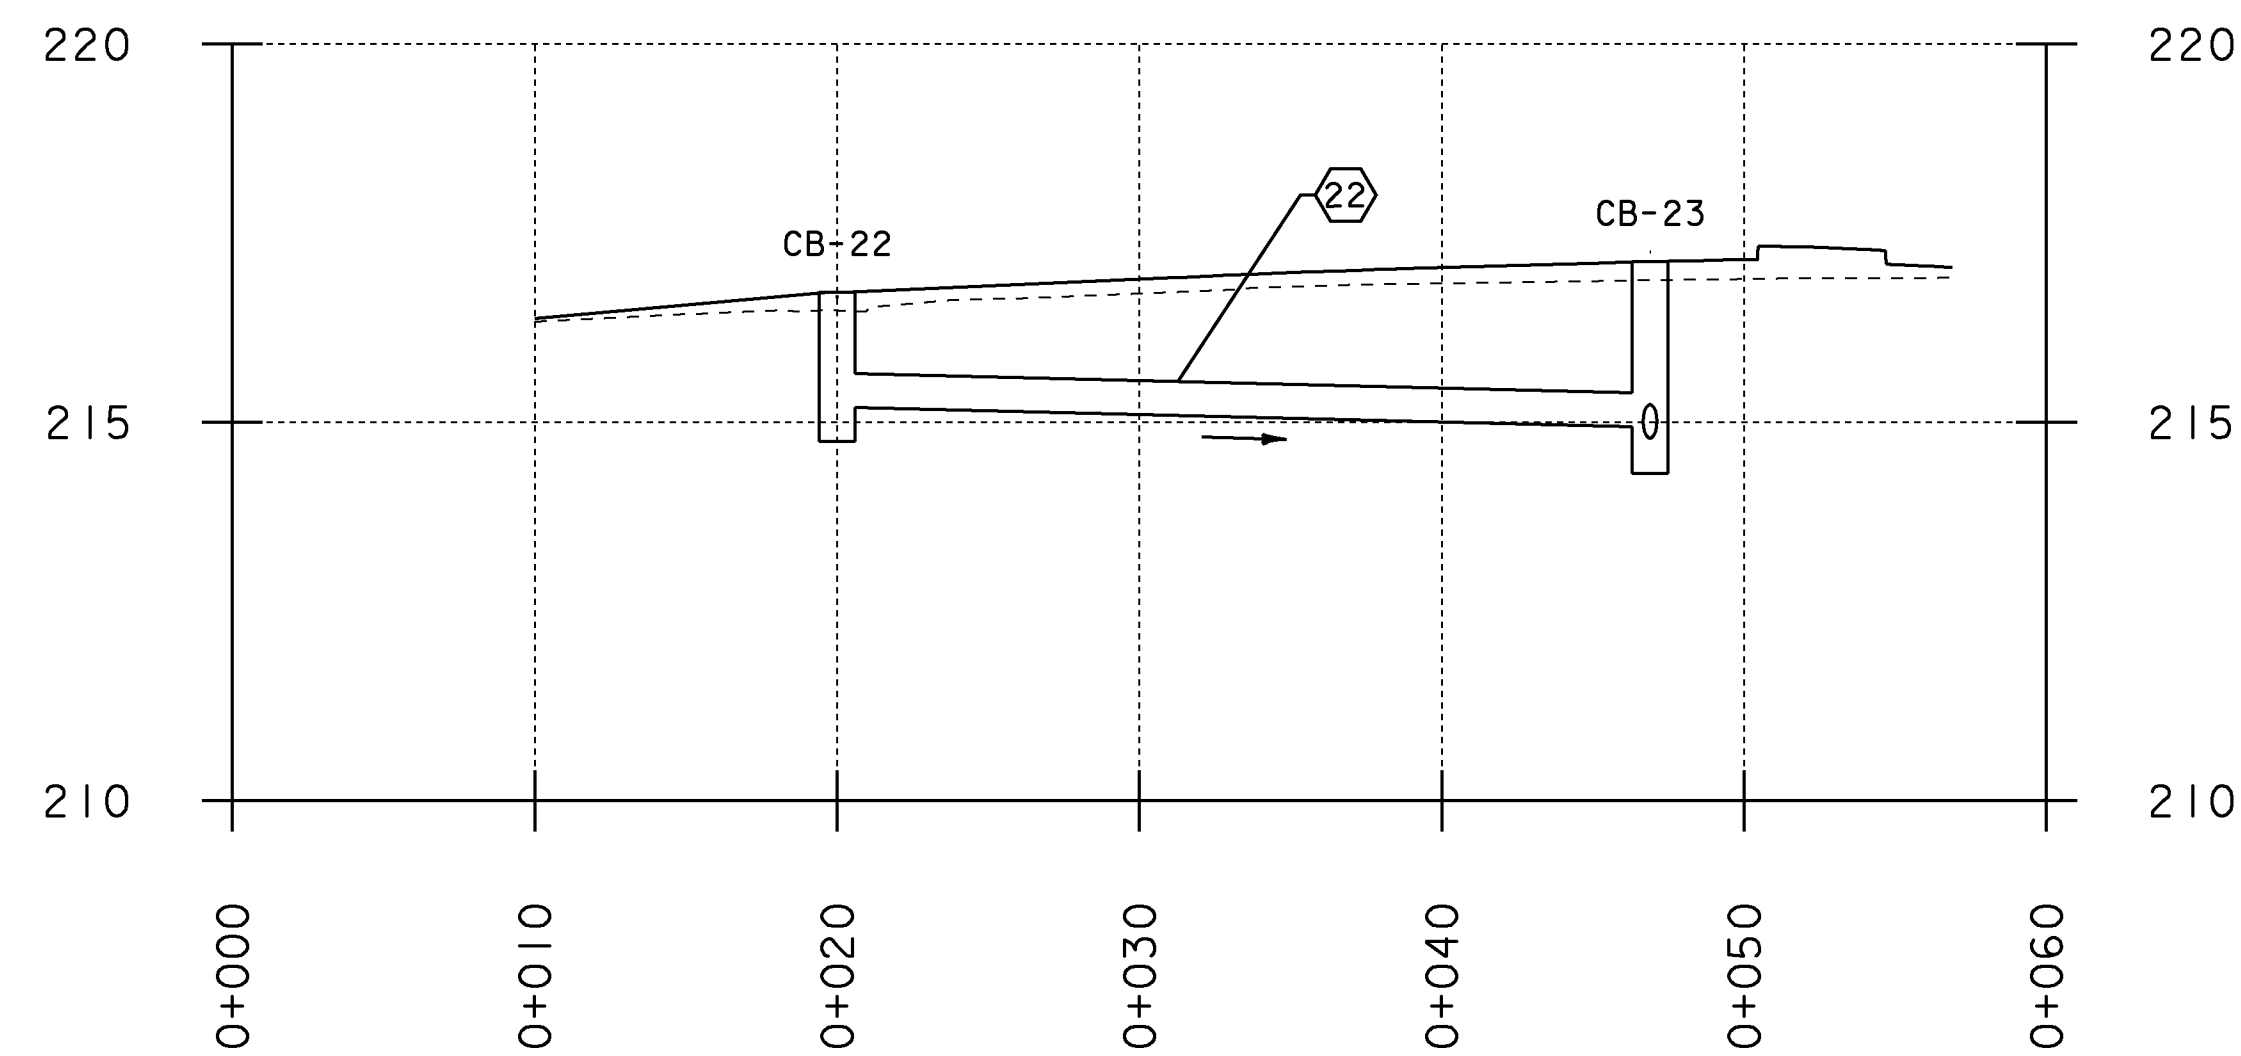

CB-22
 GRATE: TYPE D
 RIM EL = 216.72M
 DIAM. = 1200M
 DEPTH = 1.97M


22
 SLOPE = 1.00%
 NEW PIPE
 TYPE: OPTION PIPE
 LENGTH = 26.89M
 DIAMETER = 450.00MM
 INV IN = 215.19M
 INV OUT = 214.94M

PIPE 23

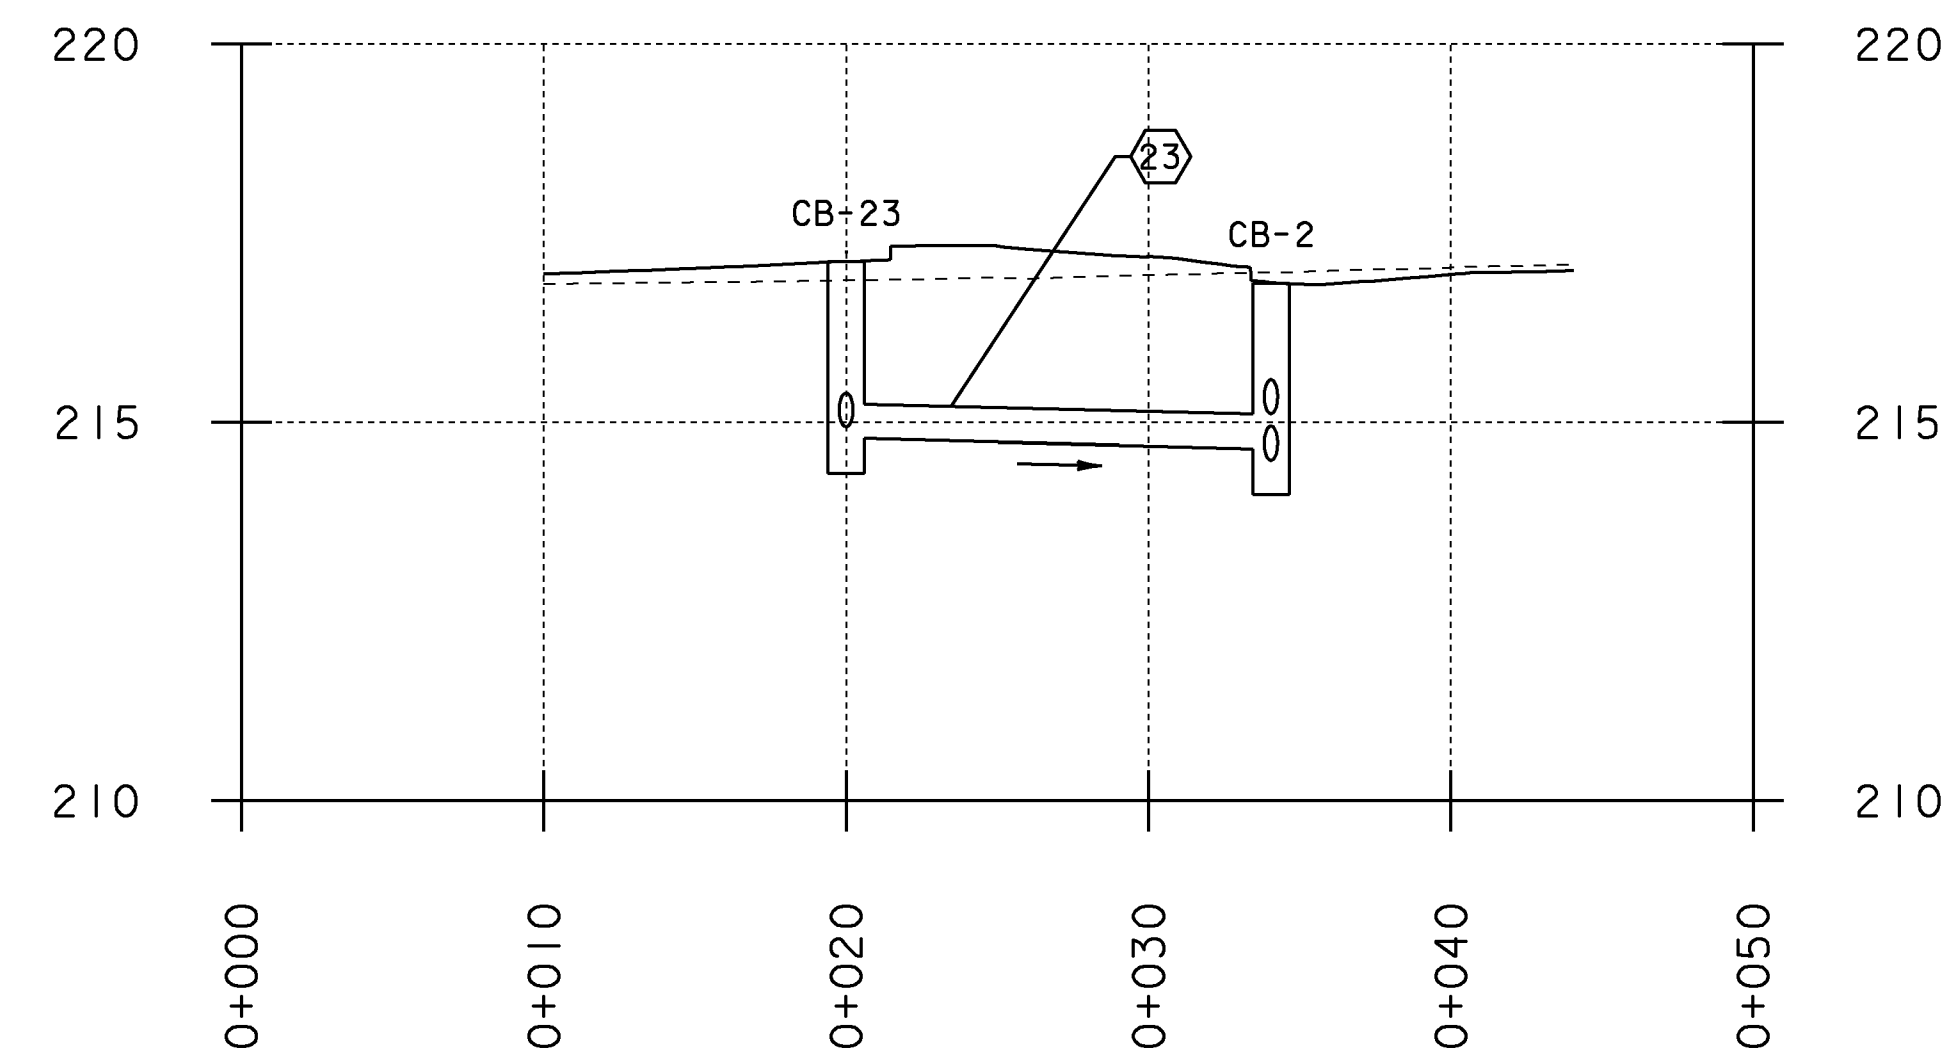


CB-23
 GRATE: TYPE D
 RIM EL = 217.12M
 DIAM. = 1200M
 DEPTH = 2.79M


23
 SLOPE = 1.00%
 NEW PIPE
 TYPE: OPTION PIPE
 LENGTH = 14.05M
 DIAMETER = 450.00MM
 INV IN = 214.78M
 INV OUT = 214.66M

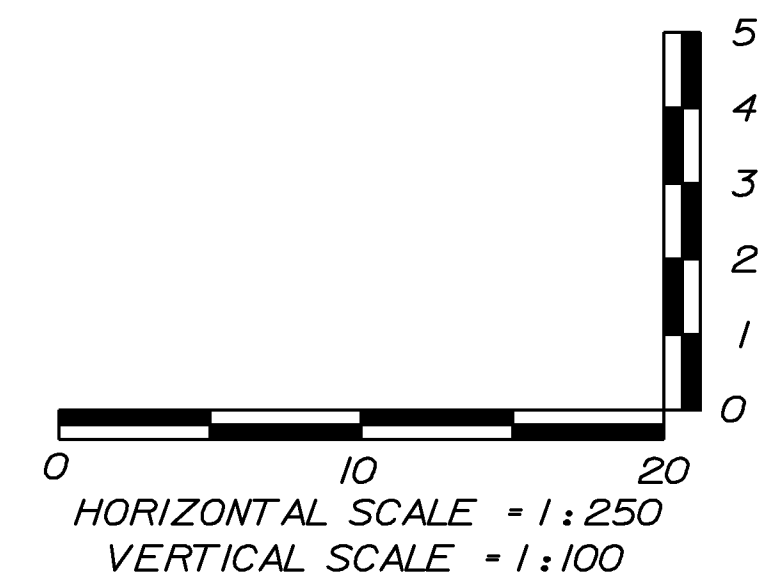


PROJECT NAME: EAST MONTPELIER	PLOT DATE: 22-MAR-2010
PROJECT NUMBER: STPG 028 - 3(35)S	DRAWN BY: D. LYMAN
FILE NAME: +98b028profile.dgn	CHECKED BY: J. DEVLIN
PROJECT LEADER: J.SCHULTZ	SHEET 46 OF 142
DESIGNED BY: J. GRUCHACZ	
DRAINAGE PROFILE SHEET 5	

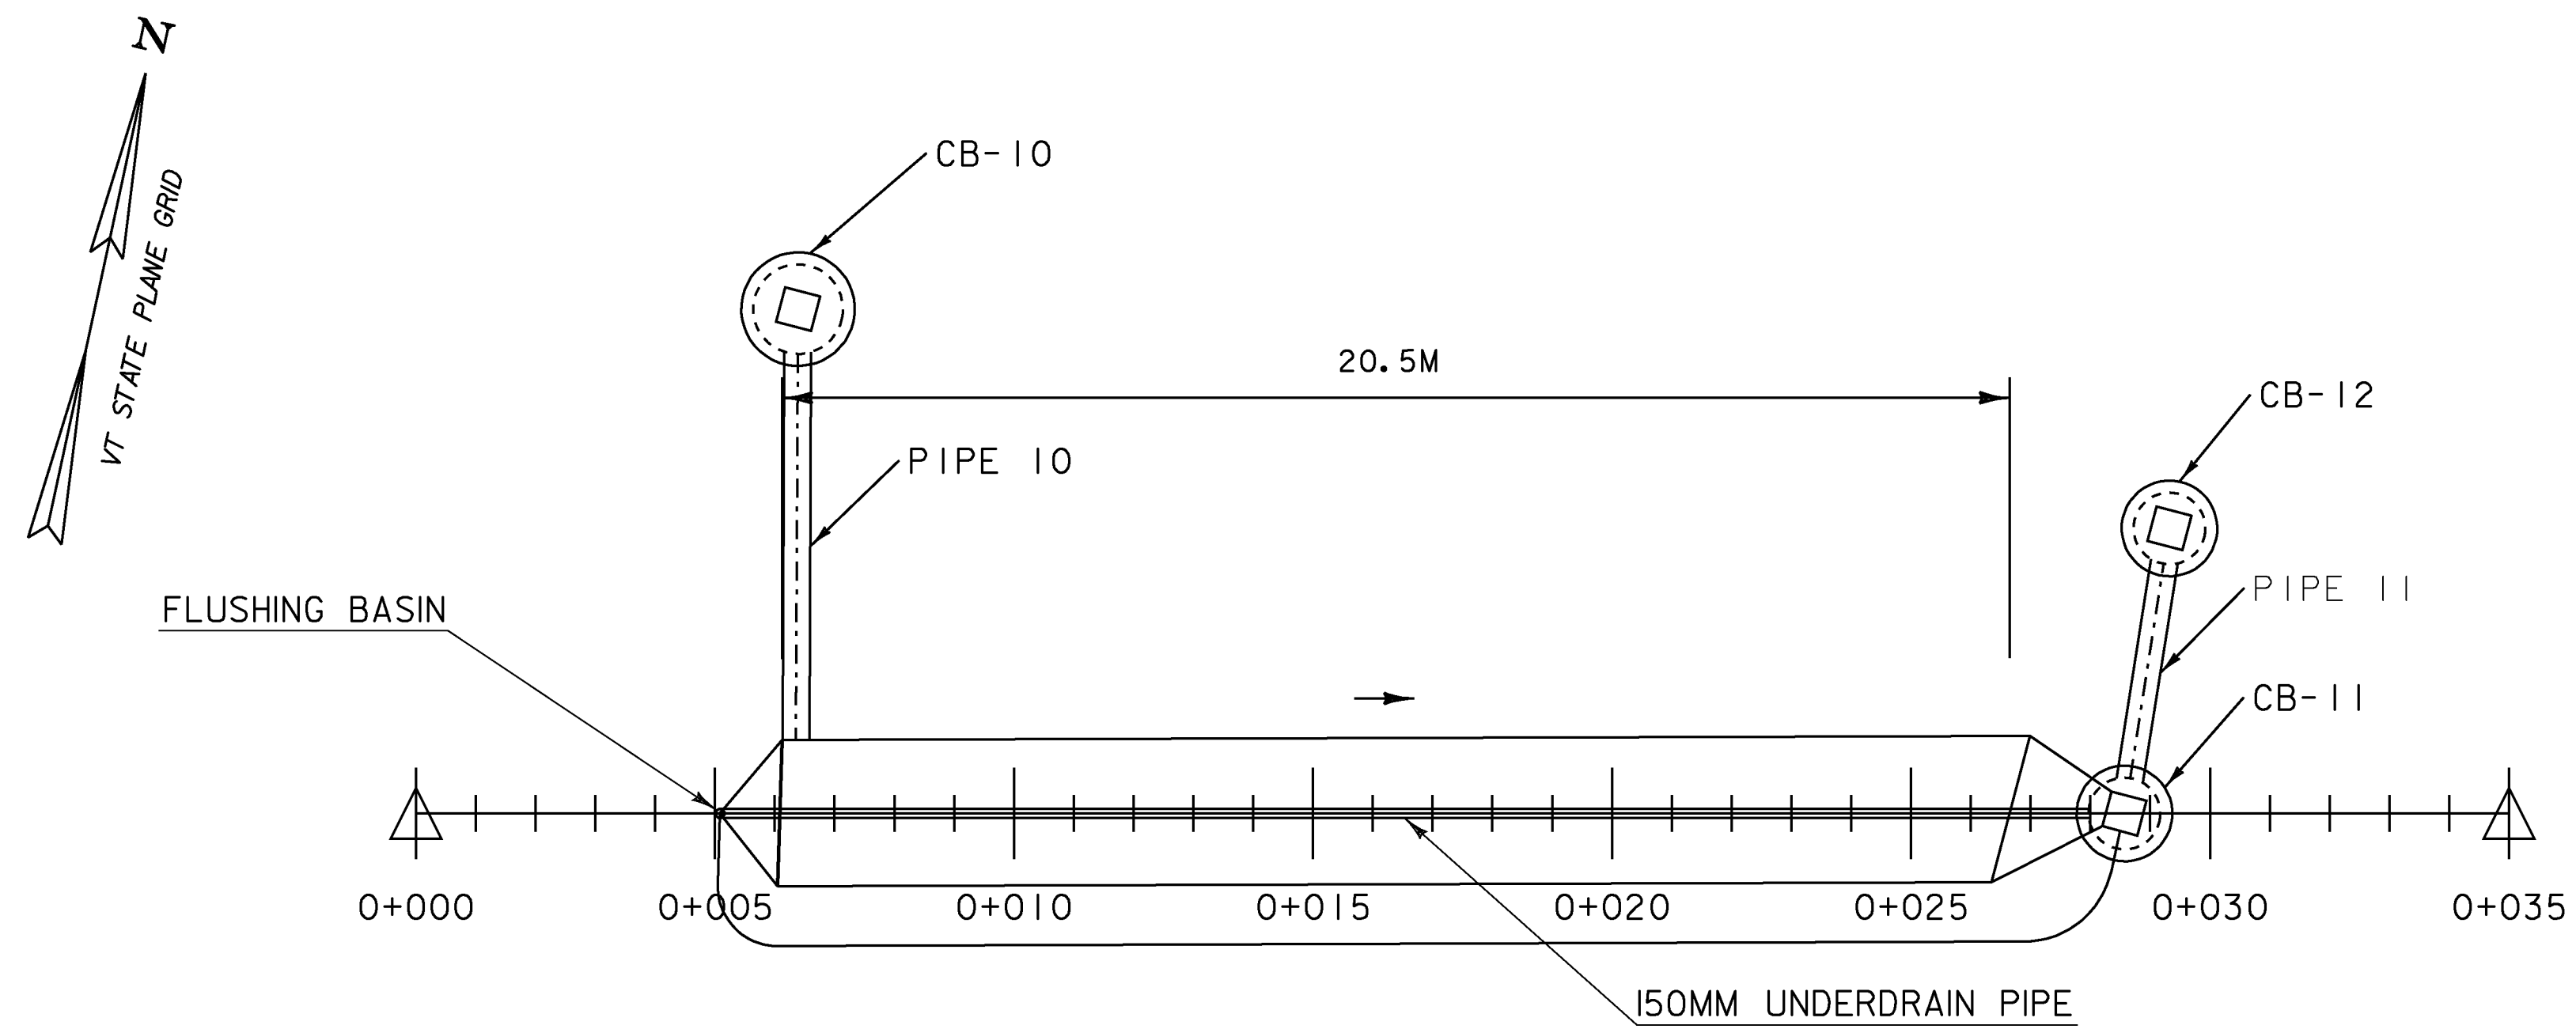

**900.640 SPECIAL PROVISION
(150MM UNDERDRAIN PIPE, DRY SWALE)
PLAN**

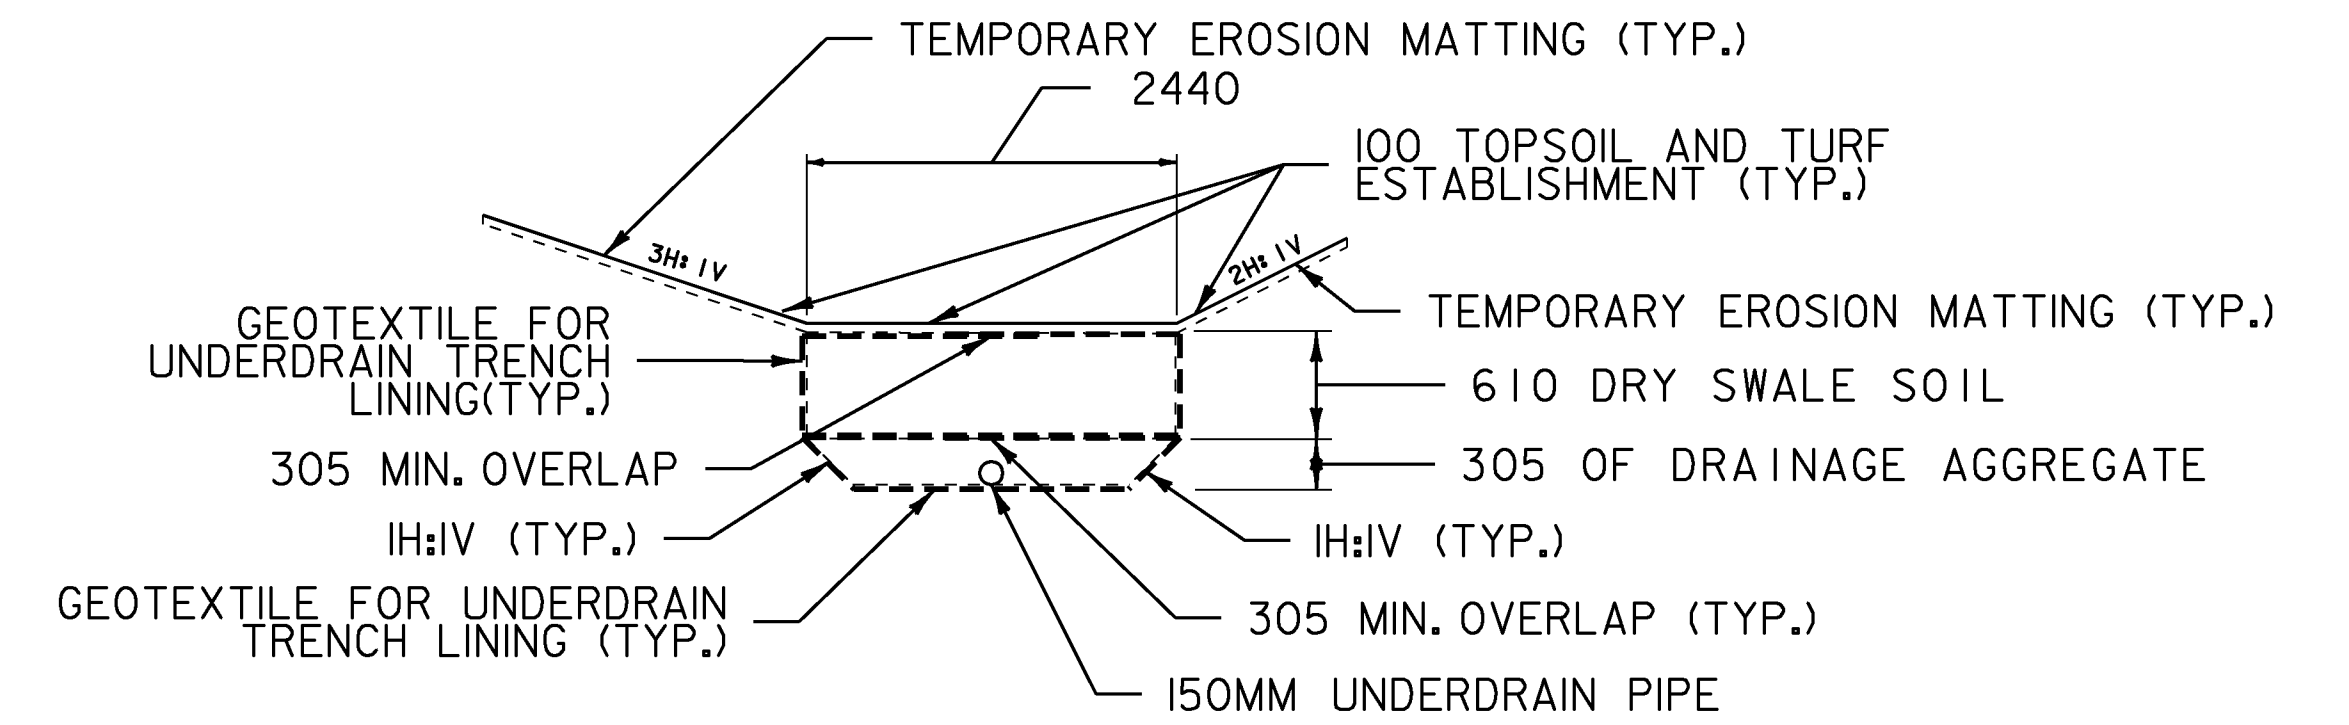


**900.640 SPECIAL PROVISION
(150MM UNDERDRAIN PIPE, DRY SWALE)
US ROUTE 2
4+800.00 RT - 4+825.00 RT
NOT TO SCALE**

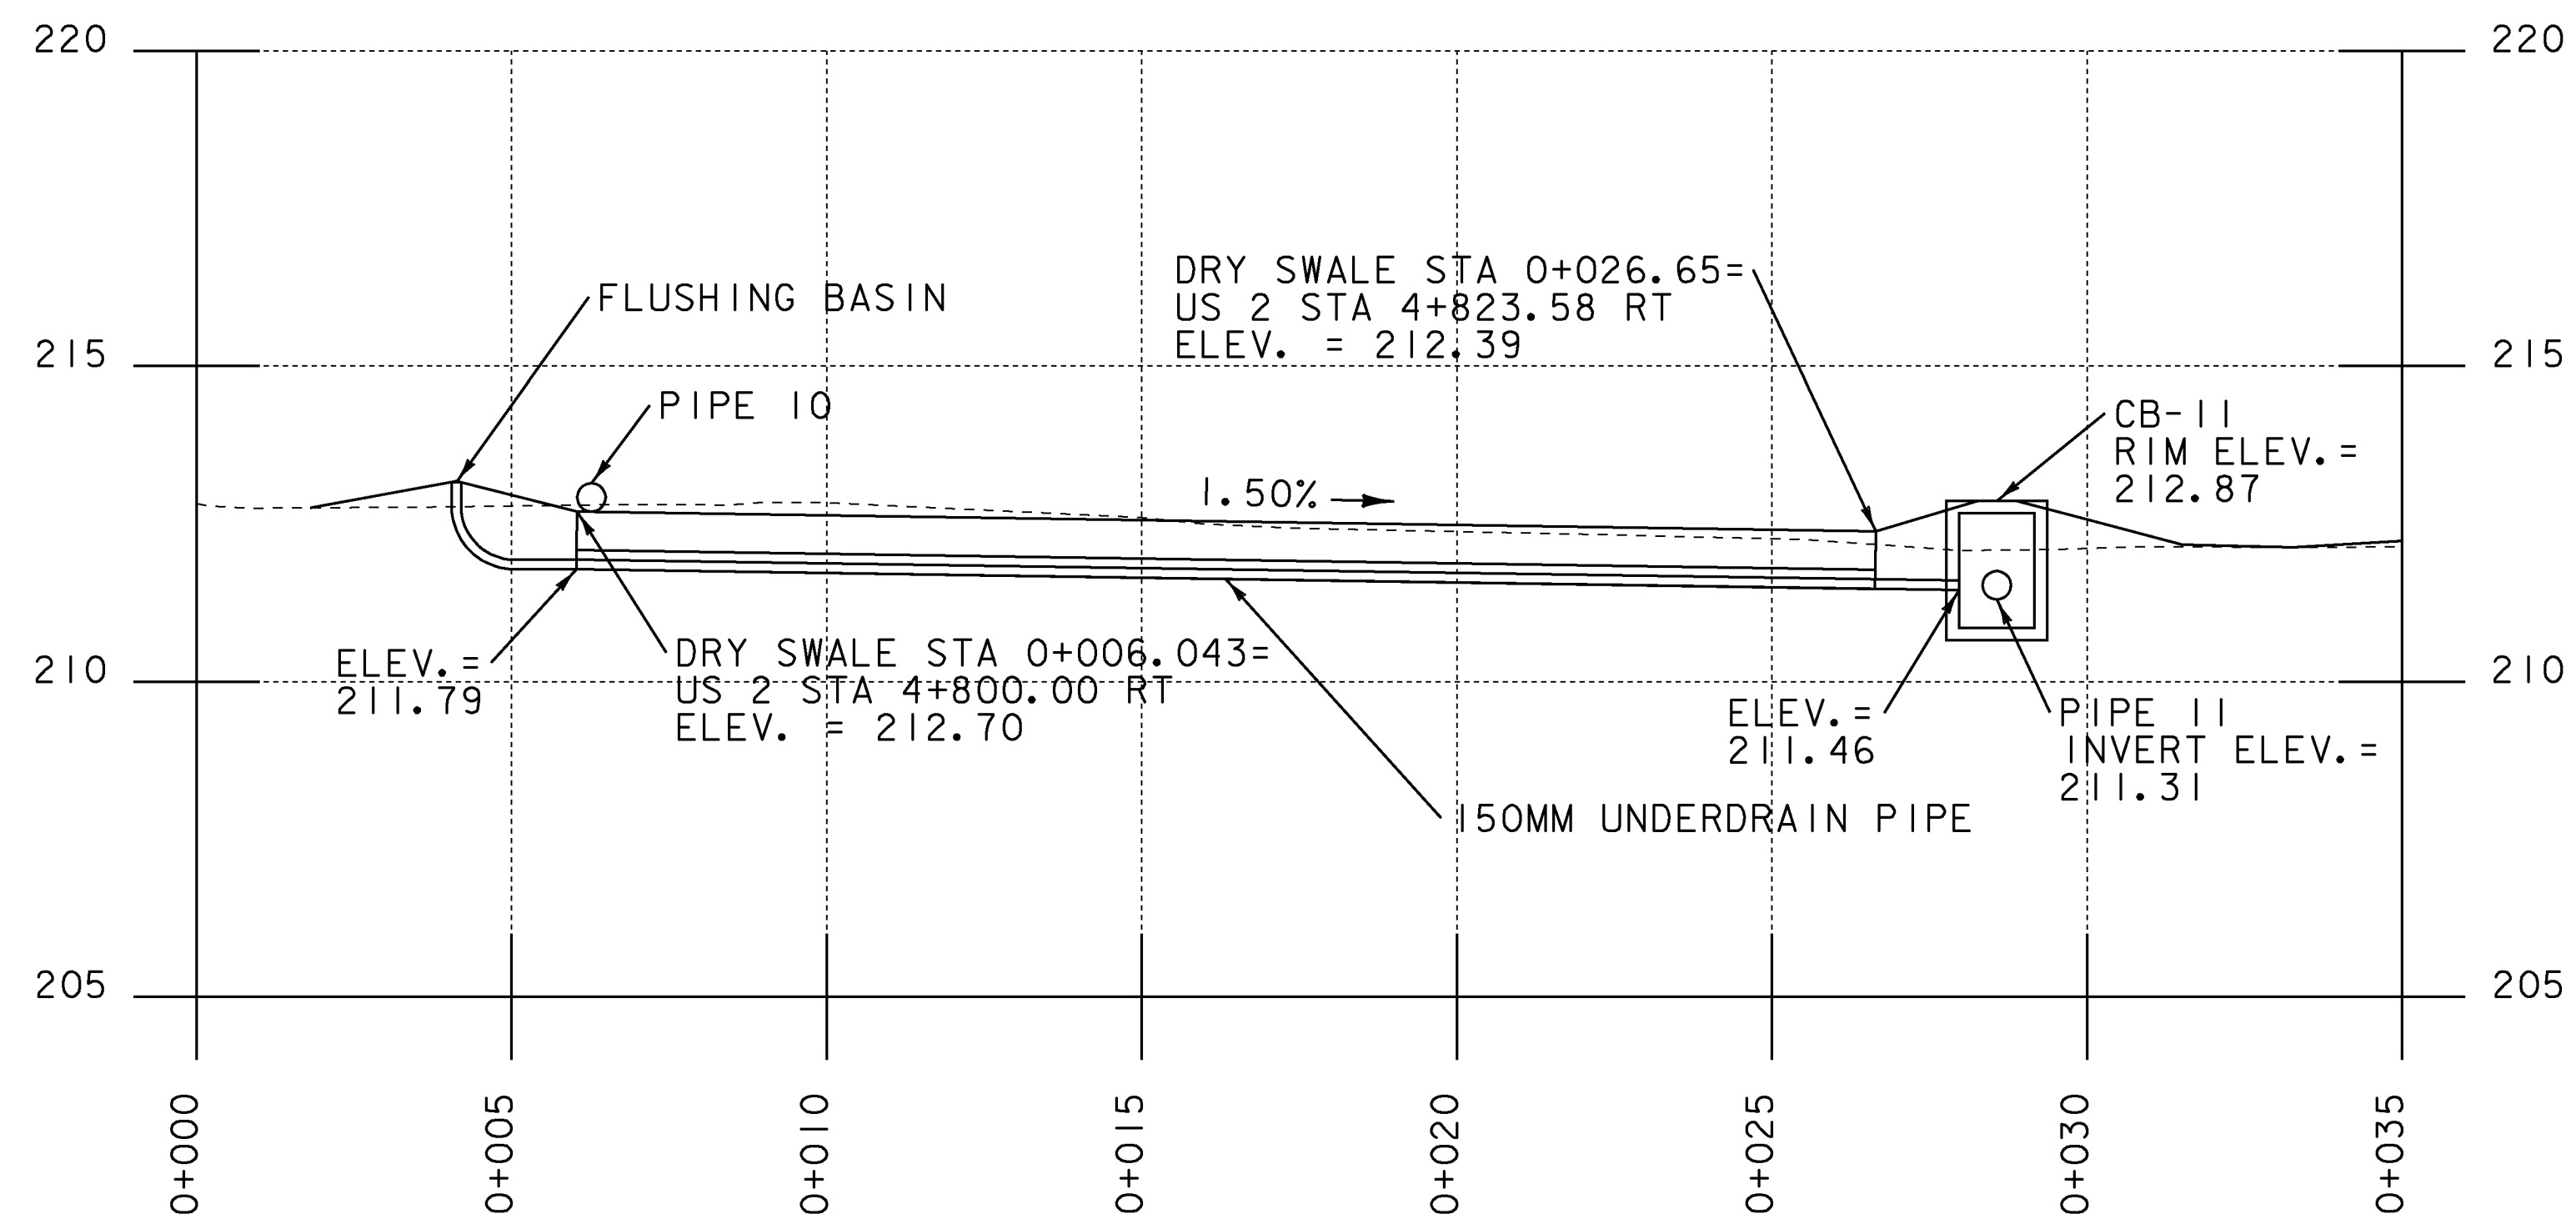

**900.640 SPECIAL PROVISION
(150MM UNDERDRAIN PIPE, DRY SWALE)
PROFILE**

DRY SWALE NOTES

1. THE CONTRACTOR SHALL WRAP GEOTEXTILE FOR UNDERDRAIN TRENCH LINING AROUND THE DRY SWALE SOIL AND DRAINAGE AGGREGATE SEPARATELY WITH A MINIMUM OF 305MM OVERLAP AT ENDS.
2. THE CONTRACTOR SHALL PLACE TEMPORARY EROSION MATTING WITH GRASS AND SEED OVER THE DRY SWALE SOIL.
3. PAYMENT FOR ITEM 900.640, "SPECIAL PROVISION (150MM UNDERDRAIN PIPE, DRY SWALE)" SHALL INCLUDE 150MM UNDERDRAIN, DRAINAGE AGGREGATE, DRY SWALE SOIL, AND GEOTEXTILE FOR UNDERDRAIN TRENCH LINING. PAYMENT FOR EXCAVATION SHALL BE MADE UNDER ITEM 204.20, "TRENCH EXCAVATION OF EARTH".

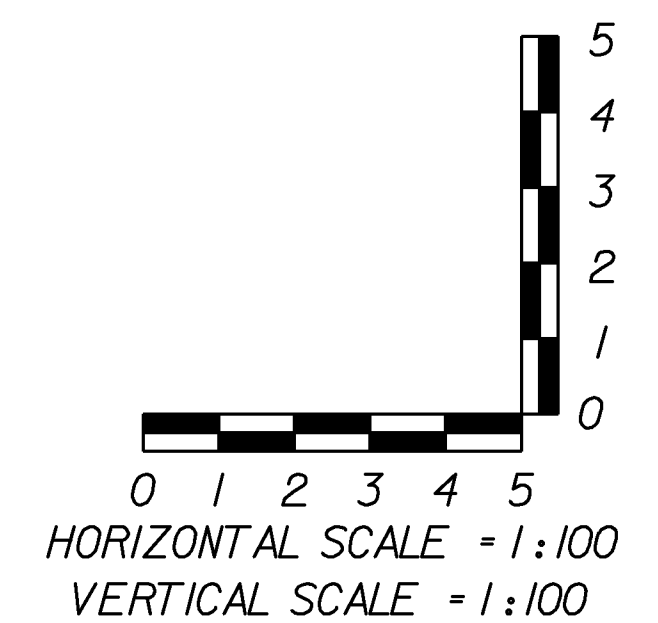

PROJECT NAME:	EAST MONTPELIER
PROJECT NUMBER:	STPG 028 - 3(35)S
FILE NAME:	+98b028+typ.dgn
PROJECT LEADER:	J. SCHULTZ
DESIGNED BY:	J. GRUCHACZ
STORMWATER TREATMENT DETAIL SHEET	
PLOT DATE:	29-MAR-2010
DRAWN BY:	D. LYMAN
CHECKED BY:	J. DEVLIN
SHEET	47 OF 142

EROSION CONTROL NARRATIVE

1.1 PROJECT DESCRIPTION

THE PROJECT IS LOCATED AT THE INTERSECTION OF US ROUTE 2 AND VT ROUTE 14 IN THE TOWN OF EAST MONTPELIER. WORK TO BE PERFORMED INCLUDES THE REALIGNMENT AND RECONSTRUCTION OF THE US ROUTE 2 AND VT ROUTE 14 INTERSECTION, INSTALLATION OF A NEW TRAFFIC CONTROL SIGNAL SYSTEM, NEW DRAINAGE FEATURES, SUBBASE, PAVEMENT, PAVEMENT MARKINGS, CONSTRUCTION OF A NEW PARKING AREA, AND MISCELLANEOUS ROADWAY ITEMS.

NOTE: AREA OF DISTURBANCE SHALL INCLUDE LIMITS OF EARTH DISTURBANCE WITHIN THE PROJECT AREA, INCLUDING ANY WASTE, STAGING AND BORROW AREAS WITHIN OR DIRECTLY ADJACENT TO THE PROJECT LIMITS.

TOTAL AREA OF DISTURBANCE IS APPROXIMATELY 1.63 HECTARES.

IT IS ANTICIPATED THAT THIS PROJECT WILL LAST TWO CONSTRUCTION SEASONS.

1.2 SITE INVENTORY

1.2.1 TOPOGRAPHY

THE PROJECT AREA CAN BE DESCRIBED AS RURAL RESIDENTIAL. THERE ARE NUMEROUS RESIDENTIAL AND COMMERCIAL BUILDINGS LOCATED ALONG THE PROJECT LENGTH. THE LAND COVER ASSOCIATED WITH THESE LOTS INCLUDE IMPERVIOUS AREA, WELL ESTABLISHED LAWNS, AS WELL AS LIGHT WOODS/BRUSH. ADJACENT TO THESE LOTS THERE ARE LARGER, UNDEVELOPED, WELL ESTABLISHED FIELDS. THE PROJECT AREA CAN BE DESCRIBED AS ROLLING TERRAIN, WITH PRIMARY DRAINAGE OCCURRING IN THE WEST TO EAST DIRECTION. DIRECTLY WEST AND NORTH OF THE PROJECT AREA, THE TOPOGRAPHY CONSISTS OF STEEP TERRAIN, DRAINING TOWARDS THE PROJECT. THE AREA SOUTH AND EAST OF THE PROJECT DRAINS AWAY FROM THE PROJECT AREA. ALL RUNOFF FROM THESE OFF-SITE AREAS HAVE BEEN CONSIDERED IN DRAINAGE DESIGN CALCULATIONS.

1.2.2 DRAINAGE, WATERWAYS, BODIES OF WATER, AND PROXIMITY TO NATURAL OR MAN-MADE WATER FEATURES

THERE ARE TWO WATER BODIES IN THE PROJECT VICINITY. THE WINOOSKI RIVER RUNS PARALLEL TO US ROUTE 2 ALONG THE PROJECT LENGTH. A SMALL PORTION OF THE PROJECT (APPROXIMATELY 0.44 ACRES) DRAINS TO THE WINOOSKI RIVER VIA OVERLAND FLOW OVER WELL ESTABLISHED FIELDS. THIS RECEIVING WATER HAS A WATERSHED AREA OF 466.20 SQUARE KILOMETERS AT THE DISCHARGE POINT. THE REMAINDER OF THE PROJECT DRAINS, VIA CLOSED DRAINAGE FEATURES AND GRASS CHANNELS, TO THE SODOM BROOK. THE SODOM BROOK INTERSECTS WITH US ROUTE 2 APPROXIMATELY 125 METERS EAST OF THE END PROJECT STATION. THIS RECEIVING WATER HAS A WATERSHED AREA OF APPROXIMATELY 26.16 SQUARE KILOMETERS AT THE DISCHARGE POINT.

1.2.3 VEGETATION

THE LAND COVER IN THE PROJECT AREA CONSISTS OF ESTABLISHED LAWNS, LIGHT WOODS/BRUSH, AND IMPERVIOUS AREA ASSOCIATED WITH THE ROADWAY AND RESIDENTIAL/COMMERCIAL DEVELOPMENT. THE IMPACT TO VEGETATION WILL BE LIMITED TO THAT WHICH IS DIRECTLY AFFECTED BY THE ROADWAY CONSTRUCTION ACTIVITIES. DISTURBED VEGETATION WILL BE REESTABLISHED WITH STANDARD SEED AND MULCH PRACTICES. MULTIPLE LANDSCAPE FEATURES WILL BE INSTALLED AS PART OF THE PROJECT.

1.2.4 SOILS

ALL SOIL DATA CAME FROM THE U.S. DEPARTMENT OF AGRICULTURE SOIL CONSERVATION SERVICE FOR THE COUNTY OF WASHINGTON, VERMONT. SOILS ON THE PROJECT SITE INCLUDE; ADAMS LOAMY FINE SAND, 3% TO 8% SLOPES, "K FACTOR" = 0.17, LOW EROSION POTENTIAL, DUMMERSTON FINE SANDY LOAM, 15% TO 25% SLOPES, "K FACTOR" = 0.32, MODERATE EROSION POTENTIAL, CABOT SILT LOAM, 0% TO 3% SLOPES, "K FACTOR" = 0.32, MODERATE EROSION POTENTIAL, AND SALMON VERY FINE SANDY LOAM, 8% TO 15% SLOPES, "K FACTOR" = 0.49, HIGH EROSION POTENTIAL.

NOTE: K-VALUES GENERALLY INDICATE THE FOLLOWING: 0.0-0.23 = LOW EROSION POTENTIAL; 0.24-0.36 = MODERATE EROSION POTENTIAL; 0.37 AND HIGHER = HIGH EROSION POTENTIAL.

1.2.5 SENSITIVE RESOURCE AREAS

CRITICAL HABITATS: NO
HISTORICAL OR ARCHEOLOGICAL AREAS: YES (MULTIPLE HISTORIC STRUCTURES, PROJECT WILL HAVE NO ADVERSE EFFECT)
PRIME AGRICULTURAL LAND: NO
THREATENED AND ENDANGERED SPECIES: NO

WATER RESOURCE: RECEIVING WATERS (WINOOSKI RIVER, SODOM BROOK)
WETLANDS: NO

1.3 RISK EVALUATION

THIS PROJECT FALLS UNDER THE JURISDICTION OF GENERAL PERMIT 3-9020 FOR STORMWATER RUNOFF FROM CONSTRUCTION SITES FOR LOW RISK PROJECTS. ANY MODIFICATIONS TO THE PROJECT THAT INCREASE THE RISK TO ENVIRONMENTAL RESOURCES SHALL BE EVALUATED IN ACCORDANCE WITH THE PERMIT REQUIREMENTS. THE CONTRACTOR WILL BE RESPONSIBLE FOR ANY ADDITIONAL PERMITTING.

1.4 EROSION PREVENTION AND SEDIMENT CONTROL

THE EROSION CONTROL PLANS ARE MEANT AS A GUIDELINE FOR PREVENTING EROSION AND CONTROLLING SEDIMENT TRANSPORT. THE PRINCIPLES OUTLINED IN THIS NARRATIVE CONSIST OF APPLYING MEASURES THROUGHOUT CONSTRUCTION OF THE PROJECT IN ORDER TO MINIMIZE SEDIMENT TRANSPORT TO THE RECEIVING WATERS. THE MEASURES INCLUDE STABILIZATION AND STRUCTURAL PRACTICES, STORM WATER CONTROLS AND OTHER POLLUTION PREVENTION PRACTICES. THEY HAVE BEEN PROPOSED BY THE DESIGNER AS A BASIS FOR PROTECTING RESOURCES AND WILL NEED TO BE BUILT UPON BASED ON THE SPECIFIC MEANS AND METHODS OF THE CONTRACTOR. REFER TO THE LOW RISK SITE HANDBOOK AND APPROPRIATE DETAIL SHEETS FOR SPECIFIC GUIDANCE AND CONSTRUCTION DETAILING.

ALL MEASURES SHALL BE REGULARLY MAINTAINED AND SHALL BE CHECKED FOR SEDIMENT BUILD-UP. SEDIMENT SHALL BE DISPOSED OF AT AN APPROVED SITE WHERE IT WILL NOT BE SUBJECT TO EROSION.

1.4.1 MARK SITE BOUNDARIES

PROJECT DEMARCATION FENCING (PDF) SHALL BE USED TO PHYSICALLY MARK SITE BOUNDARIES. BECAUSE THIS PROJECT FALLS UNDER THE CGP 3-9020 BARRIER FENCE SHALL BE USED INSTEAD OF PROJECT DEMARCATION FENCE WITHIN 100 FEET OF A WATER RESOURCE (STREAM, BROOK, LAKE, POND, WETLAND, ETC).

SINCE THIS PROJECT IS LOCATED PRIMARILY IN A RESIDENTIAL AREA THE RESIDENT ENGINEER SHALL DETERMINE LOCATIONS WHERE IT WOULD BE APPLICABLE TO DELINEATE SITE BOUNDARIES AND AREAS CONSTRUCTION EQUIPMENT CAN ACCESS. DEMARCATION FENCE SHALL BE CONSIDERED INCIDENTAL TO THE CONTRACT.

1.4.2 LIMIT DISTURBANCE AREA

PREVENTING INITIAL SOIL EROSION BY MINIMIZING THE EXPOSED AREA IS MUCH MORE EFFECTIVE THAN TREATING ERODED SEDIMENT. EARTH DISTURBANCE CAN BE MINIMIZED THROUGH CONSTRUCTION PHASING BY ONLY OPENING UP EARTH AS NECESSARY. THIS CAN LIMIT THE AREA THAT WILL BE DISTURBED AND EXPOSED TO EROSION. EMPLOY TEMPORARY CONSTRUCTION STABILIZATION PRACTICES IN INCREMENTAL STAGES AS PHASES CHANGE. FOR PROJECTS WHICH FALL UNDER THE CONSTRUCTION GENERAL PERMIT, ONLY THE ACREAGE LISTED ON THE PERMIT AUTHORIZATION MAY BE EXPOSED AT ANY GIVEN TIME.

MAINTAINING VEGETATED BUFFERS ALONG STREAM BANKS, WETLANDS OR OTHER SENSITIVE AREAS IS A CRUCIAL EROSION AND SEDIMENT CONTROL MEASURE THAT SHOULD BE ESTABLISHED WHEREVER POSSIBLE.

1.4.3 SITE ENTRANCE/EXIT STABILIZATION

TRACKING OF SEDIMENT ONTO PUBLIC HIGHWAYS SHALL BE MINIMIZED TO REDUCE THE POTENTIAL FOR RUNOFF ENTERING RECEIVING WATERS. INSTALLATION SHALL COINCIDE WITH THE CONTRACTORS PROGRESS SCHEDULE.

STABILIZED CONSTRUCTION ENTRANCES SHALL BE INSTALLED ANYWHERE EQUIPMENT WILL BE GOING FROM AREAS OF EXPOSED SOILS TO PAVED SURFACES, OR AS DIRECTED BY THE ENGINEER.

1.4.4 INSTALL SEDIMENT BARRIERS

SEDIMENT BARRIERS SHALL BE UTILIZED TO INTERCEPT RUNOFF AND ALLOW SUSPENDED SEDIMENT TO SETTLE OUT. THEY SHALL BE INSTALLED PRIOR TO ANY UP SLOPE WORK.

STONE DROP INLET PROTECTION WILL BE USED ON ALL PROPOSED DRAINAGE STRUCTURES AS PROPOSED ON THE EPSC PLAN OR AS DIRECTED BY THE ENGINEER.

SILT FENCE WILL BE INSTALLED AS PROPOSED ON THE EPSC PLAN OR AS DIRECTED BY THE ENGINEER. BECAUSE THIS PROJECT FALLS UNDER THE CGP 3-9020, WOVEN WIRE REINFORCED SILT FENCE SHALL BE USED INSTEAD OF SILT FENCE WITHIN 100 FEET UPSLOPE OF RECEIVING WATERS.

1.4.5 DIVERT UPLAND RUNOFF

DIVERSIONARY MEASURES SHALL BE USED TO INTERCEPT RUNOFF FROM ABOVE THE CONSTRUCTION AND DIRECT IT AROUND THE DISTURBED AREA SO THAT CLEAN WATER DOES NOT BECOME MUDDIED WHILE TRAVELING OVER EXPOSED SOILS ON THE CONSTRUCTION SITE.

1.4.6 SLOW DOWN CHANNELIZED RUNOFF

CHECK STRUCTURES SHALL BE UTILIZED TO REDUCE THE VELOCITY, AND THUS THE EROSION POTENTIAL, OF CONCENTRATED FLOW IN CHANNELS.

STONE CHECK DAMS SHALL BE INSTALLED AS PROPOSED ON THE EPSC PLAN OR AS DIRECTED BY THE ENGINEER.

1.4.7 CONSTRUCT PERMANENT CONTROLS

PERMANENT STORMWATER TREATMENT DEVICES SHALL BE INSTALLED AS SHOWN ON THE PLANS AND IN ACCORDANCE WITH PERMIT CONDITIONS.

TYPE II STONE FOR SLOPE LINING AND CHANNEL PROTECTION
SEED AND MULCH
DRAINAGE INLETS AND PIPING

1.4.8 STABILIZE EXPOSED SOILS DURING CONSTRUCTION

ALL AREAS OF DISTURBANCE MUST HAVE TEMPORARY STABILIZATION IN PLACE WITHIN 48 HOURS OF DISTURBANCE OR IN ACCORDANCE WITH THE CONSTRUCTION GENERAL PERMIT 3-9020 AUTHORIZATION.

SURFACE ROUGHENING OF ALL EXPOSED SLOPES, COMBINED WITH TEMPORARY MULCHING, SHALL BE UTILIZED ON A REGULAR BASIS. BIODEGRADABLE EROSION CONTROL MATTING OR AN EQUIVALENT SHALL BE USED TO STABILIZE ALL SLOPES STEEPER THAN 1:3.

THE FORECAST OF RAINFALL EVENTS SHALL TRIGGER IMMEDIATE PROTECTION OF EXPOSED SOILS.

1.4.9 WINTER STABILIZATION

VARIOUS MEASURES SPECIFIC TO WINTER MAY BE NECESSARY SHOULD THE PROJECT EXTEND INTO WINTER (OCTOBER 15 THROUGH APRIL 15). REFER TO THE LOW RISK SITE HANDBOOK FOR GUIDANCE.

1.4.10 STABILIZE SOIL AT FINAL GRADE

EXPOSED SOIL MUST BE STABILIZED WITHIN 48 HOURS OF REACHING FINAL GRADE.

SEED, MULCH, FERTILIZER AND LIME SHALL BE USED TO ESTABLISH PERMANENT VEGETATION. FOR SLOPES STEEPER THAN 1:3, BIODEGRADABLE EROSION CONTROL MATTING OR AN EQUIVALENT SHALL BE USED INSTEAD OF MULCH.

1.4.11 DE-WATERING ACTIVITIES

DISCHARGE FROM DEWATERING ACTIVITIES THAT FLOWS OFF OF THE CONSTRUCTION SITE MUST NOT CAUSE OR CONTRIBUTE TO A VIOLATION OF THE VERMONT WATER QUALITY STANDARDS.

DE-WATERING ACTIVITIES ARE NOT ANTICIPATED ON THIS PROJECT.

1.4.12 INSPECT YOUR SITE

INSPECT THE PROJECT SITE BASED ON SPECIAL PROVISION REQUIREMENTS OR CONSTRUCTION GENERAL PERMIT AUTHORIZATION STIPULATIONS.

1.5 SEQUENCE AND STAGING

THIS SECTION WILL BE DEVELOPED BY THE CONTRACTOR USING THE GUIDANCE OUTLINED IN THE VTRANS EPSC PLAN CONTRACTOR CHECKLIST.

1.5.1 CONSTRUCTION SEQUENCE


1.5.2 OFF-SITE ACTIVITIES

IN ADDITION TO THE CONTRACTOR CHECKLIST ANY ACTIVITIES OUTSIDE THE CONSTRUCTION LIMITS SHALL FOLLOW SUBSECTIONS 105.25- 105.29 OF THE STANDARD SPECIFICATIONS FOR CONSTRUCTION.



1.5.3 UPDATES

PROJECT NAME: EAST MONTPELIER
PROJECT NUMBER: STPG 028 - 3(35)S

FILE NAME: +98b028ecnarrative.dgn PLOT DATE: 22-MAR-2010
PROJECT LEADER: J. SCHULTZ DRAWN BY: J. DEVLIN
DESIGNED BY: J. GRUCHACZ CHECKED BY: J. SCHULTZ
EPSC NARRATIVE SHEET 48 OF 142

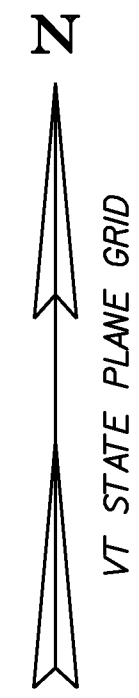

LEGEND
 — AERIAL E&T — AERIAL ELECTRIC & TELEPHONE

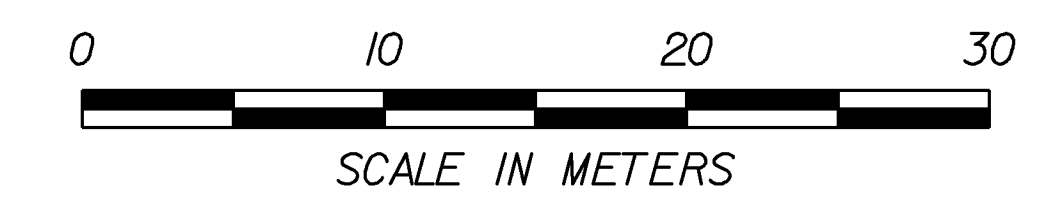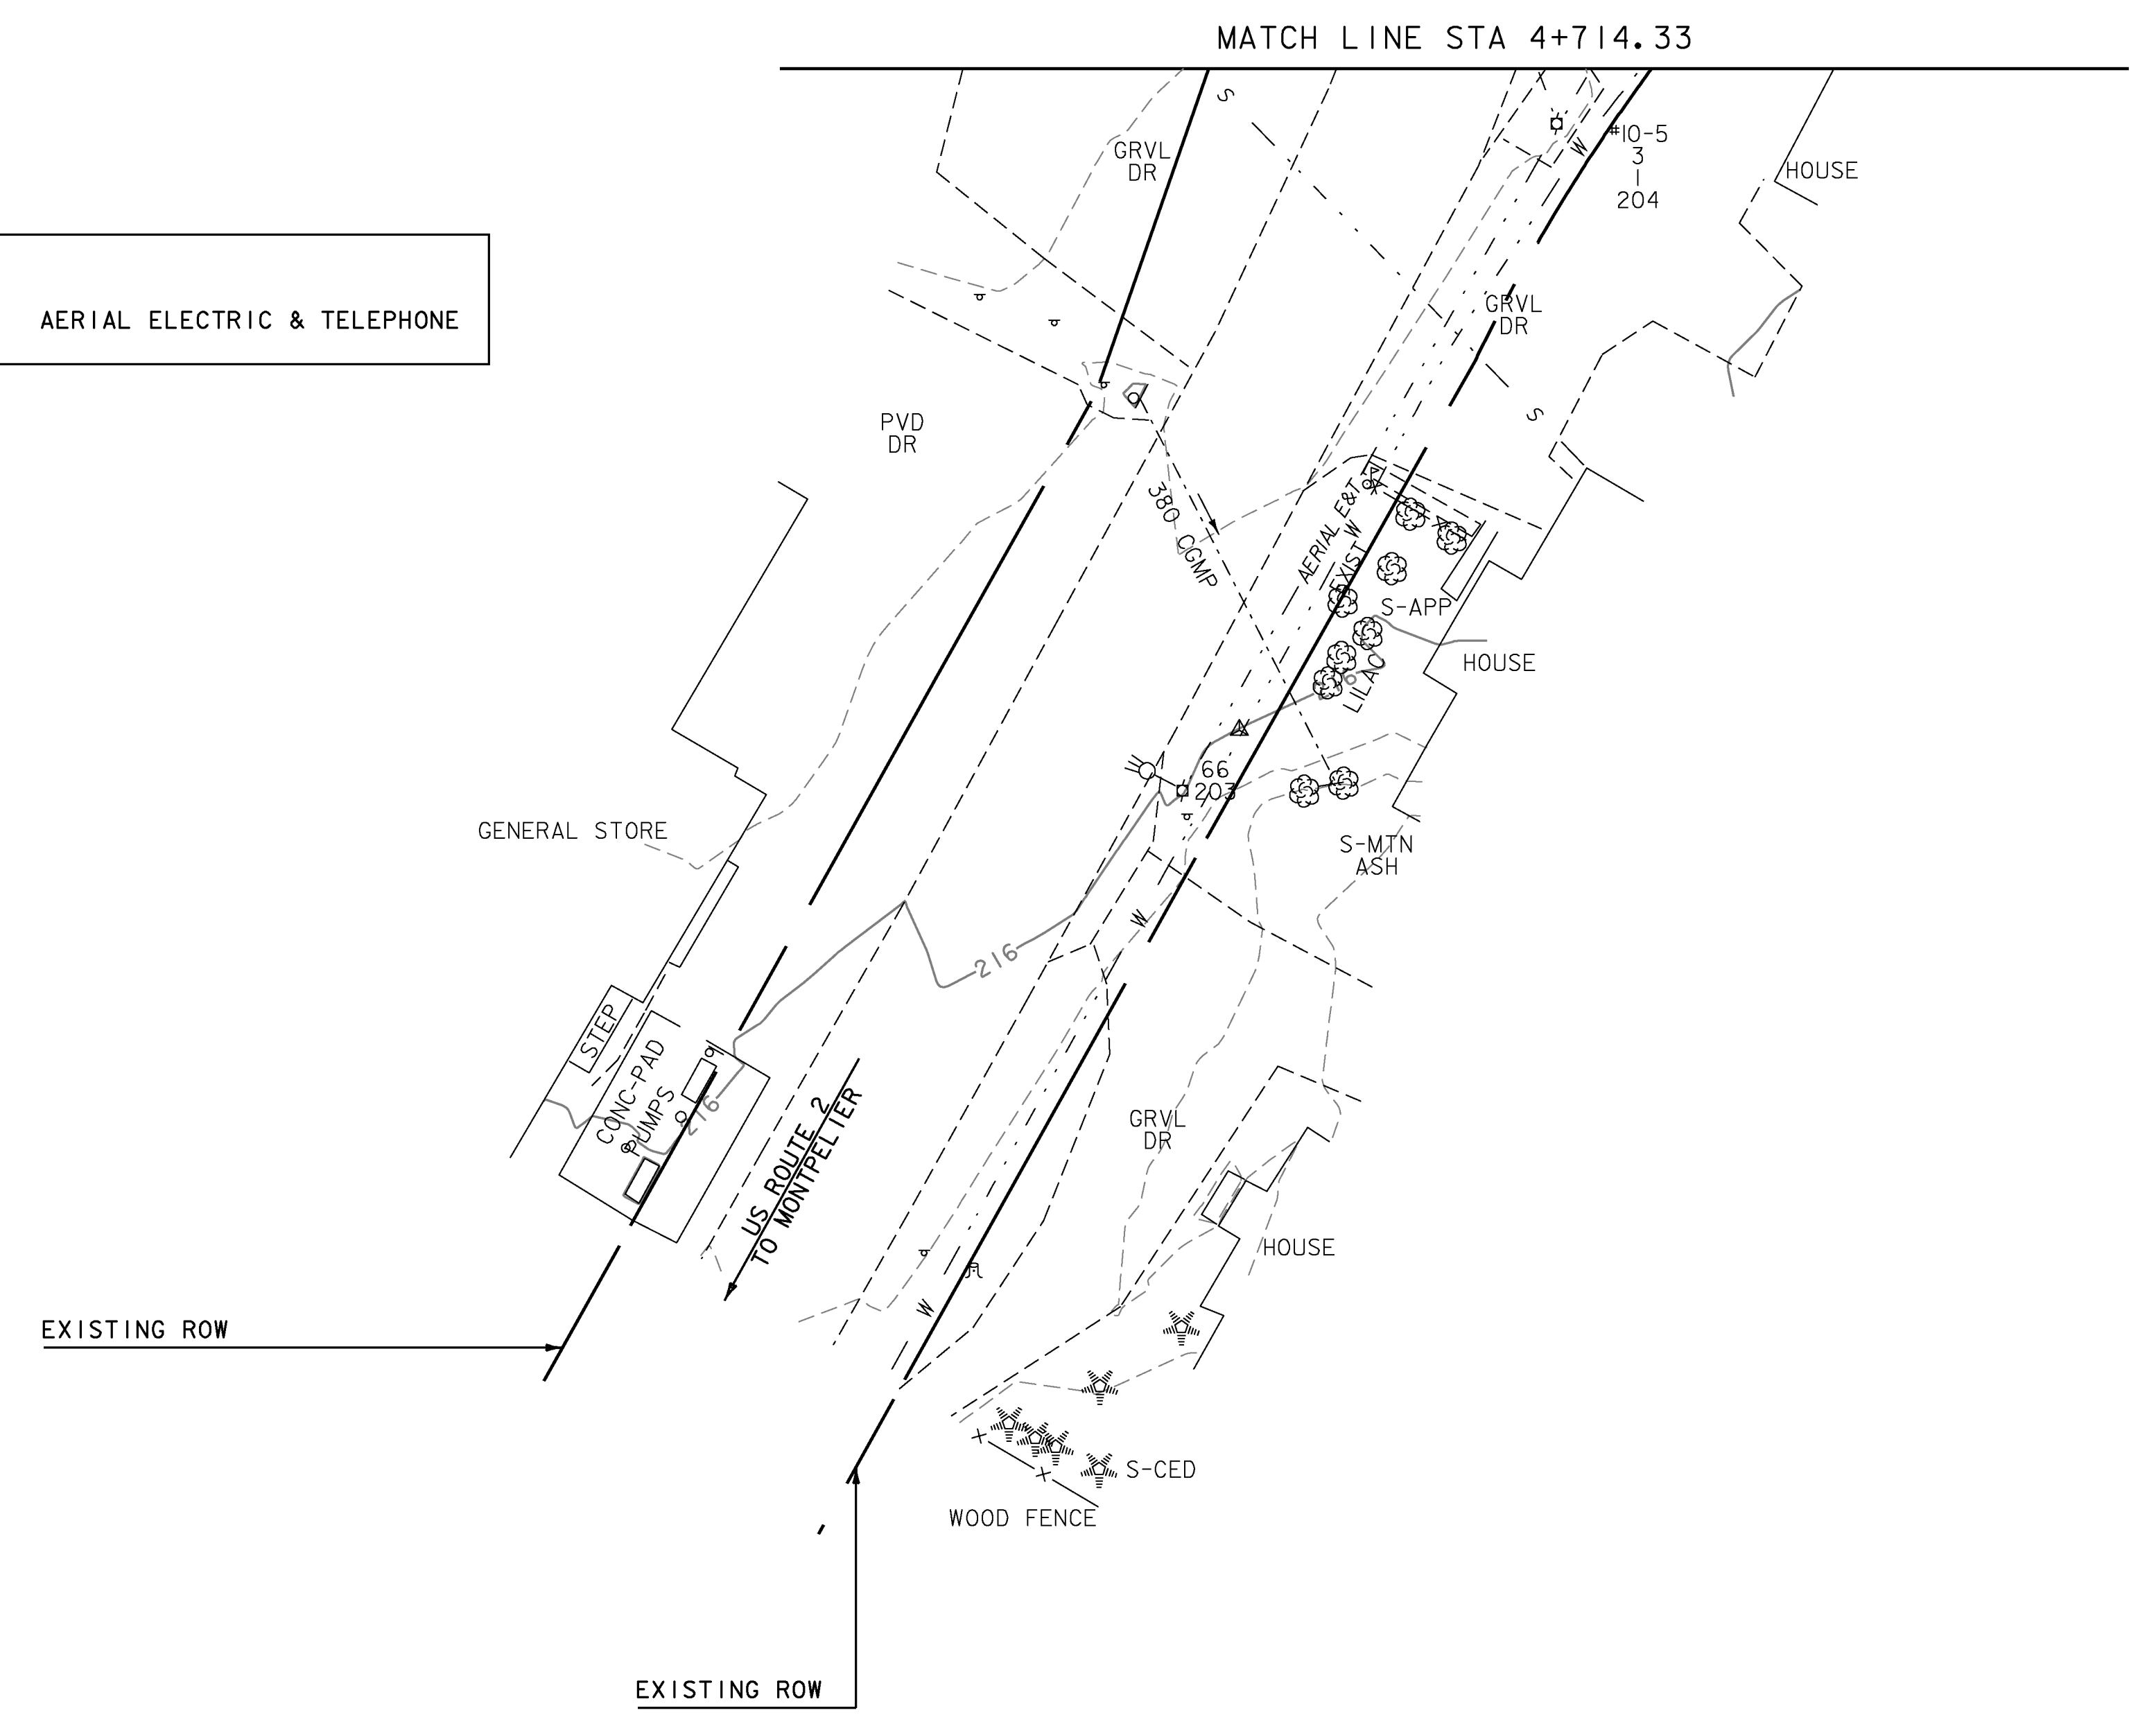


PROJECT NAME:	EAST MONTPELIER	FILE NAME:	+98b028ecexistingbdr.dgn	PLOT DATE:	22-MAR-2010
PROJECT NUMBER:	STPG 028 - 3(35)S	PROJECT LEADER:	J. SCHULTZ	DRAWN BY:	J. DEVLIN
		DESIGNED BY:	J. GRUCHACZ	CHECKED BY:	J. SCHULTZ
		EPSC EXISTING CONDITIONS SHEET 1		SHEET	49 OF 142

MATCH LINE STA 100+67.63

MATCH LINE STA 14+093.85



LEGEND
 — AERIAL E&T — AERIAL ELECTRIC & TELEPHONE

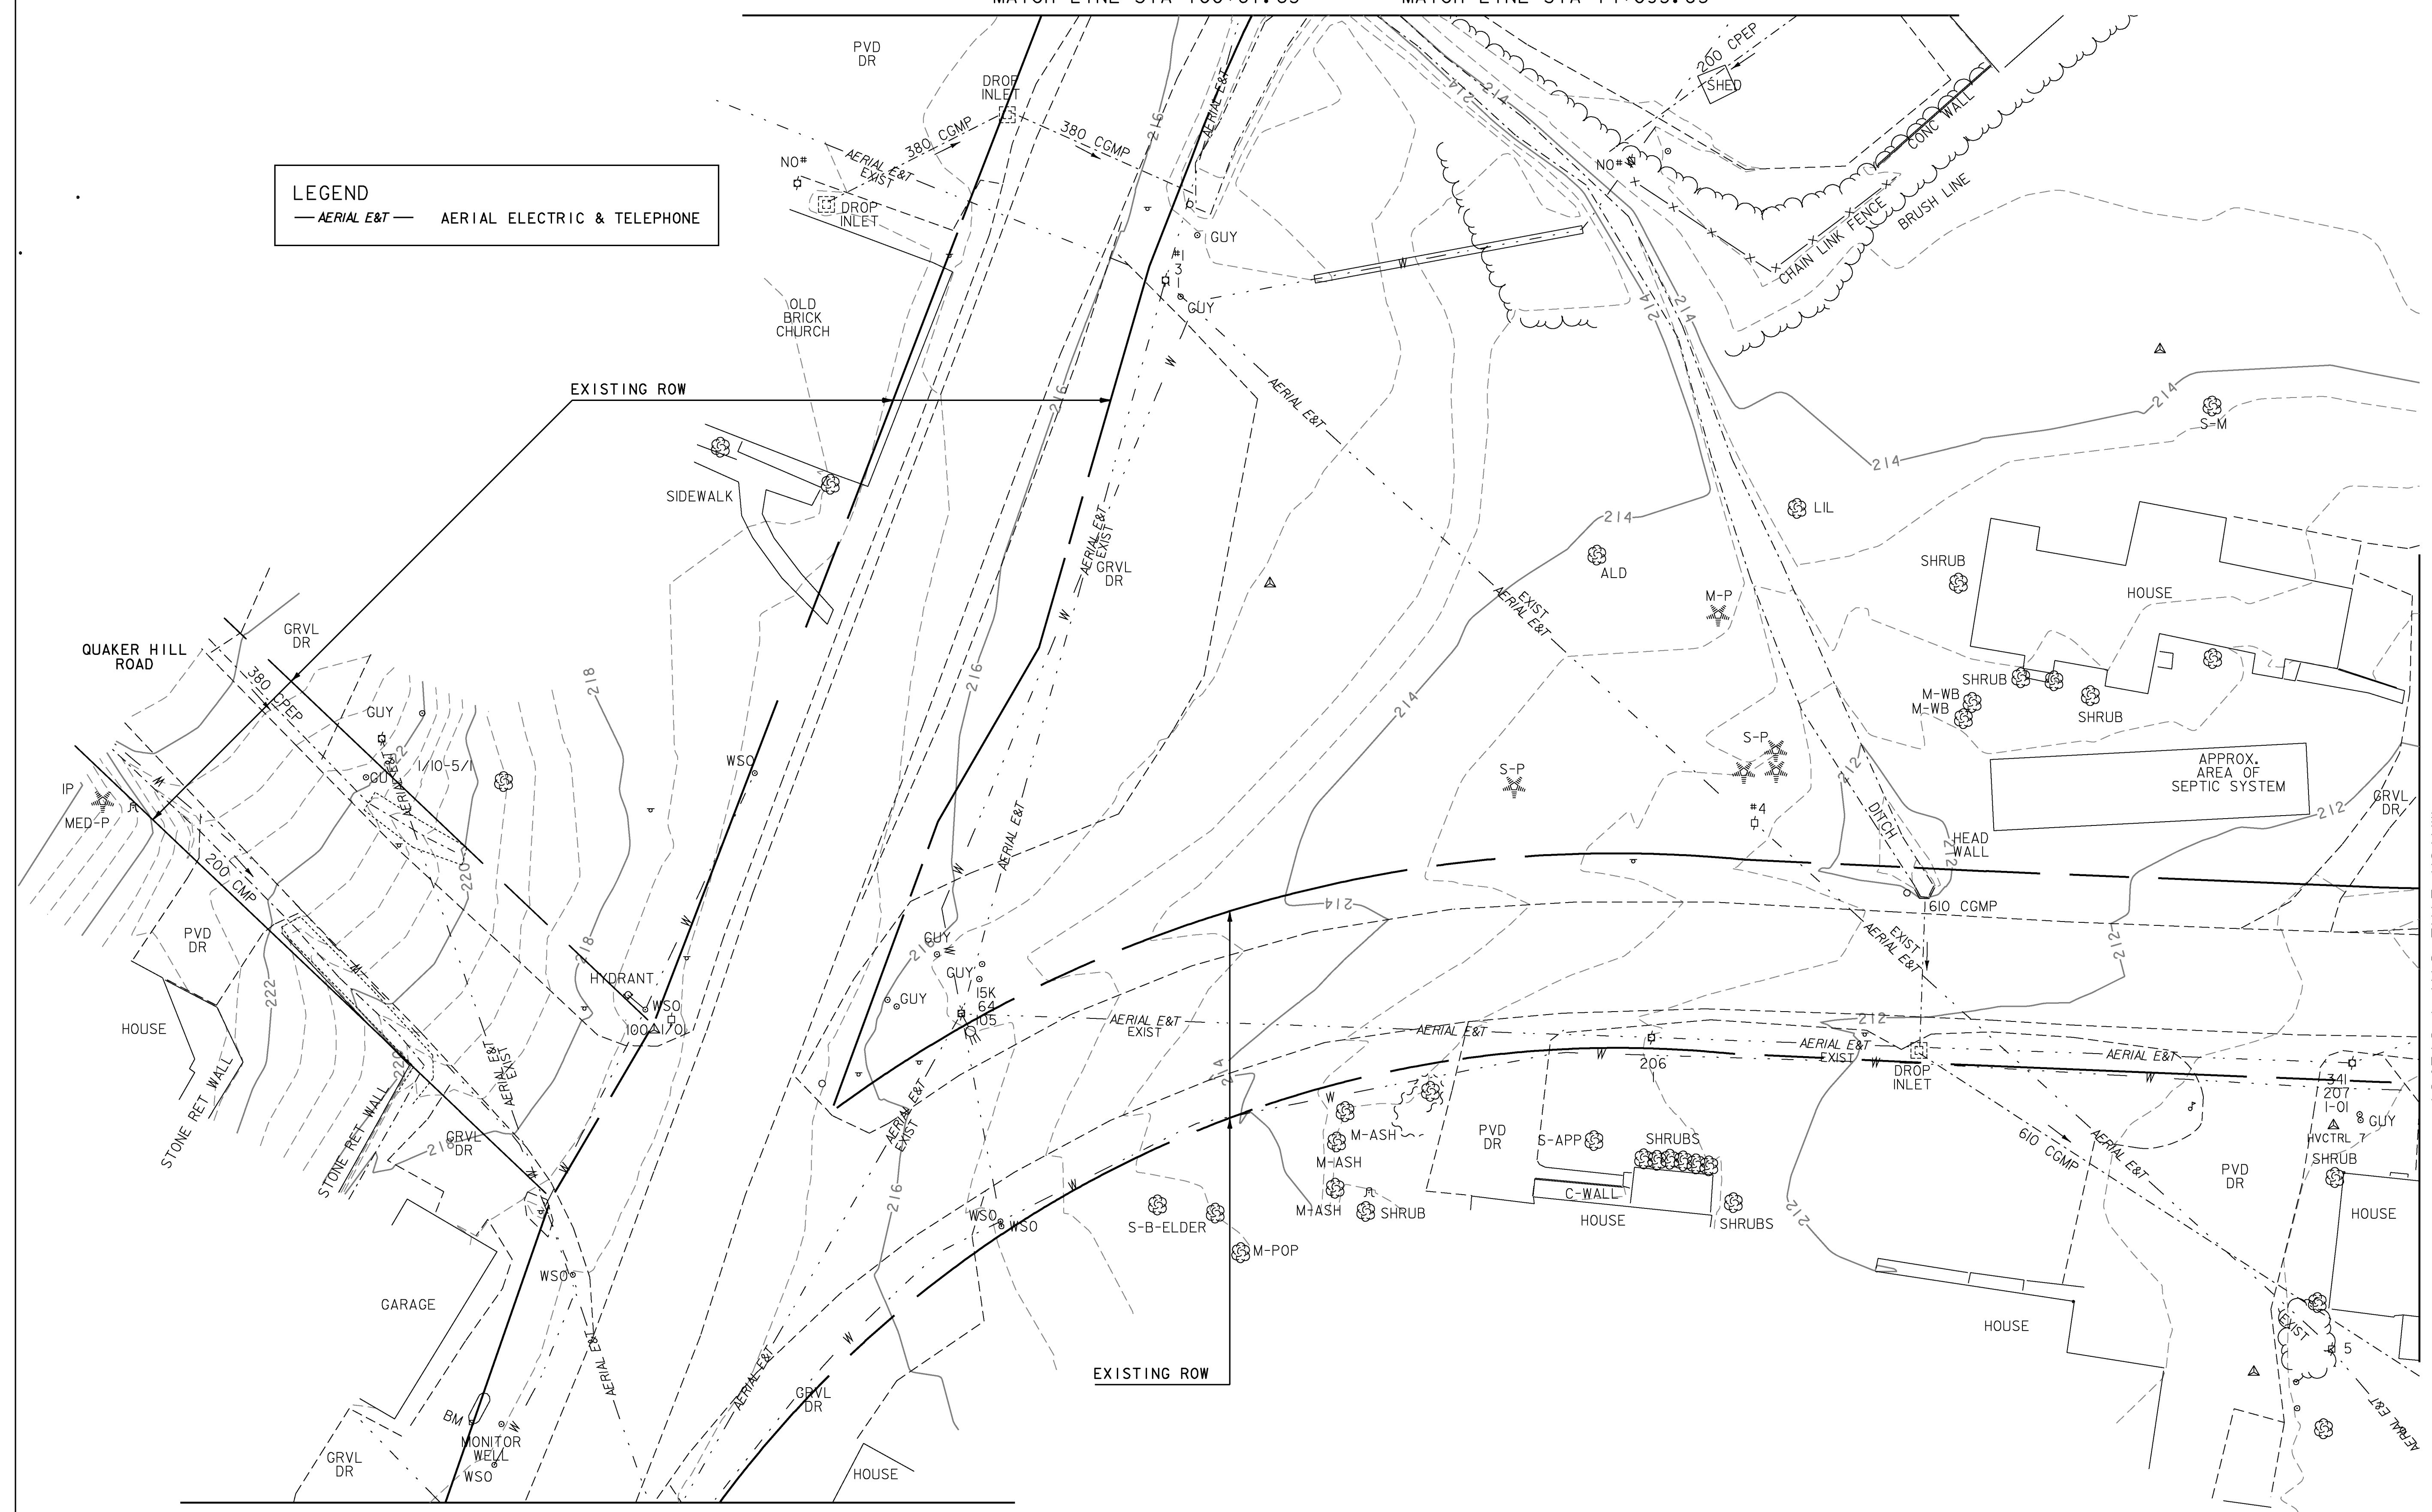

MATCH LINE STA 4+714.33


MATCH LINE STA 4+872.87




PROJECT NAME: EAST MONTPELIER
 PROJECT NUMBER: STPG 028 - 3(35)S
 FILE NAME: +98b028ecexistngbdr.dgn
 PROJECT LEADER: J. SCHULTZ
 DESIGNED BY: J. GRUCHACZ
 EPSC EXISTING CONDITIONS SHEET 2
 PLOT DATE: 22-MAR-2010
 DRAWN BY: J. DEVLIN
 CHECKED BY: J. SCHULTZ
 SHEET 50 OF 142




LEGEND
 — AERIAL E&T — AERIAL ELECTRIC & TELEPHONE

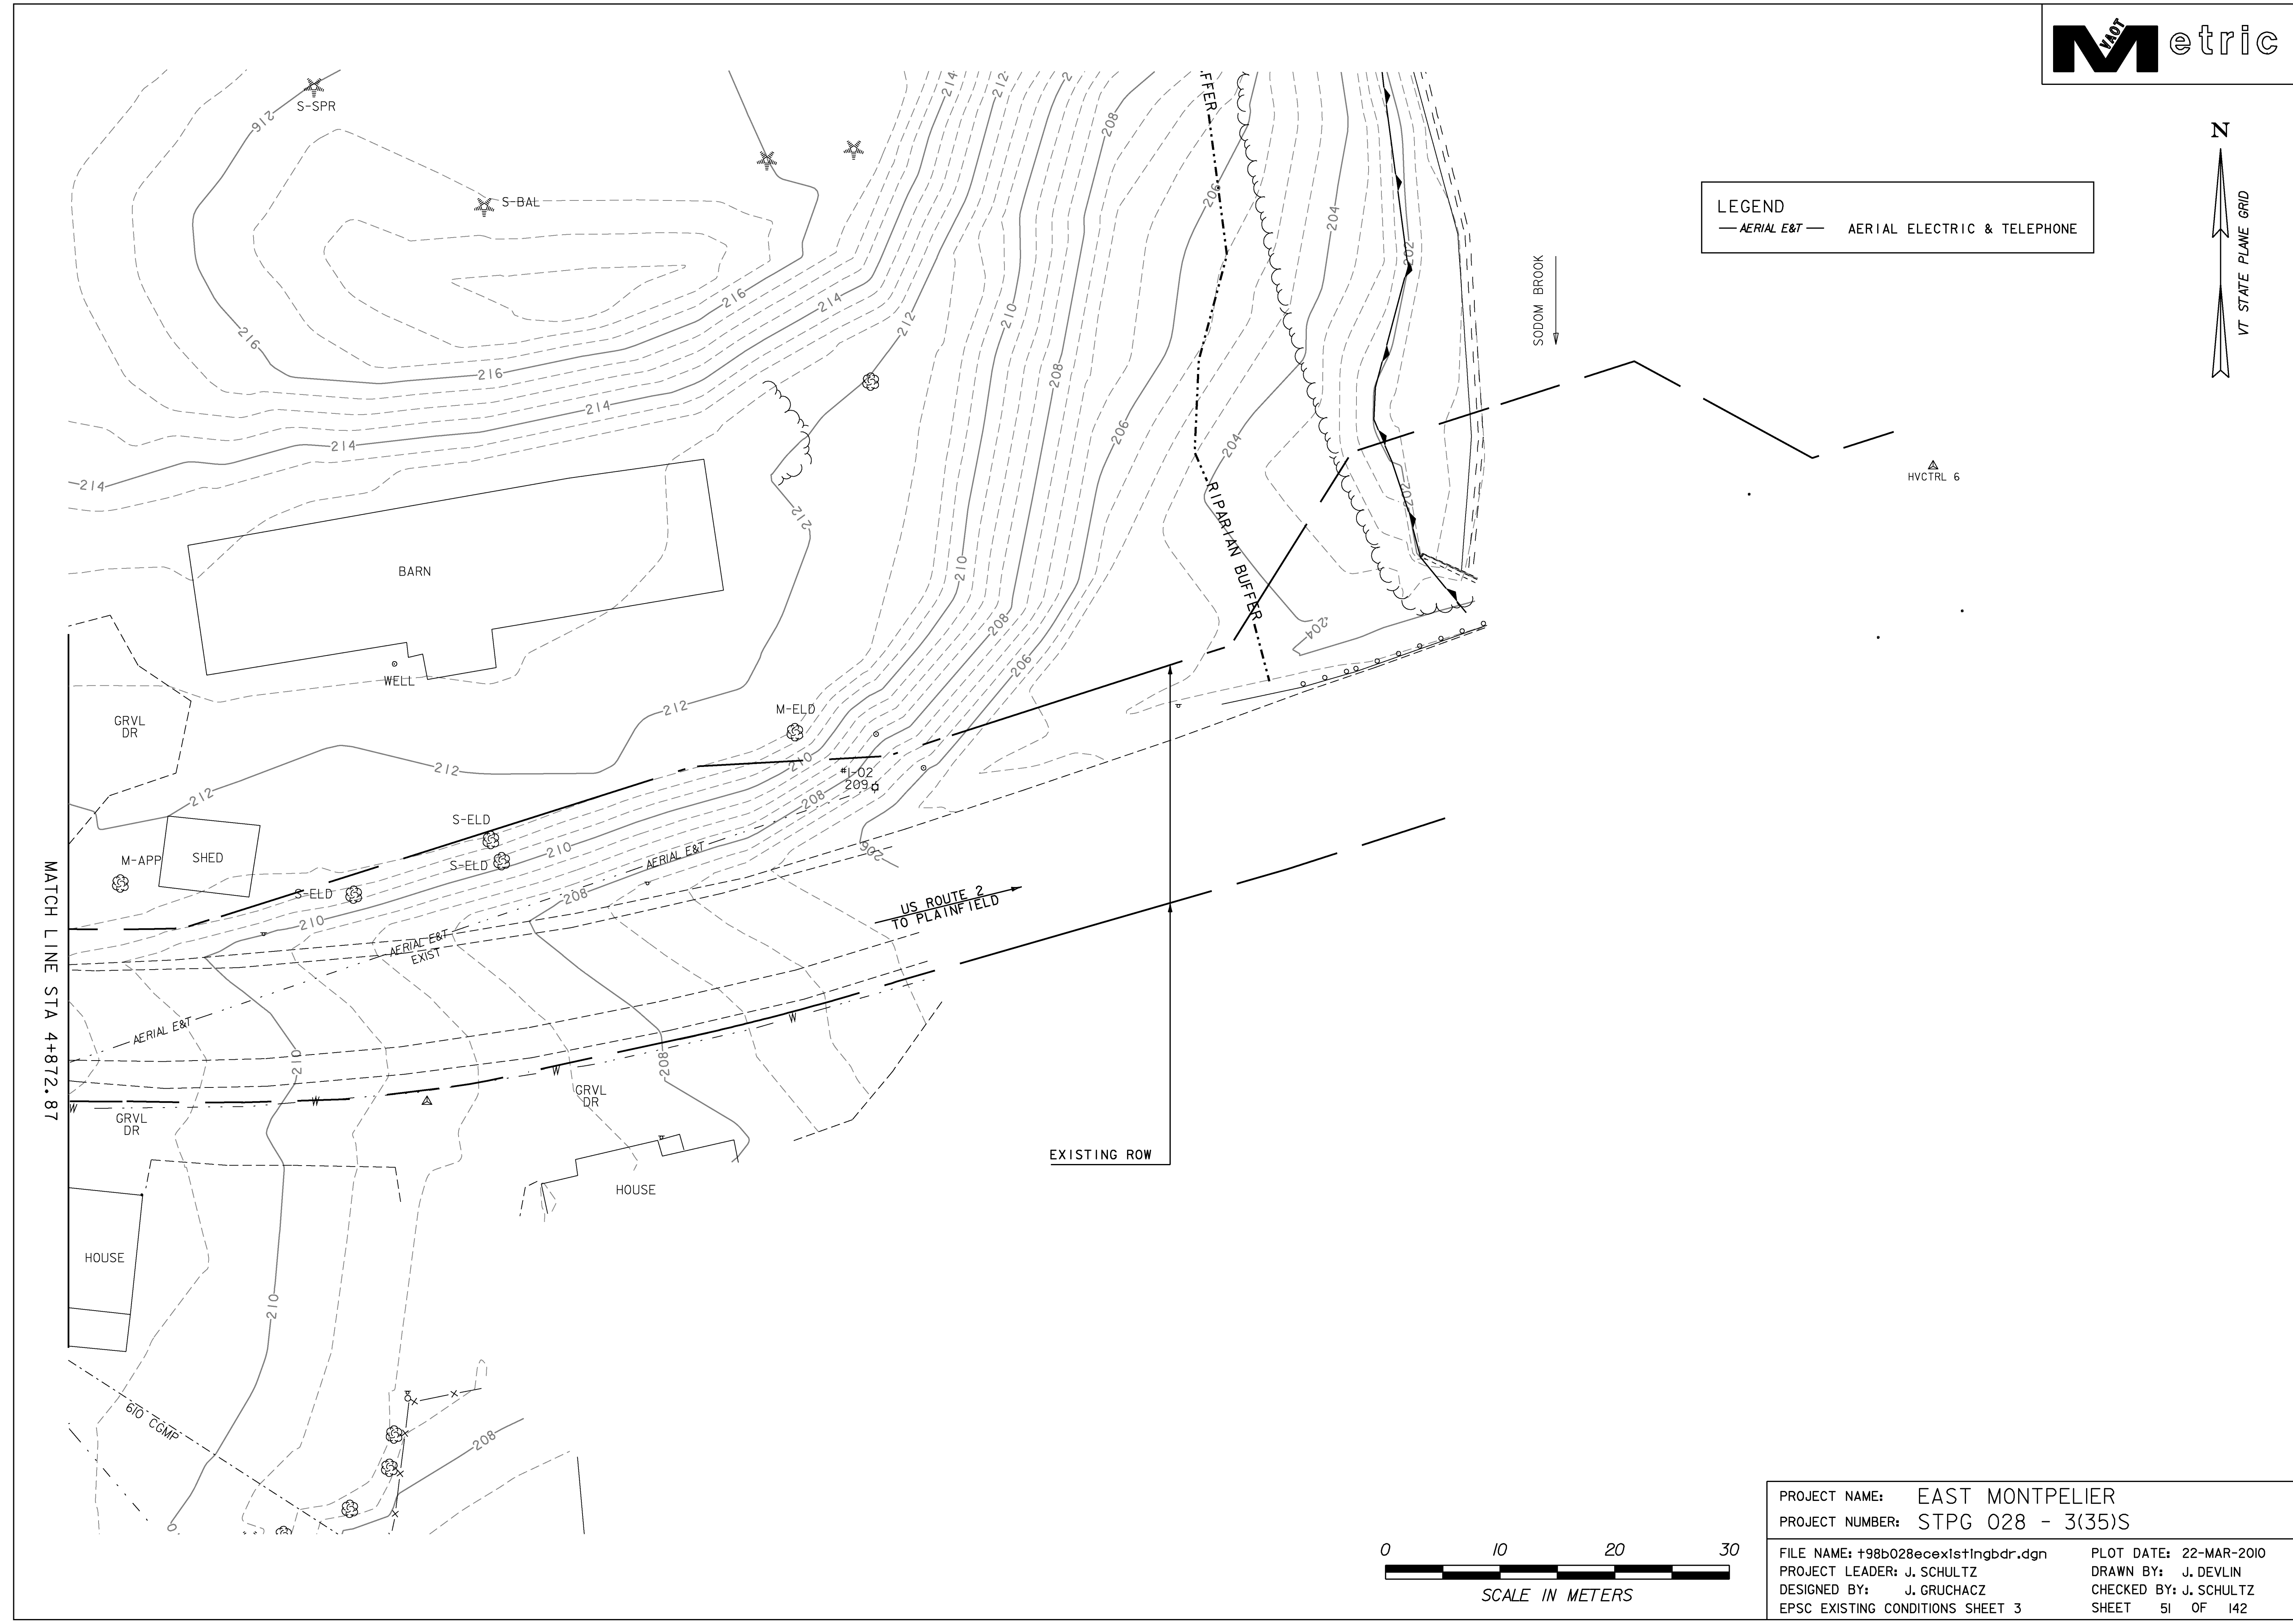

PROJECT NAME: EAST MONTPELIER	PLLOT DATE: 22-MAR-2010
PROJECT NUMBER: STPG 028 - 3(35)S	DRAWN BY: J. DEVLIN
FILE NAME: +98b028ecexist+ingbdr.dgn	CHECKED BY: J. SCHULTZ
PROJECT LEADER: J. SCHULTZ	SHEET 51 OF 142
DESIGNED BY: J. GRUCHACZ	
EPSC EXISTING CONDITIONS SHEET 3	

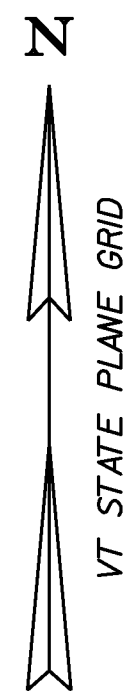


LEGEND
 — AERIAL E&T — AERIAL ELECTRIC & TELEPHONE

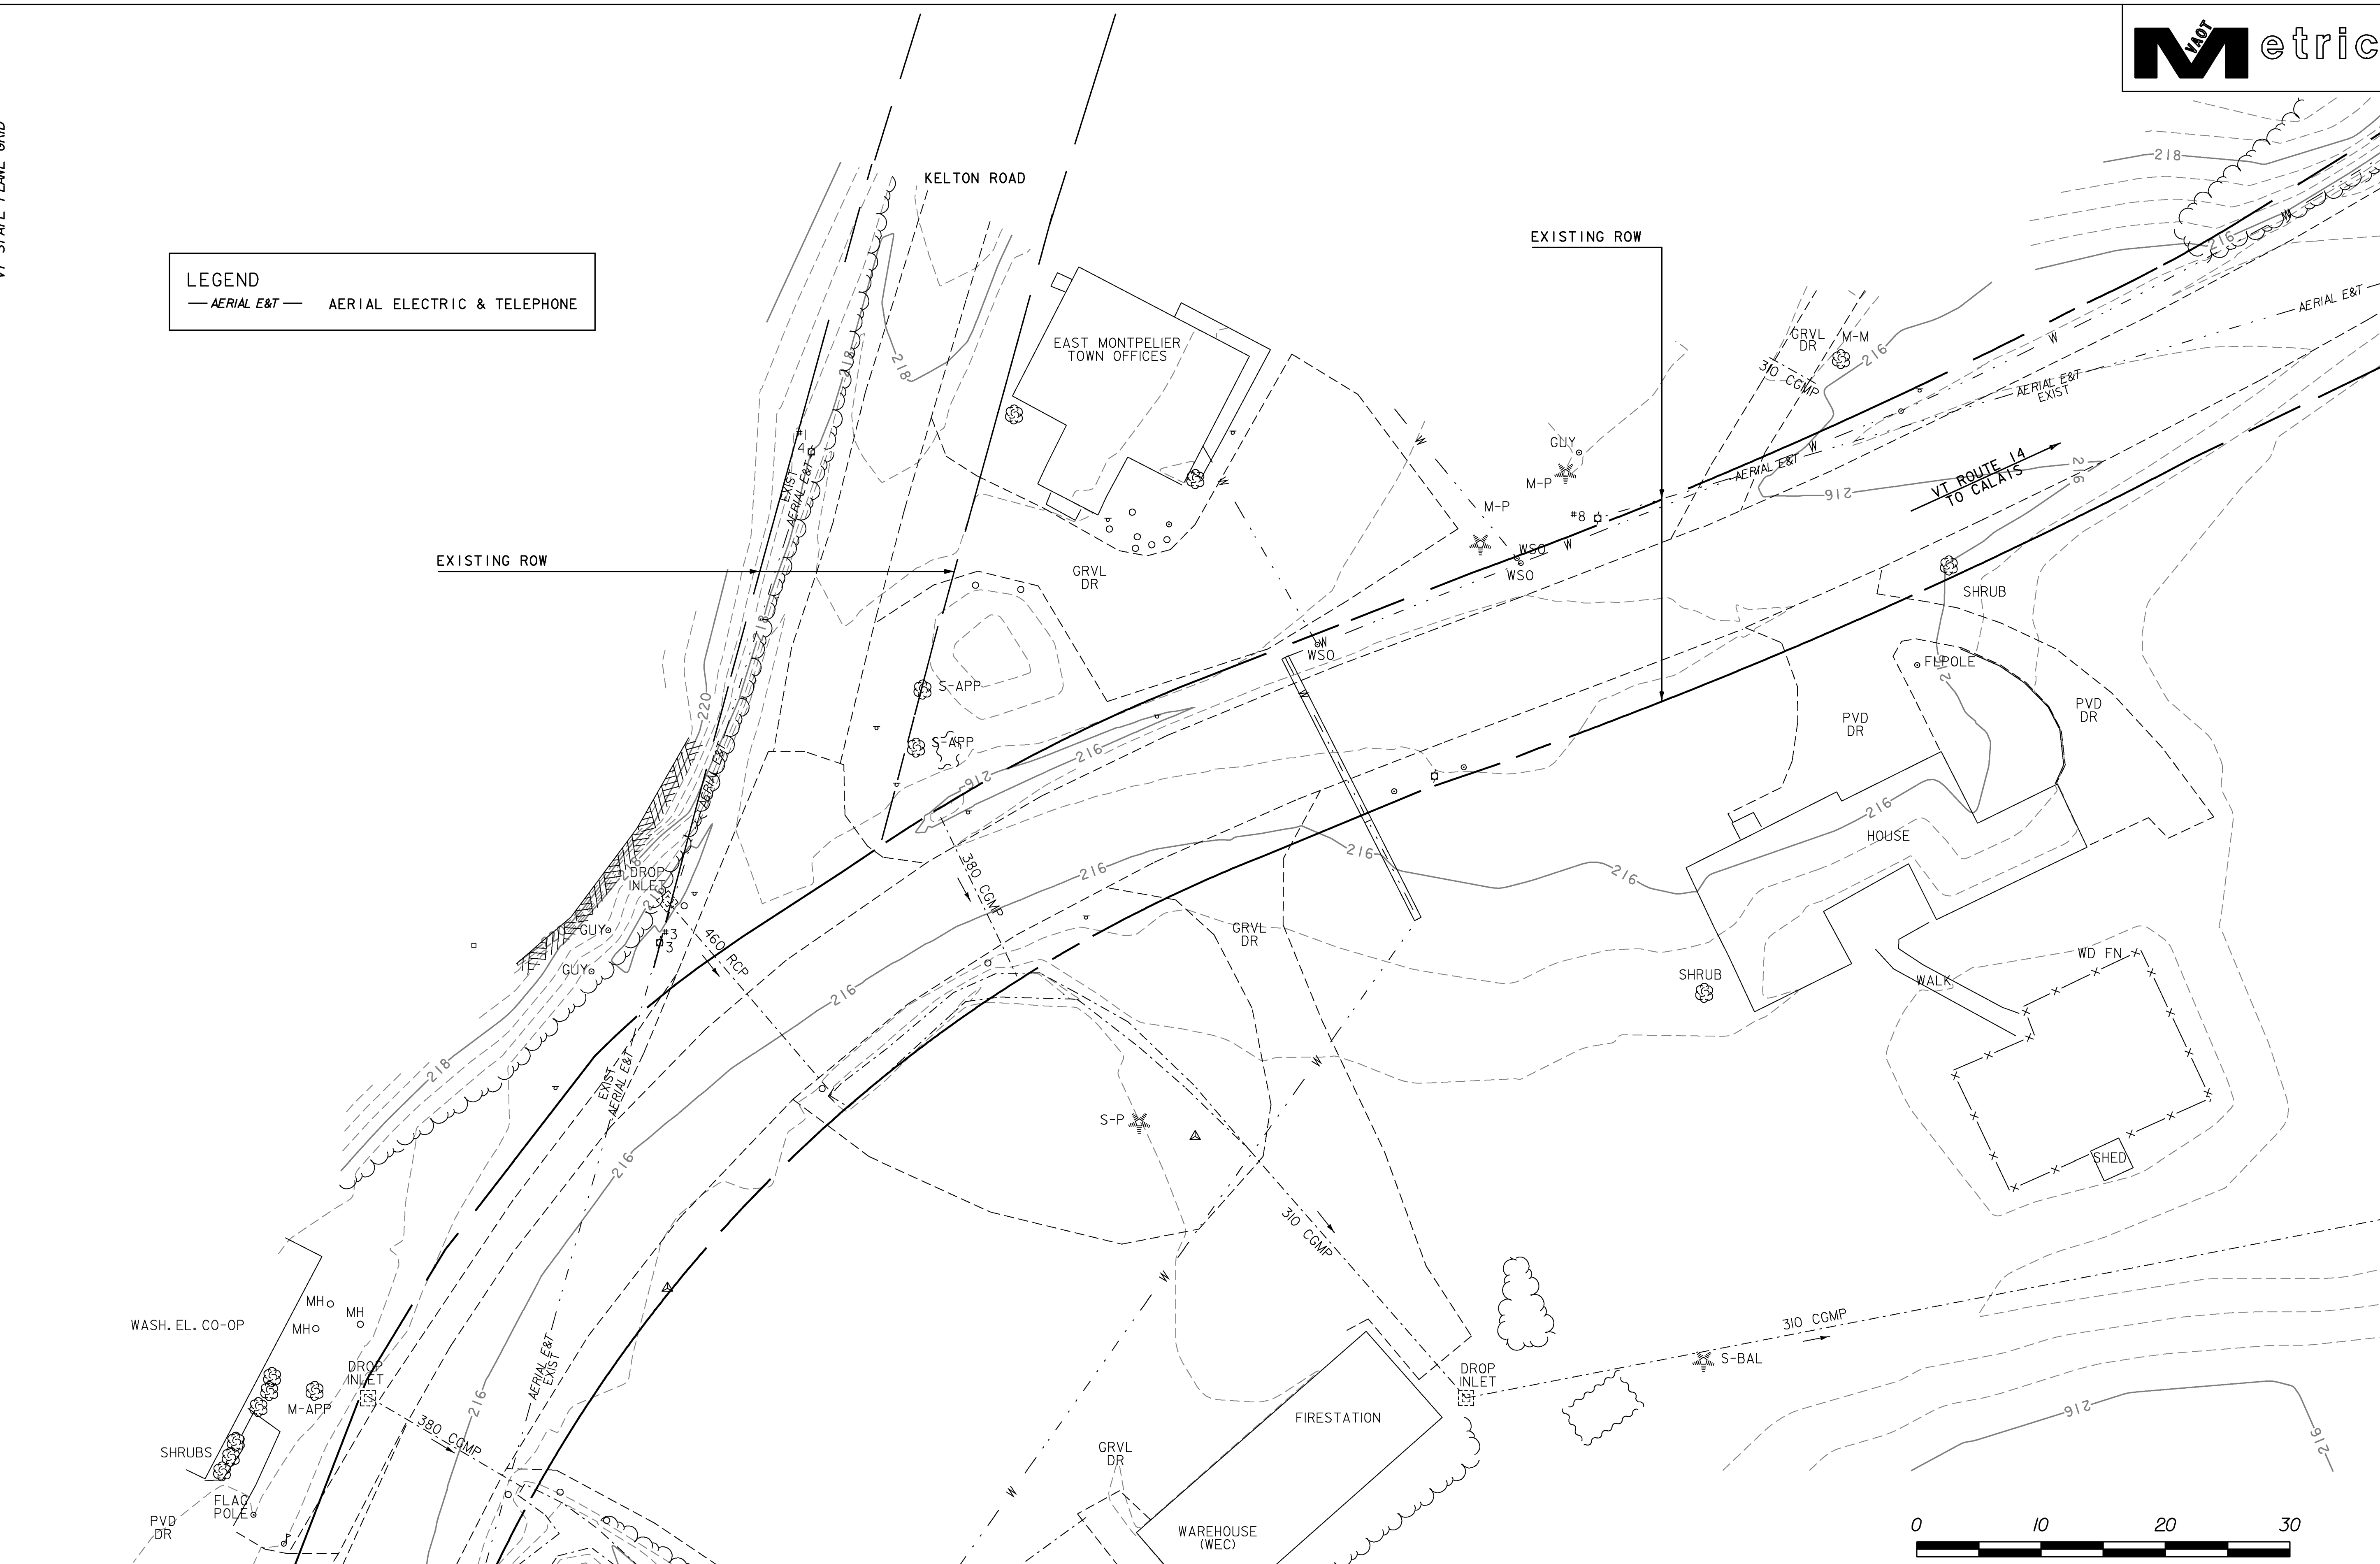



MATCH LINE STA 100+67.63 MATCH LINE STA 14+093.85

PROJECT NAME: EAST MONTPELIER	
PROJECT NUMBER: STPG 028 - 3(35)S	
FILE NAME: +98b028ecexistngbdr.dgn	PLOT DATE: 22-MAR-2010
PROJECT LEADER: J. SCHULTZ	DRAWN BY: J. DEVLIN
DESIGNED BY: J. GRUCHACZ	CHECKED BY: J. SCHULTZ
EPSC EXISTING CONDITIONS SHEET 4	SHEET 52 OF 142

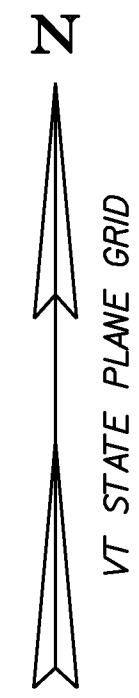

SOIL CLASSIFICATION
 DUMMERSTON FINE SANDY LOAM
 15-25% SLOPES
 HYDROGROUP B
 "K FACTOR" 0.32
 MODERATE ERODIABILITY

SOIL CLASSIFICATION
 ADAMS LOAMY FINE SAND
 3-8% SLOPES
 HYDROGROUP A
 "K FACTOR" 0.17
 LOW ERODIABILITY

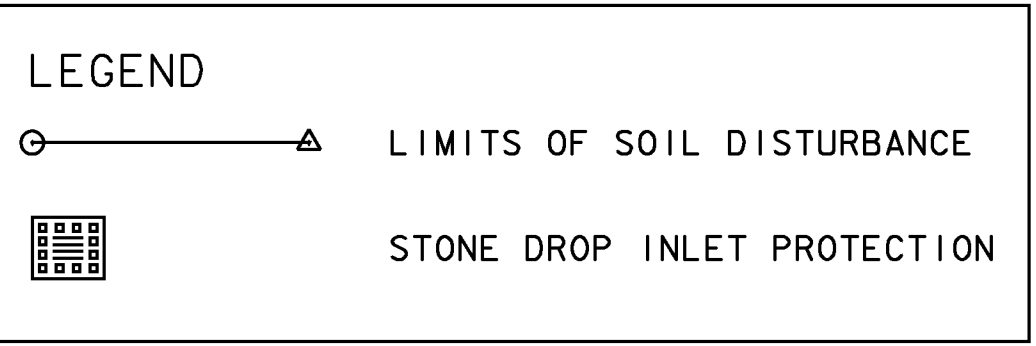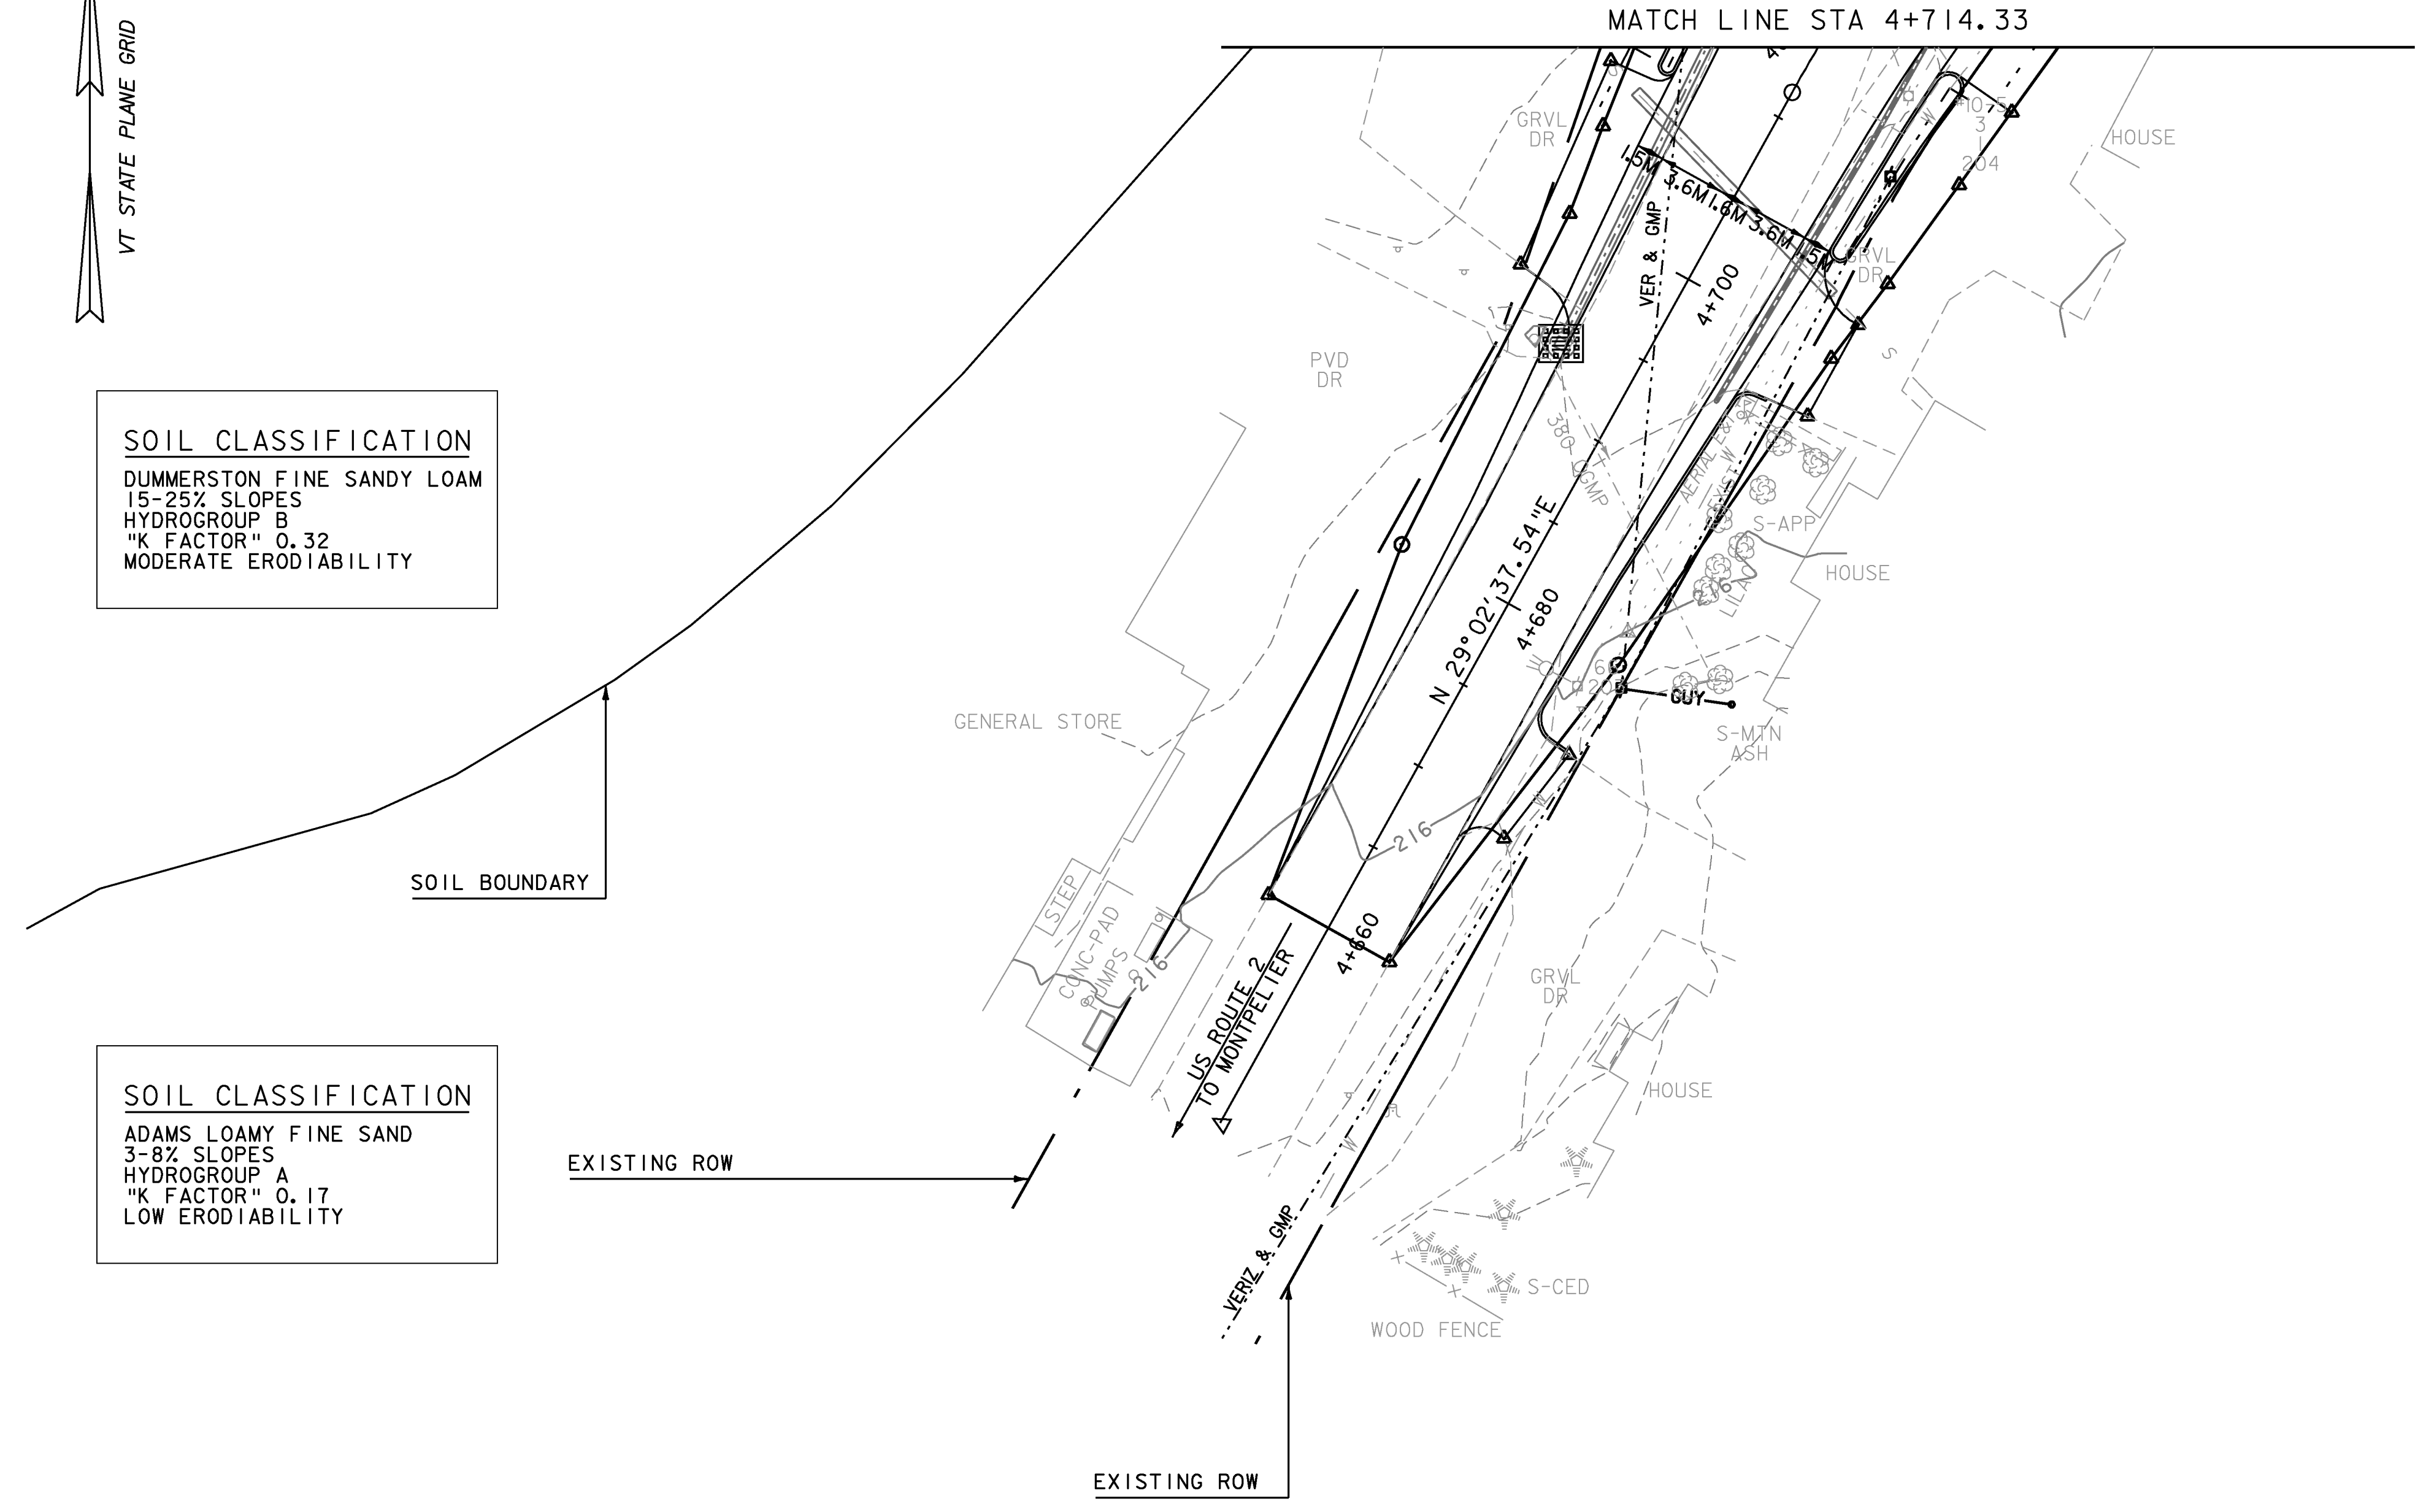

- NOTES:**
1. THESE PLANS SHOW A CONCEPTUAL EROSION CONTROL PLAN, THE CONTRACTOR MUST SUBMIT A TEMPORARY EROSION CONTROL PLAN FOR APPROVAL.
 2. TEMPORARY EROSION CONTROL MEASURES ARE CONCEPTUALLY SHOWN. THE CONTRACTOR MAY RELOCATE TEMPORARY MEASURES TO IMPROVE EROSION CONTROL WITH APPROVAL OF THE RESIDENT ENGINEER AND ON SITE COORDINATOR. SILT FENCE SHALL NOT BE INSTALLED ACROSS CONTOURS.
 3. THE CONTRACTOR SHALL USE OTHER TEMPORARY EROSION CONTROL MEASURES AS NECESSITATED BY THE SEQUENCE OF CONSTRUCTION OR AS DIRECTED BY THE RESIDENT ENGINEER AND ON SITE COORDINATOR.
 4. REFER TO TEMPORARY EROSION CONTROL DETAIL SHEETS FOR ADDITIONAL DETAILS.

653.40 - INLET PROTECTION DEVICE, TYPE I
 STA 4+693.66 LT



PROJECT NAME:	EAST MONTEPELIER
PROJECT NUMBER:	STPG 028 - 3(35)S
FILE NAME:	+98b028econstructonbdr.dgn
PLOT DATE:	22-MAR-2010
PROJECT LEADER:	J. SCHULTZ
DRAWN BY:	J. DEVLIN
DESIGNED BY:	J. GRUCHACZ
CHECKED BY:	J. SCHULTZ
EPSC CONSTRUCTION SHEET 1	SHEET 53 OF 142

NOTES:

1. THESE PLANS SHOW A CONCEPTUAL EROSION CONTROL PLAN, THE CONTRACTOR MUST SUBMIT A TEMPORARY EROSION CONTROL PLAN FOR APPROVAL.
2. TEMPORARY EROSION CONTROL MEASURES ARE CONCEPTUALLY SHOWN. THE CONTRACTOR MAY RELOCATE TEMPORARY MEASURES TO IMPROVE EROSION CONTROL WITH APPROVAL OF THE RESIDENT ENGINEER AND ON SITE COORDINATOR. SILT FENCE SHALL NOT BE INSTALLED ACROSS CONTOURS.
3. THE CONTRACTOR SHALL USE OTHER TEMPORARY EROSION CONTROL MEASURES AS NECESSITATED BY THE SEQUENCE OF CONSTRUCTION OR AS DIRECTED BY THE RESIDENT ENGINEER AND ON SITE COORDINATOR.
4. REFER TO TEMPORARY EROSION CONTROL DETAIL SHEETS FOR ADDITIONAL DETAILS.

LEGEND

- SILT FENCE
- LIMITS OF SOIL DISTURBANCE
- CHECK DAM
- EROSION MATTING
- STONE DROP INLET PROTECTION

SOIL CLASSIFICATION

CABOT SILT LOAM
0-3% SLOPES
HYDROGROUP D
"K FACTOR" 0.32
MODERATE ERODIABILITY

SOIL CLASSIFICATION



SALMON VERY FINE SANDY LOAM
8-15% SLOPES
HYDROGROUP B
"K FACTOR" 0.49
HIGH ERODIABILITY

SOIL CLASSIFICATION

DUMMERSTON FINE SANDY LOAM
15-25% SLOPES
HYDROGROUP B
"K FACTOR" 0.32
MODERATE ERODIABILITY

SOIL CLASSIFICATION

ADAMS LOAMY FINE SAND
3-8% SLOPES
HYDROGROUP A
"K FACTOR" 0.17
LOW ERODIABILITY

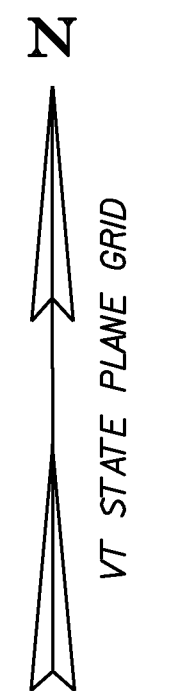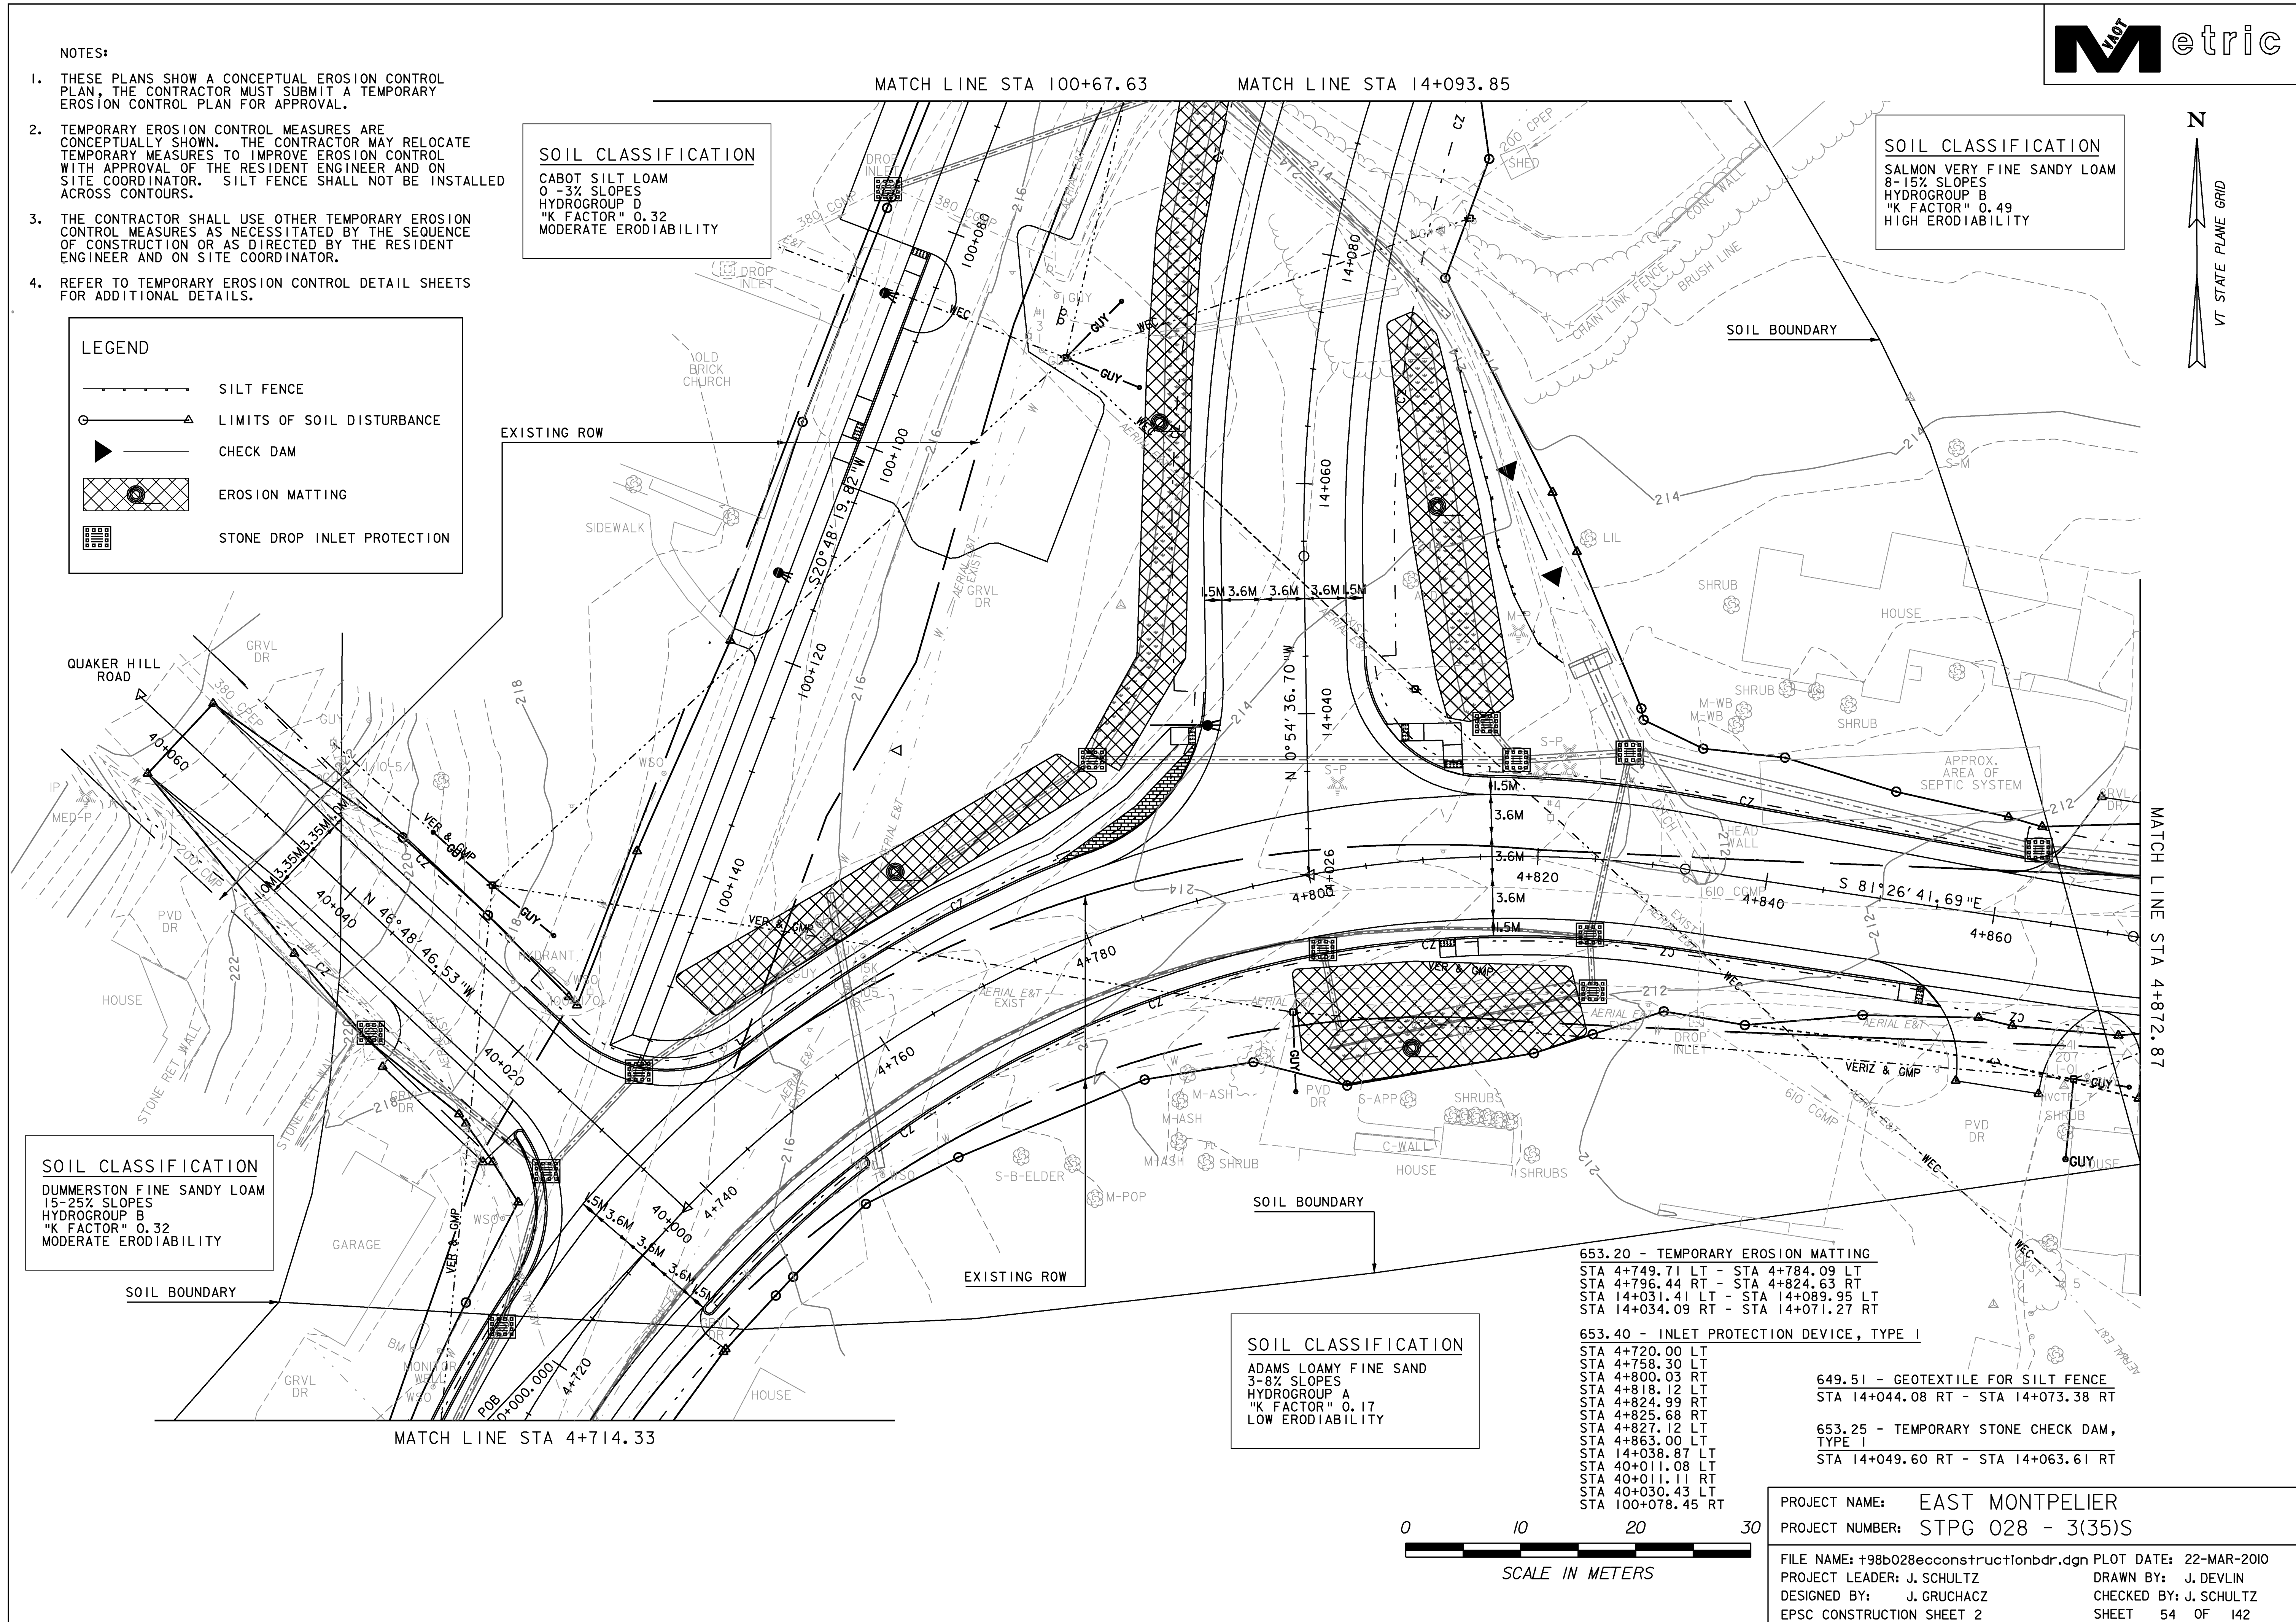


653.20 - TEMPORARY EROSION MATTING
STA 4+749.71 LT - STA 4+784.09 LT
STA 4+796.44 RT - STA 4+824.63 RT
STA 14+031.41 LT - STA 14+089.95 LT
STA 14+034.09 RT - STA 14+071.27 RT

653.40 - INLET PROTECTION DEVICE, TYPE I
STA 4+720.00 LT
STA 4+758.30 LT
STA 4+800.03 RT
STA 4+818.12 LT
STA 4+824.99 RT
STA 4+825.68 RT
STA 4+827.12 LT
STA 4+863.00 LT
STA 14+038.87 LT
STA 40+011.08 LT
STA 40+011.11 RT
STA 40+030.43 LT
STA 100+078.45 RT

649.51 - GEOTEXTILE FOR SILT FENCE
STA 14+044.08 RT - STA 14+073.38 RT

653.25 - TEMPORARY STONE CHECK DAM, TYPE I
STA 14+049.60 RT - STA 14+063.61 RT

PROJECT NAME: EAST MONTPELIER
PROJECT NUMBER: STPG 028 - 3(35)S
FILE NAME: +98b028econstructonbdr.dgn PLOT DATE: 22-MAR-2010
PROJECT LEADER: J. SCHULTZ DRAWN BY: J. DEVLIN
DESIGNED BY: J. GRUCHACZ CHECKED BY: J. SCHULTZ
EPSC CONSTRUCTION SHEET 2 SHEET 54 OF 142

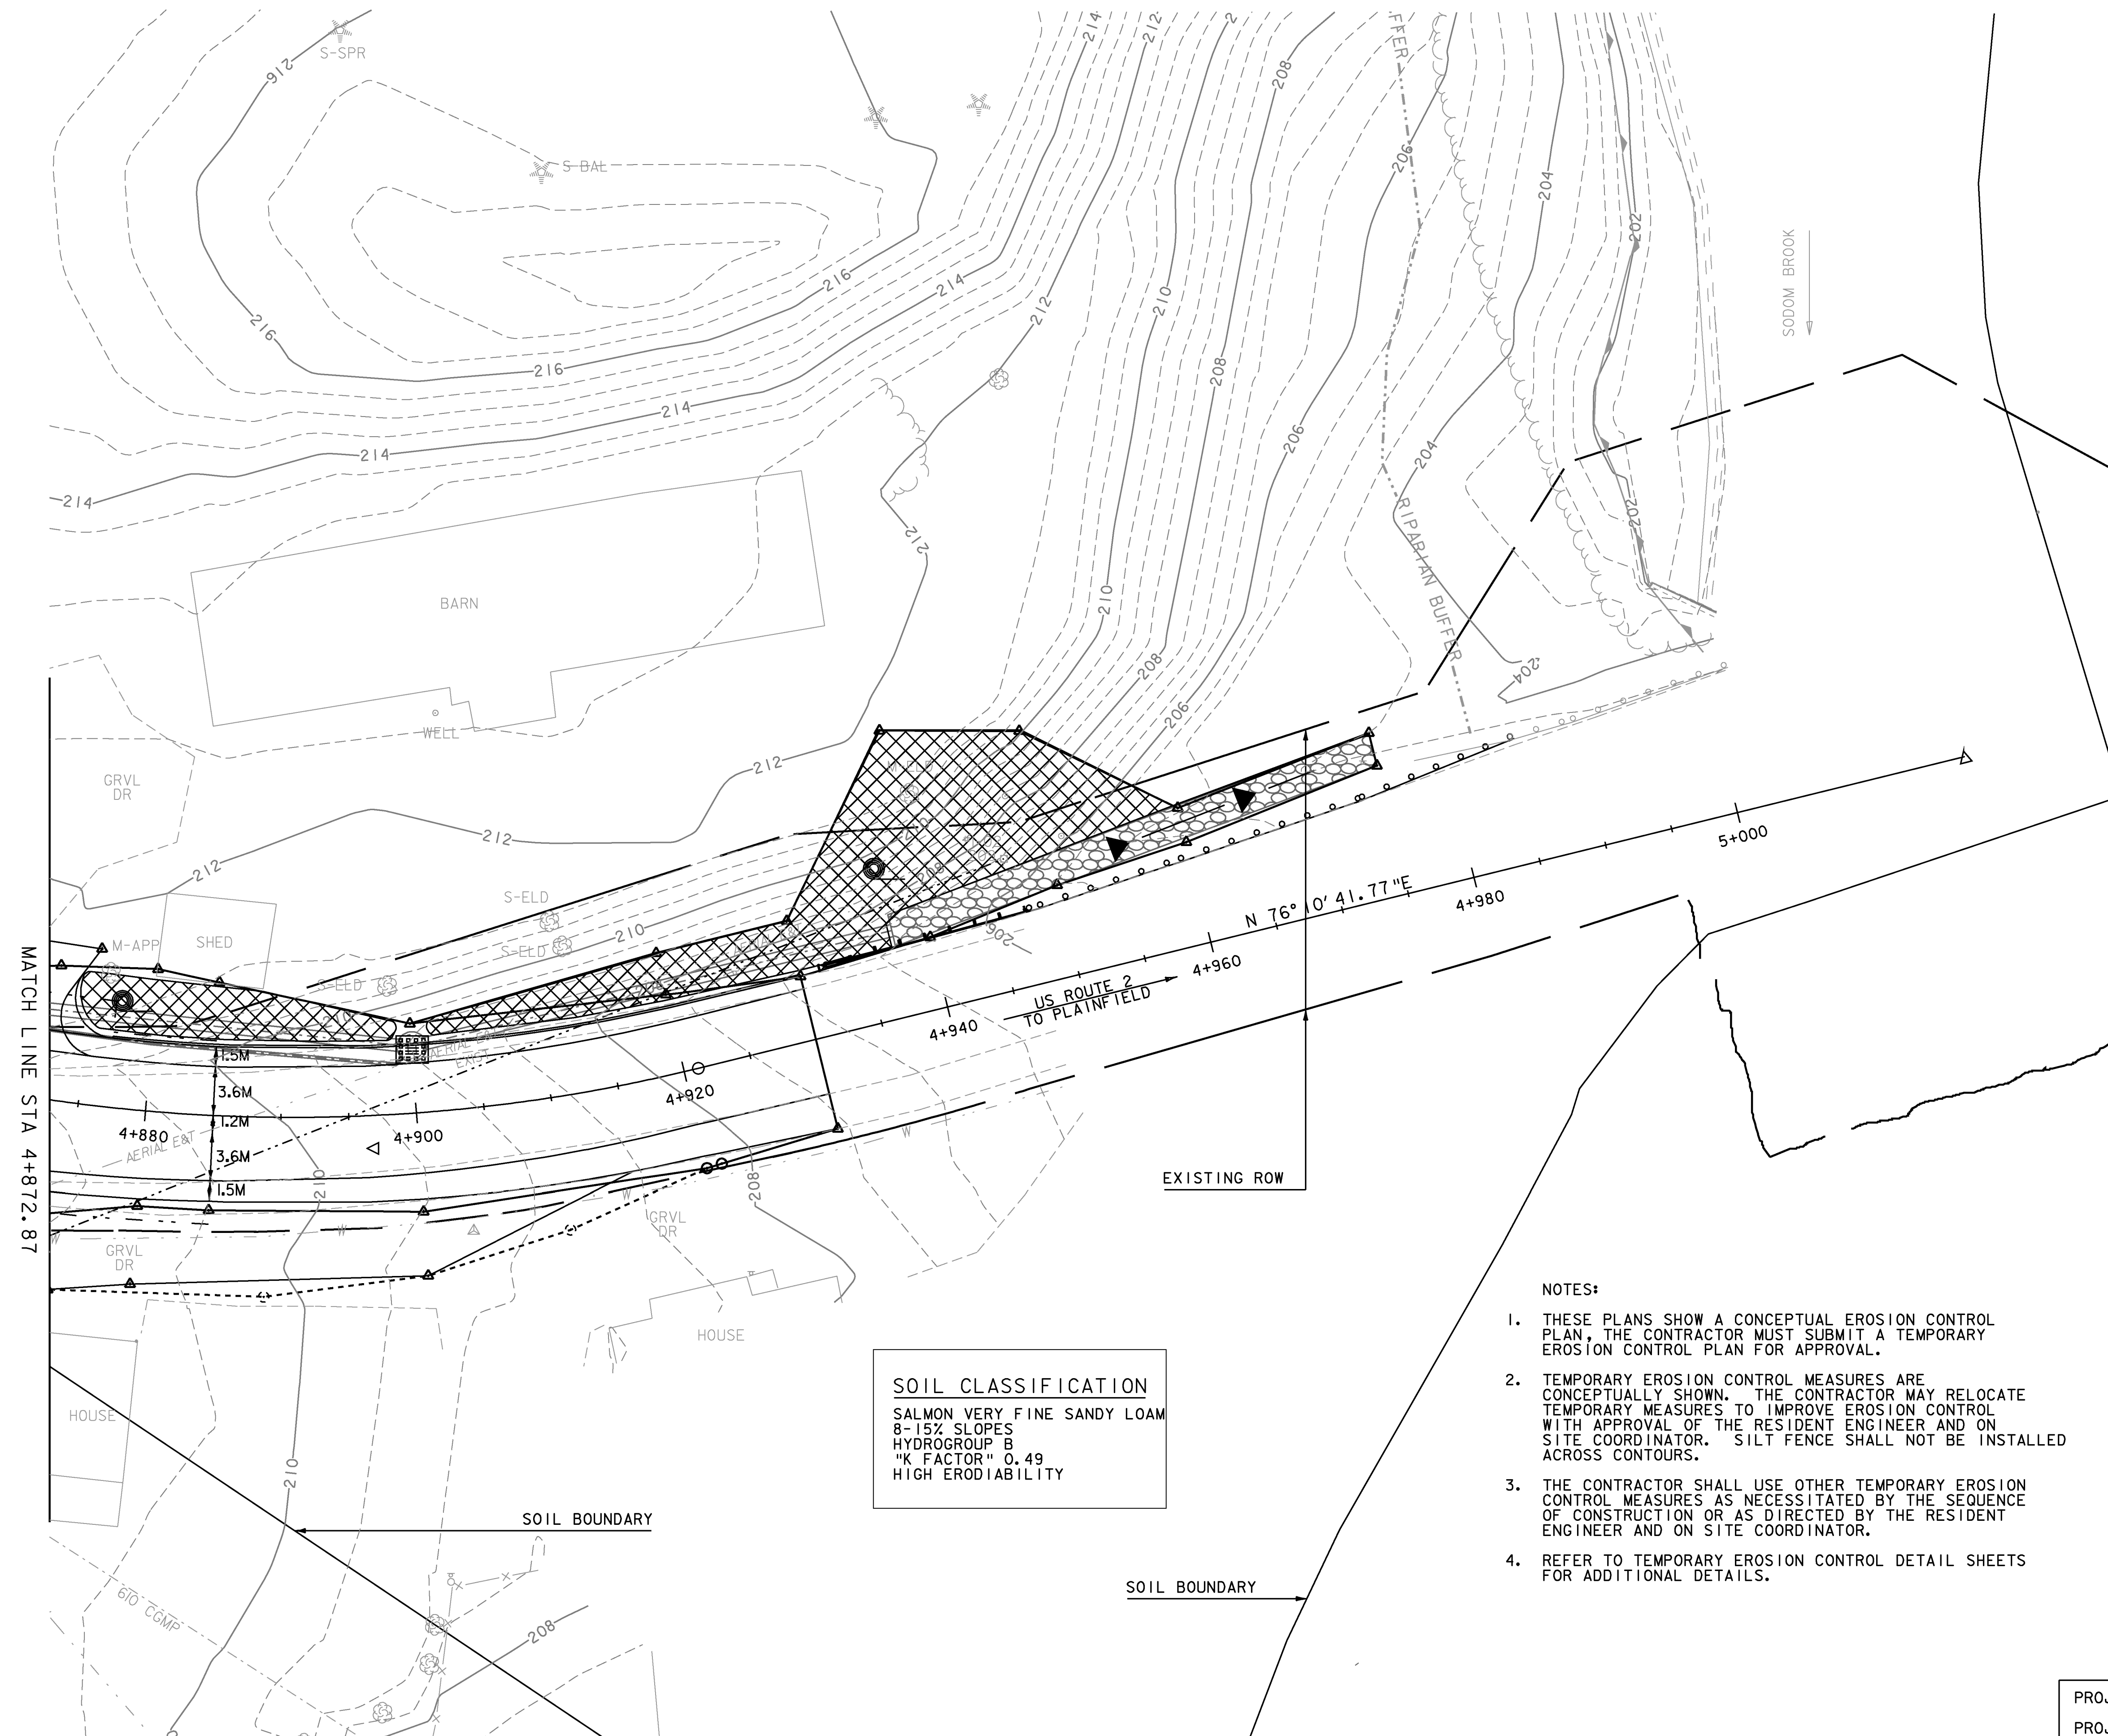

SOIL CLASSIFICATION
 SALMON VERY FINE SANDY LOAM
 8-15% SLOPES
 HYDROGROUP B
 "K FACTOR" 0.49
 HIGH ERODIABILITY

- 653.20 - TEMPORARY EROSION MATTING
 STA 4+874.06 LT - STA 4+899.10 LT
 STA 4+900.91 LT - STA 4+974.92 LT
- 653.25 - TEMPORARY STONE CHECK DAM, TYPE I
 STA 4+953.46 LT - STA 4+970.43 LT
- 653.40 - INLET PROTECTION DEVICE, TYPE I
 STA 4+900.02 LT


- NOTES:**
1. THESE PLANS SHOW A CONCEPTUAL EROSION CONTROL PLAN. THE CONTRACTOR MUST SUBMIT A TEMPORARY EROSION CONTROL PLAN FOR APPROVAL.
 2. TEMPORARY EROSION CONTROL MEASURES ARE CONCEPTUALLY SHOWN. THE CONTRACTOR MAY RELOCATE TEMPORARY MEASURES TO IMPROVE EROSION CONTROL WITH APPROVAL OF THE RESIDENT ENGINEER AND ON SITE COORDINATOR. SILT FENCE SHALL NOT BE INSTALLED ACROSS CONTOURS.
 3. THE CONTRACTOR SHALL USE OTHER TEMPORARY EROSION CONTROL MEASURES AS NECESSITATED BY THE SEQUENCE OF CONSTRUCTION OR AS DIRECTED BY THE RESIDENT ENGINEER AND ON SITE COORDINATOR.
 4. REFER TO TEMPORARY EROSION CONTROL DETAIL SHEETS FOR ADDITIONAL DETAILS.

LEGEND

- LIMITS OF SOIL DISTURBANCE
- CHECK DAM
- EROSION MATTING
- STONE DROP INLET PROTECTION



PROJECT NAME: EAST MONTPELIER
 PROJECT NUMBER: STPG 028 - 3(35)
 FILE NAME: +98b028econstructionbdr.dgn PLOT DATE: 22-MAR-2010
 PROJECT LEADER: J. SCHULTZ DRAWN BY: J. DEVLIN
 DESIGNED BY: J. GRUCHACZ CHECKED BY: J. SCHULTZ
 EPSC CONSTRUCTION SHEET 3 SHEET 55 OF 142

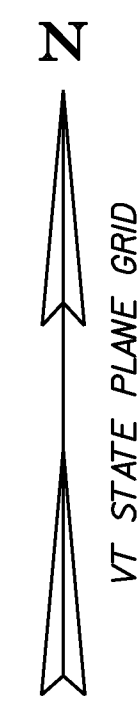

- NOTES:
1. THESE PLANS SHOW A CONCEPTUAL EROSION CONTROL PLAN. THE CONTRACTOR MUST SUBMIT A TEMPORARY EROSION CONTROL PLAN FOR APPROVAL.
 2. TEMPORARY EROSION CONTROL MEASURES ARE CONCEPTUALLY SHOWN. THE CONTRACTOR MAY RELOCATE TEMPORARY MEASURES TO IMPROVE EROSION CONTROL WITH APPROVAL OF THE RESIDENT ENGINEER AND ON SITE COORDINATOR. SILT FENCE SHALL NOT BE INSTALLED ACROSS CONTOURS.
 3. THE CONTRACTOR SHALL USE OTHER TEMPORARY EROSION CONTROL MEASURES AS NECESSITATED BY THE SEQUENCE OF CONSTRUCTION OR AS DIRECTED BY THE RESIDENT ENGINEER AND ON SITE COORDINATOR.
 4. REFER TO TEMPORARY EROSION CONTROL DETAIL SHEETS FOR ADDITIONAL DETAILS.

653.20 - TEMPORARY EROSION MATTING
 STA 14+089.95 LT - 14+090.59 LT
 STA 14+093.34 LT - 14+139.73 LT
 STA 14+150.27 RT - 14+208.19 RT

653.40 - INLET PROTECTION DEVICE, TYPE I
 STA 14+091.93 LT
 STA 14+130.87 LT
 STA 14+149.00 RT
 STA 14+149.19 LT
 STA 100.012.63 RT


LEGEND

- LIMITS OF SOIL DISTURBANCE
- EROSION MATTING
- STONE DROP INLET PROTECTION

SOIL CLASSIFICATION
 DUMMERSTON FINE SANDY LOAM
 15-25% SLOPES
 HYDROGROUP B
 "K FACTOR" 0.32
 MODERATE ERODIABILITY


SOIL CLASSIFICATION
 CABOT SILT LOAM
 0-3% SLOPES
 HYDROGROUP D
 "K FACTOR" 0.32
 MODERATE ERODIABILITY

SOIL CLASSIFICATION
 SALMON VERY FINE SANDY LOAM
 8-15% SLOPES
 HYDROGROUP B
 "K FACTOR" 0.49
 HIGH ERODIABILITY

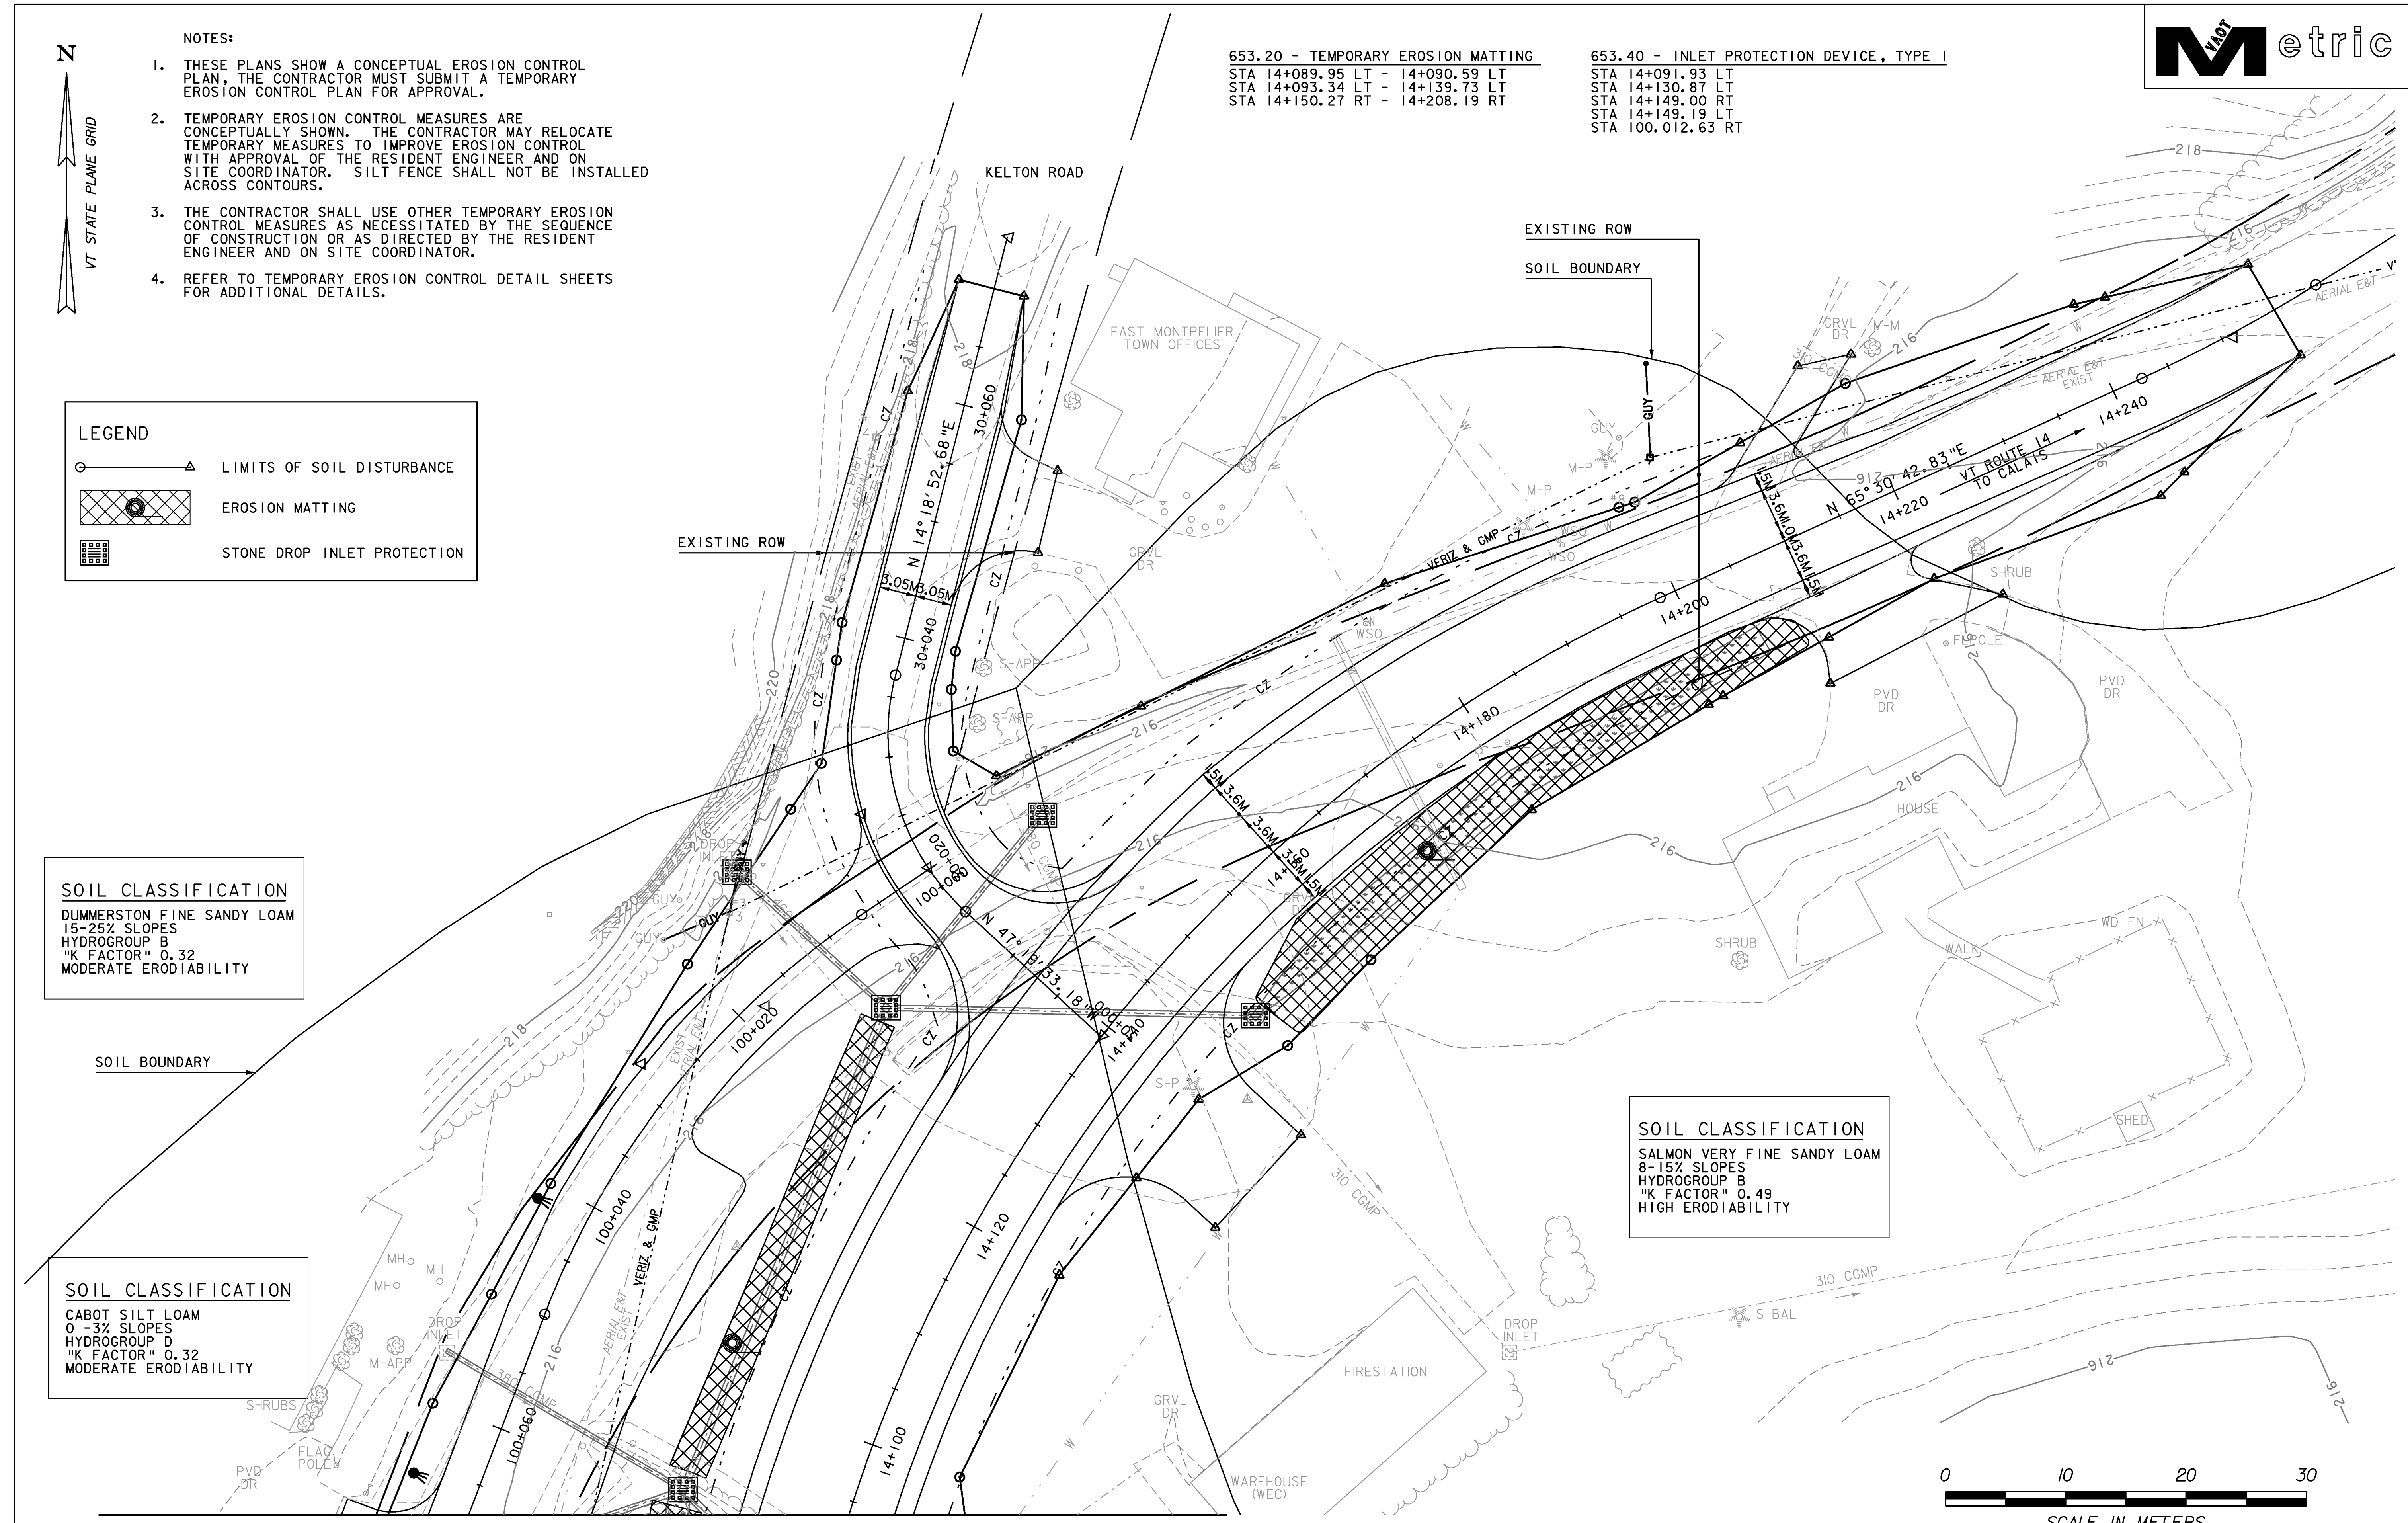


MATCH LINE STA 100+67.63 MATCH LINE STA 14+093.85

PROJECT NAME: EAST MONTEPELIER
 PROJECT NUMBER: STPG 028 - 3(35)S
 FILE NAME: +98b028econstrucTonbdr.dgn PLOT DATE: 22-MAR-2010
 PROJECT LEADER: J. SCHULTZ DRAWN BY: J. DEVLIN
 DESIGNED BY: J. GRUCHACZ CHECKED BY: J. SCHULTZ
 EPSC CONSTRUCTION SHEET 4 SHEET 56 OF 142

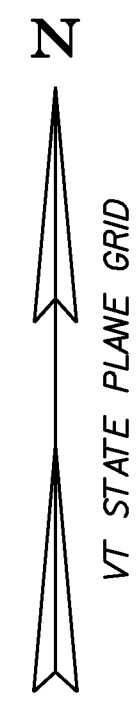

LEGEND

- AERIAL E&T — AERIAL ELECTRIC & TELEPHONE
- — △ LIMITS OF SOIL DISTURBANCE
- DISTURBED AREAS REQUIRING RE-VEGETATION

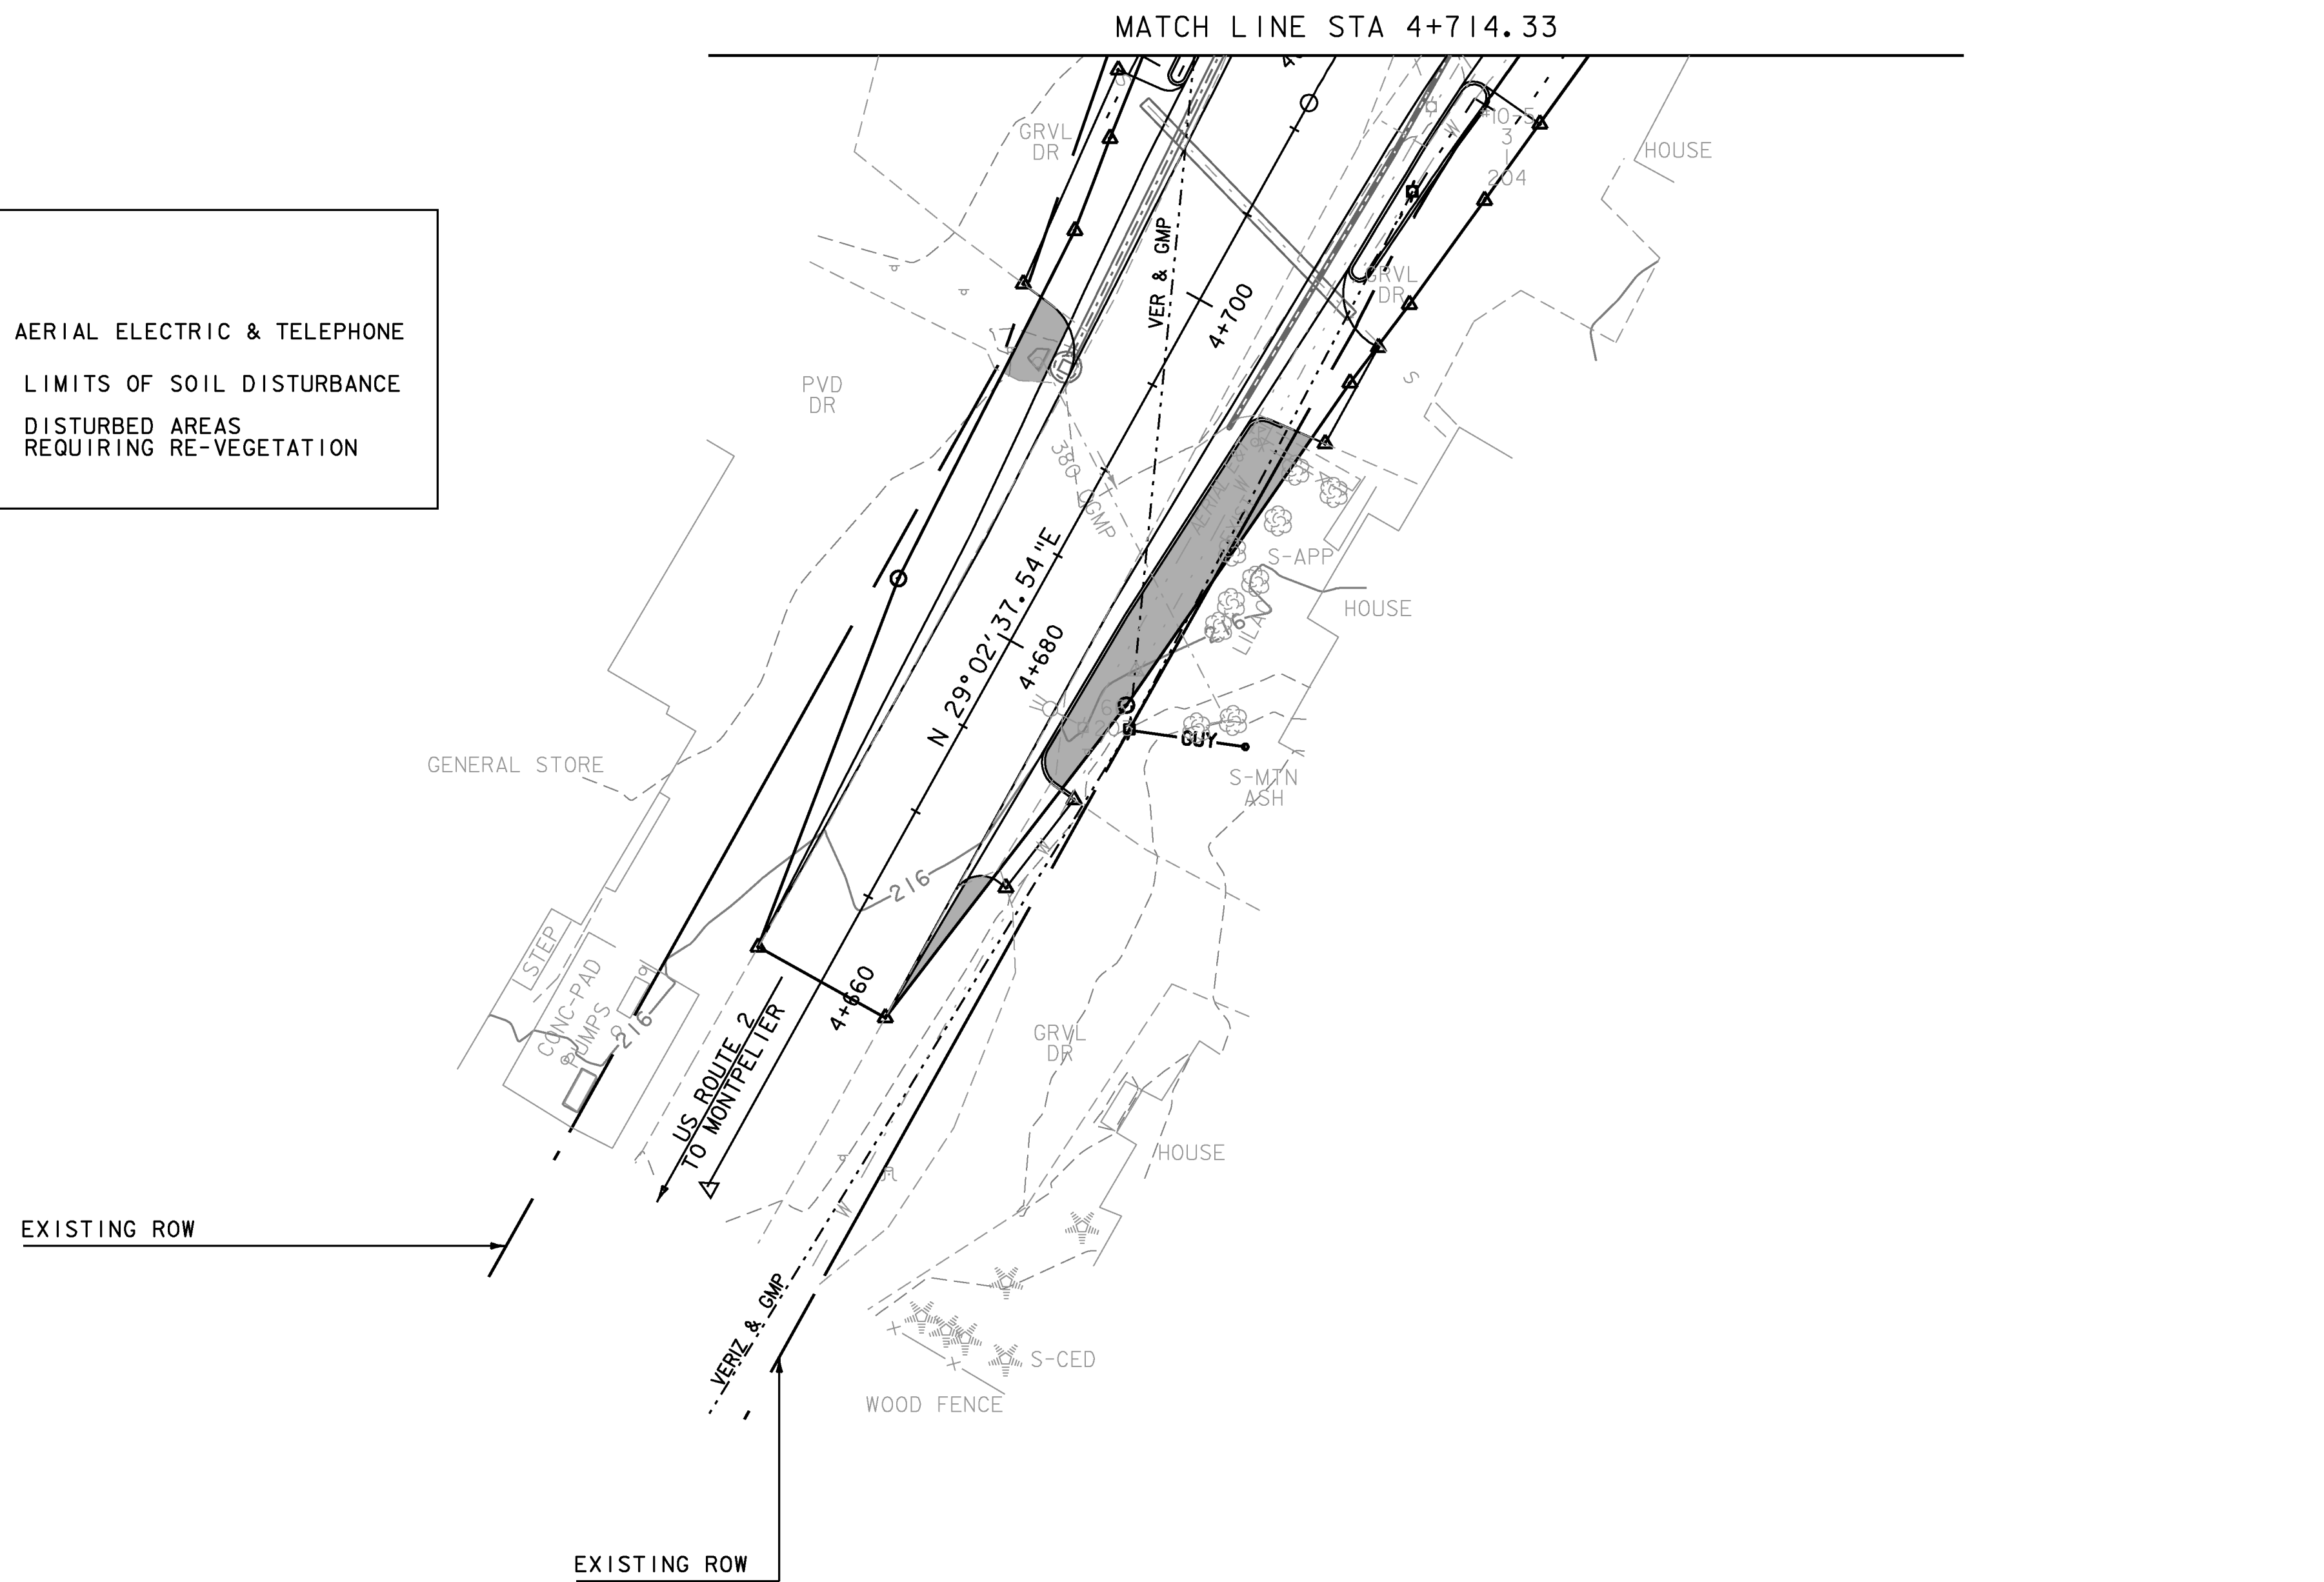


PROJECT NAME:	EAST MONTPELIER
PROJECT NUMBER:	STPG 028 - 3(35)S
FILE NAME:	+98b028ecf1nalbdr.dgn
PROJECT LEADER:	J. SCHULTZ
DESIGNED BY:	J. GRUCHACZ
EPSC FINAL CONDITIONS SHEET I	
PLOT DATE:	22-MAR-2010
DRAWN BY:	J. DEVLIN
CHECKED BY:	J. SCHULTZ
SHEET	57 OF 142

MATCH LINE STA 100+67.63

MATCH LINE STA 14+093.85

LEGEND

- AERIAL E&T — AERIAL ELECTRIC & TELEPHONE
- — △ LIMITS OF SOIL DISTURBANCE
- ▒ DISTURBED AREAS REQUIRING RE-VEGETATION

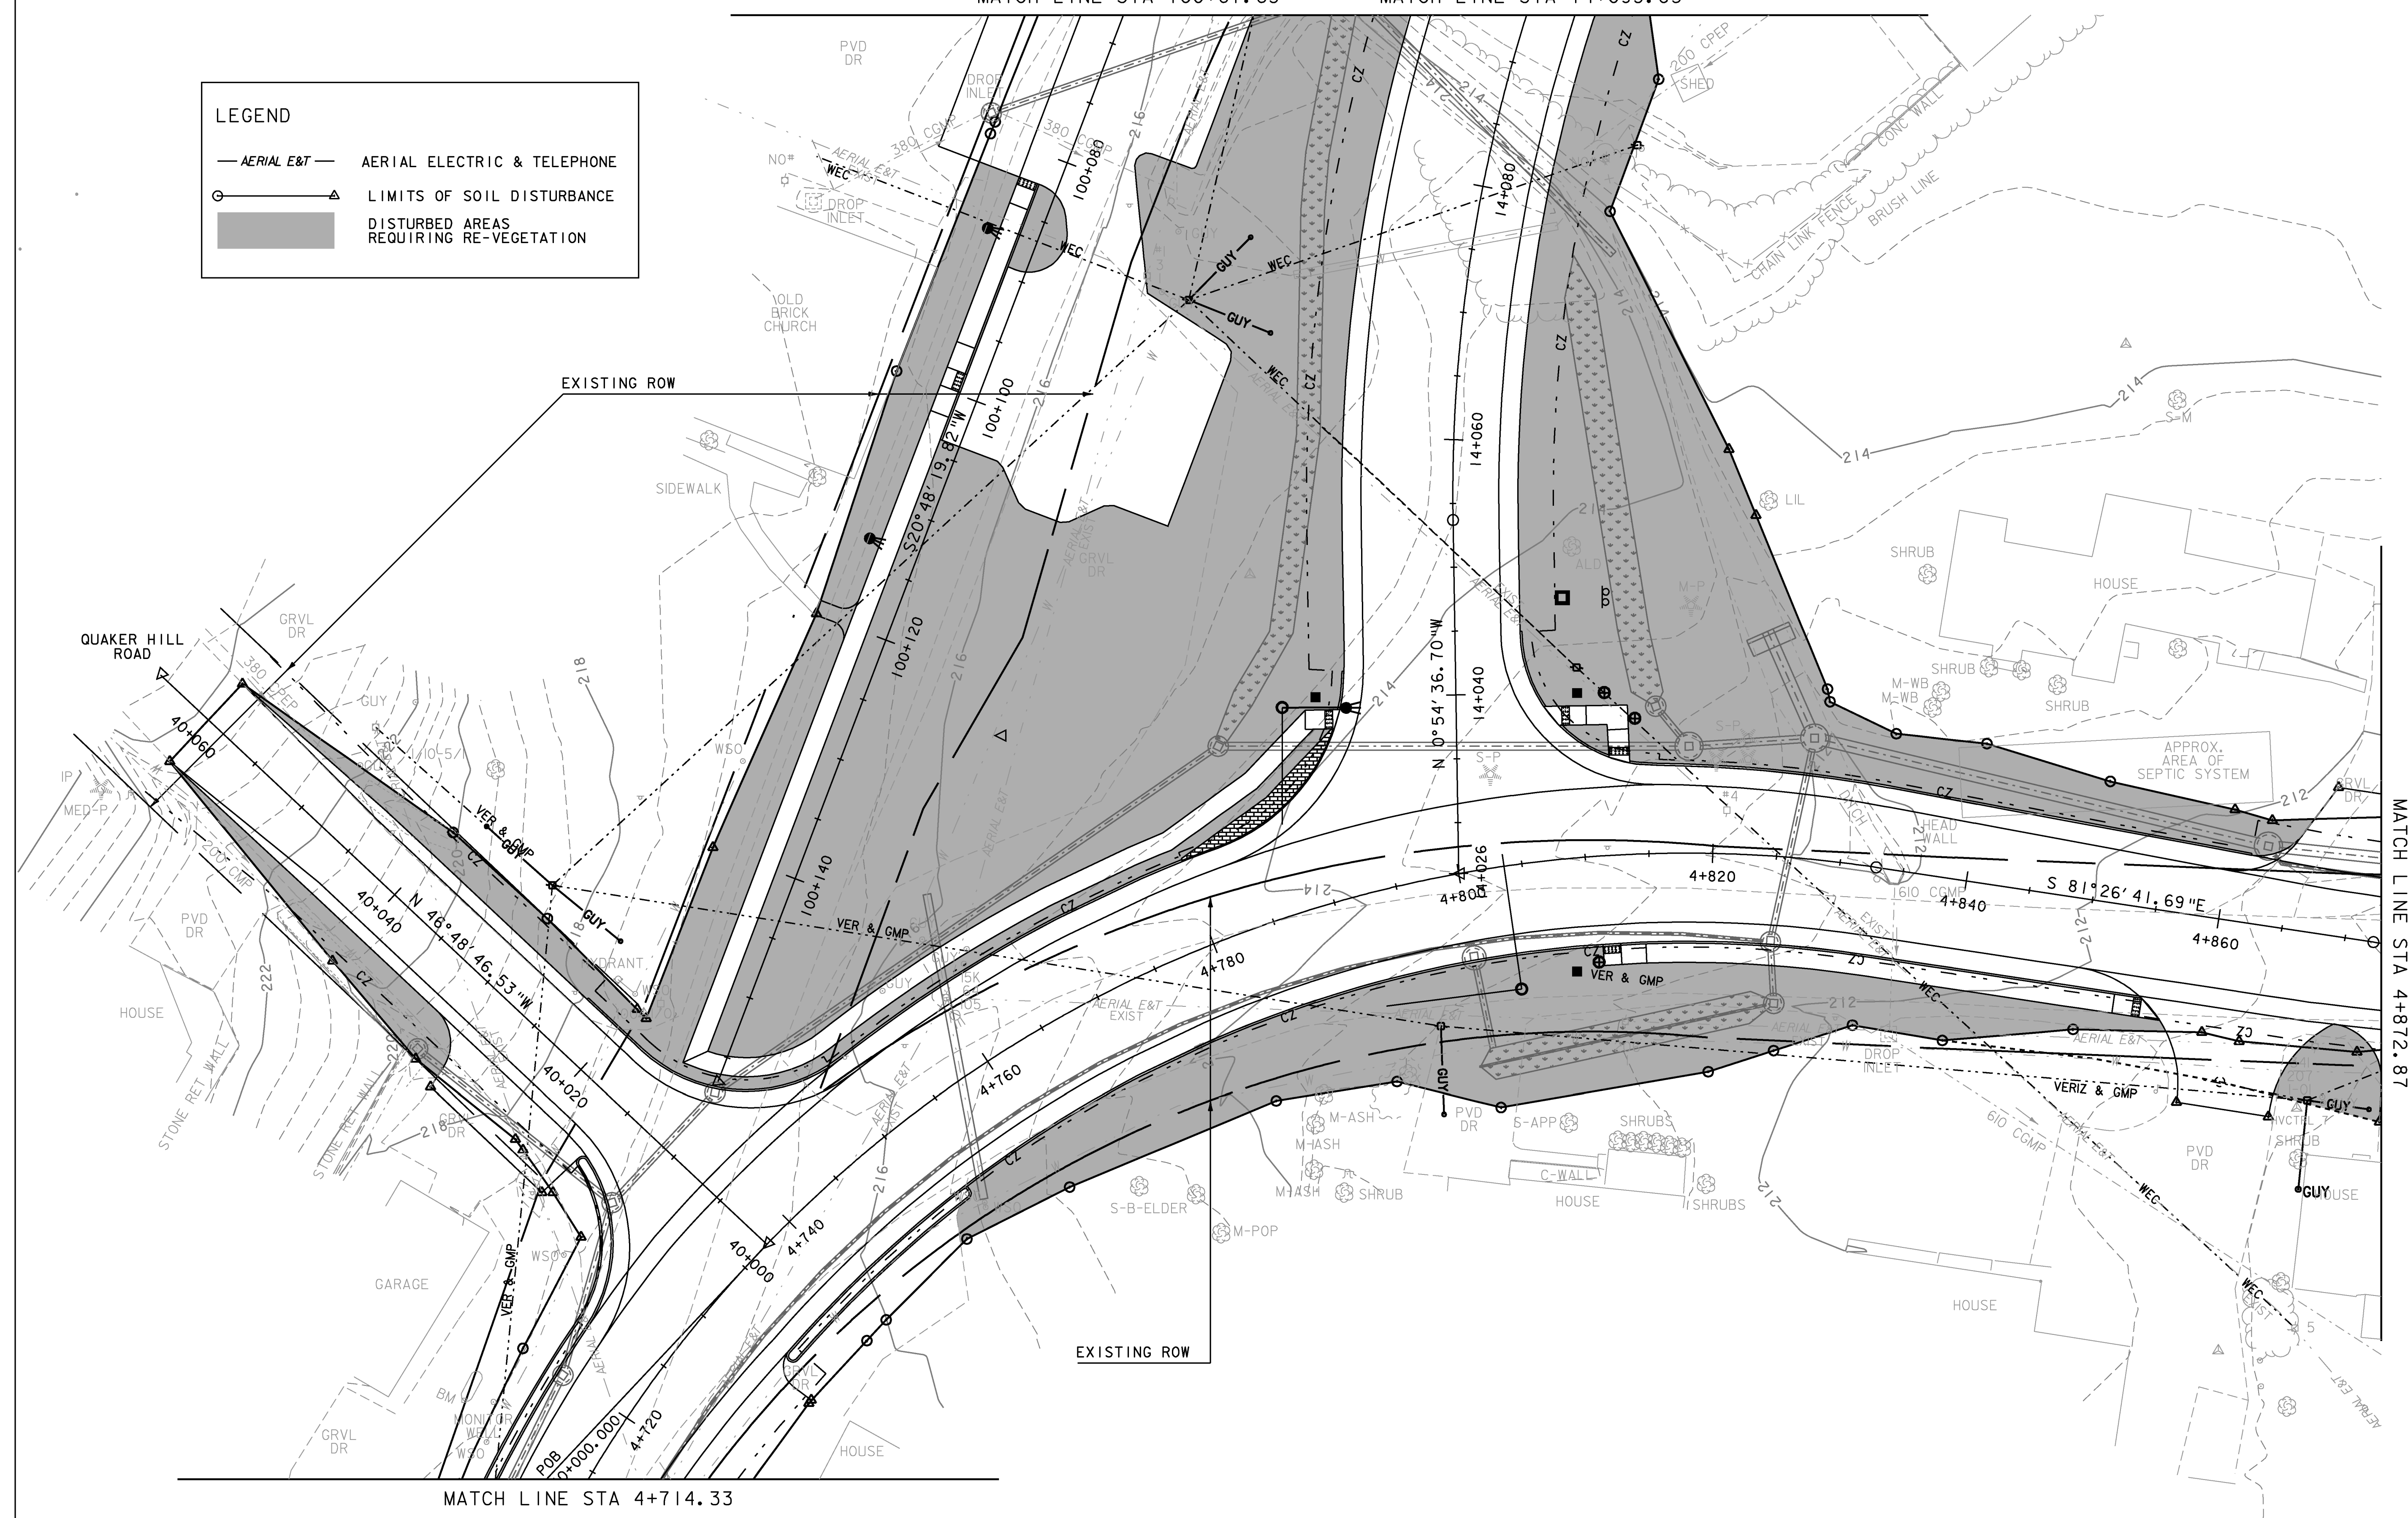


MATCH LINE STA 4+714.33

MATCH LINE STA 4+872.87



PROJECT NAME:	EAST MONTPELIER	FILE NAME:	+98b028ecf1nalbdr.dgn	PLOT DATE:	22-MAR-2010
PROJECT NUMBER:	STPG 028 - 3(35)S	PROJECT LEADER:	J. SCHULTZ	DRAWN BY:	J. DEVLIN
		DESIGNED BY:	J. GRUCHACZ	CHECKED BY:	J. SCHULTZ
		EPSC FINAL CONDITIONS SHEET 2		SHEET	58 OF 142

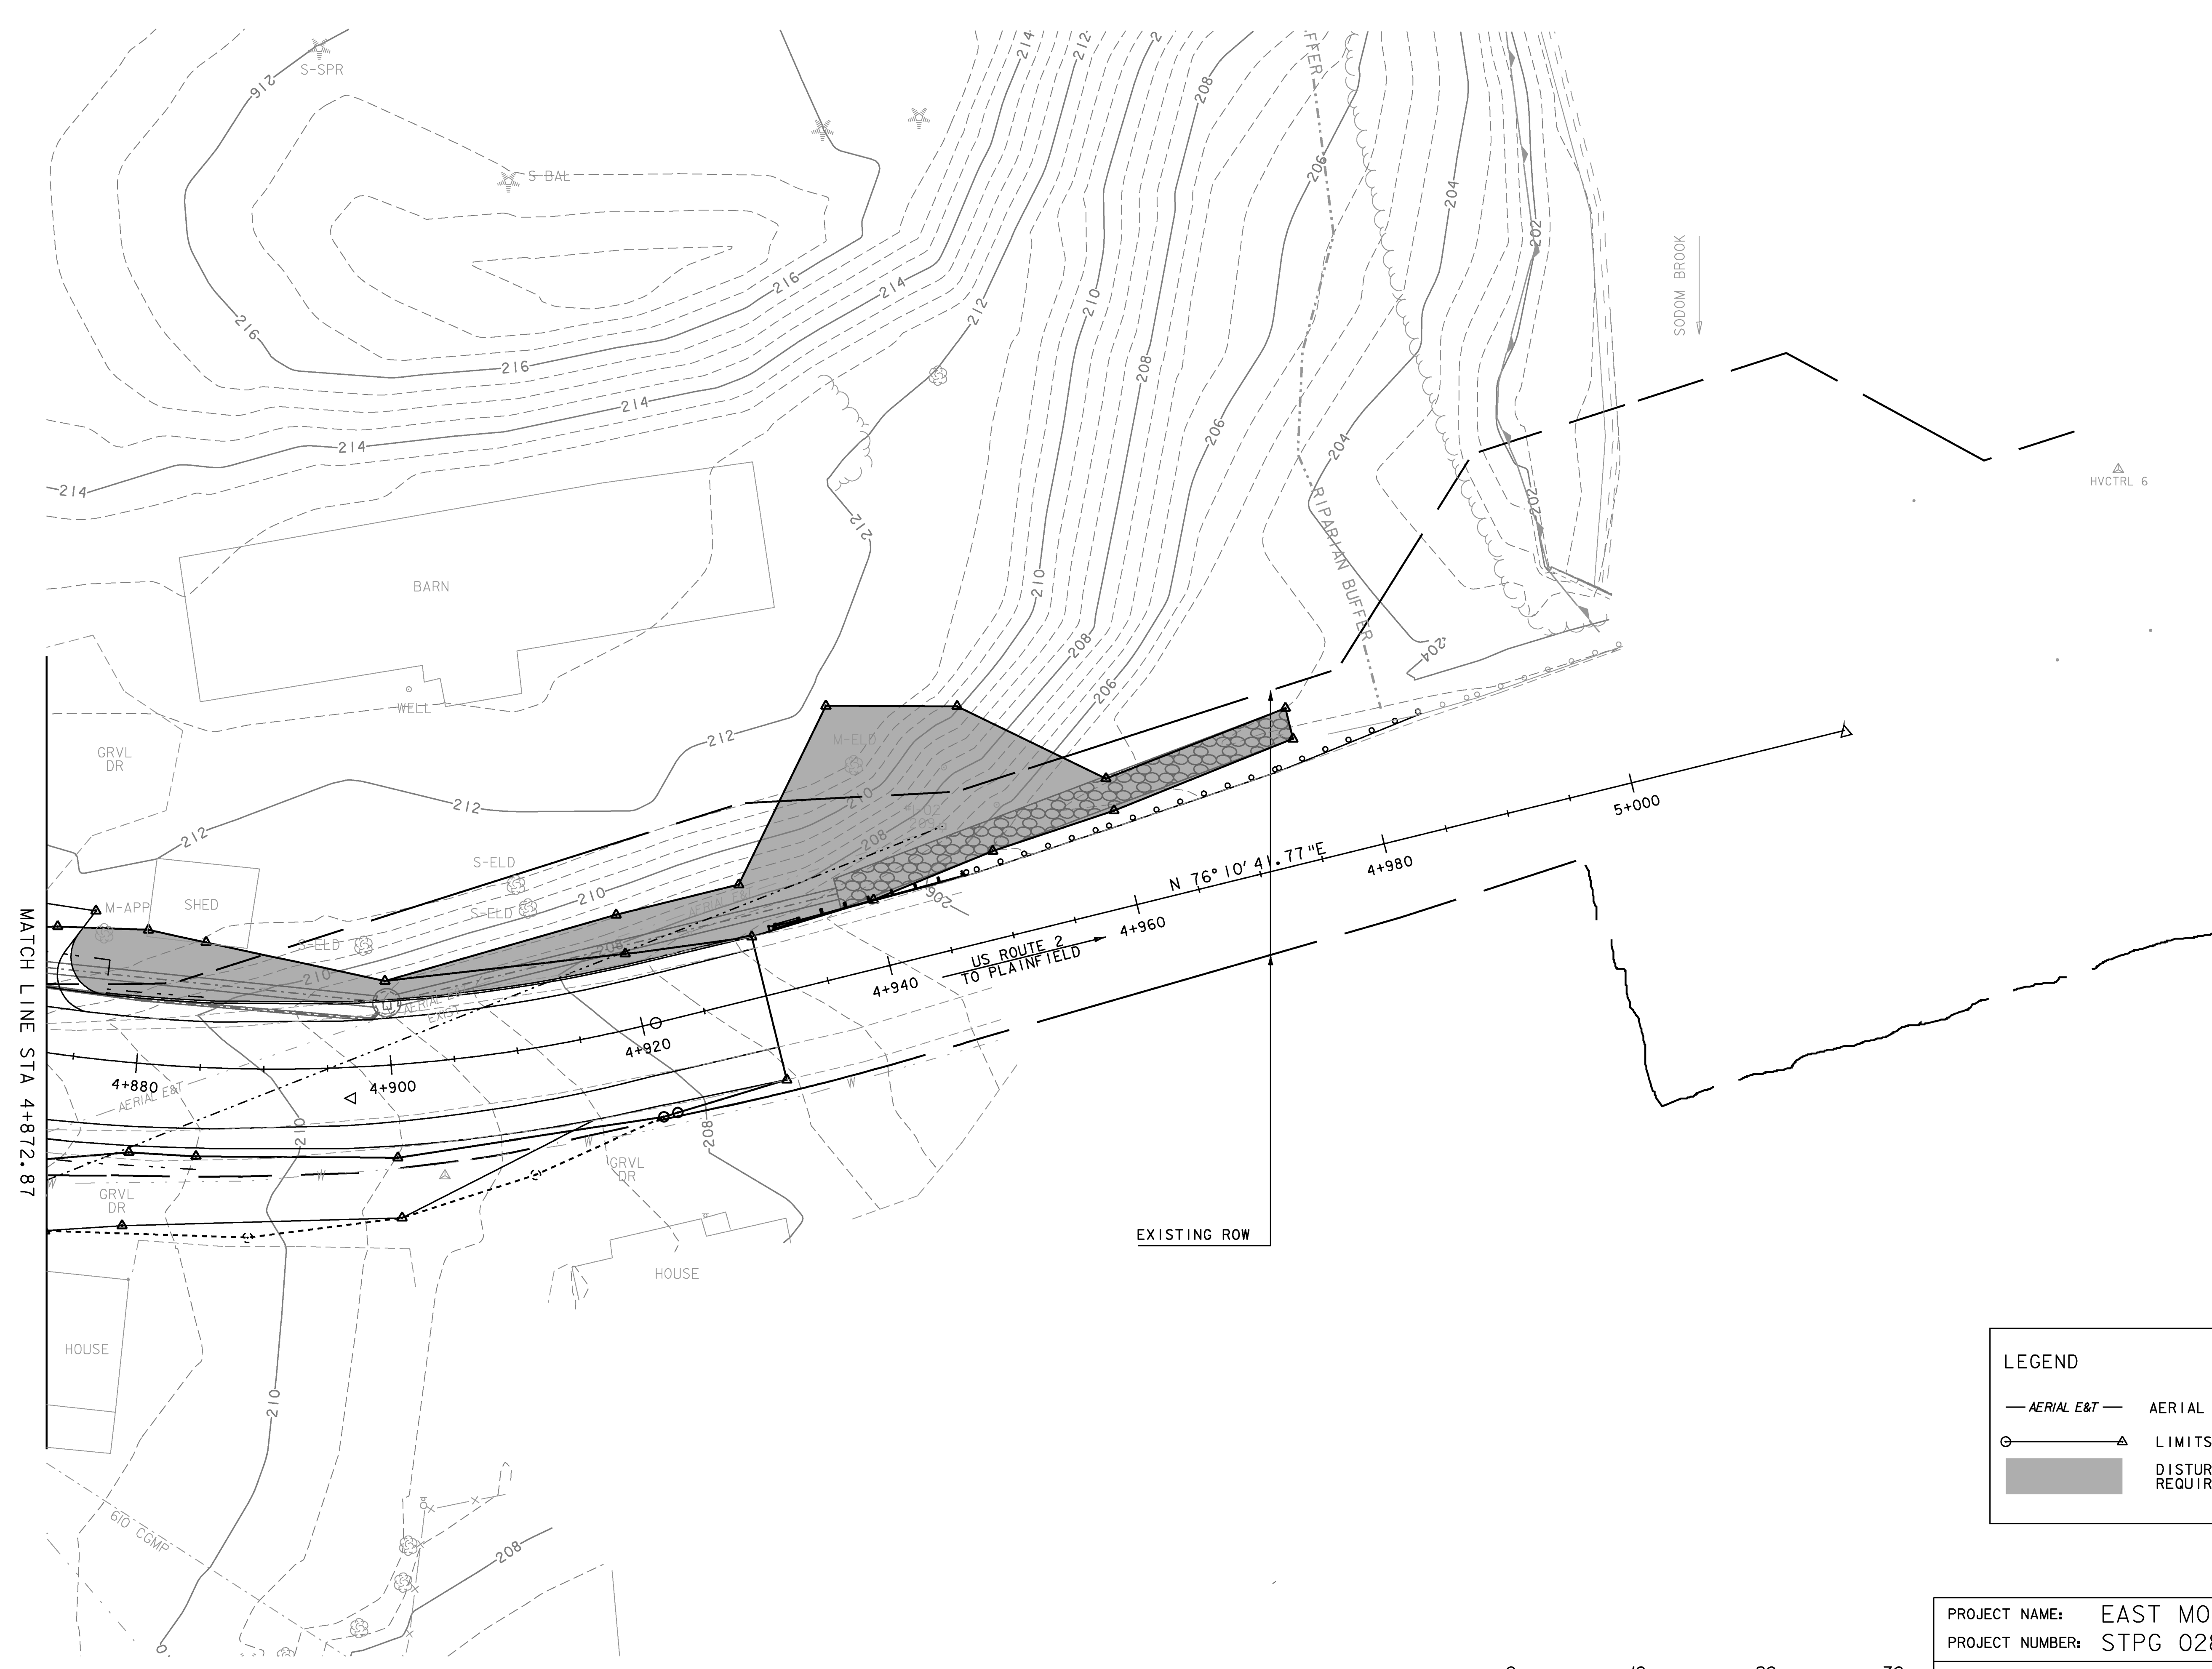


MATCH LINE STA 4+872.87

EXISTING ROW

LEGEND	
	AERIAL ELECTRIC & TELEPHONE
	LIMITS OF SOIL DISTURBANCE
	DISTURBED AREAS REQUIRING RE-VEGETATION




PROJECT NAME:	EAST MONTPELIER	FILE NAME:	+98b028ecf1nalbdr.dgn	PLOT DATE:	22-MAR-2010
PROJECT NUMBER:	STPG 028 - 3(35)S	PROJECT LEADER:	J. SCHULTZ	DRAWN BY:	J. DEVLIN
		DESIGNED BY:	J. GRUCHACZ	CHECKED BY:	J. SCHULTZ
		EPSC FINAL CONDITIONS SHEET 3		SHEET	59 OF 142

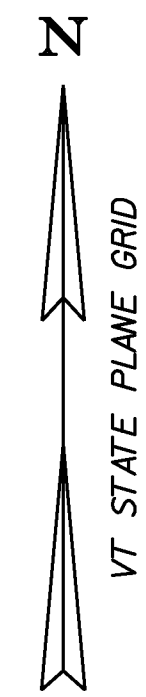

LEGEND

- AERIAL E&T — AERIAL ELECTRIC & TELEPHONE
- — △ LIMITS OF SOIL DISTURBANCE
- DISTURBED AREAS REQUIRING RE-VEGETATION

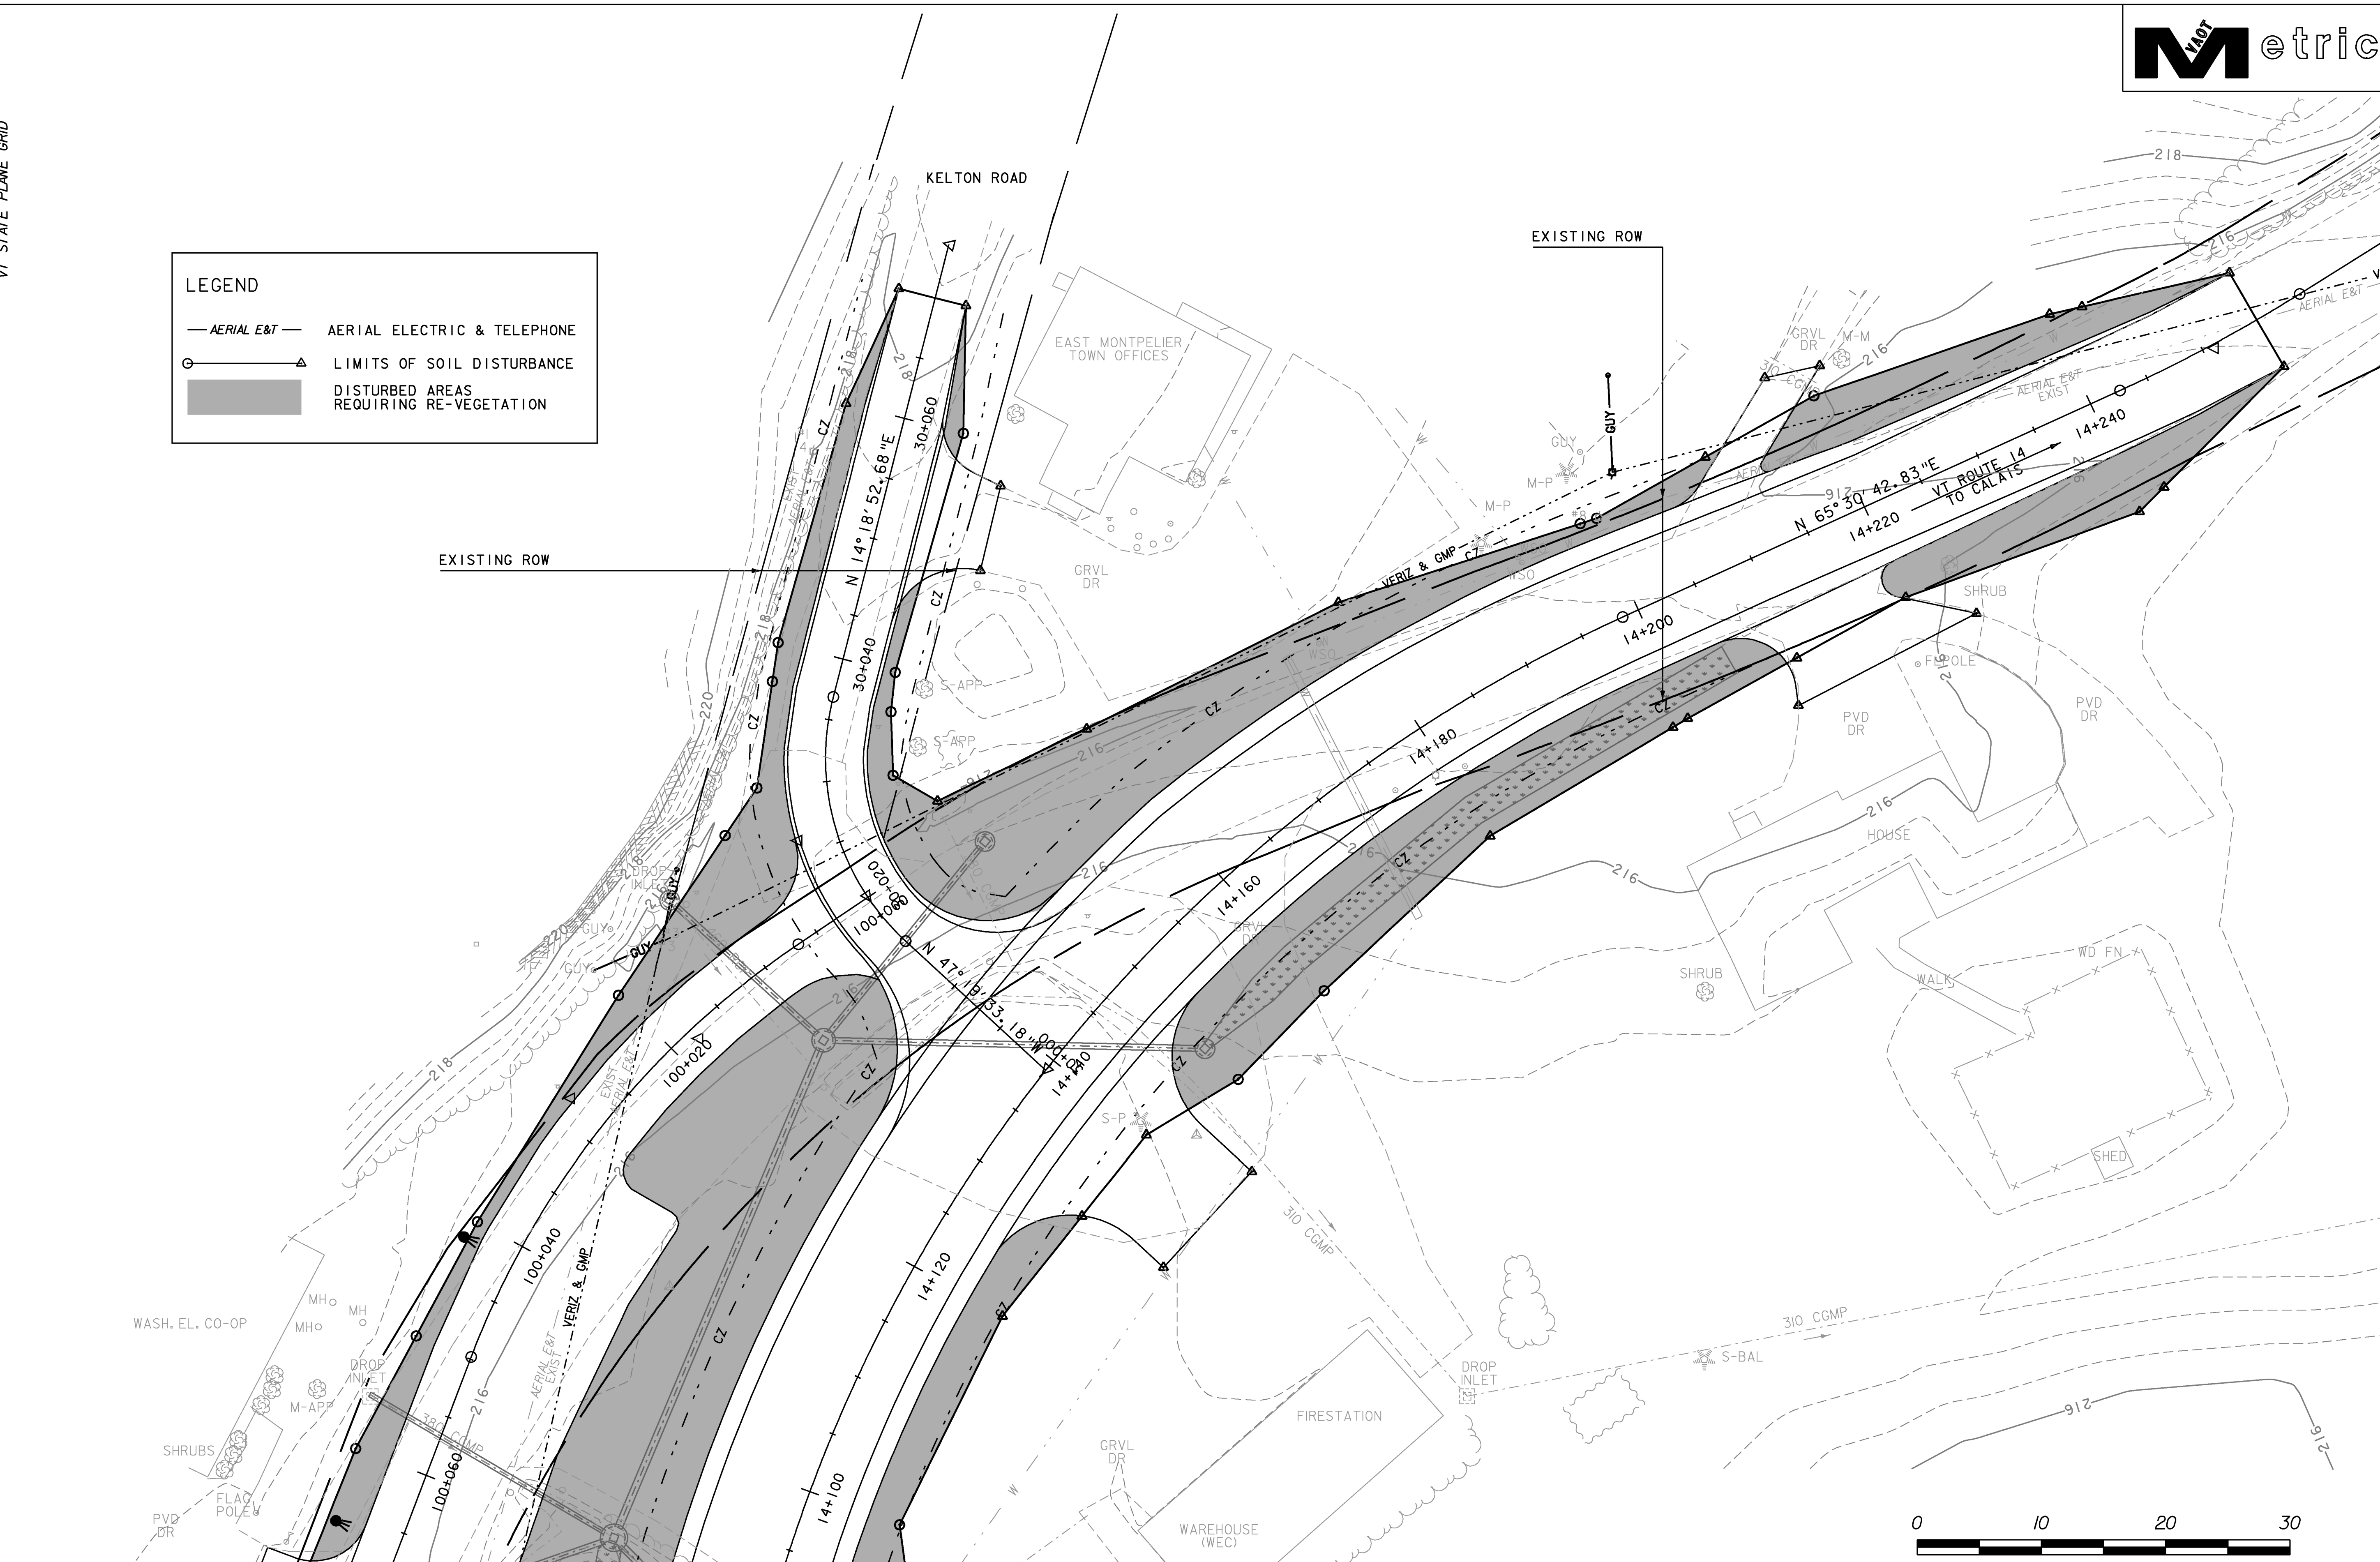


MATCH LINE STA 100+67.63

MATCH LINE STA 14+093.85

PROJECT NAME: EAST MONTPELIER
 PROJECT NUMBER: STPG 028 - 3(35)S

FILE NAME: +98b028ecf1nalbdr.dgn	PLOT DATE: 22-MAR-2010
PROJECT LEADER: J. SCHULTZ	DRAWN BY: J. DEVLIN
DESIGNED BY: J. GRUCHACZ	CHECKED BY: J. SCHULTZ
EPSC FINAL CONDITIONS SHEET 4	SHEET 60 OF 142

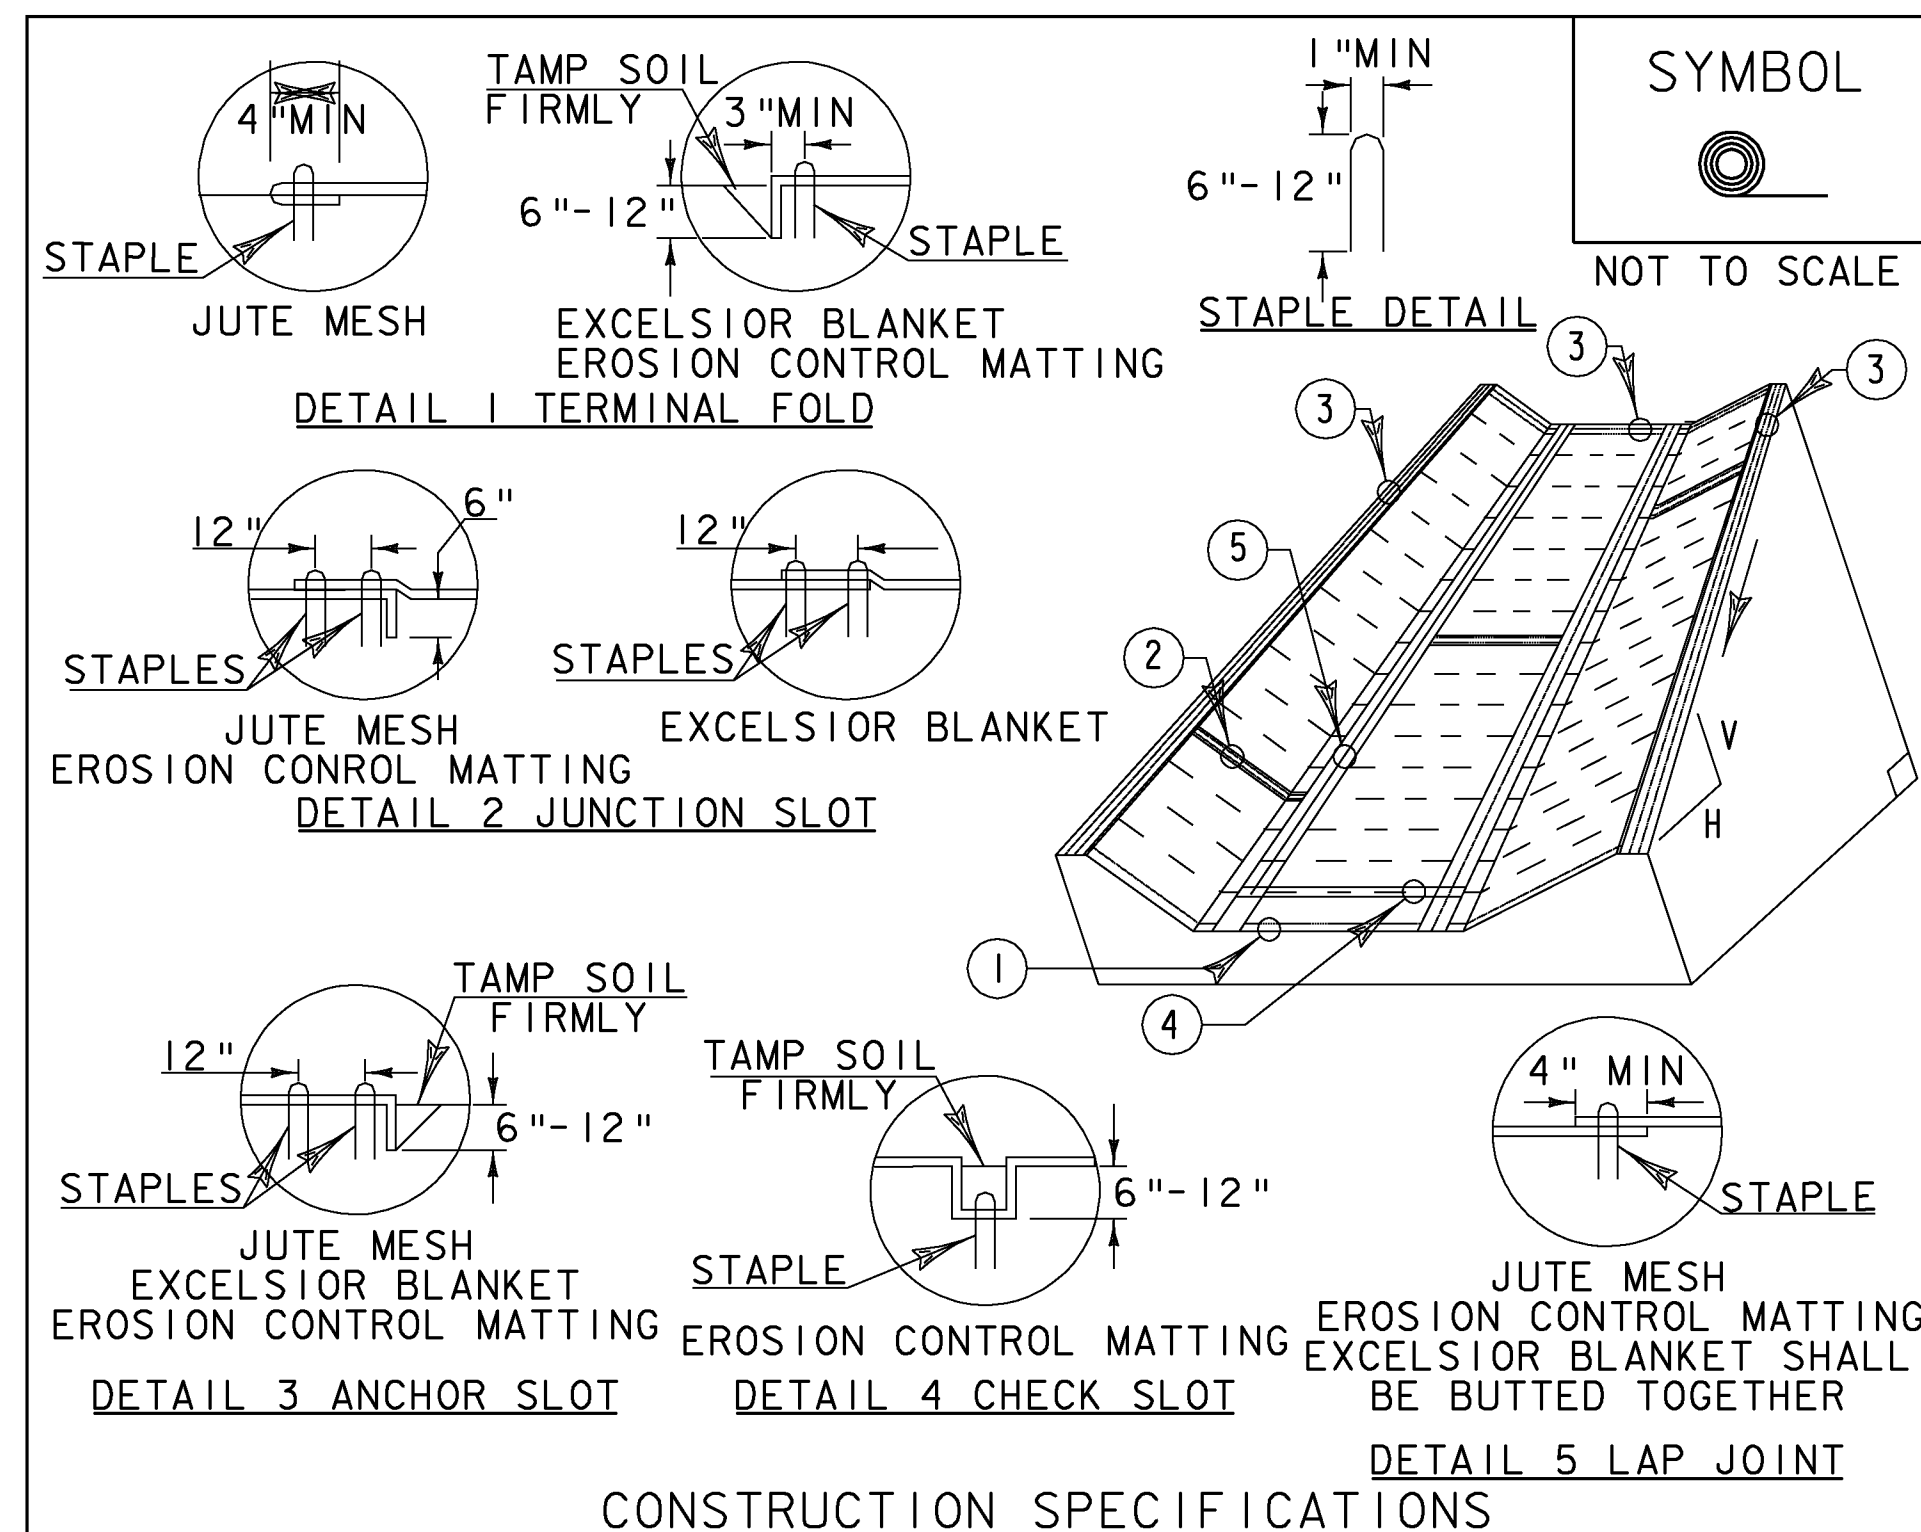


- CONSTRUCTION SPECIFICATIONS**
1. EROSION MATTING, CHECK SLOTS, SHALL BE SPACED IN DITCH CHANNEL SO THAT ONE OCCURS WITHIN EACH 50' ON SLOPES OF MORE THAN 4% AND LESS THAN 6%. ON SLOPES OF 6% OR MORE, THEY SHALL BE SPACED SO THAT ONE OCCURS WITHIN EACH 25'.
 2. APPLY FERTILIZER, LIME SEED PRIOR TO PLACING MATTING.
 3. STAPLES ARE TO BE PLACED ALTERNATELY, IN COLUMNS APPROXIMATELY 2' APART AND IN ROWS APPROXIMATELY 3' APART. APPROXIMATELY 175 STAPLES ARE REQUIRED PER 4' X 225' ROLL OF MATERIAL AND 125 STAPLES ARE REQUIRED PER 4' X 150' ROLL OF MATERIAL.
 4. DISTURBED AREAS SHALL BE SMOOTHLY GRADED. EROSION CONTROL MATERIAL SHALL BE PLACED LOOSELY OVER GROUND SURFACE. DO NOT STRETCH.
 5. ALL TERMINAL ENDS AND TRANSVERSE LAPS SHALL BE STAPLED AT APPROXIMATELY 12" INTERVALS.

ADAPTED FROM DETAILS PROVIDED BY: NEW YORK STATE DEC
ORIGINALLY DEVELOPED BY USDA-NRCS
VERMONT DEPARTMENT OF ENVIRONMENTAL CONSERVATION

ROLLED EROSION CONTROL PRODUCT (RECP) DITCH

NOTES:
REFER TO "THE VERMONT STANDARDS & SPECIFICATIONS FOR EROSION PREVENTION & SEDIMENT CONTROL -2006-" FROM THE VT AGENCY OF NATURAL RESOURCES FOR ADDITIONAL GUIDANCE.
THIS WORK SHALL BE PERFORMED IN ACCORDANCE WITH SECTION 653 AND AS SHOWN IN THE PLANS FOR TEMPORARY EROSION MATTING (PAY ITEM 653.20) OR PERMANENT EROSION MATTING (PAY ITEM 653.21).

REVISIONS		
MARCH 8, 2007	JMF	
APRIL 16, 2007	WHF	
JANUARY 13, 2009	WHF	

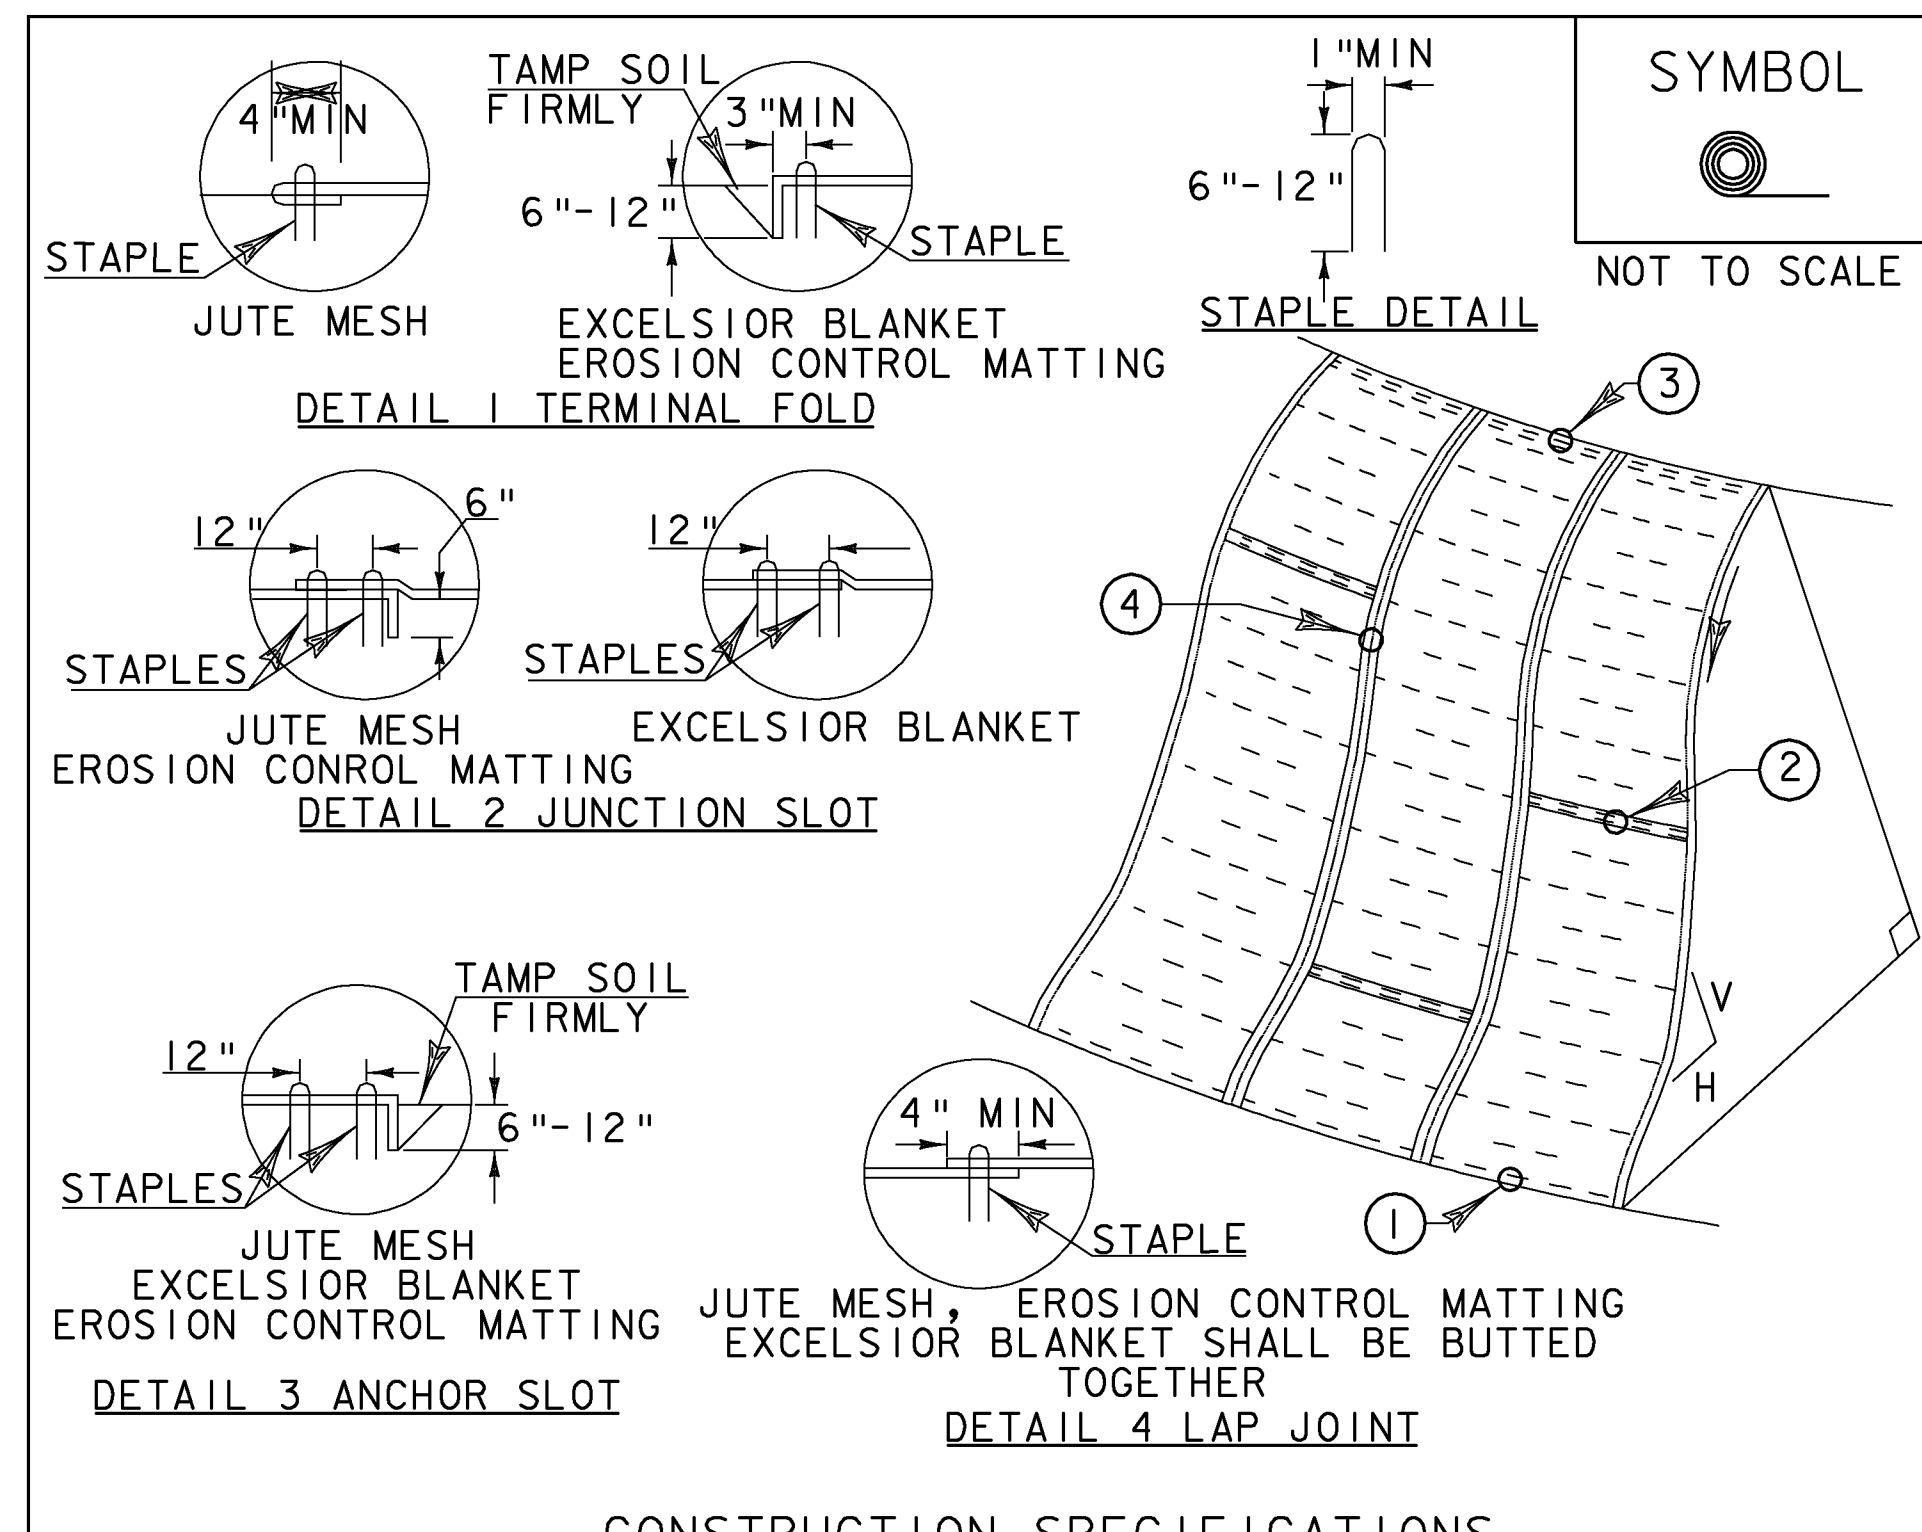


- CONSTRUCTION SPECIFICATIONS**
1. APPLY TO SLOPES GREATER THAN 3H:1V OR WHERE NECESSARY TO AID IN ESTABLISHING VEGETATION.
 2. APPLY FERTILIZER, LIME SEED PRIOR TO PLACING MATTING.
 3. STAPLES ARE TO BE PLACED ALTERNATELY, IN COLUMNS APPROXIMATELY 2' APART AND IN ROWS APPROXIMATELY 3' APART. APPROXIMATELY 175 STAPLES ARE REQUIRED PER 4' X 225' ROLL OF MATERIAL AND 125 STAPLES ARE REQUIRED PER 4' X 150' ROLL OF MATERIAL.
 4. DISTURBED AREAS SHALL BE SMOOTHLY GRADED. EROSION CONTROL MATERIAL SHALL BE PLACED LOOSELY OVER GROUND SURFACE. DO NOT STRETCH.
 5. ALL TERMINAL ENDS AND TRANSVERSE LAPS SHALL BE STAPLED AT APPROXIMATELY 12" INTERVALS.

ADAPTED FROM DETAILS PROVIDED BY: NEW YORK STATE DEC
ORIGINALLY DEVELOPED BY USDA-NRCS
VERMONT DEPARTMENT OF ENVIRONMENTAL CONSERVATION

ROLLED EROSION CONTROL PRODUCT (RECP) SIDE SLOPE

NOTES:
REFER TO "THE VERMONT STANDARDS & SPECIFICATIONS FOR EROSION PREVENTION & SEDIMENT CONTROL -2006-" FROM THE VT AGENCY OF NATURAL RESOURCES FOR ADDITIONAL GUIDANCE.
THIS WORK SHALL BE PERFORMED IN ACCORDANCE WITH SECTION 653 AND AS SHOWN IN THE PLANS FOR TEMPORARY EROSION MATTING (PAY ITEM 653.20) OR PERMANENT EROSION MATTING (PAY ITEM 653.21).

REVISIONS		
APRIL 16, 2007	JMF	
JANUARY 13, 2009	WHF	

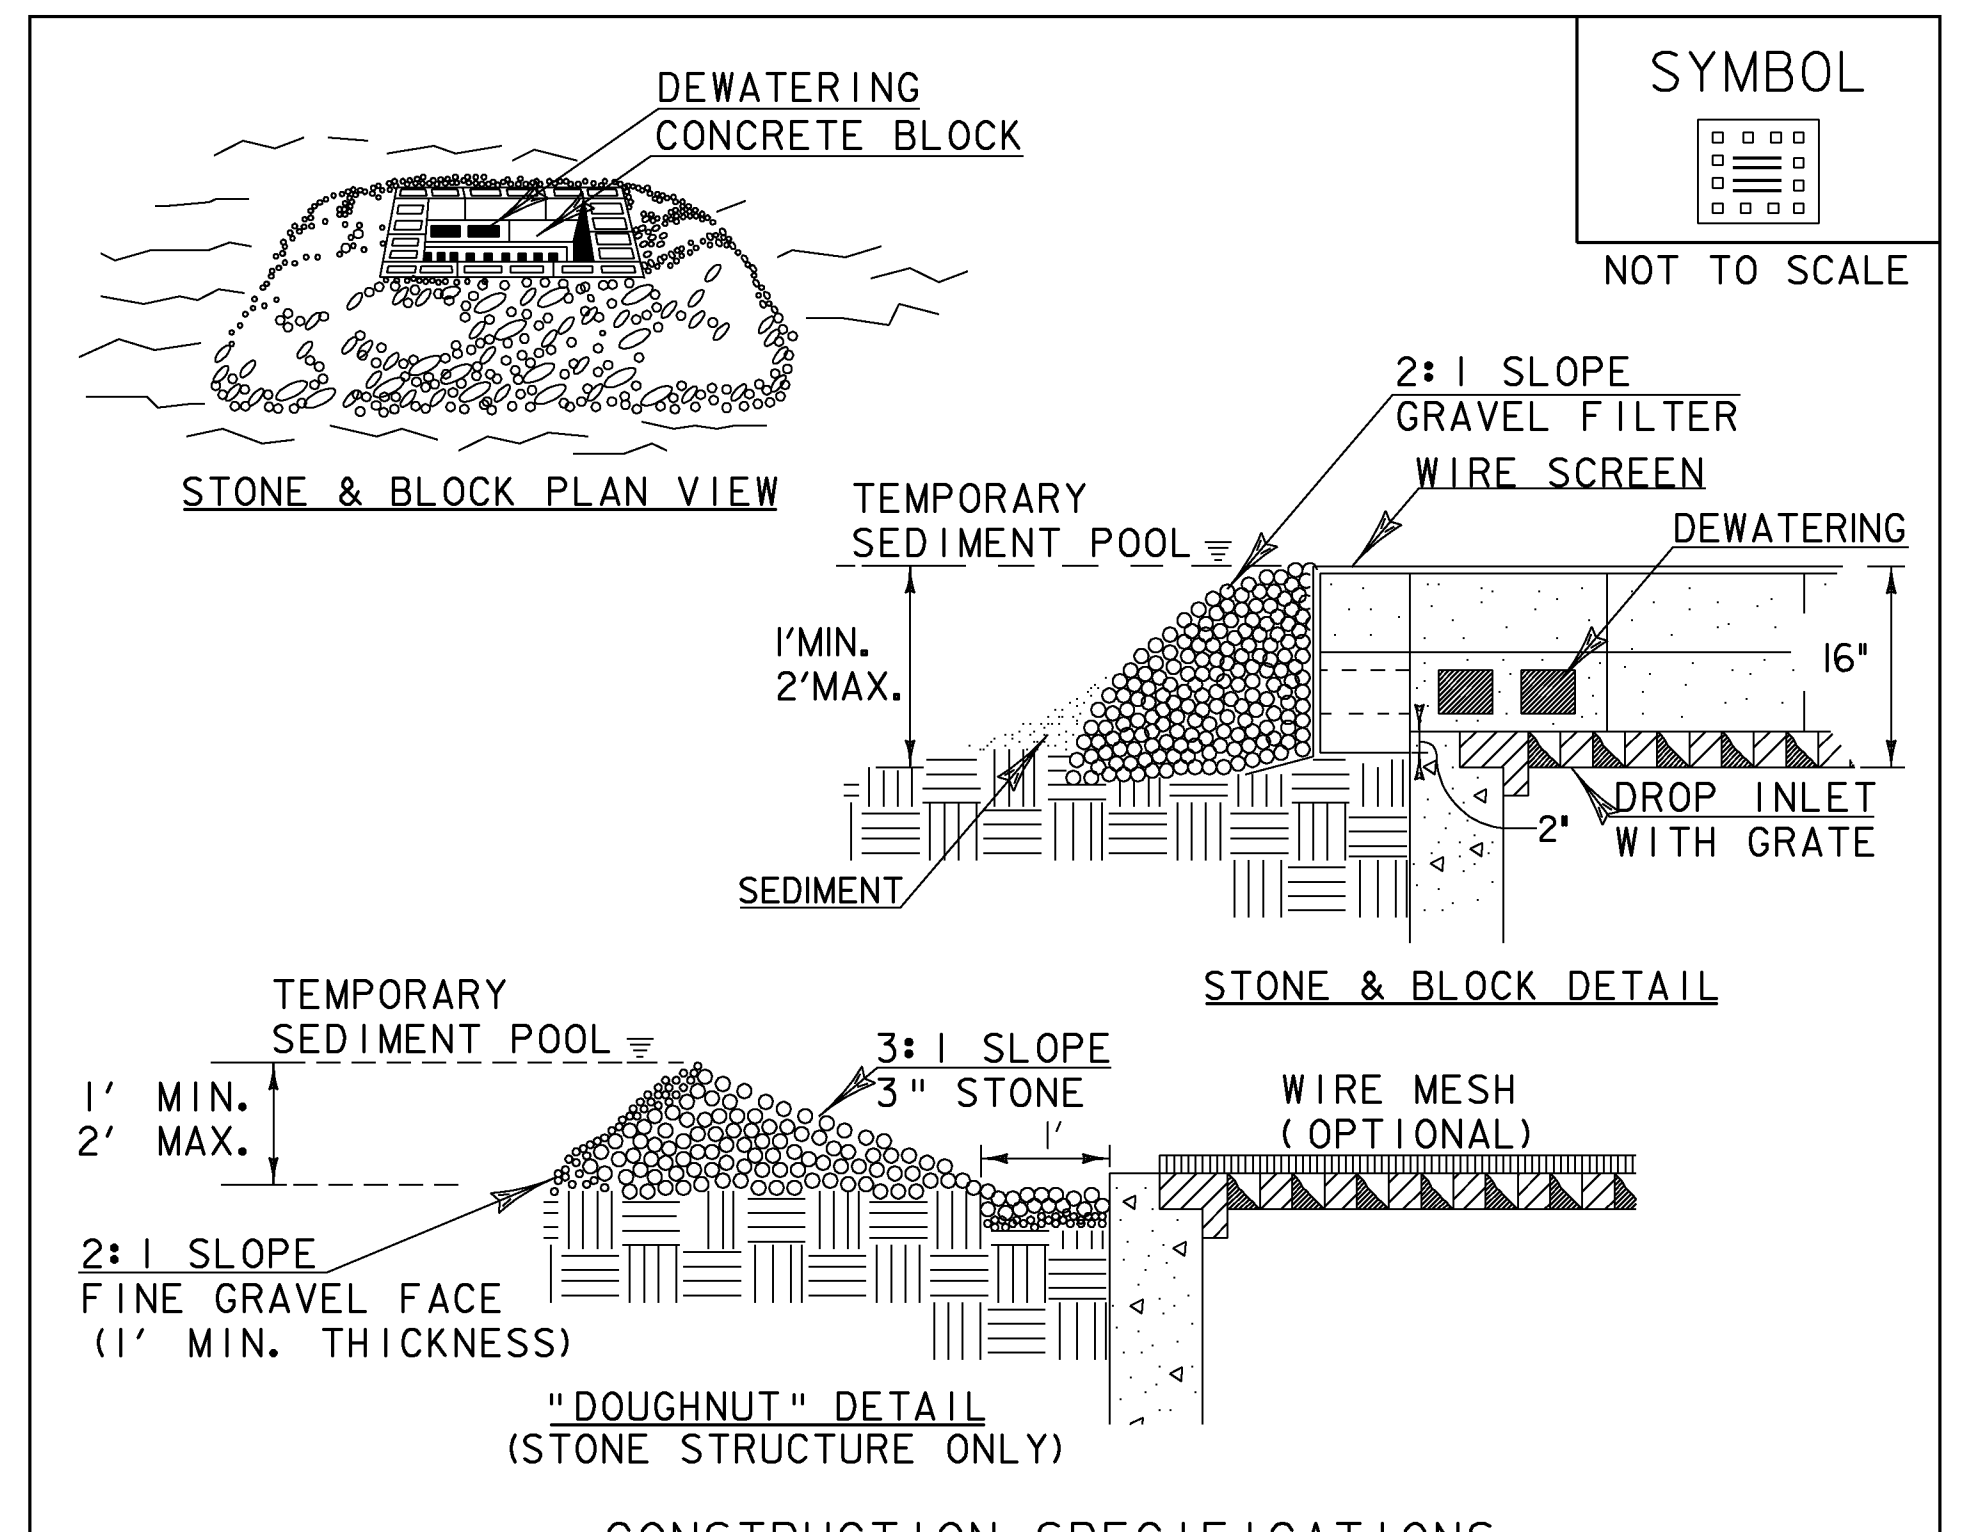


- CONSTRUCTION SPECIFICATIONS**
1. LAY ONE BLOCK ON EACH SIDE OF THE STRUCTURE ON ITS SIDE FOR DEWATERING. FOUNDATION SHALL BE 2" MINIMUM BELOW REST OF INLET AND BLOCKS SHALL BE PLACED AGAINST INLET FOR SUPPORT.
 2. HARDWARE CLOTH OR 1/2" WIRE MESH SHALL BE PLACED OVER BLOCK OPENINGS TO SUPPORT STONE.
 3. USE CLEAN STONE OR GRAVEL 1/2" - 3/4" IN DIAMETER PLACED 2" BELOW TOP OF THE BLOCK ON A 2:1 SLOPE OR FLATTER.
 4. FOR STONE STRUCTURES ONLY, A 1' THICK LAYER OF THE FILTER STONE WILL BE PLACED AGAINST THE 3" STONE AS SHOWN ON THE DRAWINGS.
 5. MAXIMUM DRAINAGE AREA 1 ACRE

ADAPTED FROM DETAILS PROVIDED BY: NEW YORK STATE DEC
ORIGINALLY DEVELOPED BY USDA-NRCS
VERMONT DEPARTMENT OF ENVIRONMENTAL CONSERVATION

STONE & BLOCK DROP INLET PROTECTION

NOTES:
REFER TO "THE VERMONT STANDARDS & SPECIFICATIONS FOR EROSION PREVENTION & SEDIMENT CONTROL -2006-" FROM THE VT AGENCY OF NATURAL RESOURCES FOR ADDITIONAL GUIDANCE.
THIS WORK SHALL BE PERFORMED IN ACCORDANCE WITH SECTION 653 FOR INLET PROTECTION DEVICE, TYPE I (PAY ITEM 653.40).

REVISIONS		
MARCH 6, 2008	WHF	
JANUARY 13, 2009	WHF	

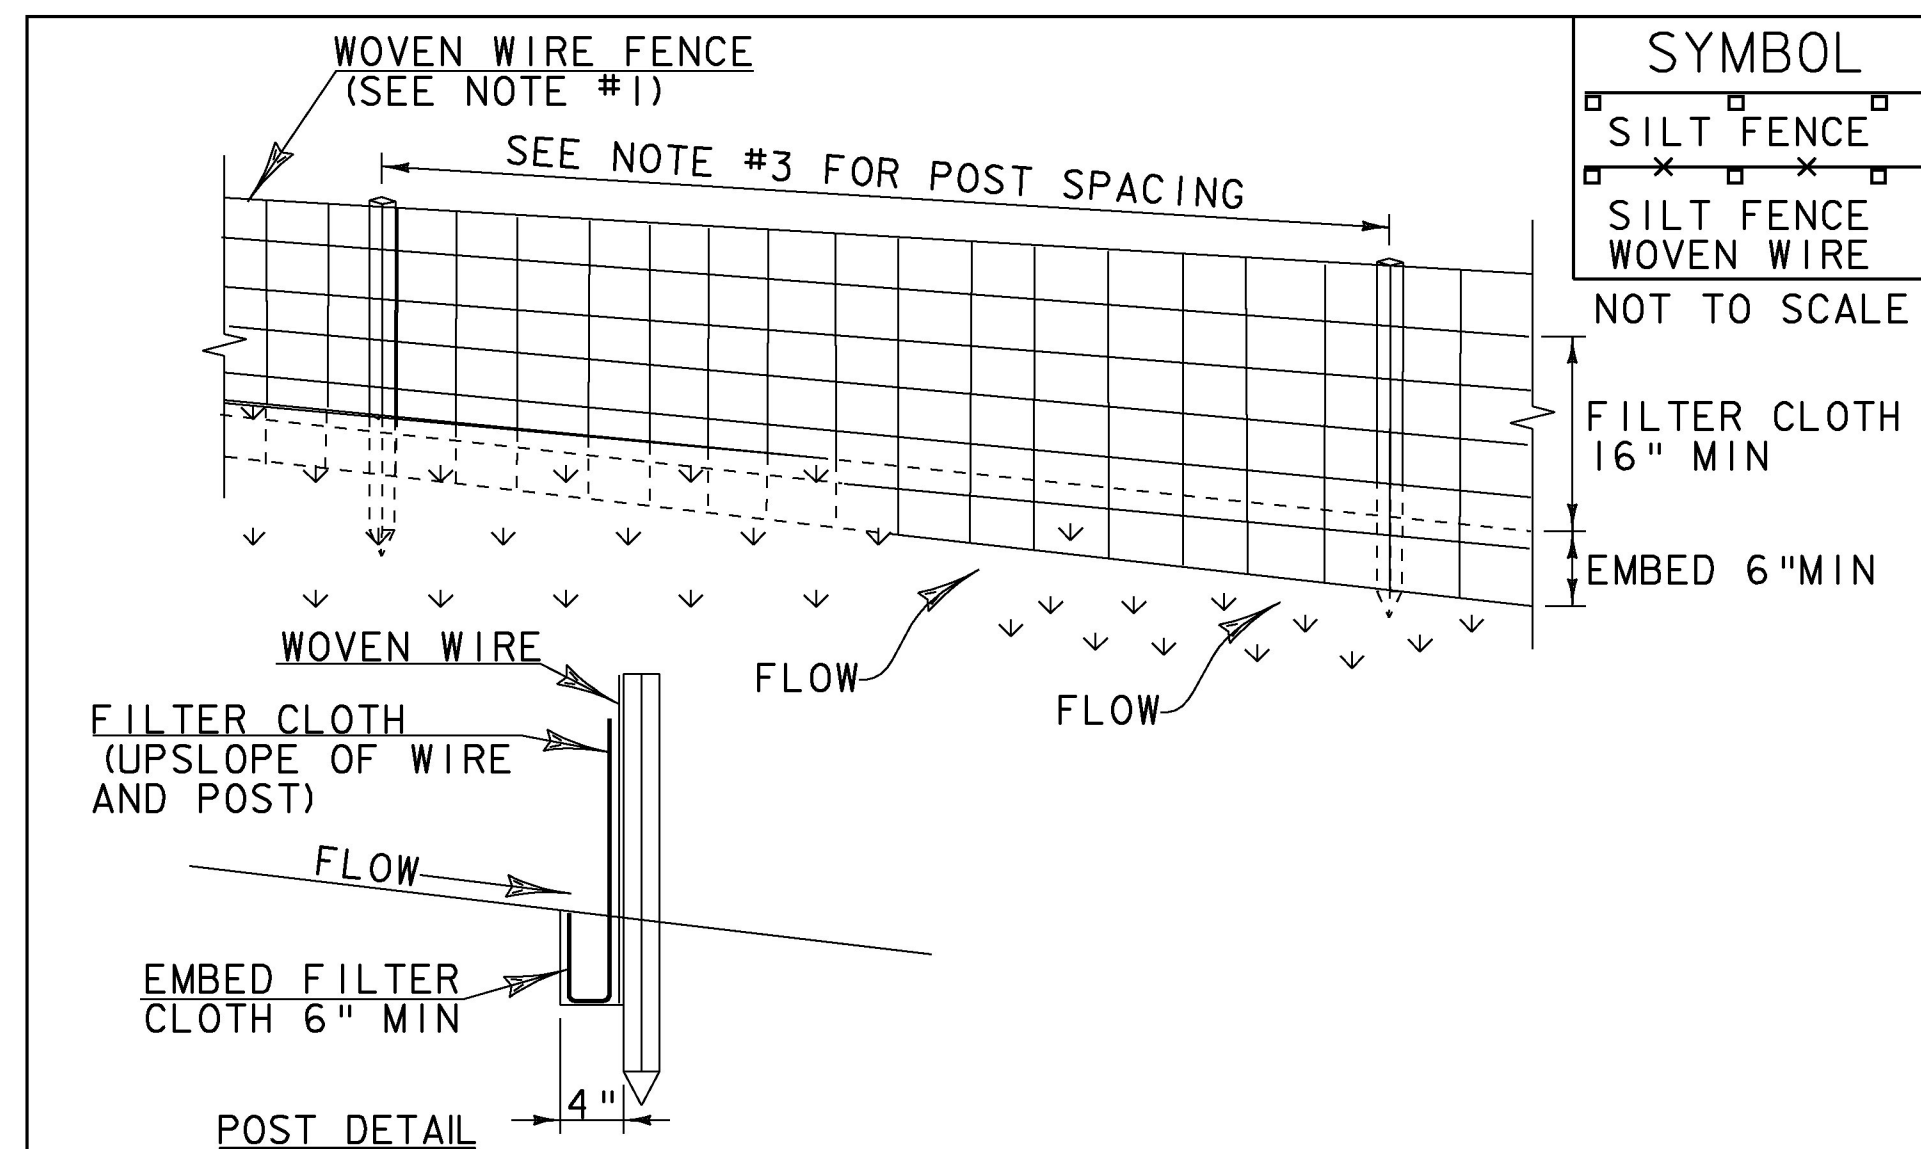

SYMBOL	
[Symbol]	SILT FENCE
[Symbol]	SILT FENCE WOVEN WIRE

CONSTRUCTION SPECIFICATIONS

- WOVEN WIRE REINFORCED FENCE IS REQUIRED WITHIN 100' UPSLOPE OF RECEIVING WATERS WHEN THE PROJECT FALLS UNDER A CONSTRUCTION STORMWATER PERMIT. WOVEN WIRE SHALL BE A MIN. 14 GAUGE WITH A 6" MAX. MESH OPENING.
- FILTER CLOTH SHALL BE EITHER FILTER X, MIRAF1100X, STABILINKA T140N OR APPROVED EQUIVALENT.
- POST SPACING FOR WIRE-BACKED FENCE SHALL BE 10' MAXIMUM. FOR FILTER-CLOTH FENCE, WHEN ELONGATION IS >50%, POST SPACING SHALL NOT EXCEED 4' AND WHEN ELONGATION IS <50%, POST SPACING SHALL NOT EXCEED 6'.
- WOVEN WIRE FENCE IS TO BE FASTENED SECURELY TO FENCE POSTS WITH WIRE TIES. FILTER CLOTH IS TO BE FASTENED SECURELY TO WOVEN WIRE FENCE WITH TIES SPACED EVERY 24" AT TOP AND MID SECTION.
- WHEN TWO SECTIONS OF FILTER CLOTH ADJOIN EACH OTHER THEY SHALL BE OVER-LAPPED BY 6" AND FOLDED.
- MAINTENANCE SHALL BE PERFORMED AS NEEDED AND MATERIAL REMOVED WHEN SEDIMENT REACHES HALF OF FABRIC HEIGHT.

ADAPTED FROM DETAILS PROVIDED BY: NEW YORK STATE DEC
ORIGINALLY DEVELOPED BY USDA-NRCS
VERMONT DEPARTMENT OF ENVIRONMENTAL CONSERVATION

SILT FENCE

NOTES:
REFER TO "THE VERMONT STANDARDS & SPECIFICATIONS FOR EROSION PREVENTION & SEDIMENT CONTROL -2006-" FROM THE VT AGENCY OF NATURAL RESOURCES FOR ADDITIONAL GUIDANCE.

THIS WORK SHALL BE PERFORMED IN ACCORDANCE WITH SECTION 649 AND AS SHOWN IN THE PLANS FOR GEOTEXTILE FOR SILT FENCE (PAY ITEM 649.5) OR GEOTEXTILE FOR SILT FENCE, WOVEN WIRE REINFORCED (PAY ITEM 649.515).

REVISIONS	
MARCH 21, 2008	WHF
DECEMBER 11, 2008	WHF
JANUARY 13, 2009	WHF

VAOT RURAL AREA MIX					
% WEIGHT	LBS/AC		NAME	GERM %	PURITY %
	BROADCAST	HYDROSEED			
37.5%	22.5	45	CREeping RED FESCUE	85%	98%
37.5%	22.5	45	TALL FESCUE	90%	95%
5.0%	3	6	RED TOP	90%	95%
15.0%	9	18	BIRDSFOOT TREFOIL	85%	98%
5.0%	3	6	ANNUAL RYE GRASS	85%	95%
100%	60	120			

VAOT URBAN AREA MIX					
% WEIGHT	LBS/AC		NAME	GERM %	PURITY %
	BROADCAST	HYDROSEED			
42.5%	34	68	CREeping RED FESCUE	85%	98%
10.0%	8	16	PERENNIAL RYE GRASS	90%	95%
42.5%	34	68	KENTUCKY BLUE GRASS	85%	85%
5.0%	4	8	ANNUAL RYE GRASS	85%	95%
100%	80	160			


GENERAL GUIDANCE			
FERTILIZER		LIME	
BROADCAST	HYDROSEED	BROADCAST	HYDROSEED
10/20/2010	19-19-19	PELLETIZED	LIQUID
500 LBS/AC		2 TONS/AC	4.4 GAL/AC

CONSTRUCTION GUIDANCE

- RURAL SEED MIX: USE AS INDICATED IN THE PLANS AND/OR FOR ALL ESTABLISHED UPLAND (NON WETLAND) AREAS DISTURBED BY THE CONTRACTOR.
- URBAN SEED MIX: USE AS INDICATED IN THE PLANS AND/OR FOR ALL ESTABLISHED LAWN AREAS DISTURBED BY THE CONTRACTOR.
- ALL SEED MIXTURES: SHALL NOT HAVE A WEED CONTENT EXCEEDING 0.40% BY WEIGHT AND SHALL BE FREE OF ALL NOXIOUS SEED.
- FERTILIZER AND LIMESTONE: SHALL FOLLOW RATES SHOWN ON PLAN OR AS DIRECTED BY THE ENGINEER
- HAY MULCH: TO BE PLACED ON EARTH SLOPES AT THE RATE OF 2 TONS/ACRE, ACHIEVE 90% GROUND COVER OR AS DIRECTED BY THE ENGINEER.
- TOPSOIL: TO BE USED WITH SEED AS INDICATED ON THE PLANS, OR AS DIRECTED BY THE ENGINEER.
- HYDROSEEDING: ALTHOUGH GUIDANCE IS GIVEN ABOVE THE SITE CONDITIONS AND THE TYPE OF HYDROSEED WILL ULTIMATELY DICTATE THE AMOUNTS AND TYPES OF SOIL AMENDMENTS TO BE APPLIED
- TURF ESTABLISHMENT: PLACING SEED, FERTILIZER, LIME AND MULCH PRIOR TO SEPTEMBER 15 AND AFTER APRIL 15 CAN BETTER ENSURE A VIGOROUS GROWTH OF GRASS.

SEED

THIS WORK SHALL BE PERFORMED IN ACCORDANCE WITH SECTION 651 FOR SEED (PAY ITEM 651.15)

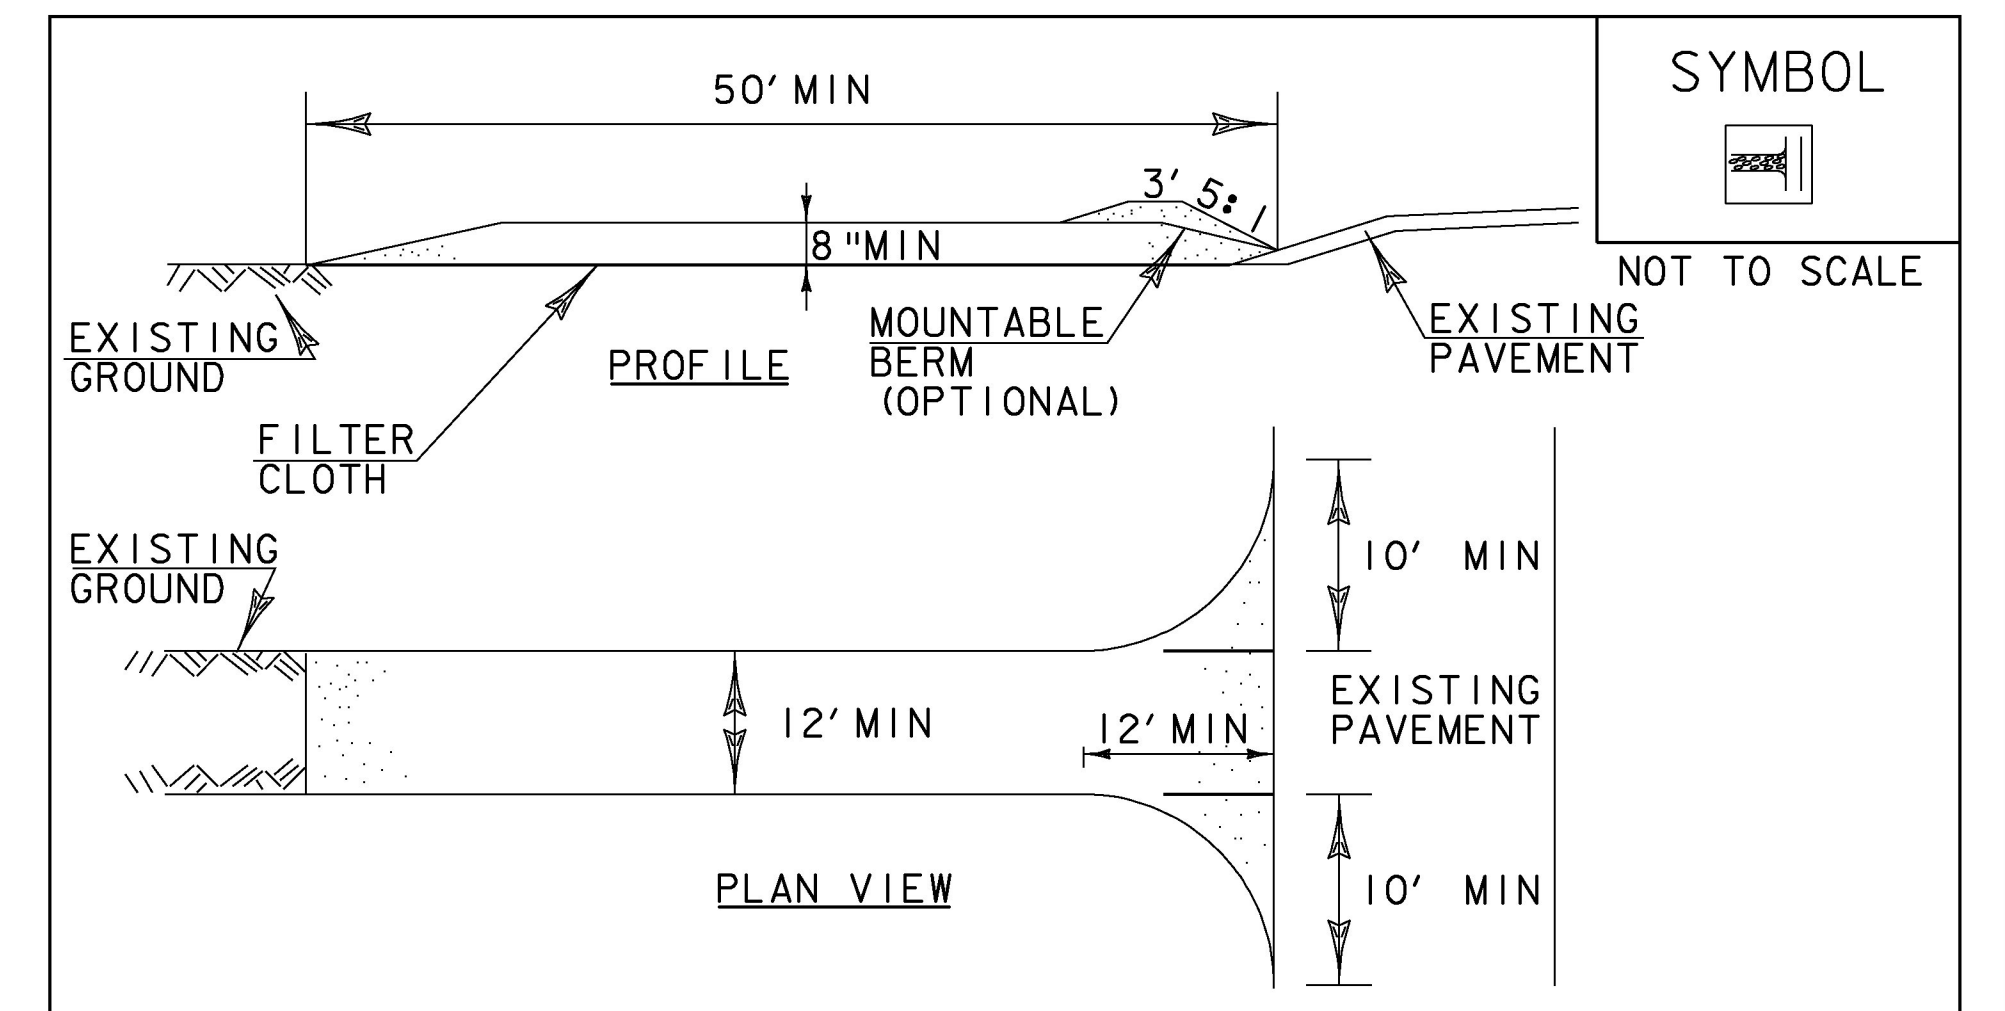

SYMBOL	
[Symbol]	STABILIZED CONSTRUCTION ENTRANCE

CONSTRUCTION SPECIFICATIONS

- STONE SIZE- USE 1-4" STONE, RECLAIMED OR RECYCLED CONCRETE EQUIVALENT.
- LENGTH- NOT LESS THAN 50' (EXCEPT ON A SINGLE RESIDENCE LOT WHERE A 30' MINIMUM LENGTH APPLIES).
- THICKNESS- NOT LESS THAN 8".
- WIDTH- 12' MINIMUM, BUT NOT LESS THAN THE FULL WIDTH AT POINTS WHERE INGRESS OR EGRESS OCCURS. 24' IF SINGLE ENTRANCE TO SITE.
- GEOTEXTILE MUST BE PLACED OVER THE ENTIRE AREA PRIOR TO PLACING STONE.
- SURFACE WATER- ALL SURFACE WATER FLOWING OR DIVERTED TOWARD CONSTRUCTION ENTRANCES SHALL BE PIPED BENEATH THE ENTRANCE. IF PIPING IS IMPRACTICAL, A MOUNTABLE BERM WITH 5:1 SLOPES WILL BE PERMITTED.
- MAINTENANCE- THE ENTRANCE SHALL BE MAINTAINED IN A CONDITION WHICH WILL PREVENT TRACKING OR FLOWING OF SEDIMENT ONTO PUBLIC RIGHTS-OF-WAY, ALL SEDIMENT SPILLED, DROPPED, WASHED OR TRACKED ONTO PUBLIC RIGHTS-OF-WAY MUST BE REMOVED IMMEDIATELY.
- WHEN WASHING IS REQUIRED, IT SHALL BE DONE ON AN AREA STABILIZED WITH STONE AND WHICH DRAINS INTO AN APPROVED SEDIMENT TRAPPING DEVICE.
- PERIODIC INSPECTION AND NEEDED MAINTENANCE SHALL BE PROVIDED ACCORDING TO PERMIT REQUIREMENTS.

ADAPTED FROM DETAILS PROVIDED BY: NEW YORK STATE DEC
ORIGINALLY DEVELOPED BY USDA-NRCS
VERMONT DEPARTMENT OF ENVIRONMENTAL CONSERVATION


STABILIZED CONSTRUCTION ENTRANCE

NOTES:
REFER TO "THE VERMONT STANDARDS & SPECIFICATIONS FOR EROSION PREVENTION & SEDIMENT CONTROL -2006-" FROM THE VT AGENCY OF NATURAL RESOURCES FOR ADDITIONAL GUIDANCE.

THIS WORK SHALL BE CONSIDERED INCIDENTAL TO THE CONTRACT

REVISIONS	
MARCH 24, 2008	WHF
JANUARY 13, 2009	WHF
FEBRUARY 17, 2010	DLL

PROJECT NAME: EAST MONTPELIER	FILE NAME: +98b028ecdetalls.dgn	PLOT DATE: 22-MAR-2010
PROJECT NUMBER: STPG 028 - 3(35)S	PROJECT LEADER: J. SCHULTZ	DRAWN BY: J. DEVLIN
	DESIGNED BY: J. GRUCHACZ	CHECKED BY: J. SCHULTZ
	EPSC DETAILS SHEET 2	SHEET 62 OF 142

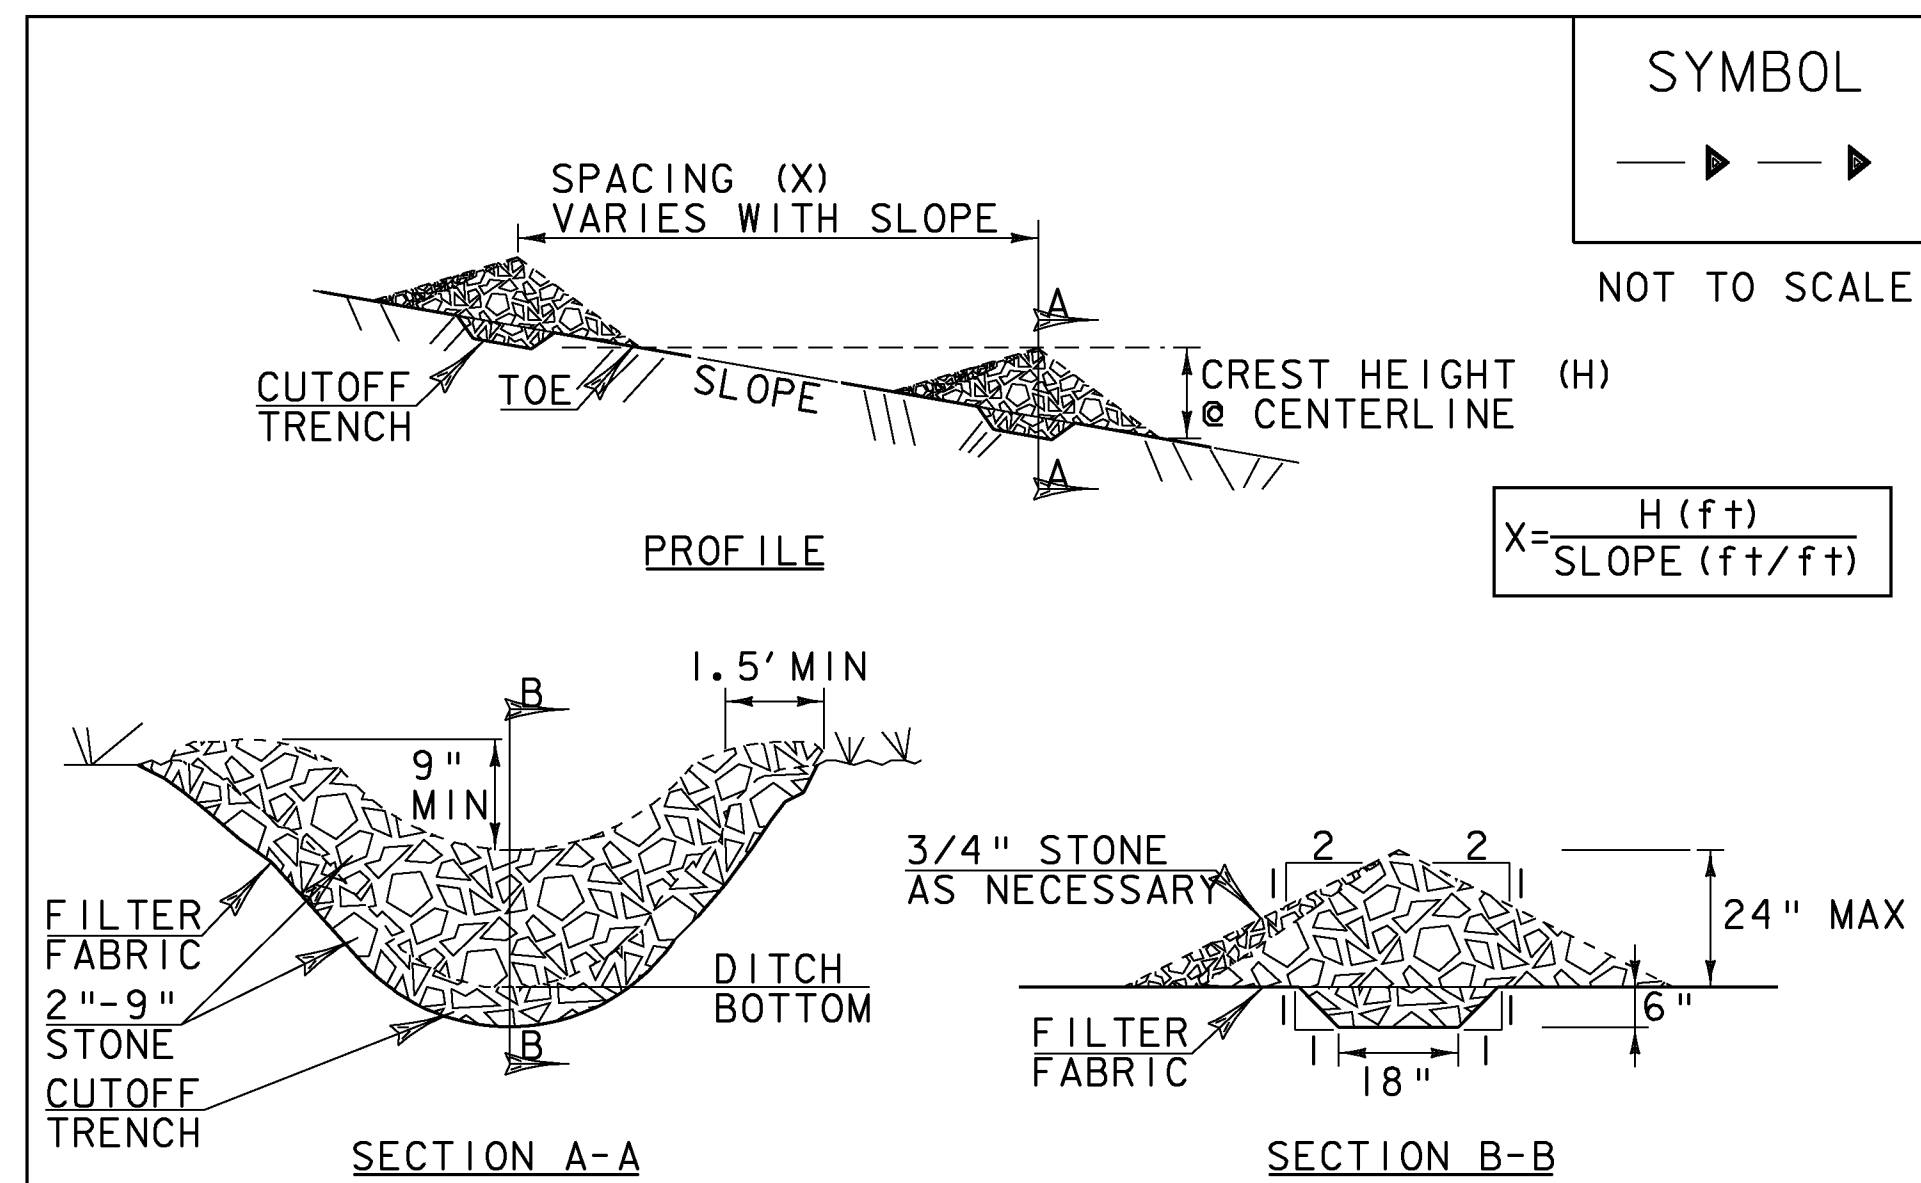

SYMBOL

 NOT TO SCALE

$$X = \frac{H (ft)}{\text{SLOPE} (ft/ft)}$$

- CONSTRUCTION SPECIFICATIONS**
1. STONE WILL BE PLACED ON A FILTER FABRIC FOUNDATION.
 2. CHECK DAMS SHALL BE SPACED SO THAT THE ELEVATION OF THE CREST OF THE DOWNSTREAM DAM IS AT THE SAME ELEVATION AS THE TOE OF THE UPSTREAM DAM.
 3. 3/4" FILTERING STONE MAY BE ADDED TO THE FACE OF THE CHECK DAM AS NECESSARY.
 4. EXTEND THE STONE A MINIMUM OF 1.5' BEYOND THE DITCH BANKS TO PREVENT CUTTING AROUND THE DAM.
 5. PROTECT CHANNEL DOWNSTREAM OF THE LOWEST CHECK DAM FROM SCOUR AND EROSION WITH STONE OR LINER AS APPROPRIATE.
 6. ENSURE THAT CHANNEL APPURTENANCES SUCH AS CULVERT ENTRANCES BELOW CHECK DAMS ARE NOT SUBJECT TO DAMAGE OR BLOCKAGE FROM DISPLACED STONE.
 7. MAXIMUM DRAINAGE AREA 2 ACRES.


ADAPTED FROM DETAILS PROVIDED BY: NEW YORK STATE DEC
 ORIGINALLY DEVELOPED BY USDA-NRCS
 VERMONT DEPARTMENT OF ENVIRONMENTAL CONSERVATION

CHECK DAM

NOTES:
 REFER TO "THE VERMONT STANDARDS & SPECIFICATIONS FOR EROSION PREVENTION & SEDIMENT CONTROL -2006- "FROM THE VT AGENCY OF NATURAL RESOURCES FOR ADDITIONAL GUIDANCE.

THIS WORK SHALL BE PERFORMED IN ACCORDANCE WITH SECTION 653 FOR TEMPORARY STONE CHECK DAM, TYPE 1(PAY ITEM 653.25)

REVISIONS	
MARCH 21, 2008	WHF
JANUARY 8, 2009	WHF

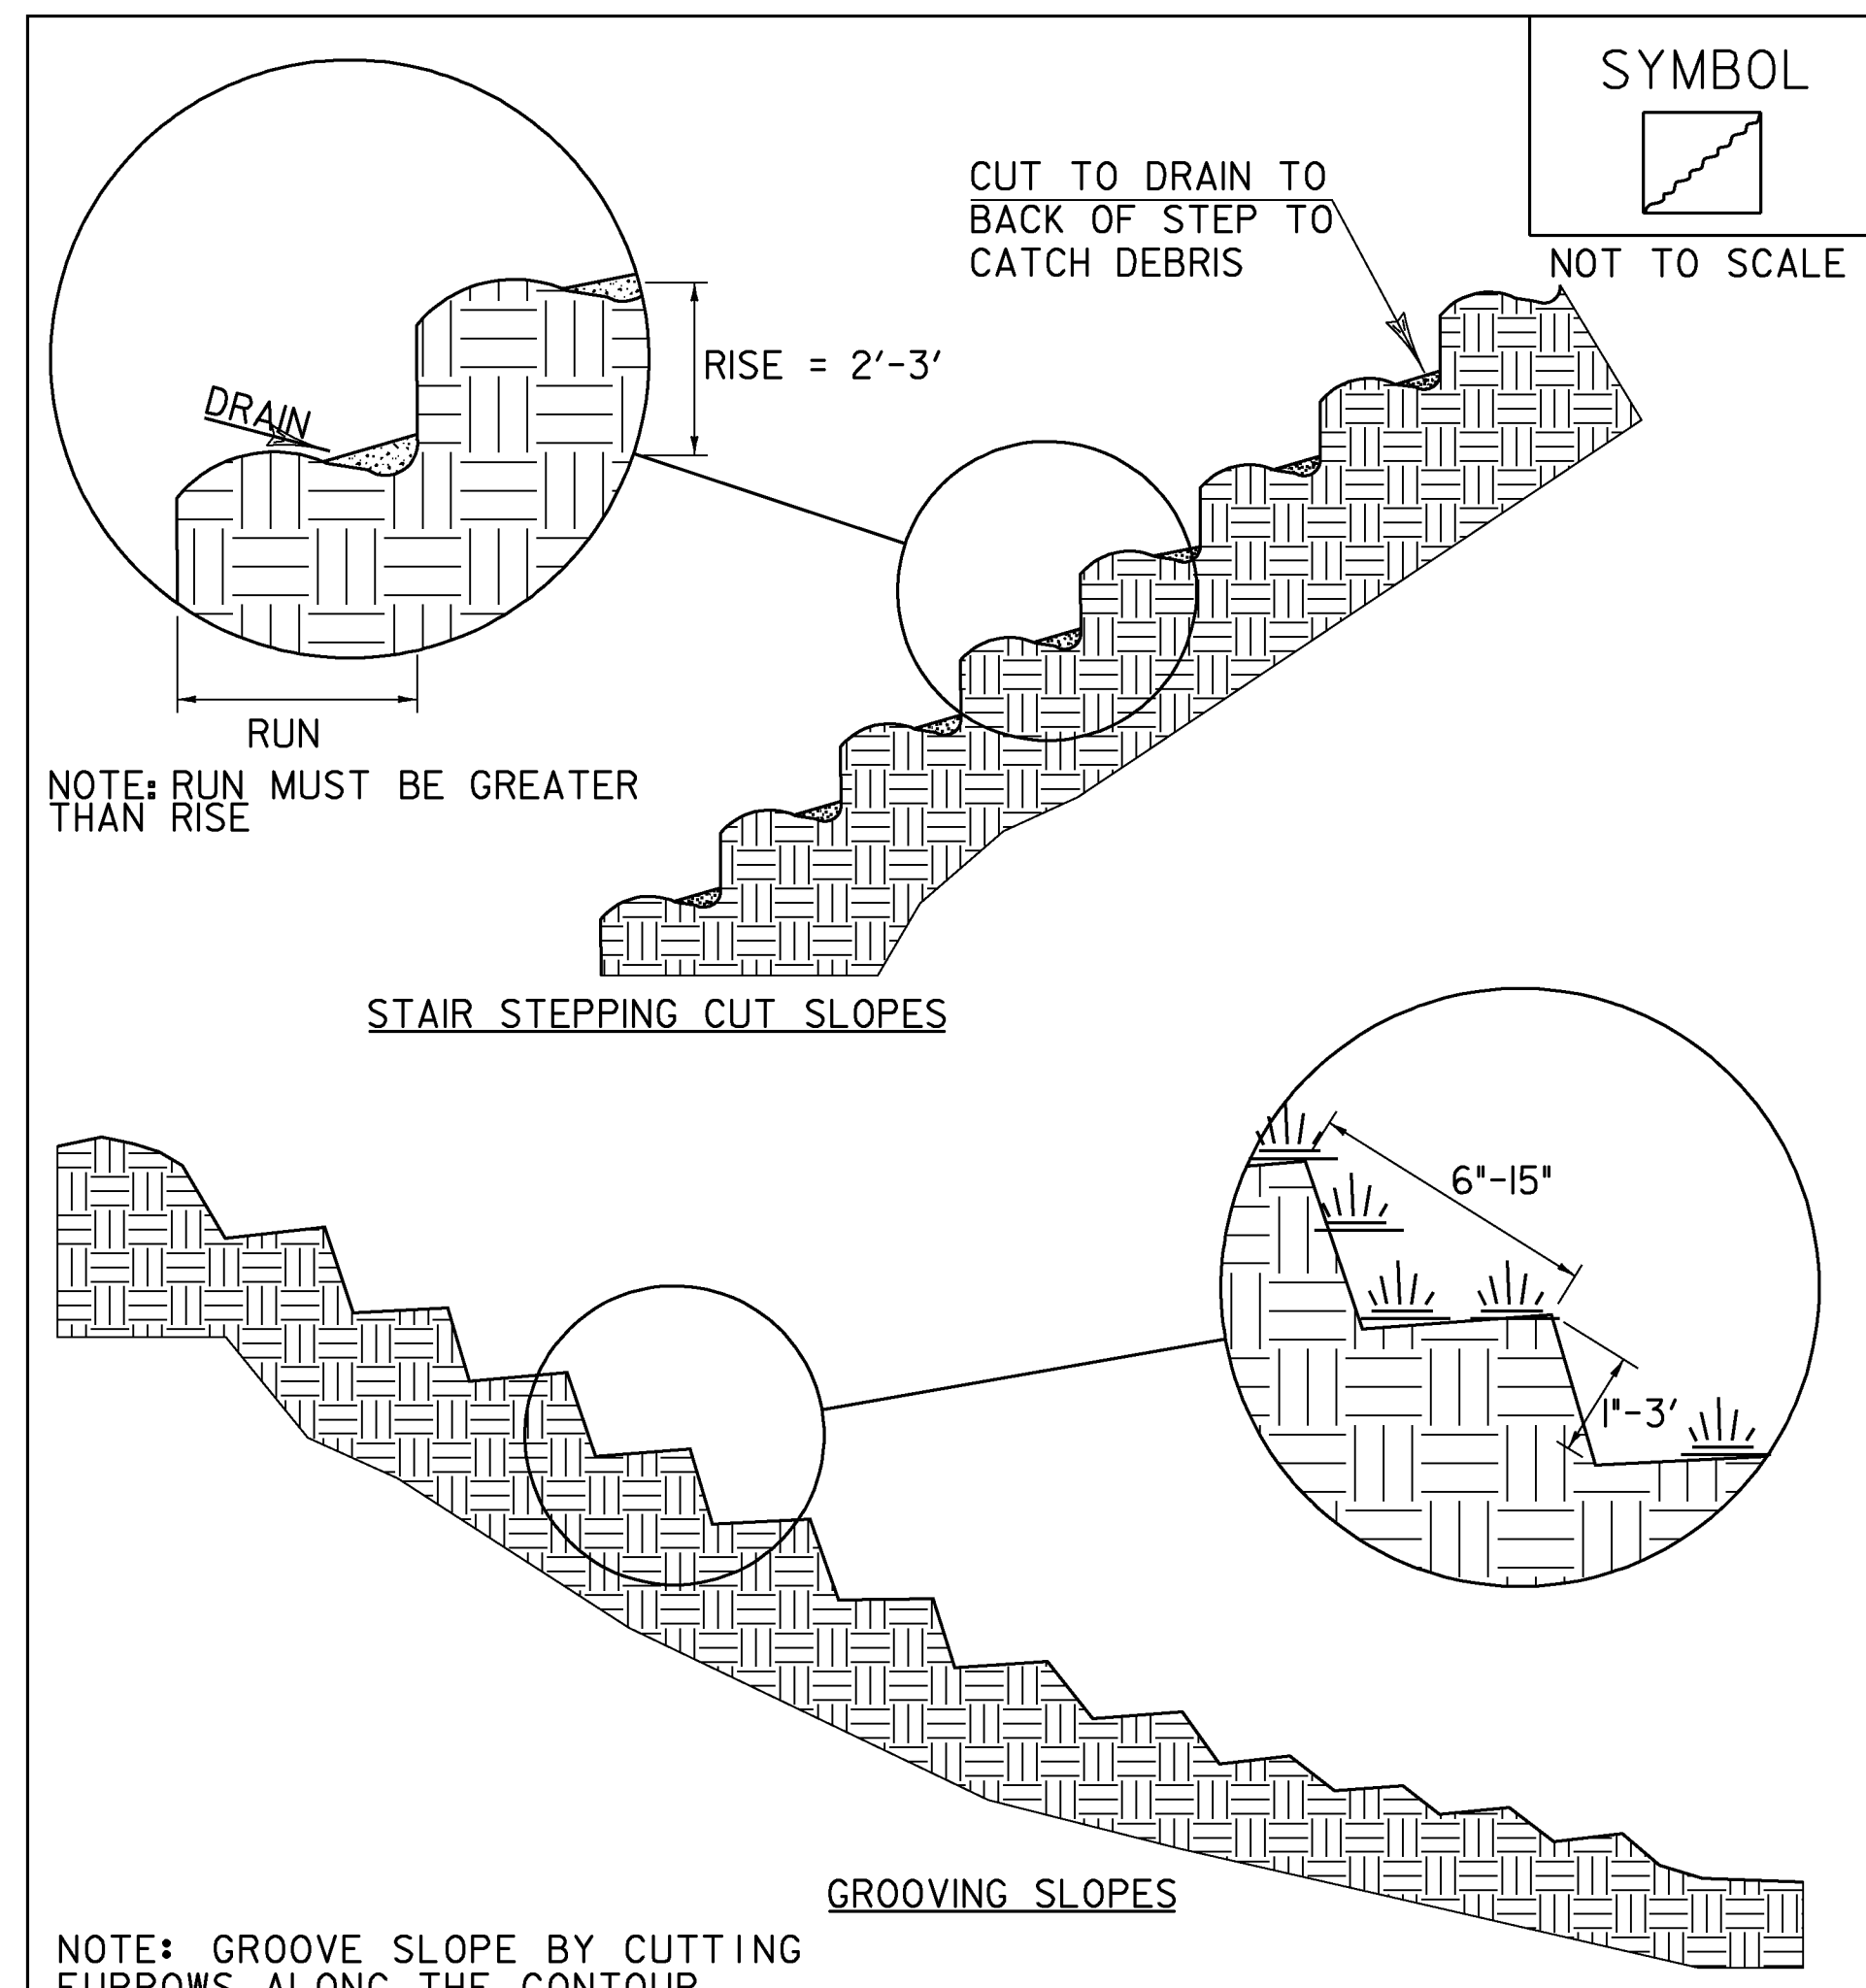

SYMBOL

 NOT TO SCALE

- NOTE: RUN MUST BE GREATER THAN RISE
- STAIR STEPPING CUT SLOPES**
- NOTE: GROOVE SLOPE BY CUTTING FURROWS ALONG THE CONTOUR. IRREGULARITIES IN THE SOIL SURFACE CATCH RAINWATER AND RETAIN LIME, FERTILIZER AND SEED.
- GROOVING SLOPES**



ADAPTED FROM DETAILS PROVIDED BY: NEW YORK STATE DEC
 ORIGINALLY DEVELOPED BY USDA-NRCS
 VERMONT DEPARTMENT OF ENVIRONMENTAL CONSERVATION

SURFACE ROUGHENING

NOTES:
 REFER TO "THE VERMONT STANDARDS & SPECIFICATIONS FOR EROSION PREVENTION & SEDIMENT CONTROL -2006- "FROM THE VT AGENCY OF NATURAL RESOURCES FOR ADDITIONAL GUIDANCE.


THIS WORK SHALL BE CONSIDERED INCIDENTAL TO THE CONTRACT

REVISIONS	
APRIL 1, 2008	WHF
JANUARY 13, 2009	WHF

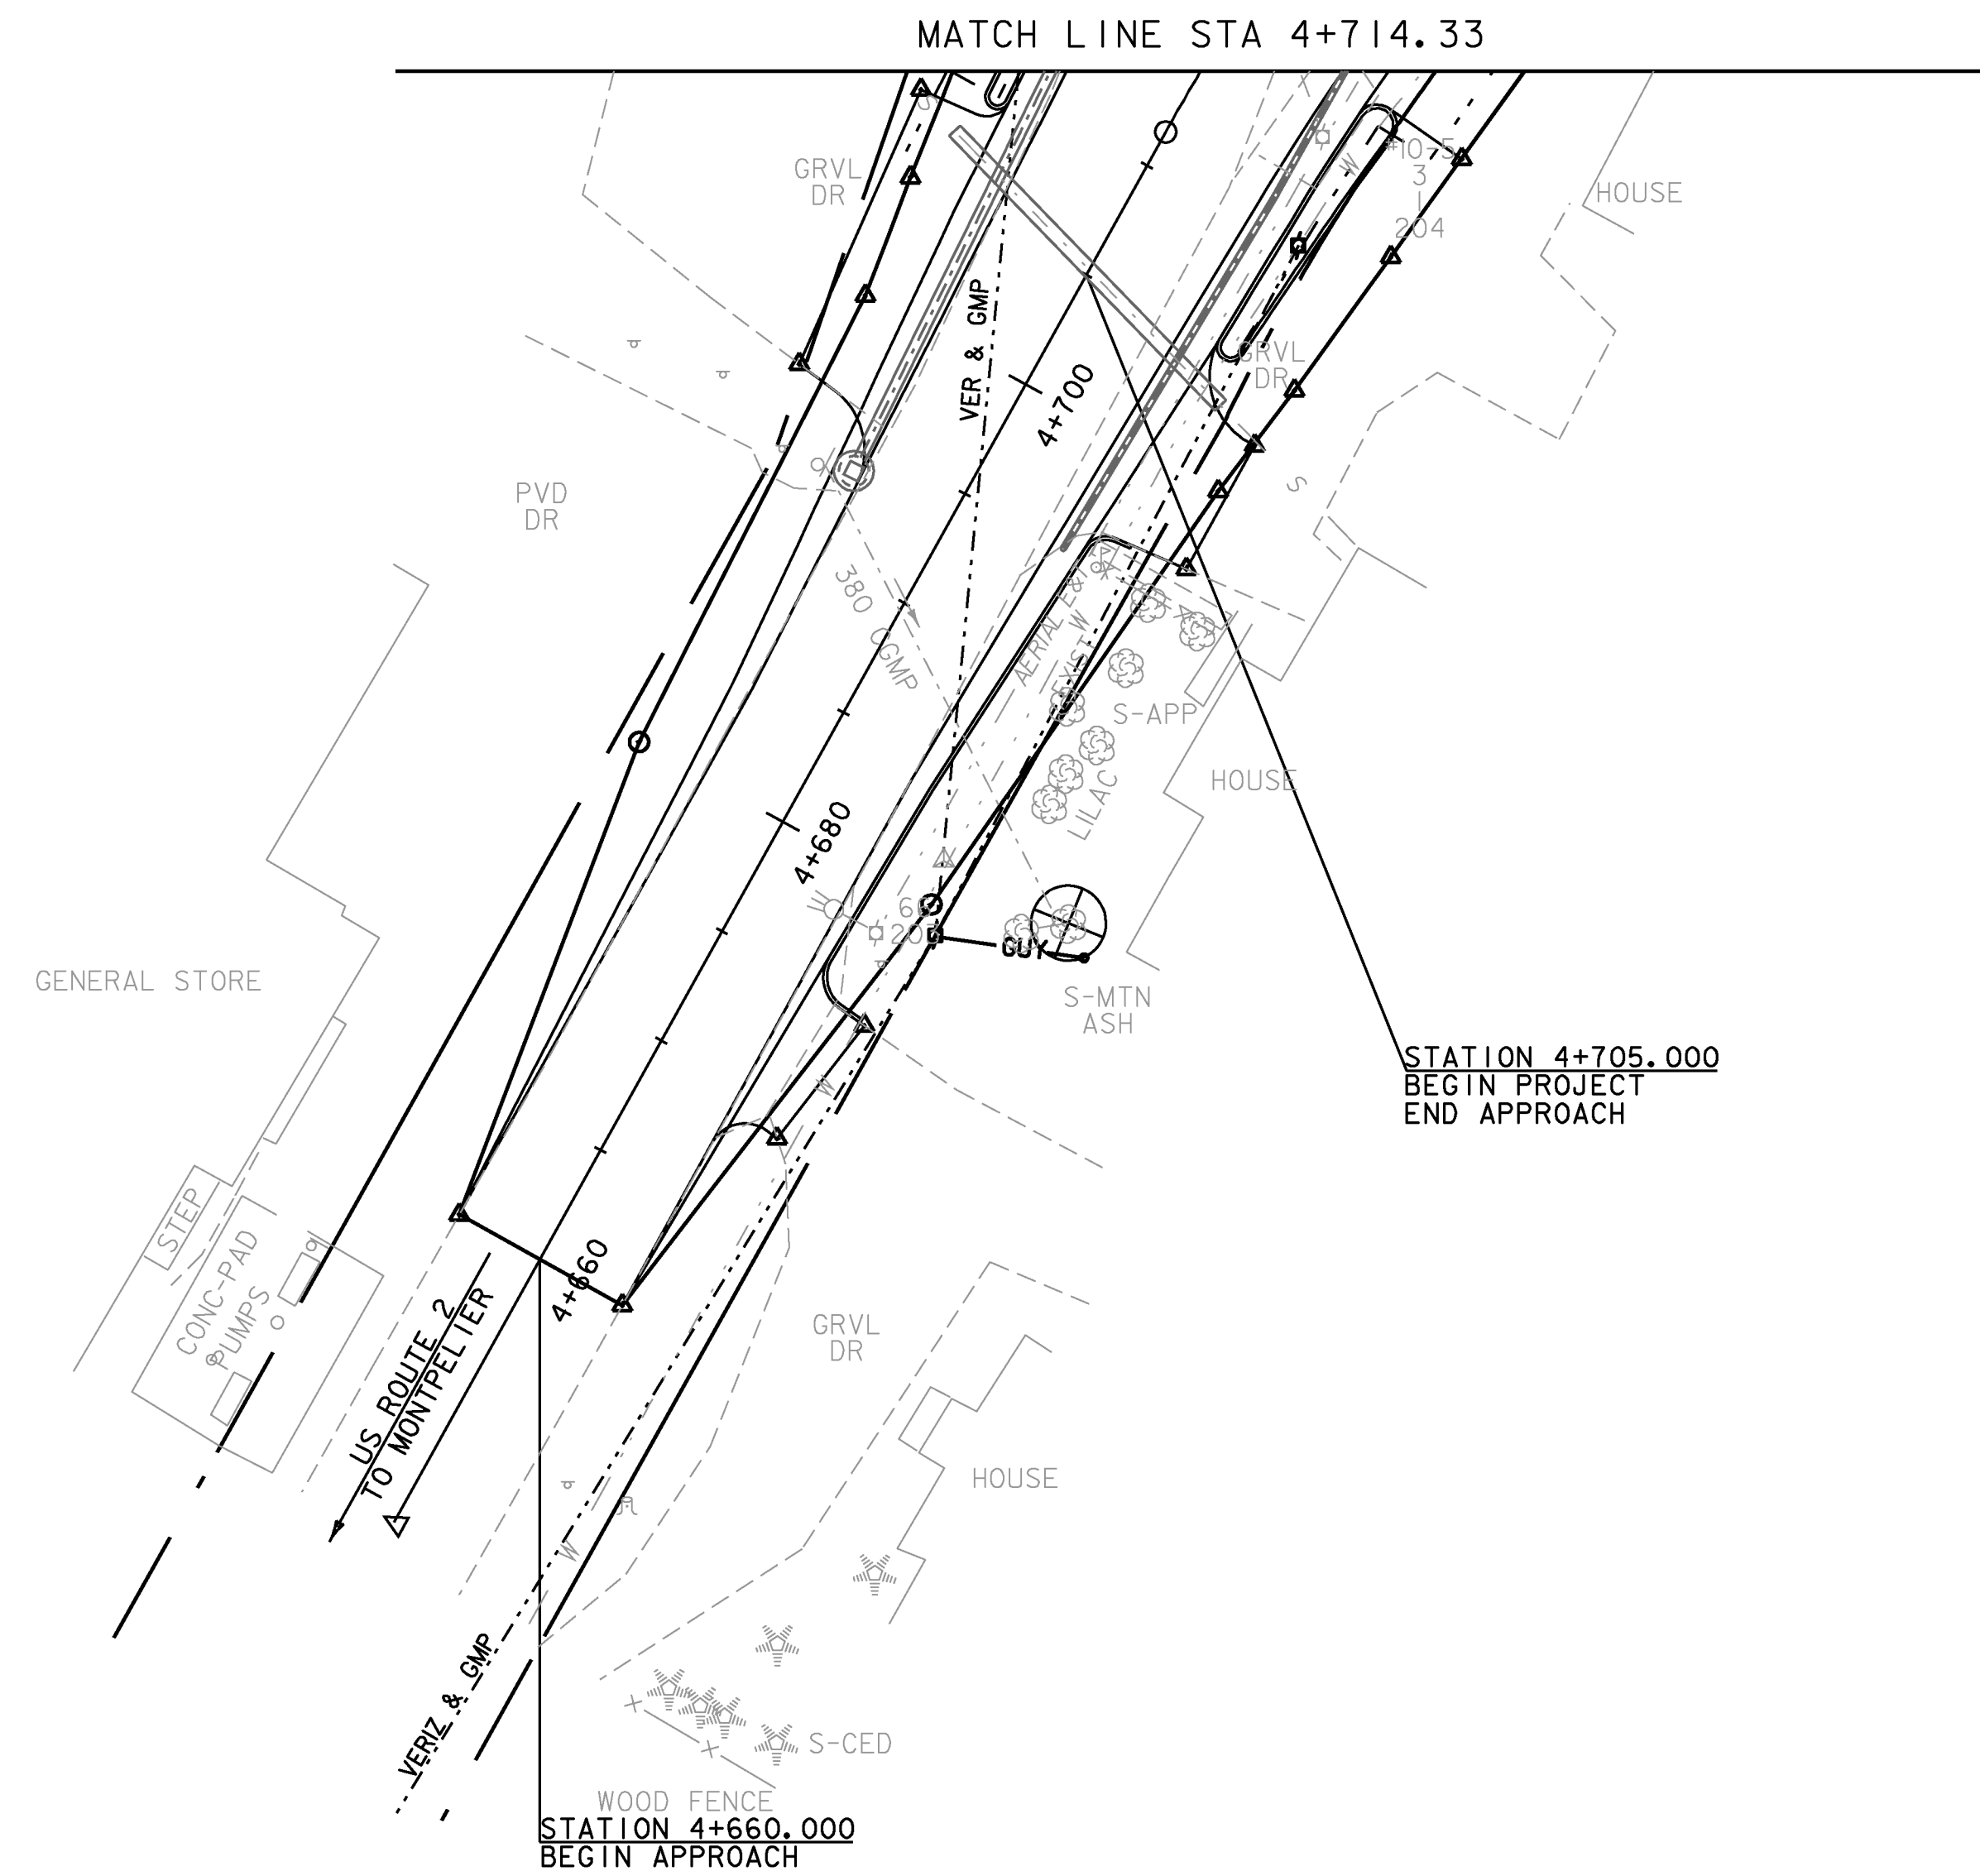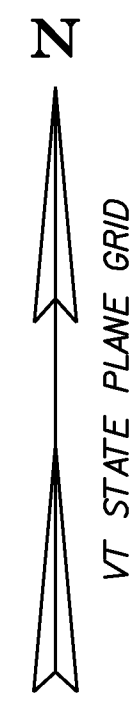

LEGEND	
	EXISTING WOODLAND
	PROPOSED DECIDUOUS TREE
	PROPOSED EVERGREEN TREE
	PROPOSED SHRUBS
	CLEAR ZONE
	AER E&T OVERHEAD UTILITY ROUTE
	TPZ TREE PROTECTION ZONE
	EXISTING TREE/SHRUB
	TREE OR STUMP REMOVAL

NOTE: SEE LANDSCAPE AND LIGHTING NOTES SHEET FOR TREE KEY AND WIRED CONDUIT SCHEDULE

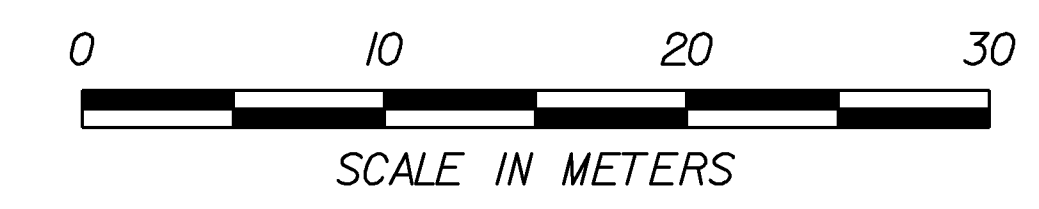


PROJECT NAME:	EAST MONTPELIER
PROJECT NUMBER:	STPG 028 - 3(35)S
FILE NAME:	+98b028landscapebdr.dgn
PROJECT LEADER:	J. SCHULTZ
DESIGNED BY:	J. GRUCHACZ
LANDSCAPE AND LIGHTING LAYOUT SHEET 1	
PLOT DATE:	22-MAR-2010
DRAWN BY:	D. LYMAN
CHECKED BY:	J. DEVLIN
LANDSCAPE AND LIGHTING LAYOUT SHEET 1	SHEET 64 OF 142

MATCH LINE STA 100+67.63

MATCH LINE STA 14+093.85

LEGEND	
	EXISTING WOODLAND
	PROPOSED DECIDUOUS TREE
	PROPOSED EVERGREEN TREE
	PROPOSED SHRUBS
	CLEAR ZONE CZ
	AERIAL E&T OVERHEAD UTILITY ROUTE
	TPZ TREE PROTECTION ZONE
	EXISTING TREE/SHRUB
	TREE OR STUMP REMOVAL

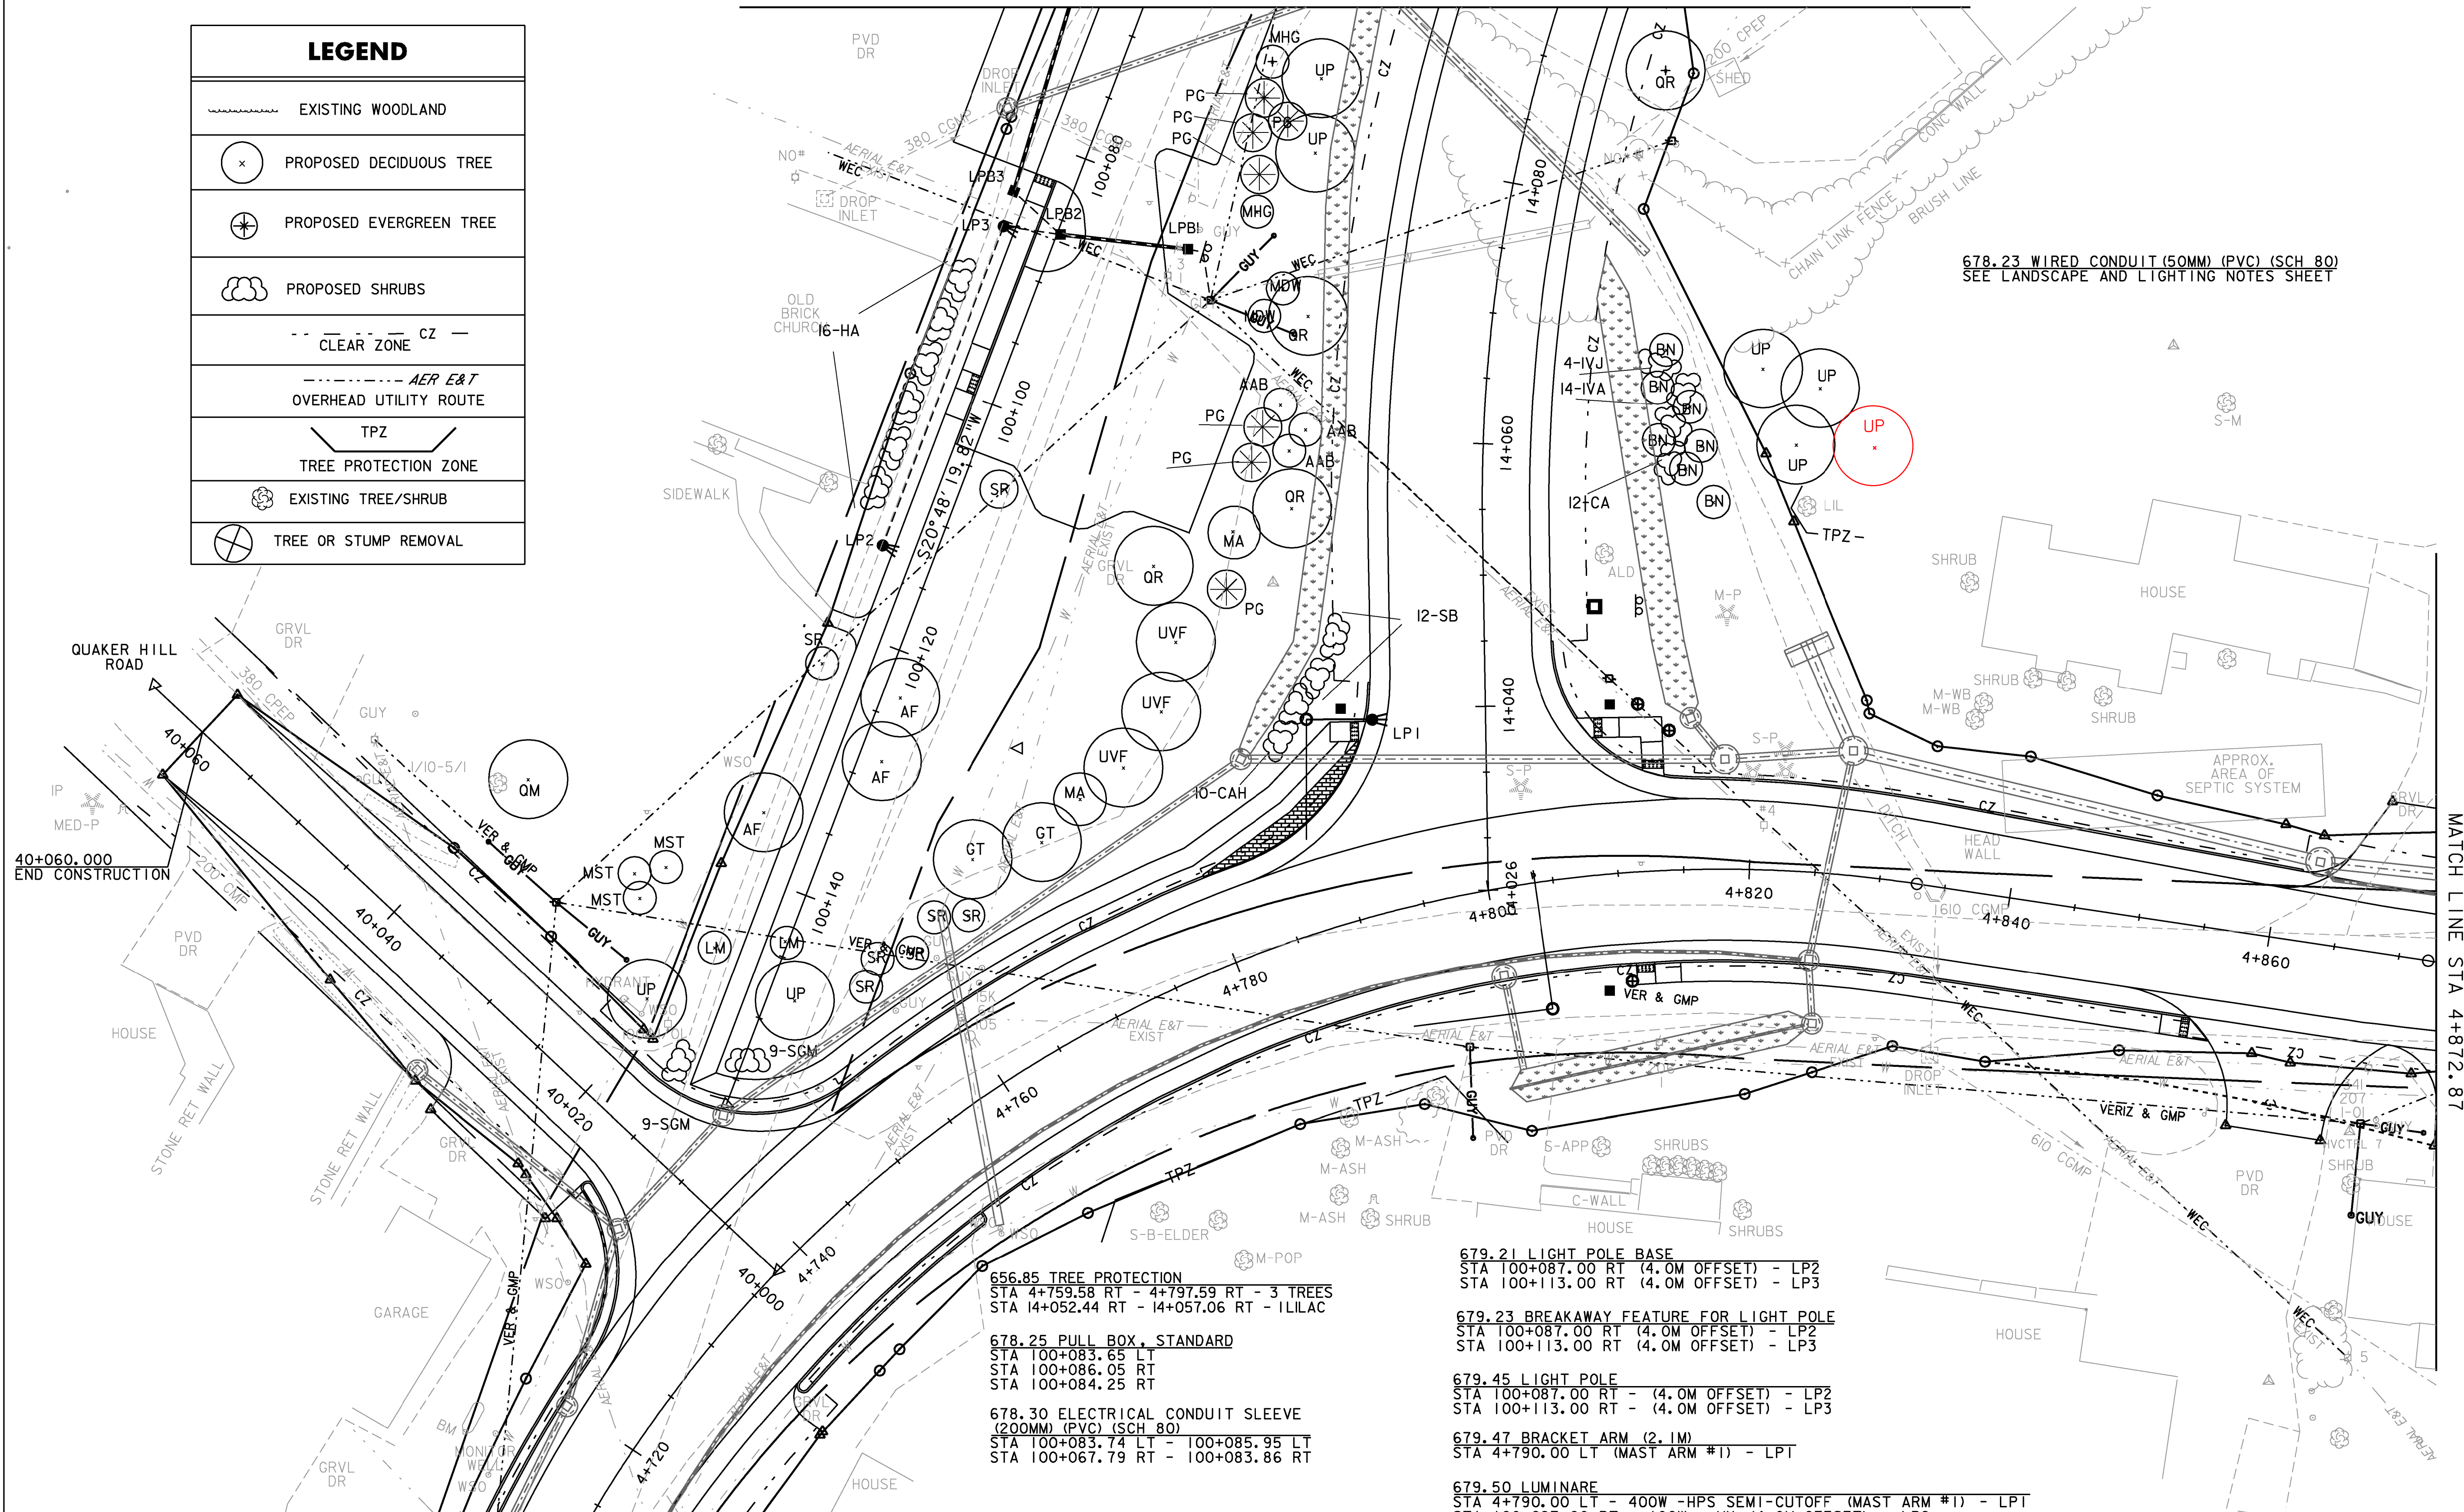

678.23 WIRED CONDUIT (50MM) (PVC) (SCH 80)
SEE LANDSCAPE AND LIGHTING NOTES SHEET

MATCH LINE STA 14+872.87

MATCH LINE STA 4+714.33

- 656.85 TREE PROTECTION
STA 4+759.58 RT - 4+797.59 RT - 3 TREES
STA 14+052.44 RT - 14+057.06 RT - 1 LILAC
- 678.25 PULL BOX, STANDARD
STA 100+083.65 LT
STA 100+086.05 RT
STA 100+084.25 RT
- 678.30 ELECTRICAL CONDUIT SLEEVE
(200MM) (PVC) (SCH 80)
STA 100+083.74 LT - 100+085.95 LT
STA 100+067.79 RT - 100+083.86 RT


- 679.21 LIGHT POLE BASE
STA 100+087.00 RT (4.0M OFFSET) - LP2
STA 100+113.00 RT (4.0M OFFSET) - LP3
- 679.23 BREAKAWAY FEATURE FOR LIGHT POLE
STA 100+087.00 RT (4.0M OFFSET) - LP2
STA 100+113.00 RT (4.0M OFFSET) - LP3
- 679.45 LIGHT POLE
STA 100+087.00 RT - (4.0M OFFSET) - LP2
STA 100+113.00 RT - (4.0M OFFSET) - LP3
- 679.47 BRACKET ARM (2.1M)
STA 4+790.00 LT (MAST ARM #1) - LPT
- 679.50 LUMINARE
STA 4+790.00 LT - 400W -HPS SEMI-CUTOFF (MAST ARM #1) - LPT
STA 100+087.00 RT - 100W - MH (4.0M OFFSET) - LP2
STA 100+113.00 RT - 100W - MH (4.0M OFFSET) - LP3

679.55 POWER DROP STANCHION, STREET LIGHTING
STA 100+083.44 LT

NOTE: SEE LANDSCAPE AND LIGHTING NOTES SHEET FOR TREE KEY AND WIRED CONDUIT SCHEDULE



PROJECT NAME:	EAST MONTPELIER
PROJECT NUMBER:	STPG 028 - 3(35)
FILE NAME:	+98b028landscapebdr.dgn
PROJECT LEADER:	J. SCHULTZ
DESIGNED BY:	J. GRUCHACZ
LANDSCAPE AND LIGHTING LAYOUT SHEET 2	
PLOT DATE:	22-MAR-2010
DRAWN BY:	D. LYMAN
CHECKED BY:	J. DEVLIN
LANDSCAPE AND LIGHTING LAYOUT SHEET 2	SHEET 65 OF 142

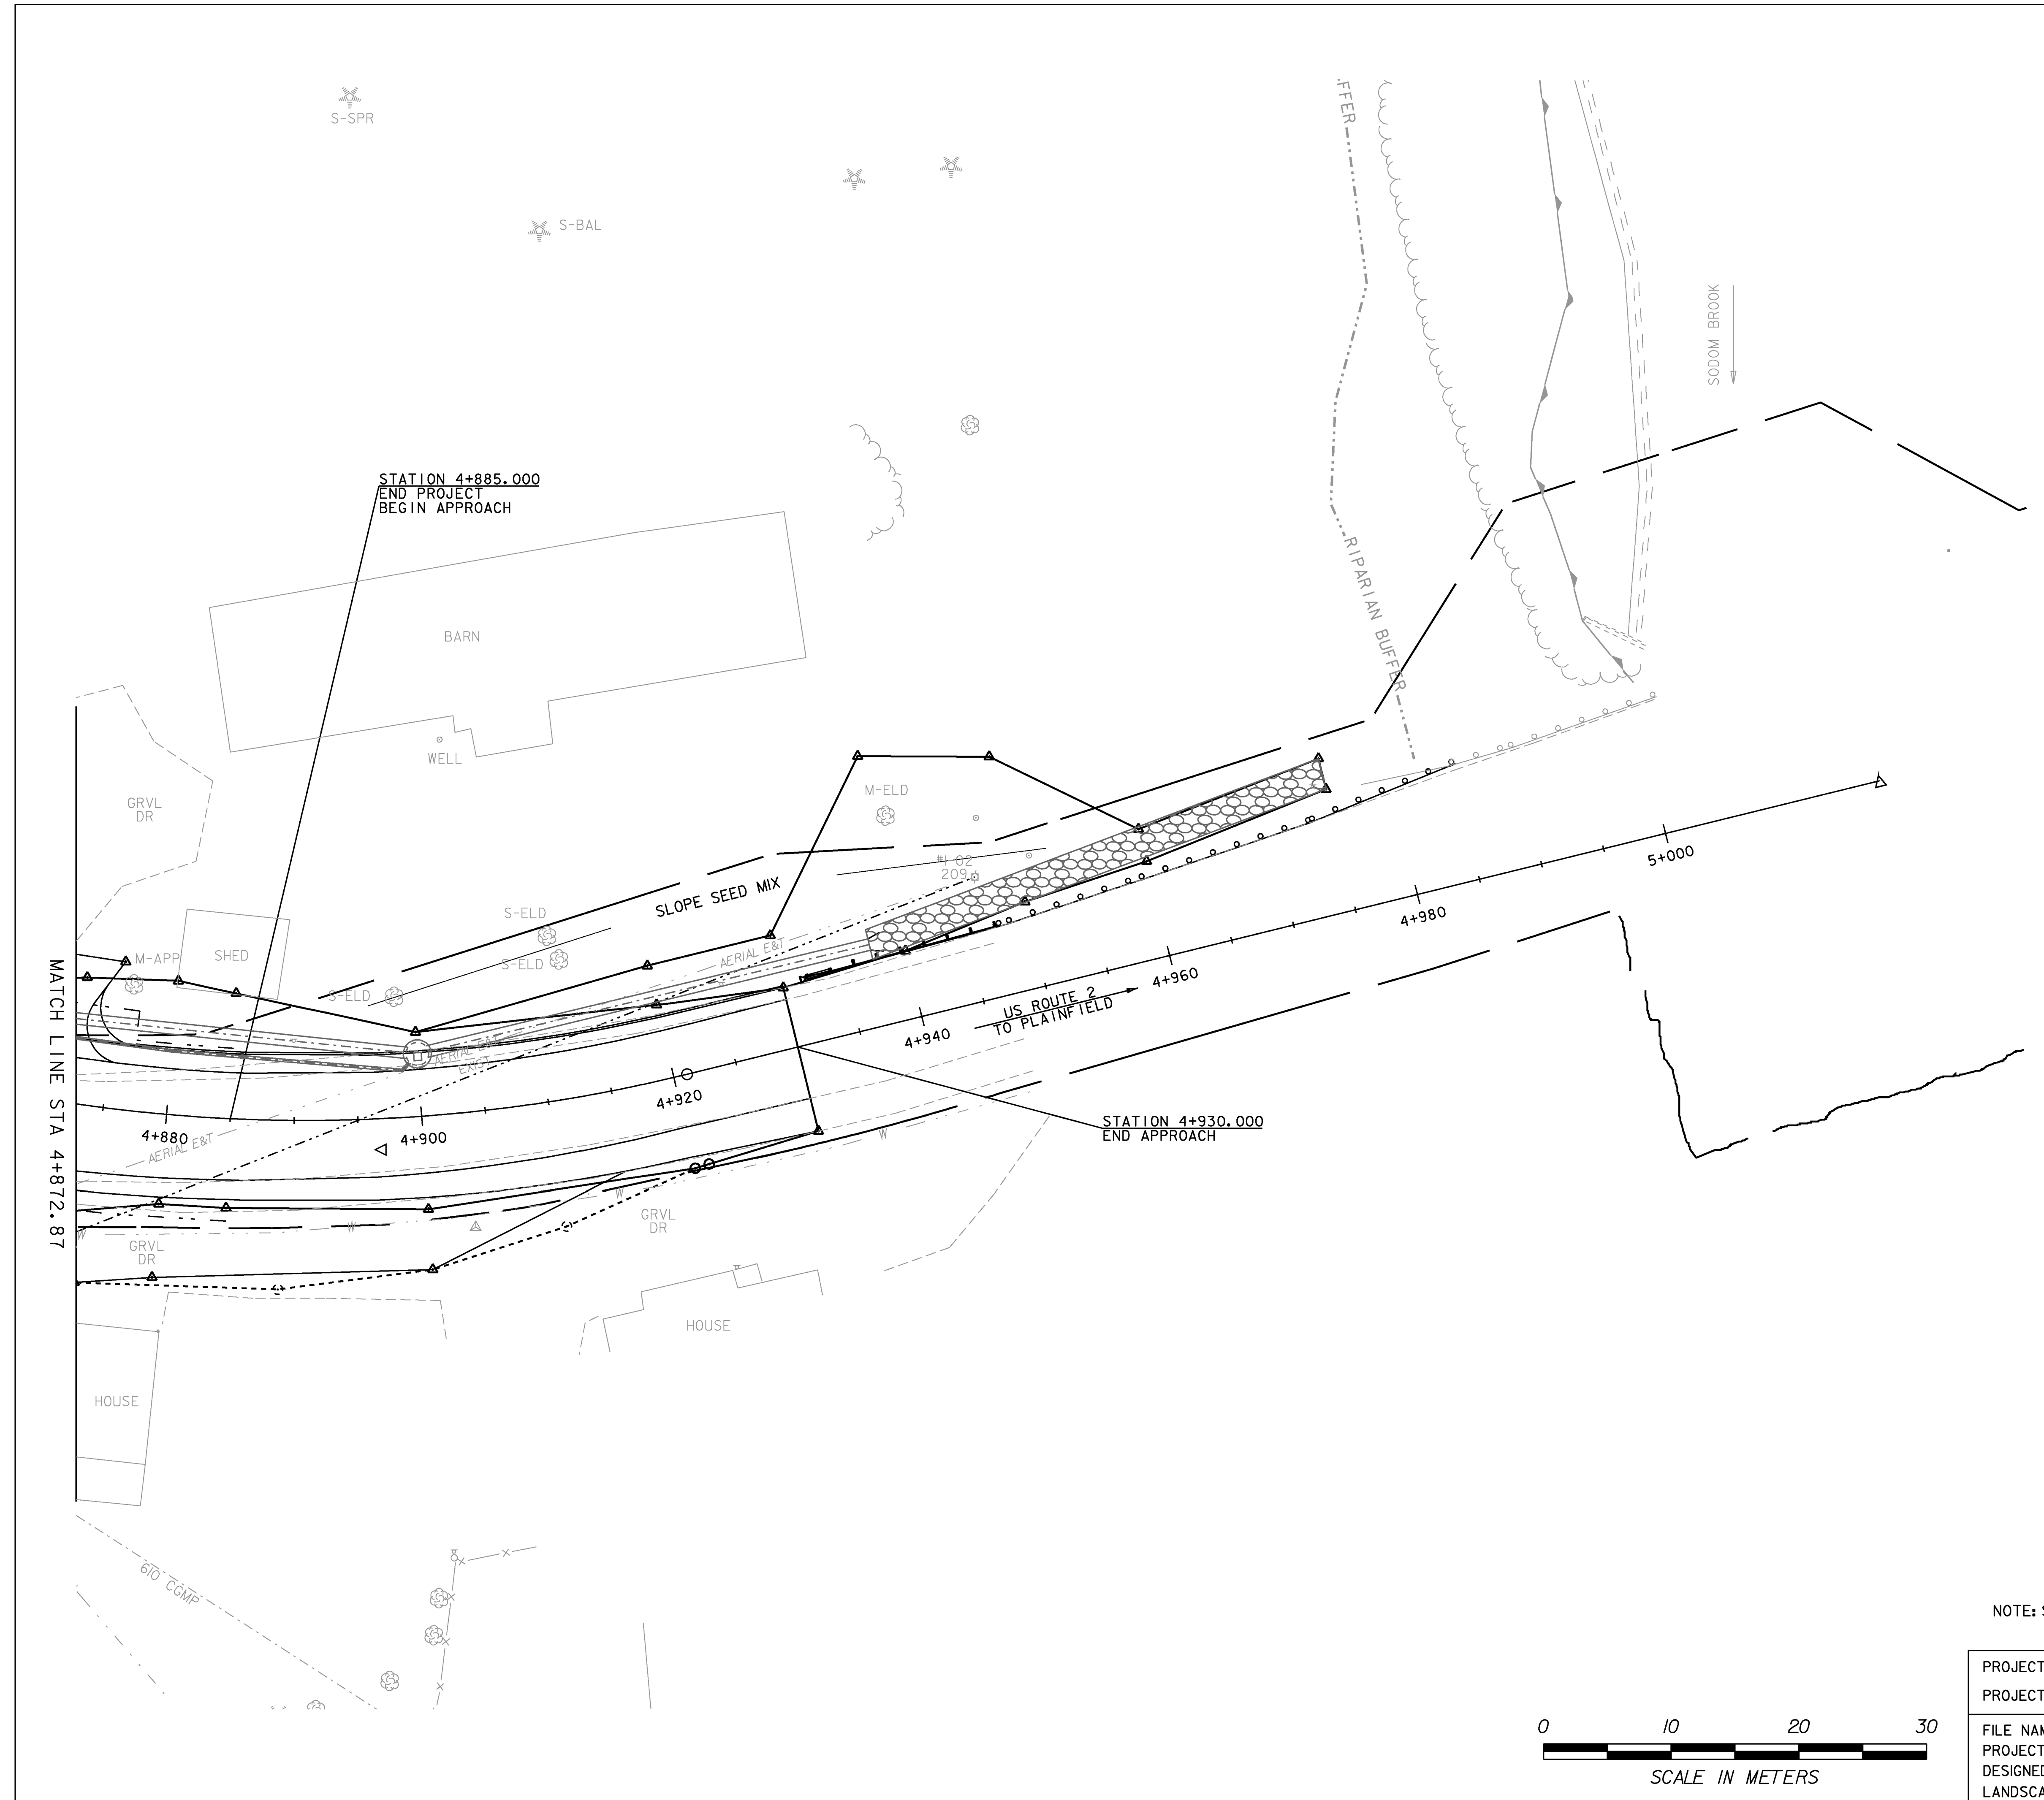


LEGEND	
	EXISTING WOODLAND
	PROPOSED DECIDUOUS TREE
	PROPOSED EVERGREEN TREE
	PROPOSED SHRUBS
	CLEAR ZONE
	AERIAL E&T OVERHEAD UTILITY ROUTE
	TREE PROTECTION ZONE
	EXISTING TREE/SHRUB
	TREE OR STUMP REMOVAL

NOTE: SEE LANDSCAPE AND LIGHTING NOTES SHEET FOR TREE KEY AND WIRED CONDUIT SCHEDULE


PROJECT NAME:	EAST MONTPELIER
PROJECT NUMBER:	STPG 028 - 3(35)S
FILE NAME:	+98b028landscapebdr.dgn
PROJECT LEADER:	J. SCHULTZ
DESIGNED BY:	J. GRUCHACZ
LANDSCAPE AND LIGHTING LAYOUT SHEET 3	PLOT DATE: 22-MAR-2010
	DRAWN BY: D. LYMAN
	CHECKED BY: J. DEVLIN
	SHEET 66 OF 142



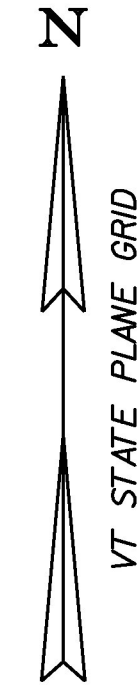

- 656.85 TREE PROTECTION
STA 30+027.05 RT - 30+042.67 RT - 2 SMALL APPLE TREES
- 678.25 PULL BOX, STANDARD
STA 100+067.40 RT
- 678.30 ELECTRICAL CONDUIT SLEEVE
(200MM) (PVC) (SCH 80)
STA 100+067.79 RT - 100+083.86 RT
- 679.21 LIGHT POLE BASE
STA 100+041.50 RT (4.5M OFFSET) - LP4
STA 100+066.00 RT (5.5M OFFSET) - LP5
- 679.23 BREAKAWAY FEATURE FOR LIGHT POLE
STA 100+041.50 RT (4.5M OFFSET) - LP4
STA 100+066.00 RT (5.5M OFFSET) - LP5
- 679.45 LIGHT POLE
STA 100+041.50 RT (4.5M OFFSET) - LP4
STA 100+066.00 RT (5.5M OFFSET) - LP5
- 679.50 LUMINAIRE
STA 100+041.50 RT - 100W - MH (4.5M OFFSET) - LP4
STA 100+066.00 RT - 100W - MH (5.5M OFFSET) - LP5

LEGEND	
	EXISTING WOODLAND
	PROPOSED DECIDUOUS TREE
	PROPOSED EVERGREEN TREE
	PROPOSED SHRUBS
	CLEAR ZONE CZ
	AERIAL E&T OVERHEAD UTILITY ROUTE
	TPZ TREE PROTECTION ZONE
	EXISTING TREE/SHRUB
	TREE OR STUMP REMOVAL

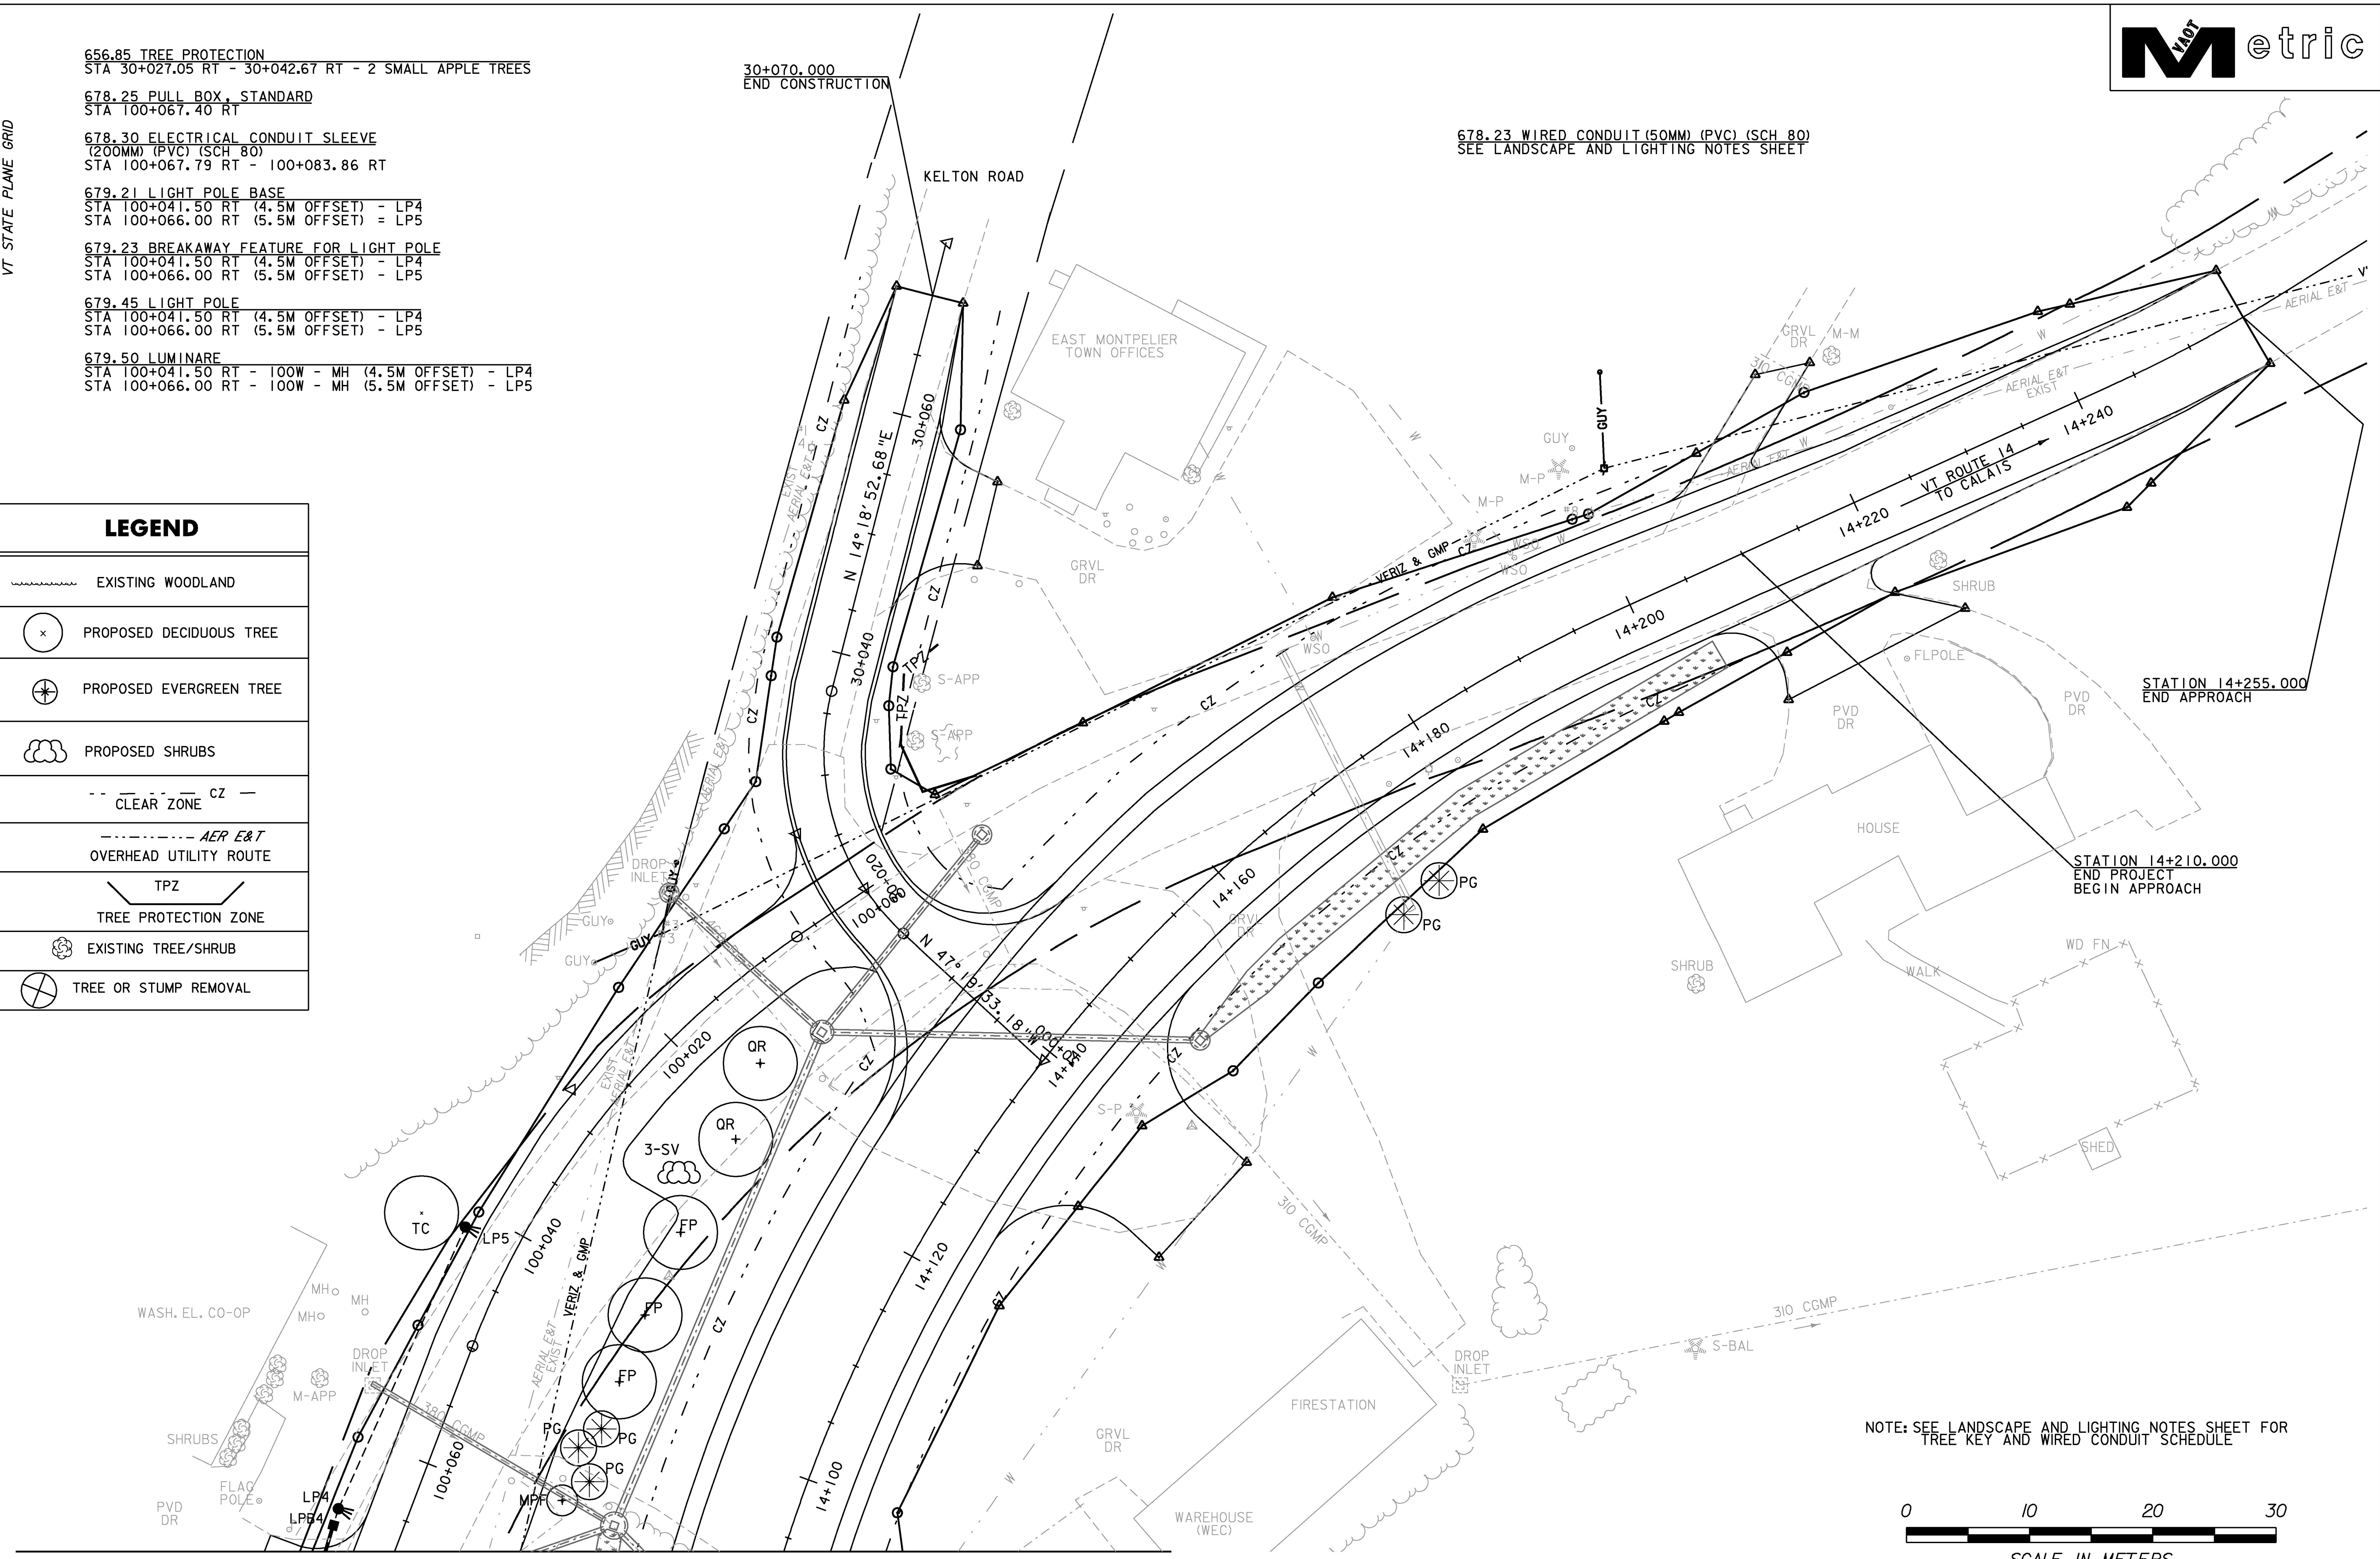

MATCH LINE STA 100+67.63 MATCH LINE STA 14+093.85

NOTE: SEE LANDSCAPE AND LIGHTING NOTES SHEET FOR TREE KEY AND WIRED CONDUIT SCHEDULE



PROJECT NAME:	EAST MONTPELIER
PROJECT NUMBER:	STPG 028 - 3(35)S
FILE NAME:	+98b028landscapebdr.dgn
PROJECT LEADER:	J. SCHULTZ
DESIGNED BY:	J. GRUCHACZ
LANDSCAPE AND LIGHTING LAYOUT SHEET 4	
PLOT DATE:	22-MAR-2010
DRAWN BY:	D. LYMAN
CHECKED BY:	J. DEVLIN
LANDSCAPE AND LIGHTING LAYOUT SHEET 4	SHEET 67 OF 142

PLANT LIST

PLANT LIST - EAST MONTPELIER STPG 028-3(35)S						
QTY	KEY	BOTANICAL NAME	COMMON NAME	SIZE	CONTAINER	SPACING, REMARKS, ITEMS
656.20 - EVERGREEN TREES						
12	PG	PICEA GLAUCA	WHITE SPRUCE	2.1 - 2.4 m HEIGHT	B&B	AS SHOWN - SPRING PLANTING
656.30 - SMALL DECIDUOUS TREES						
3	AAB	AMELANCHIER "AUTUMN BRILLIANCE"	SERVICEBERRY "AUTUMN BRILLIANCE"	0.045 - 0.050 m CAL.	B&B	AS SHOWN - SPRING PLANTING
2	LM	MAGNOLIA X LOEBNERI "LEONARD MESSEL"	"LEONARD MESSEL" MAGNOLIA	0.045 - 0.050 m CAL.	B&B	AS SHOWN - SPRING PLANTING
2	MA	MALUS "ADAMS"	"ADAMS" CRABAPPLE	0.045 - 0.050 m CAL.	B&B	AS SHOWN - SPRING PLANTING
2	MDW	MALUS "DONALD WYMAN"	"DONALD WYMAN" CRABAPPLE	0.045 - 0.050 m CAL.	B&B	AS SHOWN - SPRING PLANTING
2	MHG	MALUS "HARVEST GOLD"	"HARVEST GOLD" CRABAPPLE	0.045 - 0.050 m CAL.	B&B	AS SHOWN - SPRING PLANTING
1	MPF	MALUS "PRAIRIE FIRE"	"PRAIRIE FIRE" CRABAPPLE	0.045 - 0.050 m CAL.	B&B	AS SHOWN - SPRING PLANTING
3	MST	MALUS "SUGAR TYME"	"SUGAR TYME" CRABAPPLE	0.045 - 0.050 m CAL.	B&B	AS SHOWN - SPRING PLANTING
7	SR	SYRINGA RETICULATA "IVORY SILK"	"IVORY SILK" TREE LILAC	0.045 - 0.050 m CAL.	B&B	AS SHOWN - SPRING PLANTING
656.30 - LARGE DECIDUOUS TREES						
3	AF	ACER FREMANII X AUTUMN BLAZE	"AUTUMN BLAZE" MAPLE	0.050 - 0.065 m CAL.	B&B	AS SHOWN - SPRING PLANTING
7	BN	BELTA NIGRA "HERITAGE"	"HERITAGE RIVER BIRCH"	0.050 - 0.065 m CAL.	B&B	AS SHOWN - SPRING PLANTING
3	FP	FRAXINUS PENNSYLVANICA "SUMMIT"	"SUMMIT" GREEN ASH	0.050 - 0.065 m CAL.	B&B	AS SHOWN - SPRING PLANTING
2	GT	GLEDITSIA TRIACANTHOS INERMIS "SHADEMASTER"	"SHADEMASTER" HONEYLOCUST	0.050 - 0.065 m CAL.	B&B	AS SHOWN - SPRING PLANTING
1	TC	TILIA CORDATA "GREENSPIRE"	LINDEN "GREENSPIRE"	0.050 - 0.065 m CAL.	B&B	AS SHOWN - SPRING PLANTING
1	QM	QUERCUS MACROCARPA	BURR OAK	0.050 - 0.065 m CAL.	B&B	AS SHOWN - SPRING PLANTING
6	QR	QUERCUS RUBRA	RED OAK	0.050 - 0.065 m CAL.	B&B	AS SHOWN - SPRING PLANTING
8	UP	ULMUS AMERICANA "PRINCETON"	"PRINCETON" ELM	0.050 - 0.065 m CAL.	B&B	AS SHOWN - SPRING PLANTING
3	UVF	ULMUS AMERICANA "VALLEY FORGE"	"VALLEY FORGE" ELM	0.050 - 0.065 m CAL.	B&B	AS SHOWN - SPRING PLANTING
656.35 - DECIDUOUS SHRUBS						
10	CAH	CLETHRA ALNIFOLIA "HUMMINGBIRD"	HUMMINGBIRD SUMMERSWEET	0.45 m HEIGHT	CONTAINER	1.00 m o.c. - SPRING PLANTING
12	CA	CLETHRA ALNIFOLIA "RUBY SPICE"	RUBY SPICE SUMMERSWEET	0.60 m HEIGHT	CONTAINER	1.00 m o.c. - SPRING PLANTING
16	HA	HYDRANGEA ARBORESCENS "ANNABELLE"	ANNABELLE HYDRANGEA	0.60 m HEIGHT	CONTAINER	1.00 m o.c. - SPRING PLANTING
4	IJ	ILEX VERTICILATA "JIM DANDY"	WINTERBERRY "JIM DANDY"	0.90 m HEIGHT	CONTAINER	1.00 m o.c. - SPRING PLANTING
14	IJA	ILEX VERTICILATA "AFTERGLOW"	WINTERBERRY "AFTERGLOW"	0.90 m HEIGHT	CONTAINER	1.00 m o.c. - SPRING PLANTING
18	SGM	SPIREA X "GOLD MOUND"	"GOLD MOUND" SPIREA	0.45 m HEIGHT	CONTAINER	1.00 m o.c. - SPRING PLANTING
3	SV	SYRINGA VULGARIS	COMMON LILAC	0.90 m HEIGHT	CONTAINER	1.20 m o.c. - SPRING PLANTING
12	SB	SPIREA X BULMALDA "GOLD FLAME"	"GOLD FLAME" SPIREA	0.60 m HEIGHT	CONTAINER	1.00 m o.c. - SPRING PLANTING

GENERAL LANDSCAPE NOTES:

- FOLLOW STATE OF VERMONT AGENCY OF TRANSPORTATION STANDARD SPECIFICATIONS FOR CONSTRUCTION, DATED 2006, AS MODIFIED, SECTION 656 AND SECTION 755.
- SEE SUBSECTION 755.07 FOR THE APPLICATION OF MYCORRHIZAL FUNGI PER MANUFACTURER'S RECOMMENDATIONS. LANDSCAPING BACKFILL MIX SHALL COMPLY WITH SUBSECTION 755.01, TOPSOIL 755.02, AND COMPOST 755.05 SHALL COMPLY WITH THE RECOMMENDED AMOUNT OF ORGANIC MATERIAL AS SPECIFIED.
- LANDSCAPE BACKFILL MIX SHALL BE TESTED FOR ORGANIC MATERIAL OF 8.6%.
- CONTRACTOR SHALL PROVIDE A LOG TO THE RESIDENT SHOWING DATES OF WATERING AND NOTING NATURAL RAINFALL EVENTS WHEN NO WATERING OCCURS. WATERING SHALL COMPLY WITH SUBSECTION 656.08 (F.) WATERING.
- BARK MULCH SHALL CONFORM TO THE MATERIALS REQUIREMENTS OF SUBSECTION 755.10 (C) BARK MULCH FOR CEDAR AND PINE ONLY.

TREE PROTECTION NOTES:

- DURING CONSTRUCTION: PROTECT TREES TO BE SAVED BY ERECTING BARRIER FENCE JUST AT LIMIT OF CONSTRUCTION AS INDICATED (PLEASE SEE LANDSCAPE PLANS AND TREE PROTECTION DETAIL). INSTALL SIGNAGE AT EACH PROTECTION ZONE WHICH CLEARLY READS: "TREES ARE BEING PROTECTED. NO UNAUTHORIZED TRESPASS IS ALLOWED".
- AVOID CUTTING ROOTS OF TREES WHENEVER POSSIBLE. WHEN AVOIDANCE IS NOT POSSIBLE, CUT ROOTS FLUSH (SAW THOSE ROOTS GREATER THAN 25 MM WIDE), WHICH WILL ENCOURAGE NEW ROOT GROWTH. DO NOT RIP ROOTS WITH EXCAVATOR OR OTHER HEAVY EQUIPMENT.
- BACKFILL AS SOON AS POSSIBLE; KEEP ROOT ENDS MOIST WITH WET BURLAP OR SIMILAR MATERIAL UNTIL ABLE TO BACKFILL. ADD A ROOT STIMULATOR SUCH AS MYCORRHIZAL FUNGI PER MANUFACTURER'S INSTRUCTIONS, AND WATER (PER APPROVED WATERING SPECIFICATIONS) THE ENTIRE BACKFILL AREA WITHIN 24 HOURS.
- NO EXCAVATED OR BACKFILL MATERIAL SHALL BE PILED IN TREE PROTECTION ZONE; NO EQUIPMENT SHALL BE STORED OR PILED IN TREE PROTECTION ZONE.
- IF A PROTECTED TREE IS DAMAGED DUE TO THE CONTRACTOR'S NEGLIGENCE AND IS NOT REPAIRABLE (AS DETERMINED BY THE ENGINEER OR VAOT LANDSCAPE ARCHITECT), THEN THE CONTRACTOR SHALL REPLACE THE TREE (AT THE CONTRACTOR'S EXPENSE AND ACCORDING TO APPROVED PLANTING TECHNIQUES) WITH THE SAME TREE OF EQUAL VALUE, OR TWO OR MORE TREES WITH A TOTAL VALUE EQUAL TO THAT OF THE DAMAGED TREE. IN ADDITION, WITH THE EXCEPTION OF FENCING, ALL TREE PROTECTION MEASURES, ROOT PRUNING, AND OTHER MATERIALS WILL NOT BE PAID SEPARATELY, BUT WILL BE CONSIDERED INCIDENTAL TO ALL OTHER LANDSCAPING CONTRACT ITEMS.

LIGHTING NOTES:

- POLYMER CONCRETE AND REINFORCED FIBERGLASS U.L. LISTED PULLBOXES SHALL BE INSTALLED WITH HEAVY DUTY COVERS.
- THE CONTRACTOR SHALL ACQUIRE ALL NECESSARY PERMITS AND MAKE ALL NECESSARY ARRANGEMENTS WITH THE UTILITY COMPANY TO PROVIDE A PERMANENT POWER SUPPLY TO THE STREET LIGHTING SYSTEM. IF APPLICABLE, THE ROUTING OF POWER TO THE INTERSECTION SHALL BE SUCH THAT THE AGENCY OF TRANSPORTATION HAS FULL RESPONSIBILITY FROM THE TRANSFORMER THROUGH THE LIGHTING SYSTEM. NO INTERVENING OWNERSHIP OR RESPONSIBILITY SHALL BE ALLOWED.
- LP2, LP3, LP4, AND LP5 SHALL BE HOLOPHANE GRANVILLE PREMIER, 100 WATT METAL HALIDE (4.88 M MOUNTING HEIGHT) OR APPROVED EQUAL. ALL CORRESPONDING LIGHT POLES, BASES, AND HARDWARE SHALL BE BLACK FINISH.


WIRED CONDUIT SCHEDULE:

678.23 - WIRED CONDUIT	CONDUIT SIZE	DESCRIPTION
	50mm	
POWER TO STANCHION	15.0M	*POWER
STANCHION TO LPB1	5.3M	POWER
LPB1 TO LPB2	23.6M (2x11.8M)	POWER
LPB2 TO LP3	6.4M	POWER
LP3 TO LP2	28.0M	POWER
LPB2 TO LPB3	6.8M	POWER
LPB3 TO LPB4	18.9M	POWER
LPB4 TO LP4	3.4M	POWER
LP4 TO LP5	27.1M	POWER
SUBTOTALS	134.5 M	
ROUNDING	5.5 M	
TOTALS	140.0 M	

*-CONDUIT QUANTITY INCLUDES PVC RUN ON UTILITY POLE


PROJECT NAME: EAST MONTPELIER	
PROJECT NUMBER: STPG 028 - 3(35)S	
FILE NAME: +98b028\scapbdr.dgn	PLOT DATE: 22-MAR-2010
PROJECT LEADER: J. SCHULTZ	DRAWN BY: D. LYMAN
DESIGNED BY: J. GRUCHACZ	CHECKED BY: J. DEVLIN
LANDSCAPE AND LIGHTING NOTES SHEET	SHEET 68 OF 142

LANDSCAPE DETAILS

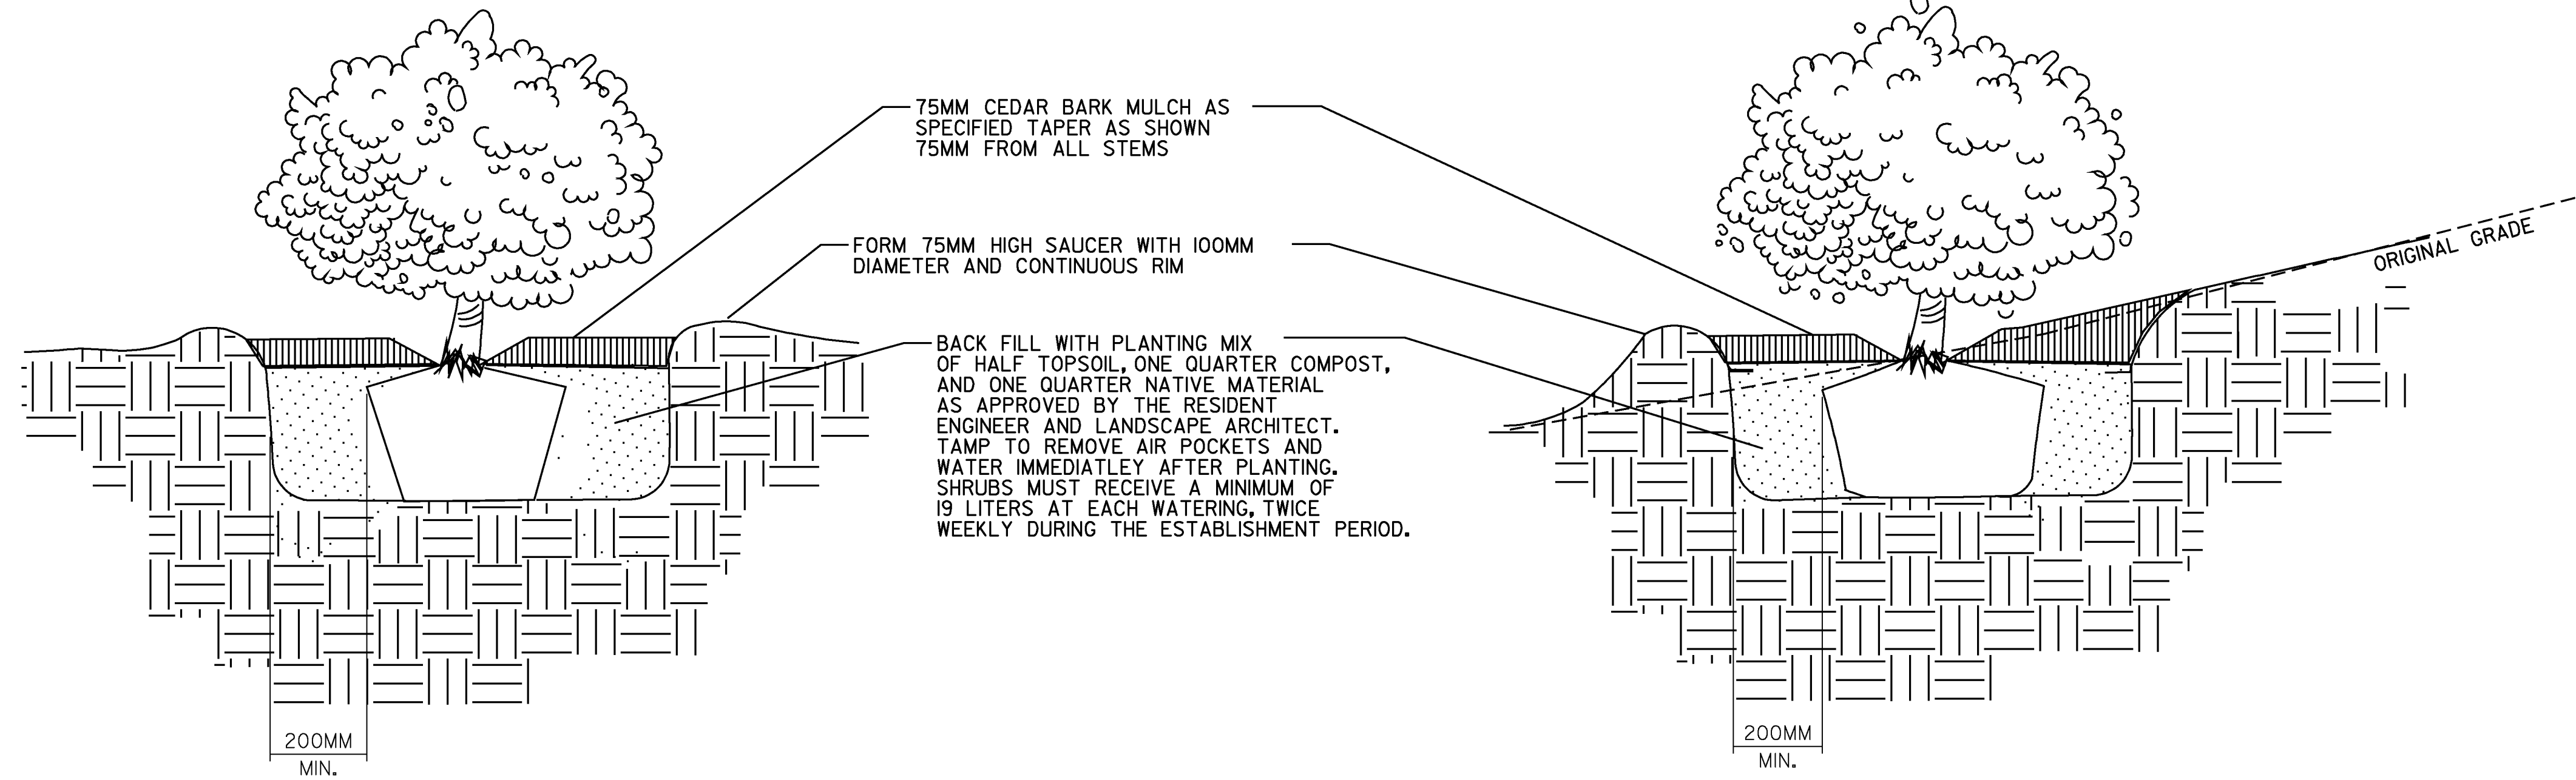


SHRUB PLANTING DETAIL
NOT TO SCALE

SHRUB PLANTING ON SLOPES DETAIL
NOT TO SCALE

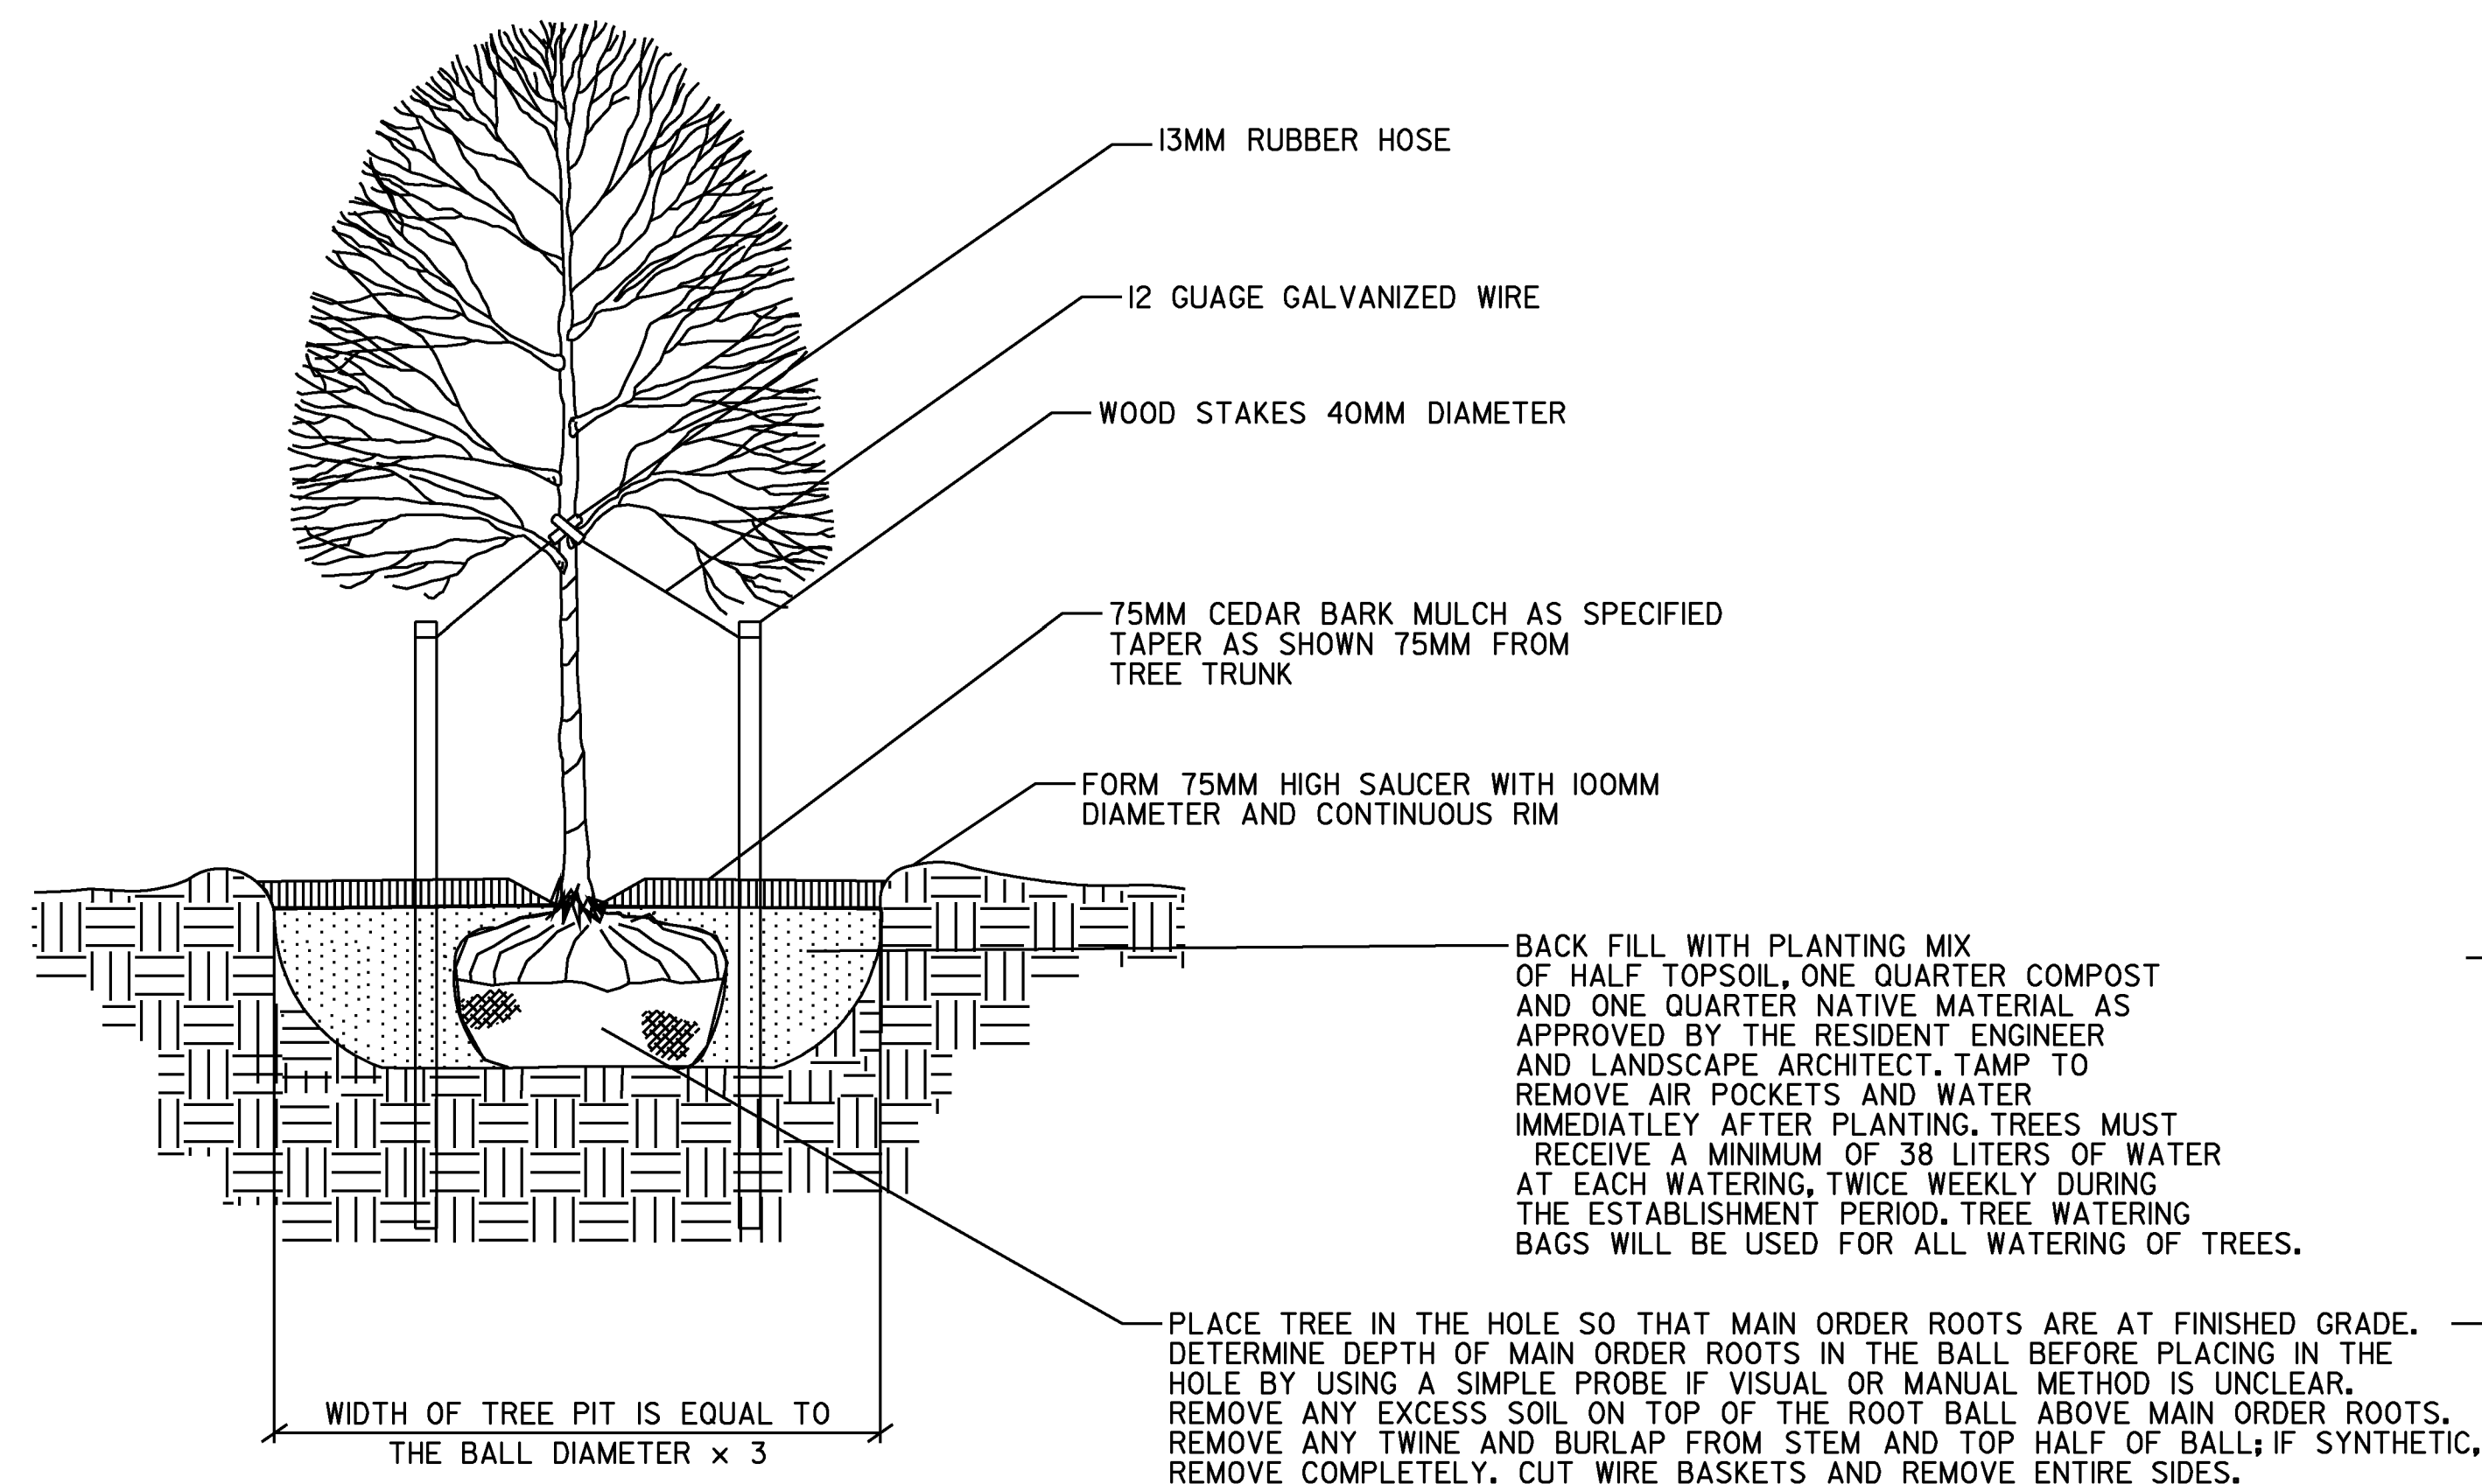

DECIDUOUS TREE PLANTING DETAIL
NOT TO SCALE

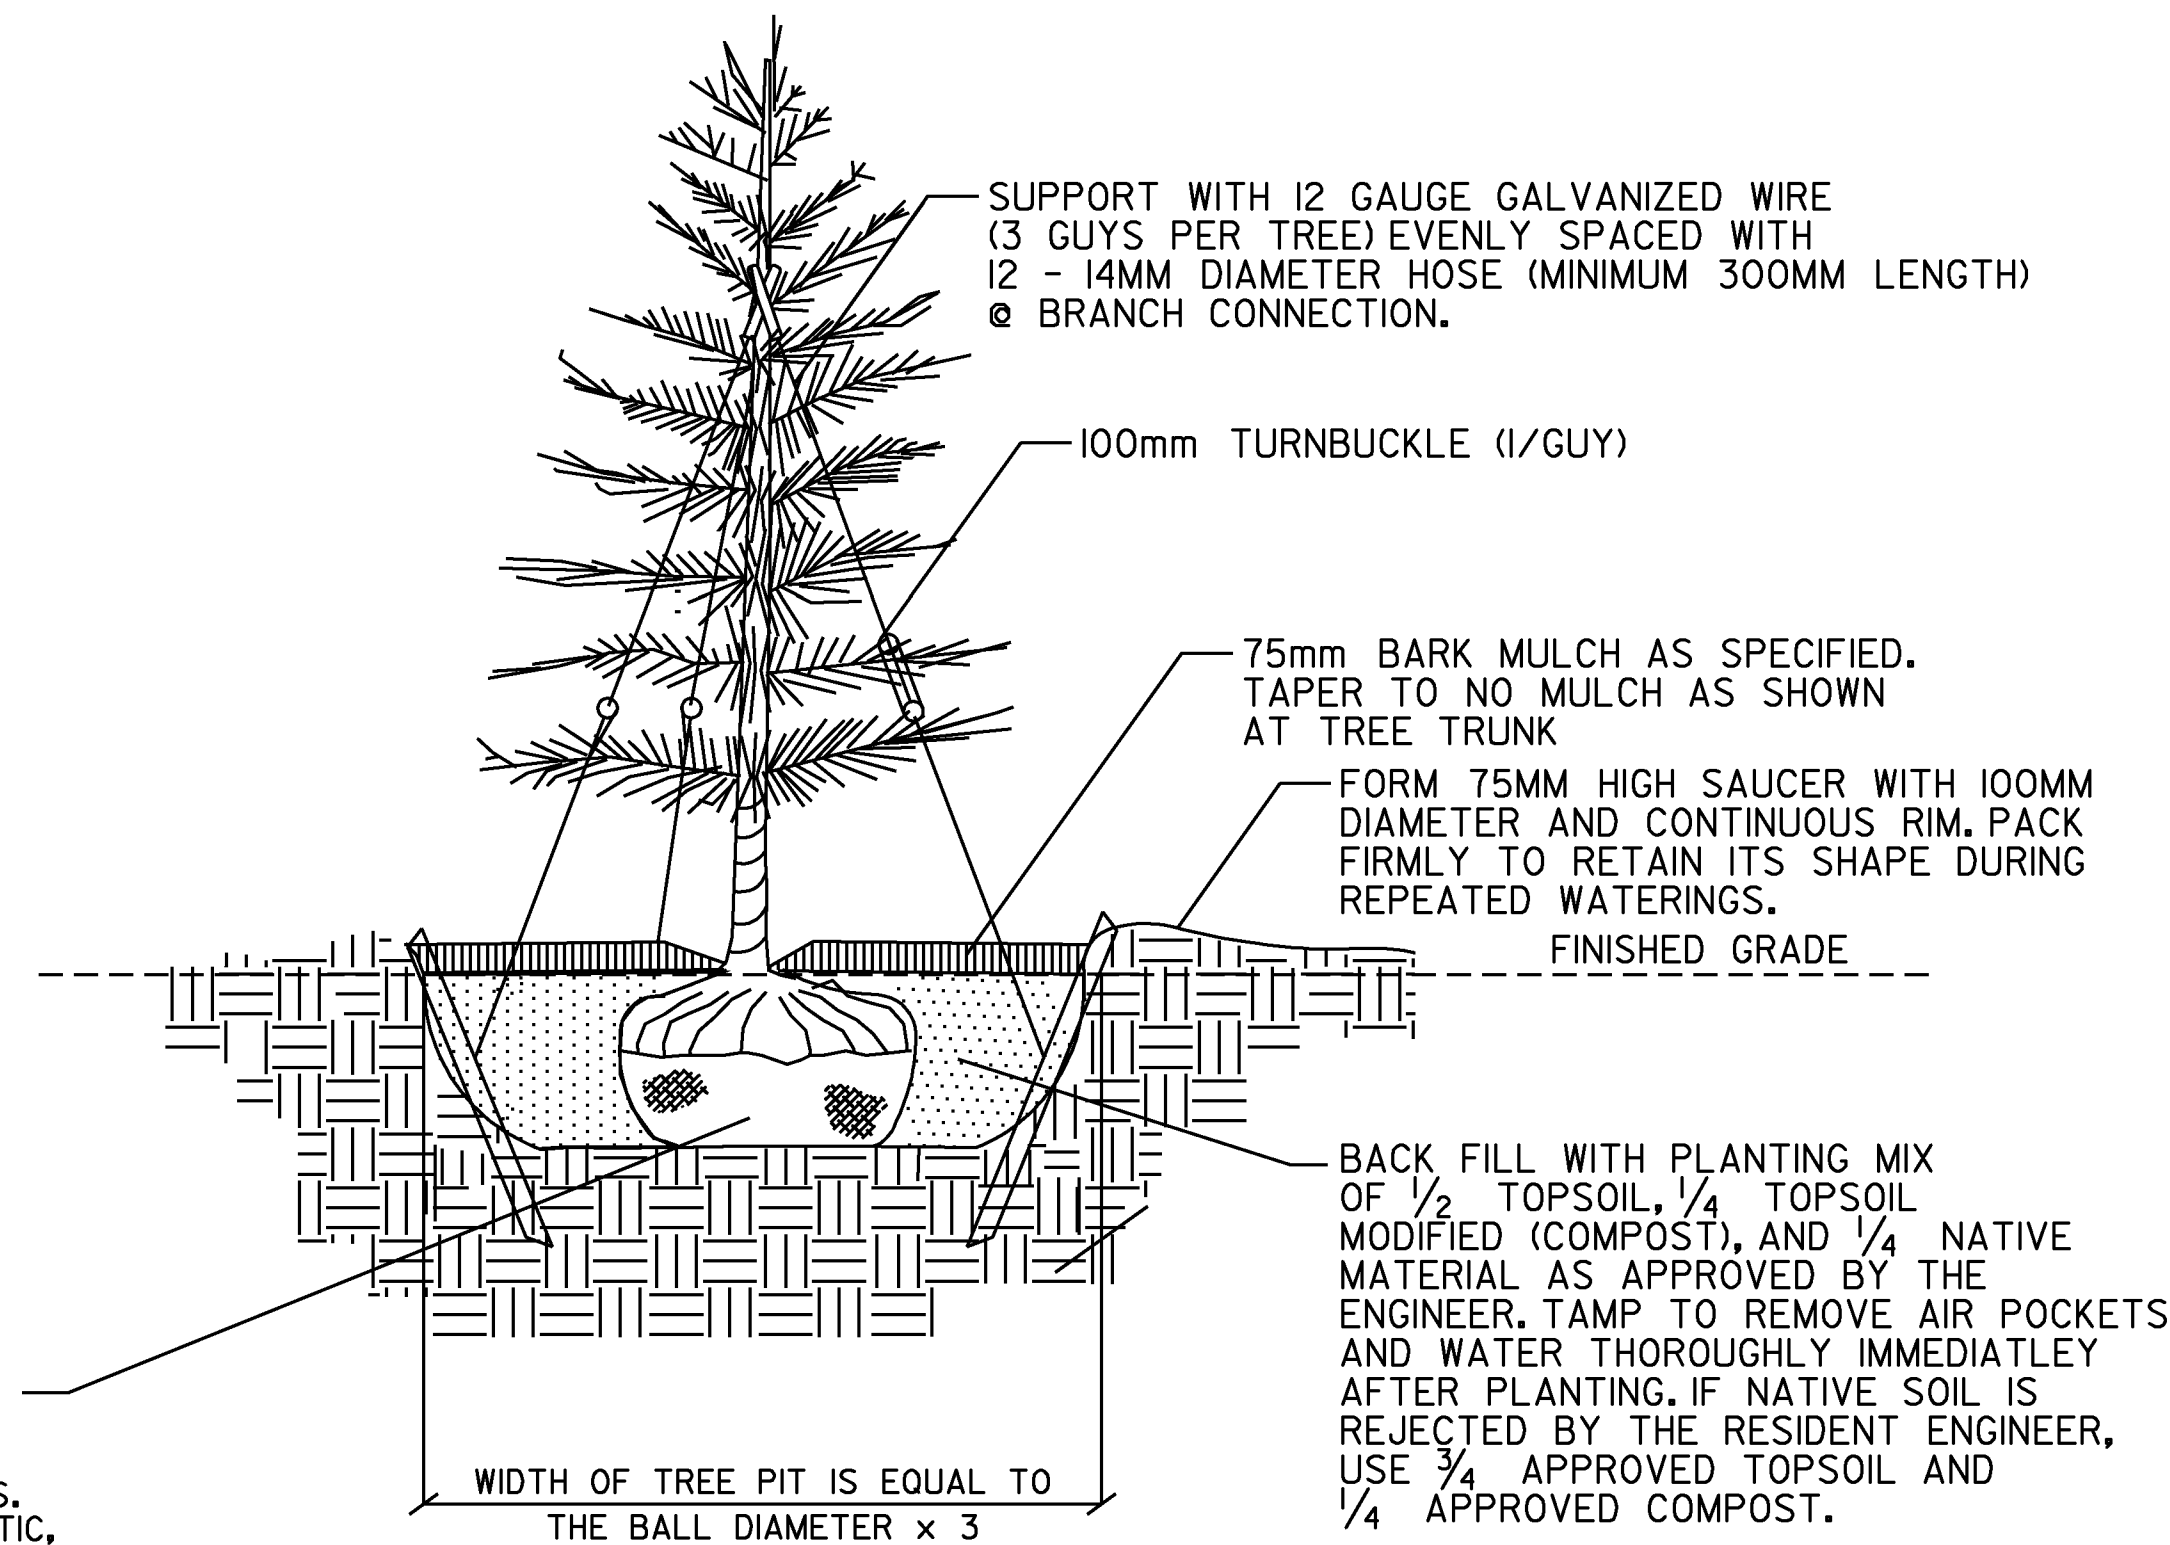

EVERGREEN TREE PLANTING DETAIL
NOT TO SCALE

NOTES:

1. STAKE ONLY THOSE TREES PLANTED IN WINDY, EXPOSED LOCATIONS WHERE THEY MIGHT BE BLOWN OVER OR VANDALIZED AS DETERMINED BY RESIDENT ENGINEER OR LANDSCAPE ARCHITECT.
2. COMPLETELY REMOVE ALL GUY WIRES, RUBBER HOSE, AND STAKES ONE YEAR AFTER PLANTING.

NOTES

1. ANTI-DESICCANT SPRAY IS TO BE APPLIED TO ALL EVERGREENS PER MANUFACTURER SPECIFICATIONS.

TREE WATERING BAG SOURCES ARE LISTED BELOW:

NORTHERN NURSERIES, INC. @
WHITE RIVER
2234 NORTH HARTLAND ROAD
(US ROUTE 5)
WHITE RIVER JUNCTION, VT 05001
PHONE: 802-295-2117

JOHN DEERE LANDSCAPES @
MANCHESTER
8030 SOUTH WILLOW STREET
MANCHESTER, NH 03103
PHONE: 603-621-2900

BEN MEADOWS COMPANY
P.O. BOX 5277
JANESVILLE, WI 53547-5277
PHONE: 800-628-2068

A.M. LEONARD, INC.
HORTICULTURAL PRODUCTS
241 FOX DRIVE
P.O. BOX 816
PIQUA, OH 45356-0816

PLANT SOURCES ARE LISTED BELOW:

HORSEFORD GARDENS & NURSERY
2111 GREENBUSH RD.
CHARLOTTE, VT 05445
802-425-2811
LORI TAXTER

HIGH REACH FARM
2847 TAMPICO RD.
DANVILLE, VT 05828
802-748-3512
STEVE PARKER & SUSANNE TERRY

COBBLE CREEK NURSERY
WHOLESALE GROWERS
RD #2, BOX 3850
BRISTOL, VT 05433
802-453-3889
JOHN PADUA

ELMORE ROOTS NURSERY
PO BOX 171
ELMORE, VT 05657
1-800-421-PLANT OR 888-3305
WWW.ELMOREROOTS.COM
DAVID L. FRIED

4 SEASONS GARDEN CENTER
427 MARSHALL AVENUE
WILLISTON, VT 05495
802-862-6036
COMMERCIAL@4SEASONS.GC.COM

PROJECT NAME: EAST MONTPELIER
PROJECT NUMBER: STPG 028 - 3(35)S

FILE NAME: +98b028landscapebdr.dgn
PROJECT LEADER: J. SCHULTZ
DESIGNED BY: J. GRUCHACZ
LANDSCAPE DETAIL SHEET

PLOT DATE: 22-MAR-2010
DRAWN BY: D. LYMAN
CHECKED BY: J. DEVLIN
SHEET 69 OF 142

LIST OF MAJOR EQUIPMENT	
ITEM # 678.15 (US 2 & VT 14)	QUANTITY
MAST ARM POLES	2
POWER METER ON STANCHION	1
NEW 12" TRAFFIC SIGNAL HEADS W/ TUNNEL VISORS, DISCONNECT HANGERS & MOUNTING HARDWARE.	
ONE-WAY 3 SECTION	5
ONE-WAY 5 SECTION	2
GROUND MNT. CABINET/CONTROLLER	1
MAST ARMS	3
BACKPLATES	7
VIDEO VEHICLE DETECTION CAMERAS	3

CONTROLLER TIMING CHART								
US ROUTE 2 & VT ROUTE 14								
PHASE	US2	VT14	US2	US2				
TRAFFIC MOVEMENT	→	↓	→	←				
MINIMUM GREEN	8	8	5	8				
MAXIMUM 1 GREEN	35	13	10	19				
MAXIMUM 2 GREEN	34	14	8	20				
MAXIMUM 3 GREEN	37	11	15	16				
YELLOW CLEARANCE	4	4	4	4				
ALL RED CLEARANCE	2	2	2	2				
VEH. EXTENSION	2	2	2	2				
WALK (MAN)								7
PED CLEAR (HAND)								14

CONTROLLER TO OPERATE MAXIMUM 2 GREEN TIMINGS FROM 6:00AM-9:00AM
 CONTROLLER TO OPERATE MAXIMUM 1 GREEN TIMINGS FROM 9:00AM-3:00PM & 6:00PM-6:00AM
 CONTROLLER TO OPERATE MAXIMUM 3 GREEN TIMINGS FROM 3:00PM-6:00PM

678.15 TRAFFIC CONTROL SIGNAL SYSTEM, INTERSECTION

MAST ARM POLES
 STA 14+039.22 LT (13.62M LT) MA1
 STA 4+803.59 RT (9.73M RT) MA2


PEDESTRIAN SIGNAL POLES
 STA 14+040.00 RT (11.63M LT) P1
 STA 4+814.28 LT (10.62M LT) P2
 STA 4+810.48 RT (8.29M RT) P3

CABINET/CONTROLLER
 STA 14+047.50 RT (8.45M RT)

POWER STANCHION
 STA 14+047.50 RT (11.59M RT)



678.25 PULL BOX, STANDARD
 STA 14+040.00 RT PB1
 STA 14+040.00 LT PB2
 STA 4+808.53 RT PB3

678.30 ELECTRICAL CONDUIT SLEEVE (200MM) (PVC) (SCH 80)
 STA 14+040.00 LT - 14+040.00 RT
 STA 4+810.31 LT - 4+808.56 RT

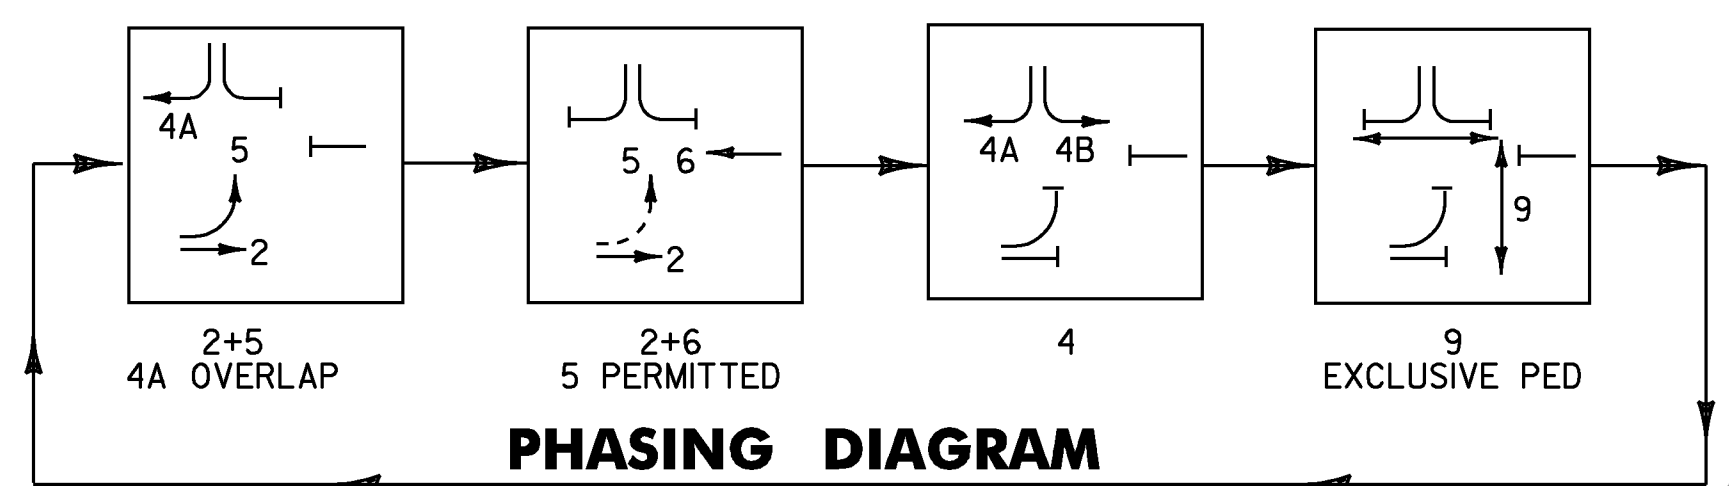


678.23 - WIRED CONDUIT	CONDUIT SIZE	DESCRIPTION
POWER TO STANCHION	50mm	
STANCHION TO CONTROLLER	17.0M	*POWER
CONTROLLER TO PB1	19.2M (2x9.6M)	POWER/VIDEO
PB1 TO PB2	45.0M (2x22.5M)	POWER/VIDEO
MA1 TO PB2	9.4M (2x4.7M)	POWER/VIDEO
PED1 TO PB1	4.1M	POWER
PED2 TO PB1	6.9M	POWER
PB3 TO PB1	47.6M (2x23.8M)	POWER/VIDEO
PED3 TO PB3	3.9M	POWER
MA2 TO PB3	13.2M (2x6.6M)	POWER/VIDEO
SUBTOTALS	171.4 M	
ROUNDING	3.6 M	
TOTALS	175.0 M	

*-CONDUIT QUANTITY INCLUDES PVC RUN ON UTILITY POLE

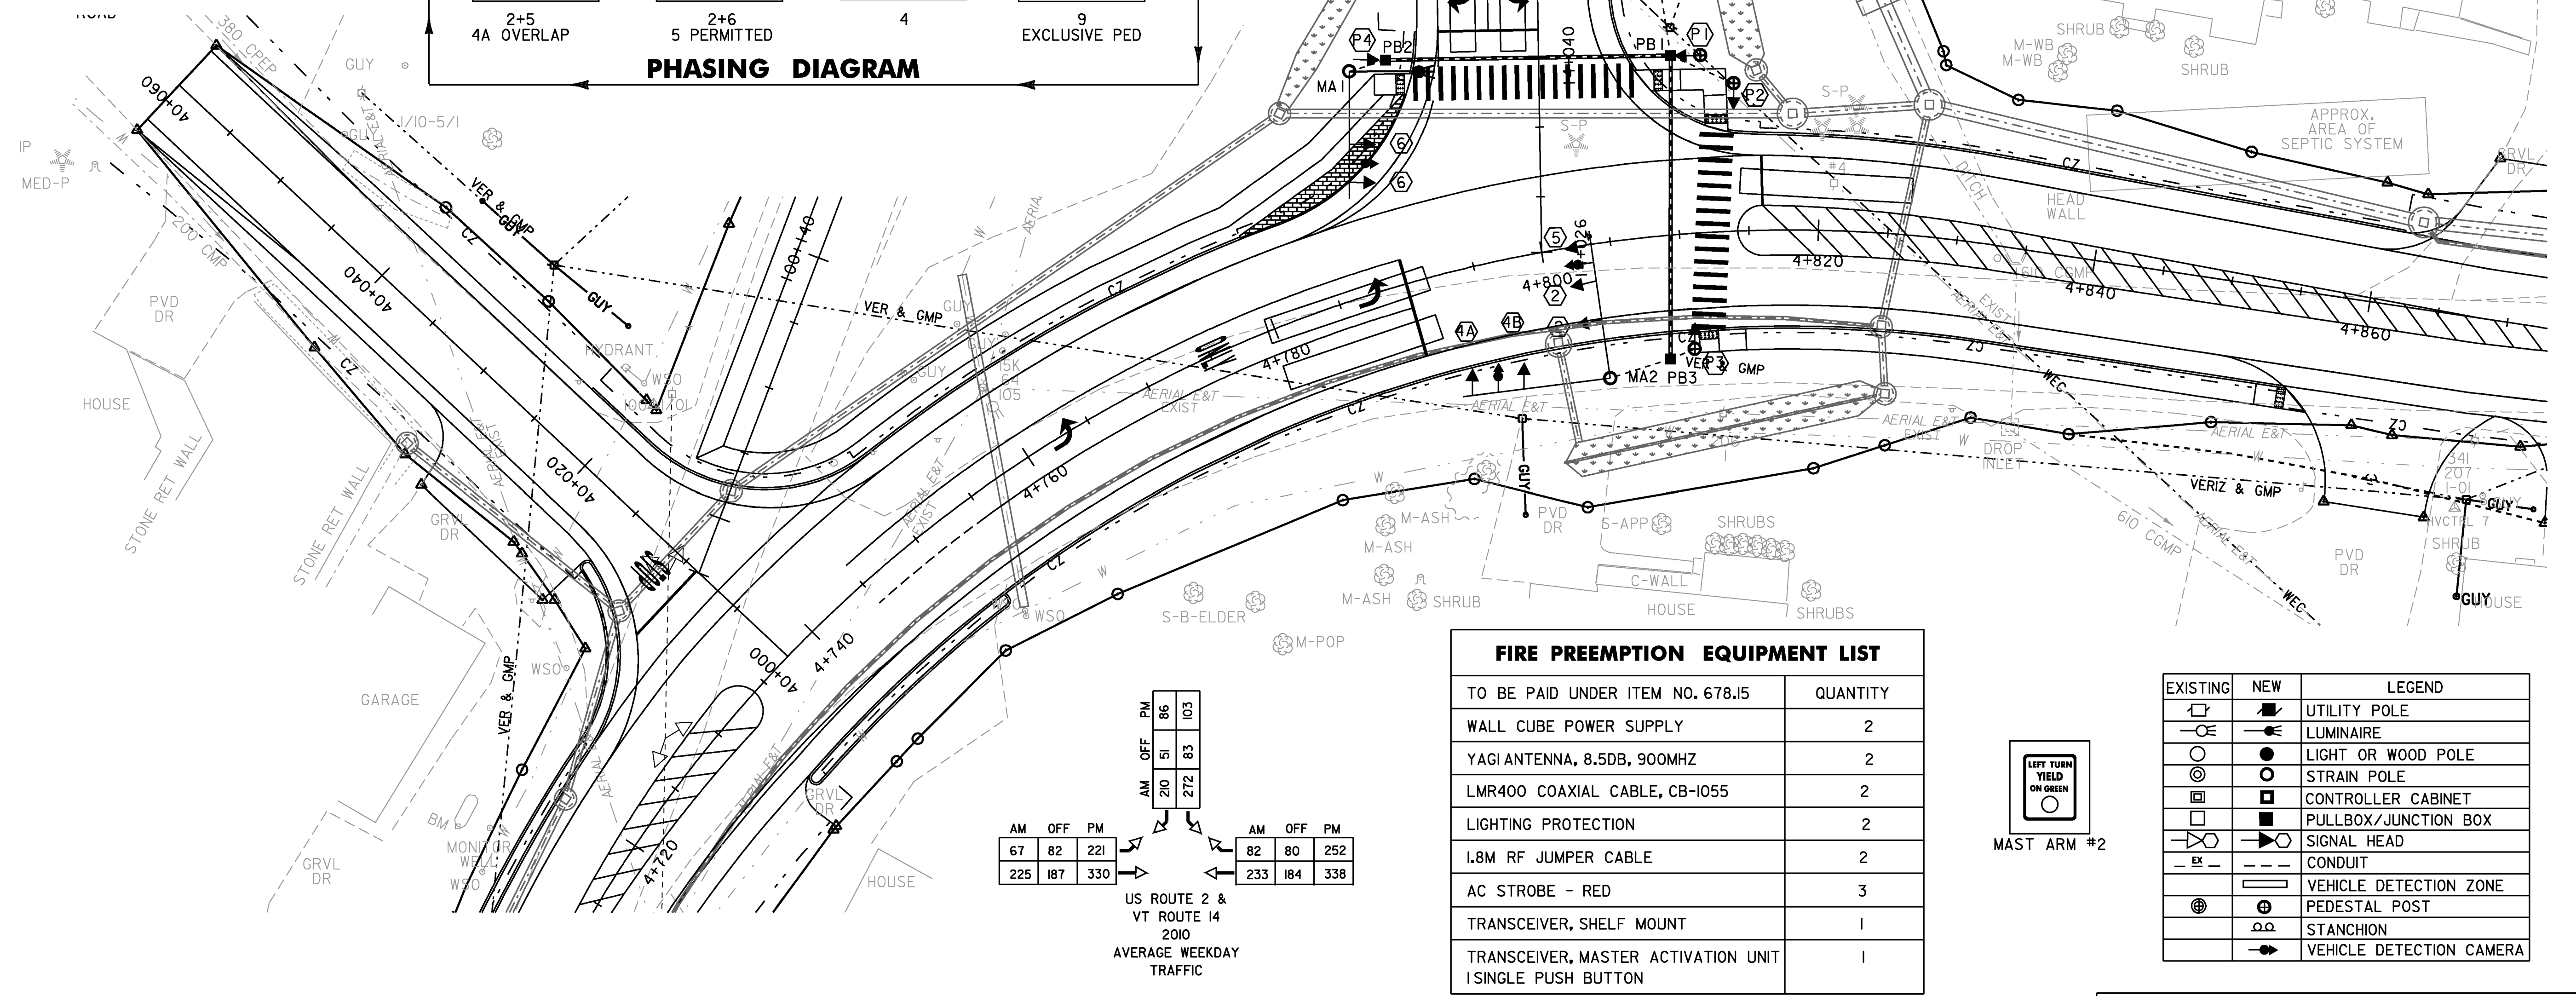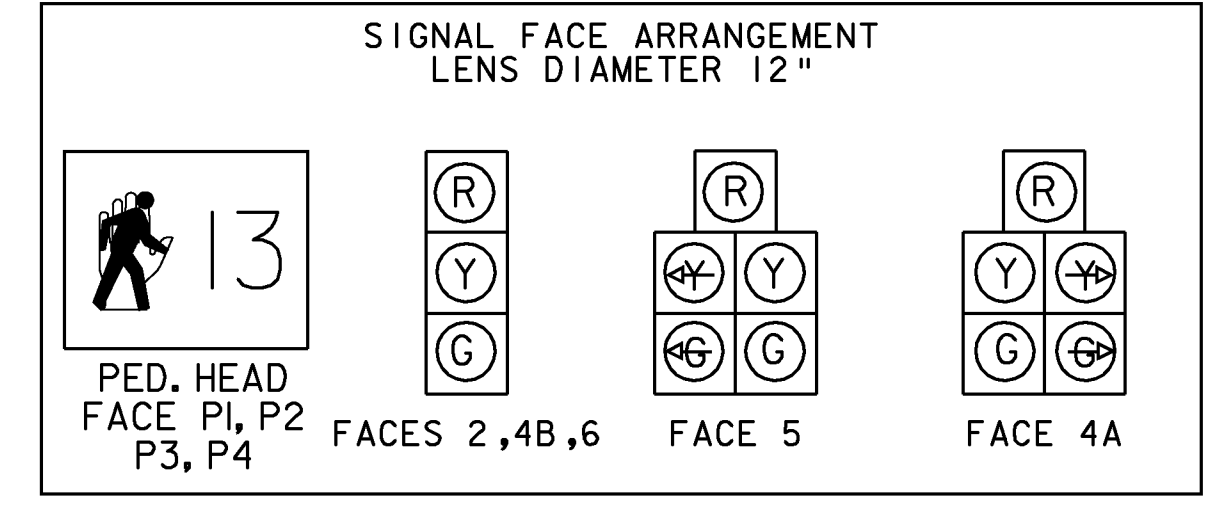

FIRE PREEMPTION EQUIPMENT LIST	
TO BE PAID UNDER ITEM NO. 678.15	QUANTITY
WALL CUBE POWER SUPPLY	2
YAGI ANTENNA, 8.5DB, 900MHZ	2
LMR400 COAXIAL CABLE, CB-1055	2
LIGHTING PROTECTION	2
1.8M RF JUMPER CABLE	2
AC STROBE - RED	3
TRANSCEIVER, SHELF MOUNT	1
TRANSCEIVER, MASTER ACTIVATION UNIT SINGLE PUSH BUTTON	1

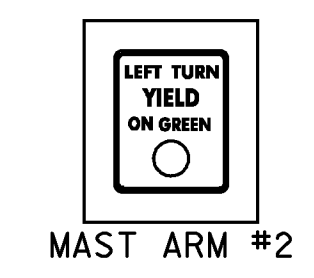

EXISTING	NEW	LEGEND
□	■	UTILITY POLE
○	●	LUMINAIRE
○	●	LIGHT OR WOOD POLE
○	●	STRAIN POLE
□	■	CONTROLLER CABINET
□	■	PULLBOX/JUNCTION BOX
○	●	SIGNAL HEAD
—	—	CONDUIT
○	○	VEHICLE DETECTION ZONE
○	○	PEDESTAL POST
○	○	STANCHION
○	○	VEHICLE DETECTION CAMERA



PROJECT NAME: EAST MONTPELIER
 PROJECT NUMBER: STPG 028 - 3(35)S

FILE NAME: +98b028traf.dgn PLOT DATE: 22-MAR-2010
 PROJECT LEADER: J. SCHULTZ DRAWN BY: D. LYMAN
 DESIGNED BY: J. GRUCHACZ CHECKED BY: J. DEVLIN
 TRAFFIC LAYOUT SHEET SHEET 70 OF 142

TRAFFIC SIGNAL NOTES

A. NEW SIGNAL EQUIPMENT

1. ALL SIGNAL HEADS SHALL HAVE POLYCARBONATE SECTIONS AND LENSES. THE SIGNAL HEADS SHALL HAVE FLAT BLACK HOUSINGS AND VISORS.
2. ALL SIGNAL HEADS SHALL HAVE BLACK LOUVERED BACK PLATES.
3. THE TRAFFIC SIGNAL CONTROLLER AND RELATED EQUIPMENT SHALL BE MANUFACTURED BY ECONOLITE CONTROL PRODUCTS, INC. OR NAZTEC, INC. CONTROLLER SHALL BE (NEMA TS2) IN A NEMA P44 TRAFFIC CONTROL CABINET WITH BASE EXTENSION INSTALLED AT THE LOCATION SHOWN ON TRAFFIC LAYOUT SHEET.
4. ALL SIGNAL HEADS SHALL HAVE RED, YELLOW AND GREEN LED SIGNALS WITH A VISIBLE BEAM SPREAD OF 80 DEGREES OFF AXIS.

B. SIGNAL OPERATION

1. SWITCH-OVER TO NEW SIGNAL SYSTEM SHALL NOT BE DONE DURING PEAK TRAFFIC PERIODS. UNIFORMED TRAFFIC OFFICERS SHALL CONTROL TRAFFIC DURING SWITCH-OVER.
2. ALL SIGNALS SHALL DWELL ON THE US ROUTE 2 THRU MOVEMENT.
3. THE US ROUTE 2 THRU PHASE SHALL BE USED FOR THE START-UP PHASE FOLLOWING FLASHING OPERATION.
4. SIGNAL TIMING SHOWN ON THE PLANS MAY REQUIRE FINE-TUNING IN THE FIELD BASED ON TRAFFIC OBSERVATION AND/OR ADDITIONAL FIELD STUDIES.

C. PULLBOXES AND JUNCTION BOXES

1. PULLBOXES AND JUNCTION BOXES ARE DETAILED ON STANDARD E-173. MINIMUM JUNCTION BOX SIZE SHALL BE 450MM x 300MM x 300MM, OR LARGER AS REQUIRED BY THE ELECTRICAL CODE.
2. THE LOGO ON PULLBOXES / JUNCTION BOXES SHALL BE "TRAFFIC SIGNAL"

D. TRAFFIC SIGNAL CONDUIT

1. ALL TRAFFIC SIGNAL CONDUIT SHALL BE SCHEDULE 80 PVC.

E. VIDEO DETECTION CAMERAS

1. VIDEO VEHICLE DETECTORS SHALL BE PLACED SO THAT OCCLUSION IS MINIMIZED AND PHASING IS NOT AFFECTED.
2. VIDEO VEHICLE DETECTION AREAS SHALL EXTEND 1.5M PAST THE STOP BAR.
3. VIDEO VEHICLE DETECTION SYSTEM SHALL BE ECONOLITE AUTOSCOPE SOLO TERRA OR ITERIS VERSICAM OR TRAFICON VIP SERIES OR APPROVED EQUAL.
4. SEE THE SPECIAL PROVISIONS FOR A DETAILED LIST OF EQUIPMENT.

F. FIRE PREEMPTION SYSTEM

1. THE FIRE PREEMPTION EQUIPMENT TO BE INSTALLED INSIDE THE CABINET: A WALL CUBE POWER SUPPLY, YAGI ANTENNA, 8.5DB, 900MHZ, LMR400 COAXIAL CABLE, CB-1055, LIGHTING PROTECTION, 1.8M RF JUMPER CABLE, AND A TRANSRECEIVER, SHELF MOUNT.
2. THE FIRE PREEMPTION EQUIPMENT TO BE INSTALLED INSIDE THE FIRE STATION: A WALL CUBE POWER SUPPLY, YAGI ANTENNA, 8.5DB, 900MHZ, LMR400 COAXIAL CABLE, CB-1055, LIGHTING PROTECTION, 1.8M RF JUMPER CABLE, AND A TRANSRECEIVER, MASTER ACTIVATION UNIT 1 SINGLE PUSH BUTTON.
3. THE FIRE PREEMPTION EQUIPMENT SHALL BE PAID FOR UNDER ITEM 678.15 TRAFFIC CONTROL SIGNAL SYSTEM, INTERSECTION, FOR A LIST OF EQUIPMENT SEE TRAFFIC LAYOUT SHEET.
4. SEE THE SPECIAL PROVISIONS FOR ADDITIONAL INFORMATION.


G. MAST ARM FOUNDATIONS

1. FOUNDATIONS SHALL BE DESIGNED IN ACCORDANCE WITH THE MREI 10-01 GUIDELINES. THE CONTRACTOR WILL BE RESPONSIBLE FOR SOIL BORINGS AND FOUNDATION DESIGN. IN ADDITION TO FABRICATION DRAWINGS, THE BORING LOGS, DESIGN CRITERIA, AND DESIGN CALCULATIONS SHALL BE SUBMITTED AS WORKING DRAWINGS IN ACCORDANCE WITH SUBSECTION 105.03.

H. GENERAL

1. A UNIFORMED TRAFFIC OFFICER SHALL DIRECT TRAFFIC WHEN ONE-WAY TRAFFIC EXISTS ON ANY APPROACH.
2. THE CONTRACTOR SHALL ACQUIRE ALL THE NECESSARY PERMITS AND MAKE ALL NECESSARY ARRANGEMENTS WITH THE UTILITY COMPANY TO PROVIDE A PERMANENT POWER SUPPLY TO THE TRAFFIC SIGNAL EQUIPMENT. THE ROUTING OF POWER TO THE INTERSECTION SHALL BE SUCH THAT THE STATE HAS FULL RESPONSIBILITY FROM THE TRANSFORMER THROUGH THE SIGNAL. NO INTERVENING OWNERSHIP/RESPONSIBILITY SHALL BE ALLOWED.
3. SEE THE PROJECT SPECIAL PROVISIONS FOR INFORMATION AND REQUIREMENTS FOR SALVAGED MATERIALS
4. ALL SIGNAL POLES, PEDESTRIAN POLES, AND CONTROLLER CABINET SHALL BE BLACK FINISH.

CONTROLLER IDENTIFICATION PLAQUE

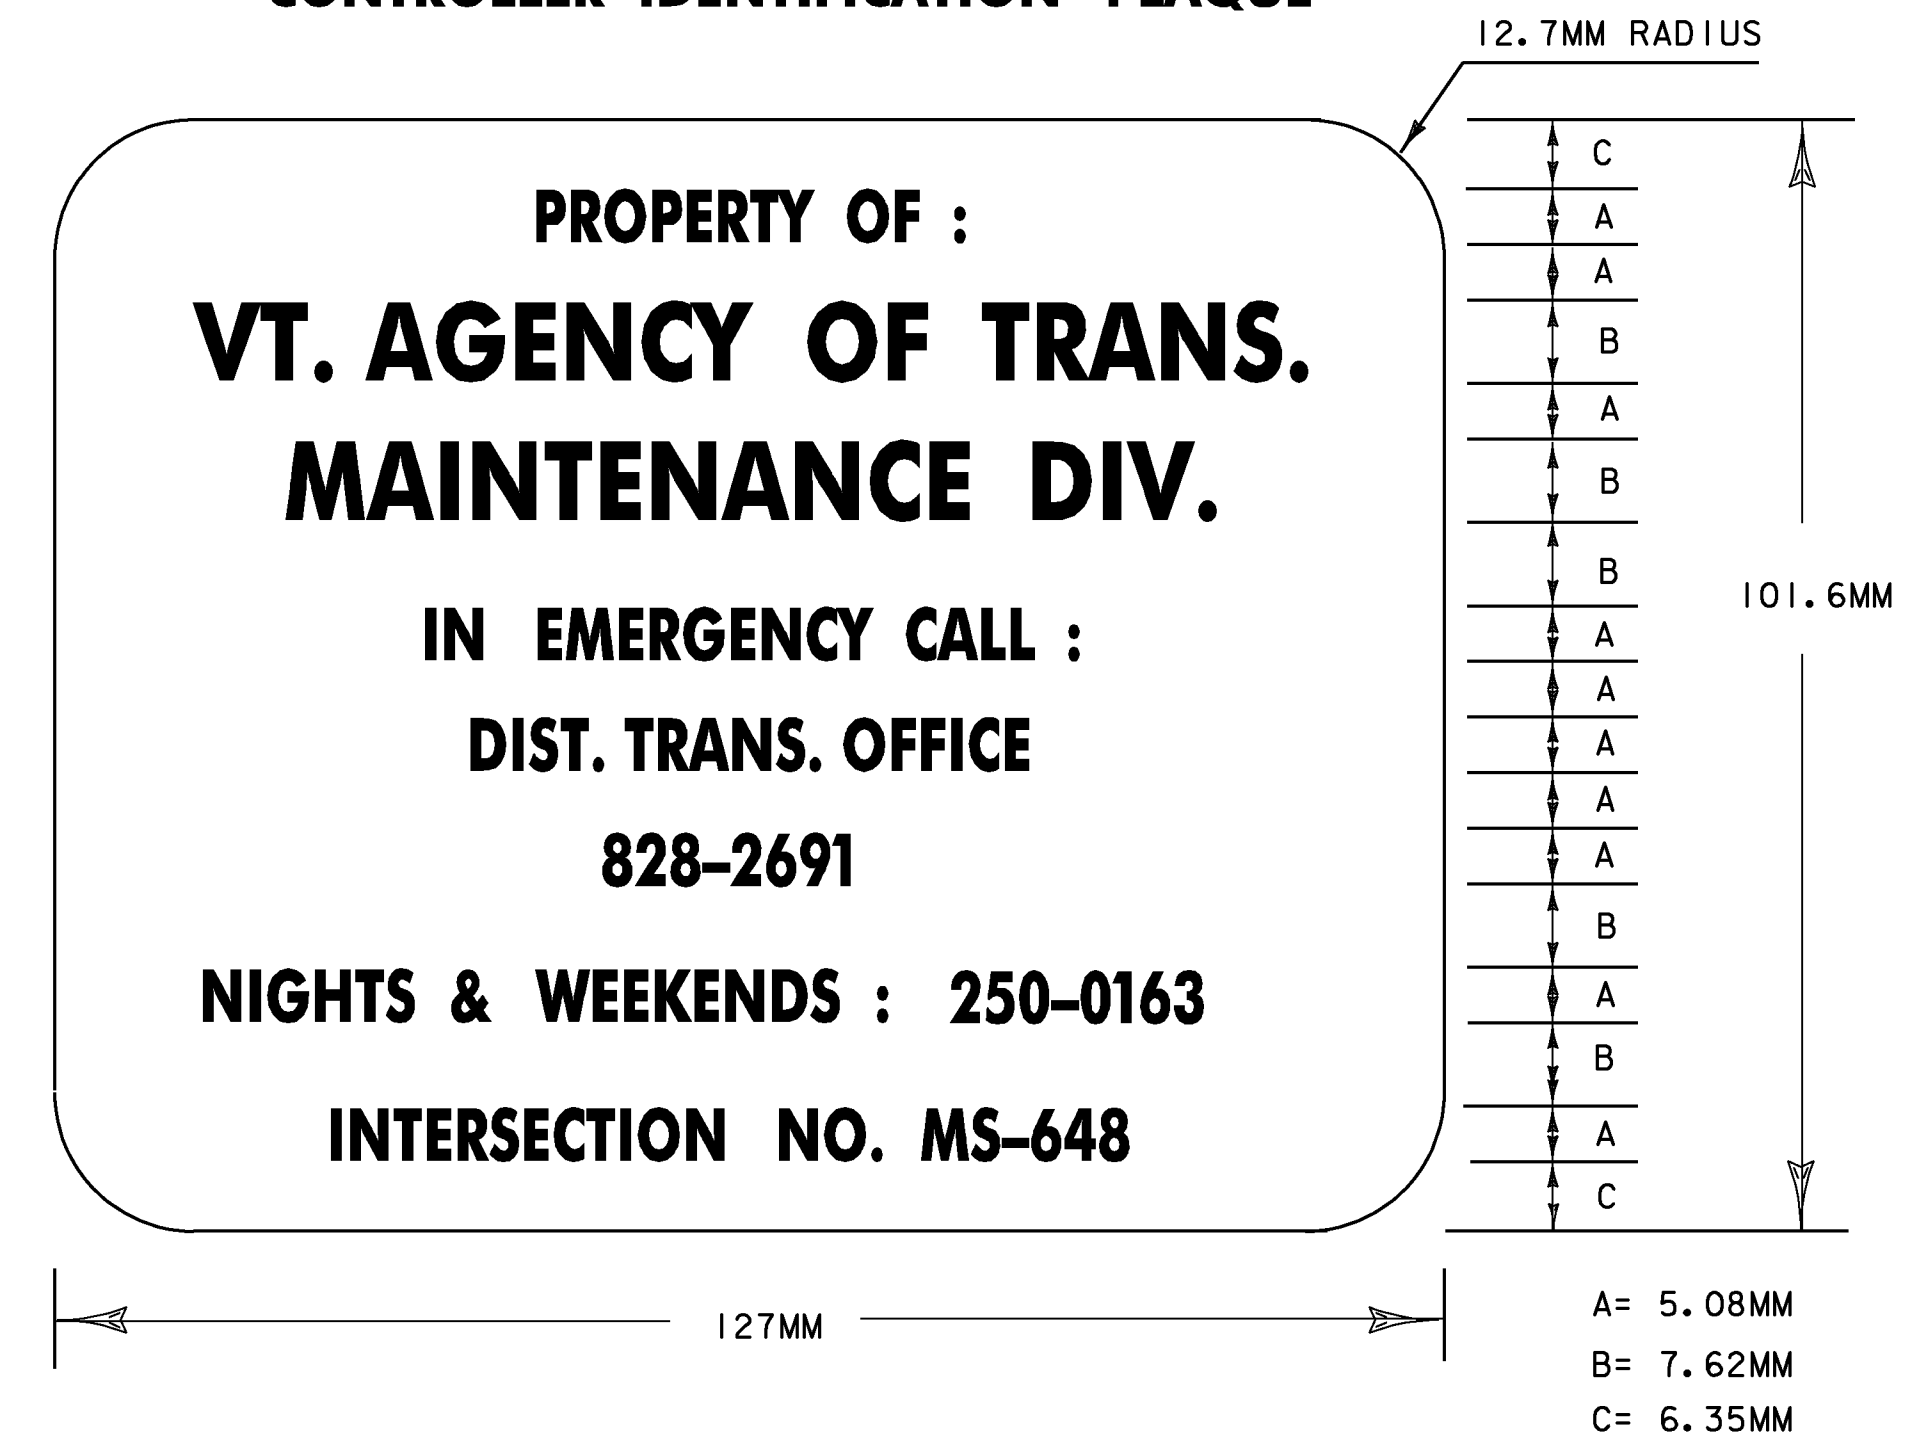

LEGEND: - BLACK (NON-REFL.) - STAMPED PRIOR TO PAINTING
 BACKGROUND: NATURAL ALUMINUM OR BRASS SURFACE

NOTES:

- 1.) THE PLAQUE SHALL BE MOUNTED ON ALL TRAFFIC SIGNAL CONTROLLER CABINETS. IT SHALL BE FASTENED TO THE CONTROLLER CABINET IN SUCH A MANNER AS TO BE NOT EASILY REMOVED, SUCH AS WELDED, RIVETED OR BOLTED WITH VANDAL PROOF BOLTS.
- 2.) THE LETTERS SHALL BE PUNCHED OR STAMPED, SUCH STAMPING SHALL PENETRATE AT LEAST 1#2 THE BASE MATERIAL THICKNESS.
- 3.) THE BASE MATERIAL FOR THE PLAQUE SHALL BE BRASS OR ALUMINUM WITH A MINIMUM THICKNESS OF 2.54MM.

PROJECT NAME: EAST MONTPELIER
 PROJECT NUMBER: STPG 028 - 3(35)S

FILE NAME: +98b028traf.dgn
 PROJECT LEADER: J. SCHULTZ
 DESIGNED BY: J. GRUCHACZ
 TRAFFIC SIGNAL NOTES

PLOT DATE: 22-MAR-2010
 DRAWN BY: D. LYMAN
 CHECKED BY: J. DEVLIN
 SHEET 71 OF 142

TRAFFIC SIGNAL GENERAL NOTES

1. ALL MATERIALS AND CONSTRUCTION SHALL CONFORM TO THE STATE OF VERMONT, AGENCY OF TRANSPORTATION'S STANDARD SPECIFICATIONS FOR CONSTRUCTION, DATED 2006, WITH CURRENT MODIFICATIONS
2. OVERHEAD SIGN/SIGNAL SUPPORTS SHALL CONFORM TO AASHTO'S PUBLICATION ENTITLED "STANDARD SPECIFICATIONS FOR STRUCTURAL SUPPORTS FOR HIGHWAY SIGNS, LUMINAIRES, AND TRAFFIC SIGNALS", DATED 2009 OR ITS LATEST REVISION.
3. THE DESIGN CALCULATIONS SHALL TAKE INTO ACCOUNT THE FOLLOWING CRITERIA:
 - STRUCTURE CRITERIA
 - DESIGN LIFE: 50 YEARS
 - WIND LOAD - 90 MPH, UNLESS SPECIAL SITE CONDITIONS DICTATE
 - ICE LOAD PER AASHTO'S PUBLICATION ENTITLED "STANDARD SPECIFICATIONS FOR STRUCTURAL SUPPORTS FOR HIGHWAY SIGNS, LUMINAIRES, AND TRAFFIC SIGNALS", DATED 2009
 - FATIGUE CRITERIA
 - FATIGUE CATEGORY: 1 FOR MAST ARM SIGN STRUCTURES, 2 FOR SIGNAL MAST ARMS
 - VORTEX SHEDDING: INCLUDE
 - NATURAL WIND GUSTS: INCLUDE
 - TRUCK INDUCED WIND GUSTS: INCLUDE FOR ROADWAYS WHERE SPEED LIMIT IS 40 MPH OR GREATER.
 - GALLOPING: DO NOT INCLUDE IN DESIGN CALCULATIONS
 - FOUNDATION CRITERIA
 - CONCRETE: CONCRETE, HIGH PERFORMANCE CLASS B, STATE OF VERMONT, AGENCY OF TRANSPORTATION'S "STANDARD SPECIFICATIONS FOR CONSTRUCTION", DATED 2006, SECTION 501.
 - REINFORCING STEEL: STATE OF VERMONT, AGENCY OF TRANSPORTATION'S "STANDARD SPECIFICATIONS FOR CONSTRUCTION", DATED 2006, SECTION 713.01.
 - ALLOWABLE BEARING CAPACITY: TO BE DETERMINED
 - INTERNAL SOIL FRICTION ANGLE, ϕ : TO BE DETERMINED
4. ANCHOR BOLTS

FOUR STAINLESS STEEL ANCHOR BOLTS WITH TWO HEXAGON NUTS, ONE WASHER AND ONE LOCK WASHER PER BOLT SHALL BE FURNISHED WITH EACH POLE. ANCHOR BOLT PLATES, WHEN USED, SHALL ALSO BE STAINLESS STEEL. STATE OF VERMONT, AGENCY OF TRANSPORTATION'S "STANDARD SPECIFICATIONS FOR CONSTRUCTION", DATED 2006, SECTION 714.09.
5. FLANGE BOLTS

ALL FLANGE BOLTS AND HEX NUTS SHALL BE HIGH STRENGTH STEEL AND SHALL CONFORM TO STATE OF VERMONT, AGENCY OF TRANSPORTATION'S "STANDARD SPECIFICATIONS FOR CONSTRUCTION", DATED 2006, SECTION 714.05.
6. HORIZONTAL AND VERTICAL MEMBERS



STEEL TUBES SHALL BE FORMED AND WELDED WITH ONE CONTINUOUS LONGITUDINAL WELD ONLY. AFTER FORMING AND WELDING THEY SHALL BE COLD ROLLED TO ENSURE UNIFORMITY OF SIZE AND SMOOTHNESS OF WELD. THERE SHALL BE NO TRANSVERSE WELDING EXCEPT AT THE FLANGE CONNECTIONS AND POLE BASE PLATES, WHERE THE TUBES SHALL TELESCOPE THE FLANGES AND PLATES AND BE CONTINUOUSLY WELDED BOTH SIDES, INSIDE AND OUT TO WITHSTAND THE FULL TRANSFER OF THE BENDING STRENGTH TO THE BOLTS. OPTIONALLY, THE MEMBERS MAY BE A SERIES OF TWO OR THREE DIFFERENT DIAMETER PIPES WELDED TOGETHER. STEEL TUBES SHALL BE CONSTRUCTED FROM MATERIALS CONFORMING TO STATE OF VERMONT, AGENCY OF TRANSPORTATION'S "STANDARD SPECIFICATIONS FOR CONSTRUCTION", DATED 2006, SECTION 752.02.
7. GALVANIZING

ALL STEEL COMPONENTS, EXCEPT CONCRETE REINFORCING AND STAINLESS STEEL HARDWARE, ARE TO BE HOT DIPPED GALVANIZED AFTER FABRICATION. THE ASSEMBLIES SHALL BE DESIGNED AND FABRICATED TO PERMIT GALVANIZING ON ALL INTERIOR AND EXTERIOR SURFACES AND SHALL BE FREE OF POCKETS AND OTHER STRUCTURAL OBSTRUCTIONS THAT WILL NOT PERMIT PROPER DEPOSITION OF ZINC COATING. GALVANIZING SHALL BE IN ACCORDANCE WITH STATE OF VERMONT, AGENCY OF TRANSPORTATION'S "STANDARD SPECIFICATIONS FOR CONSTRUCTION", DATED 2006, SECTION 752.02.
8. WELDING

ALL DESIGN DETAILS, WORKMANSHIP, PROCEDURES AND INSPECTION SHALL CONFORM TO VTRANS SPECIFICATIONS SECTION 506.10.
9. FOUNDATIONS
 - A. FOUNDATIONS SHALL BE DESIGNED IN ACCORDANCE WITH THE MREI 10-01 GUIDELINES ISSUED BY THE AGENCY.
 - B. FOUNDATIONS SHALL BE CONSTRUCTED IN ACCORDANCE WITH THE FOLLOWING NOTES:
 1. A MINIMUM EMBEDMENT DEPTH OF 5 FEET SHALL BE USED FOR ALL SPREAD FOOTING FOUNDATIONS; MEASURED FROM THE GROUND SURFACE ELEVATION TO THE BOTTOM OF THE FOOTING ELEVATION.
 2. EXCEPT FOR THE UPPERMOST 2 FT OF SOIL, DRILLED SHAFT FOUNDATIONS SHALL BE POURED AGAINST UNDISTURBED MATERIAL; THE TOP 2 FT OF SOIL SHALL BE NEGLECTED FOR DESIGN PURPOSES. A DISPOSABLE CIRCULAR CONCRETE FORM, IF USED, SHALL NOT BE PLACED DEEPER THAN 2FT, IN ORDER NOT TO REDUCE THE FRICTION BETWEEN THE SOIL AND THE CONCRETE.
 3. AS AN ALTERNATIVE TO THE DRILLED HOLES, FOUNDATIONS MAY BE POURED IN EXCAVATED HOLES USING THE PROPER FORMS, WHICH MUST BE REMOVED. THE EXCAVATED HOLES SHALL BE AT LEAST 2 FT CLEAR OF THE FOUNDATION SIDES AND 1 FT DEEPER THAN THE FOUNDATION. CARE SHALL BE TAKEN TO AVOID EXCAVATING AROUND THE TOP OF THE FOUNDATION. DESIGN LIMITS AS FOR AN AUGURED FOUNDATION APPLY.
 4. BACKFILL MATERIAL PLACED ADJACENT TO THE FOUNDATION SHALL MEET THE REQUIREMENTS FOR GRANULAR BACKFILL FOR STRUCTURES, VTRANS SPECIFICATION SECTION 704.08. BACKFILL MATERIAL SHALL BE COMPACTED AS DESCRIBED IN VTRANS' CONSTRUCTION SPECIFICATIONS SECTION 204.08.
 5. CONCRETE FOR THE FOUNDATION SHALL CONFORM TO THE REQUIREMENTS OF SECTION 501, HPC STRUCTURAL CONCRETE. IF DRILLED SHAFT FOUNDATIONS ARE REQUIRED, THE CONCRETE SPECIFICATIONS MAY NEED TO BE ADJUSTED FOR CONSTRUCTABILITY ISSUES. HOWEVER, IF REQUIRED, THE CONTRACTOR SHALL SUBMIT ANY CHANGES TO THE CONCRETE SPECIFICATION FOR REVIEW BY THE VTRANS PROJECT MANAGER.
 6. STEEL PILES SHALL MEET THE REQUIREMENTS OF SECTION 505.
 7. WHEN THE DESIGN DEPTH OF A FOUNDATION CANNOT BE OBTAINED DUE TO UNFORESEEN FIELD CONDITIONS, THE CONTRACTOR SHALL NOTIFY THE ENGINEER FOR THE MANUFACTURER TO OBTAIN A REVISED FOUNDATION DESIGN. SUCH A REVISION SHALL BE SUBMITTED TO THE VERMONT, AGENCY OF TRANSPORTATION, PROJECT MANAGER AND MAY REQUIRE UP TO A 4 WEEK REVIEW PERIOD BY VTRANS.
 - C. SIGNALS/SIGNS SHALL BE INSTALLED AND LEVELED AND POLES SHALL BE PLUMB PRIOR TO PLACING GROUT UNDER POLE BASE. GROUT MATERIAL SHALL BE NON-SHRINKING MORTAR CONFORMING TO SUB-SECTION 707.03 (MORTAR TYPE IV).
10. EACH OVERHEAD TRAFFIC SIGNAL/SIGN SUPPORT SHALL BE GROUNDED. THE GROUND SHALL CONSIST OF:
 - A. AN INTERNAL GROUND LUG OPPOSITE THE HAND HOLE.
 - B. A #6 AWG (MIN.) SOFT DRAWN COPPER GROUNDING ELECTRODE CONDUCTOR.
 - C. A 5/8 IN. X 8 FT (MIN) COPPER CLAD GROUNDING ELECTRODE. THE RESISTANCE TO GROUND SHALL BE 25 OHMS OR LESS. ADDITIONAL GROUNDING ELECTRODES MAY BE REQUIRED (MINIMUM SPACING SHALL BE 6 FT), WHEN A POWER SERVICE, METER AND DISCONNECT ARE ATTACHED TO A POLE, THERE SHALL BE A CONTINUOUS GROUNDING ELECTRODE CONDUCTOR FROM THE METER AND DISCONNECT WHICH MAY RUN INTERNAL TO THE UPRIGHT, THROUGH THE 1/2 IN. FLEXIBLE TUBING IN THE CONCRETE BASE TO THE REQUIRED GROUNDING ELECTRODE(S). THE GROUNDING ELECTRODE CONDUCTOR FROM THE POLE GROUNDING LUG, CONTROLLER CABINET AND/OR LUMINAIRE MAY ATTACH TO THIS CONTINUOUS GROUNDING ELECTRODE CONDUCTOR FROM THE SERVICE METER AND DISCONNECT. THE CONTRACTOR SHALL PERFORM A RESISTANCE TO GROUND TEST ON THE CONTINUOUS GROUNDING ELECTRODE CONDUCTOR FROM THE SERVICE METER AND DISCONNECT AND PROVIDE A WRITTEN STATEMENT TO THE AREA ELECTRICAL INSPECTOR THAT THE GROUNDING ELECTRODE CONDUCTOR IS CONTINUOUS FROM THE SERVICE METER AND DISCONNECT AND THE RESISTANCE TO GROUND IS 25 OHMS OR LESS.
11. HORIZONTAL MEMBERS SHALL BE CAMBERED AND THE VERTICAL POLES BACK RAKED (WHERE APPLICABLE) TO THE ANTICIPATED DEAD LOAD DEFLECTION PLUS THE CAMBER, IF ANY, SPECIFIED ON THE PLANS.
12. AN EQUIVALENT ALTERNATE DESIGN MAY BE SUBSTITUTED FOR THE DETAILS AND MATERIALS SHOWN.
13. THE DETAILS OF DESIGN FOR THE STRUCTURE AND FOUNDATION ARE TO BE SUPPLIED BY THE CONTRACTOR AND/OR BY THE MANUFACTURER, THE STRUCTURE SHALL BE DESIGNED TO RESIST THE MAXIMUM LOADING AS OUTLINED IN THE AASHTO STANDARD SPECIFICATIONS (SEE NOTE 2). ALL DESIGN CALCULATIONS FOR THE STRUCTURE AND THE FOUNDATION SHALL BE CHECKED AND STAMPED BY AN ENGINEER REGISTERED IN THE STATE OF VERMONT PRIOR TO SUBMITTAL OF THE FABRICATION DRAWINGS TO THE VERMONT AGENCY OF TRANSPORTATION.
14. THE CONTRACTOR SHALL SUBMIT THREE (3) COPIES OF THE DESIGN CALCULATIONS TO THE VERMONT AGENCY OF TRANSPORTATION, PROJECT MANAGER, SHOWING THE FOLLOWING INFORMATION FOR EACH OF THE VERTICAL AND HORIZONTAL COMPONENTS OF THE STRUCTURE AND FOUNDATION:
 - A. THE DESIGN AXIAL AND SHEAR FORCES AND BENDING AND TORSIONAL MOMENTS ACTING AT THE TOP OF THE FOUNDATION.
 - B. THE DESIGN AXIAL, BENDING AND SHEAR STRESSES AND THE COMBINED STRESS RATIO.
 - C. THE ALLOWABLE AXIAL, BENDING, AND SHEAR STRESSES.
 - D. ITEMS A, B, D SHALL BE SHOWN FOR EACH OF THE GROUP LOADINGS (I, II, III) AND FOR THE BASIC WIND LOAD APPLIED TO THE TWO CASES OUTLINED IN THE AASHTO STANDARD SPECIFICATIONS (SEE NOTE 2) SECTION 1.2.5 (D) (4).
 - E. FAILURE TO SUPPLY THE PROPER DESIGN INFORMATION SHALL BE CAUSE FOR REJECTION OF THE STRUCTURE.
 - F. A MINIMUM OF FOUR (4) WEEKS SHALL BE REQUIRED FOR REVIEW BY THE VERMONT AGENCY OF TRANSPORTATION.
 - G. EVERY MEMBER AND CONNECTION IN AN OVERHEAD TRAFFIC SIGN SUPPORT SHALL HAVE A MAXIMUM DESIGN RATIO OF 85% TO PROVIDE RESIDUAL CAPACITY FOR FUTURE MODIFICATIONS TO SIGN SIZE OR CONFIGURATIONS.
15. FABRICATION DRAWINGS (6 COPIES OF EACH) SHALL BE SUBMITTED TO THE STATE OF VERMONT, AGENCY OF TRANSPORTATION, PROJECT MANAGER FOR APPROVAL PRIOR TO FABRICATION. THE FABRICATION DRAWINGS SHALL INCLUDE THE FOLLOWING INFORMATION:
 - A. DETAILED DRAWING OF EACH COMPONENT OF THE STRUCTURE.
 - B. MATERIAL SPECIFICATION FOR EACH COMPONENT OF THE STRUCTURE, EITHER BY COMPLETE SPECIFICATION OR REFERENCE TO APPLICABLE ASTM STANDARDS.
 - C. NOTATION OF PROJECT NAME, PROJECT NUMBER, ROUTE NUMBER, AND STRUCTURE STATIONING (TO BE INCLUDED ON EACH SHEET).
 - D. DETAILS FOR LOCATION OF SIGNS/SIGNALS AND ATTACHMENT HARDWARE FOR THE SUPPORT STRUCTURE.
 - E. ALL ELEVATIONS AND DIMENSIONS NECESSARY TO PROVIDE A COMPLETE SET OF RECORD PLANS.
 - F. DEAD LOAD DEFLECTION AND CAMBER INFORMATION.
 - G. WELDING DETAILS AND PROCEDURES ARE REQUIRED FOR ALL WELDS. PROCEDURES SHALL BE SUBMITTED FOR APPROVAL WITH REFERENCE TO EACH WELD IDENTIFIED ON THE FABRICATION DRAWINGS. (SEE SUB-SECTION 506.10).
16. THE TRAFFIC SIGNALS SHALL BE MOUNTED TO THE ARM OR POLE USING A FIXED MOUNT SYSTEM, UNLESS OTHERWISE NOTED ON THE CROSS SECTION SHEET. FOR SIGNALS MOUNTED ON A MAST ARM, THE MAST ARM AND MOUNTING POINT SHALL BE IN THE MIDDLE OF THE SIGNAL HEAD.
17. BASE PLATES SHALL BE STAMPED WITH THE VERTICAL POLE DIAMETER, HEIGHT, YIELD STRENGTH, GAUGE AND THE HORIZONTAL MEMBER DIAMETER, LENGTH, YIELD STRENGTH, GAUGE, ALTERNATELY. THE INFORMATION MAY BE STAMPED ON A METAL TAG RIVETED TO THE POLE NEAR THE HAND HOLE.
18. SEE STANDARD E-171A FOR ADDITIONAL NOTES.

PROJECT NAME: EAST MONTPELIER
PROJECT NUMBER: STPG 028 - 3(35)S

FILE NAME: +98b028traf.dgn PLOT DATE: 29-MAR-2010
PROJECT LEADER: J. SCHULTZ DRAWN BY: D. LYMAN
DESIGNED BY: J. GRUCHACZ CHECKED BY: J. DEVLIN
TRAFFIC GENERAL NOTES SHEET 72 OF 142

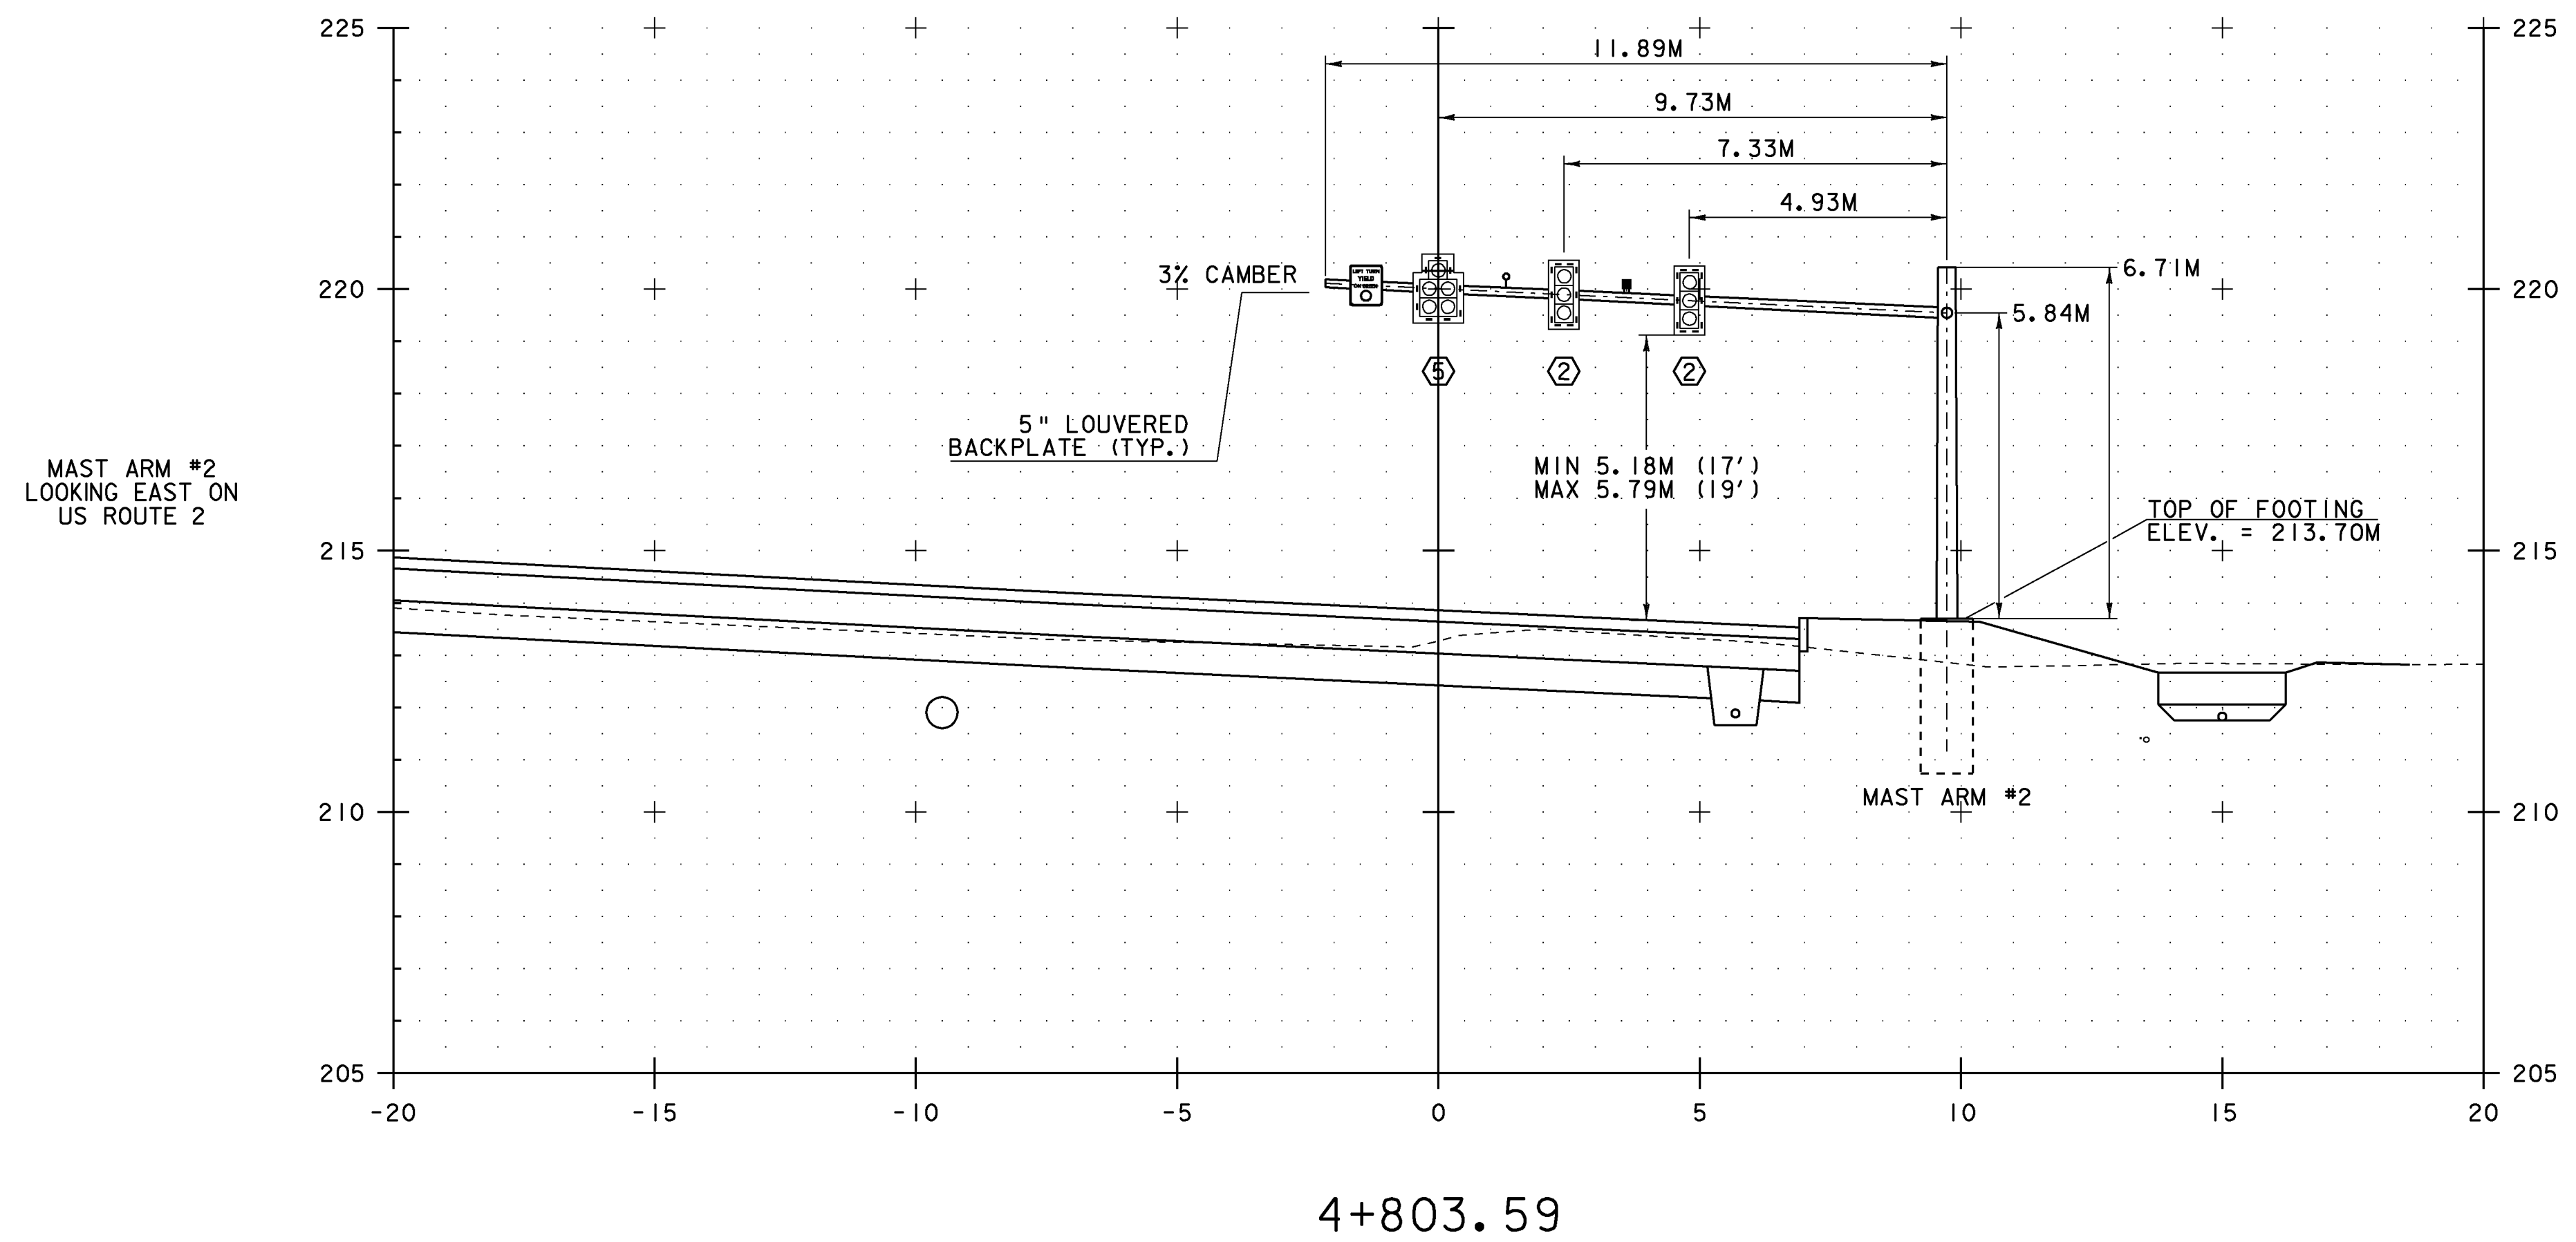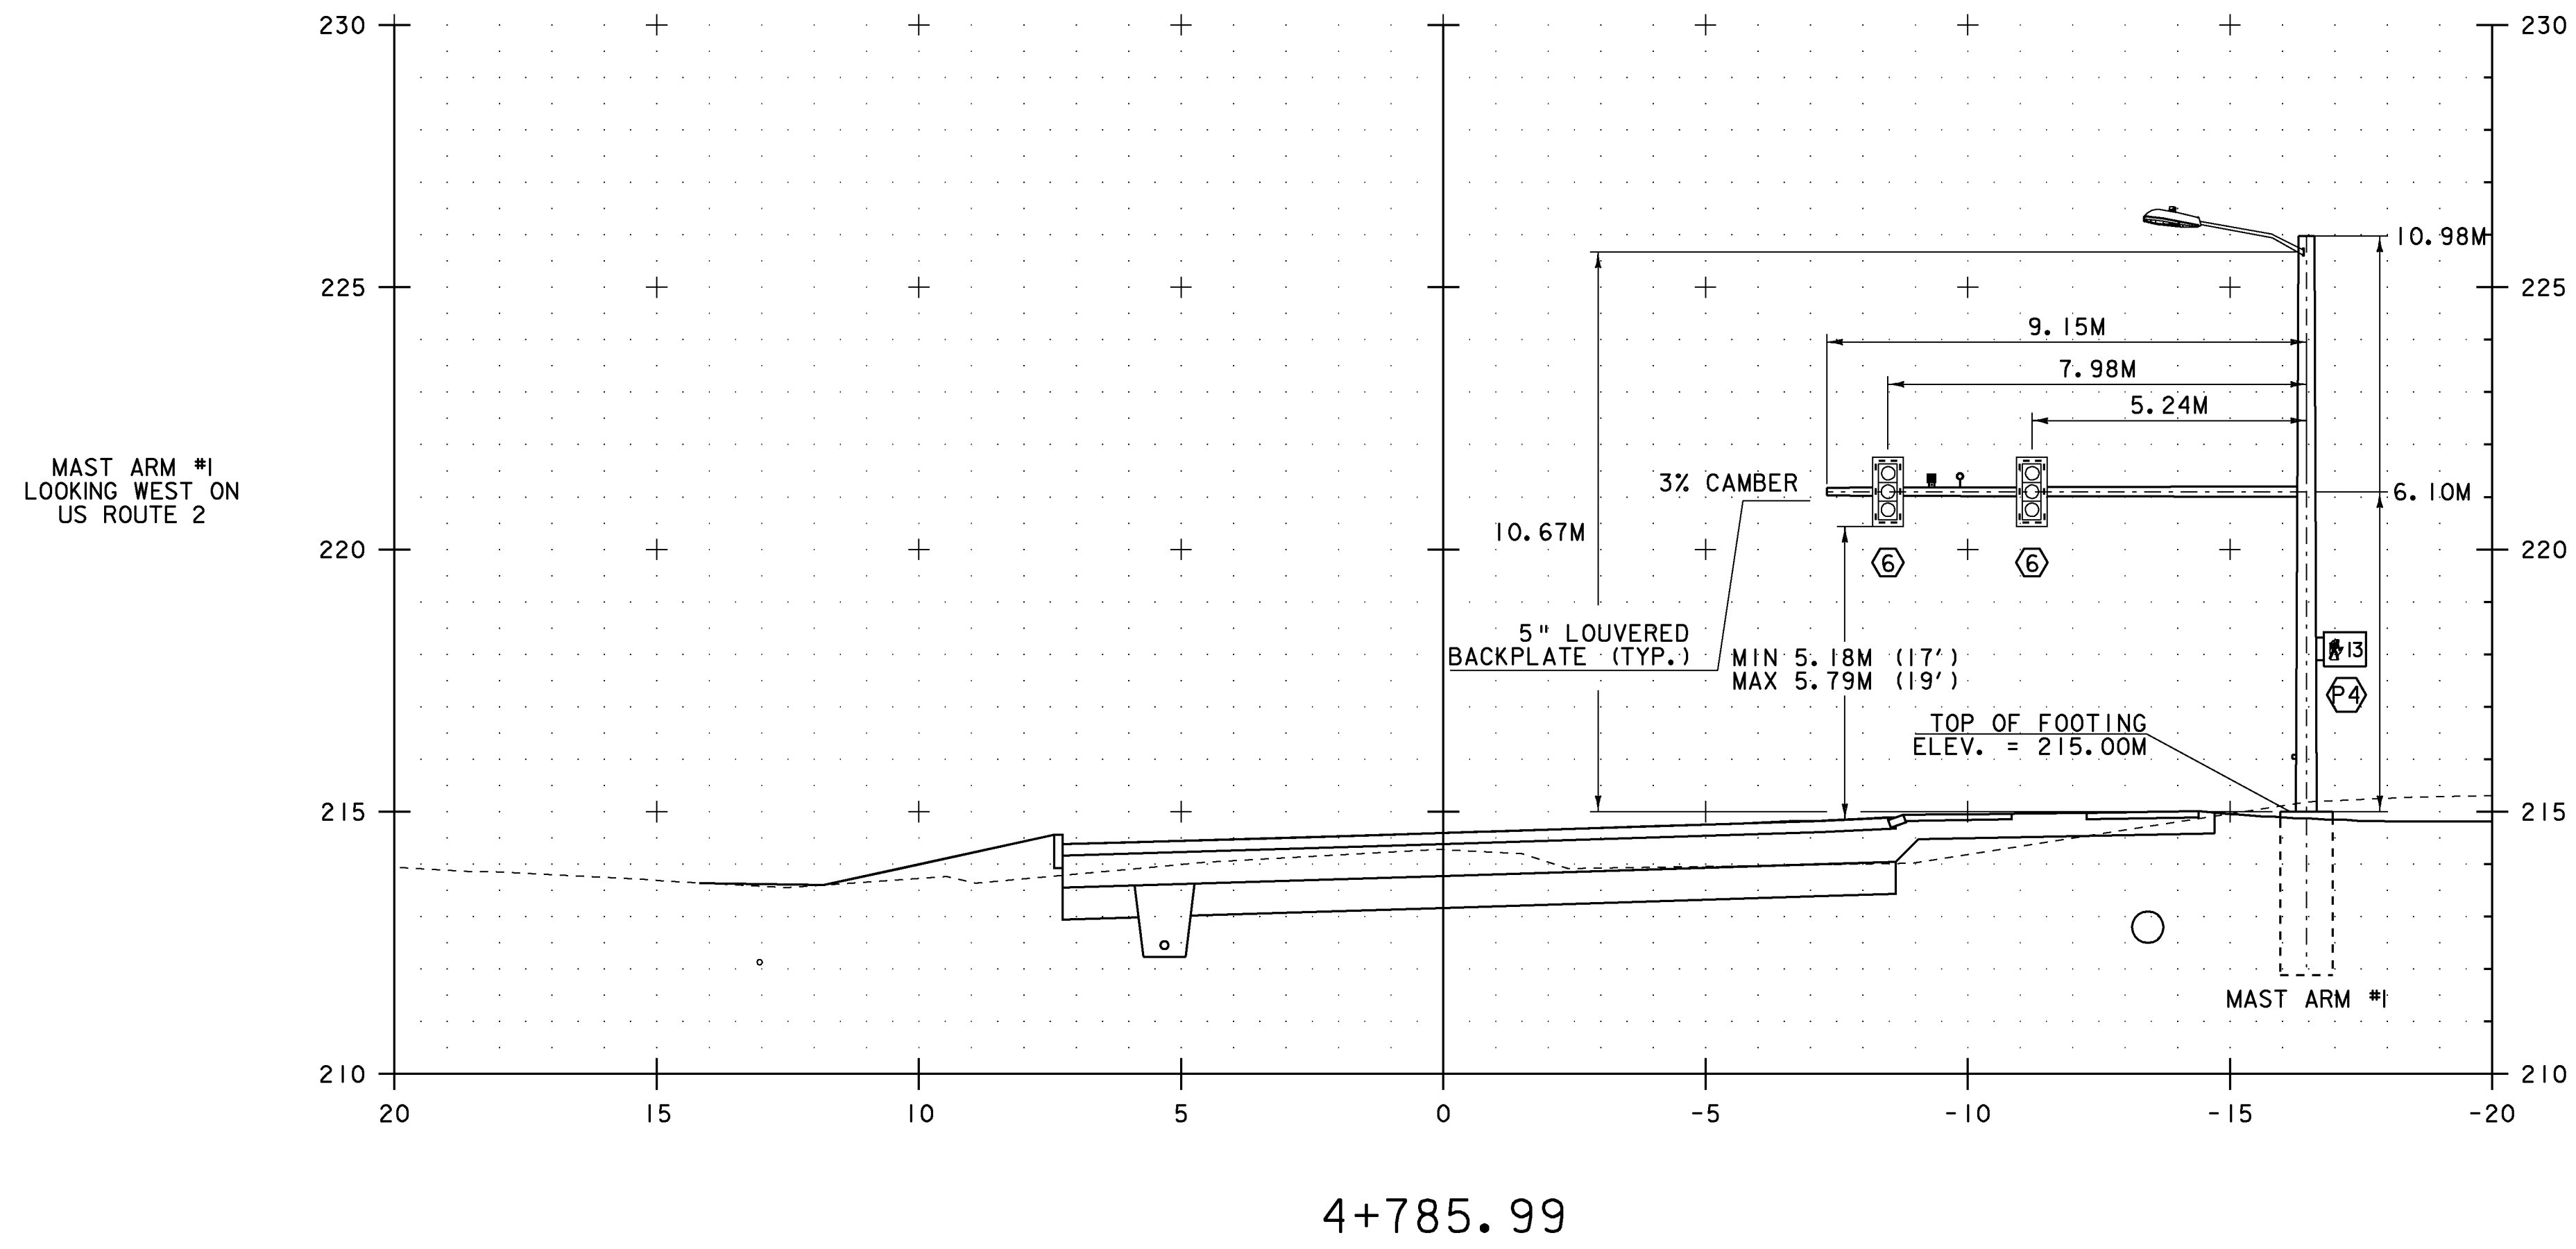


NOTE: FOUNDATION DEPTHS ARE NOT TO SCALE (TYP).



PROJECT NAME:	EAST MONTPELIER
PROJECT NUMBER:	STPG 028 - 3(35)S
FILE NAME:	+98b028traf.dgn
PROJECT LEADER:	J. SCHULTZ
DESIGNED BY:	J. GRUCHACZ
MAST ARM CROSS SECTION SHEET 1	
PLOT DATE:	22-MAR-2010
DRAWN BY:	D. LYMAN
CHECKED BY:	J. DEVLIN
SHEET	73 OF 142



MAST ARM #3
LOOKING SOUTH ON
VT ROUTE 14

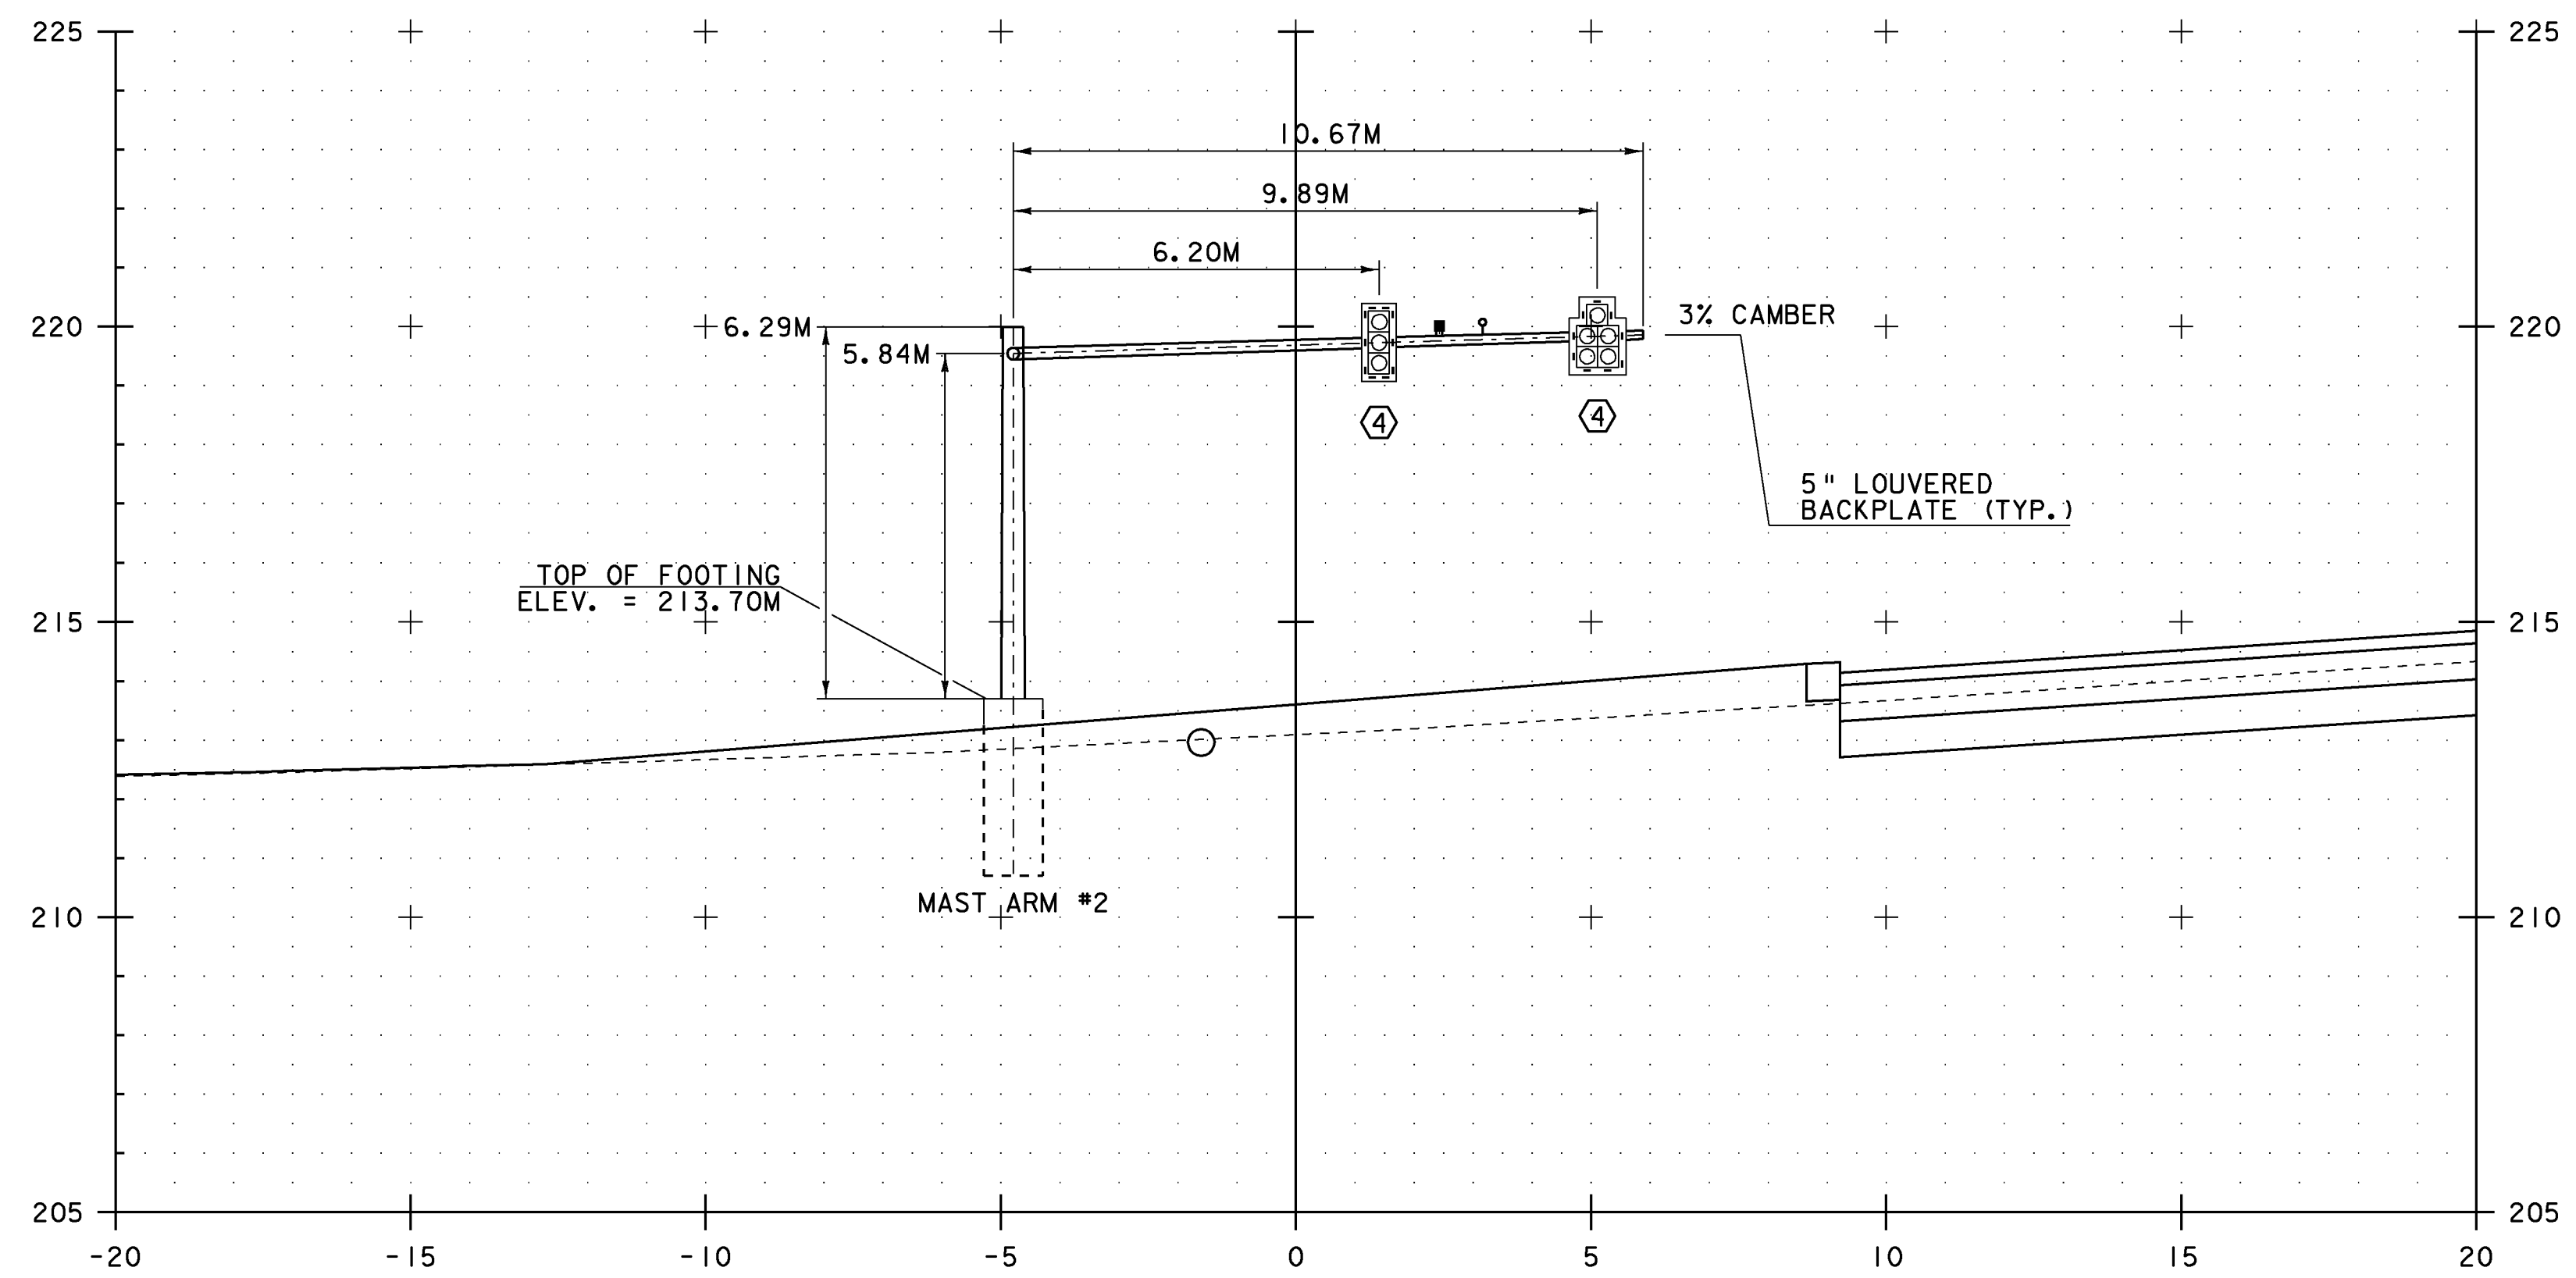

NOTE: FOUNDATION DEPTHS ARE
NOT TO SCALE (TYP).



PROJECT NAME:	EAST MONTPELIER
PROJECT NUMBER:	STPG 028 - 3(35)S
FILE NAME:	+98b028traf.dgn
PROJECT LEADER:	J. SCHULTZ
DESIGNED BY:	J. GRUCHACZ
MAST ARM CROSS SECTION SHEET 2	
PLOT DATE:	22-MAR-2010
DRAWN BY:	D. LYMAN
CHECKED BY:	J. DEVLIN
SHEET	74 OF 142

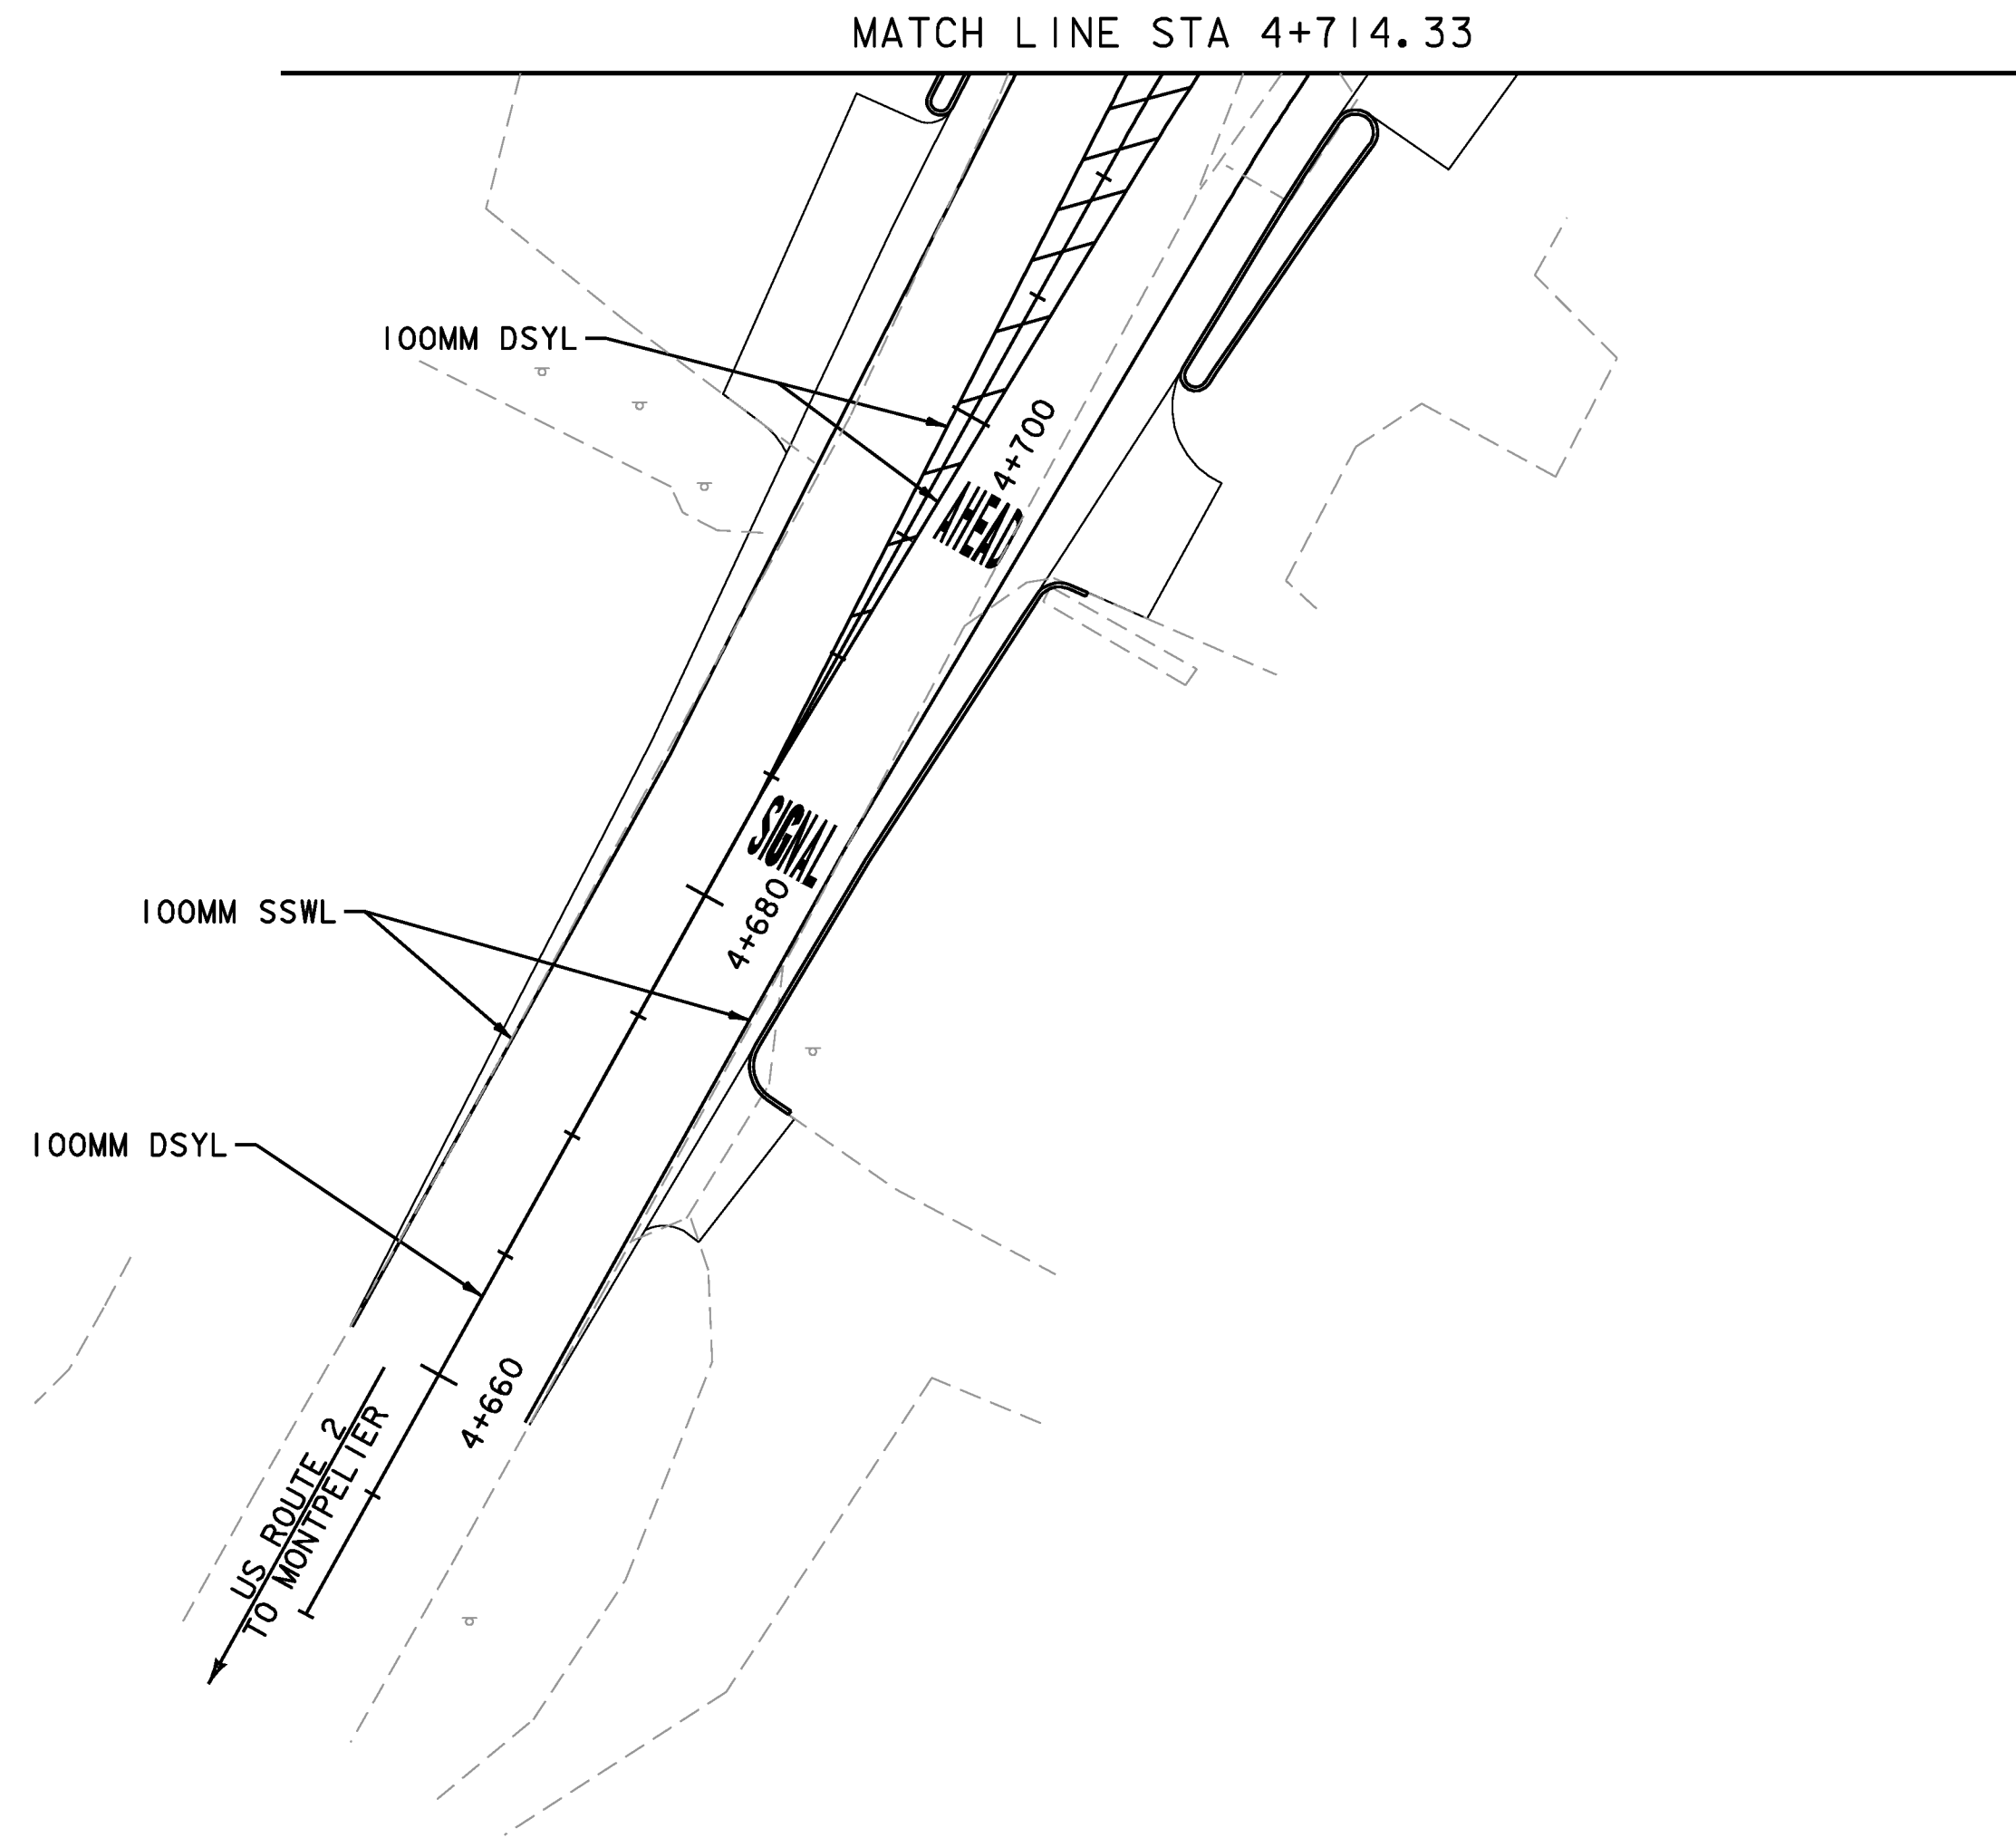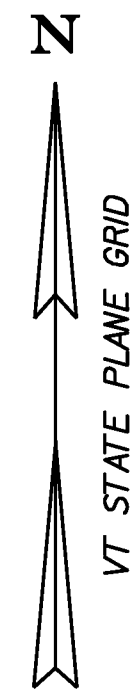

646.406 - DURABLE 100MM WHITE LINE, RECESSED POLYUREA
 STA 4+660.00 LT - 4+711.73 LT (SOLID)
 STA 4+660.00 RT - 4+717.20 RT (SOLID)

646.416 - DURABLE 100MM YELLOW LINE, RECESSED POLYUREA
 STA 4+660.00 CL - 4+684.00 CL (SOLID-DOUBLE)
 STA 4+684.00 LT - 4+713.69 LT (SOLID-DOUBLE)
 STA 4+684.00 RT - 4+715.03 RT (SOLID-DOUBLE)

646.456 - DURABLE 200MM YELLOW LINE, RECESSED POLYUREA
 STA 4+691.50 LT - 4+692.08 RT (SOLID, DIAG.)
 STA 4+694.41 LT - 4+695.21 RT (SOLID, DIAG.)
 STA 4+697.32 LT - 4+698.35 RT (SOLID, DIAG.)
 STA 4+700.23 LT - 4+701.49 RT (SOLID, DIAG.)
 STA 4+703.14 LT - 4+704.62 RT (SOLID, DIAG.)
 STA 4+706.05 LT - 4+707.76 RT (SOLID, DIAG.)
 STA 4+708.10 LT - 4+709.97 RT (SOLID, DIAG.)
 STA 4+710.16 LT - 4+712.20 RT (SOLID, DIAG.)
 STA 4+712.23 LT - 4+714.43 RT (SOLID, DIAG.)

646.491 - DURABLE LETTER OR SYMBOL, TYPE I TAPE Δ
 STA 4+683.33 RT (LETTERS - SIGNAL)
 STA 4+696.67 RT (LETTERS - AHEAD)

646.600 - TEMPORARY 100MM WHITE LINE
 STA 4+660.00 LT - 4+711.73 LT (SOLID)
 STA 4+660.00 RT - 4+717.20 RT (SOLID)

646.610 - TEMPORARY 100MM YELLOW LINE
 STA 4+660.00 CL - 4+684.00 CL (SOLID-DOUBLE)
 STA 4+684.00 LT - 4+713.69 LT (SOLID-DOUBLE)
 STA 4+684.00 RT - 4+715.03 RT (SOLID-DOUBLE)

646.690 - TEMPORARY LETTER OR SYMBOL
 STA 4+683.33 RT (LETTERS - SIGNAL)
 STA 4+696.67 RT (LETTERS - AHEAD)

Δ TYPE I TAPE SHALL BE
 ATM 400 EXTENDED GRADE TAPE OR
 DIRECTOR 60-HP OR STAMARK HIGH
 PERFORMANCE TAPE SERIES 3801


Δ REVISED ITEM

SSWL = SINGLE SOLID WHITE LINE
 DSYL = DOUBLE SOLID YELLOW LINE



PROJECT NAME: EAST MONTPELIER
 PROJECT NUMBER: STPG 028 - 3(35)S

FILE NAME: +98b028+spmbdr.dgn PLOT DATE: 11-MAY-2010
 PROJECT LEADER: J. SCHULTZ DRAWN BY: D. LYMAN
 DESIGNED BY: J. GRUCHACZ CHECKED BY: J. DEVLIN
 PAVEMENT MARKING LAYOUT SHEET I SHEET 75 OF 142

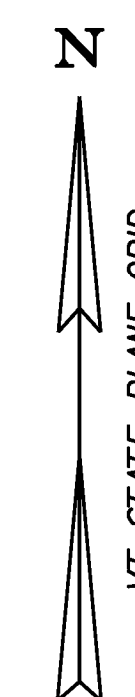

- 646.404 - DURABLE 100MM WHITE LINE, POLYUREA** △
- STA 100+066.00 LT - 100+066.00 LT (SOLID)
 - STA 100+068.75 LT - 100+068.75 LT (SOLID)
 - STA 100+071.50 LT - 100+071.50 LT (SOLID)
 - STA 100+074.25 LT - 100+074.25 LT (SOLID)
 - STA 100+090.07 LT - 100+090.07 LT (SOLID)
 - STA 100+090.07 LT - 100+090.07 RT (SOLID)
 - STA 100+092.82 LT - 100+092.82 LT (SOLID)
 - STA 100+092.82 LT - 100+092.82 RT (SOLID)
 - STA 100+095.57 LT - 100+095.57 LT (SOLID)
 - STA 100+095.57 LT - 100+095.57 RT (SOLID)
 - STA 100+098.32 LT - 100+098.32 LT (SOLID)
 - STA 100+098.32 LT - 100+098.32 RT (SOLID)
 - STA 100+098.32 RT - 100+099.37 RT (SOLID, DIAG.)
 - STA 100+098.32 LT - 100+100.22 RT (SOLID, DIAG.)
 - STA 100+098.32 LT - 100+101.07 RT (SOLID, DIAG., 2)
 - STA 100+098.32 LT - 100+101.07 LT (SOLID, DIAG., 2)
 - STA 100+098.82 LT - 100+101.07 LT (SOLID, DIAG.)
 - STA 100+099.67 LT - 100+101.07 LT (SOLID, DIAG.)
 - STA 100+100.52 LT - 100+101.07 LT (SOLID, DIAG.)
 - STA 100+101.07 LT - 100+101.07 LT (SOLID)
 - STA 100+101.07 LT - 100+101.07 RT (SOLID)

- 646.406 - DURABLE 100MM WHITE LINE, RECESSED POLYUREA**
- STA 4+711.73 LT - 14+060.00 LT (SOLID)
 - STA 4+717.18 RT - 4+810.52 RT (SOLID)
 - STA 4+813.11 RT - 4+873.59 RT (SOLID)
 - STA 4+745.00 RT - 4+755.00 RT (DOTTED)
 - STA 4+755.00 RT - 4+790.00 RT (SOLID)
 - STA 40+060.00 RT - 14+037.03 LT (SOLID)
 - STA 14+039.47 LT - 14+091.73 LT (SOLID)
 - STA 14+042.00 LT - 14+072.00 LT (SOLID)
 - STA 14+072.00 LT - 14+092.75 LT (DOTTED)
 - STA 14+095.00 RT - 14+039.47 RT (SOLID)
 - STA 14+037.03 RT - 4+811.80 LT (SOLID)
 - STA 4+814.05 LT - 4+872.34 LT (SOLID)
 - STA 14+072.00 CL - 14+093.85 CL (DOTTED)

- 646.416 - DURABLE 100MM YELLOW LINE, RECESSED POLYUREA**
- STA 4+713.67 LT - 4+734.00 CL (SOLID-DOUBLE)
 - STA 4+715.02 RT - 4+734.00 CL (SOLID-DOUBLE)
 - STA 4+745.00 LT - 4+790.00 LT (SOLID-DOUBLE)
 - STA 4+814.20 CL - 4+872.87 CL (SOLID-DOUBLE)
 - STA 4+814.20 CL - 4+873.10 RT (SOLID-DOUBLE)
 - STA 40+007.00 LT - 40+060.00 LT (SOLID-DOUBLE)
 - STA 14+042.00 LT - 14+093.23 LT (SOLID-DOUBLE)

- 646.481 - DURABLE 600MM STOP BAR, TYPE I TAPE** △
- STA 4+790.00 LT - 4+790.00 RT
 - STA 4+816.00 LT - 4+816.00 LT
 - STA 40+009.00 LT - 40+009.00 LT
 - STA 14+042.00 LT - 14+042.00 LT

- 646.491 - DURABLE LETTER OR SYMBOL, TYPE I TAPE** △
- STA 4+763.16 CL (SYMBOL - LEFT ARROW)
 - STA 4+775.36 CL (LETTERS - ONLY)
 - STA 4+787.52 CL (SYMBOL - LEFT ARROW)
 - STA 40+011.44 LT (LETTERS - STOP)
 - STA 14+044.45 LT (SYMBOL - LEFT, RIGHT ARROWS)
 - STA 14+056.64 LT (LETTERS - ONLY, ONLY)
 - STA 14+068.83 LT (SYMBOL - LEFT, RIGHT ARROWS)
 - STA 100+097.03 LT (SYMBOL - HANDICAPPED)
 - STA 100+102.53 LT (SYMBOL - HANDICAPPED)

- 646.501 - DURABLE CROSSWALK MARKING, TYPE I TAPE** △
- STA 14+038.25 LT - 14+038.25 RT
 - STA 4+813.05 LT - 4+811.65 RT


- 646.600 - TEMPORARY 100MM WHITE LINE**
- STA 4+711.73 LT - 14+060.00 LT (SOLID)
 - STA 4+717.18 RT - 4+810.52 RT (SOLID)
 - STA 4+813.11 RT - 4+873.59 RT (SOLID)
 - STA 4+745.00 RT - 4+755.00 RT (DOTTED)
 - STA 4+755.00 RT - 4+790.00 RT (SOLID)
 - STA 40+060.00 RT - 14+037.03 LT (SOLID)
 - STA 14+039.47 LT - 14+091.73 LT (SOLID)
 - STA 14+042.00 LT - 14+072.00 LT (SOLID)
 - STA 14+072.00 LT - 14+092.75 LT (DOTTED)
 - STA 14+095.00 RT - 14+039.47 RT (SOLID)
 - STA 14+037.03 RT - 4+811.80 LT (SOLID)
 - STA 4+814.05 LT - 4+872.34 LT (SOLID)
 - STA 14+072.00 CL - 14+093.85 CL (DOTTED)

- 646.610 - TEMPORARY 100MM YELLOW LINE**
- STA 4+713.67 LT - 4+734.00 CL (SOLID-DOUBLE)
 - STA 4+715.02 RT - 4+734.00 CL (SOLID-DOUBLE)
 - STA 4+745.00 LT - 4+790.00 LT (SOLID-DOUBLE)
 - STA 4+814.20 CL - 4+872.87 CL (SOLID-DOUBLE)
 - STA 4+814.20 CL - 4+873.10 RT (SOLID-DOUBLE)
 - STA 40+007.00 LT - 40+060.00 LT (SOLID-DOUBLE)
 - STA 14+042.00 LT - 14+093.23 LT (SOLID-DOUBLE)

- 646.680 - TEMPORARY 600MM STOP BAR**
- STA 4+790.00 LT - 4+790.00 RT
 - STA 4+816.00 LT - 4+816.00 LT
 - STA 40+009.00 LT - 40+009.00 LT
 - STA 14+042.00 LT - 14+042.00 LT

- 646.456 - DURABLE 200MM YELLOW LINE, RECESSED POLYUREA**
- STA 4+714.29 LT - 4+716.65 RT (SOLID, DIAG.)
 - STA 4+716.35 LT - 4+718.87 RT (SOLID, DIAG.)
 - STA 4+718.41 LT - 4+721.09 RT (SOLID, DIAG.)
 - STA 4+720.47 LT - 4+723.31 RT (SOLID, DIAG.)
 - STA 4+722.53 LT - 4+725.53 RT (SOLID, DIAG.)
 - STA 4+724.59 LT - 4+727.75 RT (SOLID, DIAG.)
 - STA 4+726.65 LT - 4+729.97 RT (SOLID, DIAG.)
 - STA 4+728.71 LT - 4+732.19 RT (SOLID, DIAG.)
 - STA 4+816.00 LT - 4+819.14 RT (SOLID, DIAG.)
 - STA 4+818.27 LT - 4+821.80 RT (SOLID, DIAG.)
 - STA 4+820.48 LT - 4+823.94 RT (SOLID, DIAG.)
 - STA 4+822.48 LT - 4+826.32 RT (SOLID, DIAG.)
 - STA 4+824.89 LT - 4+828.20 RT (SOLID, DIAG.)
 - STA 4+827.10 LT - 4+830.34 RT (SOLID, DIAG.)
 - STA 4+829.31 LT - 4+832.47 RT (SOLID, DIAG.)
 - STA 4+831.52 LT - 4+834.56 RT (SOLID, DIAG.)
 - STA 4+833.70 LT - 4+836.69 RT (SOLID, DIAG.)
 - STA 4+835.91 LT - 4+838.82 RT (SOLID, DIAG.)
 - STA 4+838.12 LT - 4+840.96 RT (SOLID, DIAG.)
 - STA 4+840.33 LT - 4+843.09 RT (SOLID, DIAG.)
 - STA 4+842.55 LT - 4+845.23 RT (SOLID, DIAG.)
 - STA 4+844.76 LT - 4+847.36 RT (SOLID, DIAG.)
 - STA 4+846.97 LT - 4+849.50 RT (SOLID, DIAG.)
 - STA 4+849.18 LT - 4+851.63 RT (SOLID, DIAG.)
 - STA 4+851.39 LT - 4+853.76 RT (SOLID, DIAG.)
 - STA 4+853.60 LT - 4+855.90 RT (SOLID, DIAG.)
 - STA 4+855.81 LT - 4+858.03 RT (SOLID, DIAG.)
 - STA 4+858.02 LT - 4+860.17 RT (SOLID, DIAG.)
 - STA 4+860.23 LT - 4+862.30 RT (SOLID, DIAG.)
 - STA 4+862.44 LT - 4+864.43 RT (SOLID, DIAG.)
 - STA 4+864.65 LT - 4+866.57 RT (SOLID, DIAG.)
 - STA 4+866.86 LT - 4+868.68 RT (SOLID, DIAG.)
 - STA 4+869.04 LT - 4+870.74 RT (SOLID, DIAG.)
 - STA 4+871.17 LT - 4+872.80 RT (SOLID, DIAG.)


- 646.690 - TEMPORARY LETTER OR SYMBOL**
- STA 4+763.16 CL (SYMBOL - LEFT ARROW)
 - STA 4+775.36 CL (LETTERS - ONLY)
 - STA 4+787.52 CL (SYMBOL - LEFT ARROW)
 - STA 40+011.44 LT (LETTERS - STOP)
 - STA 14+044.45 LT (SYMBOL - LEFT, RIGHT ARROWS)
 - STA 14+056.64 LT (LETTERS - ONLY, ONLY)
 - STA 14+068.83 LT (SYMBOL - LEFT, RIGHT ARROWS)
 - STA 100+097.03 LT (SYMBOL - HANDICAPPED)
 - STA 100+102.53 LT (SYMBOL - HANDICAPPED)

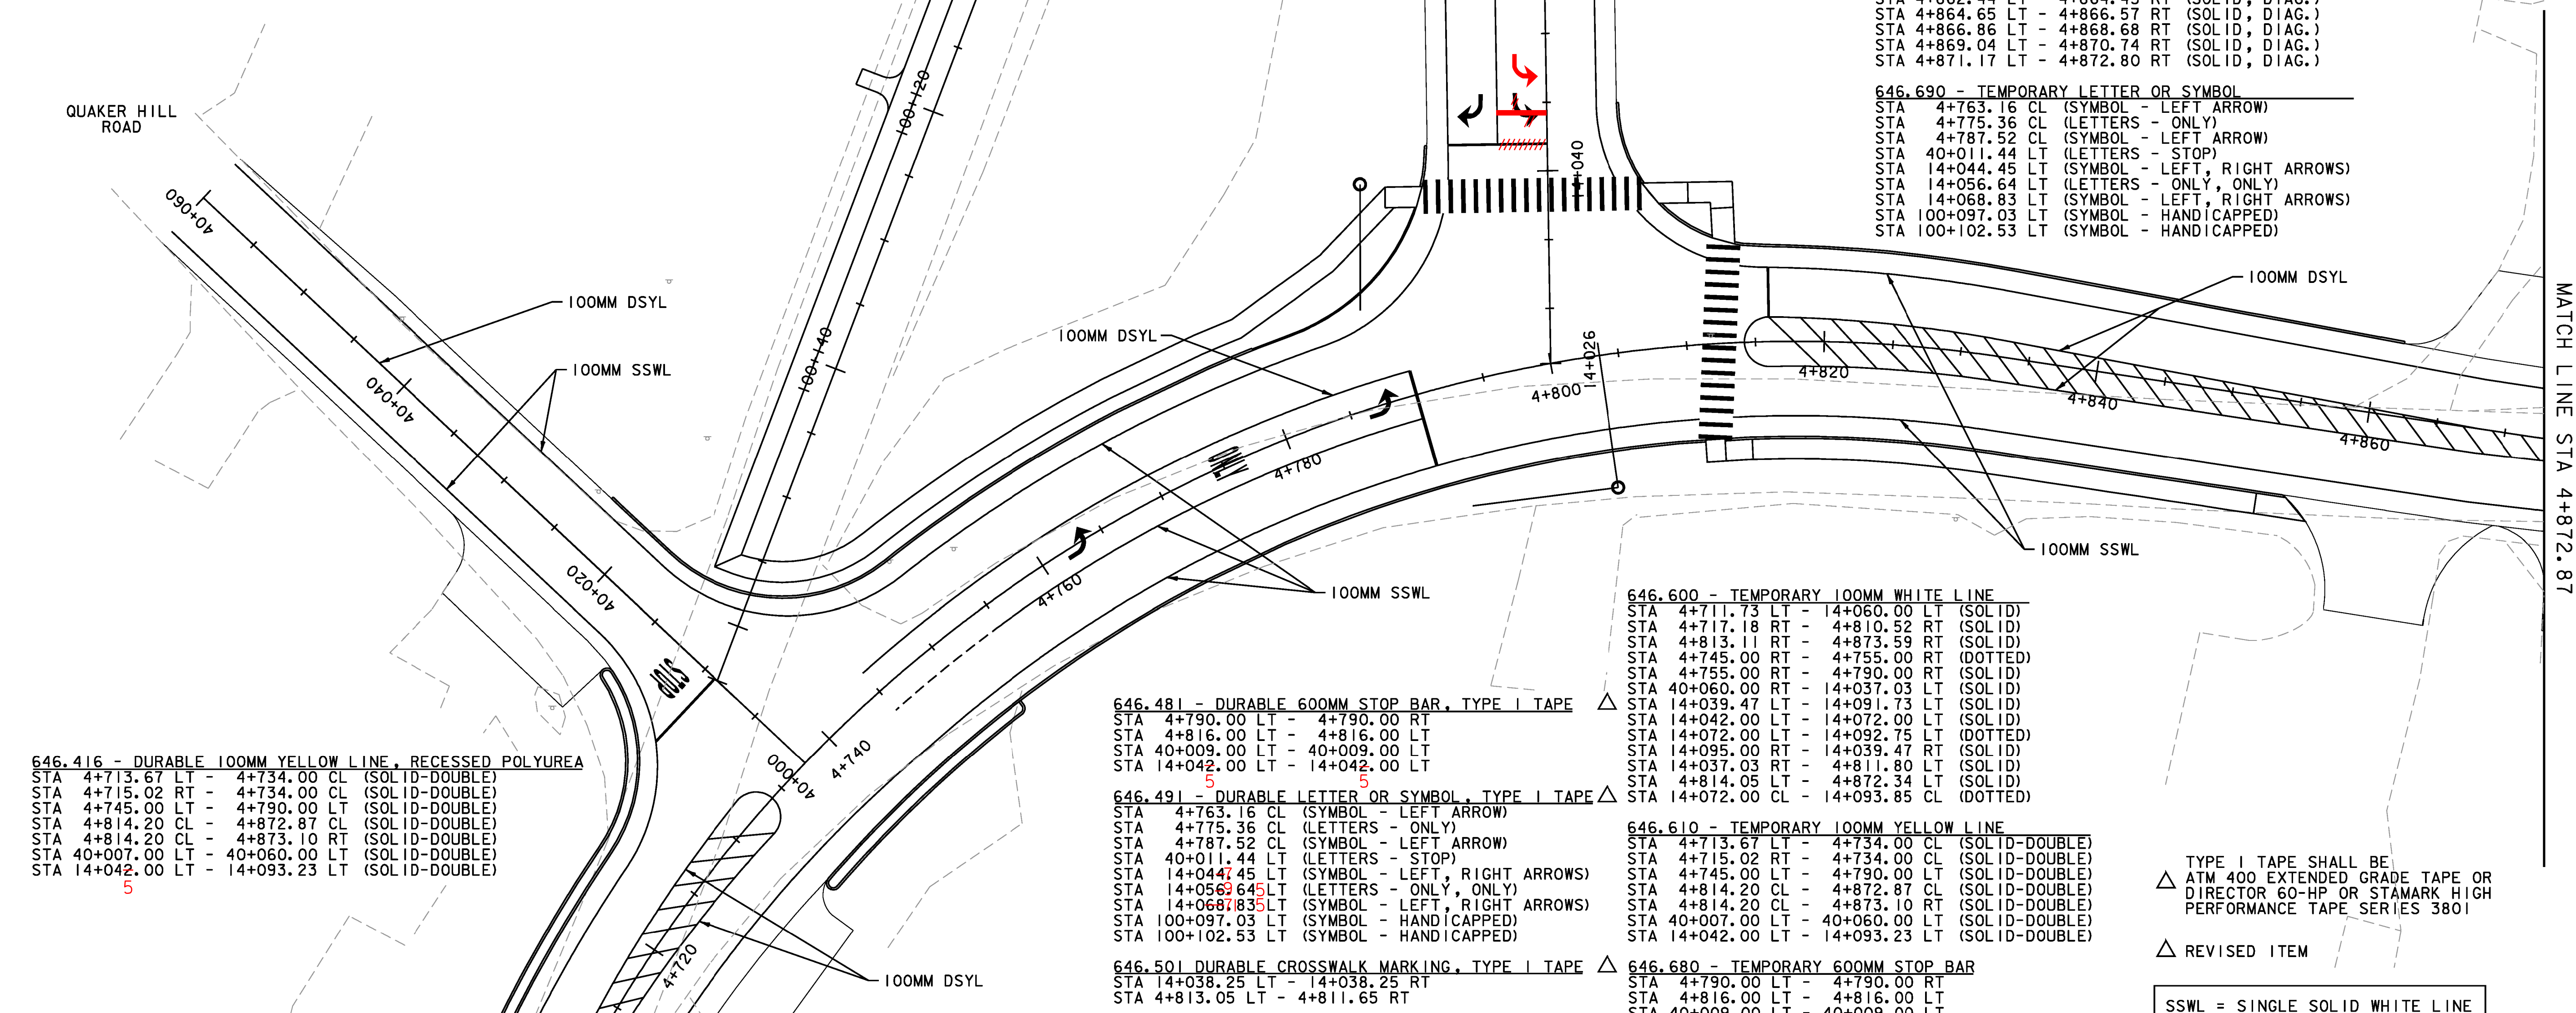


△ TYPE I TAPE SHALL BE ATM 400 EXTENDED GRADE TAPE OR DIRECTOR 60-HP OR STAMARK HIGH PERFORMANCE TAPE SERIES 3801

△ REVISED ITEM

SSWL = SINGLE SOLID WHITE LINE
DSYL = DOUBLE SOLID YELLOW LINE

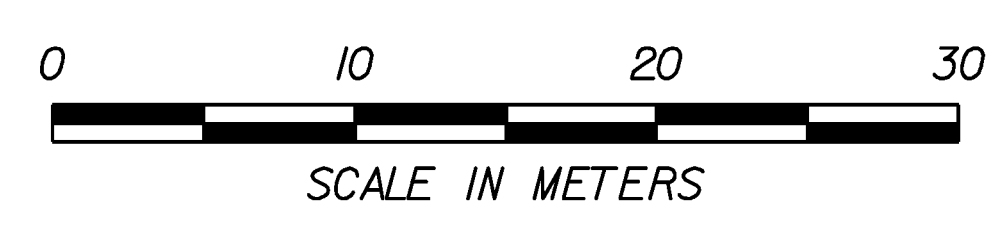

PROJECT NAME:	EAST MONTPELIER	FILE NAME:	+98b028+spmbdr.dgn	PLOT DATE:	11-MAY-2010
PROJECT NUMBER:	STPG 028-3(35)S	PROJECT LEADER:	J. SCHULTZ	DRAWN BY:	D. LYMAN
		DESIGNED BY:	J. GRUCHACZ	CHECKED BY:	J. DEVLIN
		PAVEMENT MARKING LAYOUT SHEET 2		SHEET	76 OF 142

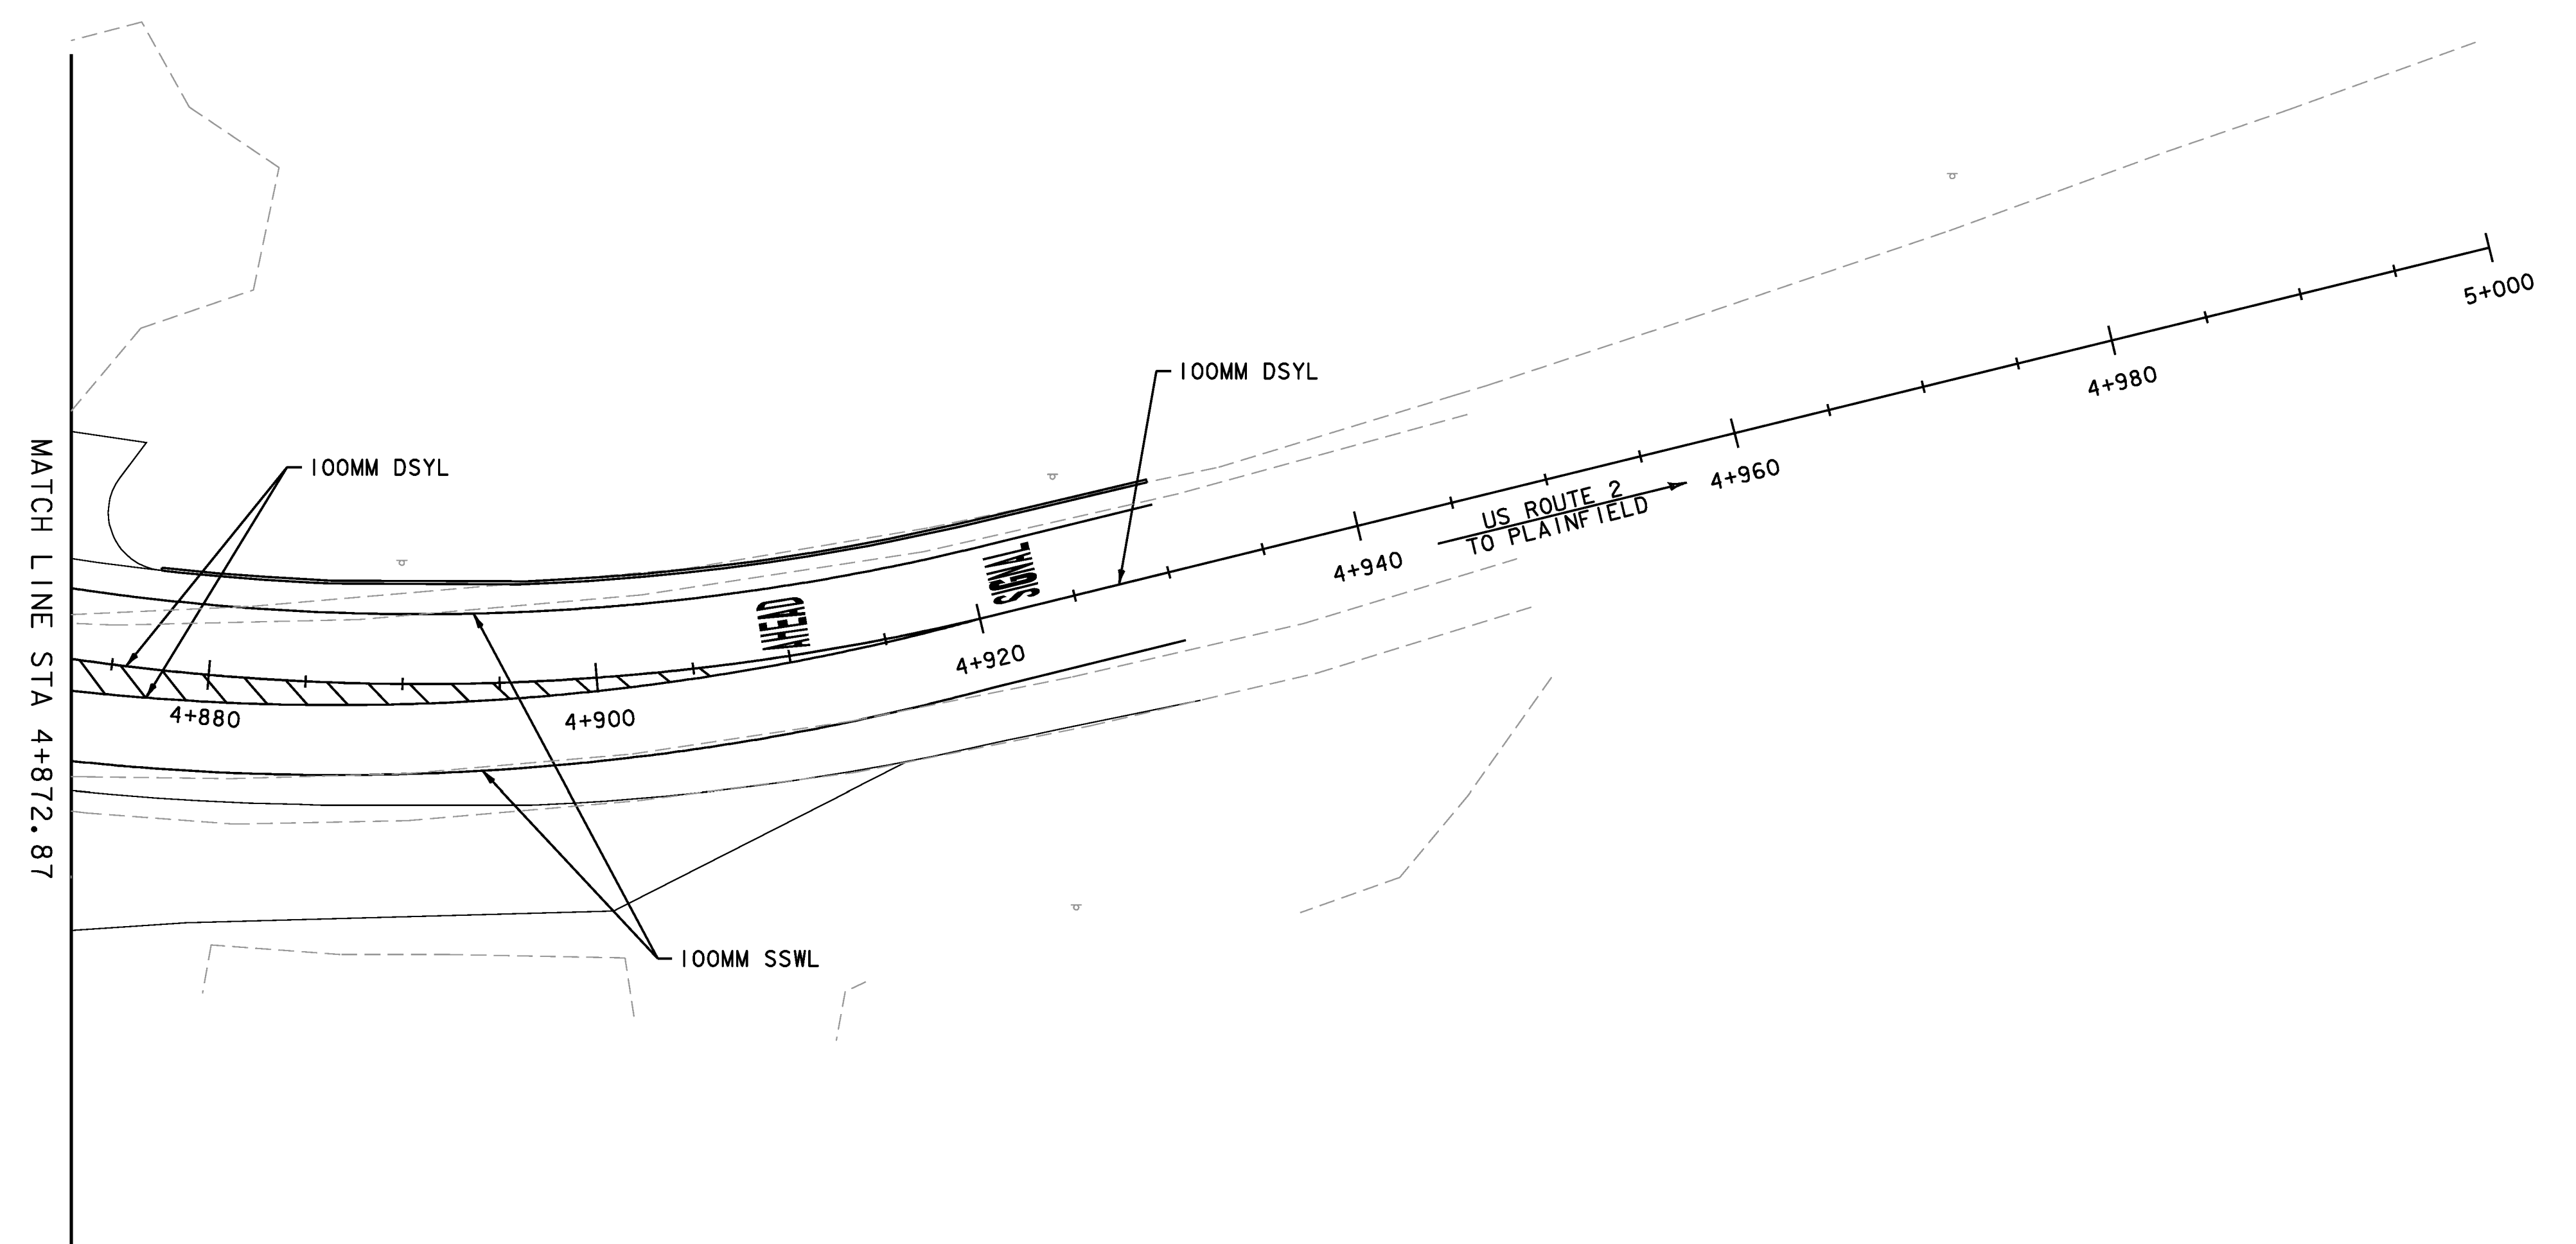

- 646.406 - DURABLE 100MM WHITE LINE, RECESSED POLYUREA
STA 4+872.33 LT - 4+930.00 LT
STA 4+873.59 RT - 4+930.00 RT
- 646.416 - DURABLE 100MM YELLOW LINE, RECESSED POLYUREA
STA 4+872.87 CL - 4+920.00 CL (SOLID-DOUBLE)
STA 4+873.59 RT - 4+920.00 CL (SOLID-DOUBLE)
STA 4+920.00 CL - 4+930.00 CL (SOLID-DOUBLE)
- 646.456 - DURABLE 200MM YELLOW LINE, RECESSED POLYUREA
STA 4+875.30 CL - 4+874.84 RT (SOLID, DIAG.)
STA 4+875.44 CL - 4+876.91 RT (SOLID, DIAG.)
STA 4+877.57 CL - 4+878.97 RT (SOLID, DIAG.)
STA 4+879.71 CL - 4+881.04 RT (SOLID, DIAG.)
STA 4+881.84 CL - 4+883.10 RT (SOLID, DIAG.)
STA 4+883.98 CL - 4+885.16 RT (SOLID, DIAG.)
STA 4+886.11 CL - 4+887.23 RT (SOLID, DIAG.)
STA 4+888.24 CL - 4+889.29 RT (SOLID, DIAG.)
STA 4+890.38 CL - 4+891.36 RT (SOLID, DIAG.)
STA 4+892.51 CL - 4+893.42 RT (SOLID, DIAG.)
STA 4+894.65 CL - 4+895.49 RT (SOLID, DIAG.)
STA 4+896.78 CL - 4+897.55 RT (SOLID, DIAG.)
STA 4+898.91 CL - 4+899.61 RT (SOLID, DIAG.)
STA 4+901.05 CL - 4+901.68 RT (SOLID, DIAG.)
STA 4+903.18 CL - 4+903.74 RT (SOLID, DIAG.)
STA 4+905.32 CL - 4+905.80 RT (SOLID, DIAG.)

- 646.491 - DURABLE LETTER OR SYMBOL, TYPE I TAPE
STA 4+909.90 LT (LETTERS - AHEAD)
STA 4+922.10 LT (LETTERS - SIGNAL)
- 646.600 - TEMPORARY 100MM WHITE LINE
STA 4+872.33 LT - 4+930.00 LT
STA 4+873.59 RT - 4+930.00 RT
- 646.610 - TEMPORARY 100MM YELLOW LINE
STA 4+872.87 CL - 4+920.00 CL (SOLID-DOUBLE)
STA 4+873.59 RT - 4+920.00 CL (SOLID-DOUBLE)
STA 4+920.00 CL - 4+930.00 CL (SOLID-DOUBLE)
- 646.690 - TEMPORARY LETTER OR SYMBOL
STA 4+909.90 LT (LETTERS - AHEAD)
STA 4+922.10 LT (LETTERS - SIGNAL)
- 646.850 - REMOVAL OF EXISTING PAVEMENT MARKINGS
STA 5+093.33 LT APPROX. (LETTERS - AHEAD)
STA 5+106.66 LT APPROX. (LETTERS - STOP)


TYPE I TAPE SHALL BE
 ATM 400 EXTENDED GRADE TAPE OR
 DIRECTOR 60-HP OR STAMARK HIGH
 PERFORMANCE TAPE SERIES 3801

REVISED ITEM

SSWL = SINGLE SOLID WHITE LINE
 DSYL = DOUBLE SOLID YELLOW LINE



PROJECT NAME: EAST MONTPELIER	
PROJECT NUMBER: STPG 028-3(35)S	
FILE NAME: +98b028+spmbdr.dgn	PLOT DATE: 11-MAY-2010
PROJECT LEADER: J. SCHULTZ	DRAWN BY: D. LYMAN
DESIGNED BY: J. GRUCHACZ	CHECKED BY: J. DEVLIN
PAVEMENT MARKING LAYOUT SHEET 3	SHEET 77 OF 142

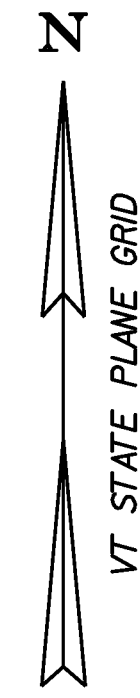

646.404 - DURABLE 100MM WHITE LINE, POLYUREA Δ
 STA 100+033.60 LT - 100+033.60 LT (SOLID)
 STA 100+036.80 LT - 100+036.53 LT (SOLID)
 STA 100+039.95 LT - 100+039.91 LT (SOLID)
 STA 100+043.04 LT - 100+043.62 LT (SOLID)
 STA 100+046.25 LT - 100+046.56 LT (SOLID)
 STA 100+049.45 LT - 100+049.48 LT (SOLID)
 STA 100+052.25 LT - 100+052.25 LT (SOLID)
 STA 100+057.75 LT - 100+057.75 LT (SOLID)
 STA 100+060.50 LT - 100+060.50 LT (SOLID)
 STA 100+063.25 LT - 100+063.25 LT (SOLID)
 STA 100+066.00 LT - 100+066.00 LT (SOLID)

646.406 - DURABLE 100MM WHITE LINE, RECESSED POLYUREA
 STA 14+091.71 LT - 100+009.26 LT (SOLID)
 STA 14+092.75 LT - 14+110.00 LT (DOTTED)
 STA 14+093.85 CL - 14+110.00 CL (DOTTED)
 STA 14+110.00 CL - 14+135.00 CL (SOLID)
 STA 14+095.02 RT - 14+255.00 RT (SOLID)
 STA 100+009.25 LT - 30+036.85 LT (SOLID)
 STA 30+036.85 RT - 14+255.00 LT (SOLID)

646.416 - DURABLE 100MM YELLOW LINE, RECESSED POLYUREA
 STA 14+093.23 LT - 14+135.00 LT (SOLID-DOUBLE)
 STA 14+148.23 LT - 14+221.00 LT (SOLID-DOUBLE, 2)
 STA 14+221.00 LT - 14+255.00 CL (SOLID-DOUBLE)
 STA 30+010.00 CL - 30+015.34 CL (SOLID-DOUBLE)
 STA 100+009.00 CL - 100+029.00 CL (SOLID-DOUBLE)

646.456 - DURABLE 200MM YELLOW LINE, RECESSED POLYUREA
 STA 14+150.00 LT - 14+153.66 LT (SOLID, DIAG.)
 STA 14+152.34 LT - 14+155.79 LT (SOLID, DIAG.)
 STA 14+154.47 LT - 14+157.93 LT (SOLID, DIAG.)
 STA 14+156.55 LT - 14+160.06 LT (SOLID, DIAG.)
 STA 14+158.74 LT - 14+162.18 LT (SOLID, DIAG.)
 STA 14+160.92 LT - 14+164.33 LT (SOLID, DIAG.)
 STA 14+163.16 LT - 14+166.46 LT (SOLID, DIAG.)
 STA 14+165.41 LT - 14+168.58 LT (SOLID, DIAG.)
 STA 14+167.65 LT - 14+170.70 LT (SOLID, DIAG.)
 STA 14+169.89 LT - 14+172.81 LT (SOLID, DIAG.)
 STA 14+172.14 LT - 14+174.93 LT (SOLID, DIAG.)
 STA 14+174.38 LT - 14+177.05 LT (SOLID, DIAG.)
 STA 14+176.62 LT - 14+179.16 LT (SOLID, DIAG.)
 STA 14+178.87 LT - 14+181.28 LT (SOLID, DIAG.)
 STA 14+181.11 LT - 14+183.40 LT (SOLID, DIAG.)
 STA 14+183.36 LT - 14+185.52 LT (SOLID, DIAG.)
 STA 14+185.61 LT - 14+187.63 LT (SOLID, DIAG.)
 STA 14+187.85 LT - 14+189.75 LT (SOLID, DIAG.)
 STA 14+190.10 LT - 14+191.87 LT (SOLID, DIAG.)
 STA 14+192.34 LT - 14+193.99 LT (SOLID, DIAG.)
 STA 14+194.59 LT - 14+196.10 LT (SOLID, DIAG.)
 STA 14+196.84 LT - 14+198.22 LT (SOLID, DIAG.)
 STA 14+199.05 LT - 14+200.34 LT (SOLID, DIAG.)
 STA 14+201.30 LT - 14+202.45 LT (SOLID, DIAG.)
 STA 14+203.55 LT - 14+204.57 LT (SOLID, DIAG.)
 STA 14+205.80 LT - 14+206.69 LT (SOLID, DIAG.)
 STA 14+208.05 LT - 14+208.81 LT (SOLID, DIAG.)
 STA 14+210.30 LT - 14+210.93 LT (SOLID, DIAG.)
 STA 14+212.57 LT - 14+213.06 LT (SOLID, DIAG.)

646.481 - DURABLE 600MM STOP BAR, TYPE I TAPE Δ
 STA 30+010.00 LT - 30+010.00 LT
 STA 100+009.00 LT - 100+009.00 LT

646.491 - DURABLE LETTER OR SYMBOL, TYPE I TAPE Δ
 STA 14+108.17 LT (SYMBOL - LEFT ARROW)
 STA 14+120.37 LT (LETTERS - ONLY)
 STA 14+132.56 LT (SYMBOL - LEFT ARROW)
 STA 14+183.90 LT (LETTERS - AHEAD)
 STA 14+196.10 LT (LETTERS - SIGNAL)
 STA 30+012.44 LT (LETTERS - STOP)
 STA 100+011.44 LT (LETTERS - STOP)

646.600 - TEMPORARY 100MM WHITE LINE
 STA 14+091.71 LT - 100+009.26 LT (SOLID)
 STA 14+092.75 LT - 14+110.00 LT (DOTTED)
 STA 14+093.85 CL - 14+110.00 CL (DOTTED)
 STA 14+110.00 CL - 14+135.00 CL (SOLID)
 STA 14+095.02 RT - 14+255.00 RT (SOLID)
 STA 100+009.25 LT - 30+036.85 LT (SOLID)
 STA 30+036.85 RT - 14+255.00 LT (SOLID)

646.610 - TEMPORARY 100MM YELLOW LINE
 STA 14+093.23 LT - 14+135.00 LT (SOLID-DOUBLE)
 STA 14+148.23 LT - 14+221.00 LT (SOLID-DOUBLE, 2)
 STA 14+221.00 LT - 14+255.00 CL (SOLID-DOUBLE)
 STA 30+010.00 CL - 30+015.34 CL (SOLID-DOUBLE)
 STA 100+009.00 CL - 100+029.00 CL (SOLID-DOUBLE)


646.680 - TEMPORARY 600MM STOP BAR
 STA 30+010.00 LT - 30+010.00 LT
 STA 100+009.00 LT - 100+009.00 LT

646.690 - TEMPORARY LETTER OR SYMBOL
 STA 14+108.17 LT (SYMBOL - LEFT ARROW)
 STA 14+120.37 LT (LETTERS - ONLY)
 STA 14+132.56 LT (SYMBOL - LEFT ARROW)
 STA 14+183.90 LT (LETTERS - AHEAD)
 STA 14+196.10 LT (LETTERS - SIGNAL)
 STA 30+012.44 LT (LETTERS - STOP)
 STA 100+011.44 LT (LETTERS - STOP)

TYPE I TAPE SHALL BE
 Δ ATM 400 EXTENDED GRADE TAPE OR
 DIRECTOR 60-HP OR STAMARK HIGH
 PERFORMANCE TAPE SERIES 3801


Δ REVISED ITEM

SSWL = SINGLE SOLID WHITE LINE
 DSYL = DOUBLE SOLID YELLOW LINE

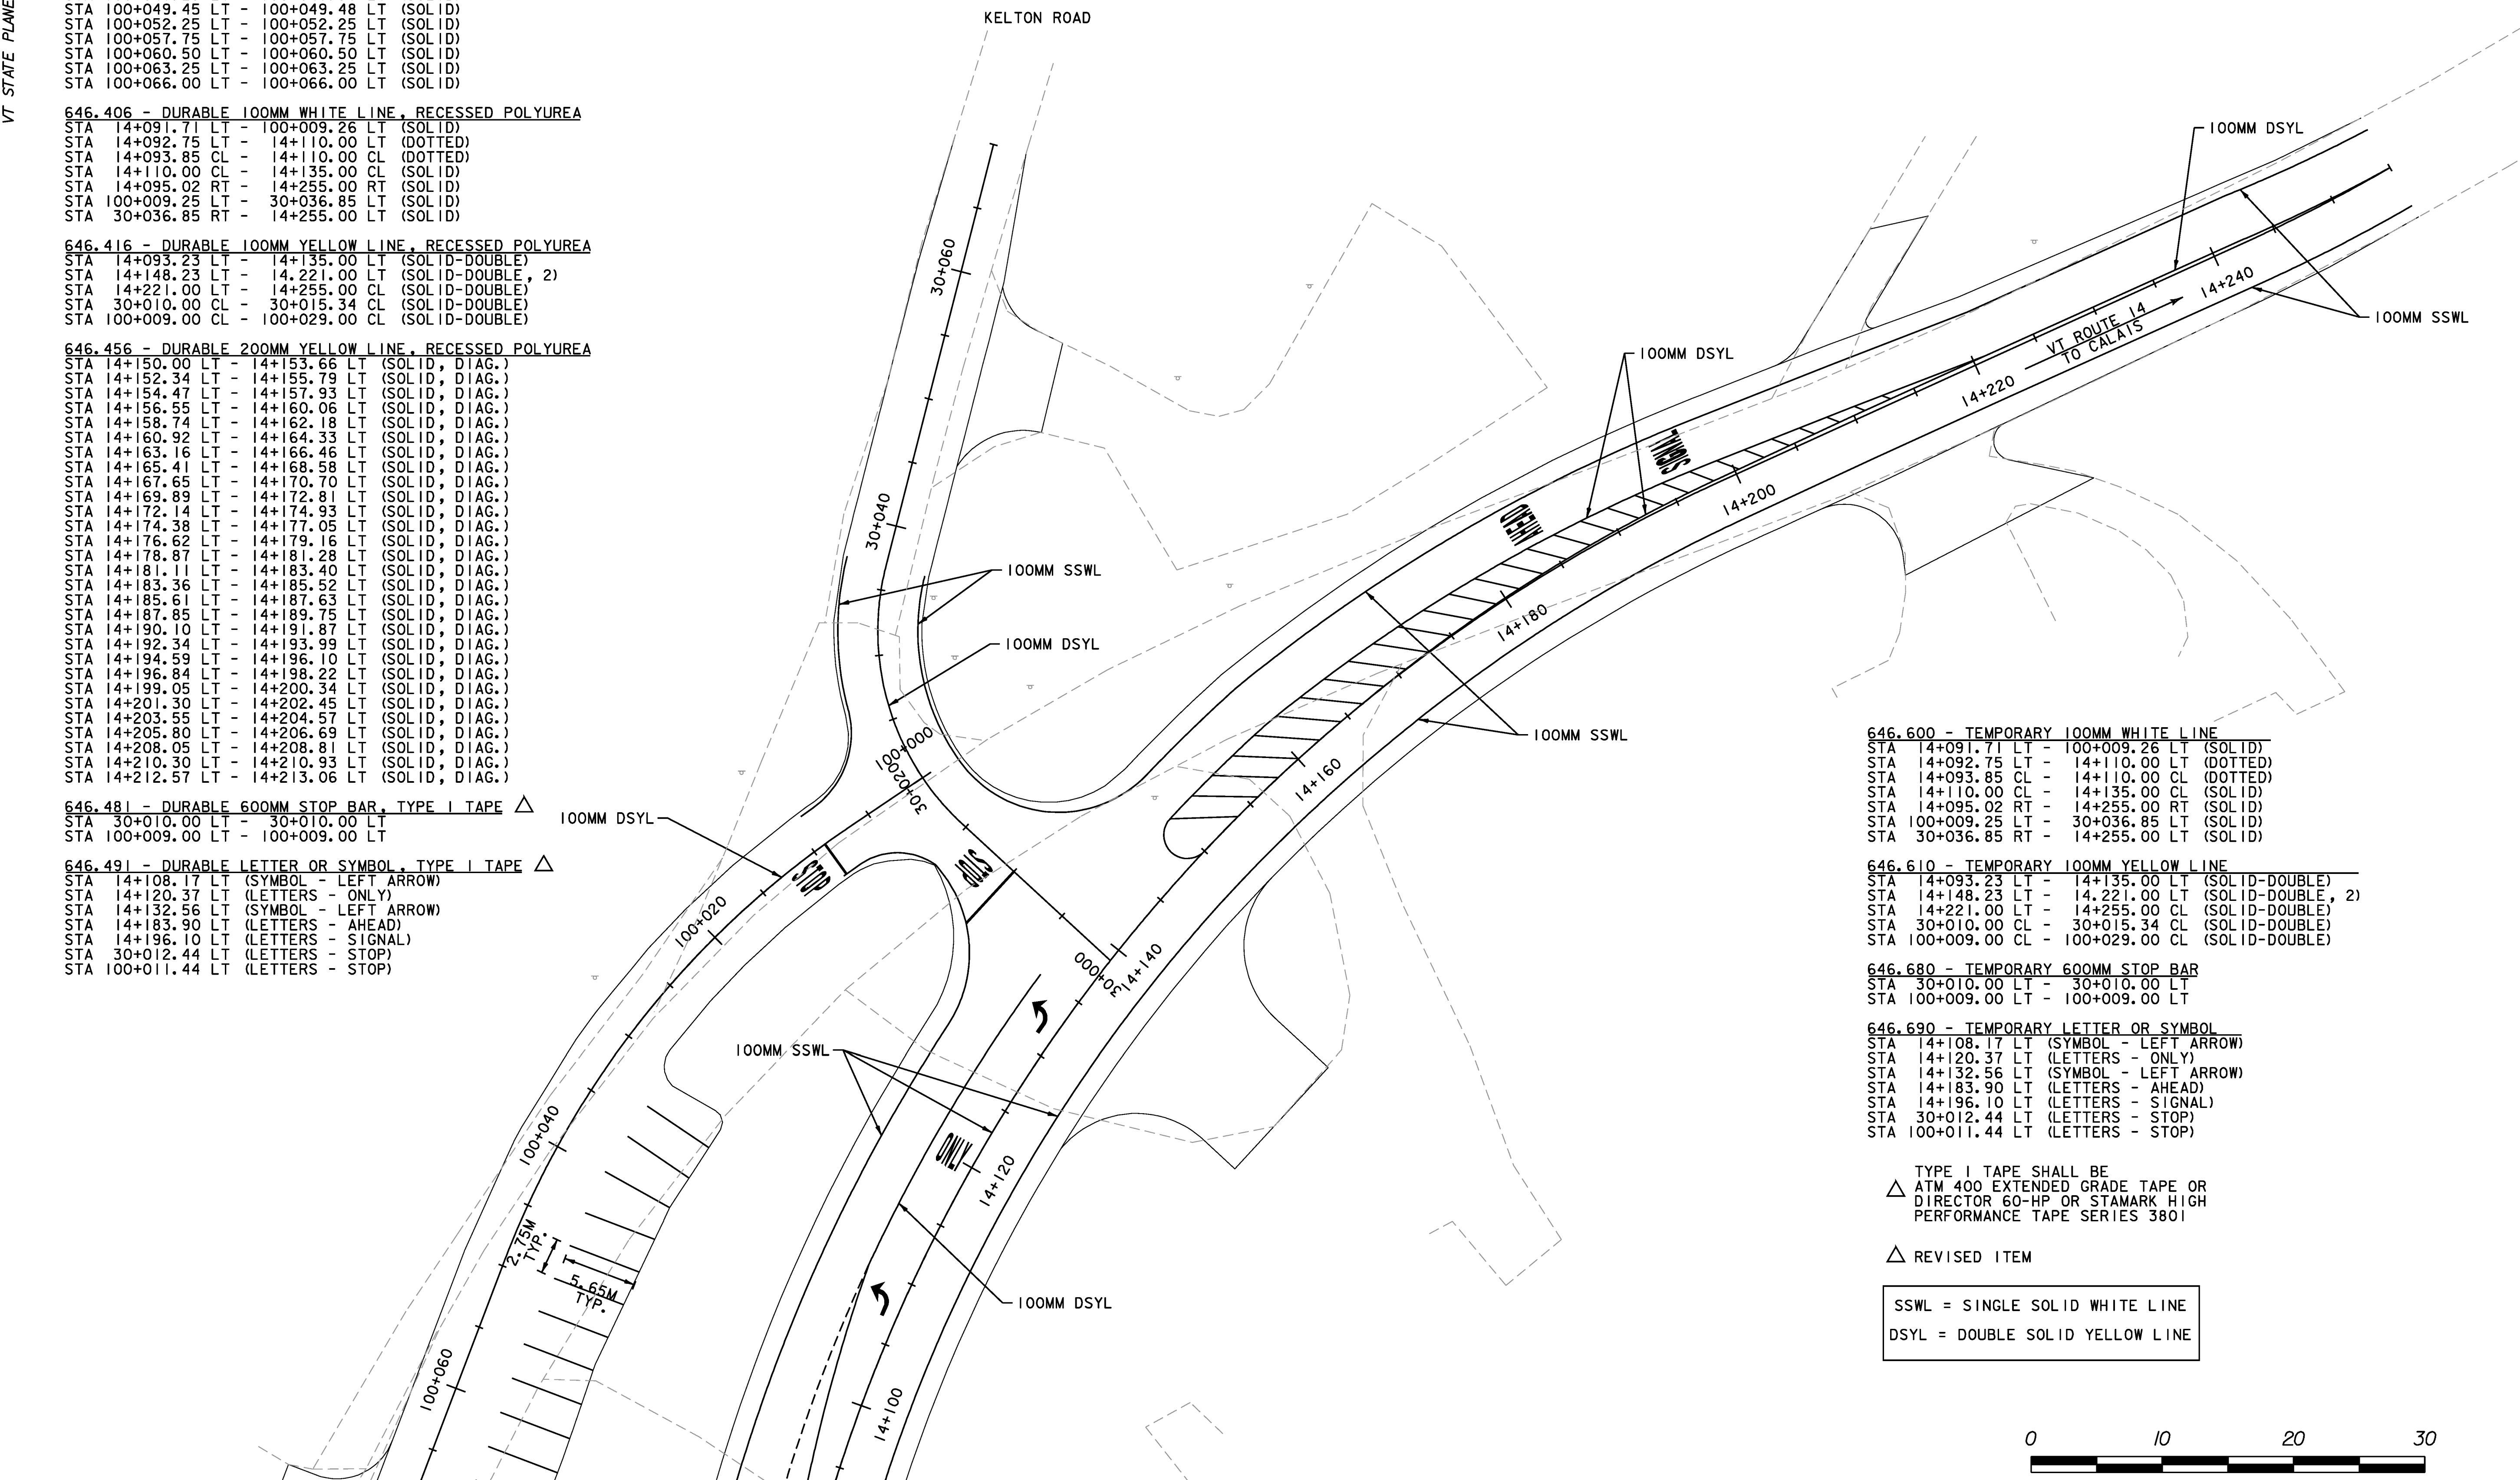


MATCH LINE STA 100+67.63 MATCH LINE STA 14+093.85

PROJECT NAME:	EAST MONTPELIER
PROJECT NUMBER:	STPG 028-3(35)S
FILE NAME:	+98b028+spmbdr.dgn
PROJECT LEADER:	J. SCHULTZ
DESIGNED BY:	J. GRUCHACZ
PAVEMENT MARKING LAYOUT SHEET 4	
PLOT DATE:	11-MAY-2010
DRAWN BY:	D. LYMAN
CHECKED BY:	J. DEVLIN
SHEET	78 OF 142

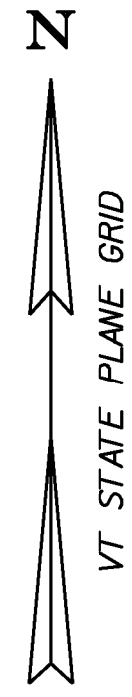

MATCH LINE STA 4+714.33

675.50 - REMOVING SIGNS
AS SHOWN - II

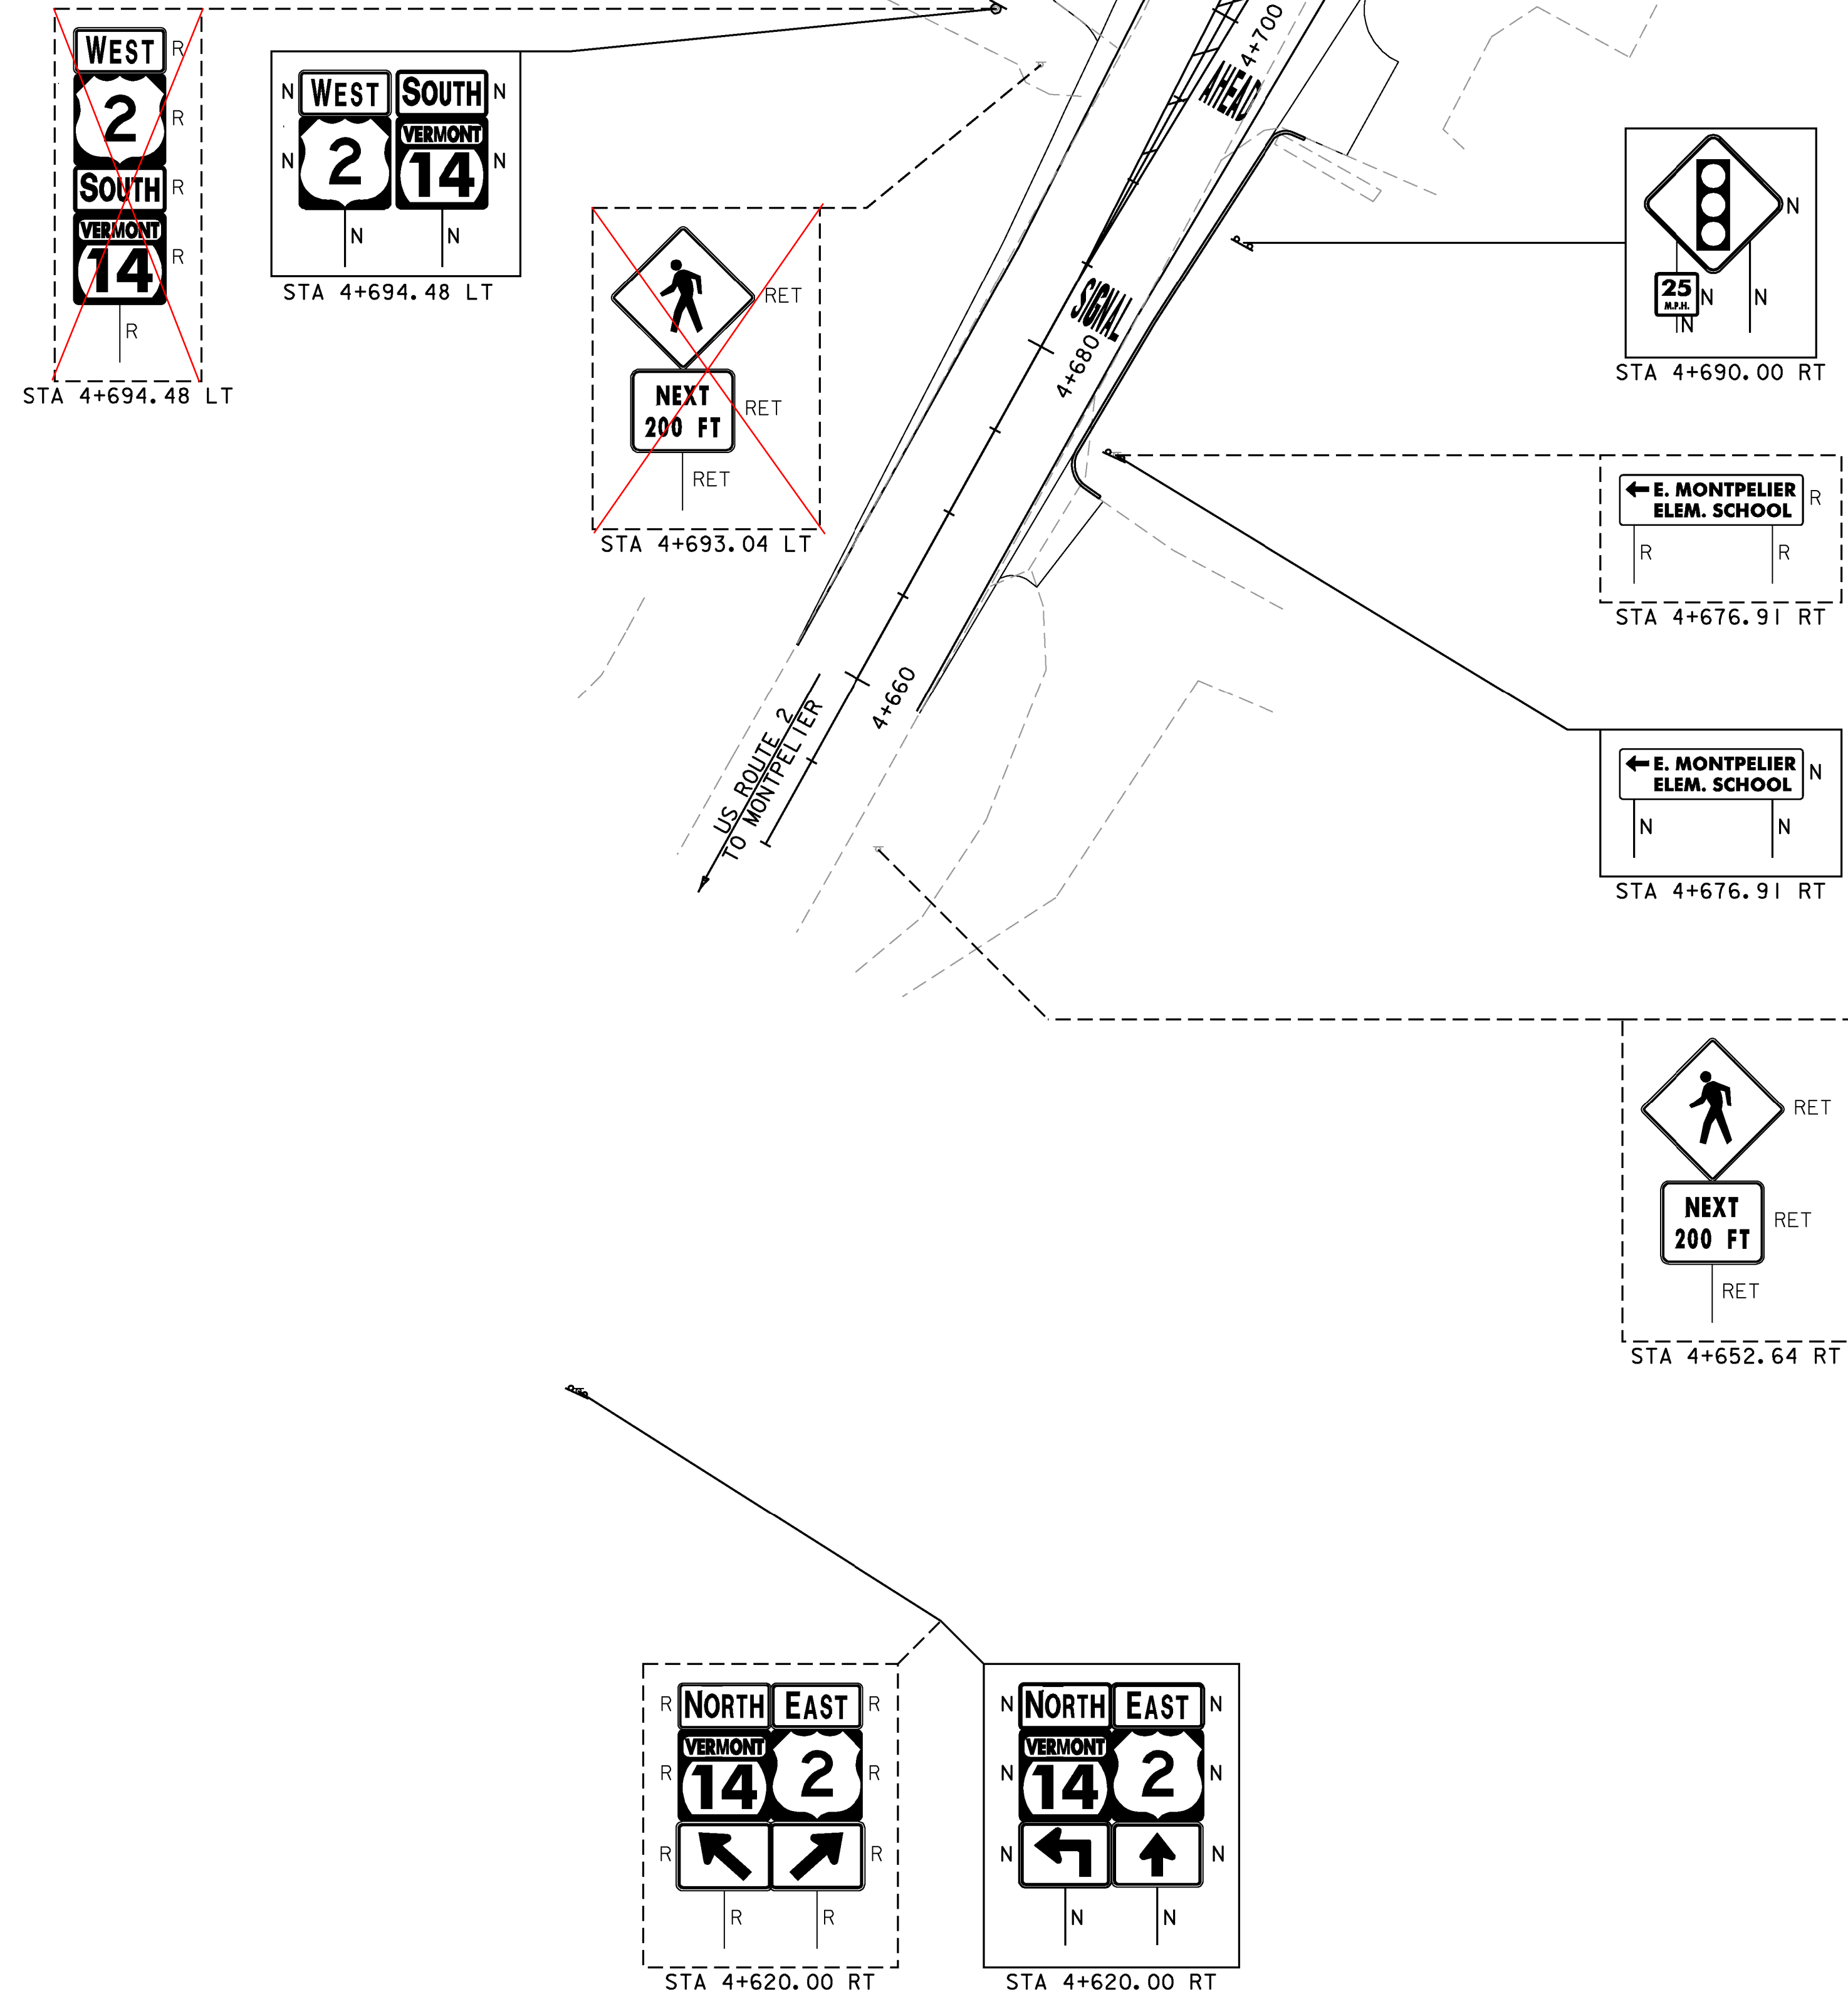


SIGN LEGEND	
R	= REMOVE
S	= SALVAGE
N	= NEW
RET	= RETAIN
EX	= BACK TO BACK
---	= EXISTING
---	= NEW



PROJECT NAME: EAST MONTPELIER
 PROJECT NUMBER: STPG 028-3(35)S
 FILE NAME: +98b028+spmbdr.dgn
 PROJECT LEADER: J. SCHULTZ
 DESIGNED BY: J. GRUCHACZ
 TRAFFIC SIGNS LAYOUT SHEET I

PLOT DATE: 22-MAR-2010
 DRAWN BY: D. LYMAN
 CHECKED BY: J. DEVLIN
 SHEET 79 OF 142

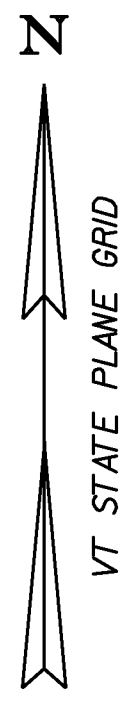

STA 100+081.42 LT.

MATCH LINE STA 100+67.63



MATCH LINE STA 14+093.85

675.50 - REMOVING SIGNS
AS SHOWN - 35




675.60 - ERECTING SALVAGED SIGNS
AS SHOWN - 5

675.61 - SETTING SALVAGED POSTS
AS SHOWN - 4






NO LONGER A VALID FIRE STATION
(MOVED TO US 2 EAST)

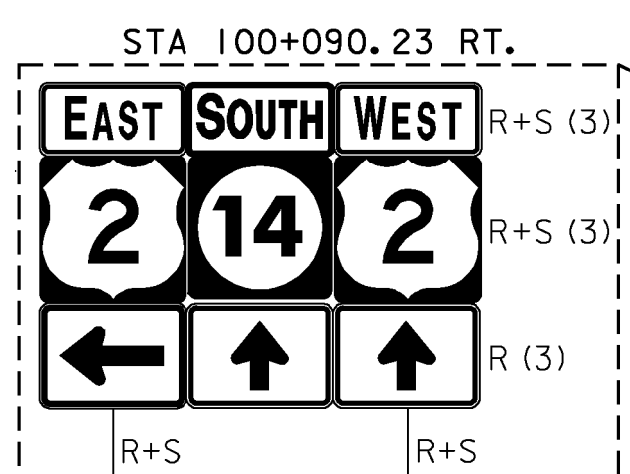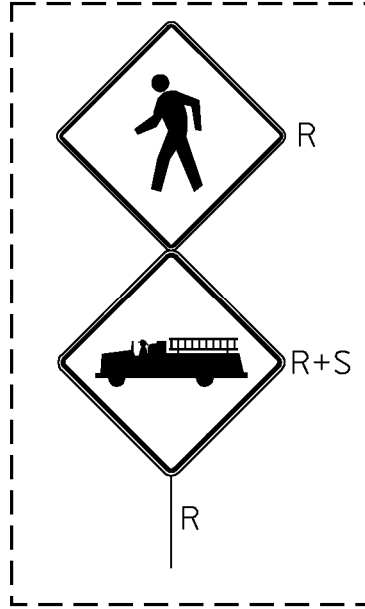



STA 100+102.53 RT STA 100+097.03 RT

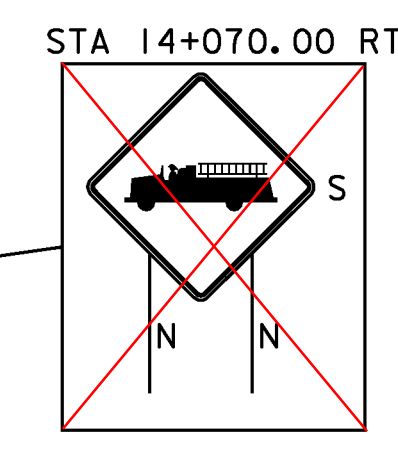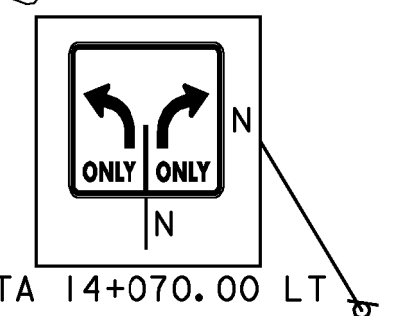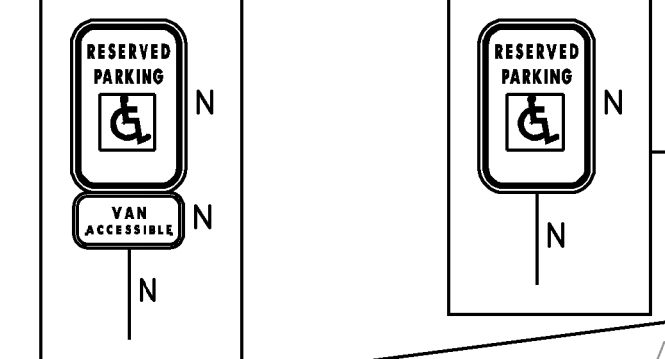



STA 40+043.44 RT STA 40+045.00 RT

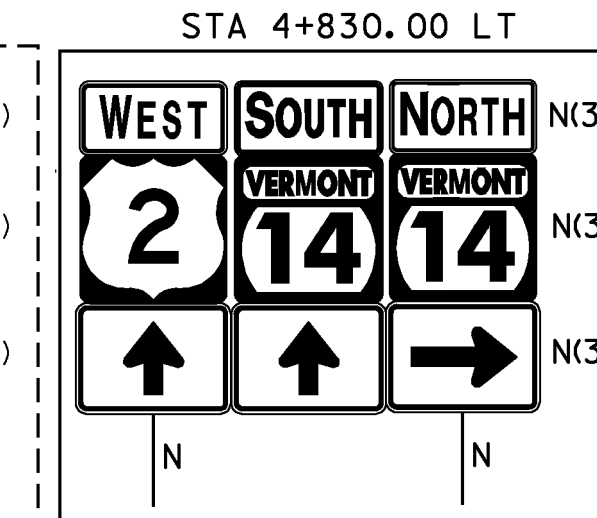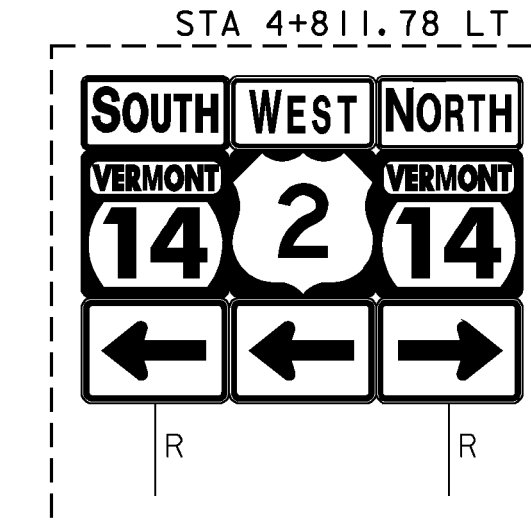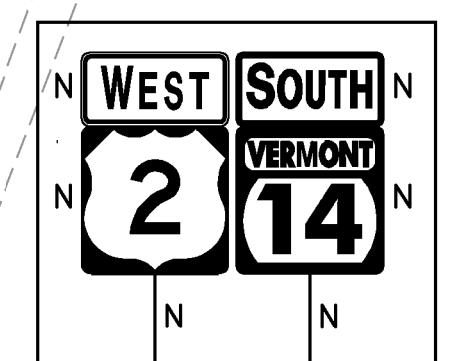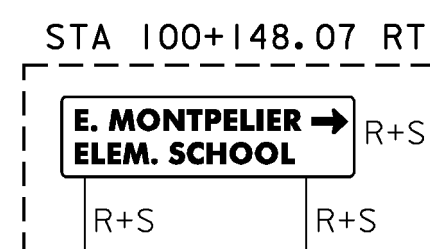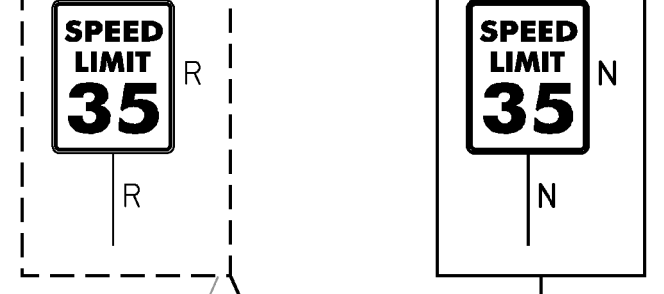










QUAKER HILL ROAD

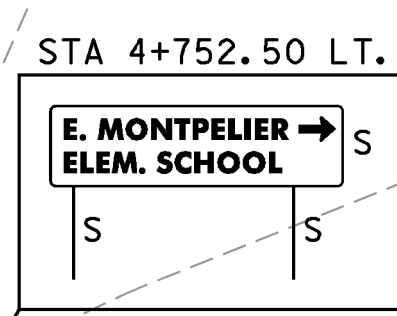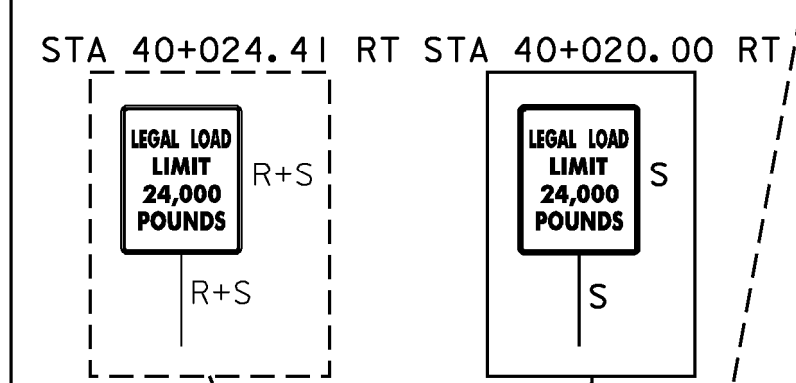


MATCH LINE STA 4+872.87

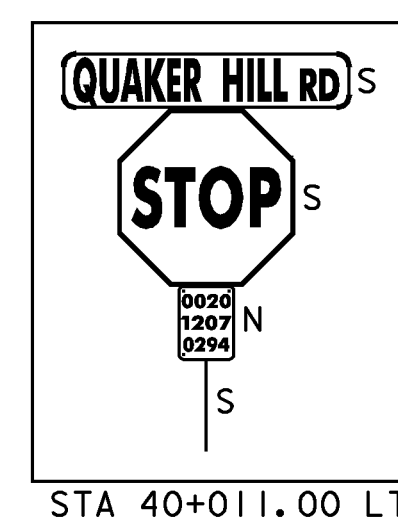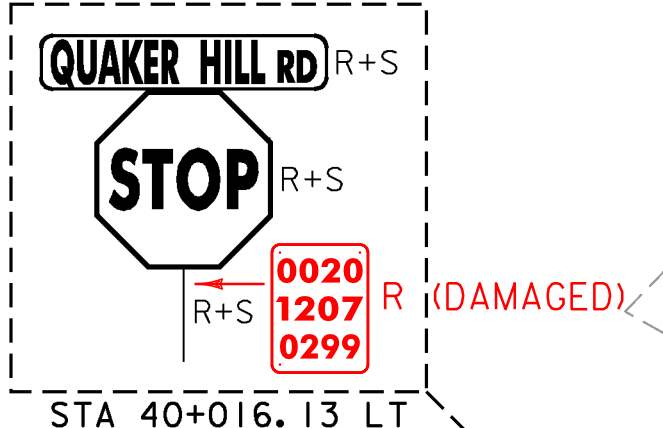

MATCH LINE STA 4+714.33

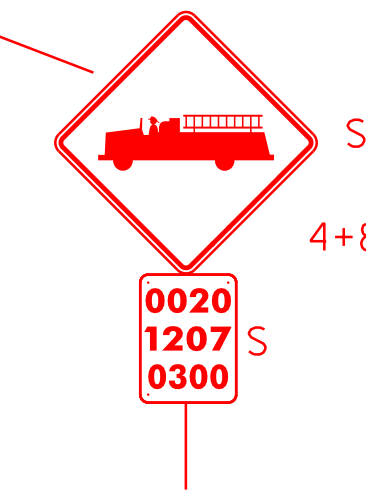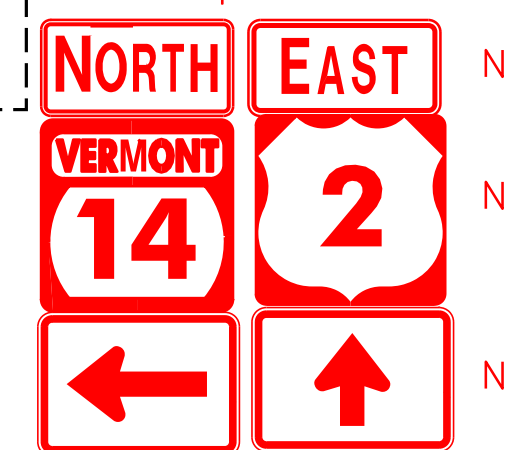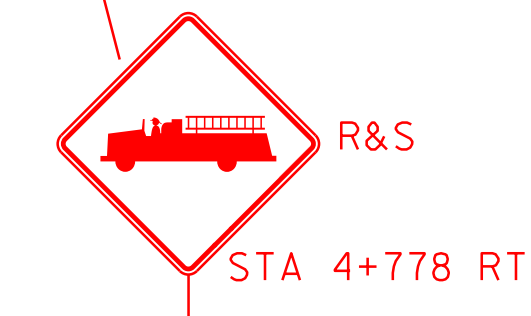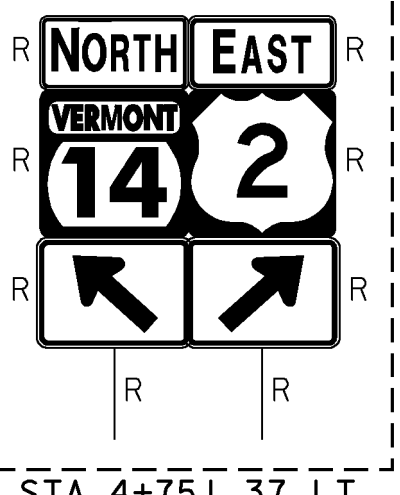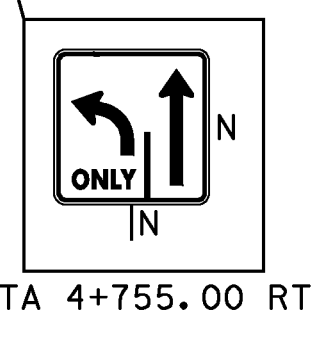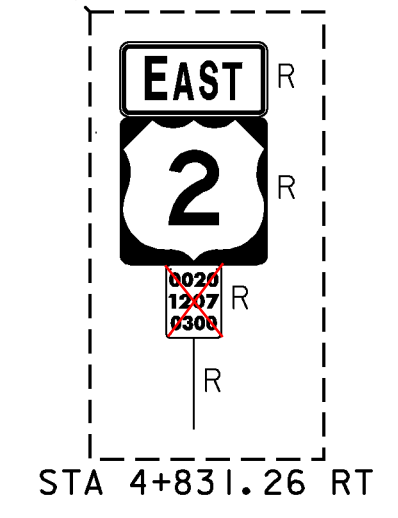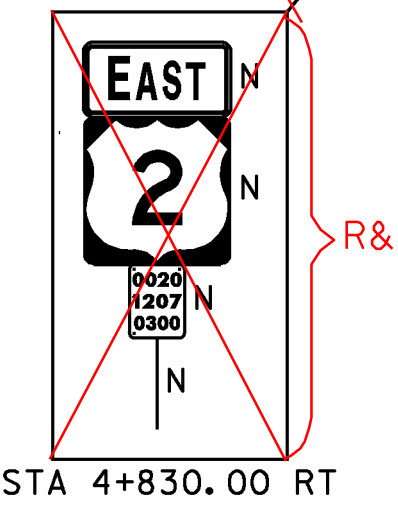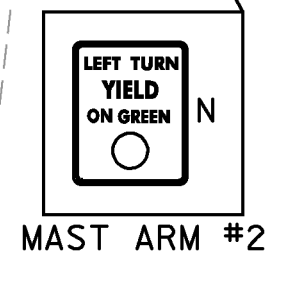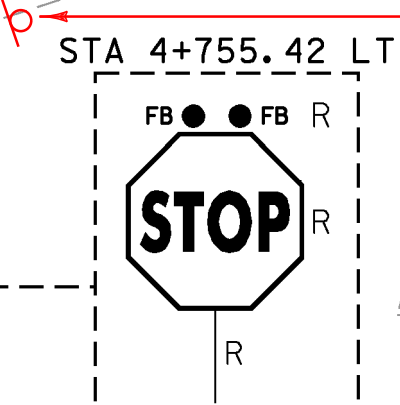

SIGN LEGEND	
R	= REMOVE
S	= SALVAGE
N	= NEW
RET	= RETAIN
B-B	= BACK TO BACK
EXISTING	= EXISTING
NEW	= NEW

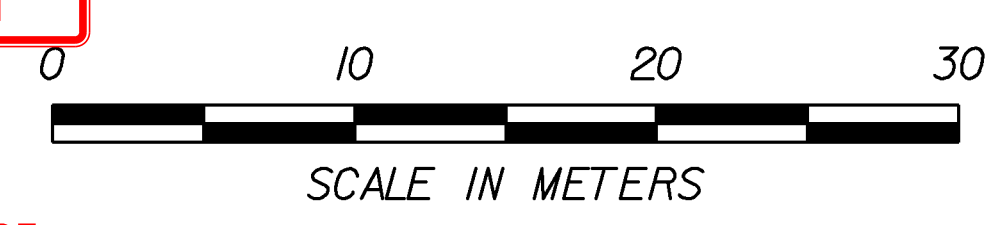


PROJECT NAME: EAST MONTPELIER
PROJECT NUMBER: STPG 028-3(35)S

FILE NAME: +98b028+spmbdr.dgn
PROJECT LEADER: J. SCHULTZ
DESIGNED BY: J. GRUCHACZ
TRAFFIC SIGNS LAYOUT SHEET 2

PLOT DATE: 22-MAR-2010
DRAWN BY: D. LYMAN
CHECKED BY: J. DEVLIN
SHEET 80 OF 142

675.50 - REMOVING SIGNS
AS SHOWN - 10

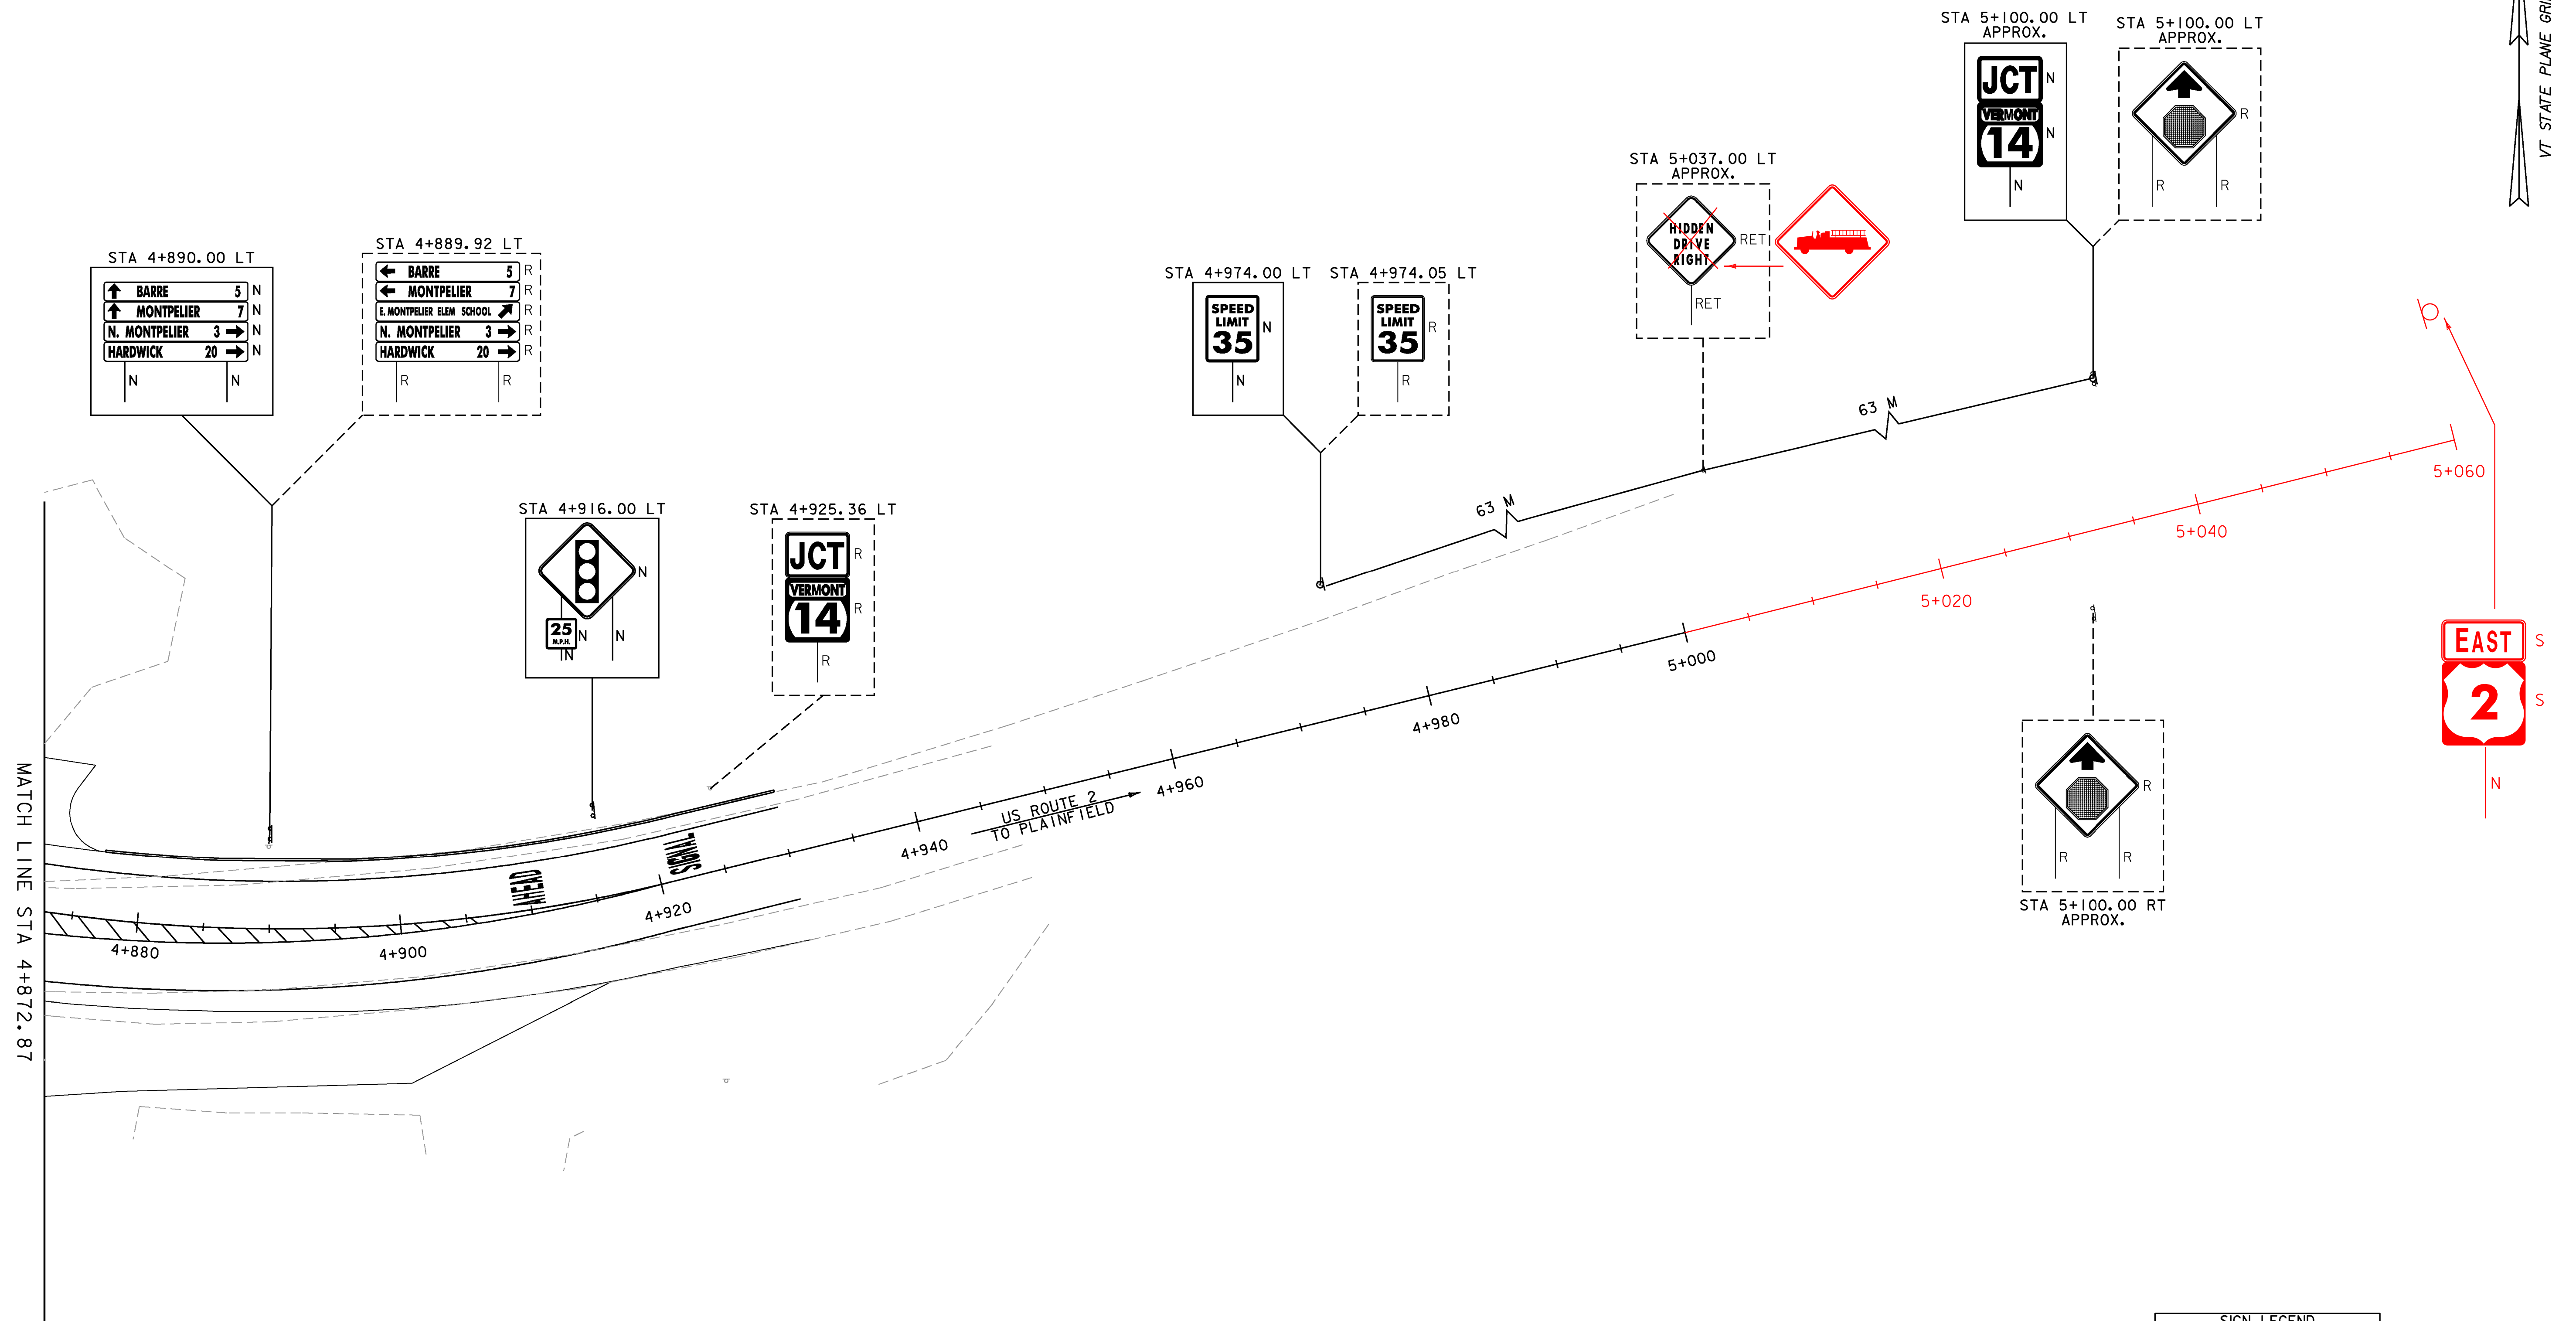


SIGN LEGEND	
R	= REMOVE
S	= SALVAGE
N	= NEW
RET	= RETAIN
B-B	= BACK TO BACK
EXISTING	=
NEW	=



PROJECT NAME: EAST MONTPELIER
PROJECT NUMBER: STPG 028-3(35)S





FILE NAME: +98b028+spmbdr.dgn	PLOT DATE: 22-MAR-2010
PROJECT LEADER: J. SCHULTZ	DRAWN BY: D. LYMAN
DESIGNED BY: J. GRUCHACZ	CHECKED BY: J. DEVLIN
TRAFFIC SIGNS LAYOUT SHEET 3	SHEET 81 OF 142

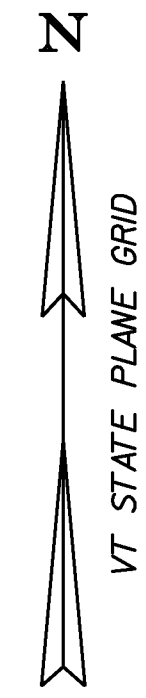

675.50 - REMOVING SIGNS
AS SHOWN - 12

675.60 - ERECTING SALVAGED SIGNS
AS SHOWN - 16

675.61 - SETTING SALVAGED POSTS
AS SHOWN - 10

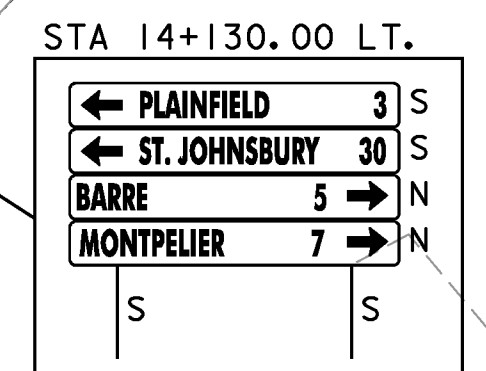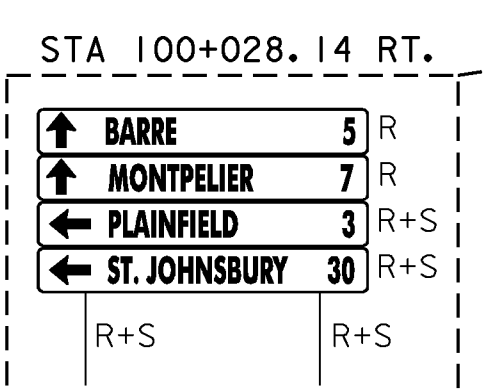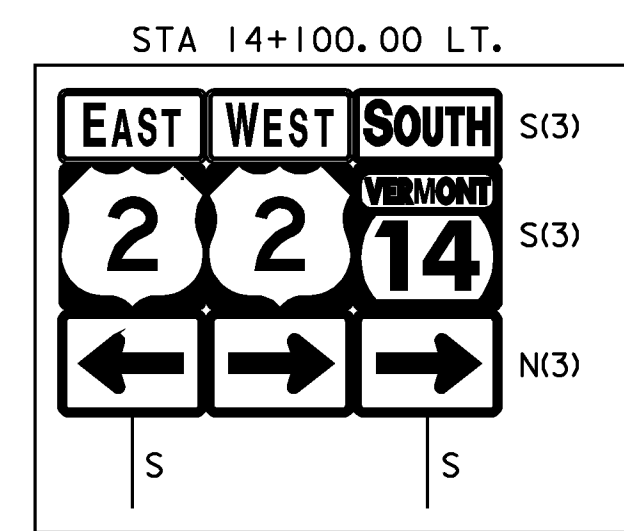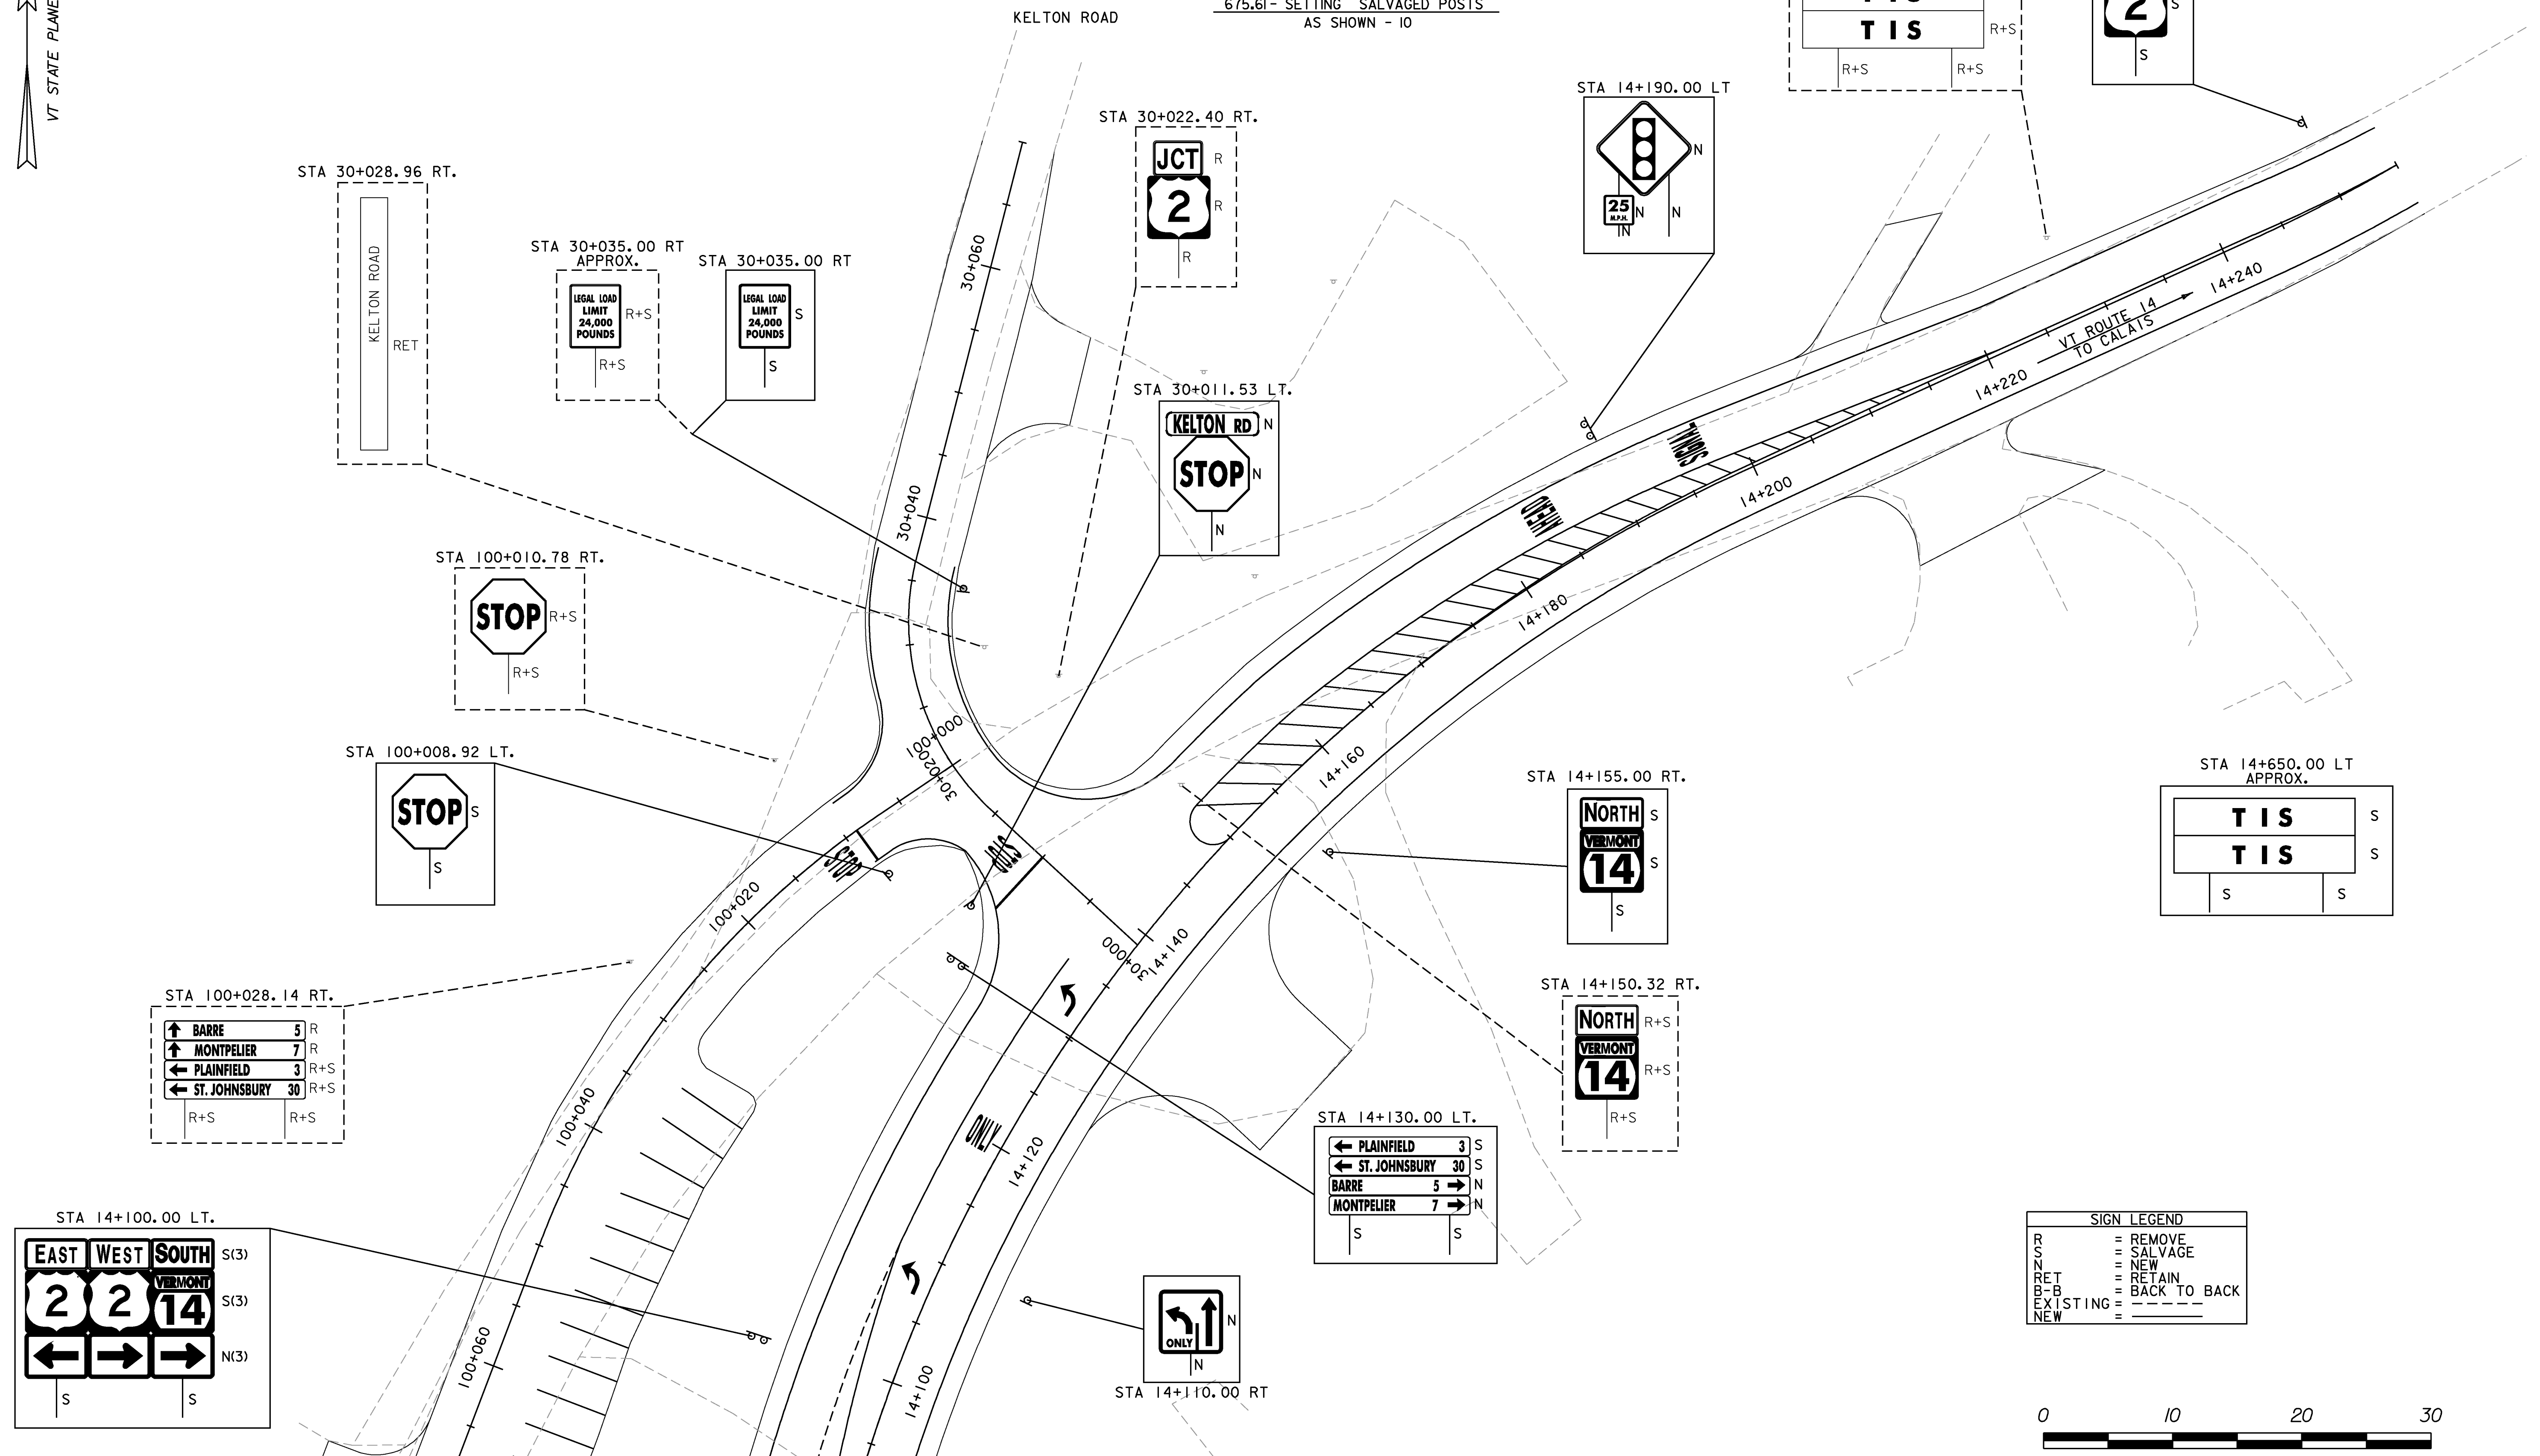


SIGN LEGEND	
R	= REMOVE
S	= SALVAGE
N	= NEW
RET	= RETAIN
B-B	= BACK TO BACK
EXISTING	= EXISTING
NEW	= NEW




MATCH LINE STA 100+67.63 MATCH LINE STA 14+093.85


PROJECT NAME: EAST MONTPELIER
 PROJECT NUMBER: STPG 028-3(35)S
 FILE NAME: +98b028+spmbdr.dgn PLOT DATE: 22-MAR-2010
 PROJECT LEADER: J. SCHULTZ DRAWN BY: D. LYMAN
 DESIGNED BY: J. GRUCHACZ CHECKED BY: J. DEVLIN
 TRAFFIC SIGNS LAYOUT SHEET 4 SHEET 82 OF 142

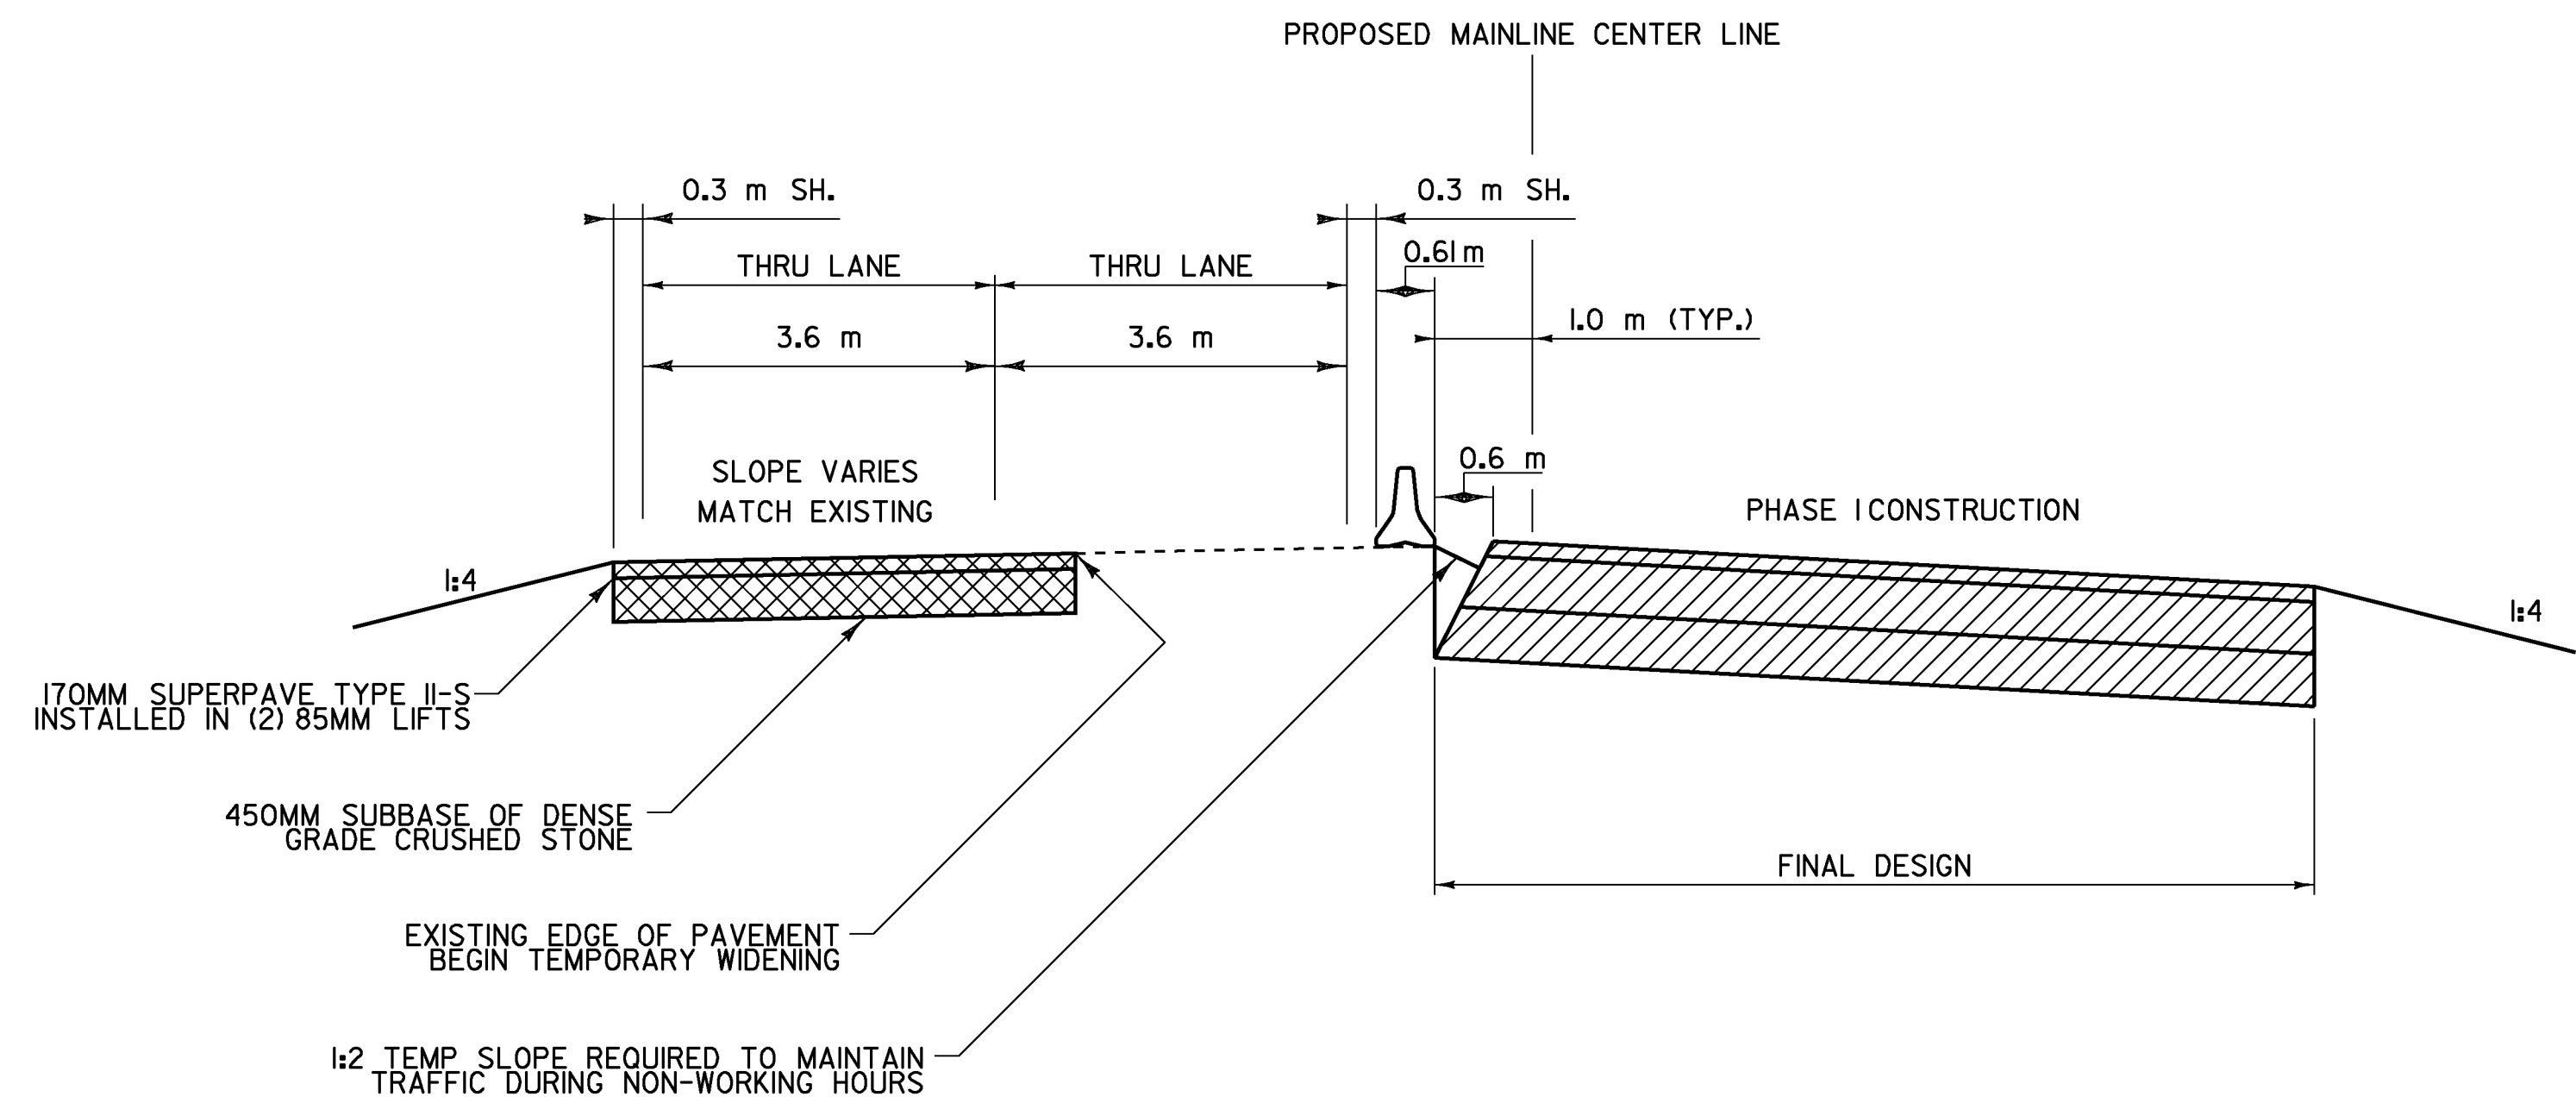

US 2 - PHASE I & II
(NOT TO SCALE)

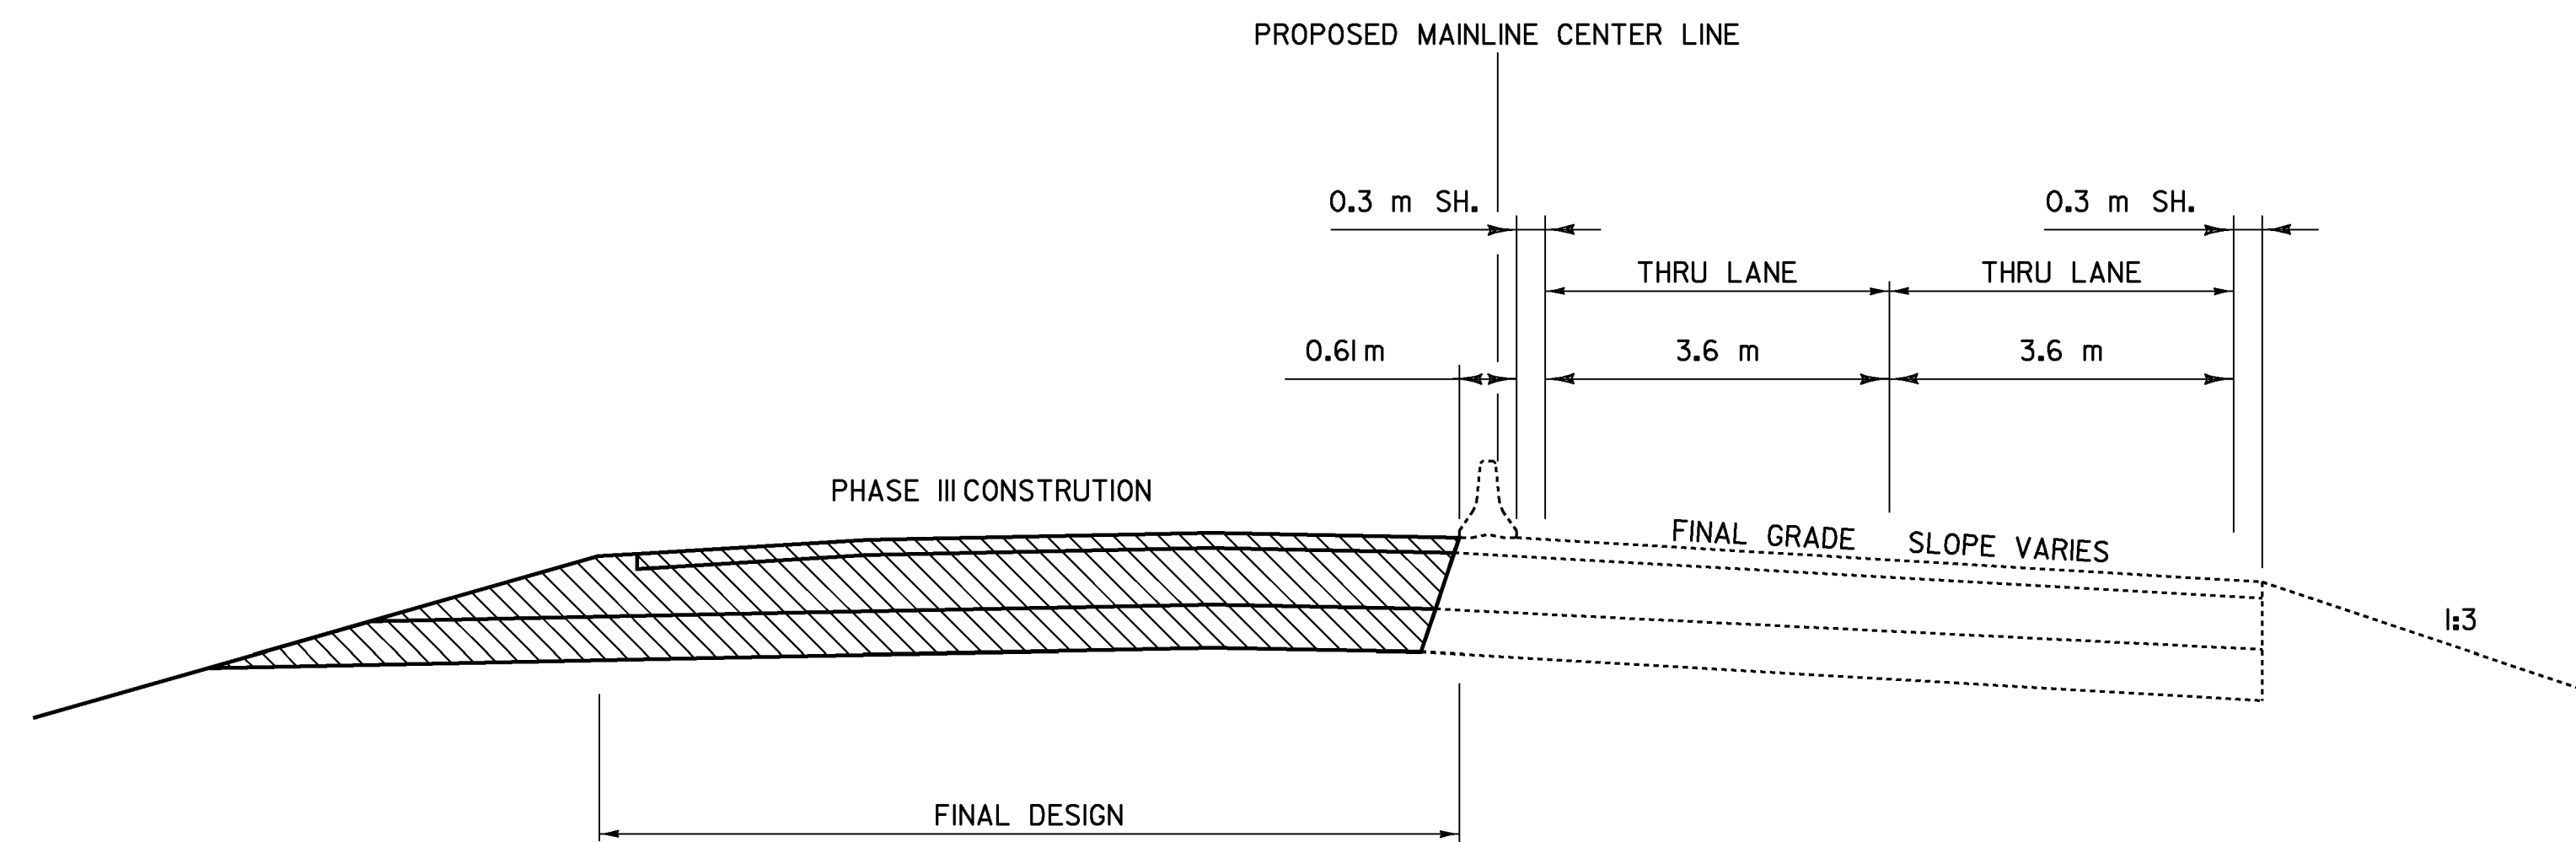

US 2 - PHASE III
(NOT TO SCALE)

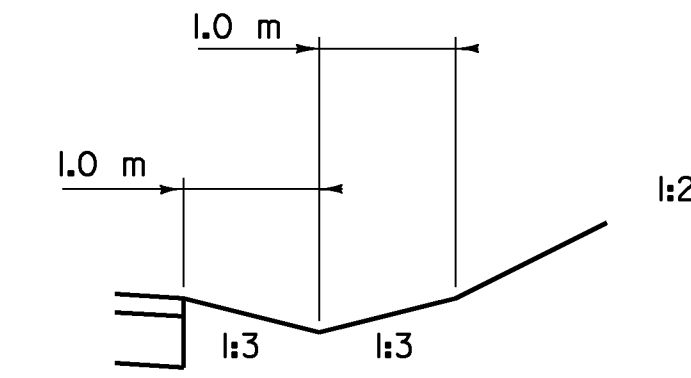

TEMPORARY DITCH DETAIL

TEMPORARY WIDENING GENERAL NOTES


1. DURING TEMPORARY WIDENING FOR PHASE I & II, FULL DEPTH RECONSTRUCTION SHALL OCCUR WITHIN THE MAINLINE TYPICAL SECTION LIMITS AND/OR THE TEMPORARY DETOUR LIMITS
2. THE PAVEMENT WEARING COURSE SHALL BE APPLIED AFTER FULL DEPTH RECONSTRUCTION HAS BEEN COMPLETED
3. REFERENCE TRAFFIC CONTROL PLAN SHEETS FOR ALL ALIGNMENT SHIFTS
4. THE TEMPORARY WIDENING FOR PHASE I & II TRAFFIC SHALL BE REMOVED AFTER THE COMPLETION OF ALL PHASE III CONSTRUCTION
5. PAYMENT FOR THE TEMPORARY WIDENING WILL BE MADE UNDER ITEM NO. 900.645 (TEMPORARY ROADWAY)

LEGEND	
	= PHASE I CONSTRUCTION
	= TEMPORARY WIDENING FOR PHASE I & II TRAFFIC
	= PHASE III CONSTRUCTION

PROJECT NAME: EAST MONTEPELIER
PROJECT NUMBER: STPG 028 - 3(35)S


FILE NAME: +98b028trafcontrl.dgn
PROJECT LEADER: J. SCHULTZ
DESIGNED BY: J. GRUCHACZ
TRAFFIC CONTROL TYPICAL SHEET

PLOT DATE: 22-MAR-2010
DRAWN BY: D. LYMAN
CHECKED BY: J. DEVLIN
SHEET 86 OF 142

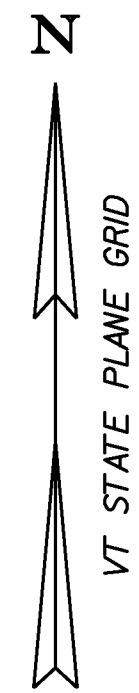

NOTES:

1. TRAFFIC CONTROL PHASE I SHALL CONSIST OF TEMPORARY ROAD CLOSURE WITH DIVERSION ON US ROUTE 2 AND VT ROUTE 14. REFER TO MUTCD FIGURE 6H-7, ROAD CLOSURE WITH DIVERSION (TYPICAL APPLICATION 7).
2. TEMPORARY LANE OR SHOULDER CLOSURES SHALL BE ALLOWED DURING WORKING HOURS. US ROUTE 2 AND VT ROUTE 14 SHALL BE RESTORED TO FULL CAPACITY AT THE CLOSE OF DAILY CONSTRUCTION ACTIVITIES.
3. ALL TEMPORARY PAVEMENT MARKINGS SHALL BE INSTALLED AS DENOTED ON TRAFFIC CONTROL LAYOUT SHEETS, AND SHALL BE PAID UNDER CONTRACT ITEM 900.645 (TEMPORARY ROADWAY).
4. ADDITIONAL TRAFFIC CONTROL WARNING SIGNS MAY BE REQUIRED AND SHALL BE INSTALLED AS REQUESTED BY THE RESIDENT ENGINEER PER THE MUTCD. PAYMENT FOR THESE SIGNS, THE REFLECTORIZED PLASTIC DRUMS, ETC., SHALL BE PAID UNDER CONTRACT ITEM 641.10.
5. ACCESS TO RESIDENTIAL DRIVES, COMMERCIAL DRIVES, AND TOWN HIGHWAYS SHALL BE MAINTAINED THROUGHOUT THE PROJECT'S DURATION.
6. NON CRASHWORTHY FEATURES RESULTING FROM CONSTRUCTION ACTIVITIES THAT ARE LOCATED WITHIN THE CLEAR ZONE SHALL BE PROPERLY PROTECTED. ALL TEMPORARY DEVICES SHALL BE NCHRP COMPLIANT AND SHALL BE FURNISHED IN ACCORDANCE WITH SECTION 621. PAYMENT FOR TEMPORARY TRAFFIC BARRIER WILL BE MADE UNDER ITEM NO. 621.90 AND ENERGY ABSORPTION ATTENUATORS WILL BE MADE UNDER ITEM NO. 621.56.
7. IF TEMPORARY BARRIER IS USED, BARRIER ENDS FACING ONCOMING TRAFFIC SHALL BE TAPERED BEYOND THE CLEAR ZONE, OR PROTECTED WITH AN APPROVED END TREATMENT. IF TEMPORARY BARRIER IS TO BE RELOCATED, PAYMENT WILL BE MADE UNDER ITEM NO. 621.95 REMOVE AND RESET TEMPORARY TRAFFIC BARRIER. IF AN ENERGY ABSORPTION ATTENUATOR IS TO BE RELOCATED, IT WILL BE CONSIDERED INCIDENTAL TO ITEM NO. 621.56.
8. AS PER THE DISPLAYED TRAFFIC CONTROL PLAN, THE REMOVAL AND RESETTING OF TEMPORARY TRAFFIC BARRIER IS ONLY ANTICIPATED BETWEEN TRAFFIC CONTROL PHASES.


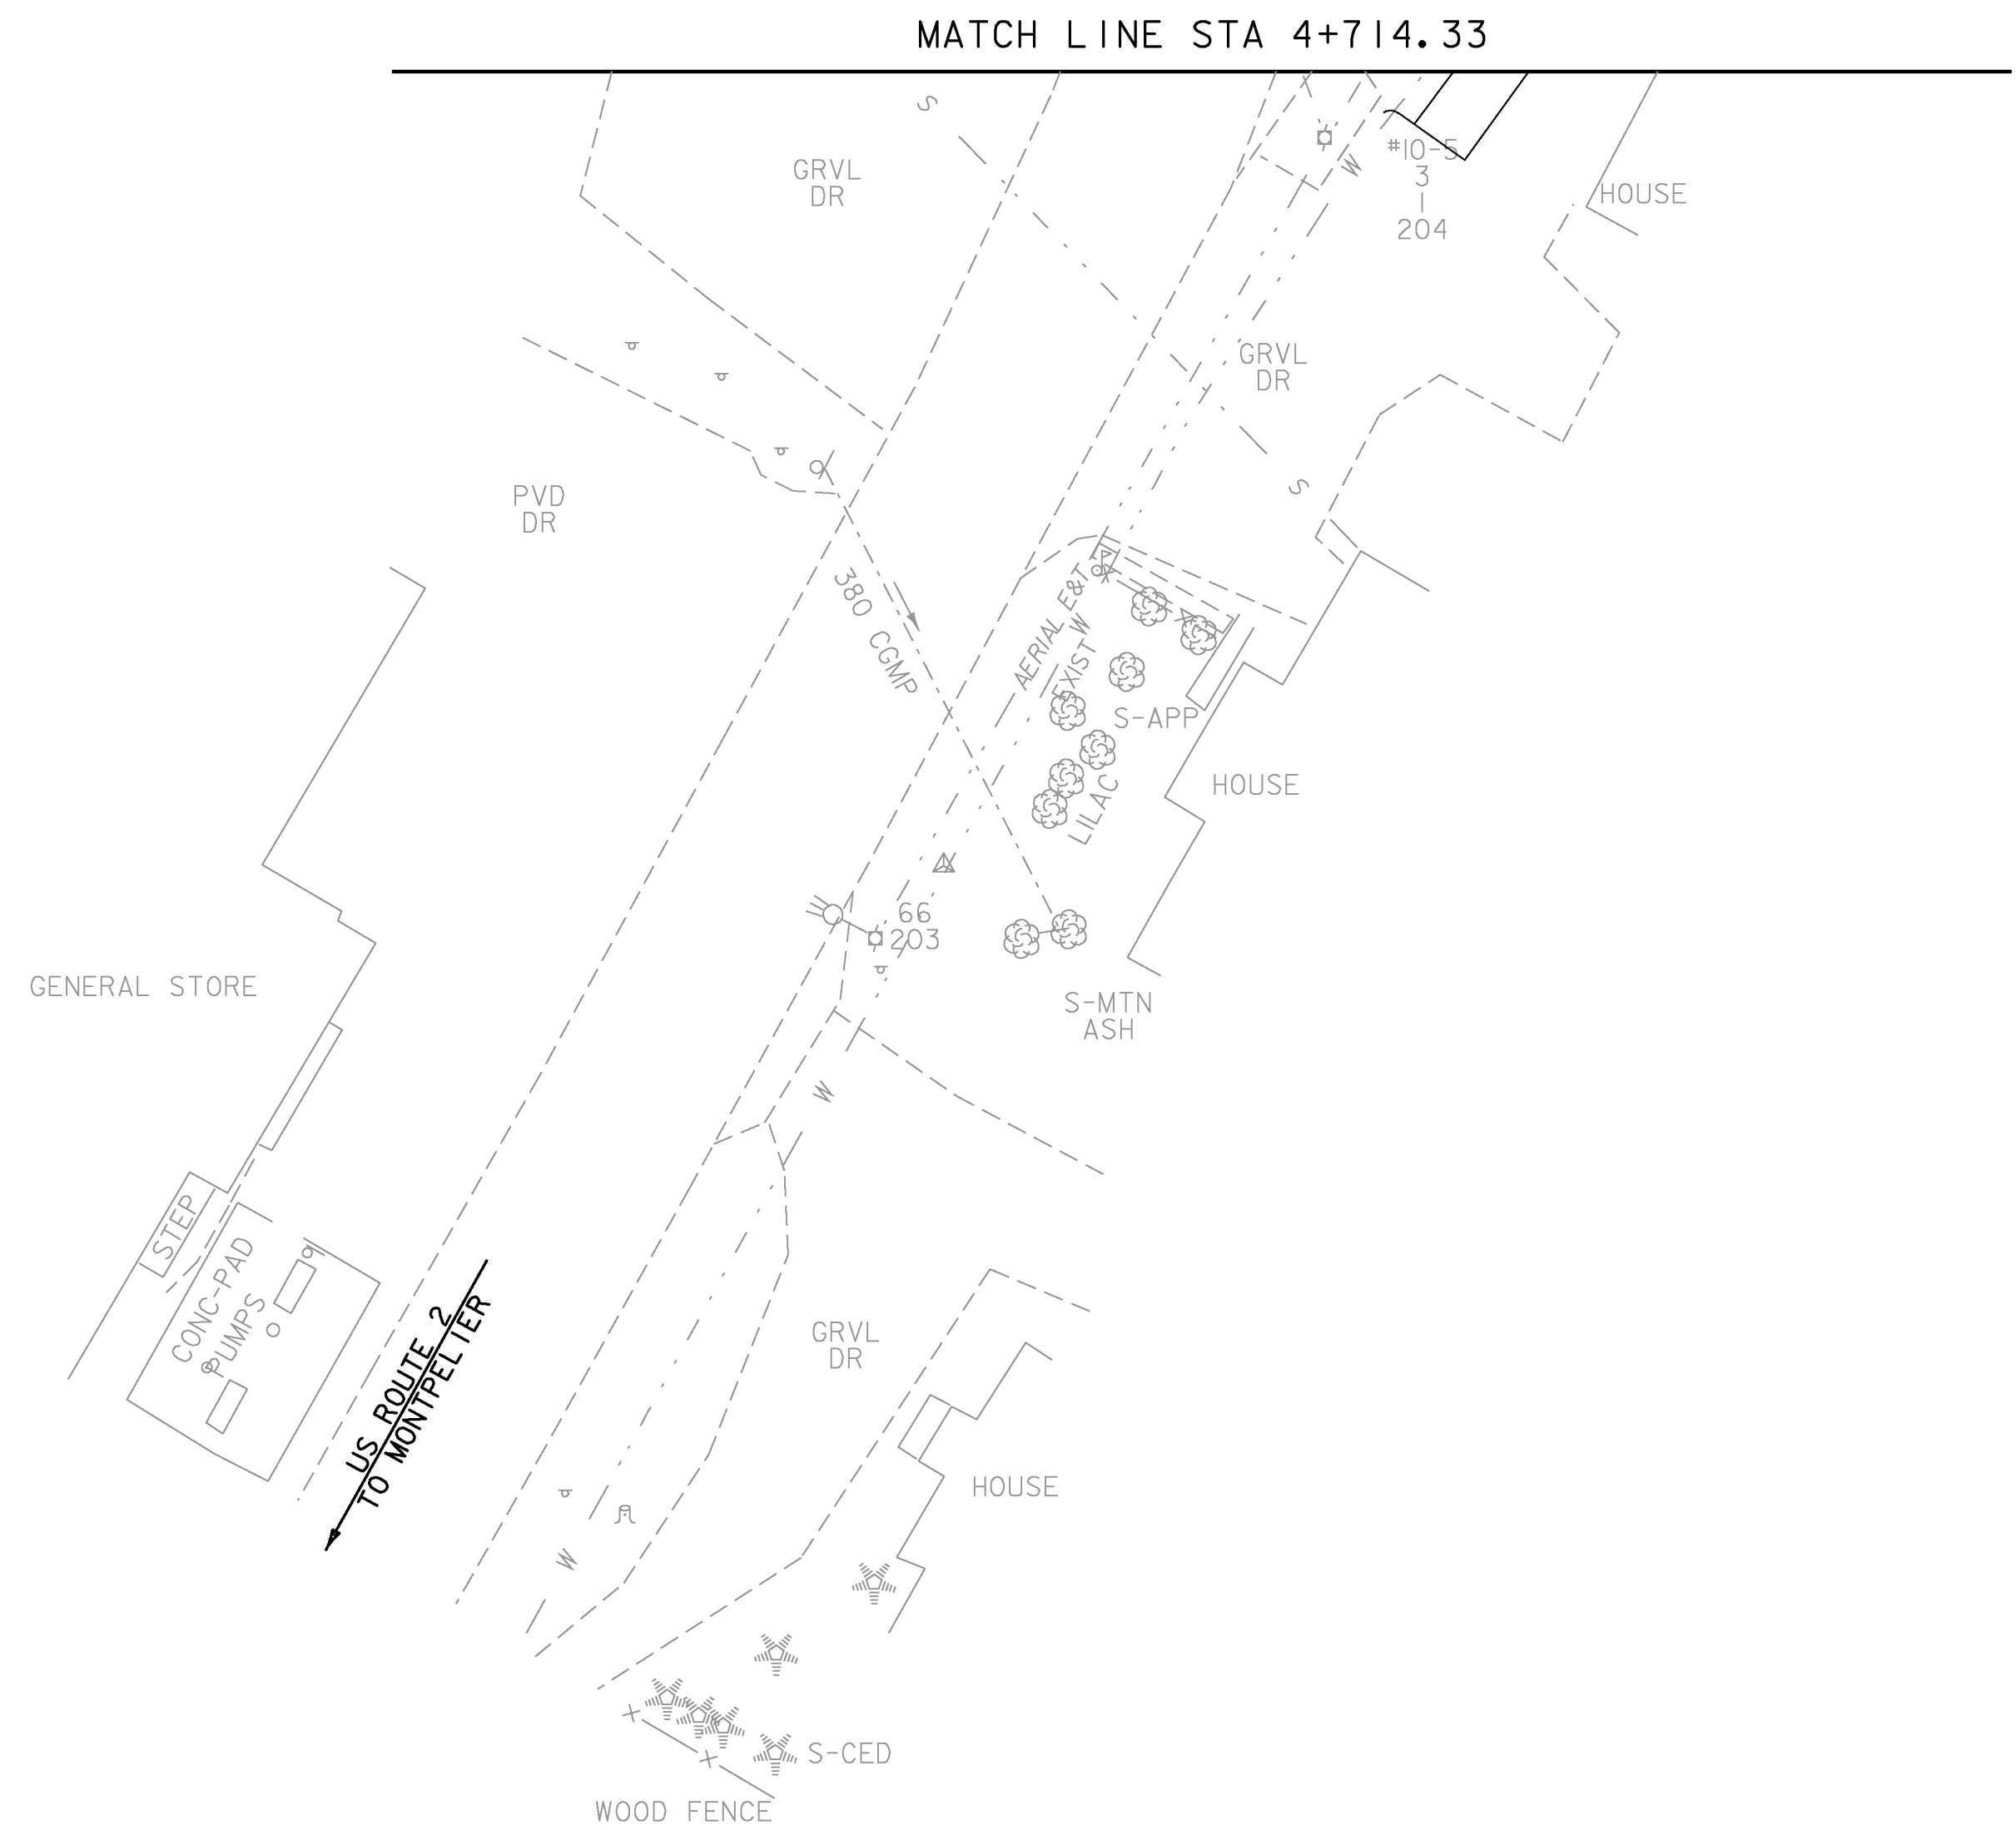


PROJECT NAME:	EAST MONTPELIER	FILE NAME:	+98b028+cp1bdr.dgn	PLOT DATE:	22-MAR-2010
PROJECT NUMBER:	STPG 028 - 3(35)S	PROJECT LEADER:	J. SCHULTZ	DRAWN BY:	I.DEGUTIS
		DESIGNED BY:	J. GRUCHACZ	CHECKED BY:	J. DEVLIN
		TC PHASE I LAYOUT SHEET 1		SHEET	87 OF 142

NOTES:

1. TRAFFIC CONTROL PHASE I SHALL CONSIST OF TEMPORARY ROAD CLOSURE WITH DIVERSION ON US ROUTE 2 AND VT ROUTE 14. REFER TO MUTCD FIGURE 6H-7, ROAD CLOSURE WITH DIVERSION (TYPICAL APPLICATION 7).
2. TEMPORARY LANE OR SHOULDER CLOSURES SHALL BE ALLOWED DURING WORKING HOURS. US ROUTE 2 AND VT ROUTE 14 SHALL BE RESTORED TO FULL CAPACITY AT THE CLOSE OF DAILY CONSTRUCTION ACTIVITIES.
3. ALL TEMPORARY PAVEMENT MARKINGS SHALL BE INSTALLED AS DENOTED ON TRAFFIC CONTROL LAYOUT SHEETS, AND SHALL BE PAID UNDER CONTRACT ITEM 900.645 (TEMPORARY ROADWAY).
4. ADDITIONAL TRAFFIC CONTROL WARNING SIGNS MAY BE REQUIRED AND SHALL BE INSTALLED AS REQUESTED BY THE RESIDENT ENGINEER PER THE MUTCD. PAYMENT FOR THESE SIGNS, THE REFLECTORIZED PLASTIC DRUMS, ETC., SHALL BE PAID UNDER CONTRACT ITEM 641.10.
5. ACCESS TO RESIDENTIAL DRIVES, COMMERCIAL DRIVES, AND TOWN HIGHWAYS SHALL BE MAINTAINED THROUGHOUT THE PROJECT'S DURATION.
6. NON CRASHWORTHY FEATURES RESULTING FROM CONSTRUCTION ACTIVITIES THAT ARE LOCATED WITHIN THE CLEAR ZONE SHALL BE PROPERLY PROTECTED. ALL TEMPORARY DEVICES SHALL BE NCHRP COMPLIANT AND SHALL BE FURNISHED IN ACCORDANCE WITH SECTION 621. PAYMENT FOR TEMPORARY TRAFFIC BARRIER WILL BE MADE UNDER ITEM NO. 621.90 AND ENERGY ABSORPTION ATTENUATORS WILL BE MADE UNDER ITEM NO. 621.56.

7. IF TEMPORARY BARRIER IS USED, BARRIER ENDS FACING ONCOMING TRAFFIC SHALL BE TAPERED BEYOND THE CLEAR ZONE, OR PROTECTED WITH AN APPROVED END TREATMENT. IF TEMPORARY BARRIER IS TO BE RELOCATED, PAYMENT WILL BE MADE UNDER ITEM NO. 621.95 REMOVE AND RESET TEMPORARY TRAFFIC BARRIER. IF AN ENERGY ABSORPTION ATTENUATOR IS TO BE RELOCATED, IT WILL BE CONSIDERED INCIDENTAL TO ITEM NO. 621.56.
8. AS PER THE DISPLAYED TRAFFIC CONTROL PLAN, THE REMOVAL AND RESETTING OF TEMPORARY TRAFFIC BARRIER IS ONLY ANTICIPATED BETWEEN TRAFFIC CONTROL PHASES.

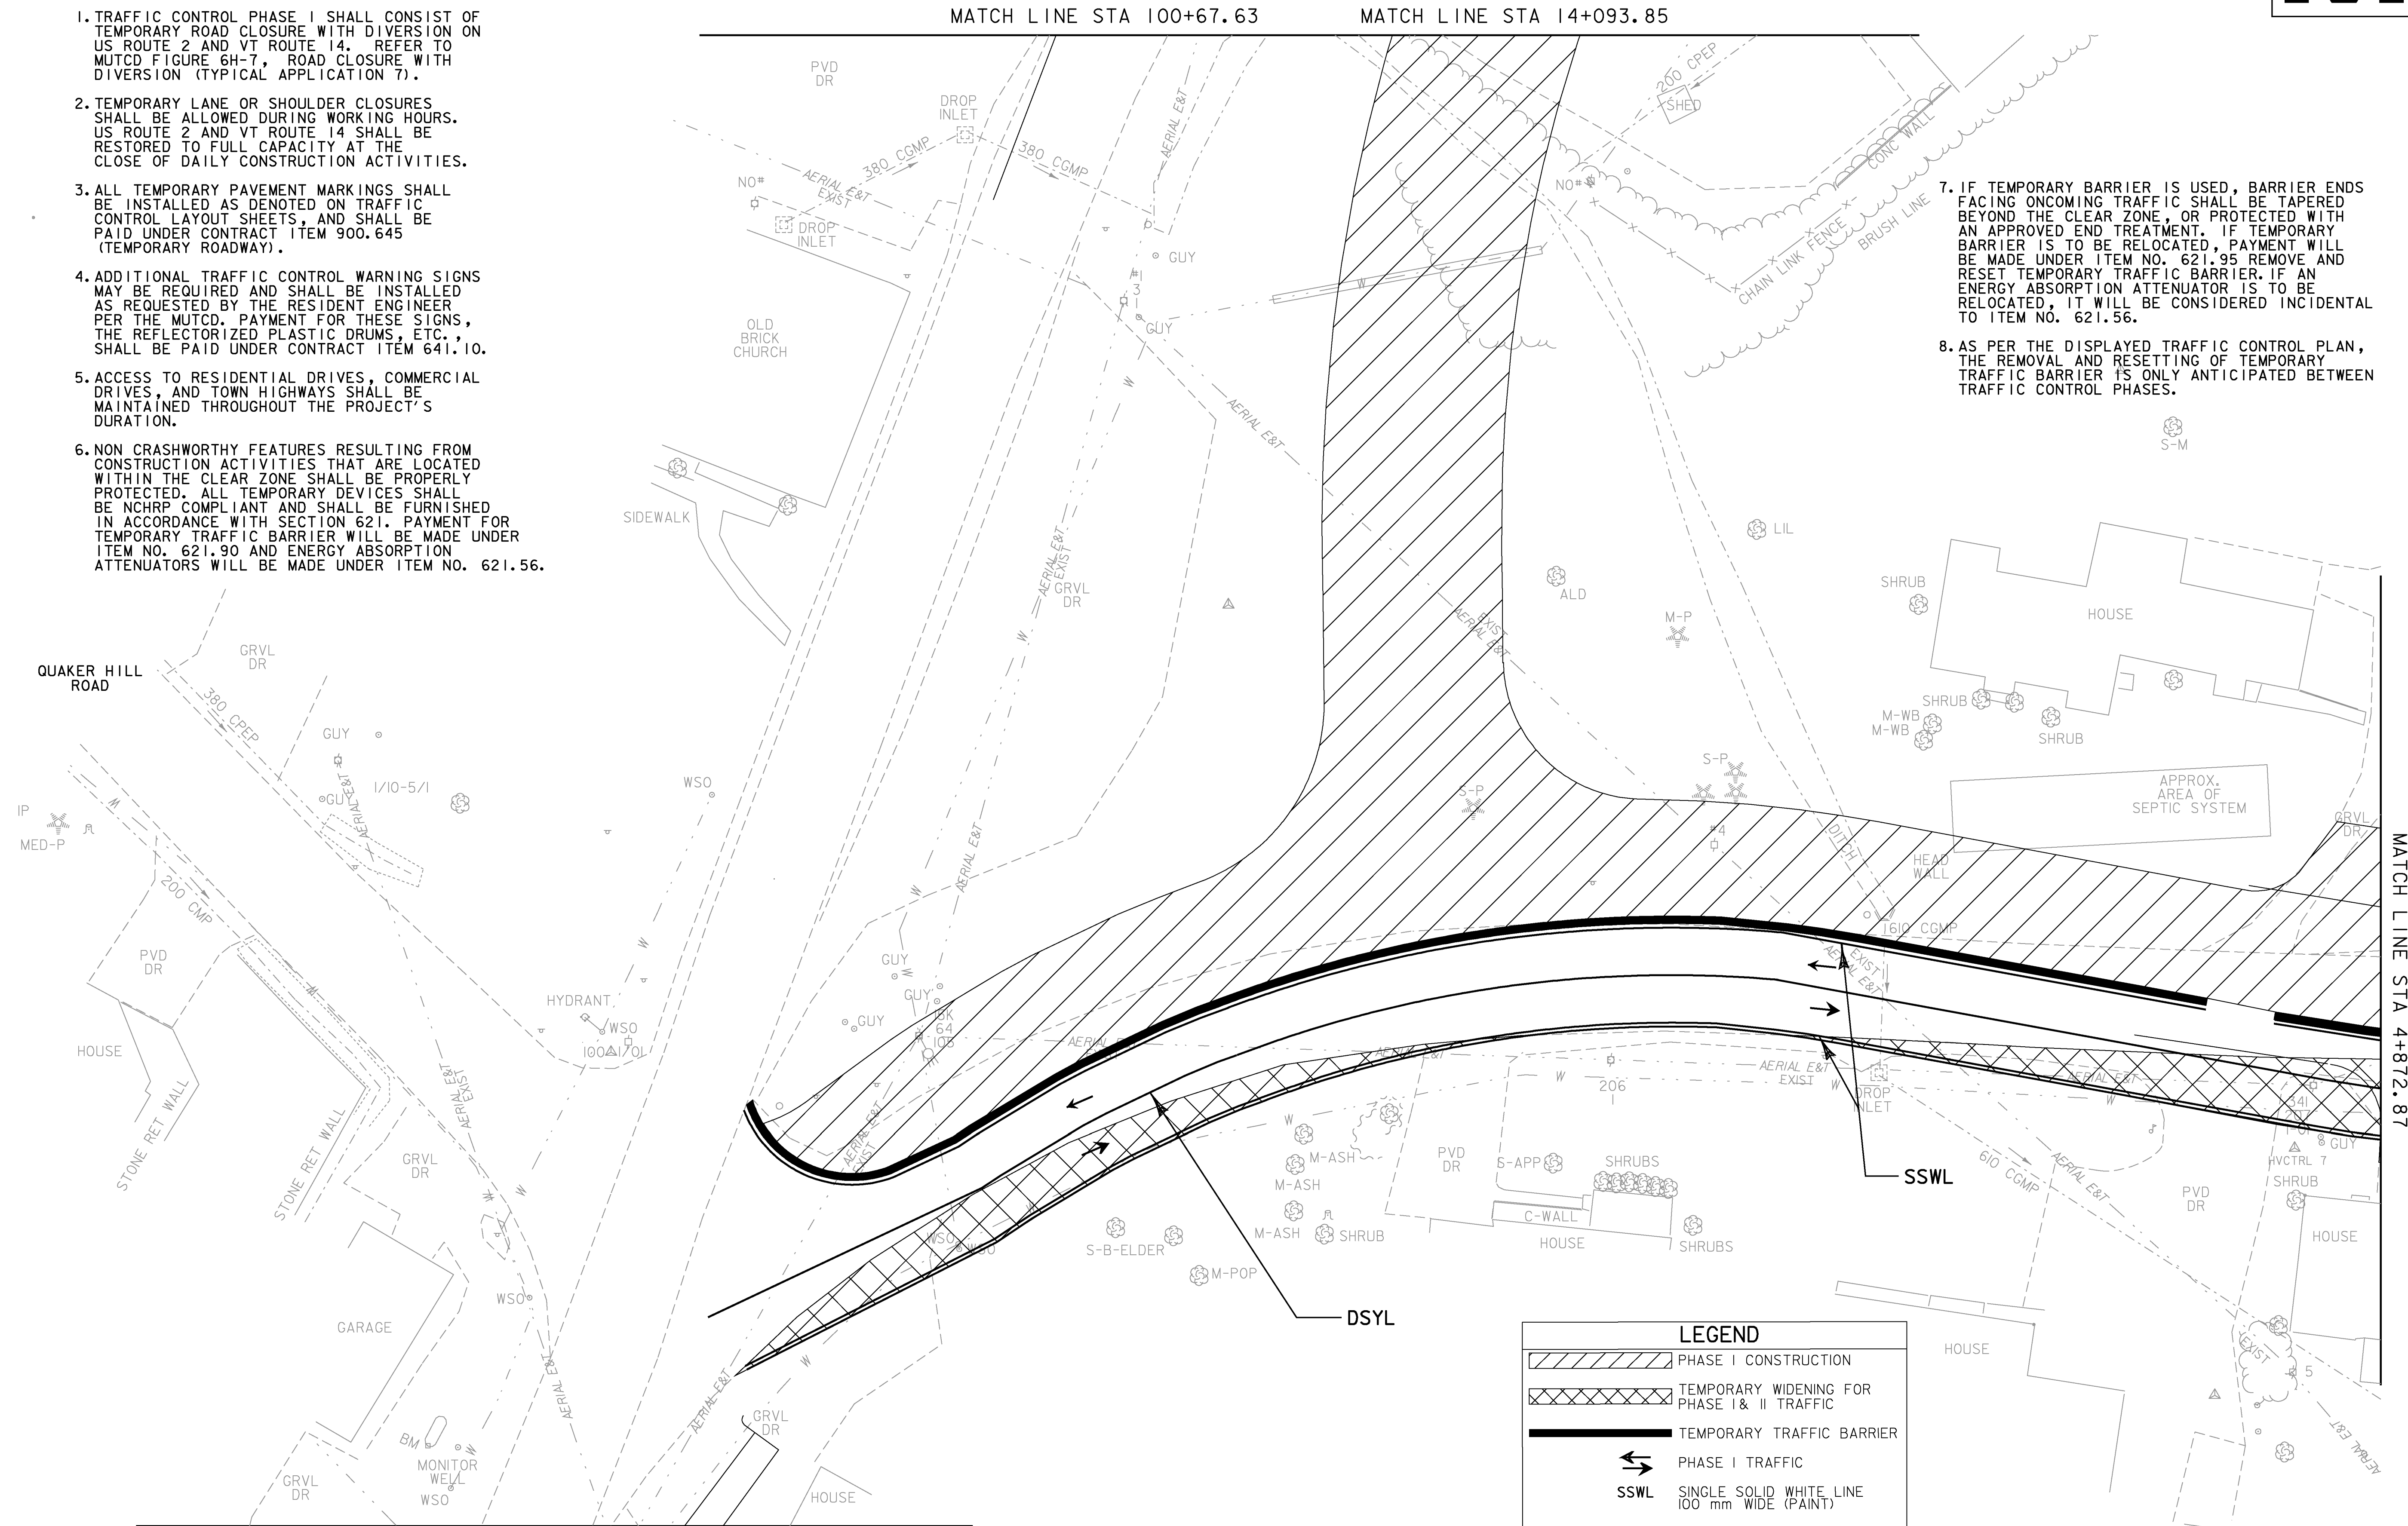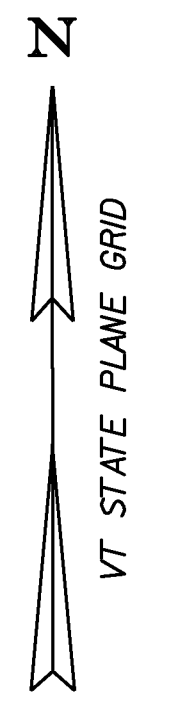

LEGEND

	PHASE I CONSTRUCTION
	TEMPORARY WIDENING FOR PHASE I & II TRAFFIC
	TEMPORARY TRAFFIC BARRIER
	PHASE I TRAFFIC
	SSWL SINGLE SOLID WHITE LINE 100 mm WIDE (PAINT)
	DSYL DOUBLE SOLID YELLOW LINE 100mm WIDE (PAINT)



PROJECT NAME: EAST MONTPELIER
 PROJECT NUMBER: STPG 028 - 3(35)S
 FILE NAME: +98b028+cp1bdr-.dgn
 PROJECT LEADER: J. SCHULTZ
 DESIGNED BY: J. GRUCHACZ
 TC PHASE I LAYOUT SHEET 2


PLOT DATE: 29-MAR-2010
 DRAWN BY: I. DEGUTIS
 CHECKED BY: J. DEVLIN
 SHEET 88 OF 142




NOTES:

1. TRAFFIC CONTROL PHASE I SHALL CONSIST OF TEMPORARY ROAD CLOSURE WITH DIVERSION ON US ROUTE 2 AND VT ROUTE 14. REFER TO MUTCD FIGURE 6H-7, ROAD CLOSURE WITH DIVERSION (TYPICAL APPLICATION 7).
2. TEMPORARY LANE OR SHOULDER CLOSURES SHALL BE ALLOWED DURING WORKING HOURS. US ROUTE 2 AND VT ROUTE 14 SHALL BE RESTORED TO FULL CAPACITY AT THE CLOSE OF DAILY CONSTRUCTION ACTIVITIES.
3. ALL TEMPORARY PAVEMENT MARKINGS SHALL BE INSTALLED AS DENOTED ON TRAFFIC CONTROL LAYOUT SHEETS, AND SHALL BE PAID UNDER CONTRACT ITEM 900.645 (TEMPORARY ROADWAY).
4. ADDITIONAL TRAFFIC CONTROL WARNING SIGNS MAY BE REQUIRED AND SHALL BE INSTALLED AS REQUESTED BY THE RESIDENT ENGINEER PER THE MUTCD. PAYMENT FOR THESE SIGNS, THE REFLECTORIZED PLASTIC DRUMS, ETC., SHALL BE PAID UNDER CONTRACT ITEM 641.10.
5. ACCESS TO RESIDENTIAL DRIVES, COMMERCIAL DRIVES, AND TOWN HIGHWAYS SHALL BE MAINTAINED THROUGHOUT THE PROJECT'S DURATION.
6. NON CRASHWORTHY FEATURES RESULTING FROM CONSTRUCTION ACTIVITIES THAT ARE LOCATED WITHIN THE CLEAR ZONE SHALL BE PROPERLY PROTECTED. ALL TEMPORARY DEVICES SHALL BE NCHRP COMPLIANT AND SHALL BE FURNISHED IN ACCORDANCE WITH SECTION 621. PAYMENT FOR TEMPORARY TRAFFIC BARRIER WILL BE MADE UNDER ITEM NO. 621.90 AND ENERGY ABSORPTION ATTENUATORS WILL BE MADE UNDER ITEM NO. 621.56.
7. IF TEMPORARY BARRIER IS USED, BARRIER ENDS FACING ONCOMING TRAFFIC SHALL BE TAPERED BEYOND THE CLEAR ZONE, OR PROTECTED WITH AN APPROVED END TREATMENT. IF TEMPORARY BARRIER IS TO BE RELOCATED, PAYMENT WILL BE MADE UNDER ITEM NO. 621.95 REMOVE AND RESET TEMPORARY TRAFFIC BARRIER. IF AN ENERGY ABSORPTION ATTENUATOR IS TO BE RELOCATED, IT WILL BE CONSIDERED INCIDENTAL TO ITEM NO. 621.56.
8. AS PER THE DISPLAYED TRAFFIC CONTROL PLAN, THE REMOVAL AND RESETTING OF TEMPORARY TRAFFIC BARRIER IS ONLY ANTICIPATED BETWEEN TRAFFIC CONTROL PHASES.

LEGEND	
	PHASE I CONSTRUCTION
	TEMPORARY WIDENING FOR PHASE I & II TRAFFIC
	TEMPORARY TRAFFIC BARRIER
	PHASE I TRAFFIC
	SSWL SINGLE SOLID WHITE LINE 100 mm WIDE (PAINT)
	DSYL DOUBLE SOLID YELLOW LINE 100mm WIDE (PAINT)
	TRAFFIC CONTROL DRUM

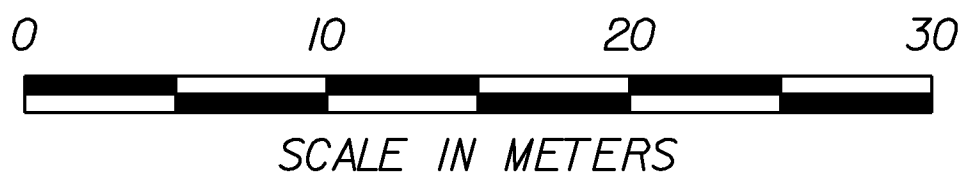

PROJECT NAME: EAST MONTPELIER	PLOT DATE: 22-MAR-2010
PROJECT NUMBER: STPG 028 - 3(35)S	DRAWN BY: I. DEGUTIS
FILE NAME: +98b028+cplbdr.dgn	CHECKED BY: J. DEVLIN
PROJECT LEADER: J. SCHULTZ	SHEET 89 OF 142
DESIGNED BY: J. GRUCHACZ	
TC PHASE I LAYOUT SHEET 3	

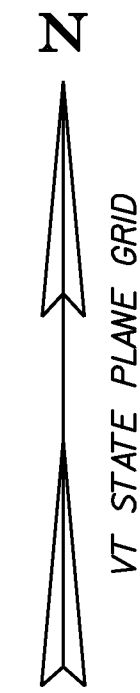

NOTES:

1. TRAFFIC CONTROL PHASE I SHALL CONSIST OF TEMPORARY ROAD CLOSURE WITH DIVERSION ON US ROUTE 2 AND VT ROUTE 14. REFER TO MUTCD FIGURE 6H-7, ROAD CLOSURE WITH DIVERSION (TYPICAL APPLICATION 7).
2. TEMPORARY LANE OR SHOULDER CLOSURES SHALL BE ALLOWED DURING WORKING HOURS. US ROUTE 2 AND VT ROUTE 14 SHALL BE RESTORED TO FULL CAPACITY AT THE CLOSE OF DAILY CONSTRUCTION ACTIVITIES.
3. ALL TEMPORARY PAVEMENT MARKINGS SHALL BE INSTALLED AS DENOTED ON TRAFFIC CONTROL LAYOUT SHEETS, AND SHALL BE PAID UNDER CONTRACT ITEM 900.645 (TEMPORARY ROADWAY).
4. ADDITIONAL TRAFFIC CONTROL WARNING SIGNS MAY BE REQUIRED AND SHALL BE INSTALLED AS REQUESTED BY THE RESIDENT ENGINEER PER THE MUTCD. PAYMENT FOR THESE SIGNS, THE REFLECTORIZED PLASTIC DRUMS, ETC., SHALL BE PAID UNDER CONTRACT ITEM 641.10.
5. ACCESS TO RESIDENTIAL DRIVES, COMMERCIAL DRIVES, AND TOWN HIGHWAYS SHALL BE MAINTAINED THROUGHOUT THE PROJECT'S DURATION.
6. NON CRASHWORTHY FEATURES RESULTING FROM CONSTRUCTION ACTIVITIES THAT ARE LOCATED WITHIN THE CLEAR ZONE SHALL BE PROPERLY PROTECTED. ALL TEMPORARY DEVICES SHALL BE NCHRP COMPLIANT AND SHALL BE FURNISHED IN ACCORDANCE WITH SECTION 621. PAYMENT FOR TEMPORARY TRAFFIC BARRIER WILL BE MADE UNDER ITEM NO. 621.90 AND ENERGY ABSORPTION ATTENUATORS WILL BE MADE UNDER ITEM NO. 621.56.
7. IF TEMPORARY BARRIER IS USED, BARRIER ENDS FACING ONCOMING TRAFFIC SHALL BE TAPERED BEYOND THE CLEAR ZONE, OR PROTECTED WITH AN APPROVED END TREATMENT. IF TEMPORARY BARRIER IS TO BE RELOCATED, PAYMENT WILL BE MADE UNDER ITEM NO. 621.95 REMOVE AND RESET TEMPORARY TRAFFIC BARRIER. IF AN ENERGY ABSORPTION ATTENUATOR IS TO BE RELOCATED, IT WILL BE CONSIDERED INCIDENTAL TO ITEM NO. 621.56.
8. AS PER THE DISPLAYED TRAFFIC CONTROL PLAN, THE REMOVAL AND RESETTING OF TEMPORARY TRAFFIC BARRIER IS ONLY ANTICIPATED BETWEEN TRAFFIC CONTROL PHASES




MATCH LINE STA 100+67.63 MATCH LINE STA 14+093.85

LEGEND
 PHASE I CONSTRUCTION




PROJECT NAME:	EAST MONTEPELIER
PROJECT NUMBER:	STPG 028 - 3(35)S
FILE NAME:	+98b028+cp1bdr.dgn
PROJECT LEADER:	J. SCHULTZ
DESIGNED BY:	J. GRUCHACZ
TC PHASE I LAYOUT SHEET 4	
PLOT DATE:	22-MAR-2010
DRAWN BY:	I. DEGUTIS
CHECKED BY:	J. DEVLIN
SHEET	90 OF 142

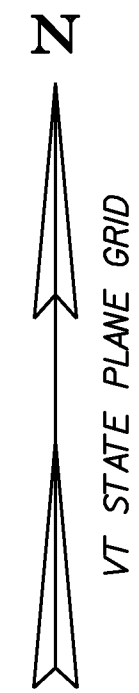

NOTES:

1. TRAFFIC CONTROL PHASE II SHALL CONSIST OF TEMPORARY ROAD CLOSURE WITH DIVERSION ON US ROUTE 2 AND VT ROUTE 14. REFER TO MUTCD FIGURE 6H-7, ROAD CLOSURE WITH DIVERSION (TYPICAL APPLICATION 7). TRAFFIC CONTROL FOR QUAKER HILL ROAD AND KELTON ROAD WILL CONSIST OF ONE-WAY TRAFFIC, REFER TO MUTCD FIGURE 6H-10, LANE CLOSURE ON TWO-LANE ROAD USING FLAGGERS (TYPICAL APPLICATION 10).
2. TEMPORARY LANE OR SHOULDER CLOSURES SHALL BE ALLOWED DURING WORKING HOURS. US ROUTE 2, VT ROUTE 14, QUAKER HILL ROAD, AND KELTON ROAD SHALL BE RESTORED TO FULL CAPACITY AT THE CLOSE OF DAILY CONSTRUCTION ACTIVITIES.
3. ALL TEMPORARY PAVEMENT MARKINGS SHALL BE INSTALLED AS DENOTED ON TRAFFIC CONTROL LAYOUT SHEETS, AND SHALL BE PAID UNDER CONTRACT ITEM 900.645 (TEMPORARY ROADWAY).
4. ADDITIONAL TRAFFIC CONTROL WARNING SIGNS MAY BE REQUIRED AND SHALL BE INSTALLED AS REQUESTED BY THE RESIDENT ENGINEER PER THE MUTCD. PAYMENT FOR THESE SIGNS, THE REFLECTORIZED PLASTIC DRUMS, ETC., SHALL BE PAID UNDER CONTRACT ITEM 641.10.
5. ACCESS TO RESIDENTIAL DRIVES, COMMERCIAL DRIVES, AND TOWN HIGHWAYS SHALL BE MAINTAINED THROUGHOUT THE PROJECT'S DURATION.
6. NON CRASHWORTHY FEATURES RESULTING FROM CONSTRUCTION ACTIVITIES THAT ARE LOCATED WITHIN THE CLEAR ZONE SHALL BE PROPERLY PROTECTED. ALL TEMPORARY DEVICES SHALL BE NCHRP COMPLIANT AND SHALL BE FURNISHED IN ACCORDANCE WITH SECTION 621. PAYMENT FOR TEMPORARY TRAFFIC BARRIER WILL BE MADE UNDER ITEM NO. 621.95 AND ENERGY ABSORPTION ATTENUATORS WILL BE MADE UNDER ITEM NO. 621.56.
7. IF TEMPORARY BARRIER IS USED, BARRIER ENDS FACING ONCOMING TRAFFIC SHALL BE TAPERED BEYOND THE CLEAR ZONE, OR PROTECTED WITH AN APPROVED END TREATMENT. IF TEMPORARY BARRIER IS TO BE RELOCATED, PAYMENT WILL BE MADE UNDER ITEM NO. 621.95 REMOVE AND RESET TEMPORARY TRAFFIC BARRIER. IF AN ENERGY ABSORPTION ATTENUATOR IS TO BE RELOCATED, IT WILL BE CONSIDERED INCIDENTAL TO ITEM NO. 621.56.
8. AS PER THE DISPLAYED TRAFFIC CONTROL PLAN, THE REMOVAL AND RESETTING OF TEMPORARY TRAFFIC BARRIER IS ONLY ANTICIPATED BETWEEN TRAFFIC CONTROL PHASES.

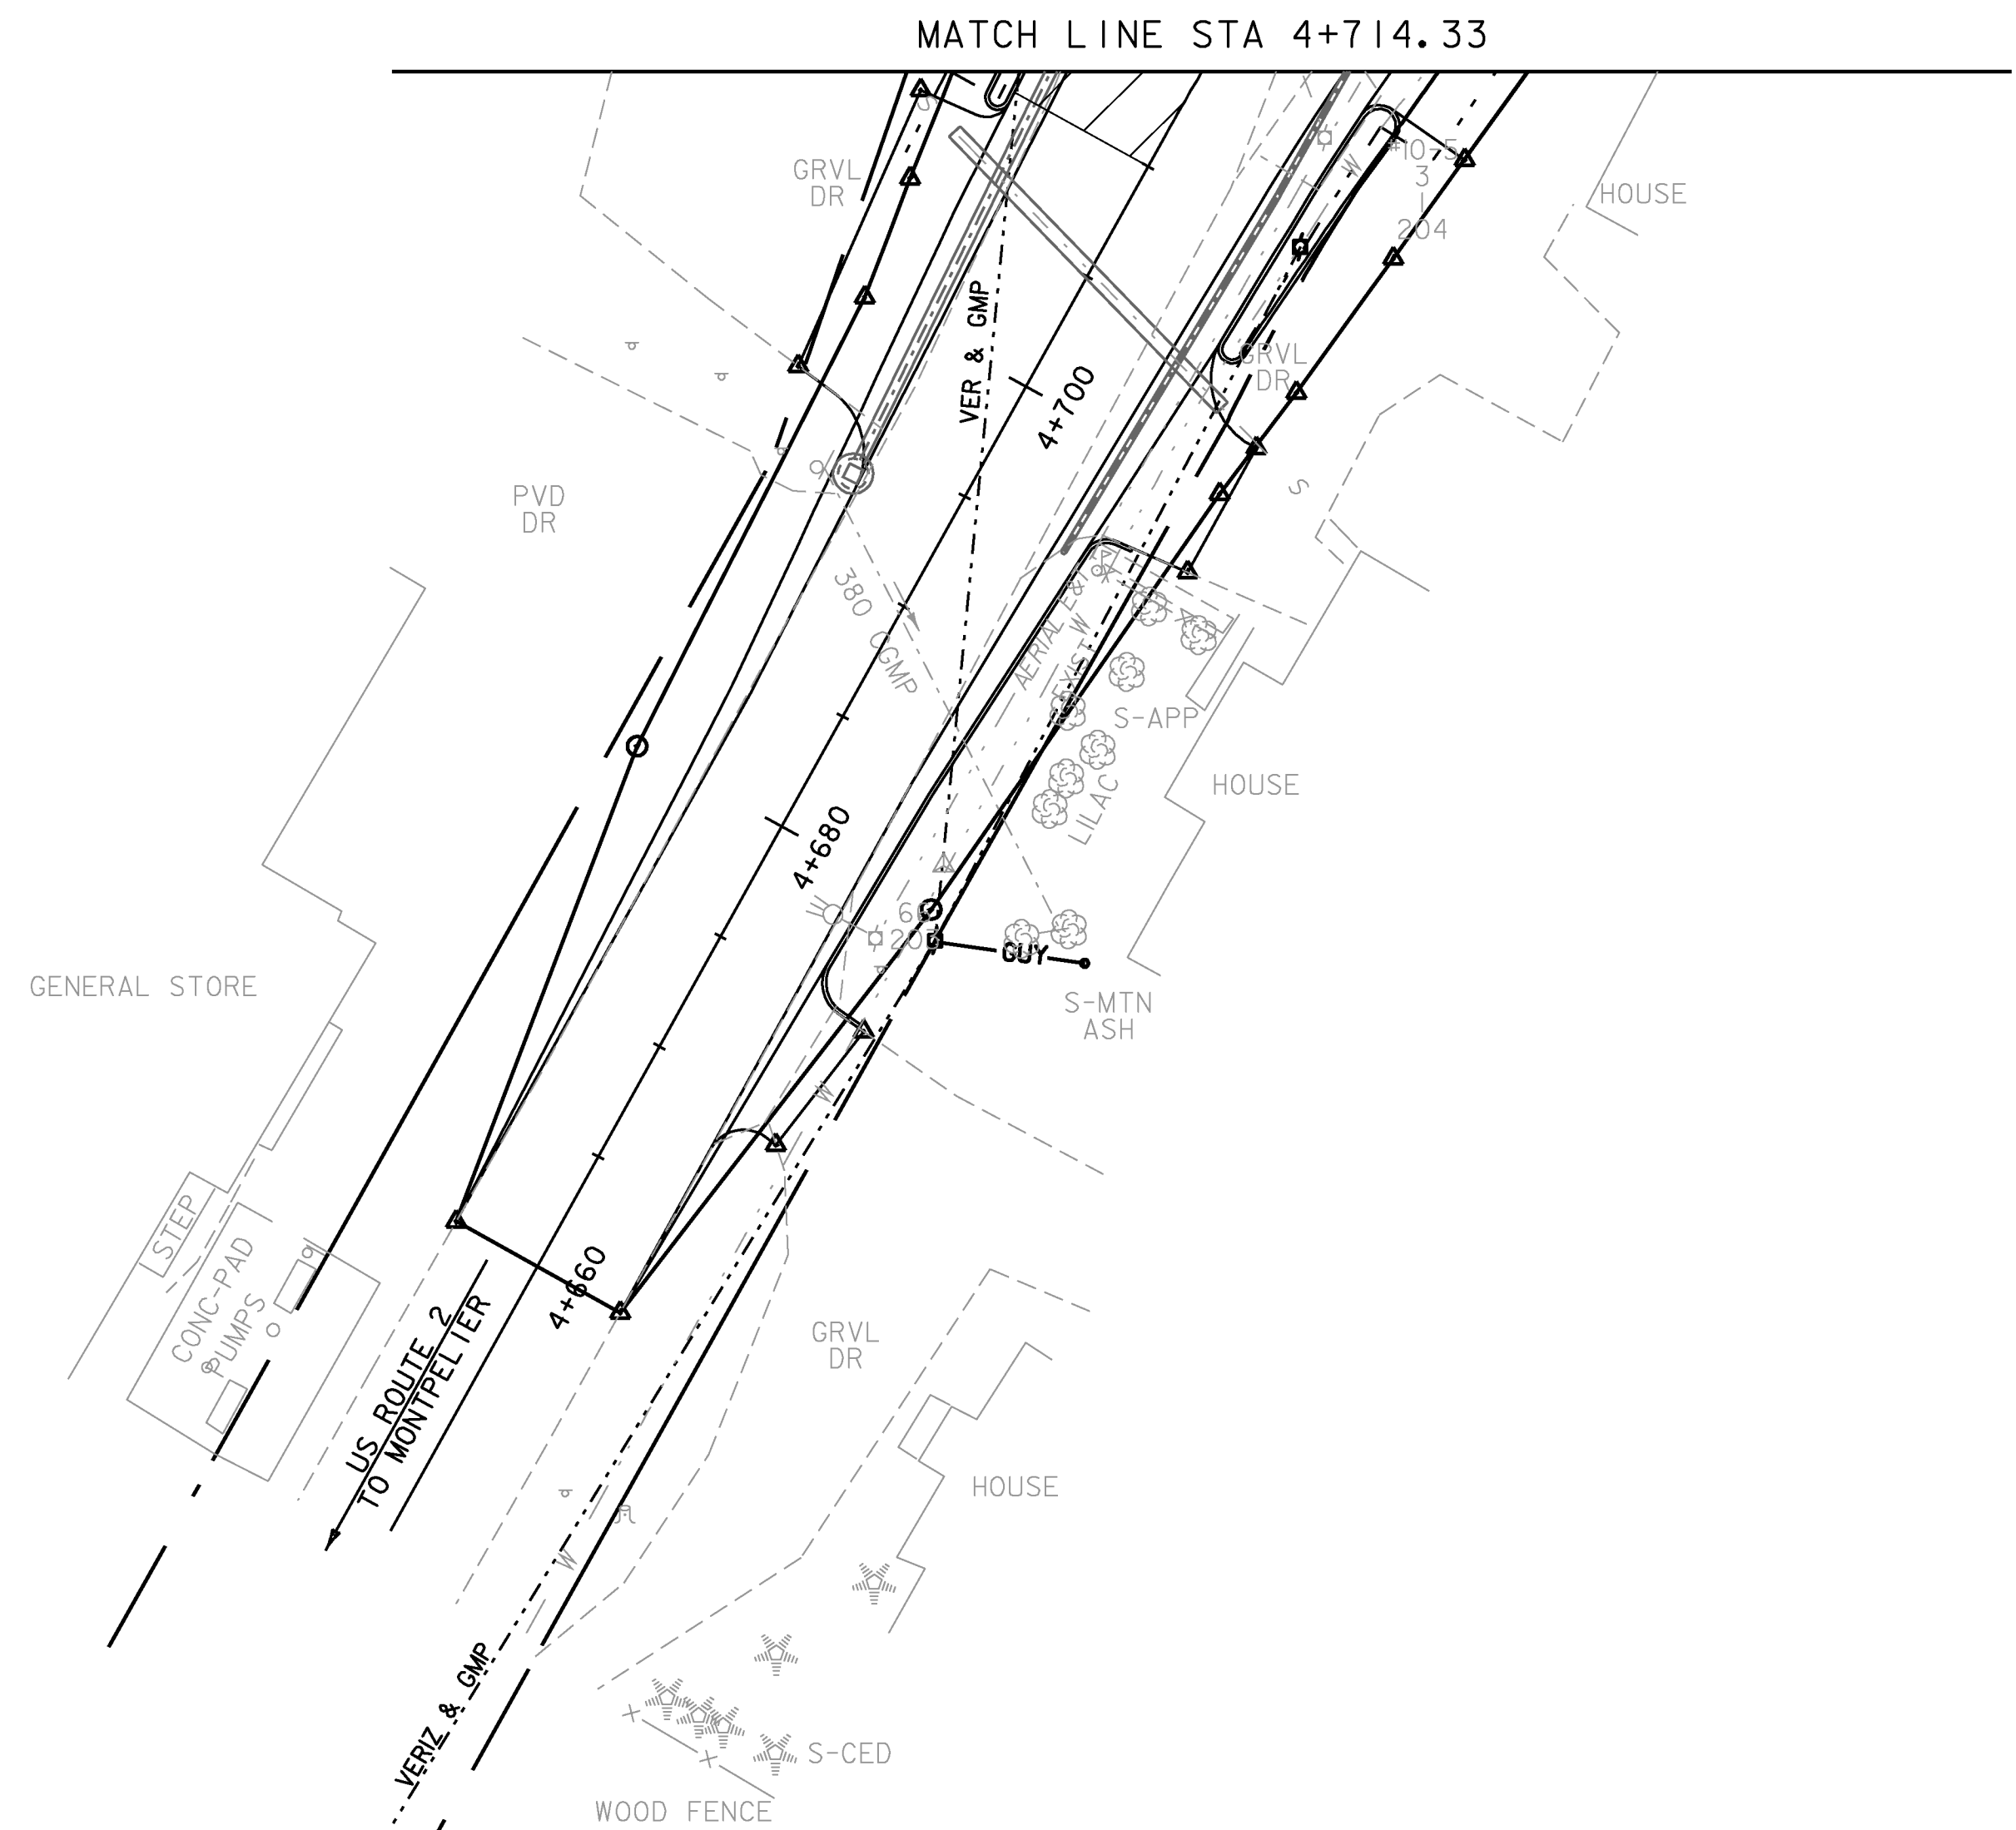

LEGEND	
	PHASE II CONSTRUCTION





PROJECT NAME: EAST MONTEPELIER	PLOT DATE: 22-MAR-2010
PROJECT NUMBER: STPG 028 - 3(35)S	DRAWN BY: I. DEGUTIS
FILE NAME: +98b028+cp2bdr.dgn	CHECKED BY: J. DEVLIN
PROJECT LEADER: J. SCHULTZ	SHEET 91 OF 142
DESIGNED BY: J. GRUCHACZ	
TC PHASE 2 LAYOUT SHEET 1	

NOTES:

1. TRAFFIC CONTROL PHASE II SHALL CONSIST OF TEMPORARY ROAD CLOSURE WITH DIVERSION ON US ROUTE 2 AND VT ROUTE 14. REFER TO MUTCD FIGURE 6H-7, ROAD CLOSURE WITH DIVERSION (TYPICAL APPLICATION 7). TRAFFIC CONTROL FOR QUAKER HILL ROAD AND KELTON ROAD WILL CONSIST OF ONE-WAY TRAFFIC, REFER TO MUTCD FIGURE 6H-10, LANE CLOSURE ON TWO-LANE ROAD USING FLAGGERS (TYPICAL APPLICATION 10).
2. TEMPORARY LANE OR SHOULDER CLOSURES SHALL BE ALLOWED DURING WORKING HOURS. US ROUTE 2, VT ROUTE 14, QUAKER HILL ROAD, AND KELTON ROAD SHALL BE RESTORED TO FULL CAPACITY AT THE CLOSE OF DAILY CONSTRUCTION ACTIVITIES.
3. ALL TEMPORARY PAVEMENT MARKINGS SHALL BE INSTALLED AS DENOTED ON TRAFFIC CONTROL LAYOUT SHEETS, AND SHALL BE PAID UNDER CONTRACT ITEM 900.645 (TEMPORARY ROADWAY).
4. ADDITIONAL TRAFFIC CONTROL WARNING SIGNS MAY BE REQUIRED AND SHALL BE INSTALLED AS REQUESTED BY THE RESIDENT ENGINEER PER THE MUTCD. PAYMENT FOR THESE SIGNS, THE REFLECTORIZED PLASTIC DRUMS, ETC., SHALL BE PAID UNDER CONTRACT ITEM 641.10.
5. ACCESS TO RESIDENTIAL DRIVES, COMMERCIAL DRIVES, AND TOWN HIGHWAYS SHALL BE MAINTAINED THROUGHOUT THE PROJECT'S DURATION.

6. NON CRASHWORTHY FEATURES RESULTING FROM CONSTRUCTION ACTIVITIES THAT ARE LOCATED WITHIN THE CLEAR ZONE SHALL BE PROPERLY PROTECTED. ALL TEMPORARY DEVICES SHALL BE NCHRP COMPLIANT AND SHALL BE FURNISHED IN ACCORDANCE WITH SECTION 621. PAYMENT FOR TEMPORARY TRAFFIC BARRIER WILL BE MADE UNDER ITEM NO. 621.95 AND ENERGY ABSORPTION ATTENUATORS WILL BE MADE UNDER ITEM NO. 621.56.
7. IF TEMPORARY BARRIER IS USED, BARRIER ENDS FACING ONCOMING TRAFFIC SHALL BE TAPERED BEYOND THE CLEAR ZONE, OR PROTECTED WITH AN APPROVED END TREATMENT. IF TEMPORARY BARRIER IS TO BE RELOCATED, PAYMENT WILL BE MADE UNDER ITEM NO. 621.95 REMOVE AND RESET TEMPORARY TRAFFIC BARRIER. IF AN ENERGY ABSORPTION ATTENUATOR IS TO BE RELOCATED, IT WILL BE CONSIDERED INCIDENTAL TO ITEM NO. 621.56.
8. AS PER THE DISPLAYED TRAFFIC CONTROL PLAN, THE REMOVAL AND RESETTING OF TEMPORARY TRAFFIC BARRIER IS ONLY ANTICIPATED BETWEEN TRAFFIC CONTROL PHASES.

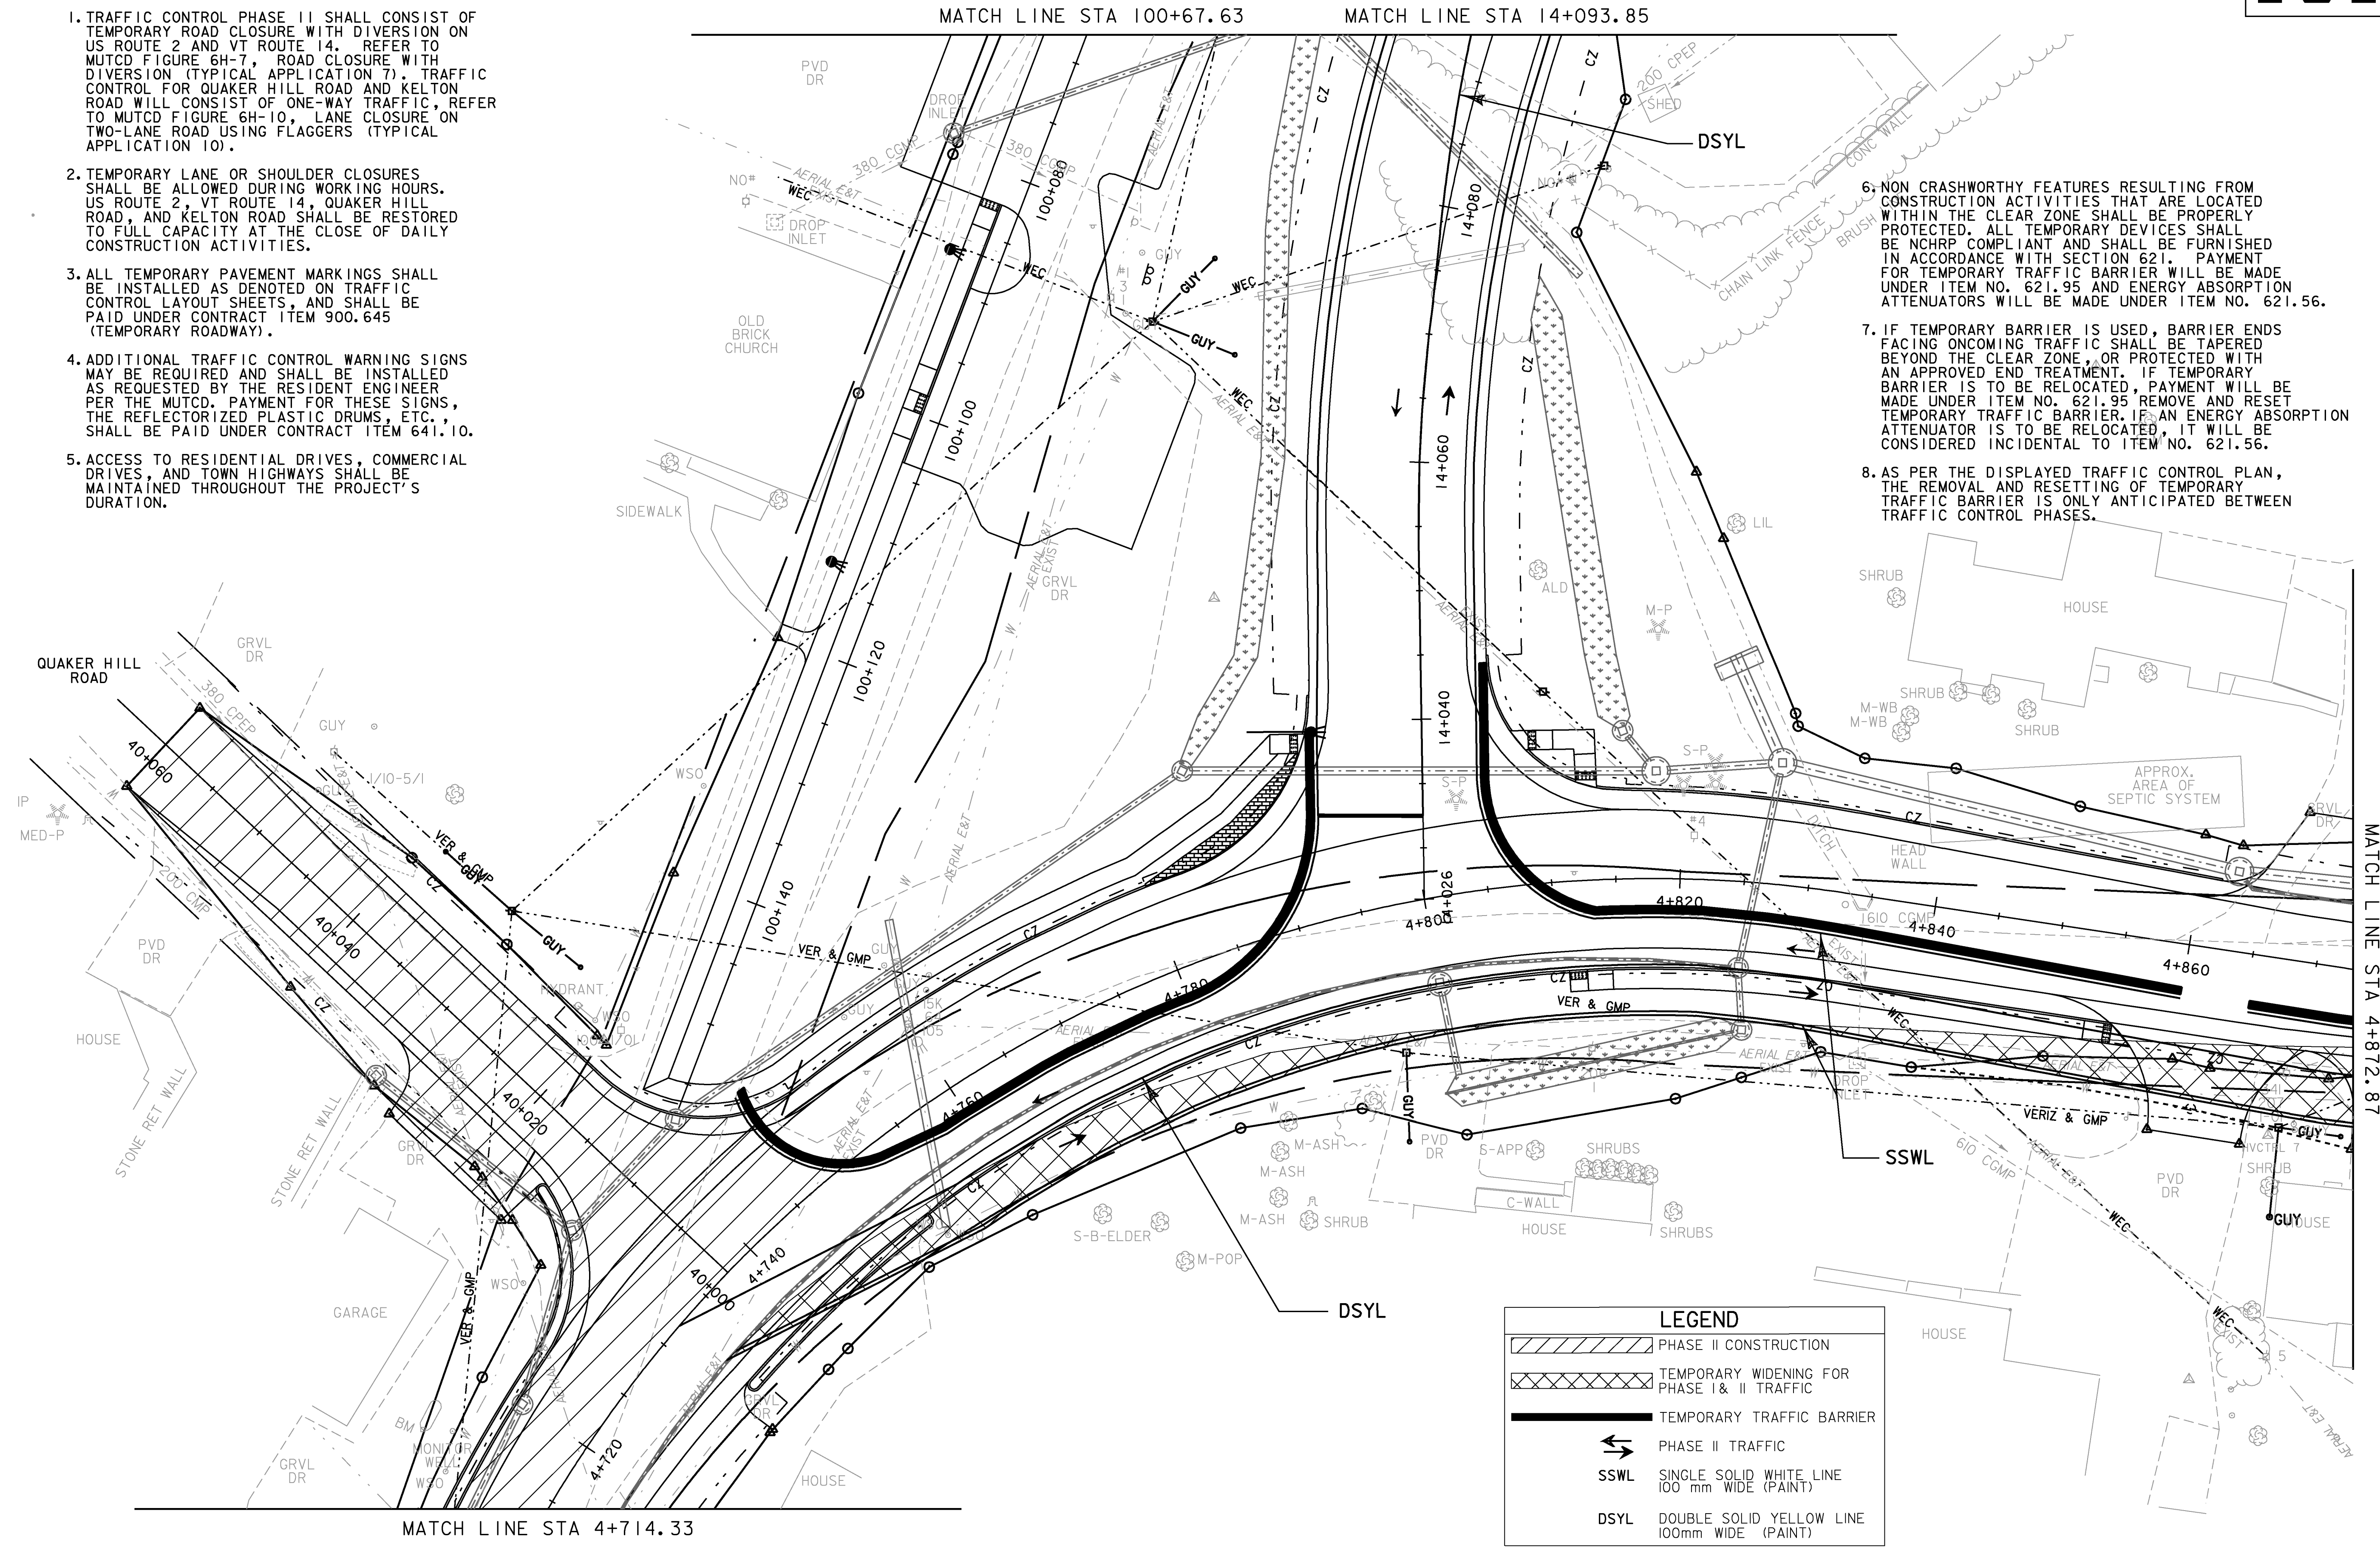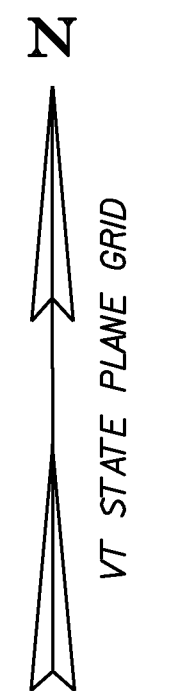

LEGEND

- PHASE II CONSTRUCTION
- TEMPORARY WIDENING FOR PHASE I & II TRAFFIC
- TEMPORARY TRAFFIC BARRIER
- PHASE II TRAFFIC
- SSWL SINGLE SOLID WHITE LINE 100 mm WIDE (PAINT)
- DSYL DOUBLE SOLID YELLOW LINE 100mm WIDE (PAINT)




PROJECT NAME: EAST MONTPELIER
 PROJECT NUMBER: STPG 028 - 3(35)S
 FILE NAME: +98b028+cp2bdr.dgn
 PROJECT LEADER: J. SCHULTZ
 DESIGNED BY: J. GRUCHACZ
 TC PHASE 2 LAYOUT SHEET 2
 PLOT DATE: 29-MAR-2010
 DRAWN BY: I. DEGUTIS
 CHECKED BY: J. DEVLIN
 SHEET 92 OF 142




NOTES:

1. TRAFFIC CONTROL PHASE II SHALL CONSIST OF TEMPORARY ROAD CLOSURE WITH DIVERSION ON US ROUTE 2 AND VT ROUTE 14. REFER TO MUTCD FIGURE 6H-7, ROAD CLOSURE WITH DIVERSION (TYPICAL APPLICATION 7). TRAFFIC CONTROL FOR QUAKER HILL ROAD AND KELTON ROAD WILL CONSIST OF ONE-WAY TRAFFIC, REFER TO MUTCD FIGURE 6H-10, LANE CLOSURE ON TWO-LANE ROAD USING FLAGGERS (TYPICAL APPLICATION 10).
2. TEMPORARY LANE OR SHOULDER CLOSURES SHALL BE ALLOWED DURING WORKING HOURS. US ROUTE 2, VT ROUTE 14, QUAKER HILL ROAD, AND KELTON ROAD SHALL BE RESTORED TO FULL CAPACITY AT THE CLOSE OF DAILY CONSTRUCTION ACTIVITIES.
3. ALL TEMPORARY PAVEMENT MARKINGS SHALL BE INSTALLED AS DENOTED ON TRAFFIC CONTROL LAYOUT SHEETS, AND SHALL BE PAID UNDER CONTRACT ITEM 900.645 (TEMPORARY ROADWAY).
4. ADDITIONAL TRAFFIC CONTROL WARNING SIGNS MAY BE REQUIRED AND SHALL BE INSTALLED AS REQUESTED BY THE RESIDENT ENGINEER PER THE MUTCD. PAYMENT FOR THESE SIGNS, THE REFLECTORIZED PLASTIC DRUMS, ETC., SHALL BE PAID UNDER CONTRACT ITEM 641.10.

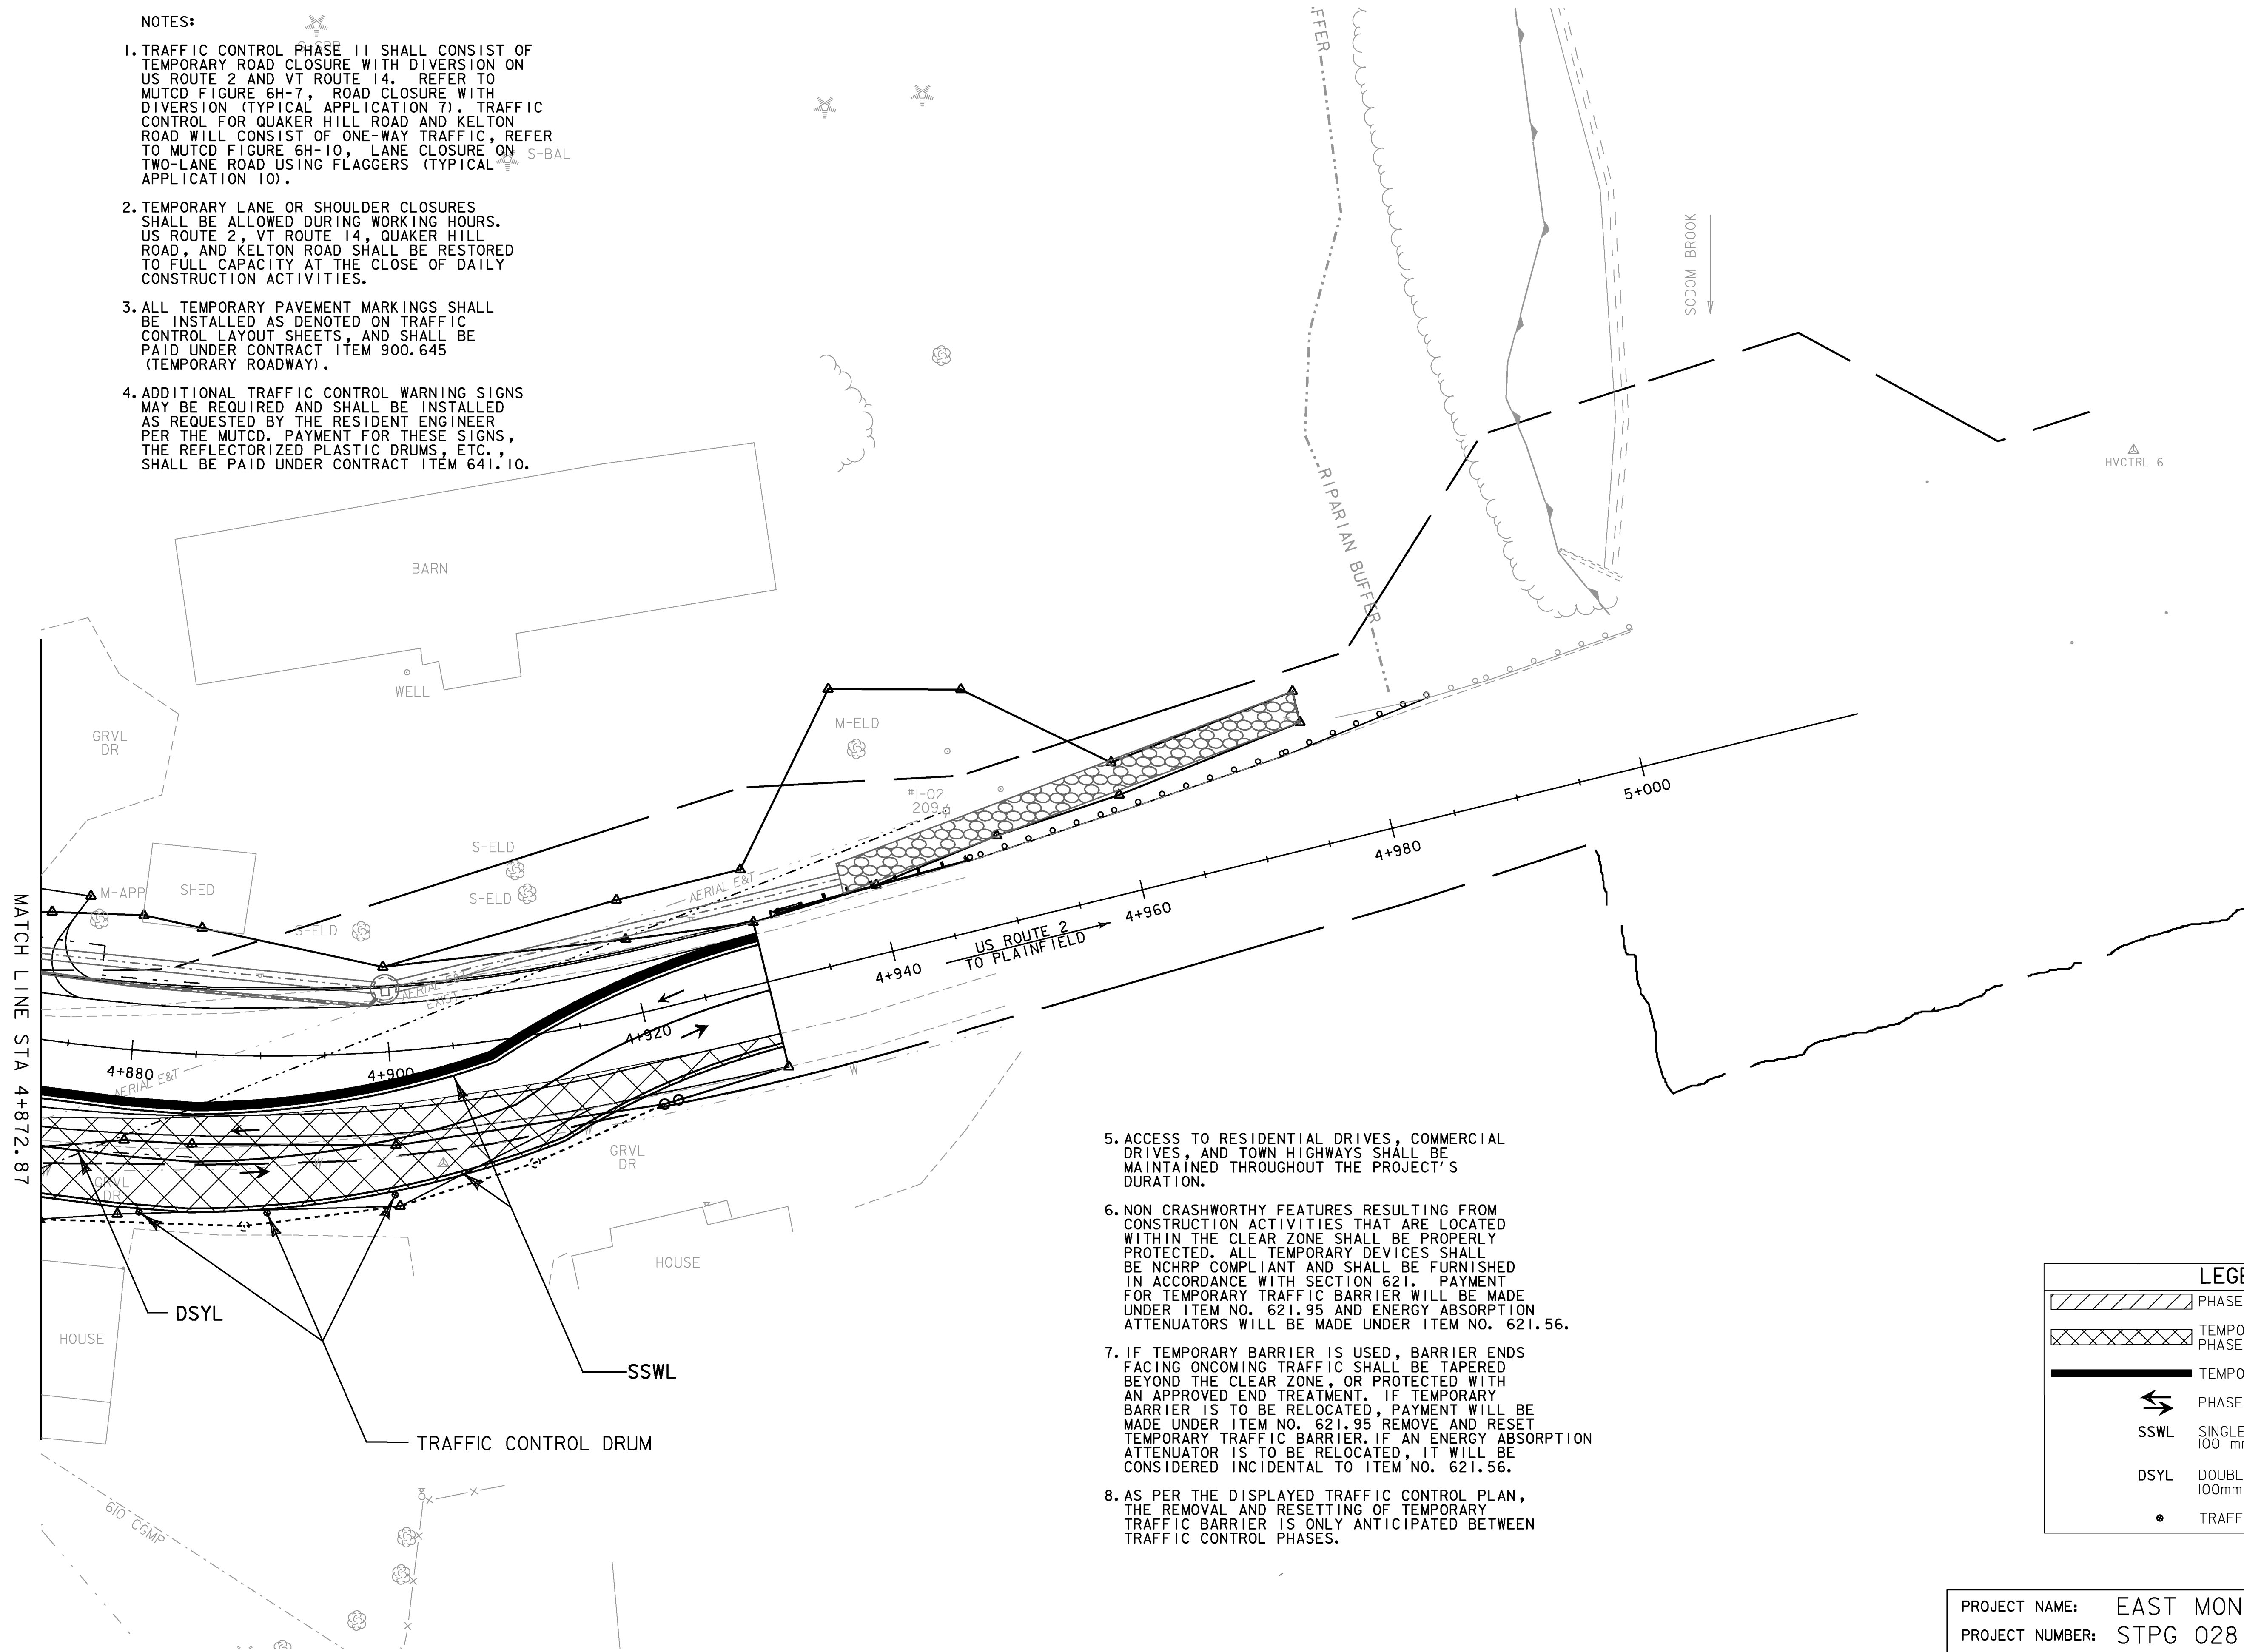


5. ACCESS TO RESIDENTIAL DRIVES, COMMERCIAL DRIVES, AND TOWN HIGHWAYS SHALL BE MAINTAINED THROUGHOUT THE PROJECT'S DURATION.
6. NON CRASHWORTHY FEATURES RESULTING FROM CONSTRUCTION ACTIVITIES THAT ARE LOCATED WITHIN THE CLEAR ZONE SHALL BE PROPERLY PROTECTED. ALL TEMPORARY DEVICES SHALL BE NCHRP COMPLIANT AND SHALL BE FURNISHED IN ACCORDANCE WITH SECTION 621. PAYMENT FOR TEMPORARY TRAFFIC BARRIER WILL BE MADE UNDER ITEM NO. 621.95 AND ENERGY ABSORPTION ATTENUATORS WILL BE MADE UNDER ITEM NO. 621.56.
7. IF TEMPORARY BARRIER IS USED, BARRIER ENDS FACING ONCOMING TRAFFIC SHALL BE TAPERED BEYOND THE CLEAR ZONE, OR PROTECTED WITH AN APPROVED END TREATMENT. IF TEMPORARY BARRIER IS TO BE RELOCATED, PAYMENT WILL BE MADE UNDER ITEM NO. 621.95 REMOVE AND RESET TEMPORARY TRAFFIC BARRIER. IF AN ENERGY ABSORPTION ATTENUATOR IS TO BE RELOCATED, IT WILL BE CONSIDERED INCIDENTAL TO ITEM NO. 621.56.
8. AS PER THE DISPLAYED TRAFFIC CONTROL PLAN, THE REMOVAL AND RESETING OF TEMPORARY TRAFFIC BARRIER IS ONLY ANTICIPATED BETWEEN TRAFFIC CONTROL PHASES.

LEGEND	
	PHASE II CONSTRUCTION
	TEMPORARY WIDENING FOR PHASE I & II TRAFFIC
	TEMPORARY TRAFFIC BARRIER
	PHASE II TRAFFIC
	SSWL SINGLE SOLID WHITE LINE 100 mm WIDE (PAINT)
	DSYL DOUBLE SOLID YELLOW LINE 100mm WIDE (PAINT)
	TRAFFIC CONTROL DRUM

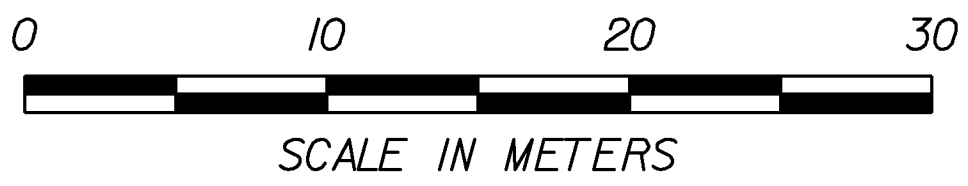


PROJECT NAME: EAST MONTPELIER	PLOT DATE: 29-MAR-2010
PROJECT NUMBER: STPG 028 - 3(35)S	DRAWN BY: I. DEGUTIS
FILE NAME: +98b028+cp2bdr.dgn	CHECKED BY: J. DEVLIN
PROJECT LEADER: J. SCHULTZ	SHEET 93 OF 142
DESIGNED BY: J. GRUCHACZ	
TC PHASE 2 LAYOUT SHEET 3	

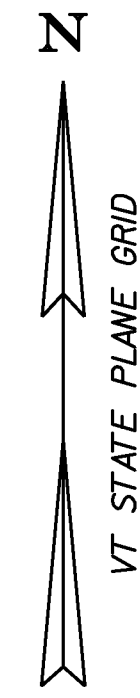

NOTES:

1. TRAFFIC CONTROL PHASE II SHALL CONSIST OF TEMPORARY ROAD CLOSURE WITH DIVERSION ON US ROUTE 2 AND VT ROUTE 14. REFER TO MUTCD FIGURE 6H-7, ROAD CLOSURE WITH DIVERSION (TYPICAL APPLICATION 7). TRAFFIC CONTROL FOR QUAKER HILL ROAD AND KELTON ROAD WILL CONSIST OF ONE-WAY TRAFFIC, REFER TO MUTCD FIGURE 6H-10, LANE CLOSURE ON TWO-LANE ROAD USING FLAGGERS (TYPICAL APPLICATION 10).
2. TEMPORARY LANE OR SHOULDER CLOSURES SHALL BE ALLOWED DURING WORKING HOURS. US ROUTE 2, VT ROUTE 14, QUAKER HILL ROAD, AND KELTON ROAD SHALL BE RESTORED TO FULL CAPACITY AT THE CLOSE OF DAILY CONSTRUCTION ACTIVITIES.
3. ALL TEMPORARY PAVEMENT MARKINGS SHALL BE INSTALLED AS DENOTED ON TRAFFIC CONTROL LAYOUT SHEETS, AND SHALL BE PAID UNDER CONTRACT ITEM 900.645 (TEMPORARY ROADWAY).
4. ADDITIONAL TRAFFIC CONTROL WARNING SIGNS MAY BE REQUIRED AND SHALL BE INSTALLED AS REQUESTED BY THE RESIDENT ENGINEER PER THE MUTCD. PAYMENT FOR THESE SIGNS, THE REFLECTORIZED PLASTIC DRUMS, ETC., SHALL BE PAID UNDER CONTRACT ITEM 641.10.
5. ACCESS TO RESIDENTIAL DRIVES, COMMERCIAL DRIVES, AND TOWN HIGHWAYS SHALL BE MAINTAINED THROUGHOUT THE PROJECT'S DURATION.
6. NON CRASHWORTHY FEATURES RESULTING FROM CONSTRUCTION ACTIVITIES THAT ARE LOCATED WITHIN THE CLEAR ZONE SHALL BE PROPERLY PROTECTED. ALL TEMPORARY DEVICES SHALL BE NCHRP COMPLIANT AND SHALL BE FURNISHED IN ACCORDANCE WITH SECTION 621. PAYMENT FOR TEMPORARY TRAFFIC BARRIER WILL BE MADE UNDER ITEM NO. 621.95 AND ENERGY ABSORPTION ATTENUATORS WILL BE MADE UNDER ITEM NO. 621.56.
7. IF TEMPORARY BARRIER IS USED, BARRIER ENDS FACING ONCOMING TRAFFIC SHALL BE TAPERED BEYOND THE CLEAR ZONE, OR PROTECTED WITH AN APPROVED END TREATMENT. IF TEMPORARY BARRIER IS TO BE RELOCATED, PAYMENT WILL BE MADE UNDER ITEM NO. 621.95 REMOVE AND RESET TEMPORARY TRAFFIC BARRIER. IF AN ENERGY ABSORPTION ATTENUATOR IS TO BE RELOCATED, IT WILL BE CONSIDERED INCIDENTAL TO ITEM NO. 621.56.
8. AS PER THE DISPLAYED TRAFFIC CONTROL PLAN, THE REMOVAL AND RESETTING OF TEMPORARY TRAFFIC BARRIER IS ONLY ANTICIPATED BETWEEN TRAFFIC CONTROL PHASES.

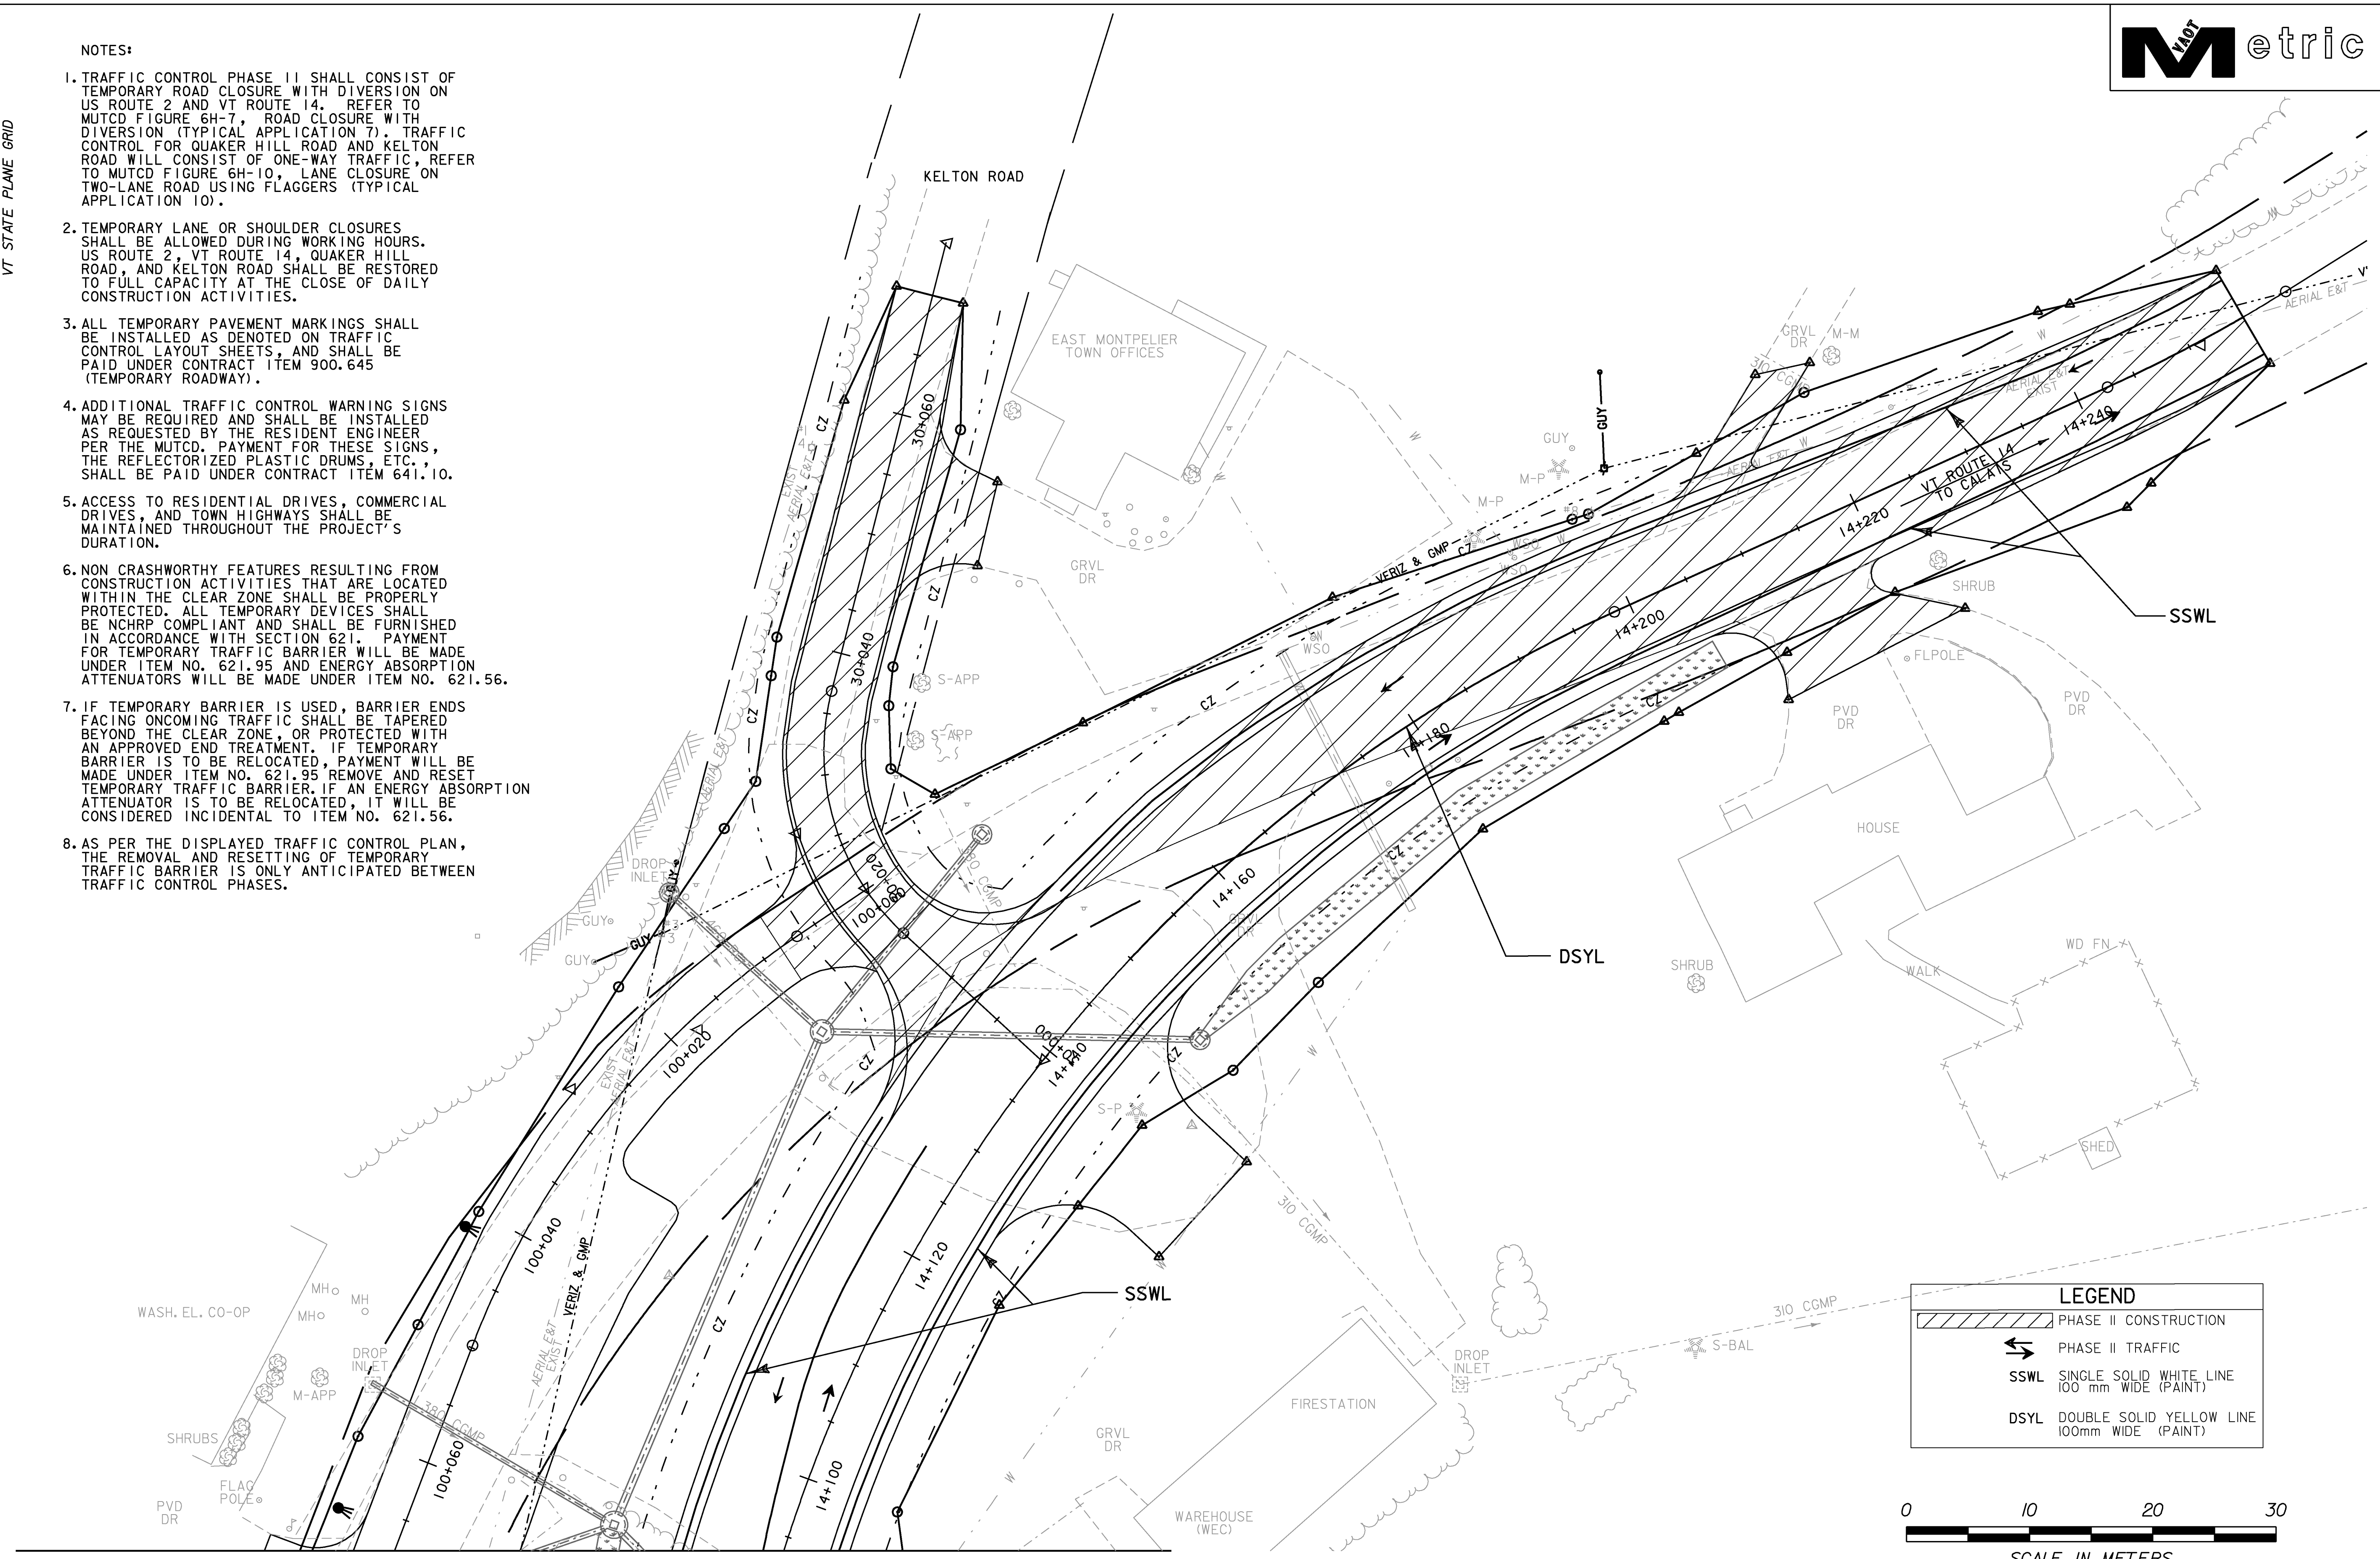


MATCH LINE STA 100+67.63 MATCH LINE STA 14+093.85

LEGEND	
	PHASE II CONSTRUCTION
	PHASE II TRAFFIC
	SSWL SINGLE SOLID WHITE LINE 100 mm WIDE (PAINT)
	DSYL DOUBLE SOLID YELLOW LINE 100mm WIDE (PAINT)




PROJECT NAME: EAST MONTPELIER
 PROJECT NUMBER: STPG 028 - 3(35)S
 FILE NAME: +98b028+cp2bdr.dgn PLOT DATE: 22-MAR-2010
 PROJECT LEADER: J. SCHULTZ DRAWN BY: I. DEGUTIS
 DESIGNED BY: J. GRUCHACZ CHECKED BY: J. DEVLIN
 TC PHASE 2 LAYOUT SHEET 4 SHEET 94 OF 142

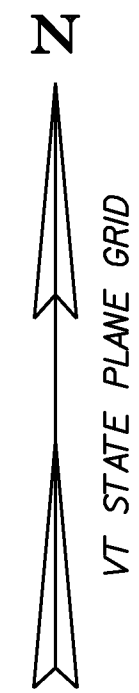

NOTES:

1. TRAFFIC CONTROL PHASE III SHALL CONSIST OF TEMPORARY ROAD CLOSURE WITH DIVERSION ON US ROUTE 2 AND VT ROUTE 14. REFER TO MUTCD FIGURE 6H-7, ROAD CLOSURE WITH DIVERSION (TYPICAL APPLICATION 7).
2. TEMPORARY LANE OR SHOULDER CLOSURES SHALL BE ALLOWED DURING WORKING HOURS. US ROUTE 2 AND VT 14 SHALL BE RESTORED TO FULL CAPACITY AT THE CLOSE OF DAILY CONSTRUCTION ACTIVITIES.
3. ALL TEMPORARY PAVEMENT MARKINGS SHALL BE INSTALLED AS DENOTED ON TRAFFIC CONTROL LAYOUT SHEETS, AND SHALL BE PAID UNDER CONTRACT ITEM 900.645 (TEMPORARY ROADWAY)
4. ADDITIONAL TRAFFIC CONTROL WARNING SIGNS MAY BE REQUIRED AND SHALL BE INSTALLED AS REQUESTED BY THE RESIDENT ENGINEER PER THE MUTCD. PAYMENT FOR THESE SIGNS, THE REFLECTORIZED PLASTIC DRUMS, ETC., SHALL BE PAID UNDER CONTRACT ITEM 641.10.
5. ACCESS TO RESIDENTIAL DRIVES, COMMERCIAL DRIVES, AND TOWN HIGHWAYS SHALL BE MAINTAINED THROUGHOUT THE PROJECT'S DURATION.
6. NON CRASHWORTHY FEATURES RESULTING FROM CONSTRUCTION ACTIVITIES THAT ARE LOCATED WITHIN THE CLEAR ZONE SHALL BE PROPERLY PROTECTED. ALL TEMPORARY DEVICES SHALL BE NCHRP COMPLIANT AND SHALL BE FURNISHED IN ACCORDANCE WITH SECTION 621. PAYMENT FOR TEMPORARY TRAFFIC BARRIER WILL BE MADE UNDER ITEM NO. 621.90 AND ENERGY ABSORPTION ATTENUATORS WILL BE MADE UNDER ITEM NO. 621.56.
7. IF TEMPORARY BARRIER IS USED, BARRIER ENDS FACING ONCOMING TRAFFIC SHALL BE TAPERED BEYOND THE CLEAR ZONE, OR PROTECTED WITH AN APPROVED END TREATMENT. IF TEMPORARY BARRIER IS TO BE RELOCATED, PAYMENT WILL BE MADE UNDER ITEM NO. 621.95 REMOVE AND RESET TEMPORARY TRAFFIC BARRIER. IF AN ENERGY ABSORPTION ATTENUATOR IS TO BE RELOCATED, IT WILL BE CONSIDERED INCIDENTAL TO ITEM NO. 621.56.
8. AS PER THE DISPLAYED TRAFFIC CONTROL PLAN, THE REMOVAL AND RESETTING OF TEMPORARY TRAFFIC BARRIER IS ONLY ANTICIPATED BETWEEN TRAFFIC CONTROL PHASES.

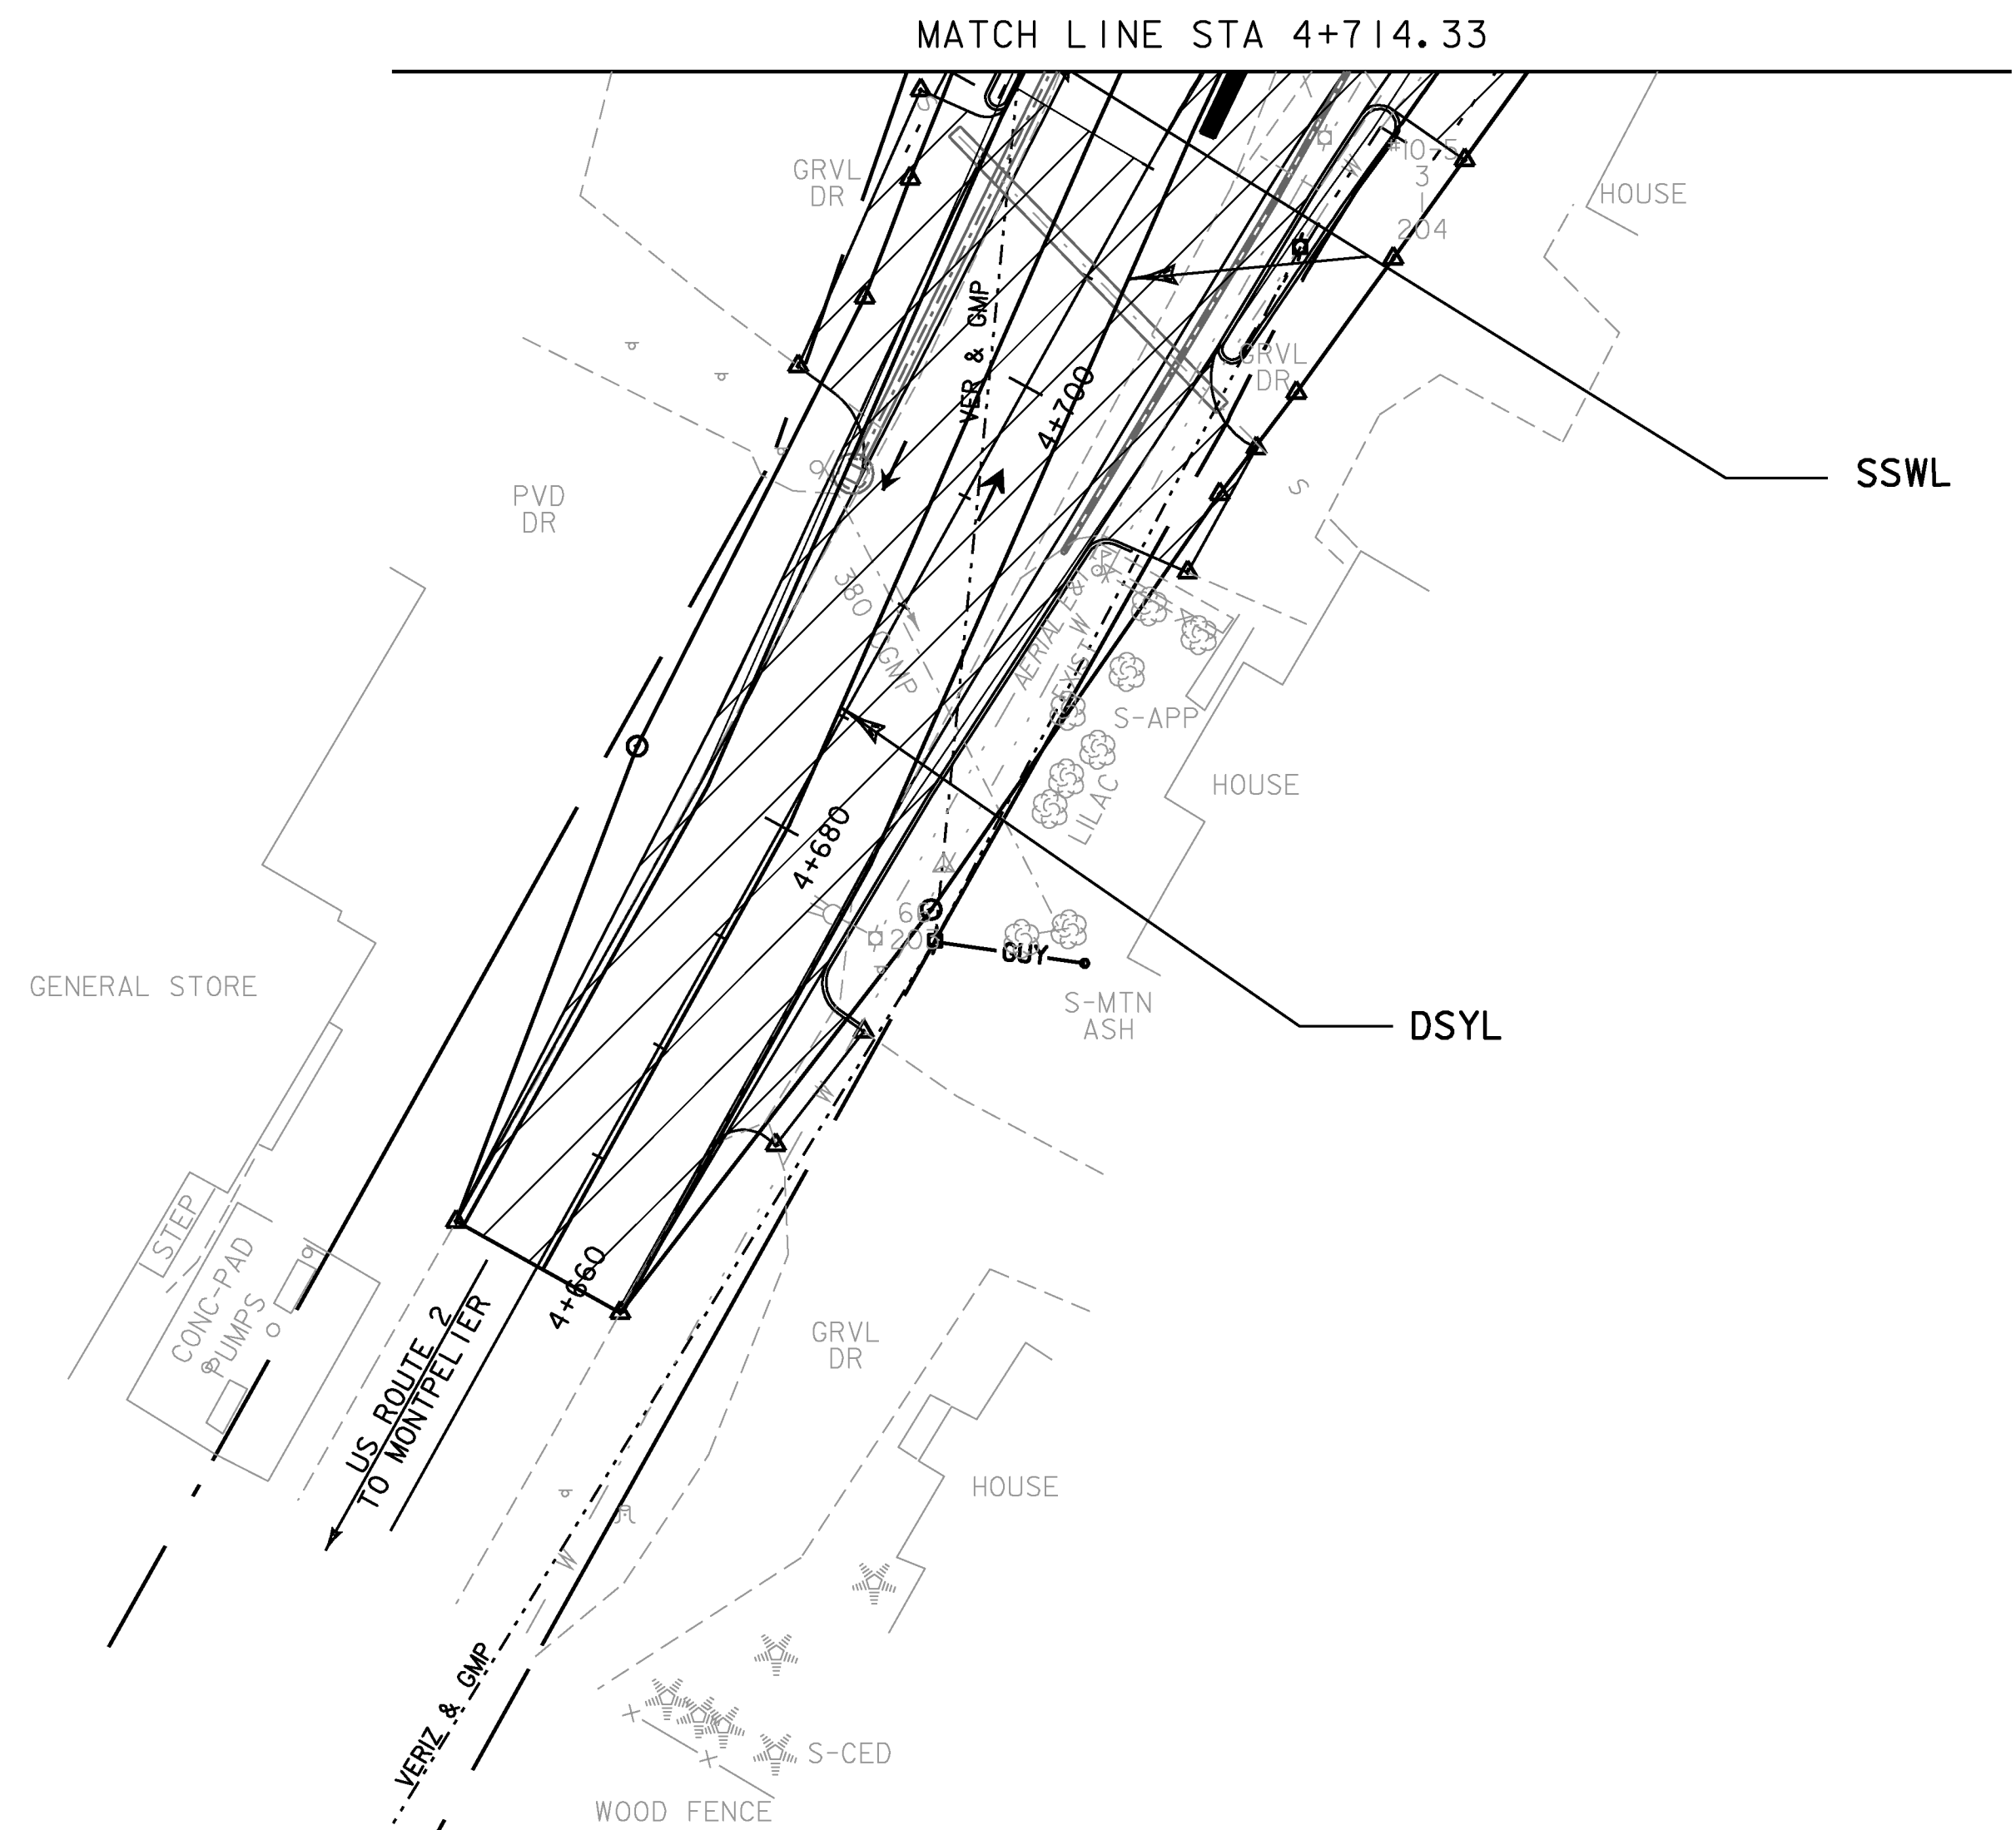

LEGEND	
	PHASE III CONSTRUCTION
	PHASE III TRAFFIC
	SSWL SINGLE SOLID WHITE LINE 100 mm WIDE (PAINT)
	DSYL DOUBLE SOLID YELLOW LINE 100mm WIDE (PAINT)





PROJECT NAME:	EAST MONTPELIER	FILE NAME:	+98b028+cp3bdr.dgn	PLOT DATE:	29-MAR-2010
PROJECT NUMBER:	STPG 028 - 3(35)S	PROJECT LEADER:	J. SCHULTZ	DRAWN BY:	I. DEGUTIS
		DESIGNED BY:	J. GRUCHACZ	CHECKED BY:	J. DEVLIN
		TC PHASE 3 LAYOUT SHEET 1		SHEET	95 OF 142

NOTES:

1. TRAFFIC CONTROL PHASE III SHALL CONSIST OF TEMPORARY ROAD CLOSURE WITH DIVERSION ON US ROUTE 2 AND VT ROUTE 14. REFER TO MUTCD FIGURE 6H-7, ROAD CLOSURE WITH DIVERSION (TYPICAL APPLICATION 7).
2. TEMPORARY LANE OR SHOULDER CLOSURES SHALL BE ALLOWED DURING WORKING HOURS. US ROUTE 2 AND VT 14 SHALL BE RESTORED TO FULL CAPACITY AT THE CLOSE OF DAILY CONSTRUCTION ACTIVITIES.
3. ALL TEMPORARY PAVEMENT MARKINGS SHALL BE INSTALLED AS DENOTED ON TRAFFIC CONTROL LAYOUT SHEETS, AND SHALL BE PAID UNDER CONTRACT ITEM 900.645 (TEMPORARY ROADWAY)
4. ADDITIONAL TRAFFIC CONTROL WARNING SIGNS MAY BE REQUIRED AND SHALL BE INSTALLED AS REQUESTED BY THE RESIDENT ENGINEER PER THE MUTCD. PAYMENT FOR THESE SIGNS, THE REFLECTORIZED PLASTIC DRUMS, ETC., SHALL BE PAID UNDER CONTRACT ITEM 641.10.
5. ACCESS TO RESIDENTIAL DRIVES, COMMERCIAL DRIVES, AND TOWN HIGHWAYS SHALL BE MAINTAINED THROUGHOUT THE PROJECT'S DURATION.

6. NON CRASHWORTHY FEATURES RESULTING FROM CONSTRUCTION ACTIVITIES THAT ARE LOCATED WITHIN THE CLEAR ZONE SHALL BE PROPERLY PROTECTED. ALL TEMPORARY DEVICES SHALL BE NCHRP COMPLIANT AND SHALL BE FURNISHED IN ACCORDANCE WITH SECTION 621. PAYMENT FOR TEMPORARY TRAFFIC BARRIER WILL BE MADE UNDER ITEM NO. 621.95 AND ENERGY ABSORPTION ATTENUATORS WILL BE MADE UNDER ITEM NO. 621.56.
7. IF TEMPORARY BARRIER IS USED, BARRIER ENDS FACING ONCOMING TRAFFIC SHALL BE TAPERED BEYOND THE CLEAR ZONE, OR PROTECTED WITH AN APPROVED END TREATMENT. IF TEMPORARY BARRIER IS TO BE RELOCATED, PAYMENT WILL BE MADE UNDER ITEM NO. 621.95 REMOVE AND RESET TEMPORARY TRAFFIC BARRIER. IF AN ENERGY ABSORPTION ATTENUATOR IS TO BE RELOCATED, IT WILL BE CONSIDERED INCIDENTAL TO ITEM NO. 621.56.
8. AS PER THE DISPLAYED TRAFFIC CONTROL PLAN, THE REMOVAL AND RESETTING OF TEMPORARY TRAFFIC BARRIER IS ONLY ANTICIPATED BETWEEN TRAFFIC CONTROL PHASES.

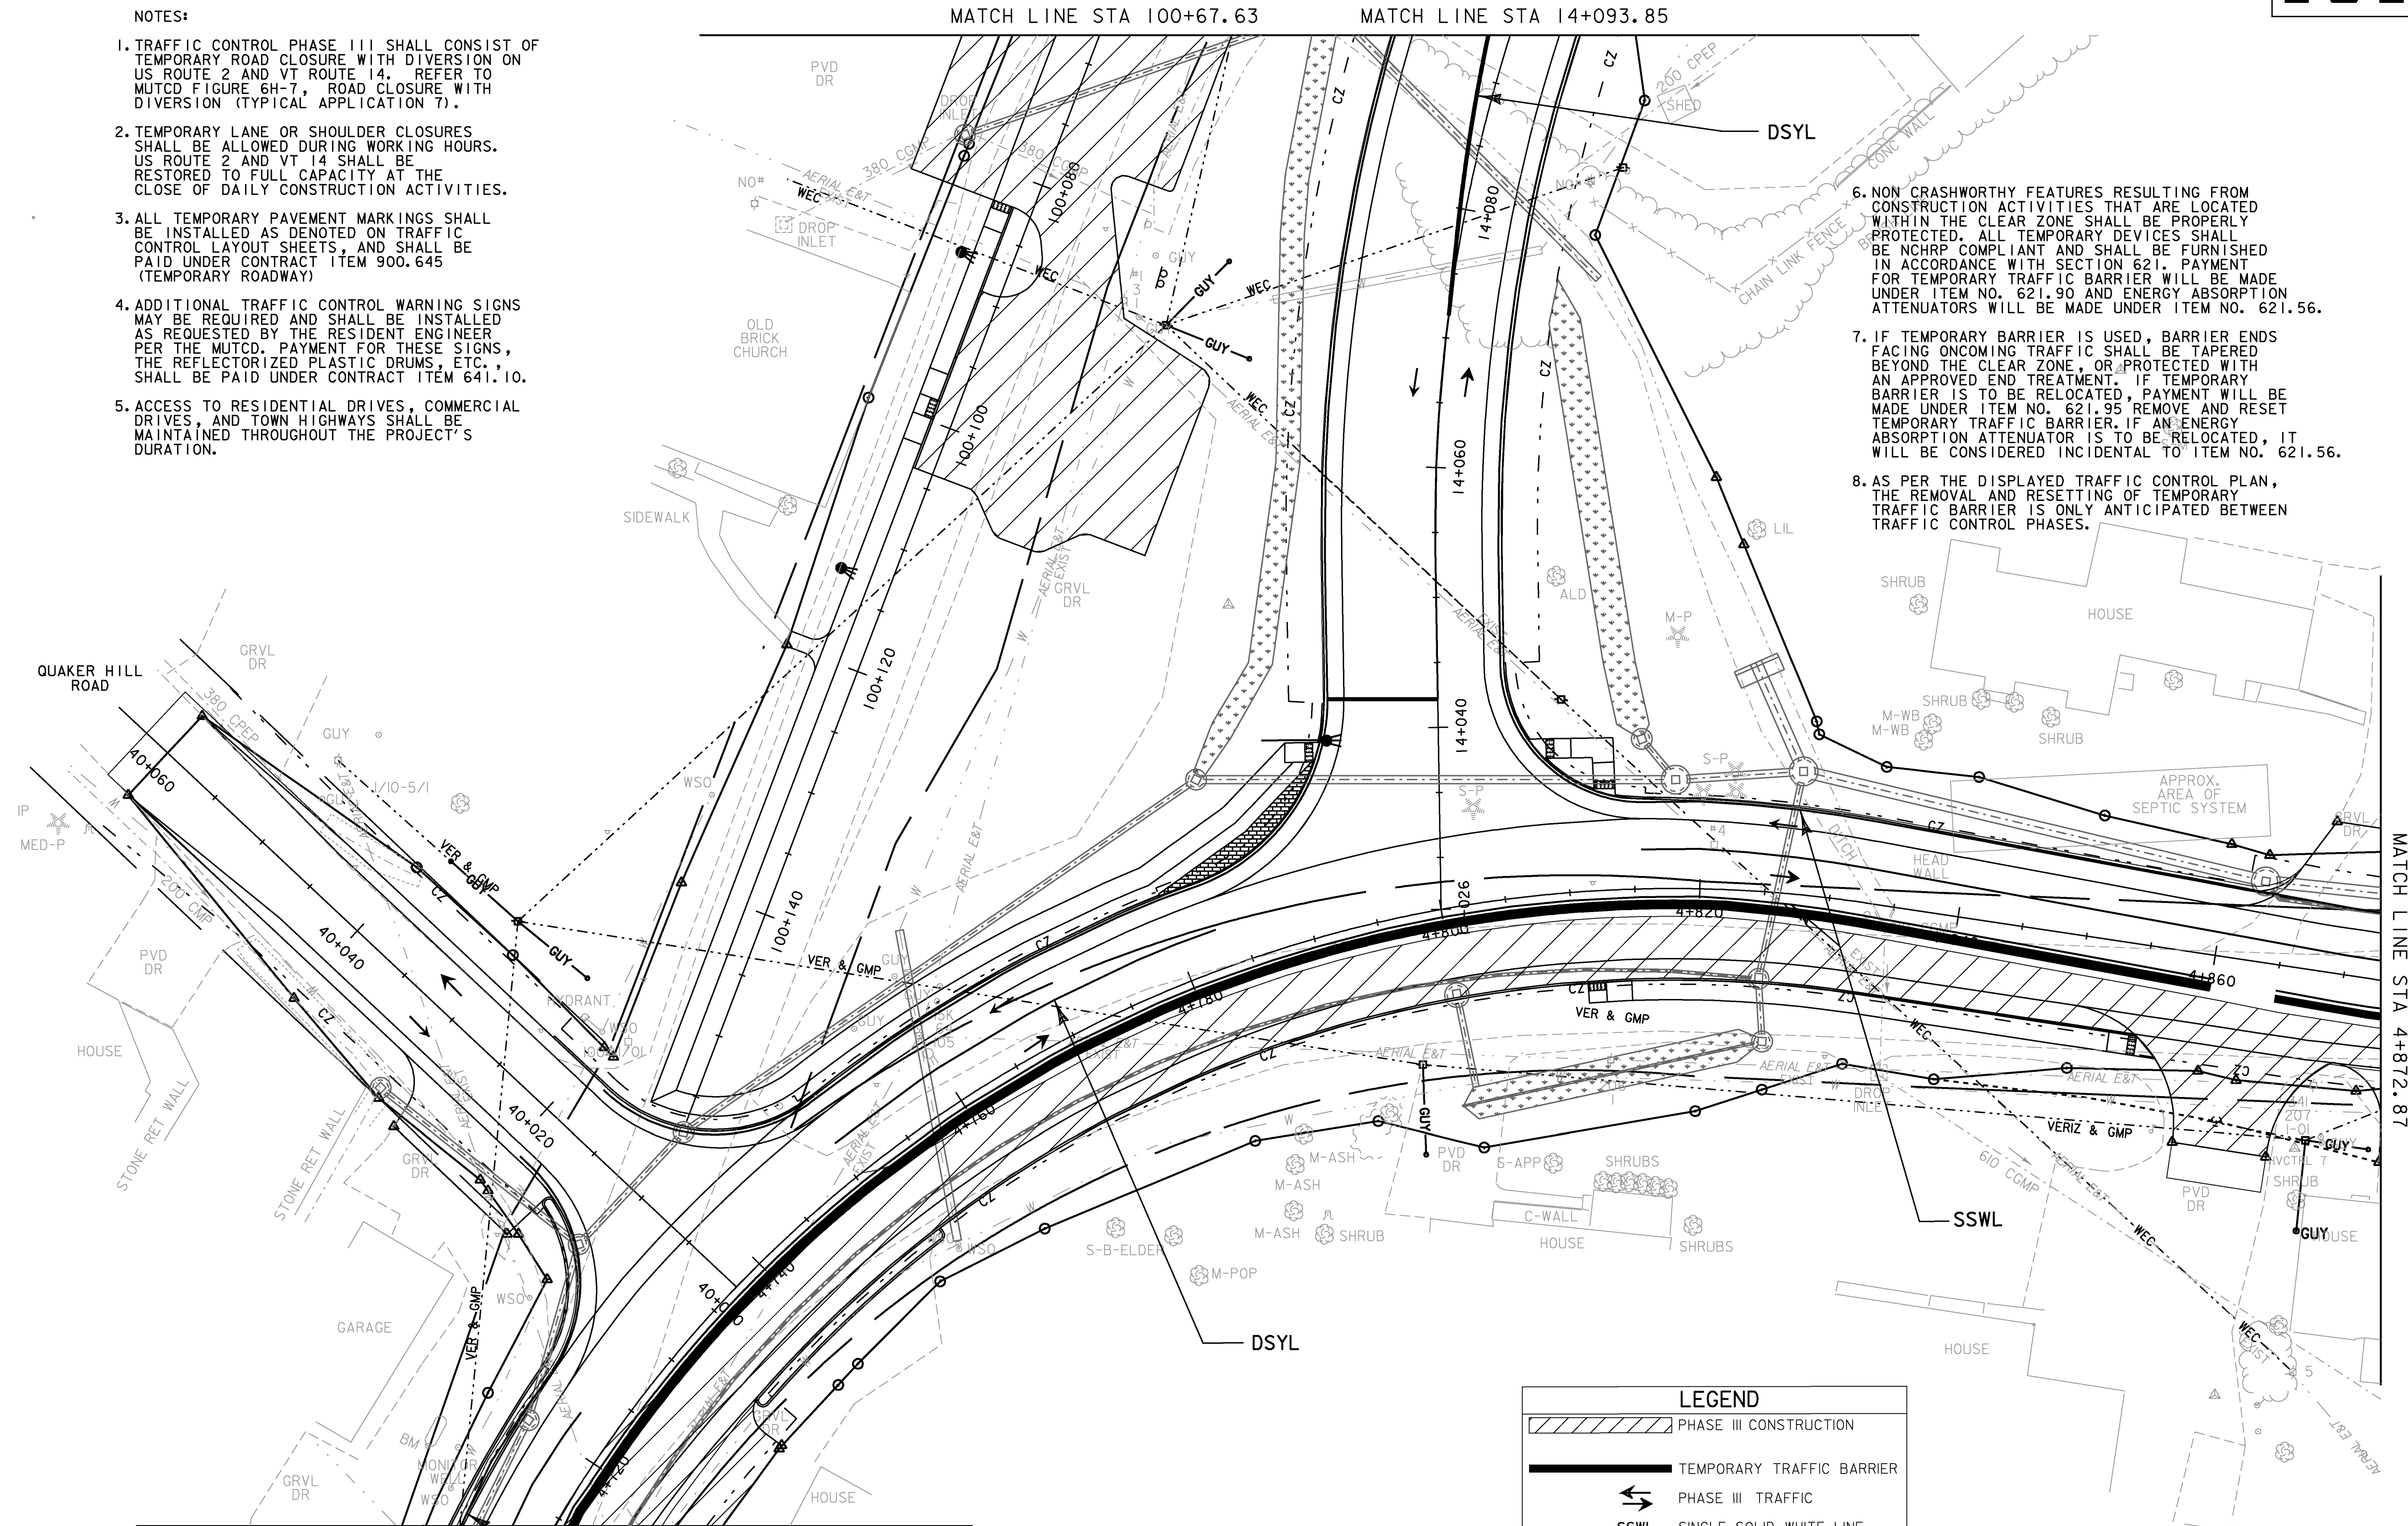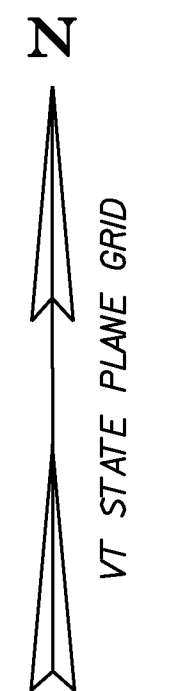

LEGEND	
	PHASE III CONSTRUCTION
	TEMPORARY TRAFFIC BARRIER
	PHASE III TRAFFIC
	SSWL SINGLE SOLID WHITE LINE 100 mm WIDE (PAINT)
	DSYL DOUBLE SOLID YELLOW LINE 100mm WIDE (PAINT)




PROJECT NAME: EAST MONTPELIER
 PROJECT NUMBER: STPG 028 - 3(35)S
 FILE NAME: +98b028+cp3bdr.dgn
 PROJECT LEADER: J. SCHULTZ
 DESIGNED BY: J. GRUCHACZ
 TC PHASE 3 LAYOUT SHEET 2

PLOT DATE: 29-MAR-2010
 DRAWN BY: I. DEGUTIS
 CHECKED BY: J. DEVLIN
 SHEET 96 OF 142

NOTES:

1. TRAFFIC CONTROL PHASE III SHALL CONSIST OF TEMPORARY ROAD CLOSURE WITH DIVERSION ON US ROUTE 2 AND VT ROUTE 14. REFER TO MUTCD FIGURE 6H-7, ROAD CLOSURE WITH DIVERSION (TYPICAL APPLICATION 7).
2. TEMPORARY LANE OR SHOULDER CLOSURES SHALL BE ALLOWED DURING WORKING HOURS. US ROUTE 2 AND VT 14 SHALL BE RESTORED TO FULL CAPACITY AT THE CLOSE OF DAILY CONSTRUCTION ACTIVITIES.
3. ALL TEMPORARY PAVEMENT MARKINGS SHALL BE INSTALLED AS DENOTED ON TRAFFIC CONTROL LAYOUT SHEETS, AND SHALL BE PAID UNDER CONTRACT ITEM 900.645 (TEMPORARY ROADWAY)
4. ADDITIONAL TRAFFIC CONTROL WARNING SIGNS MAY BE REQUIRED AND SHALL BE INSTALLED AS REQUESTED BY THE RESIDENT ENGINEER PER THE MUTCD. PAYMENT FOR THESE SIGNS, THE REFLECTORIZED PLASTIC DRUMS, ETC., SHALL BE PAID UNDER CONTRACT ITEM 641.10.
5. ACCESS TO RESIDENTIAL DRIVES, COMMERCIAL DRIVES, AND TOWN HIGHWAYS SHALL BE MAINTAINED THROUGHOUT THE PROJECT'S DURATION.


6. NON CRASHWORTHY FEATURES RESULTING FROM CONSTRUCTION ACTIVITIES THAT ARE LOCATED WITHIN THE CLEAR ZONE SHALL BE PROPERLY PROTECTED. ALL TEMPORARY DEVICES SHALL BE NCHRP COMPLIANT AND SHALL BE FURNISHED IN ACCORDANCE WITH SECTION 621. PAYMENT FOR TEMPORARY TRAFFIC BARRIER WILL BE MADE UNDER ITEM NO. 621.90 AND ENERGY ABSORPTION ATTENUATORS WILL BE MADE UNDER ITEM NO. 621.56.
7. IF TEMPORARY BARRIER IS USED, BARRIER ENDS FACING ONCOMING TRAFFIC SHALL BE TAPERED BEYOND THE CLEAR ZONE, OR PROTECTED WITH AN APPROVED END TREATMENT. IF TEMPORARY BARRIER IS TO BE RELOCATED, PAYMENT WILL BE MADE UNDER ITEM NO. 621.95 REMOVE AND RESET TEMPORARY TRAFFIC BARRIER. IF AN ENERGY ABSORPTION ATTENUATOR IS TO BE RELOCATED, IT WILL BE CONSIDERED INCIDENTAL TO ITEM NO. 621.56.
8. AS PER THE DISPLAYED TRAFFIC CONTROL PLAN, THE REMOVAL AND RESETTING OF TEMPORARY TRAFFIC BARRIER IS ONLY ANTICIPATED BETWEEN TRAFFIC CONTROL PHASES.

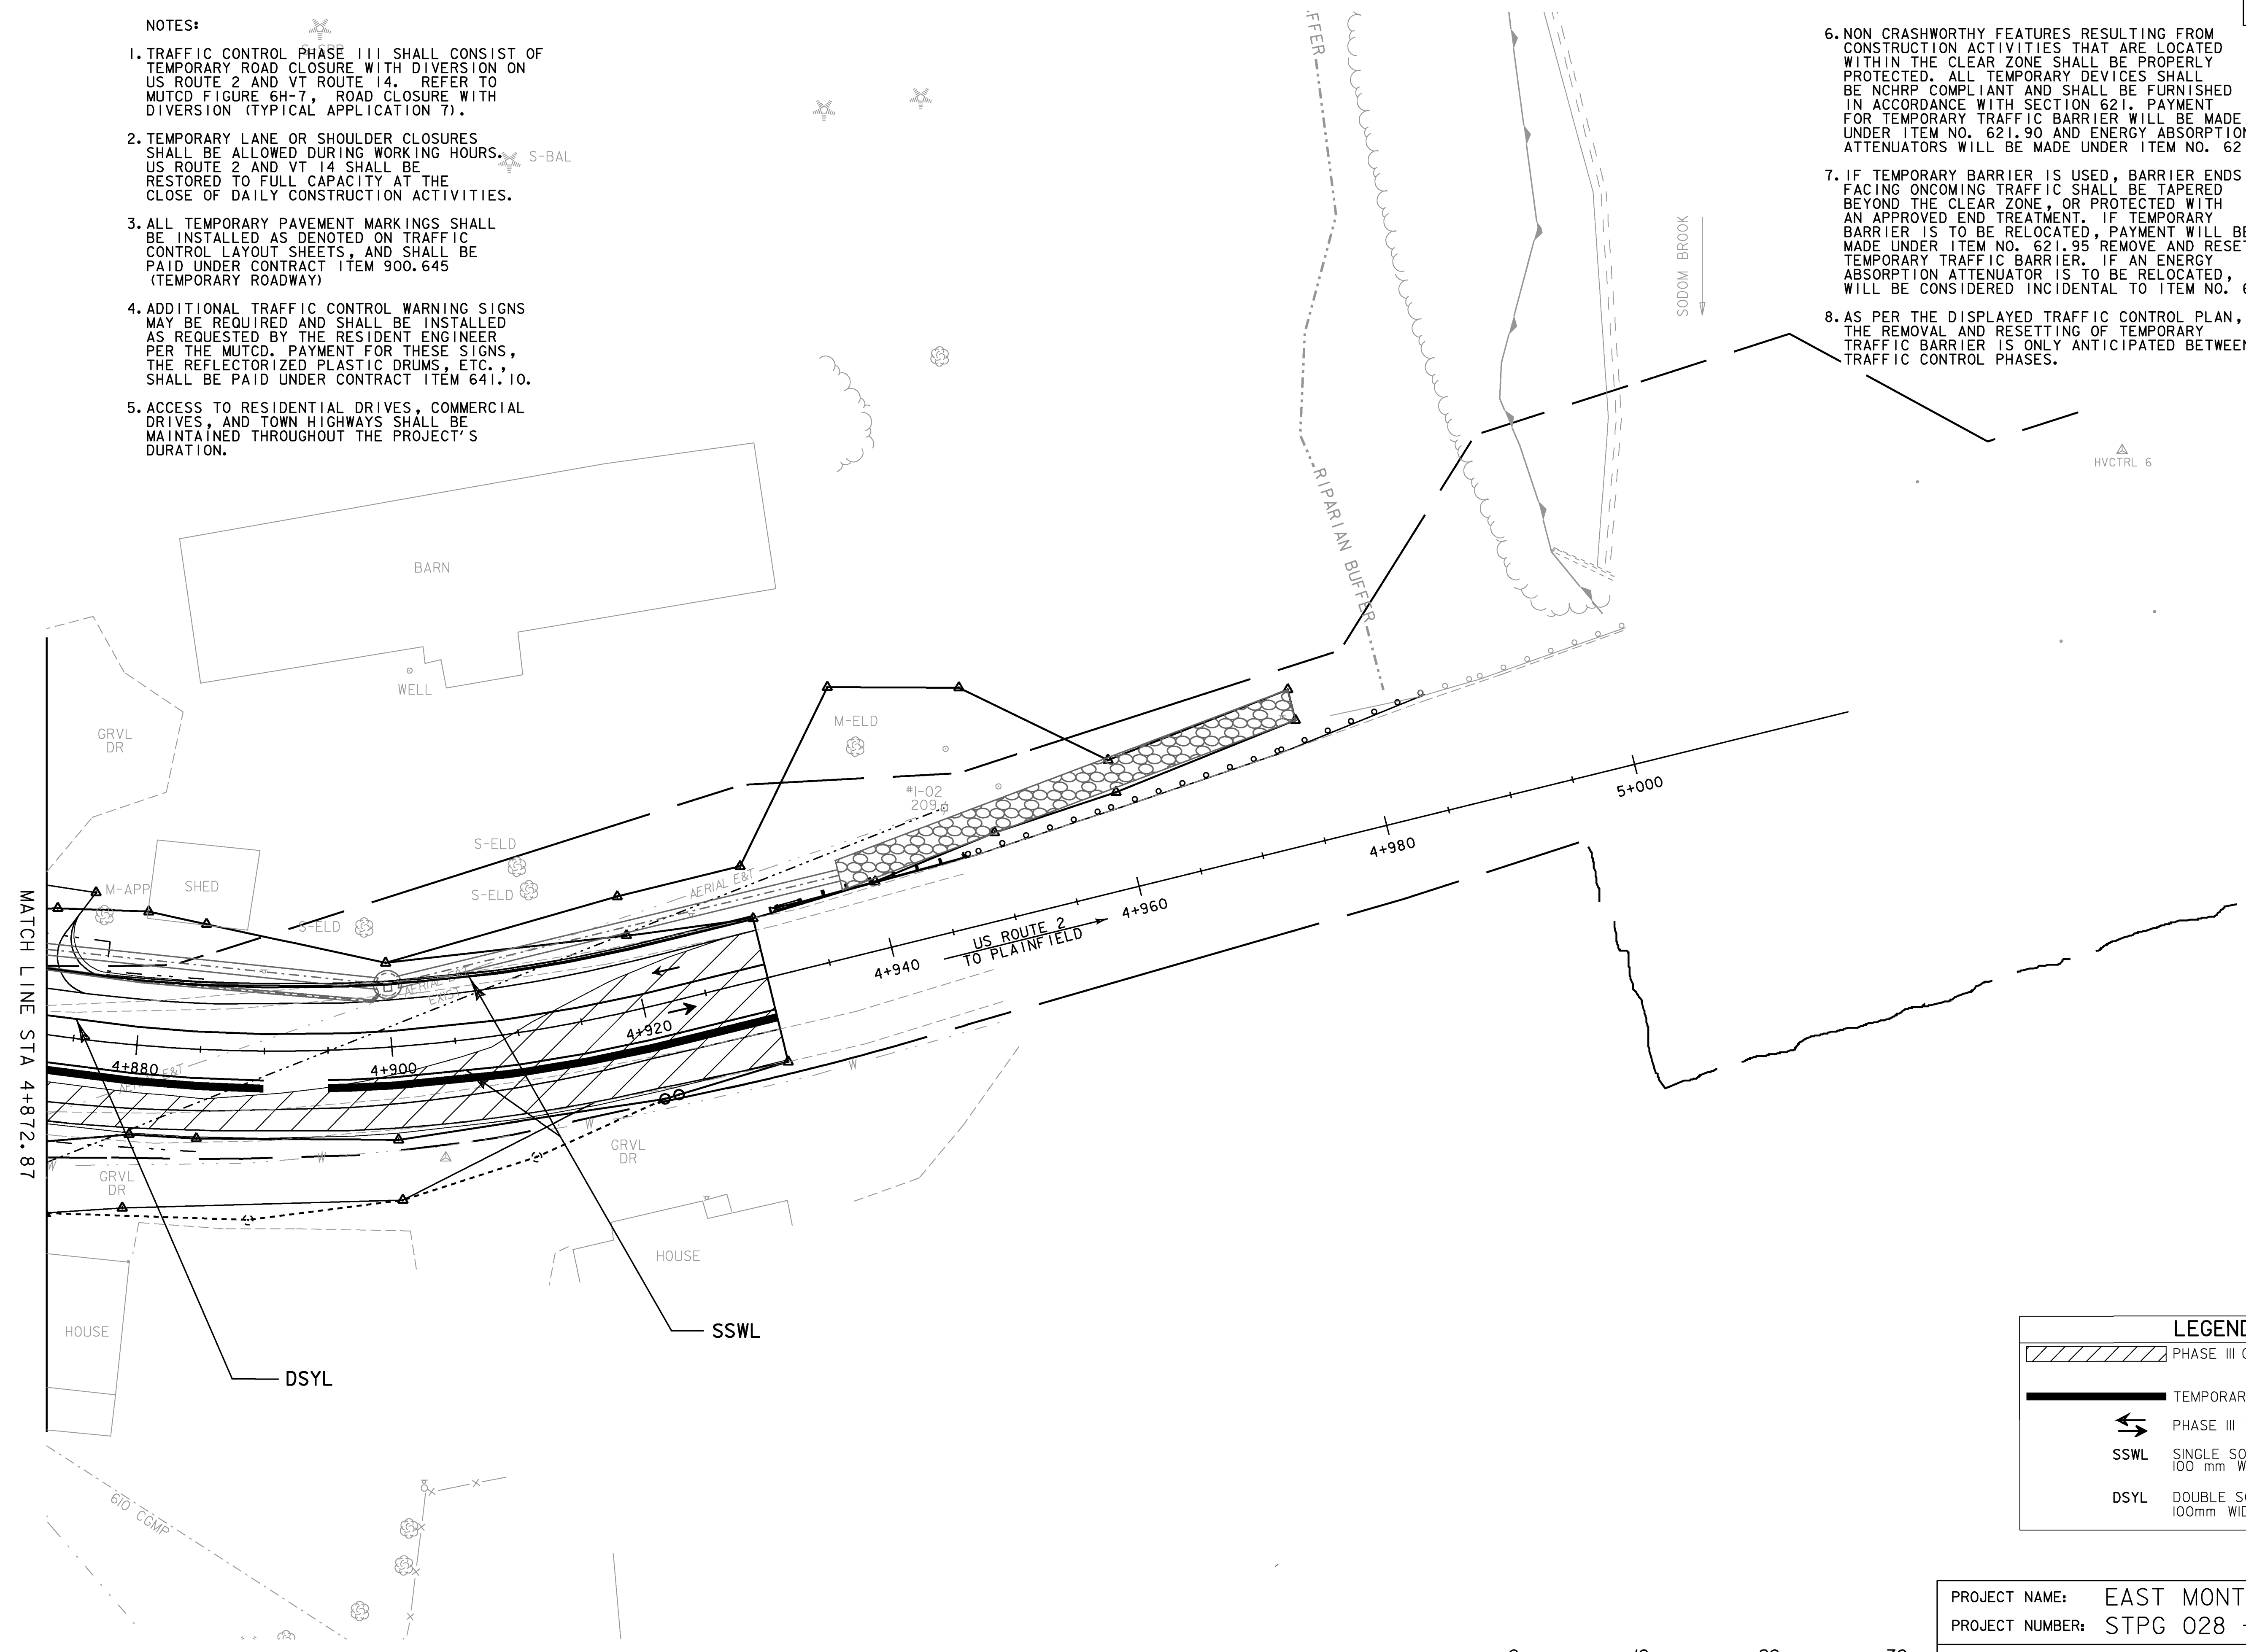


LEGEND	
	PHASE III CONSTRUCTION
	TEMPORARY TRAFFIC BARRIER
	PHASE III TRAFFIC
	SSWL SINGLE SOLID WHITE LINE 100 mm WIDE (PAINT)
	DSYL DOUBLE SOLID YELLOW LINE 100mm WIDE (PAINT)



PROJECT NAME: EAST MONTPELIER
 PROJECT NUMBER: STPG 028 - 3(35)S
 FILE NAME: +98b028+cp3bdr.dgn
 PROJECT LEADER: J. SCHULTZ
 DESIGNED BY: J. GRUCHACZ
 TC PHASE 3 LAYOUT SHEET 3
 PLOT DATE: 29-MAR-2010
 DRAWN BY: I. DEGUTIS
 CHECKED BY: J. DEVLIN
 SHEET 97 OF 142

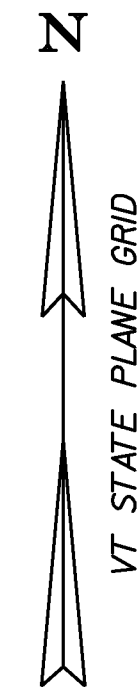

- NOTES:
1. TRAFFIC CONTROL PHASE III SHALL CONSIST OF TEMPORARY ROAD CLOSURE WITH DIVERSION ON US ROUTE 2 AND VT ROUTE 14. REFER TO MUTCD FIGURE 6H-7, ROAD CLOSURE WITH DIVERSION (TYPICAL APPLICATION 7).
 2. TEMPORARY LANE OR SHOULDER CLOSURES SHALL BE ALLOWED DURING WORKING HOURS. US ROUTE 2 AND VT 14 SHALL BE RESTORED TO FULL CAPACITY AT THE CLOSE OF DAILY CONSTRUCTION ACTIVITIES.
 3. ALL TEMPORARY PAVEMENT MARKINGS SHALL BE INSTALLED AS DENOTED ON TRAFFIC CONTROL LAYOUT SHEETS, AND SHALL BE PAID UNDER CONTRACT ITEM 900.645 (TEMPORARY ROADWAY)
 4. ADDITIONAL TRAFFIC CONTROL WARNING SIGNS MAY BE REQUIRED AND SHALL BE INSTALLED AS REQUESTED BY THE RESIDENT ENGINEER PER THE MUTCD. PAYMENT FOR THESE SIGNS, THE REFLECTORIZED PLASTIC DRUMS, ETC., SHALL BE PAID UNDER CONTRACT ITEM 641.10.
 5. ACCESS TO RESIDENTIAL DRIVES, COMMERCIAL DRIVES, AND TOWN HIGHWAYS SHALL BE MAINTAINED THROUGHOUT THE PROJECT'S DURATION.
 6. NON CRASHWORTHY FEATURES RESULTING FROM CONSTRUCTION ACTIVITIES THAT ARE LOCATED WITHIN THE CLEAR ZONE SHALL BE PROPERLY PROTECTED. ALL TEMPORARY DEVICES SHALL BE NCHRP COMPLIANT AND SHALL BE FURNISHED IN ACCORDANCE WITH SECTION 621. PAYMENT FOR TEMPORARY TRAFFIC BARRIER WILL BE MADE UNDER ITEM NO. 621.90 AND ENERGY ABSORPTION ATTENUATORS WILL BE MADE UNDER ITEM NO. 621.56.
 7. IF TEMPORARY BARRIER IS USED, BARRIER ENDS FACING ONCOMING TRAFFIC SHALL BE TAPERED BEYOND THE CLEAR ZONE, OR PROTECTED WITH AN APPROVED END TREATMENT. IF TEMPORARY BARRIER IS TO BE RELOCATED, PAYMENT WILL BE MADE UNDER ITEM NO. 621.95 REMOVE AND RESET TEMPORARY TRAFFIC BARRIER. IF AN ENERGY ABSORPTION ATTENUATOR IS TO BE RELOCATED, IT WILL BE CONSIDERED INCIDENTAL TO ITEM NO. 621.56.
 8. AS PER THE DISPLAYED TRAFFIC CONTROL PLAN, THE REMOVAL AND RESETTING OF TEMPORARY TRAFFIC BARRIER IS ONLY ANTICIPATED BETWEEN TRAFFIC CONTROL PHASES.

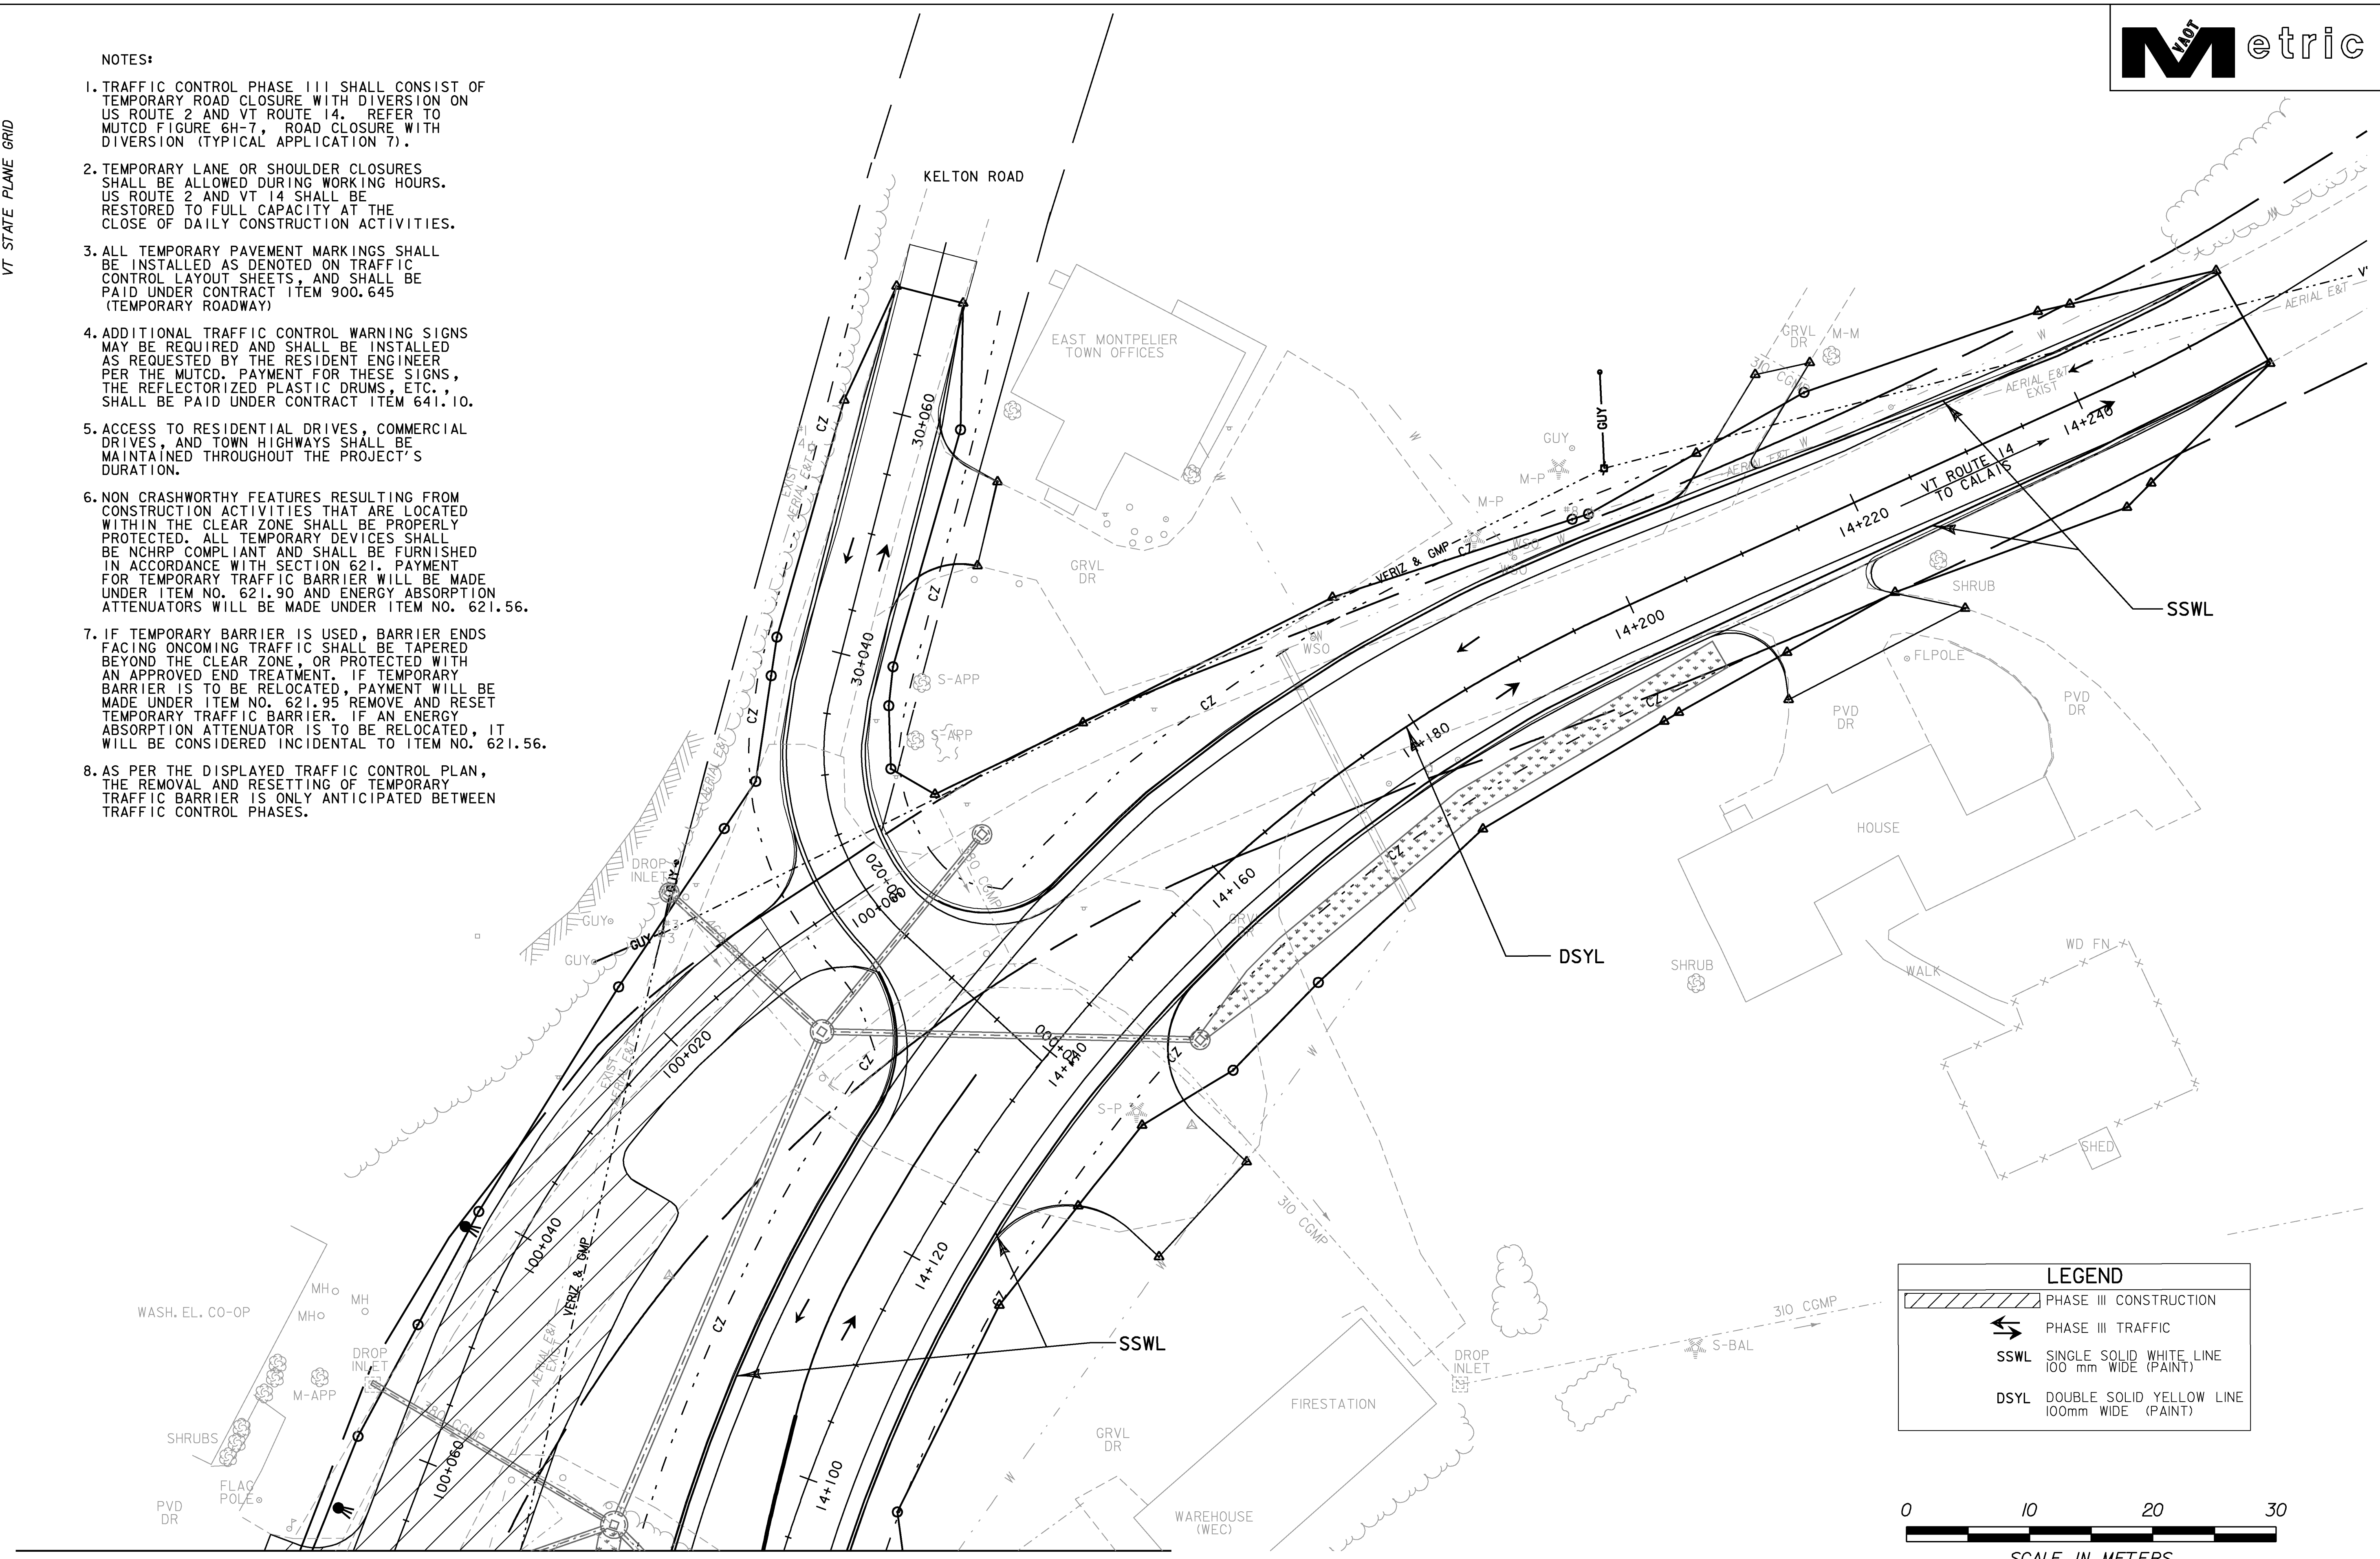


LEGEND	
	PHASE III CONSTRUCTION
	PHASE III TRAFFIC
	SSWL SINGLE SOLID WHITE LINE 100 mm WIDE (PAINT)
	DSYL DOUBLE SOLID YELLOW LINE 100mm WIDE (PAINT)




MATCH LINE STA 100+67.63 MATCH LINE STA 14+093.85


PROJECT NAME: EAST MONTPELIER
 PROJECT NUMBER: STPG 028 - 3(35)S
 FILE NAME: +98b028+cp3bdr.dgn PLOT DATE: 29-MAR-2010
 PROJECT LEADER: J. SCHULTZ DRAWN BY: I. DEGUTIS
 DESIGNED BY: J. GRUCHACZ CHECKED BY: J. DEVLIN
 TC PHASE 3 LAYOUT SHEET 4 SHEET 98 OF 142

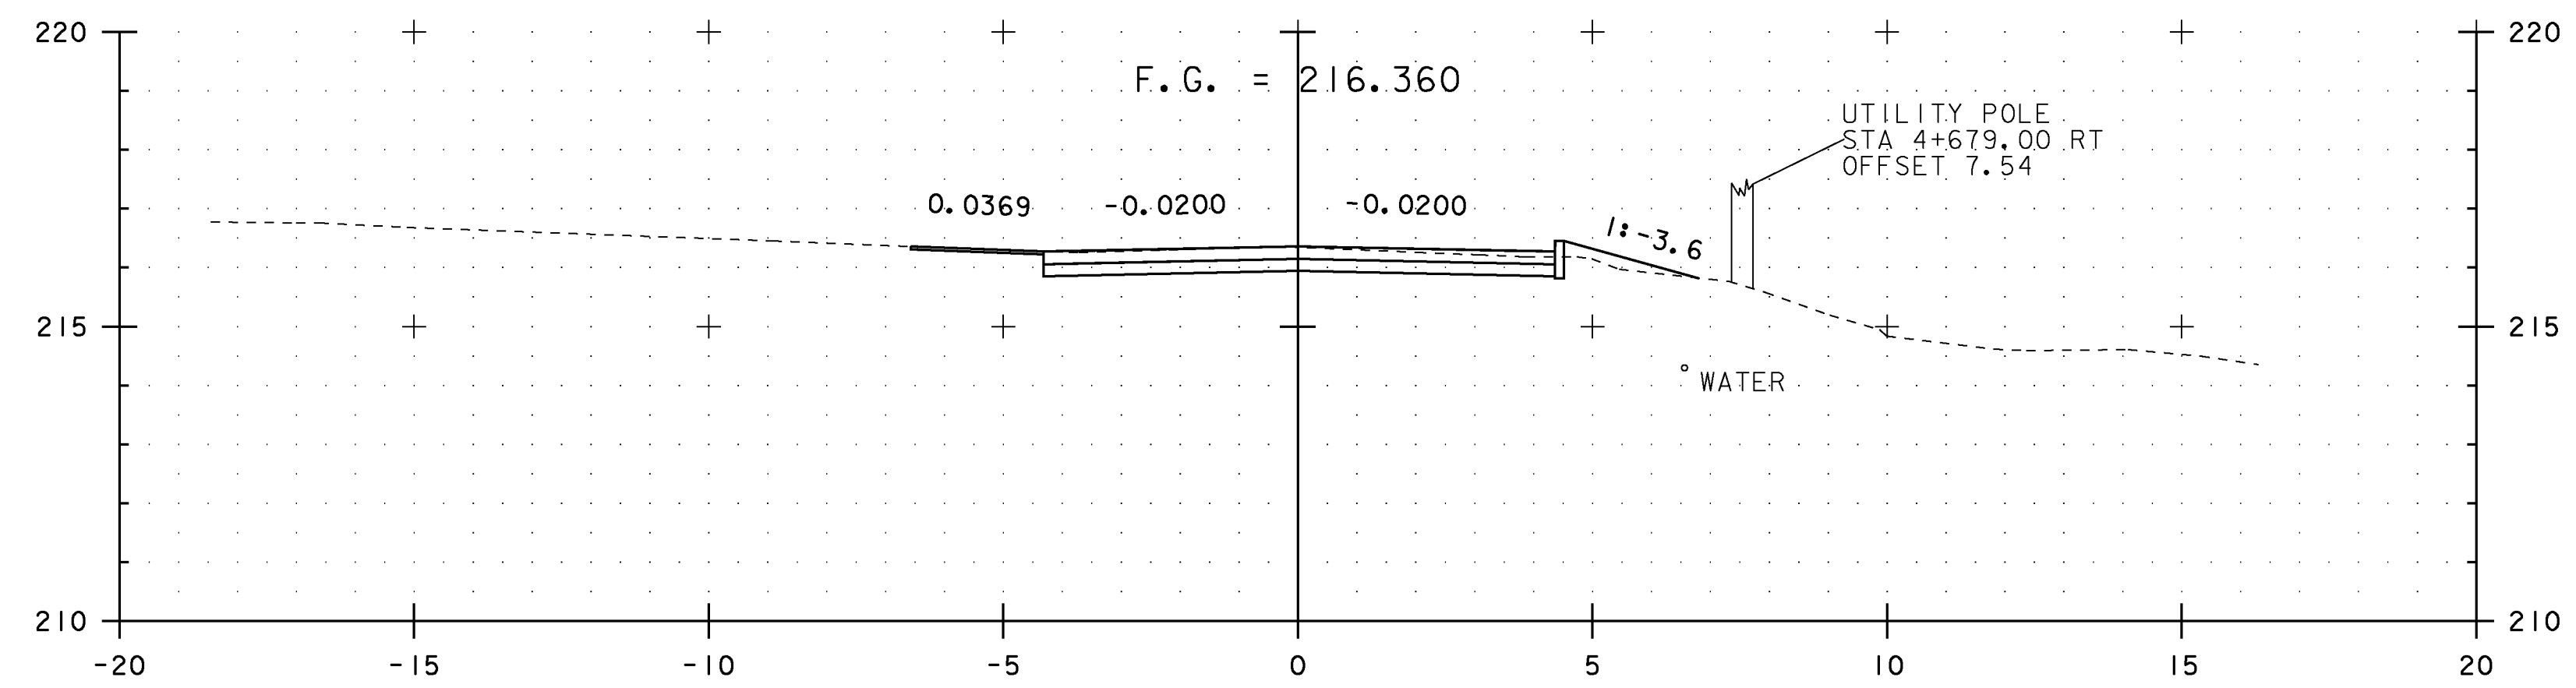


4+680.00

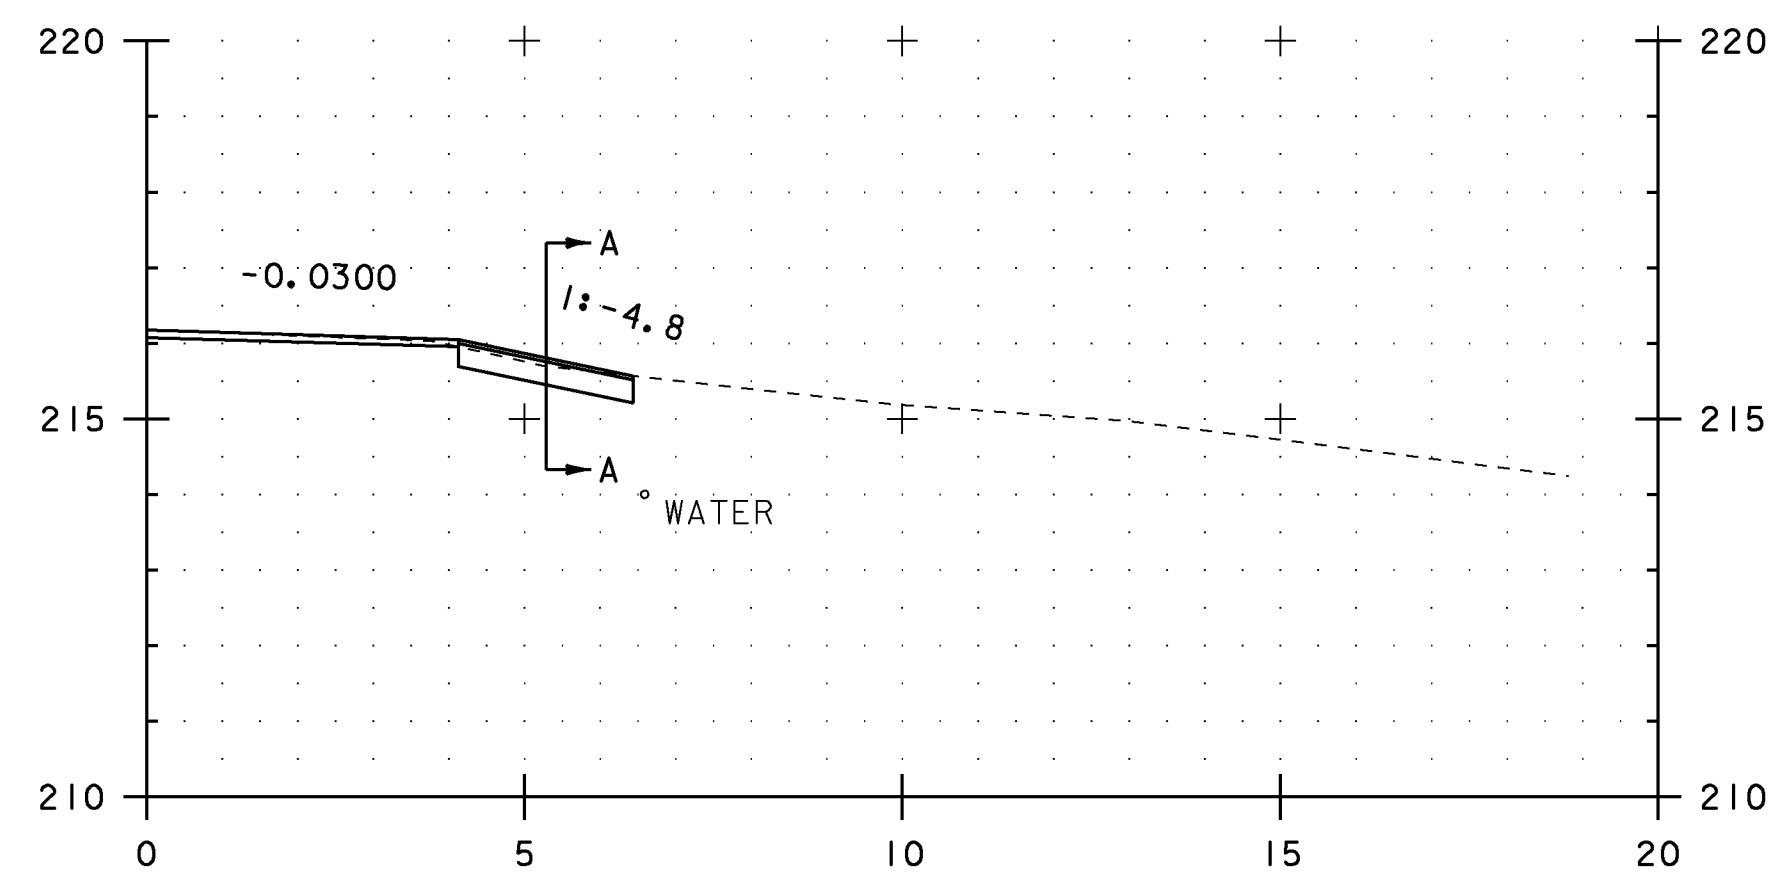

4+672.00
PAVED DRIVE RT

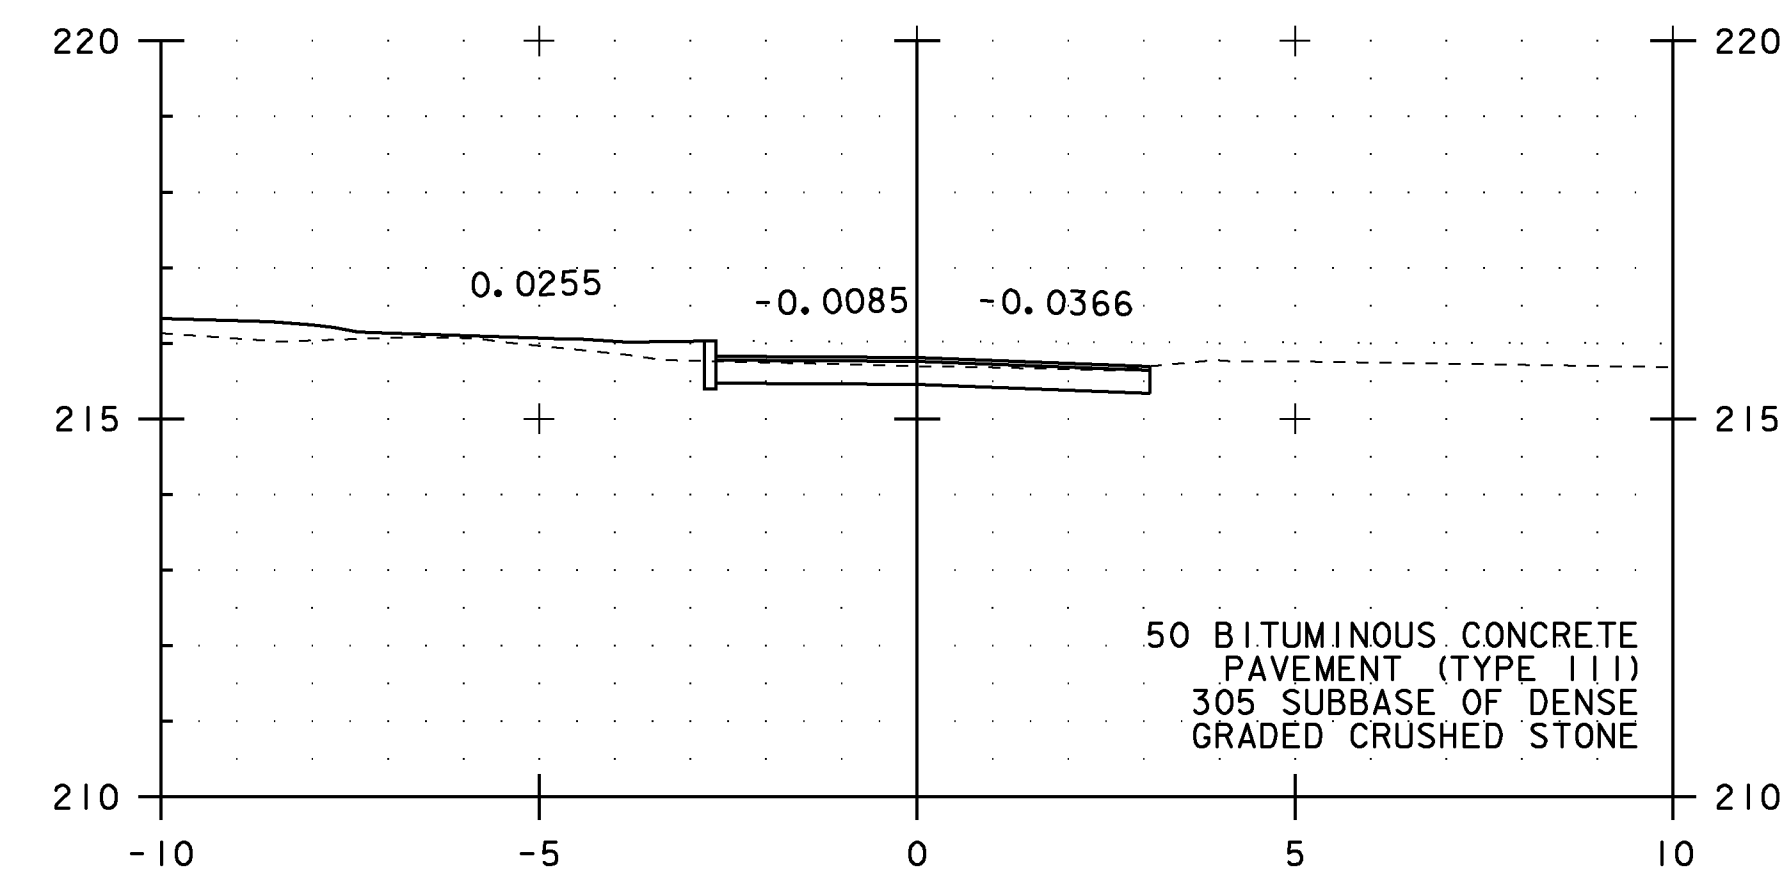

SECTION A-A

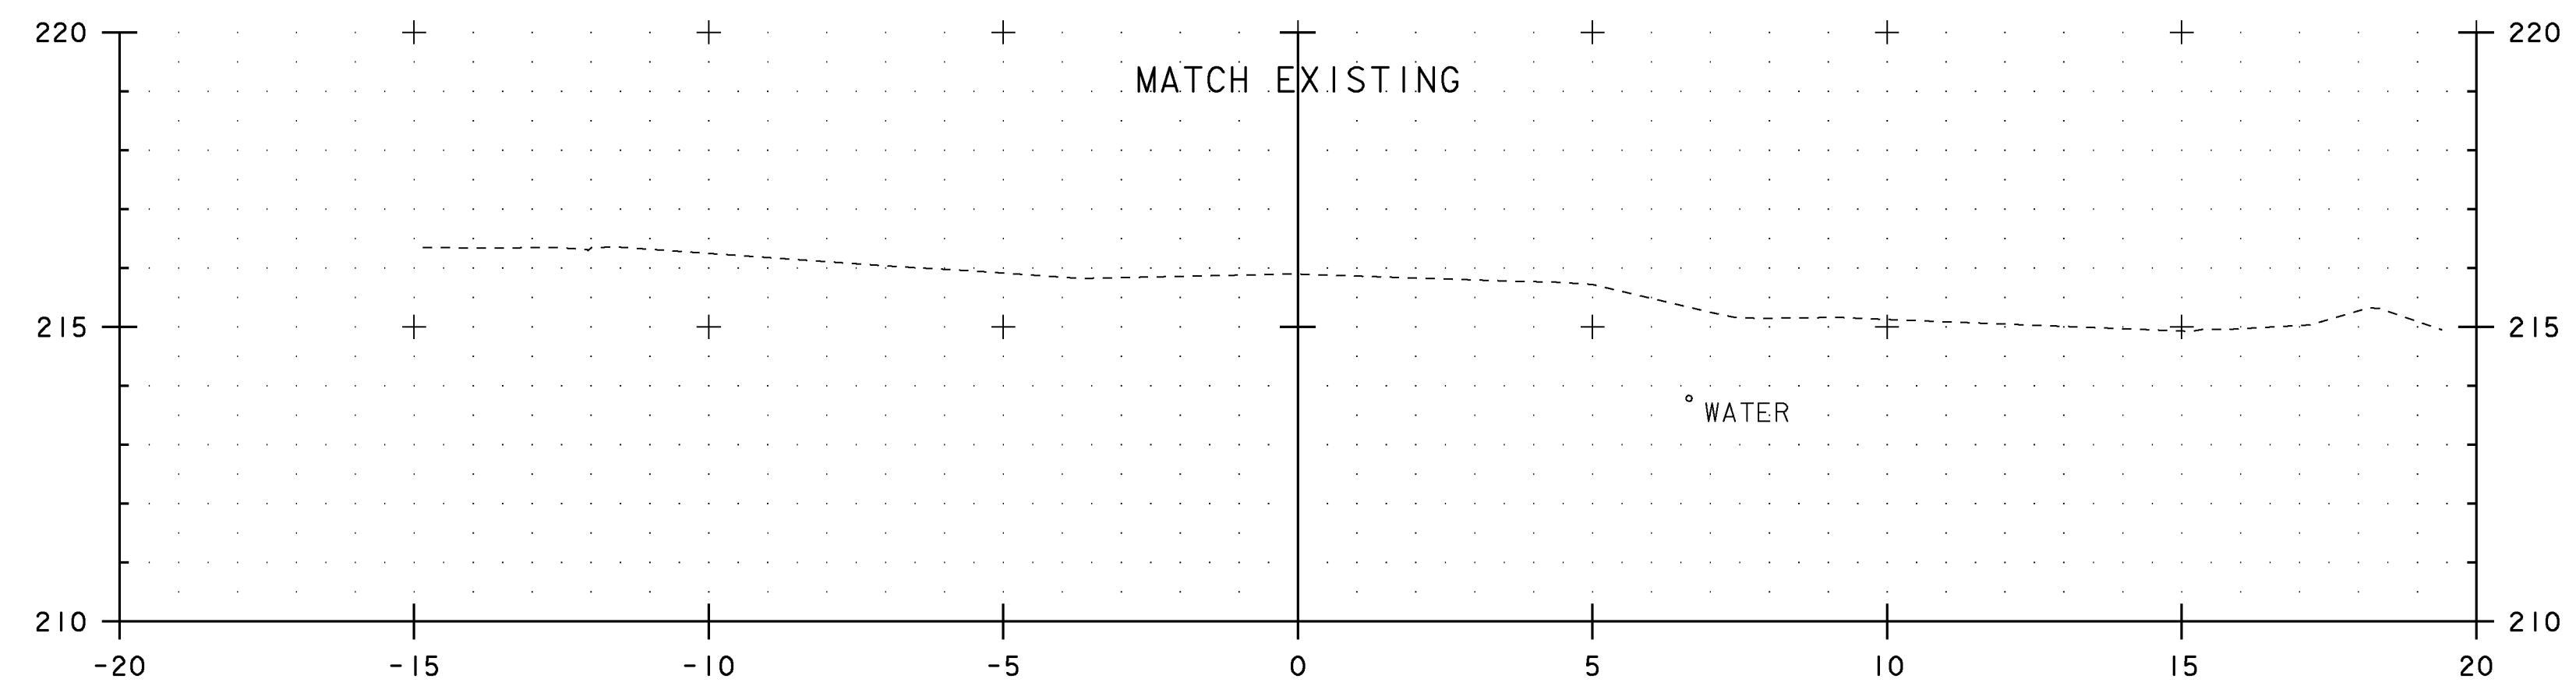

4+660.00
BEGIN APPROACH



NOTES:


1. ALL BURIED UTILITIES ARE EXISTING, THE LOCATIONS ARE APPROXIMATE AND ARE TO REMAIN UNDISTURBED
2. DRAINAGE FEATURES DISPLAYED ON CROSS SECTIONS ARE PROJECTED. SEE DRAINAGE DETAIL SHEETS, LAYOUTS AND PROFILES FOR TRUE LOCATIONS

PROJECT NAME: EAST MONTPELIER
PROJECT NUMBER: STPG 028 - 3(35)S


FILE NAME: +98b028xsl.dgn
PROJECT LEADER: J. SCHULTZ
DESIGNED BY: J. GRUCHACZ
US ROUTE 2 CROSS SECTION SHEET 1

PLOT DATE: 22-MAR-2010
DRAWN BY: D. LYMAN
CHECKED BY: J. DEVLIN
SHEET 99 OF 142


STA. 4+660 TO STA. 4+680

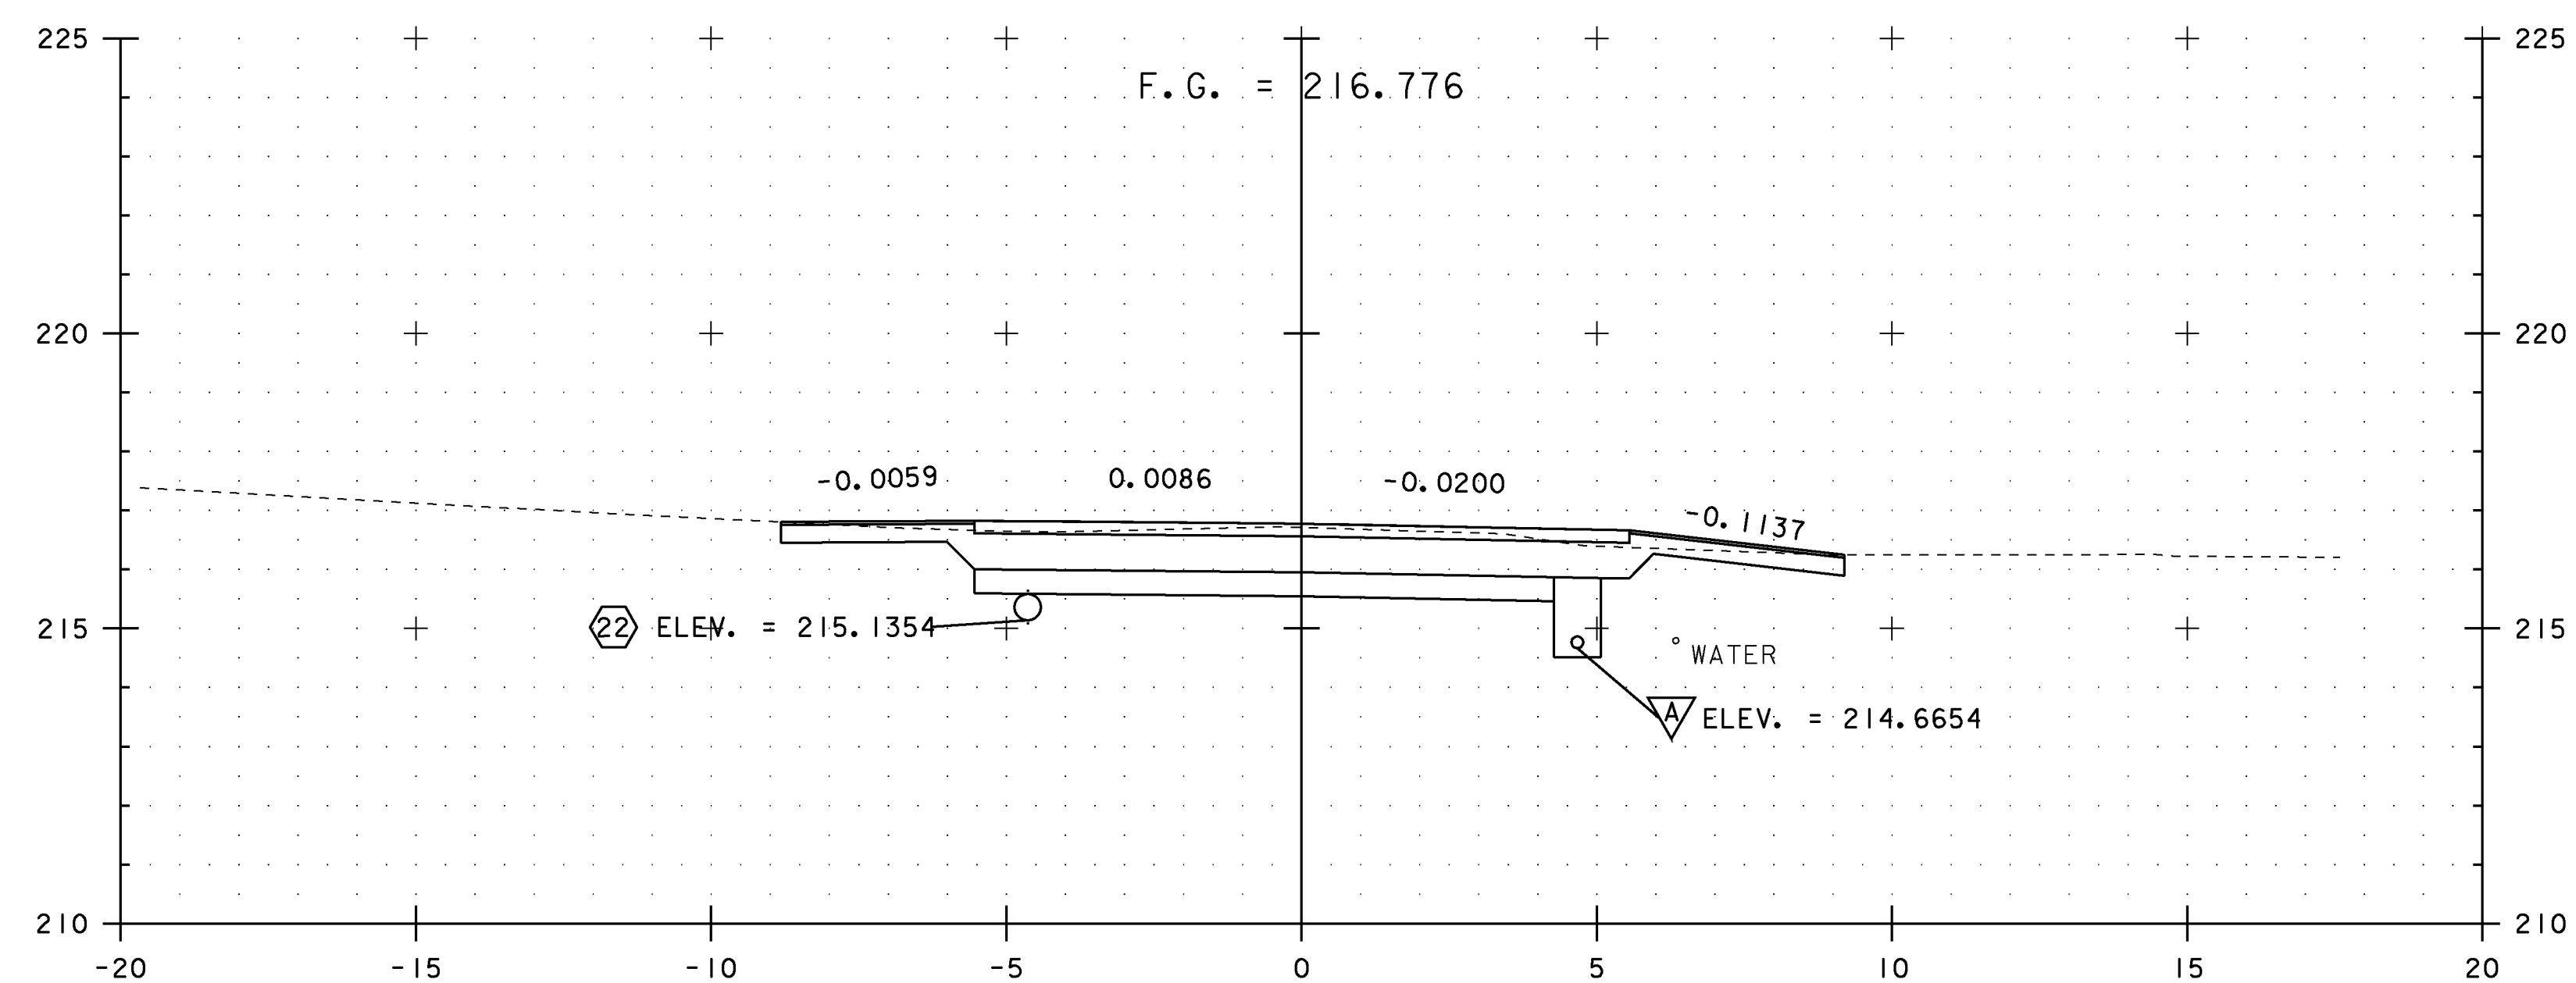


4+700.00

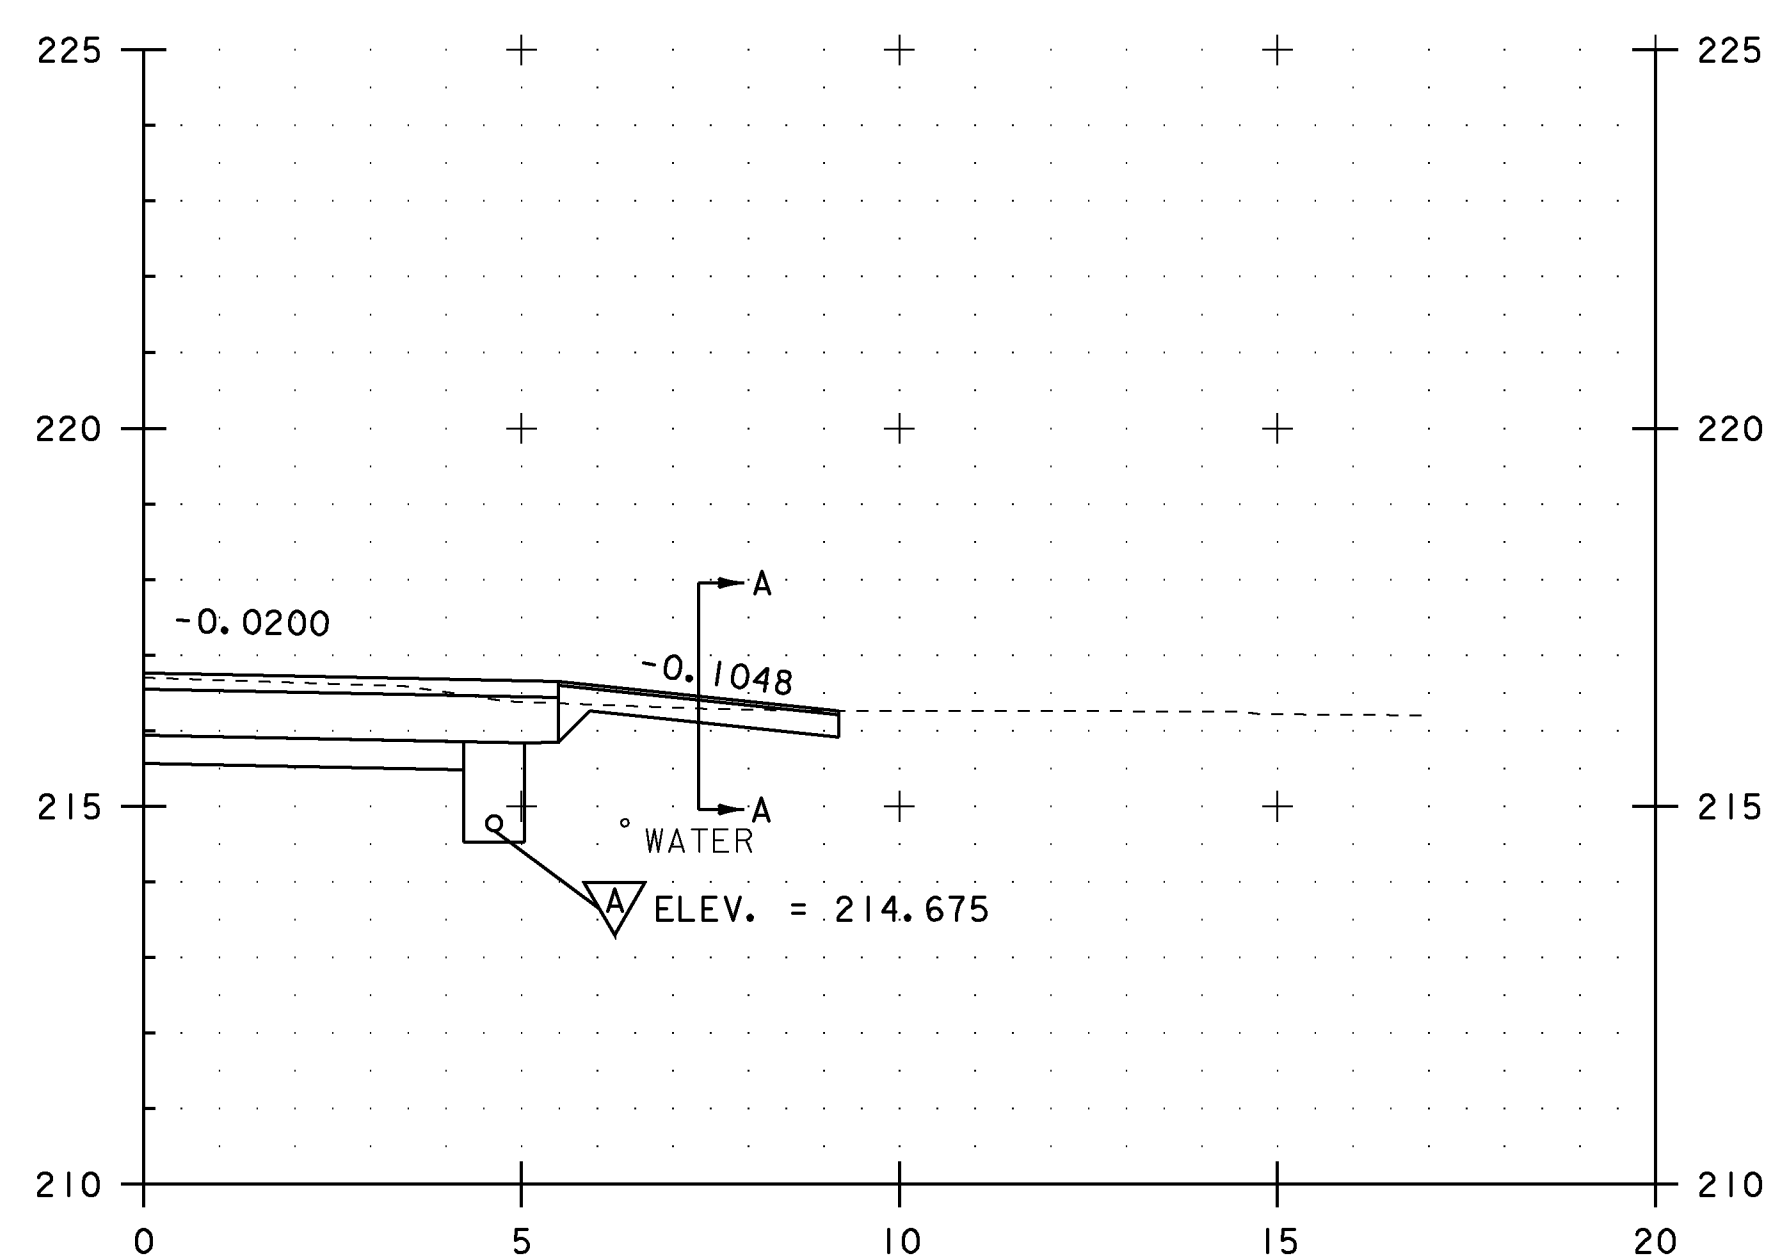

4+699.00
PAVED DRIVE RT

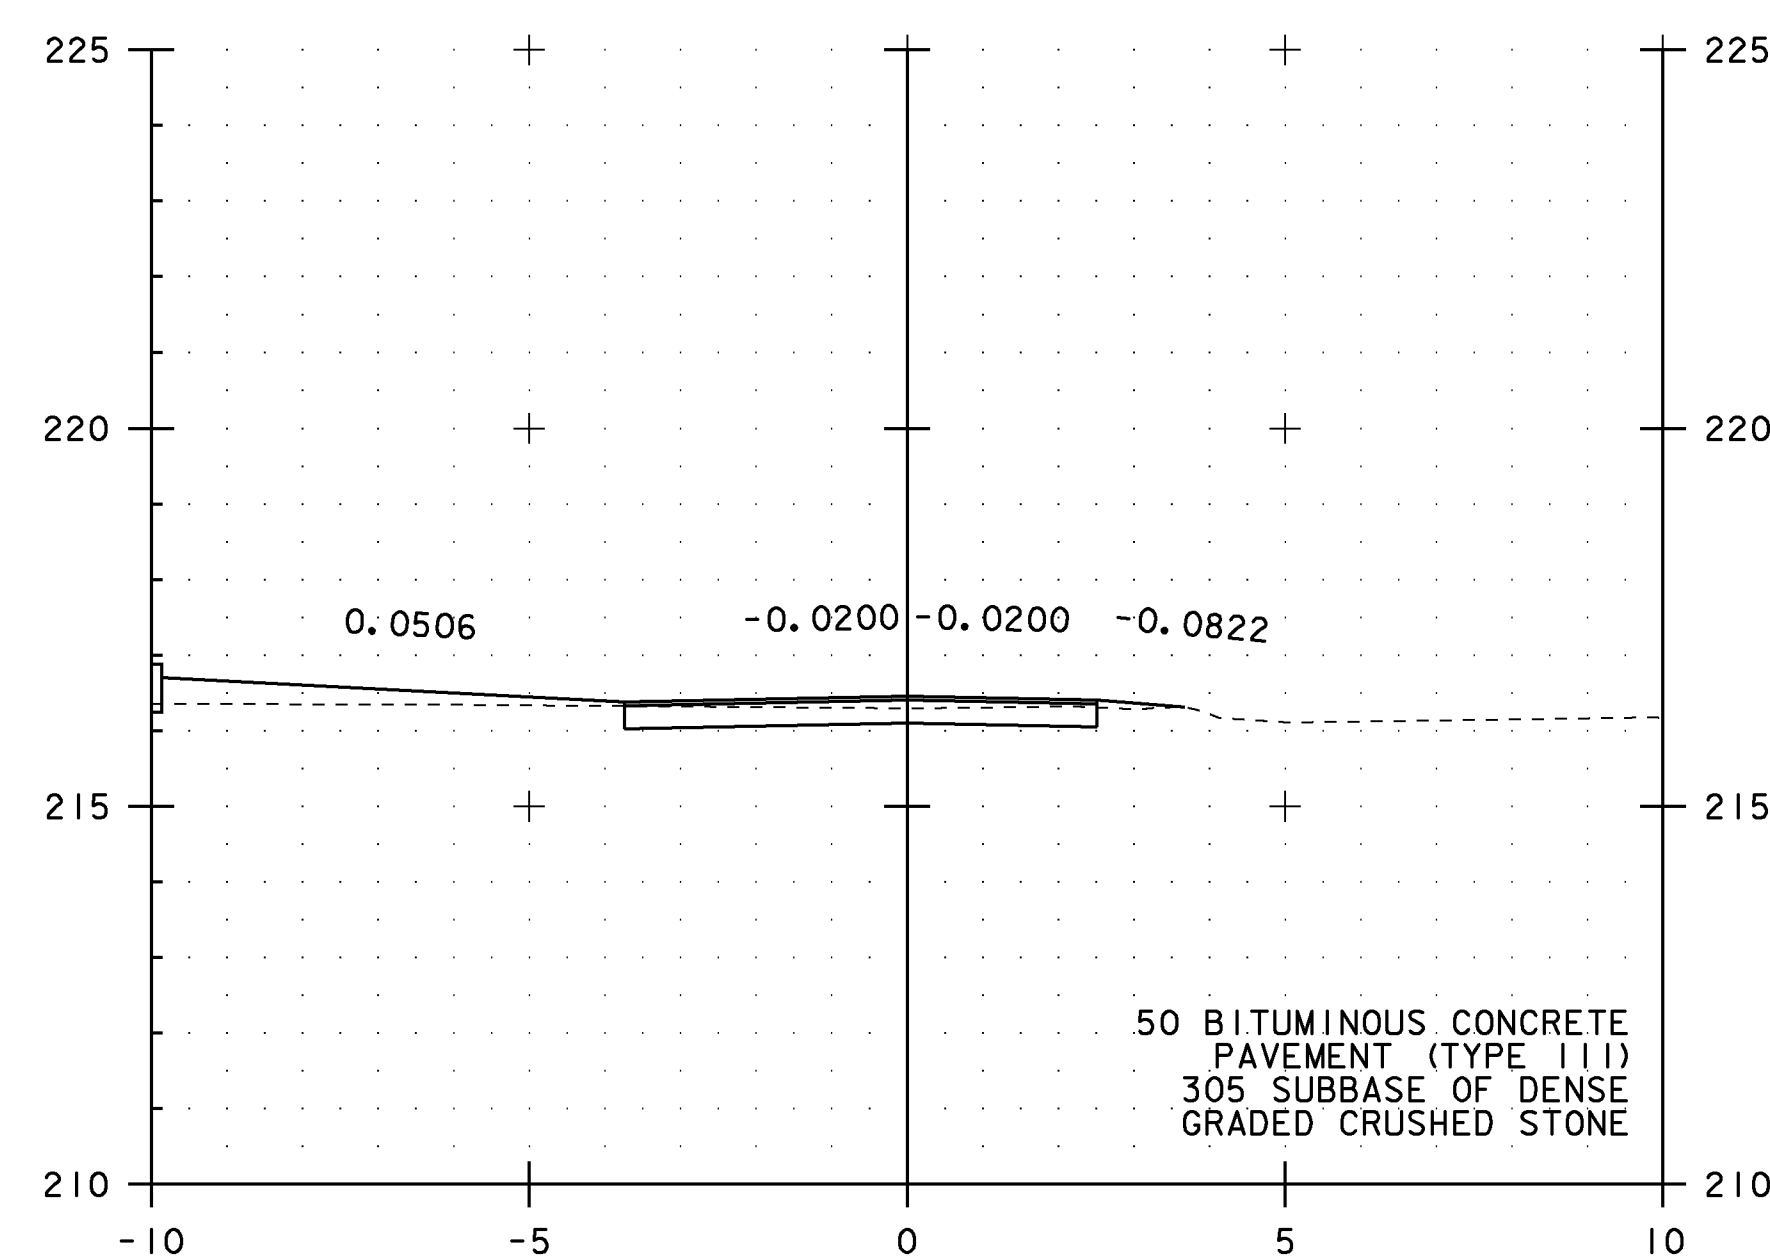

SECTION A-A

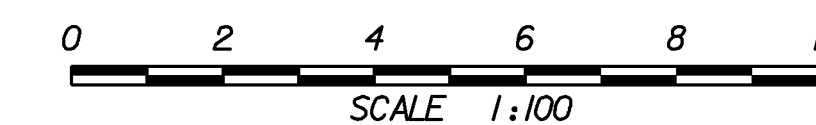




NOTES:

1. ALL BURIED UTILITIES ARE EXISTING, THE LOCATIONS ARE APPROXIMATE AND ARE TO REMAIN UNDISTURBED
2. DRAINAGE FEATURES DISPLAYED ON CROSS SECTIONS ARE PROJECTED. SEE DRAINAGE DETAIL SHEETS, LAYOUTS AND PROFILES FOR TRUE LOCATIONS

STA. 4+699 TO STA. 4+700

PROJECT NAME: EAST MONTPELIER
PROJECT NUMBER: STPG 028 - 3(35)S

FILE NAME: +98b028xsl.dgn
 PROJECT LEADER: J. SCHULTZ
 DESIGNED BY: J. GRUCHACZ
 US ROUTE 2 CROSS SECTION SHEET 2
 PLOT DATE: 22-MAR-2010
 DRAWN BY: D. LYMAN
 CHECKED BY: J. DEVLIN
 SHEET 100 OF 142

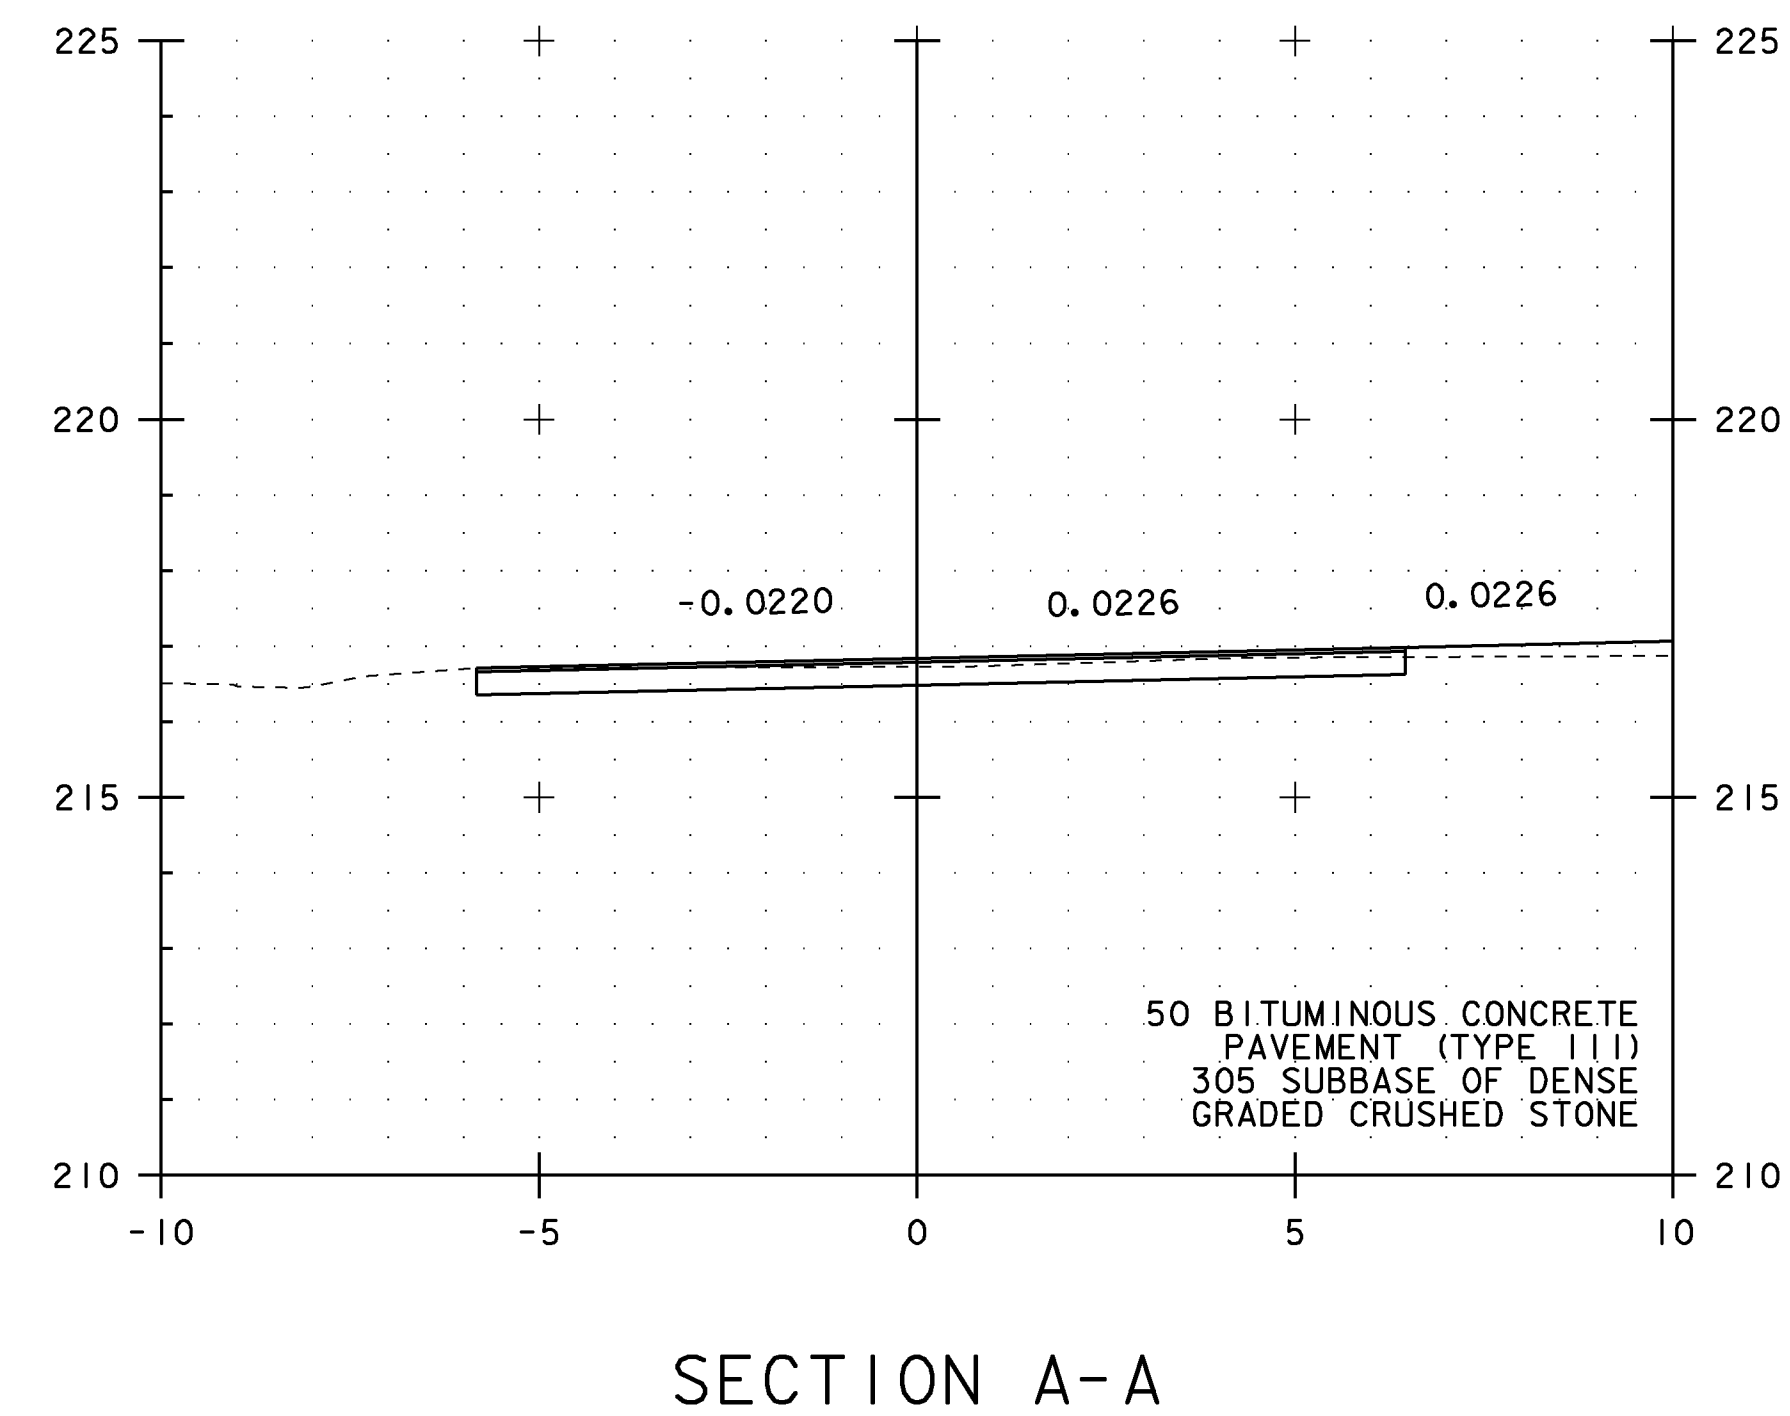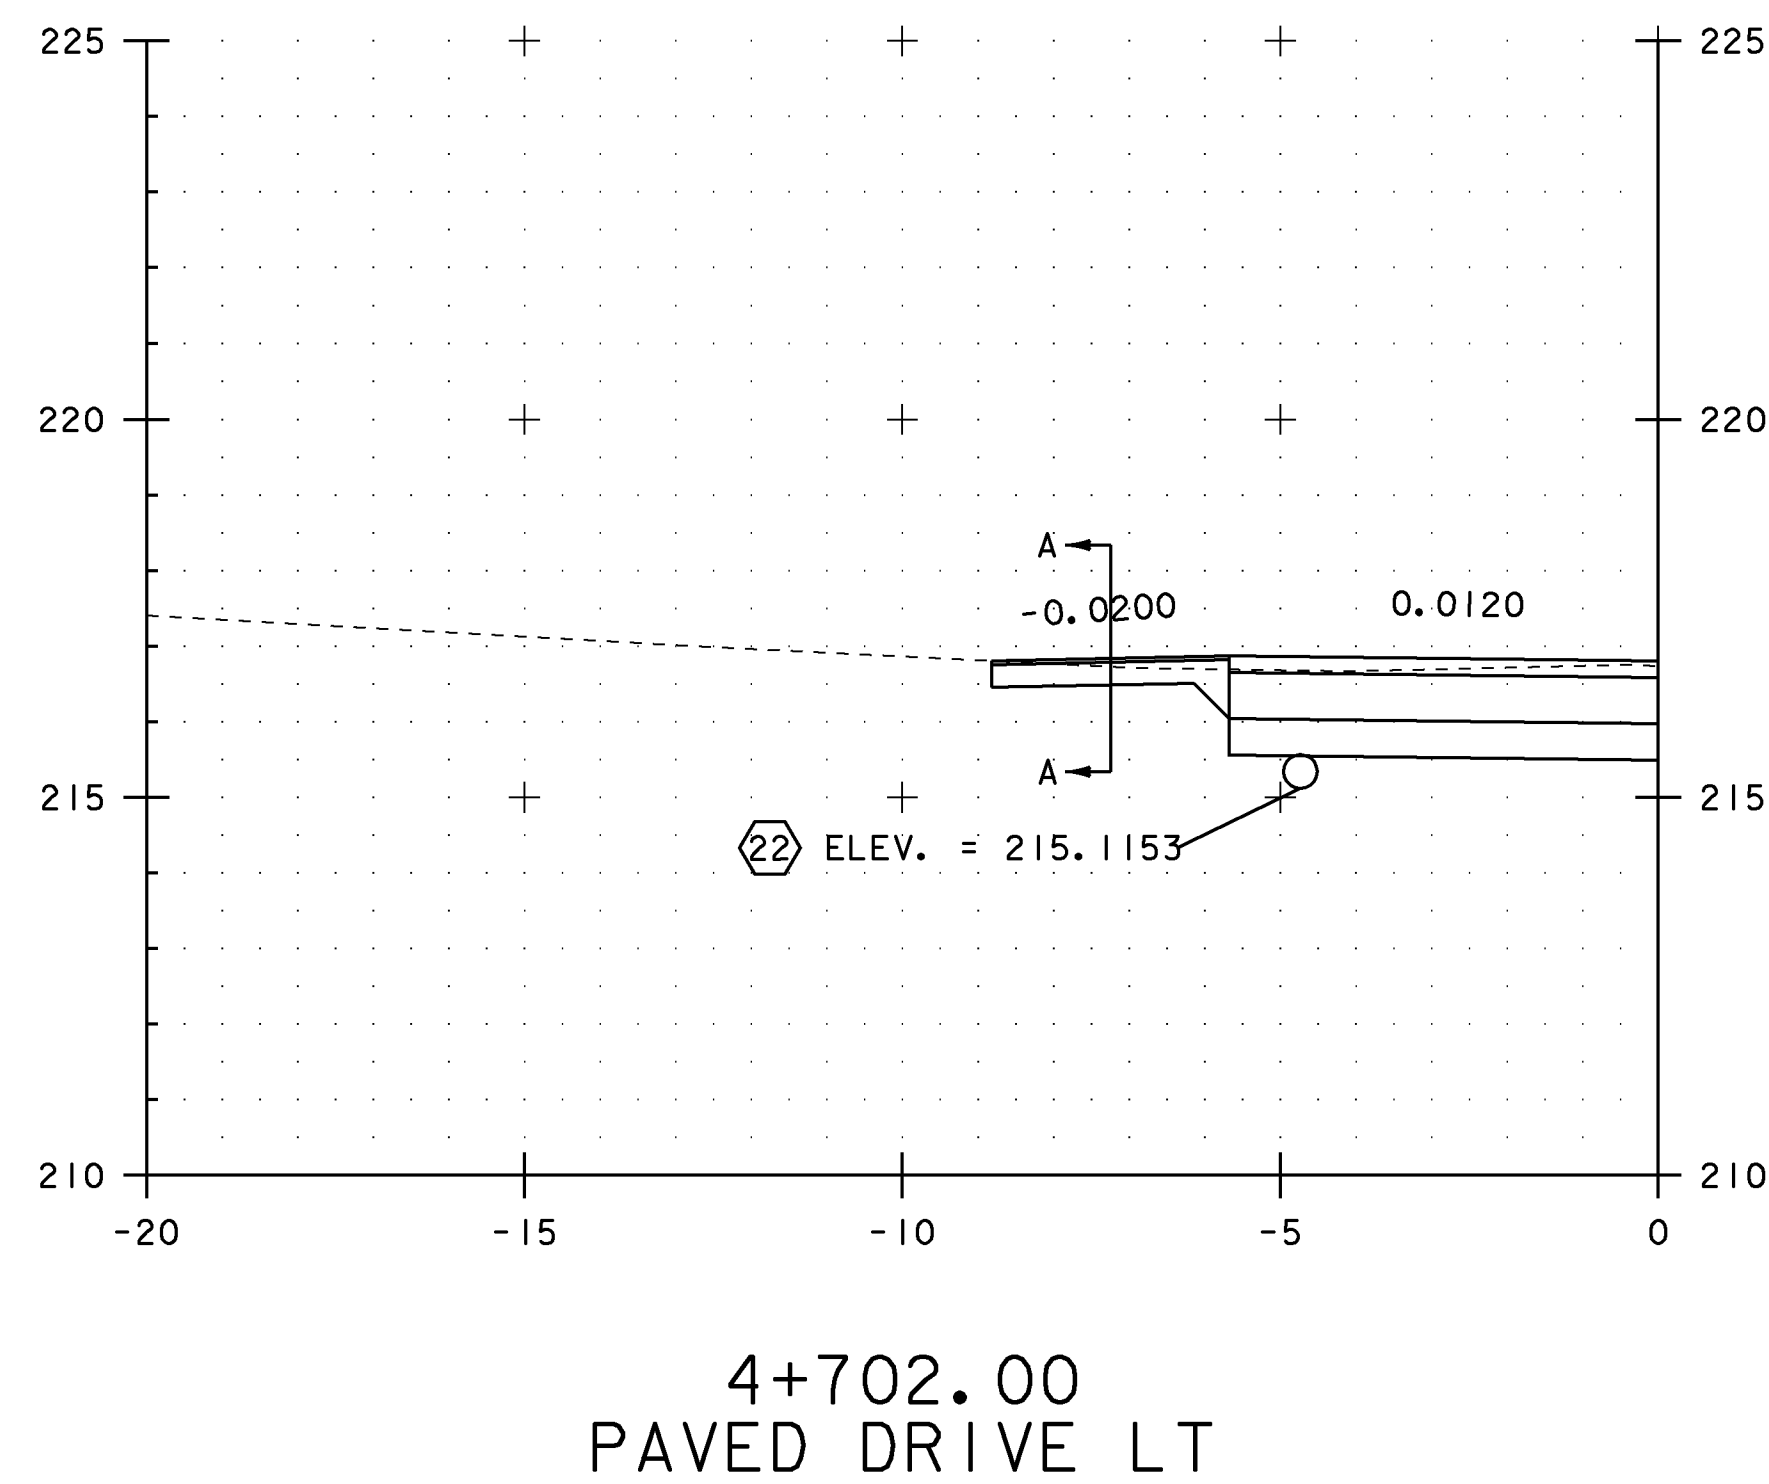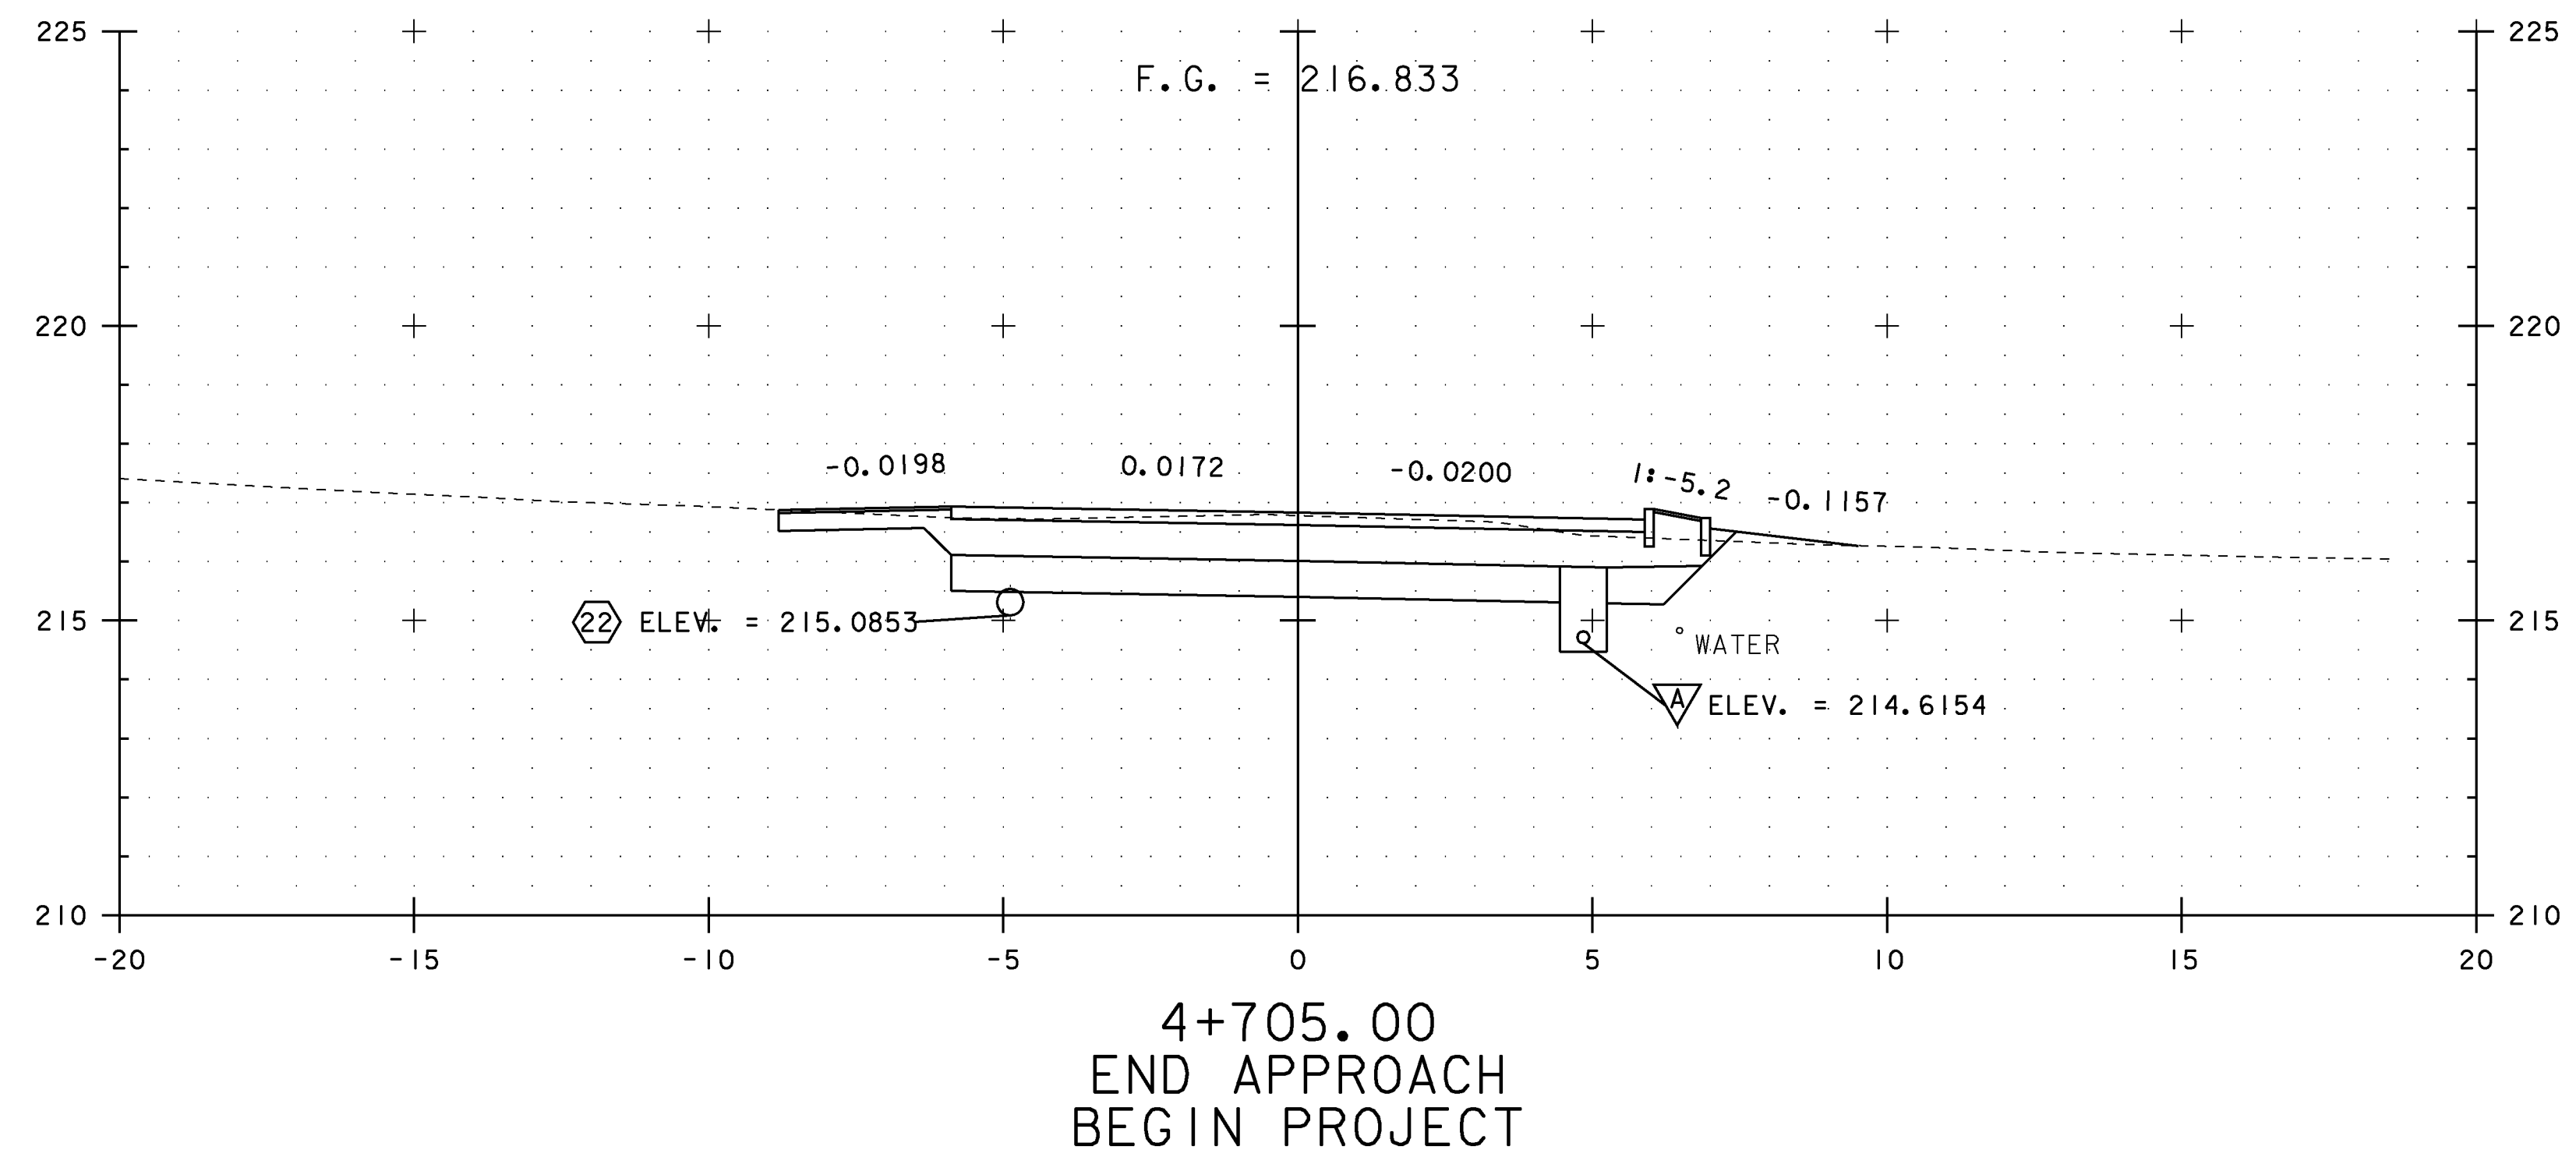




NOTES:

1. ALL BURIED UTILITIES ARE EXISTING, THE LOCATIONS ARE APPROXIMATE AND ARE TO REMAIN UNDISTURBED
2. DRAINAGE FEATURES DISPLAYED ON CROSS SECTIONS ARE PROJECTED. SEE DRAINAGE DETAIL SHEETS, LAYOUTS AND PROFILES FOR TRUE LOCATIONS

STA. 4+702 TO STA. 4+705

PROJECT NAME: EAST MONTPELIER
PROJECT NUMBER: STPG 028 - 3(35)S


FILE NAME: +98b028xsl.dgn	PLOT DATE: 22-MAR-2010
PROJECT LEADER: J. SCHULTZ	DRAWN BY: D. LYMAN
DESIGNED BY: J. GRUCHACZ	CHECKED BY: J. DEVLIN
US ROUTE 2 CROSS SECTION SHEET 3	SHEET 101 OF 142

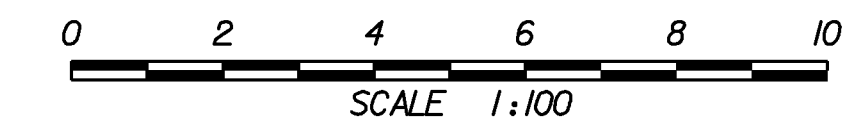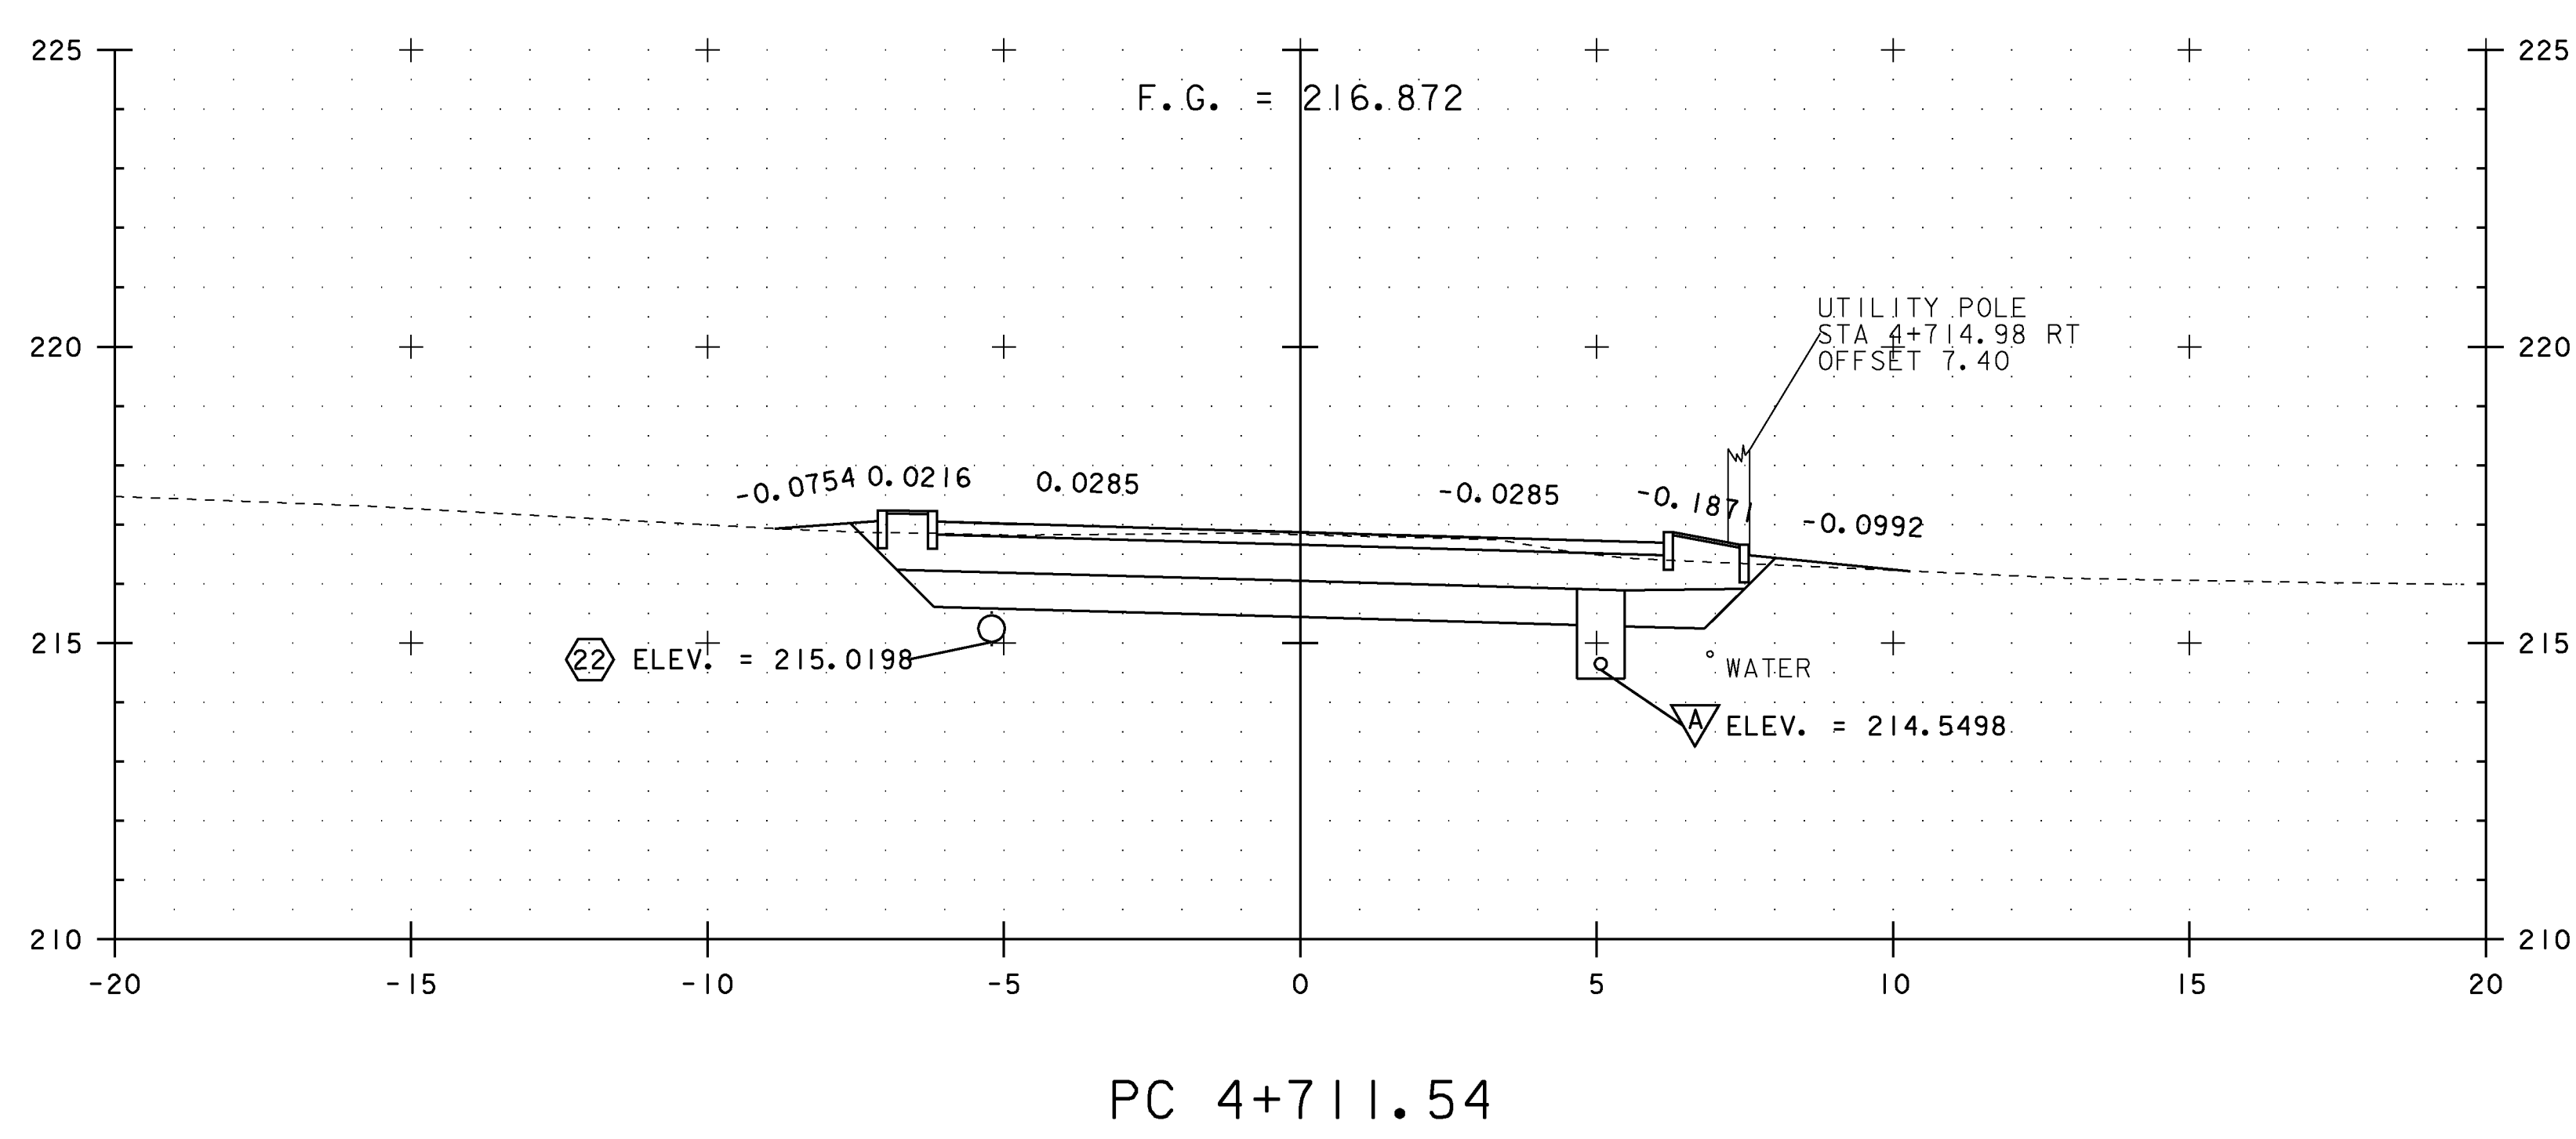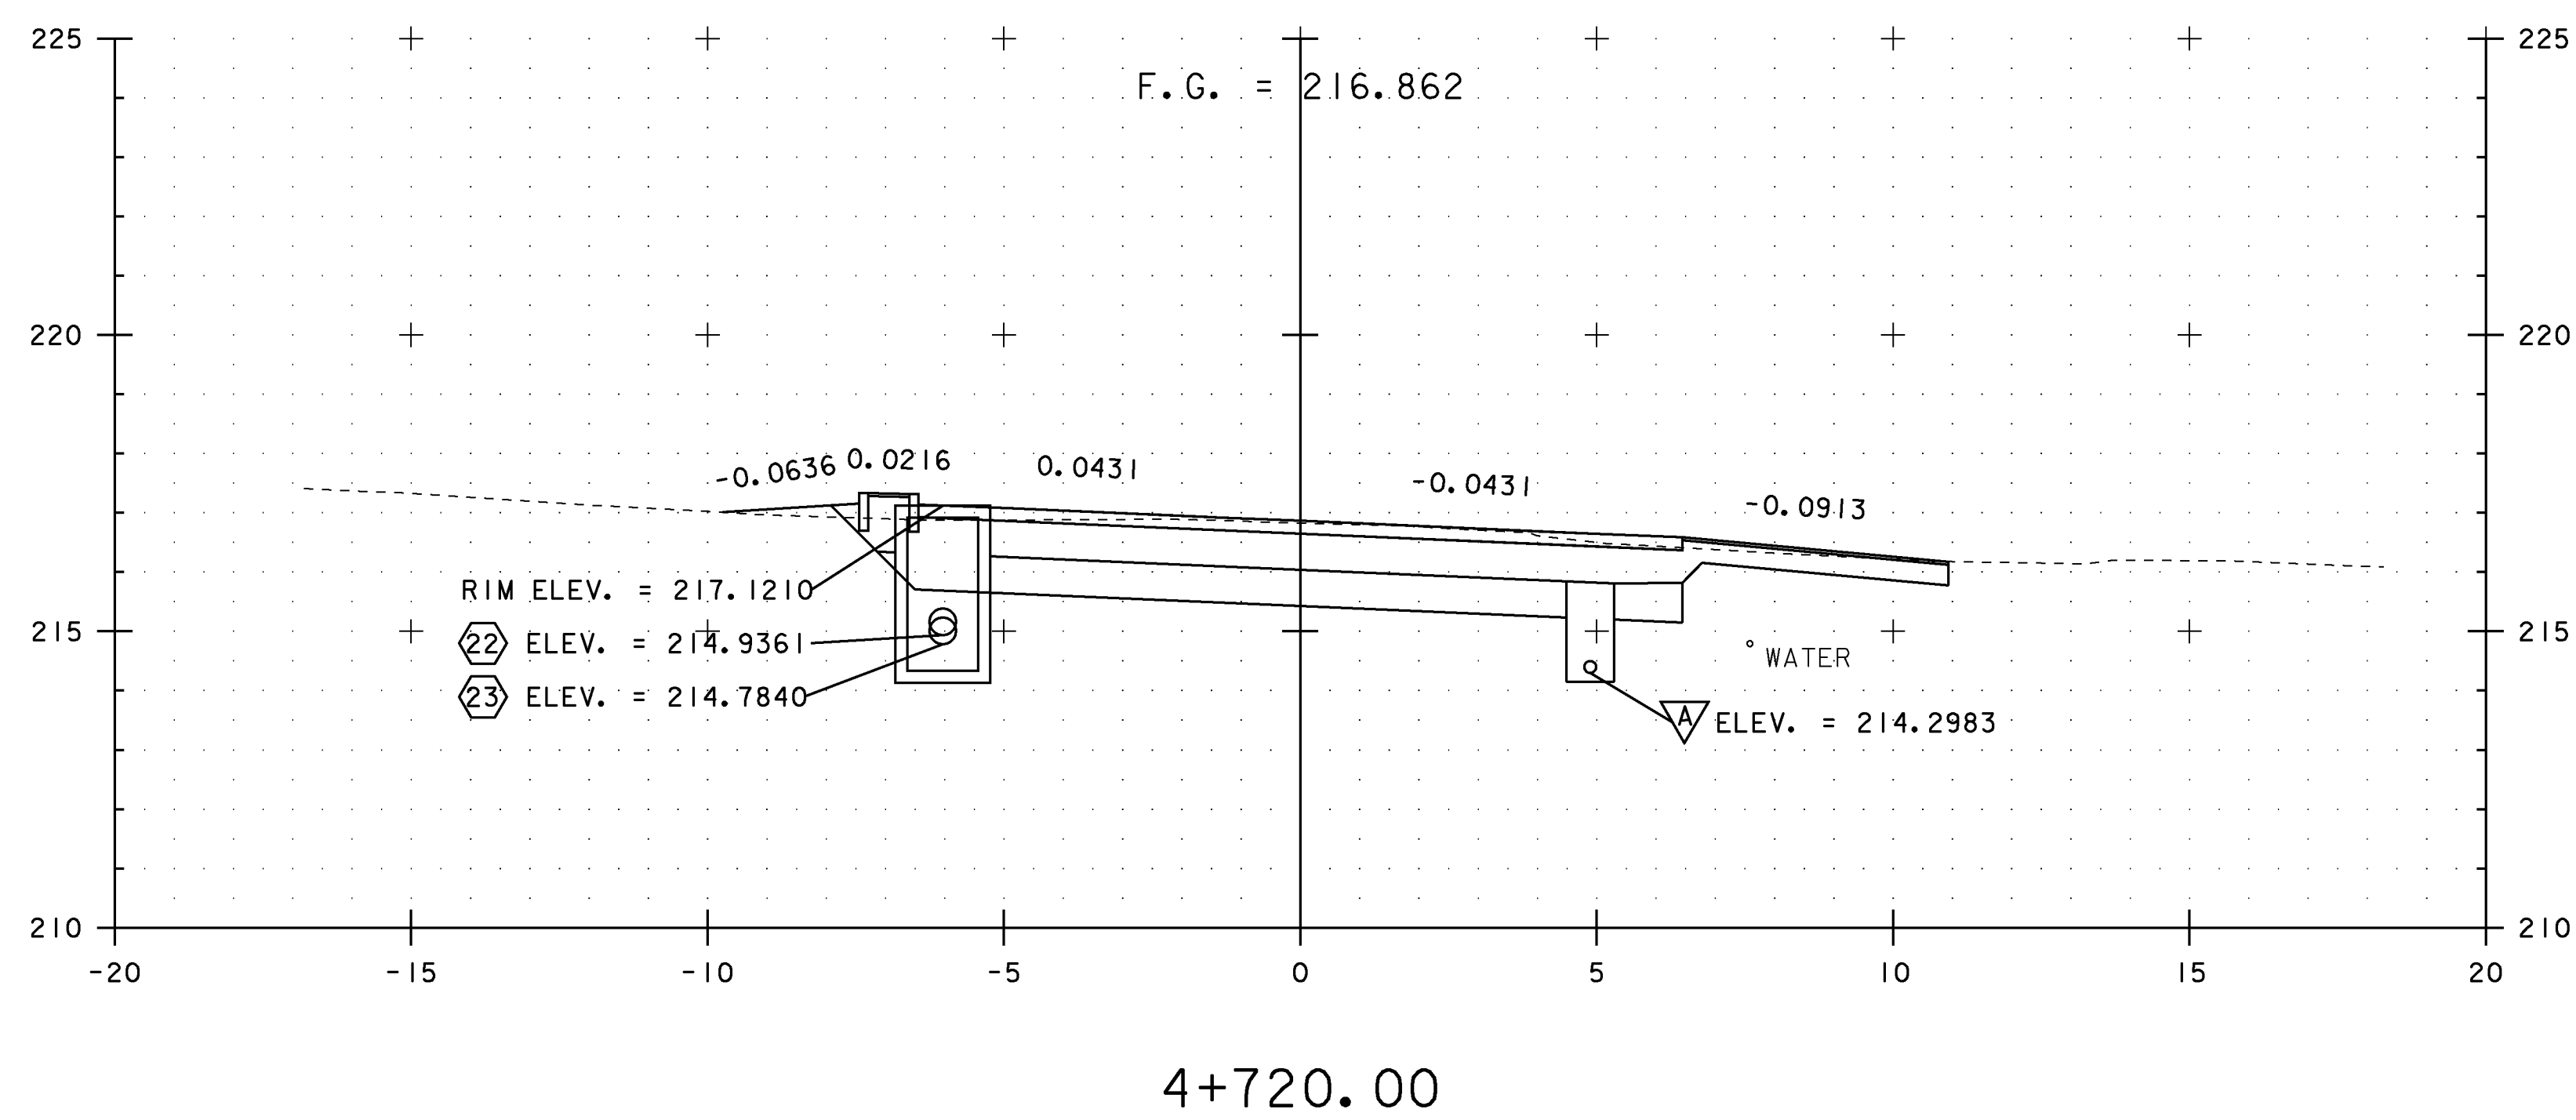


- NOTES:
1. ALL BURIED UTILITIES ARE EXISTING, THE LOCATIONS ARE APPROXIMATE AND ARE TO REMAIN UNDISTURBED
 2. DRAINAGE FEATURES DISPLAYED ON CROSS SECTIONS ARE PROJECTED. SEE DRAINAGE DETAIL SHEETS, LAYOUTS AND PROFILES FOR TRUE LOCATIONS

PROJECT NAME:	EAST MONTPELIER
PROJECT NUMBER:	STPG 028 - 3(35)S
FILE NAME:	+98b028xsl.dgn
PROJECT LEADER:	J. SCHULTZ
DESIGNED BY:	J. GRUCHACZ
US ROUTE 2 CROSS SECTION SHEET 4	
PLOT DATE:	22-MAR-2010
DRAWN BY:	D. LYMAN
CHECKED BY:	J. DEVLIN
SHEET	102 OF 142


STA. 4+711.54 TO STA. 4+720

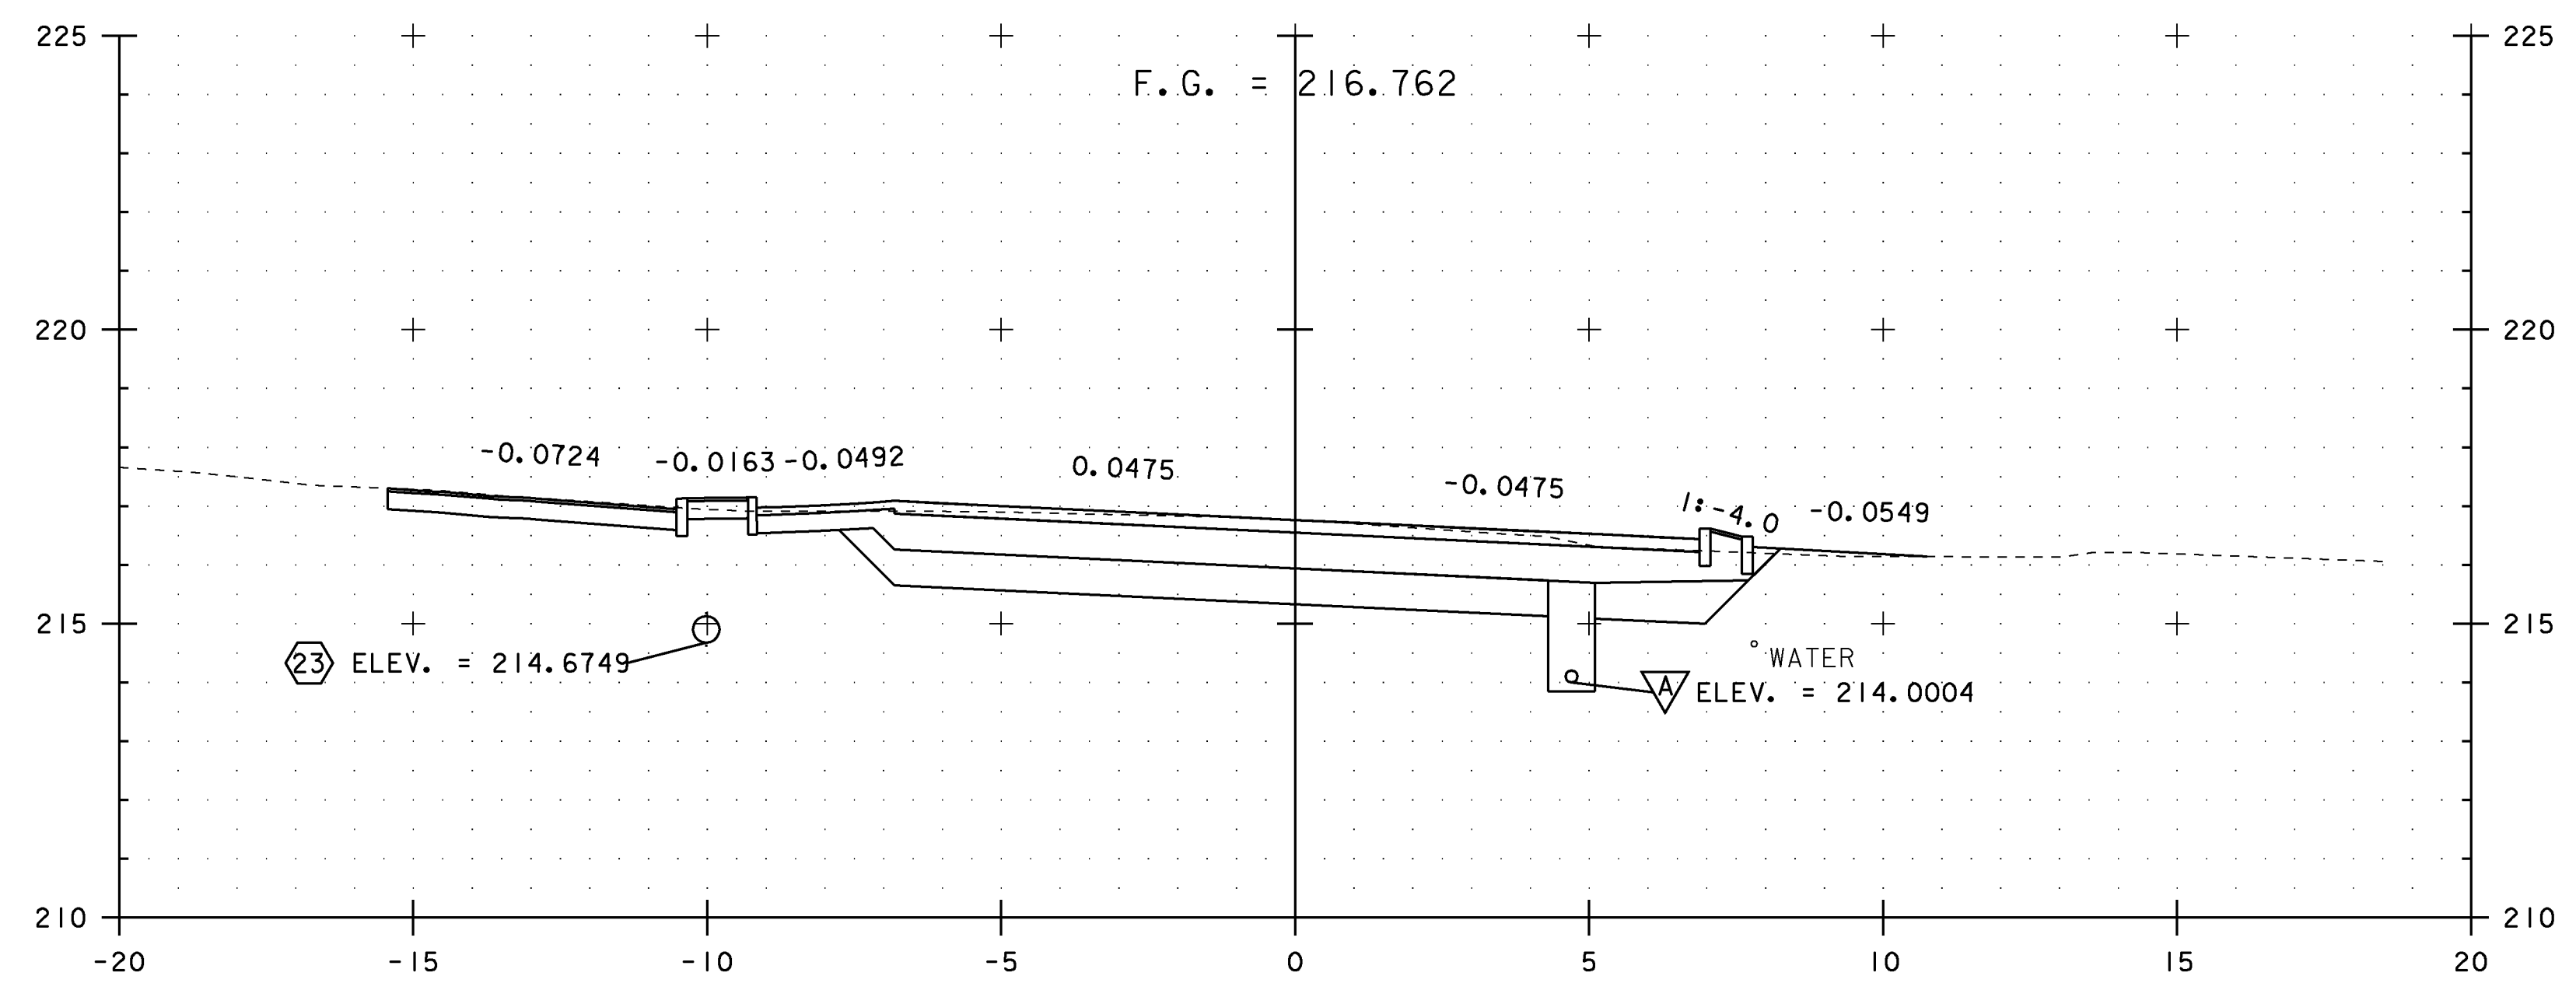

4+730.00

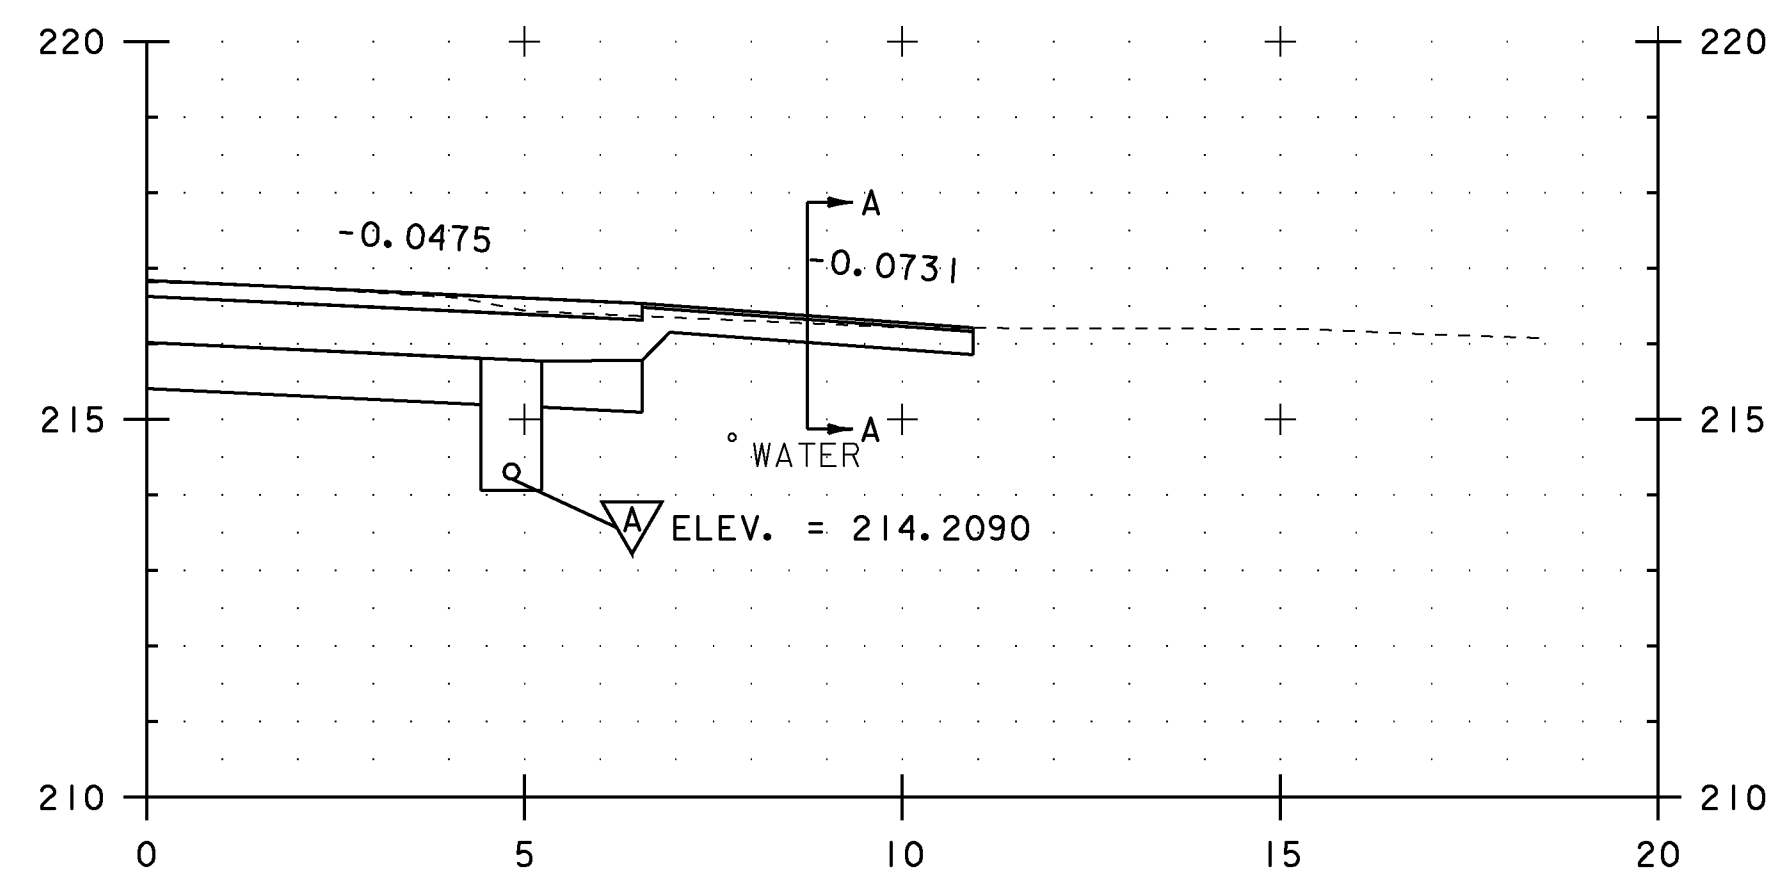

4+723.00
PAVED DRIVE RT

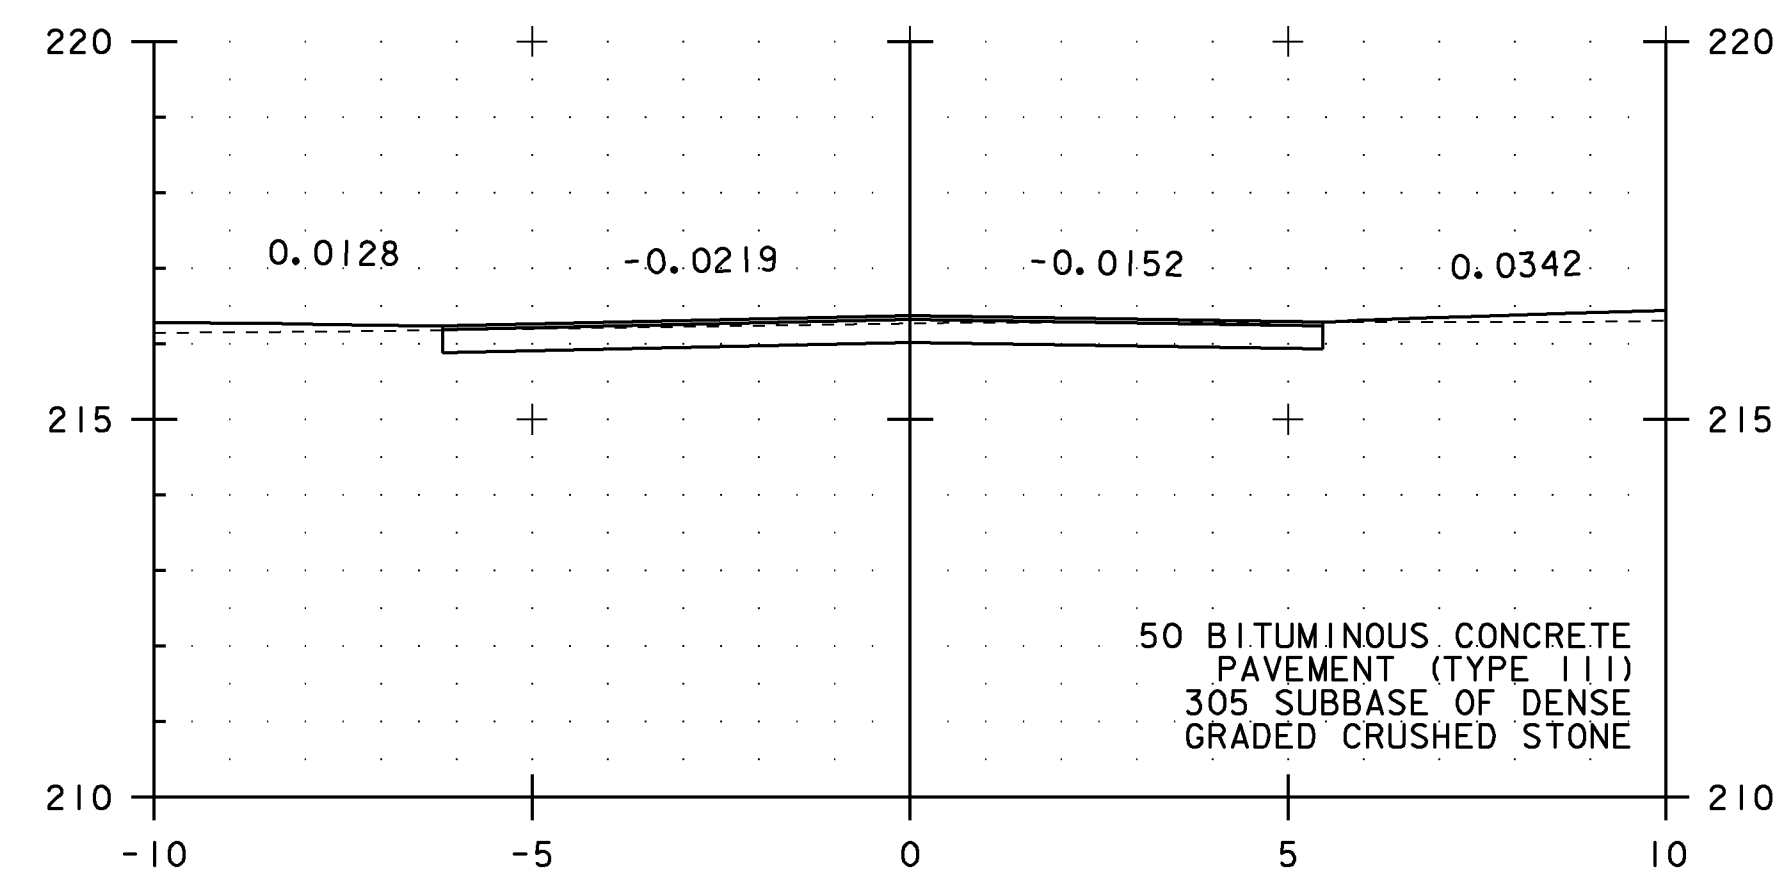

SECTION A-A




NOTES:

1. ALL BURIED UTILITIES ARE EXISTING, THE LOCATIONS ARE APPROXIMATE AND ARE TO REMAIN UNDISTURBED
2. DRAINAGE FEATURES DISPLAYED ON CROSS SECTIONS ARE PROJECTED. SEE DRAINAGE DETAIL SHEETS, LAYOUTS AND PROFILES FOR TRUE LOCATIONS


STA. 4+723 TO STA. 4+730

PROJECT NAME: EAST MONTPELIER
PROJECT NUMBER: STPG 028 - 3(35)S

FILE NAME: +98b028xsl.dgn	PLOT DATE: 22-MAR-2010
PROJECT LEADER: J. SCHULTZ	DRAWN BY: D. LYMAN
DESIGNED BY: J. GRUCHACZ	CHECKED BY: J. DEVLIN
US ROUTE 2 CROSS SECTION SHEET 5	SHEET 103 OF 142

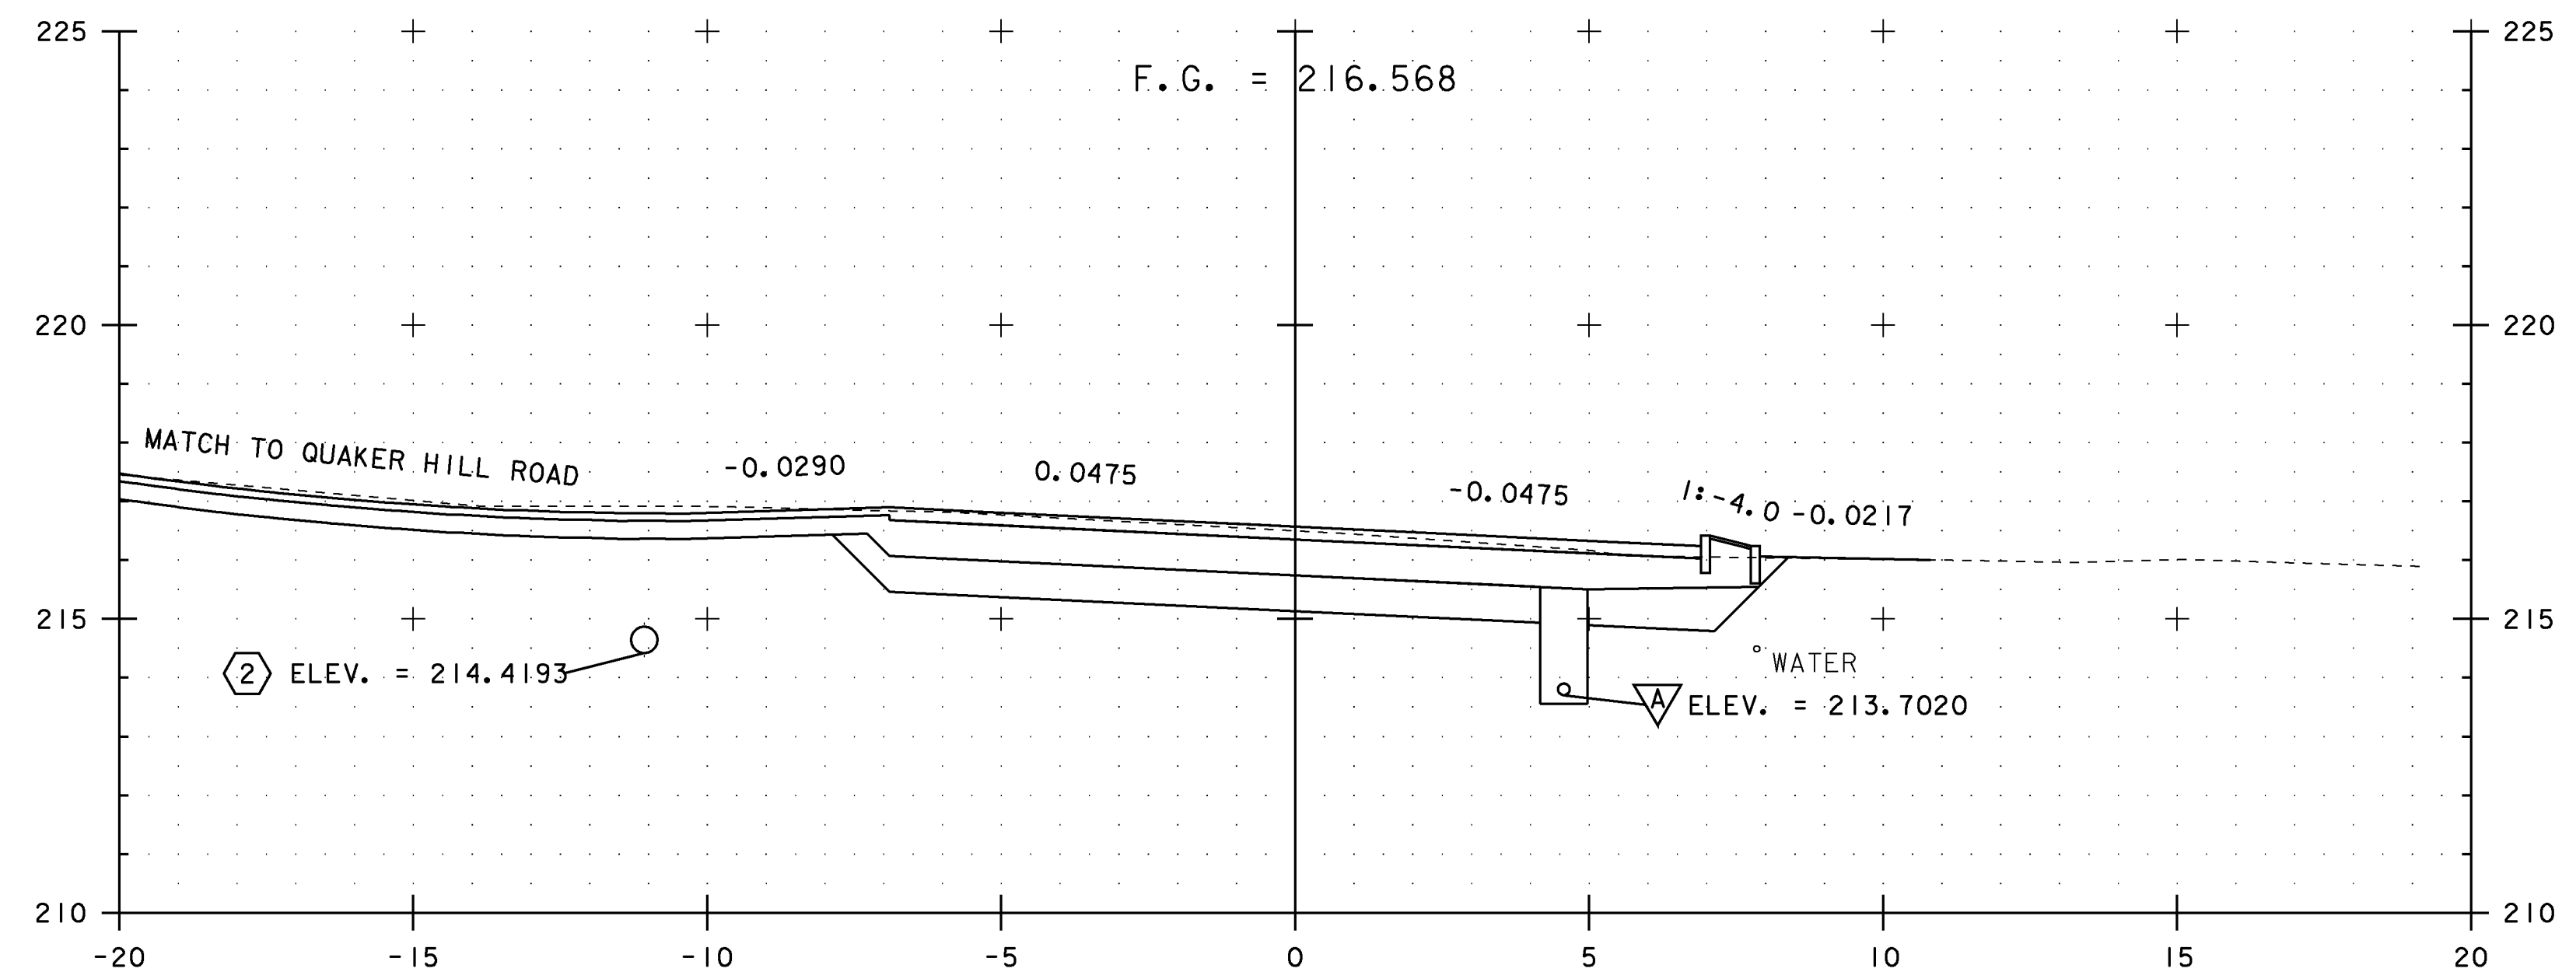

4+740.00

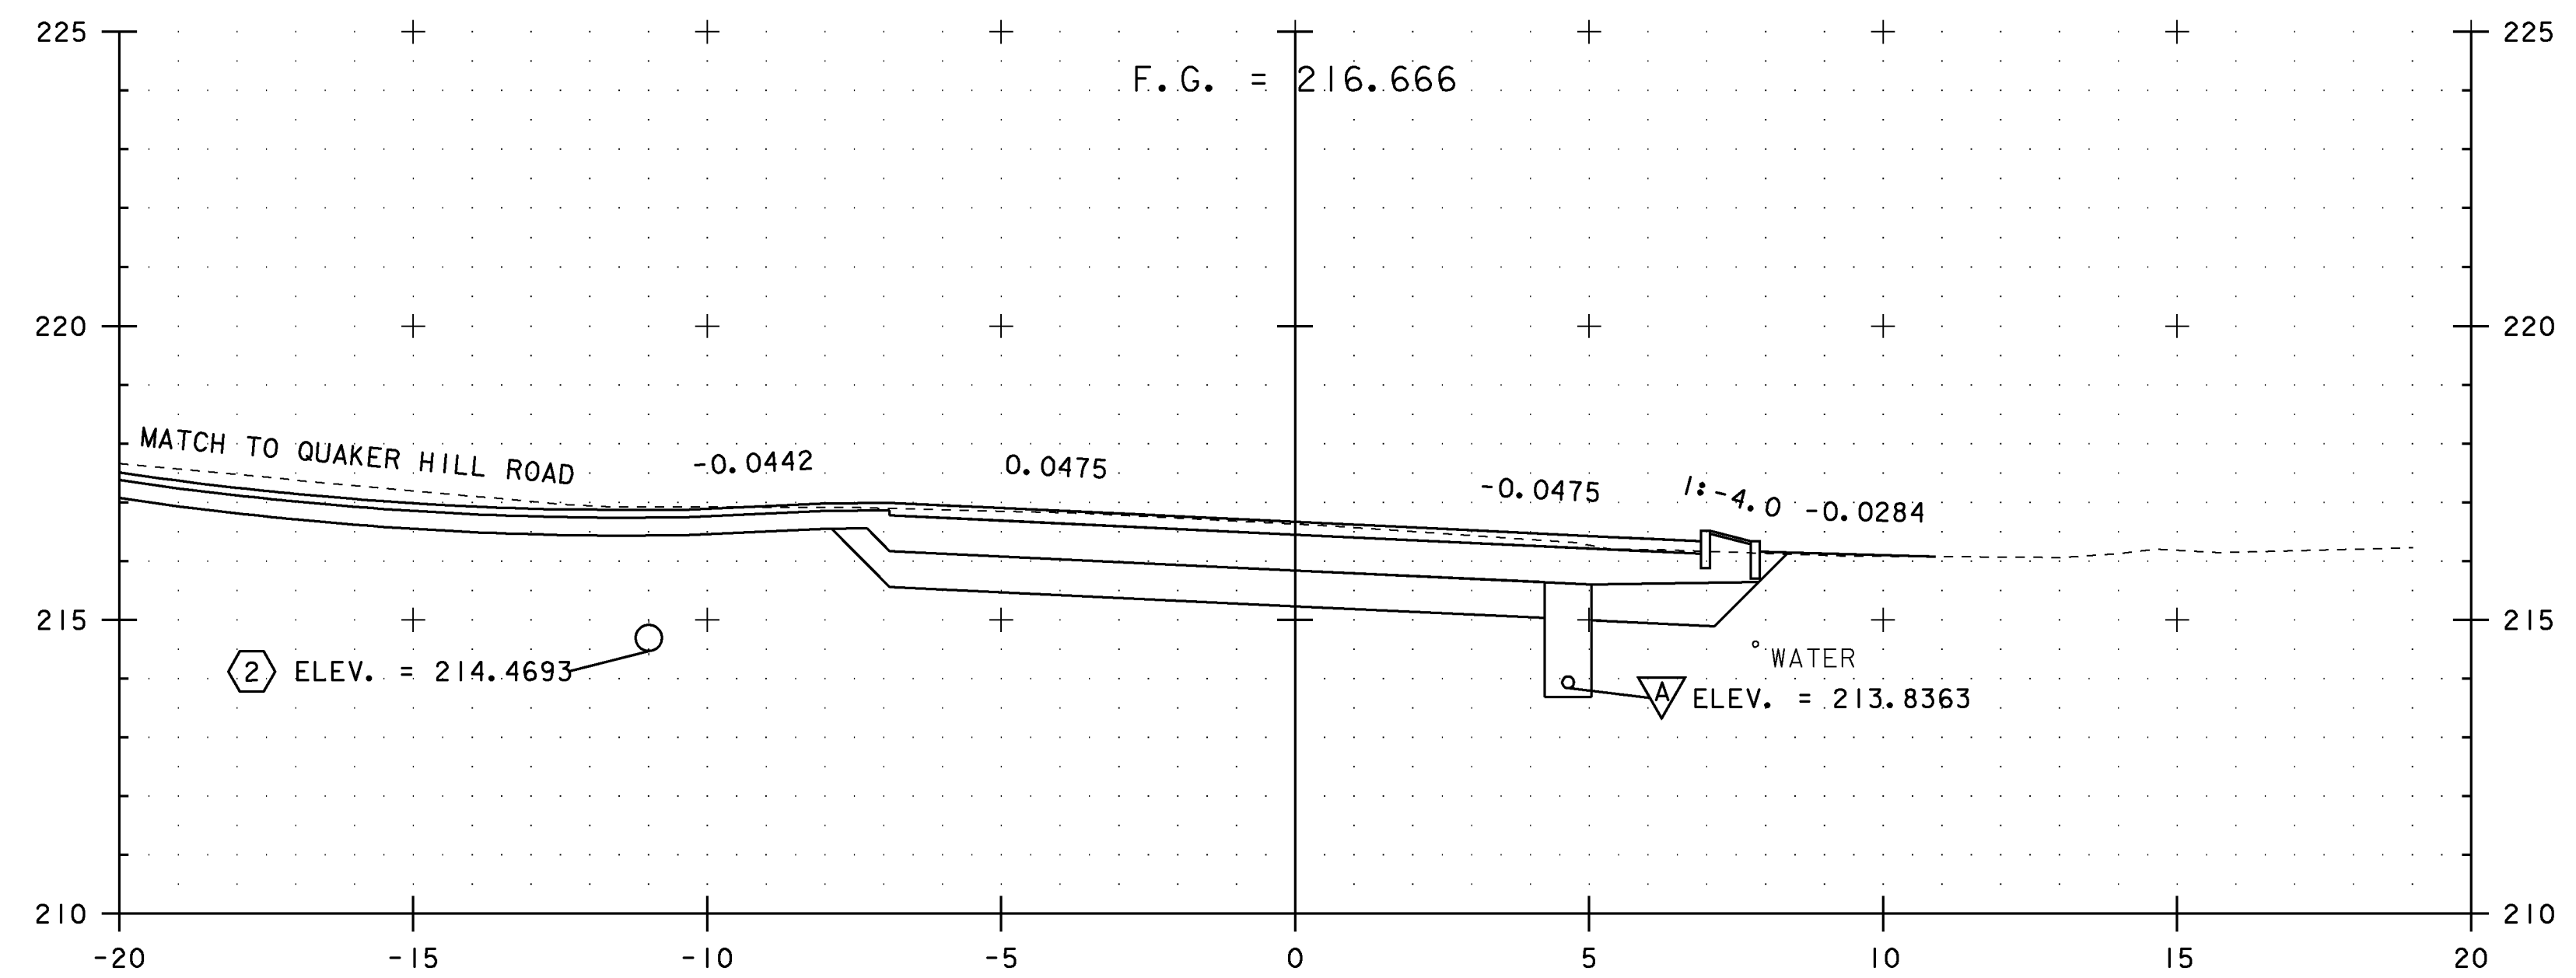

4+735.50







NOTES:

1. ALL BURIED UTILITIES ARE EXISTING, THE LOCATIONS ARE APPROXIMATE AND ARE TO REMAIN UNDISTURBED
2. DRAINAGE FEATURES DISPLAYED ON CROSS SECTIONS ARE PROJECTED. SEE DRAINAGE DETAIL SHEETS, LAYOUTS AND PROFILES FOR TRUE LOCATIONS

PROJECT NAME: EAST MONTPELIER
 PROJECT NUMBER: STPG 028 - 3(35)S

FILE NAME: +98b028xsl.dgn	PLOT DATE: 22-MAR-2010
PROJECT LEADER: J. SCHULTZ	DRAWN BY: D. LYMAN
DESIGNED BY: J. GRUCHACZ	CHECKED BY: J. DEVLIN
US ROUTE 2 CROSS SECTION SHEET 6	SHEET 104 OF 142

STA. 4+735.50 TO STA. 4+740

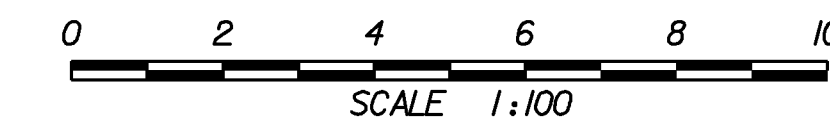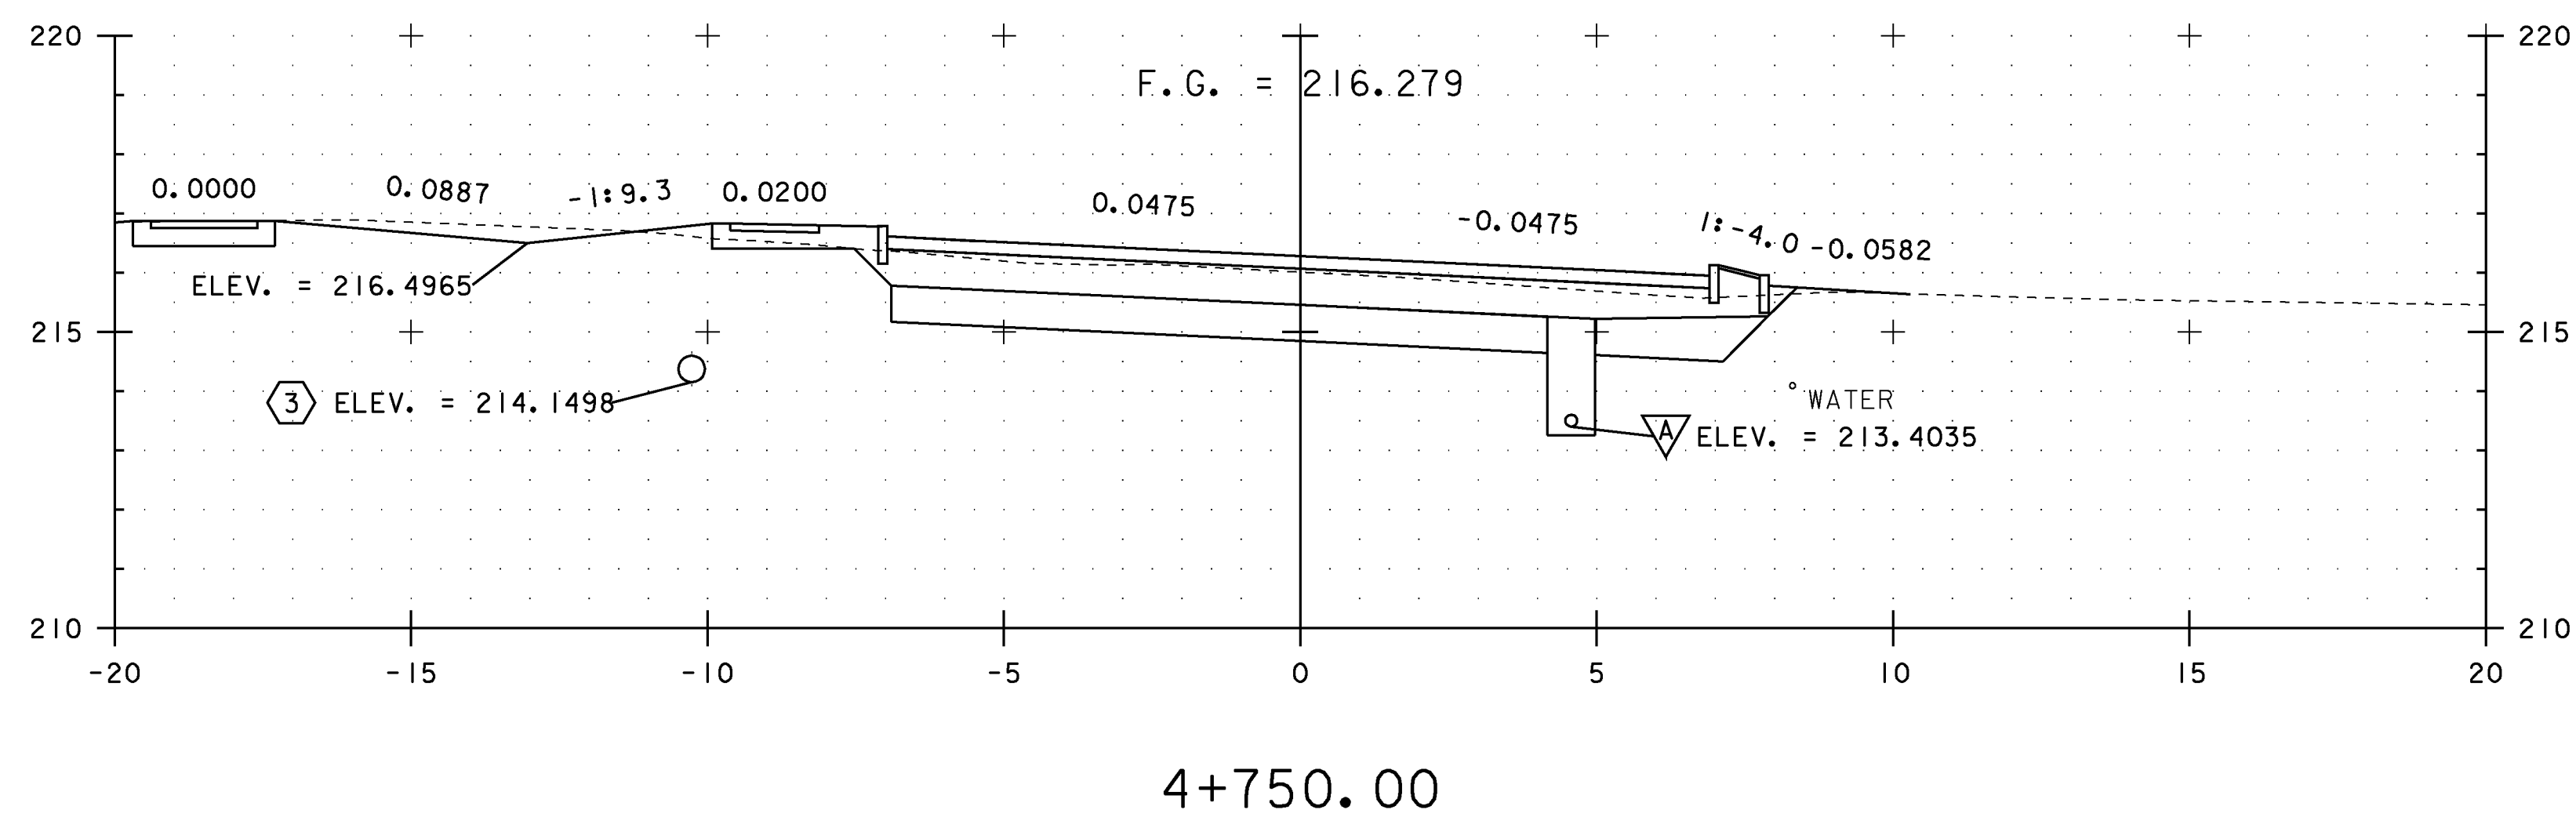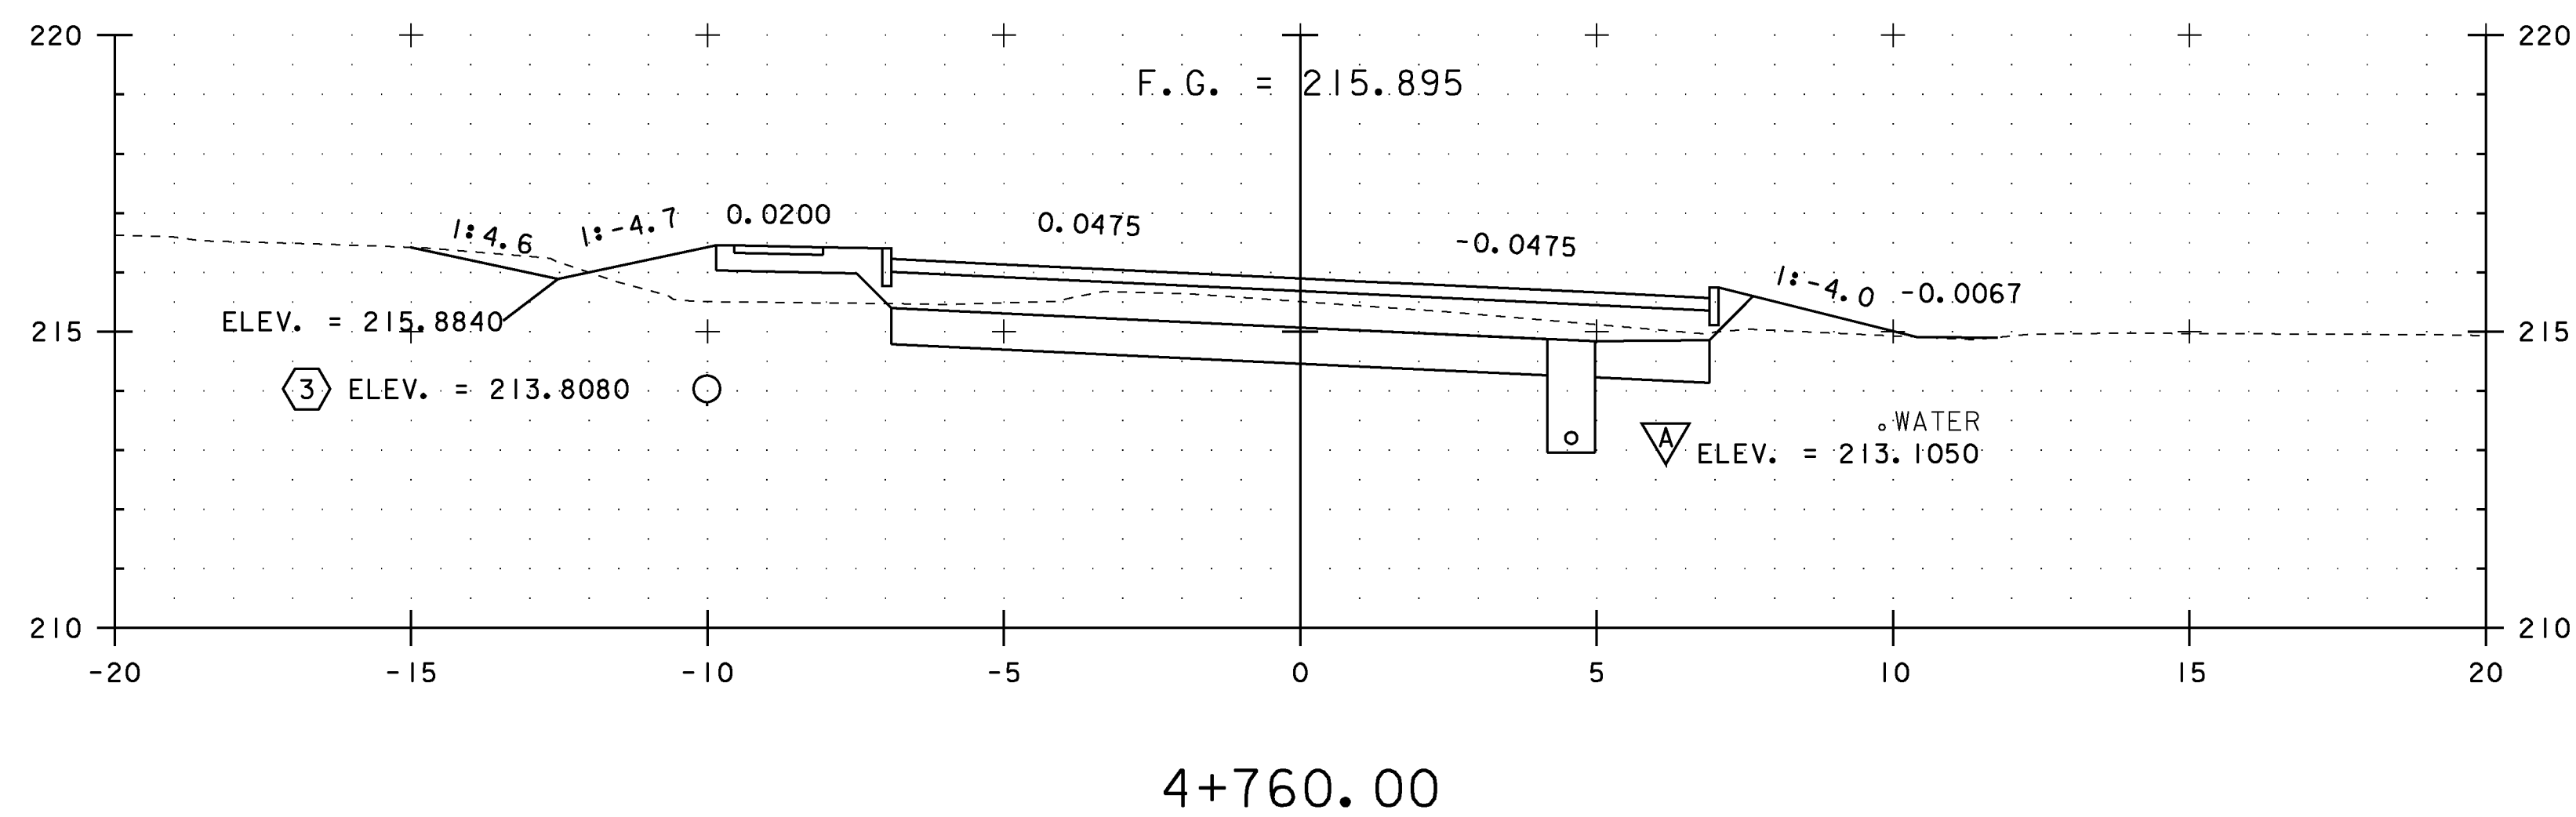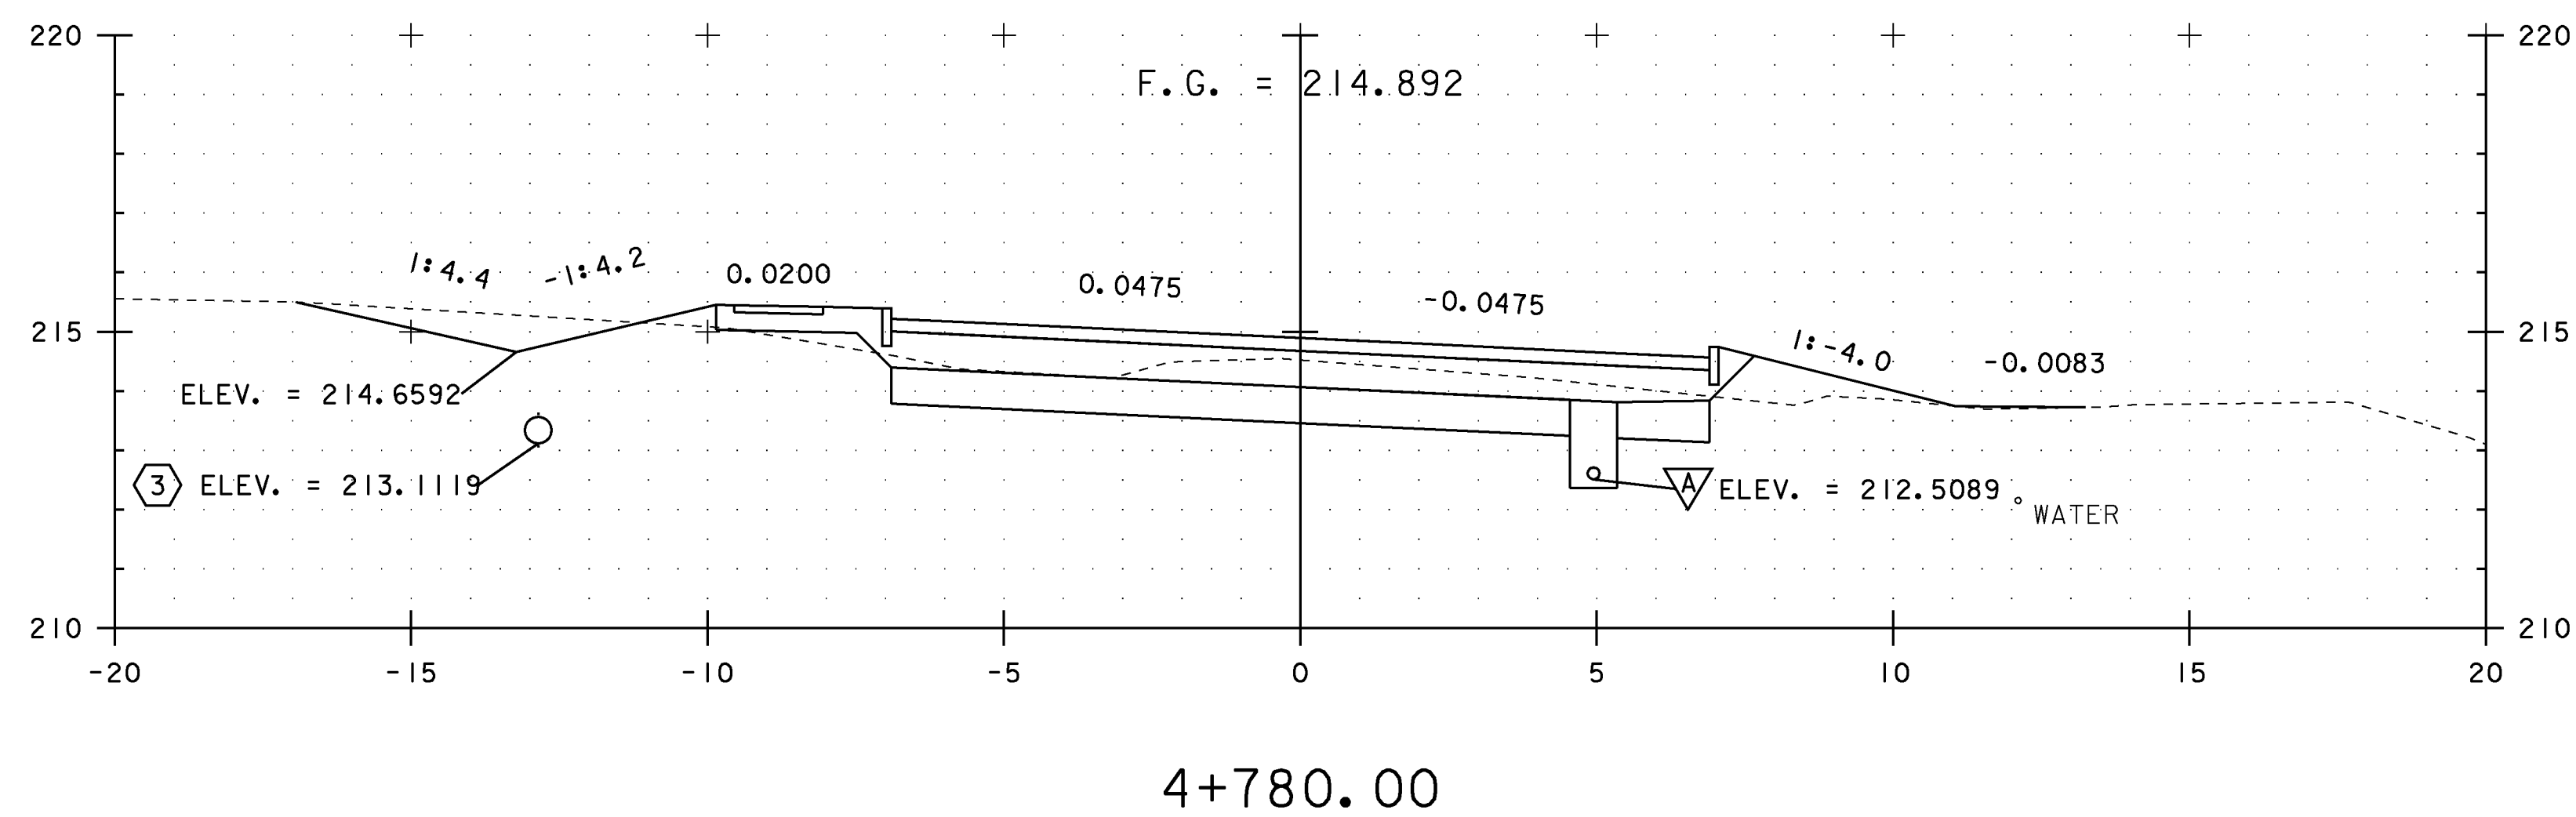


NOTES:

1. ALL BURIED UTILITIES ARE EXISTING, THE LOCATIONS ARE APPROXIMATE AND ARE TO REMAIN UNDISTURBED
2. DRAINAGE FEATURES DISPLAYED ON CROSS SECTIONS ARE PROJECTED. SEE DRAINAGE DETAIL SHEETS, LAYOUTS AND PROFILES FOR TRUE LOCATIONS


PROJECT NAME: EAST MONTPELIER
 PROJECT NUMBER: STPG 028 - 3(35)S

FILE NAME: +98b028xsl.dgn
 PROJECT LEADER: J. SCHULTZ
 DESIGNED BY: J. GRUCHACZ
 US ROUTE 2 CROSS SECTION SHEET 7


PLOT DATE: 22-MAR-2010
 DRAWN BY: D. LYMAN
 CHECKED BY: J. DEVLIN
 SHEET 105 OF 142

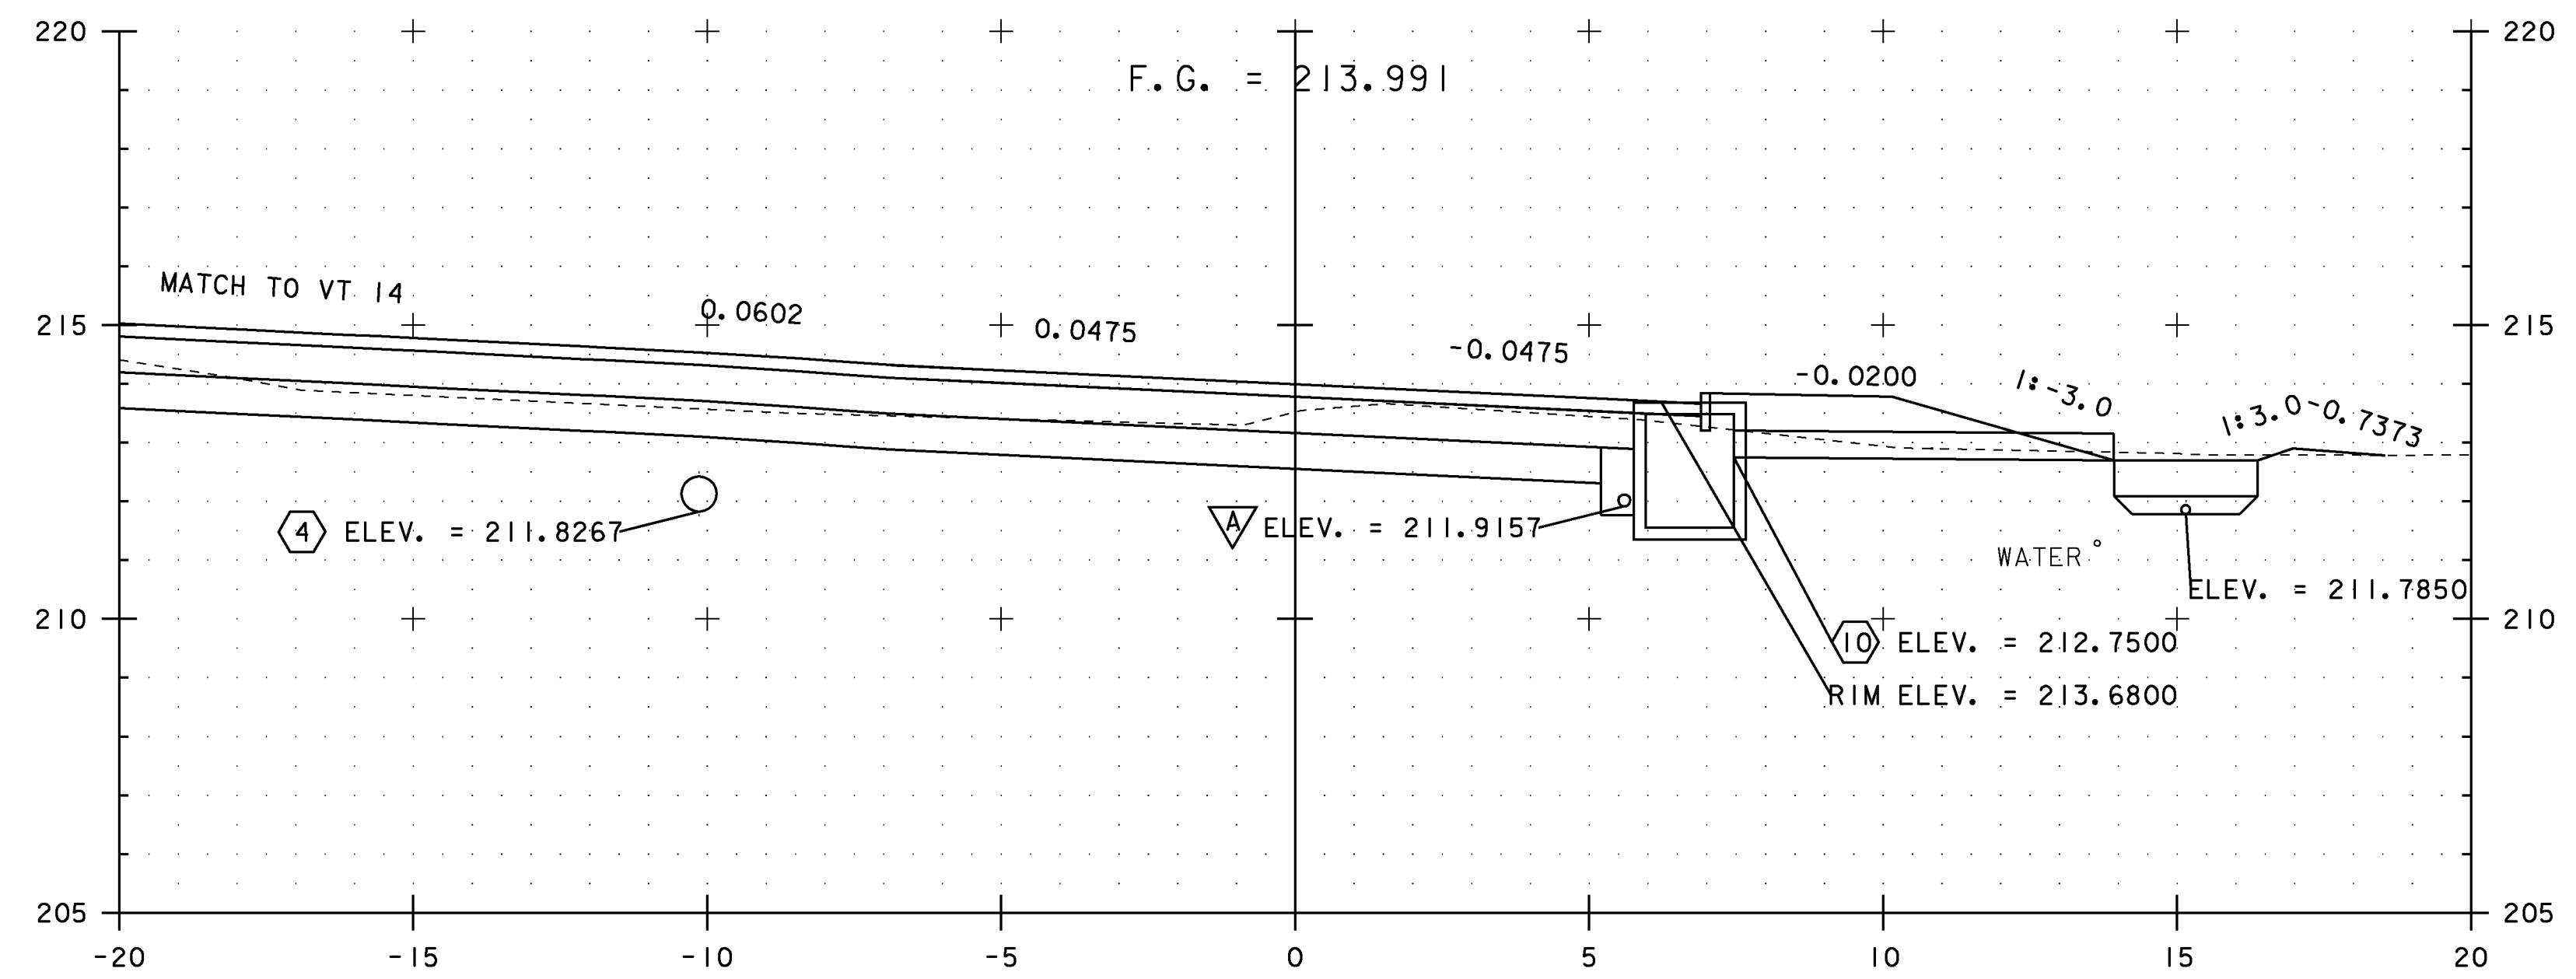

4+800.00

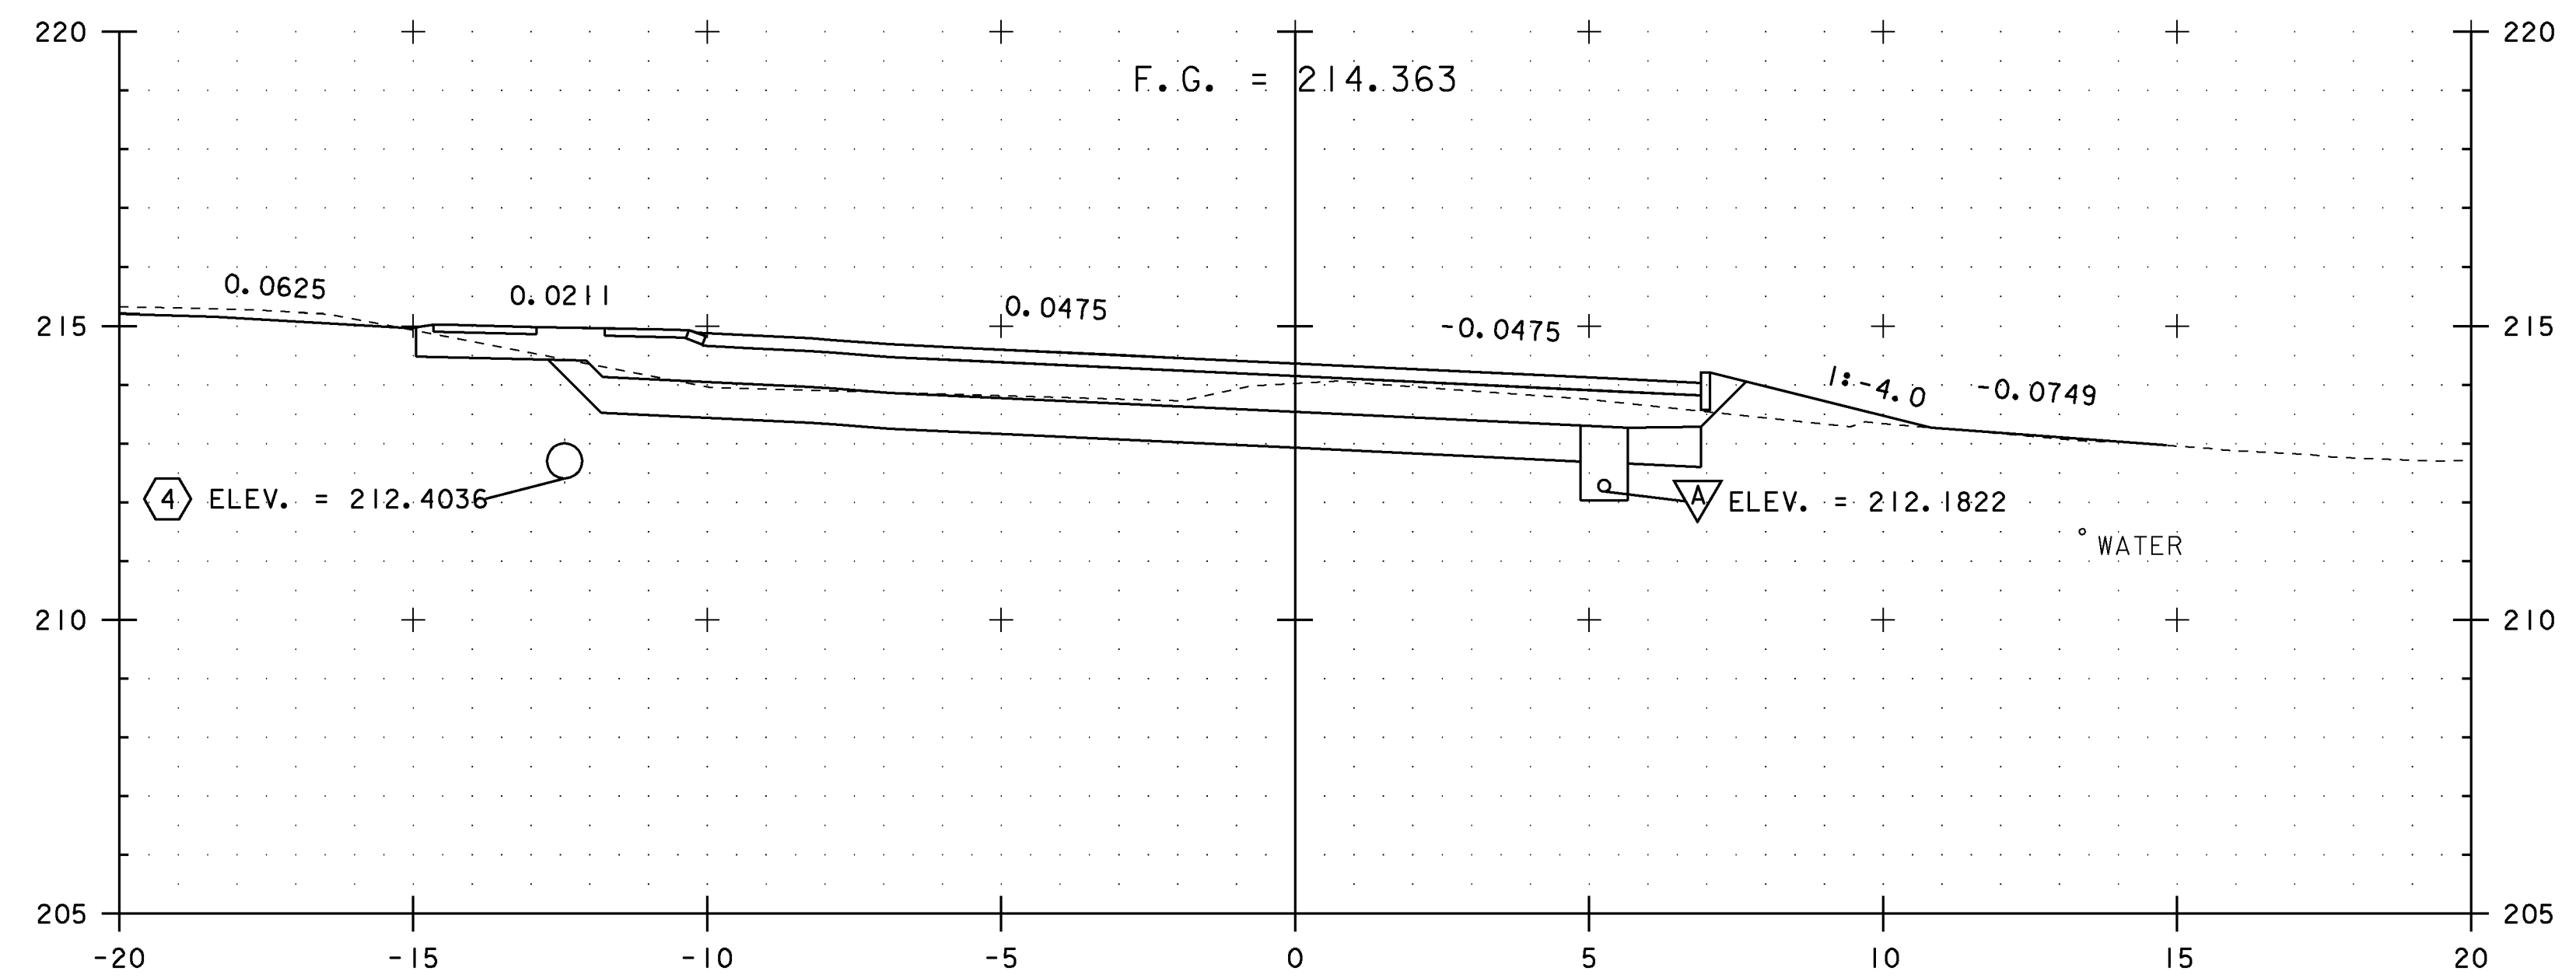

4+791.00



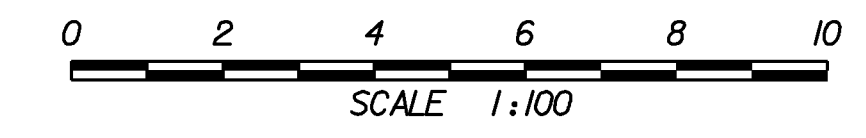


NOTES:

1. ALL BURIED UTILITIES ARE EXISTING, THE LOCATIONS ARE APPROXIMATE AND ARE TO REMAIN UNDISTURBED
2. DRAINAGE FEATURES DISPLAYED ON CROSS SECTIONS ARE PROJECTED. SEE DRAINAGE DETAIL SHEETS, LAYOUTS AND PROFILES FOR TRUE LOCATIONS

STA. 4+791 TO STA. 4+800


PROJECT NAME: EAST MONTPELIER	
PROJECT NUMBER: STPG 028 - 3(35)S	
FILE NAME: +98b028xsl.dgn	PLOT DATE: 22-MAR-2010
PROJECT LEADER: J. SCHULTZ	DRAWN BY: D. LYMAN
DESIGNED BY: J. GRUCHACZ	CHECKED BY: J. DEVLIN
US ROUTE 2 CROSS SECTION SHEET 8	SHEET 106 OF 142

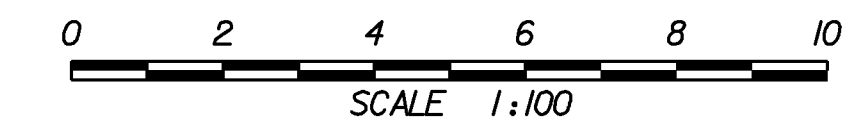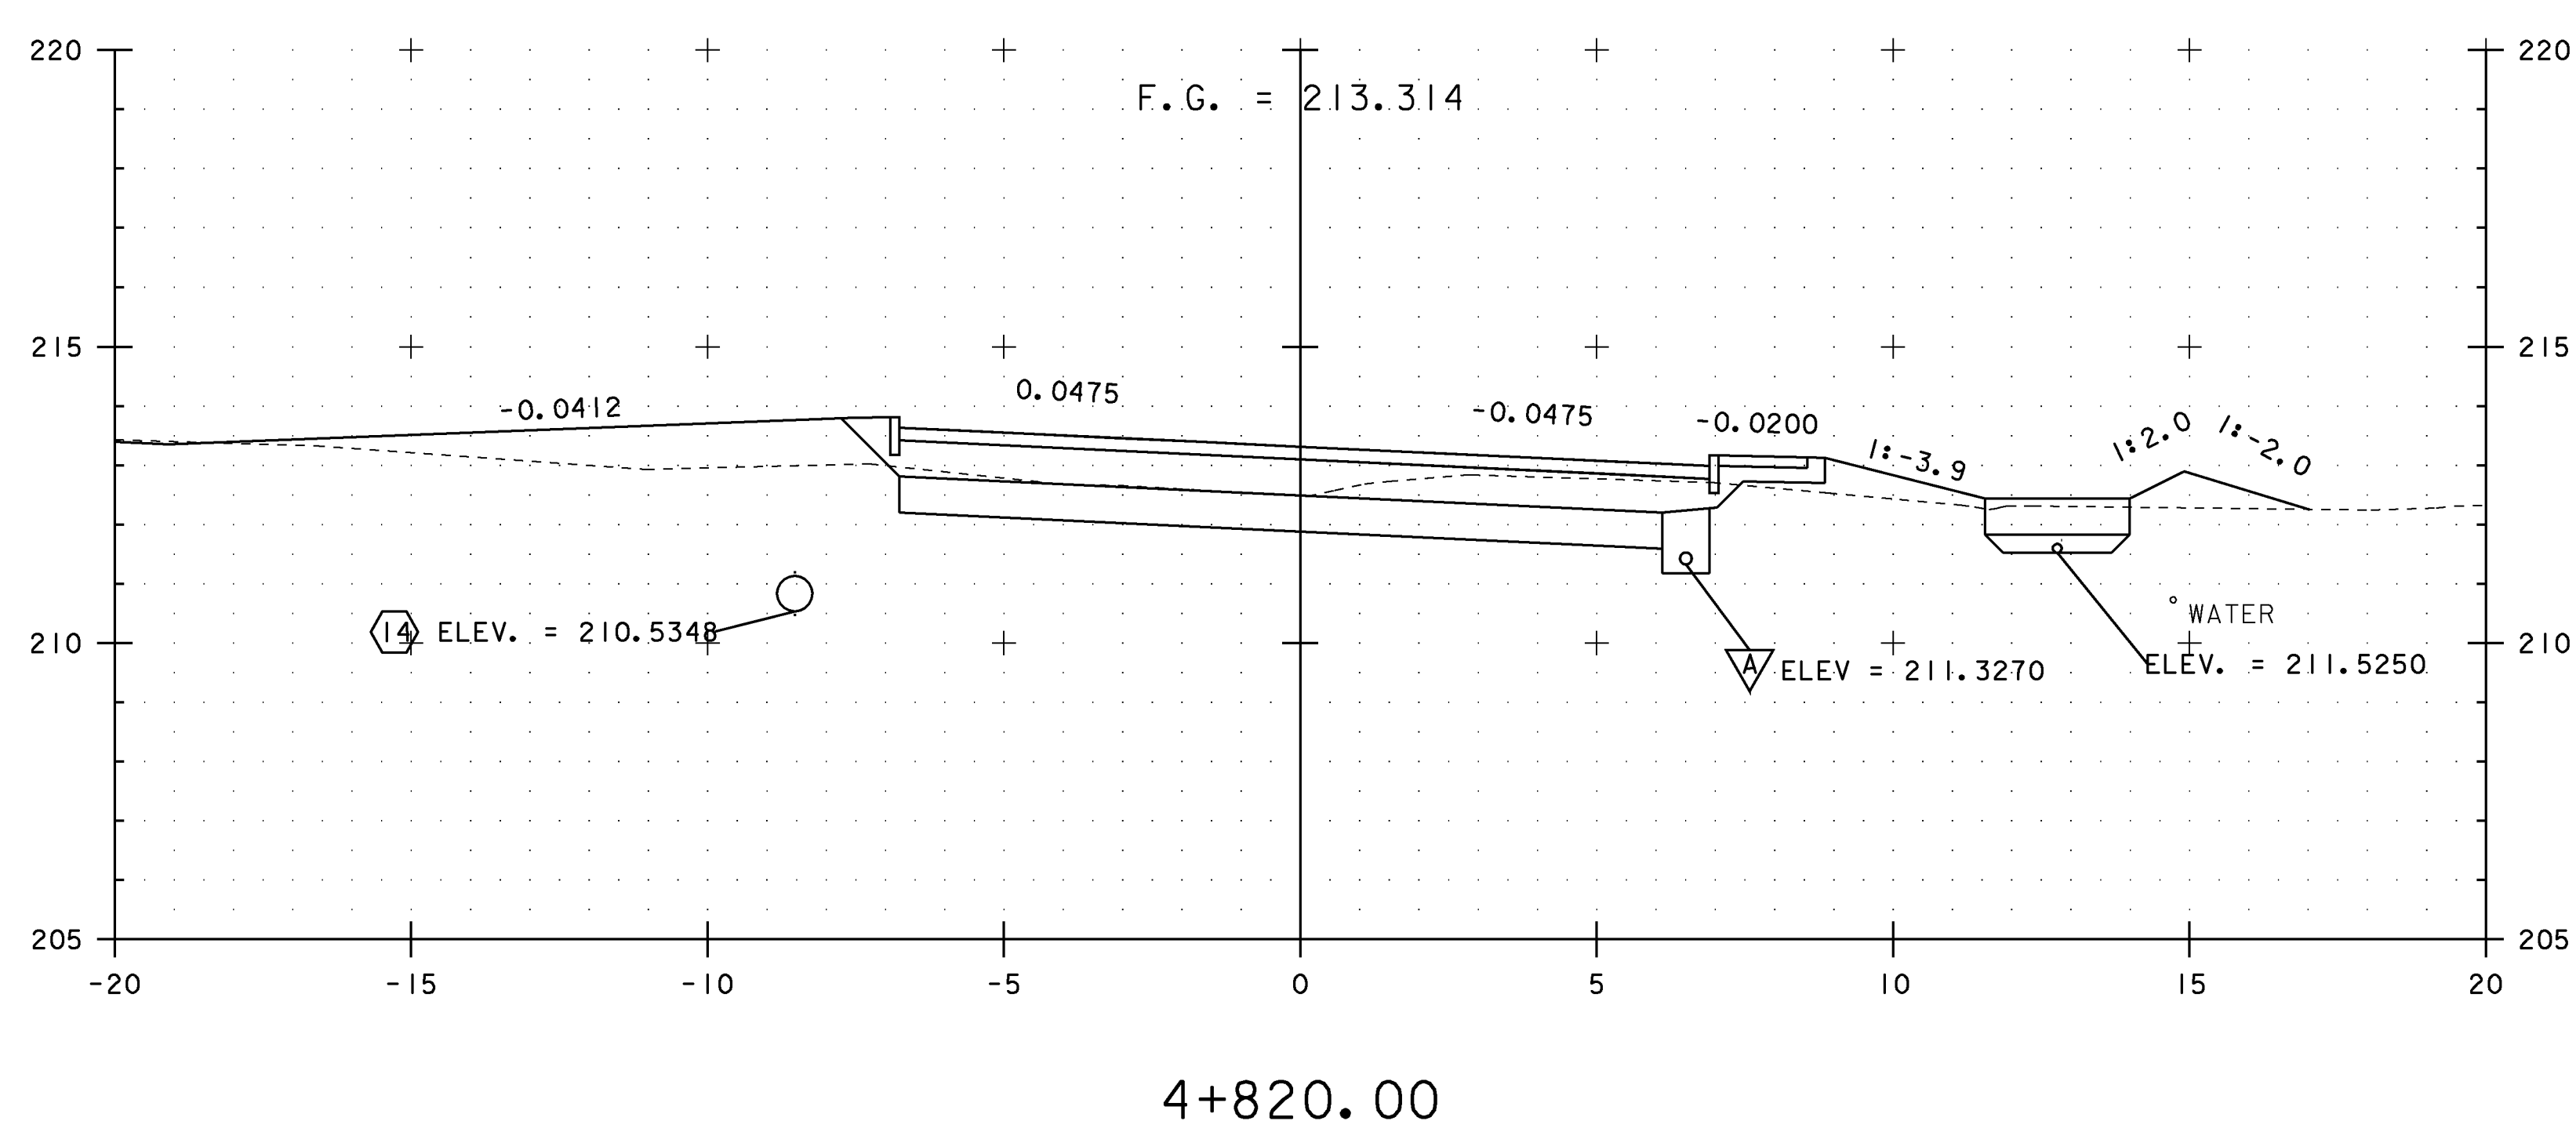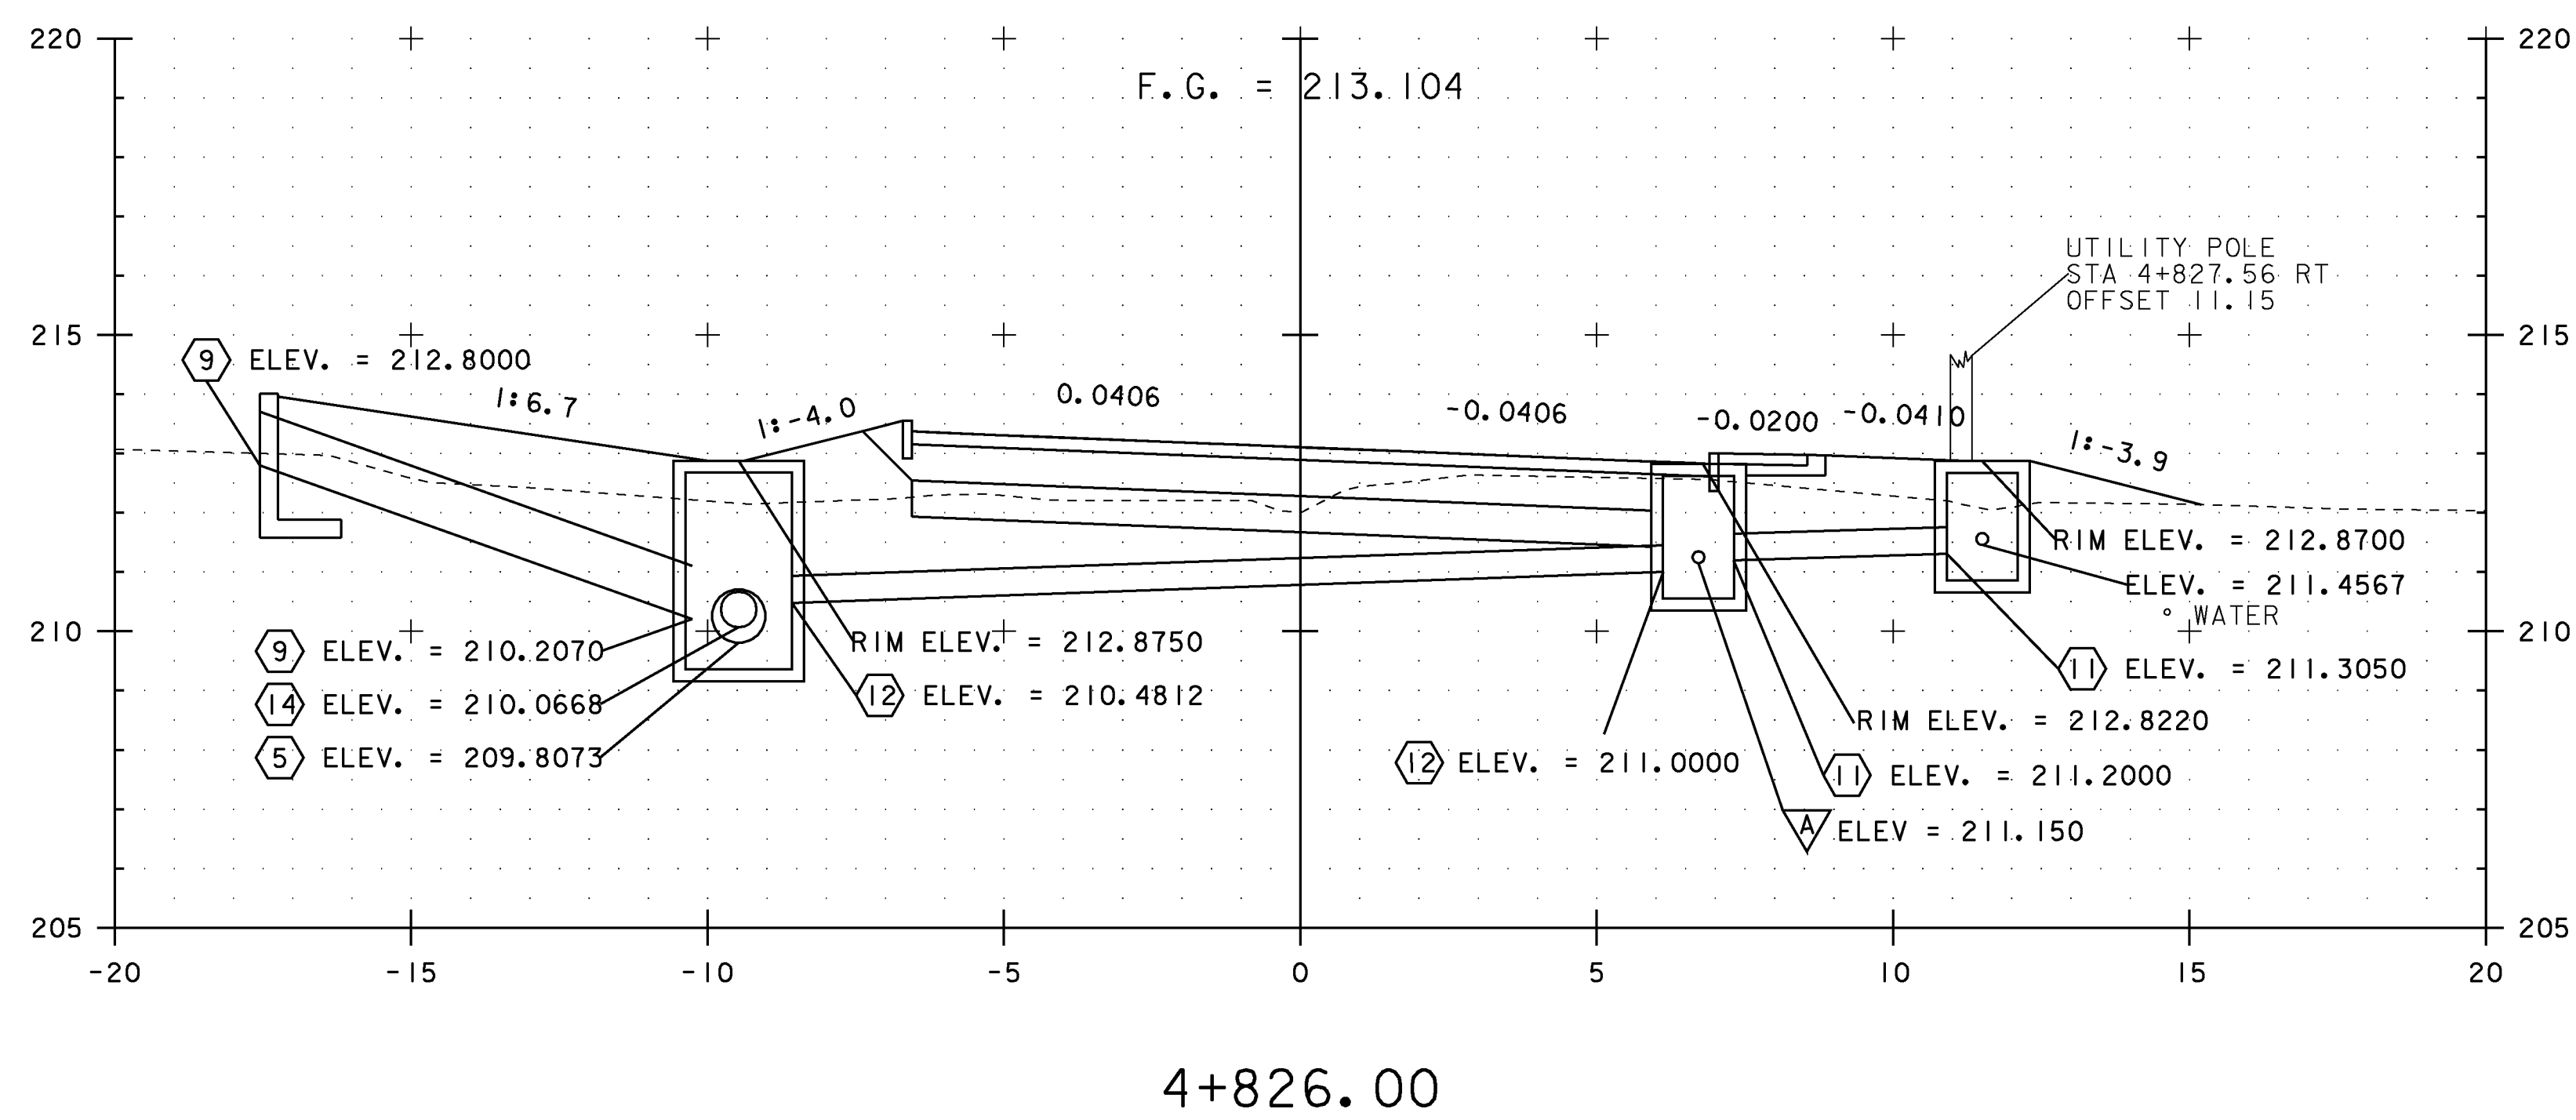


NOTES:
 1. ALL BURIED UTILITIES ARE EXISTING, THE LOCATIONS ARE APPROXIMATE AND ARE TO REMAIN UNDISTURBED
 2. DRAINAGE FEATURES DISPLAYED ON CROSS SECTIONS ARE PROJECTED. SEE DRAINAGE DETAIL SHEETS, LAYOUTS AND PROFILES FOR TRUE LOCATIONS

PROJECT NAME:	EAST MONTEPELIER
PROJECT NUMBER:	STPG 028 - 3(35)S
FILE NAME:	+98b028xsl.dgn
PROJECT LEADER:	J. SCHULTZ
DESIGNED BY:	J. GRUCHACZ
US ROUTE 2 CROSS SECTION SHEET 9	
PLOT DATE:	22-MAR-2010
DRAWN BY:	D. LYMAN
CHECKED BY:	J. DEVLIN
SHEET	107 OF 142


STA. 4+820 TO STA. 4+826

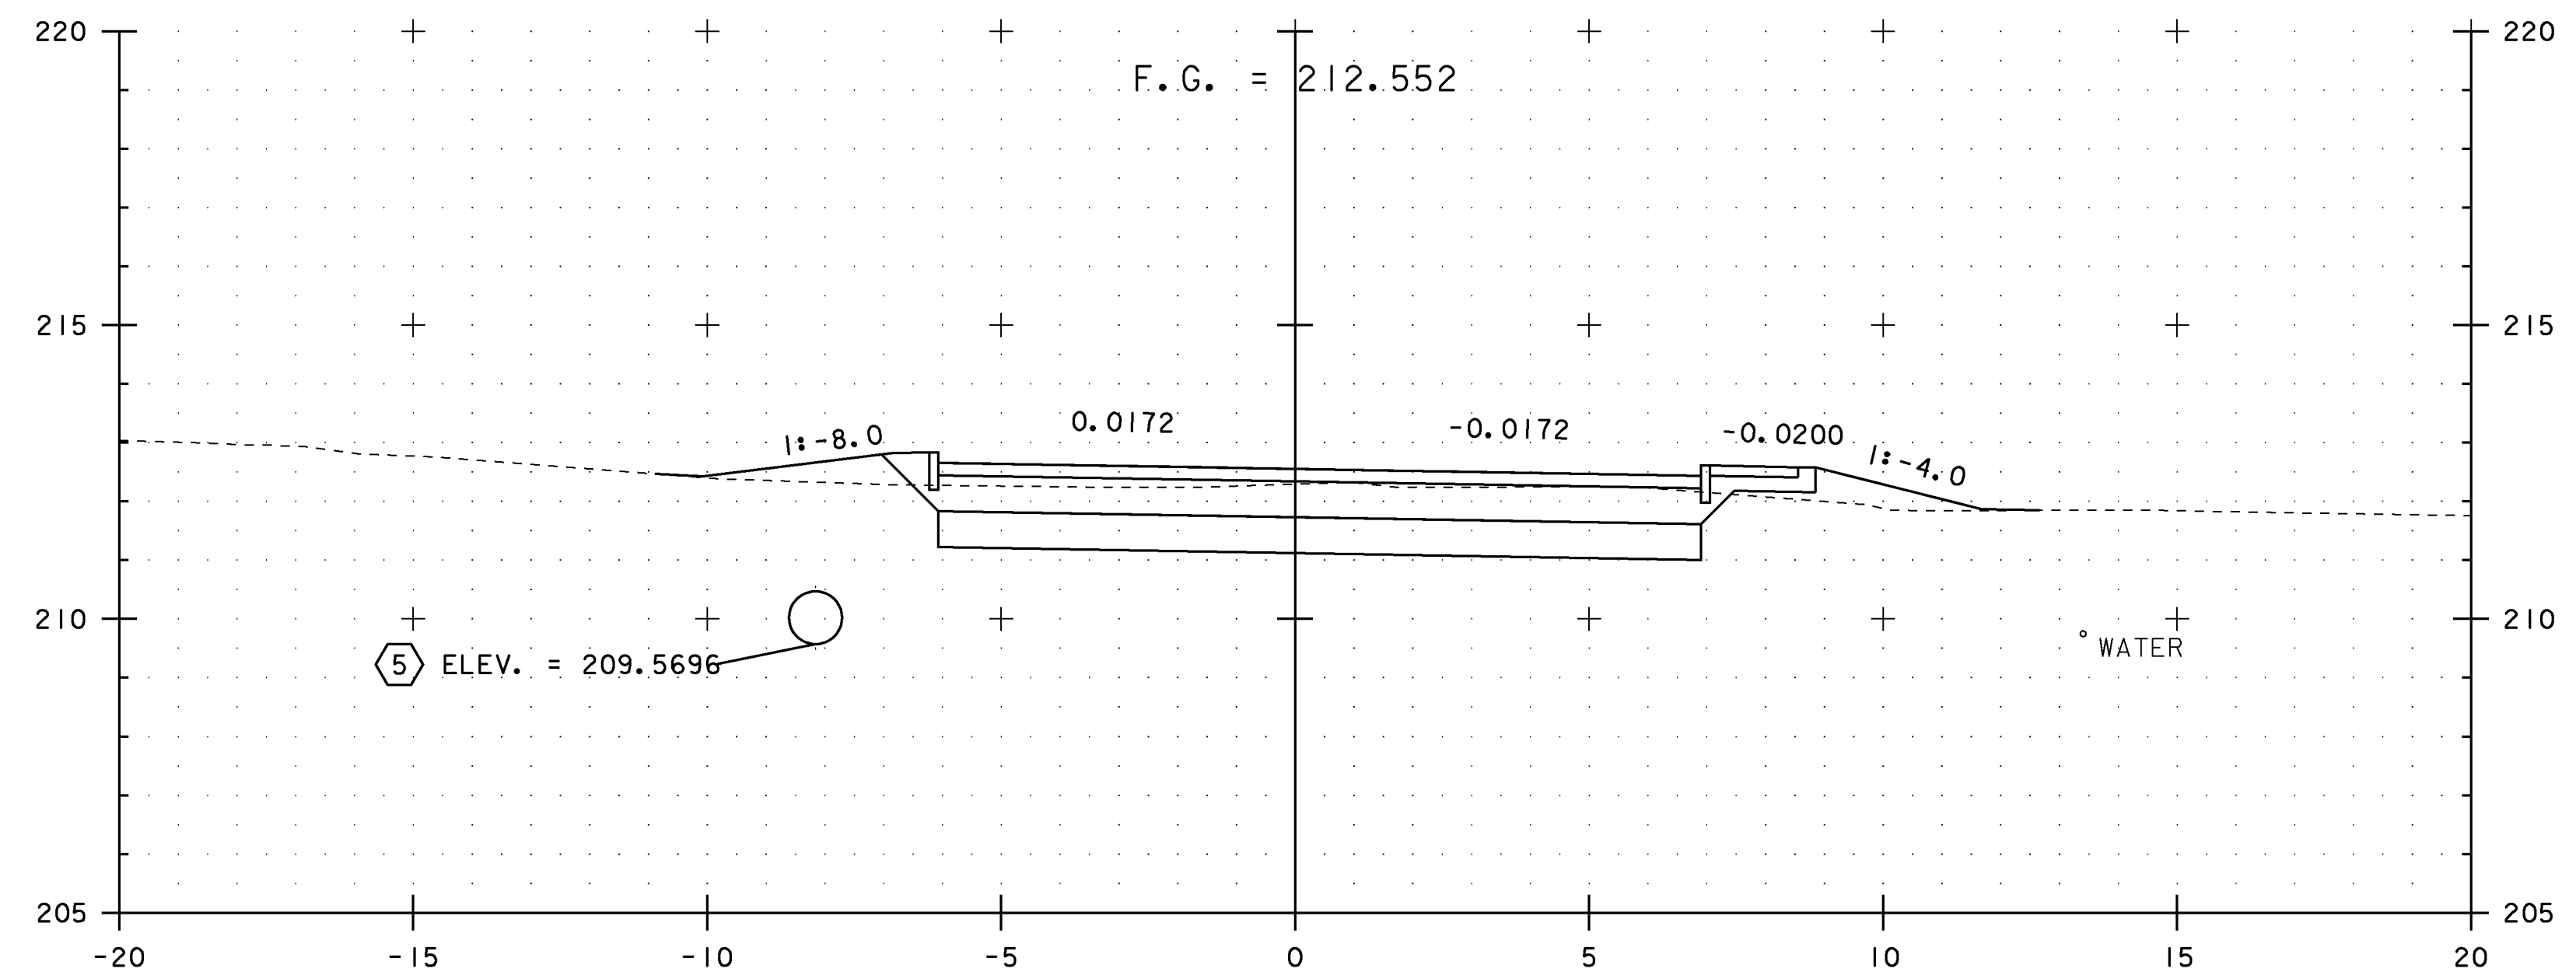

4+840.00

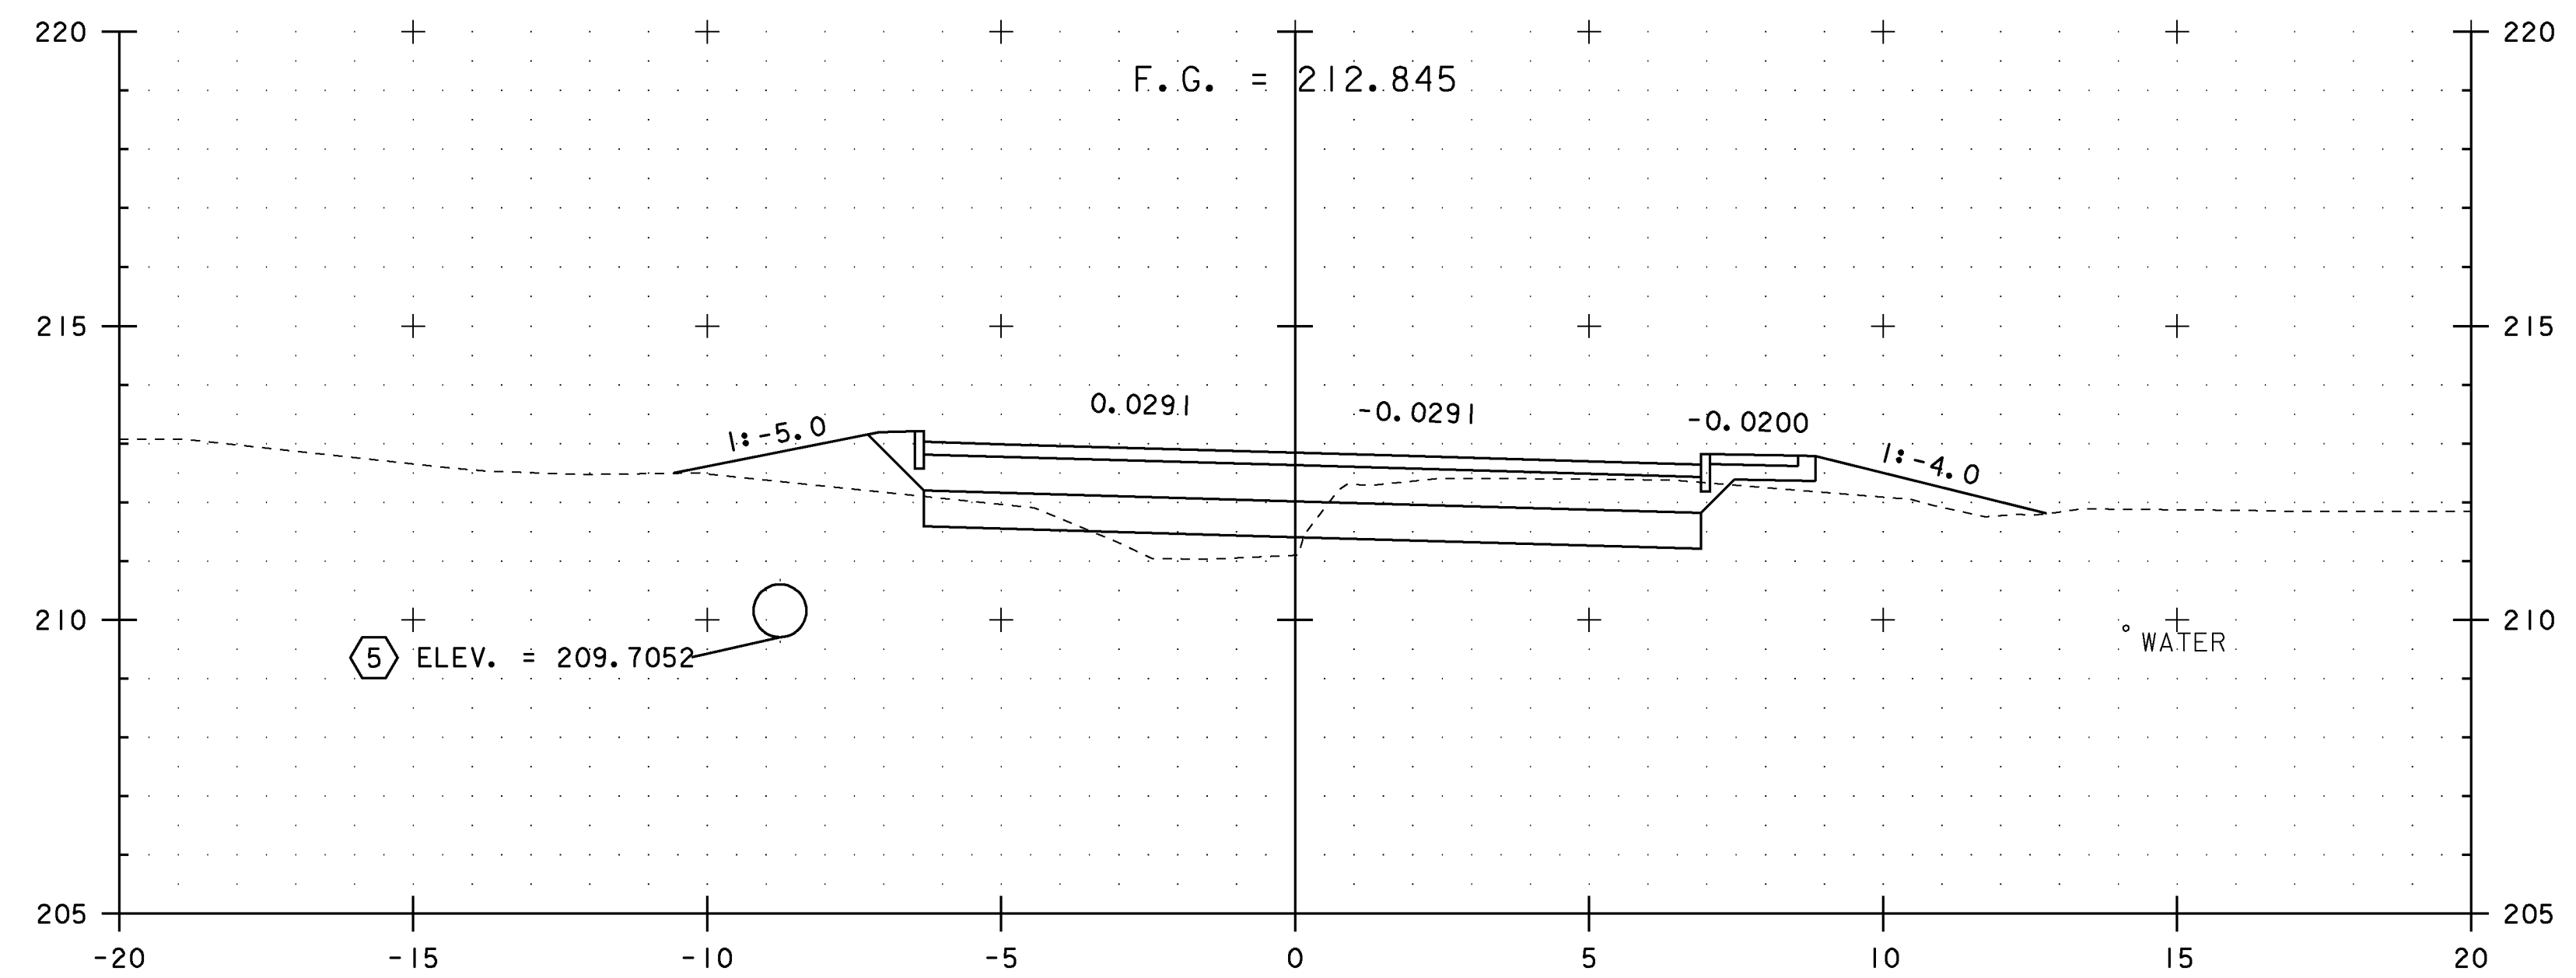

PT 4+832.86

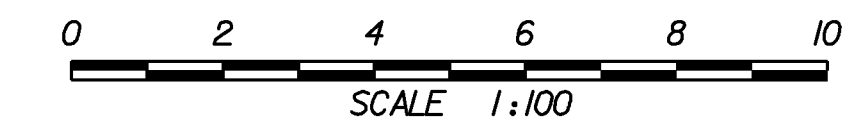




NOTES:

1. ALL BURIED UTILITIES ARE EXISTING, THE LOCATIONS ARE APPROXIMATE AND ARE TO REMAIN UNDISTURBED
2. DRAINAGE FEATURES DISPLAYED ON CROSS SECTIONS ARE PROJECTED. SEE DRAINAGE DETAIL SHEETS, LAYOUTS AND PROFILES FOR TRUE LOCATIONS

PROJECT NAME: EAST MONTPELIER
 PROJECT NUMBER: STPG 028 - 3(35)S

FILE NAME: +98b028xsl.dgn	PLOT DATE: 22-MAR-2010
PROJECT LEADER: J. SCHULTZ	DRAWN BY: D. LYMAN
DESIGNED BY: J. GRUCHACZ	CHECKED BY: J. DEVLIN
US ROUTE 2 CROSS SECTION SHEET 10	SHEET 108 OF 142

STA. 4+832.86 TO STA. 4+840

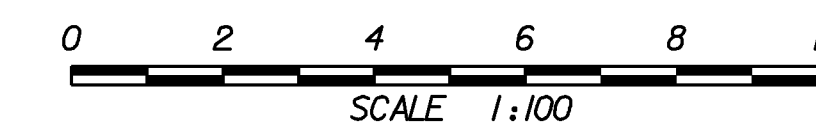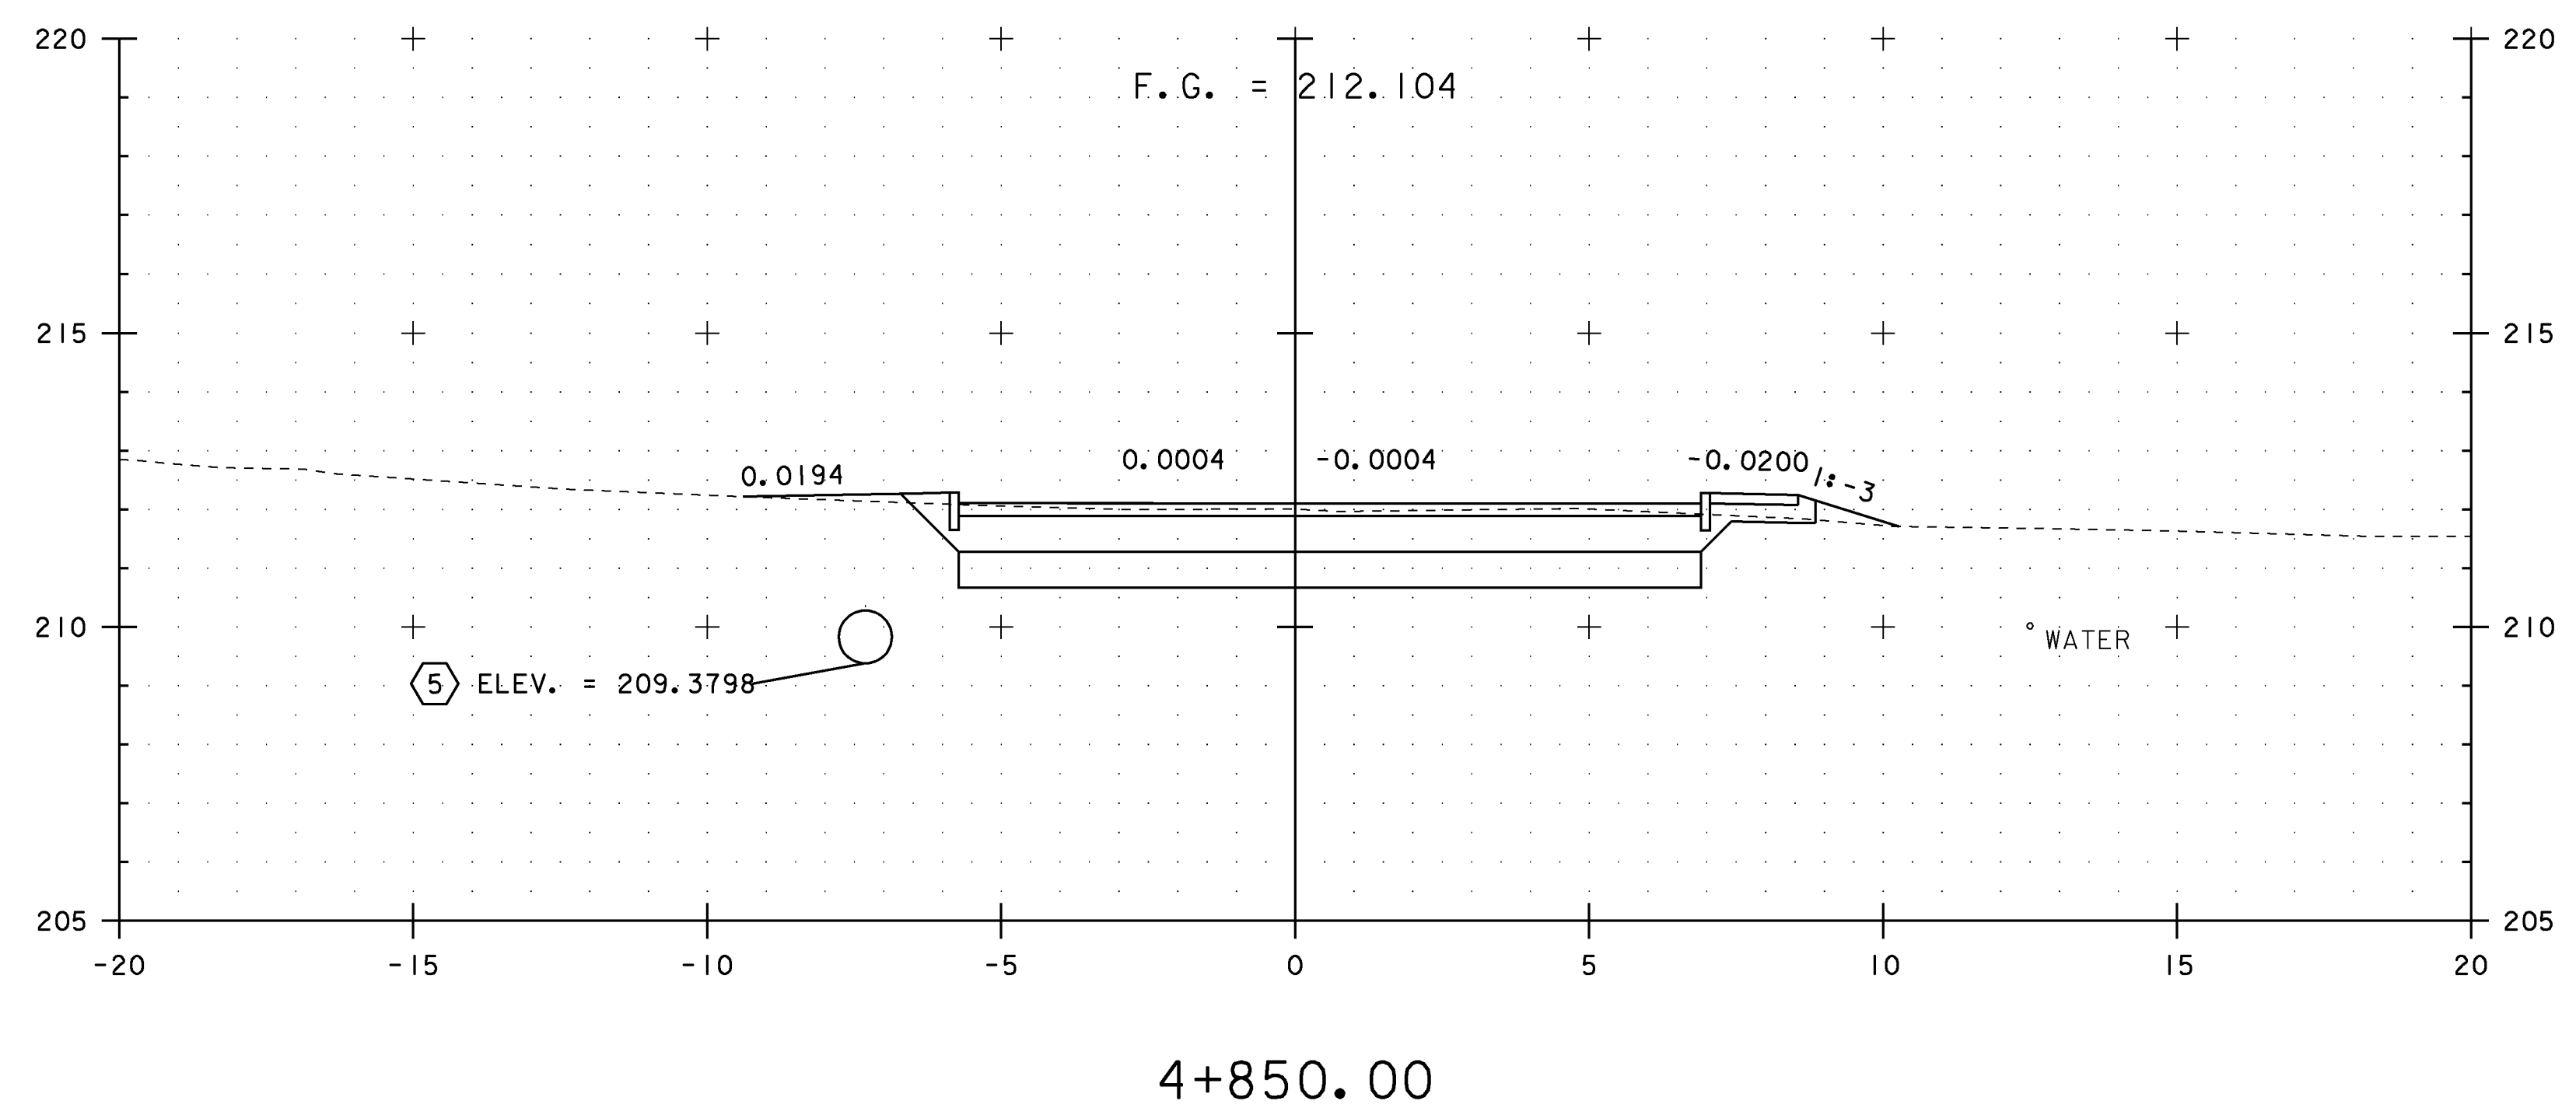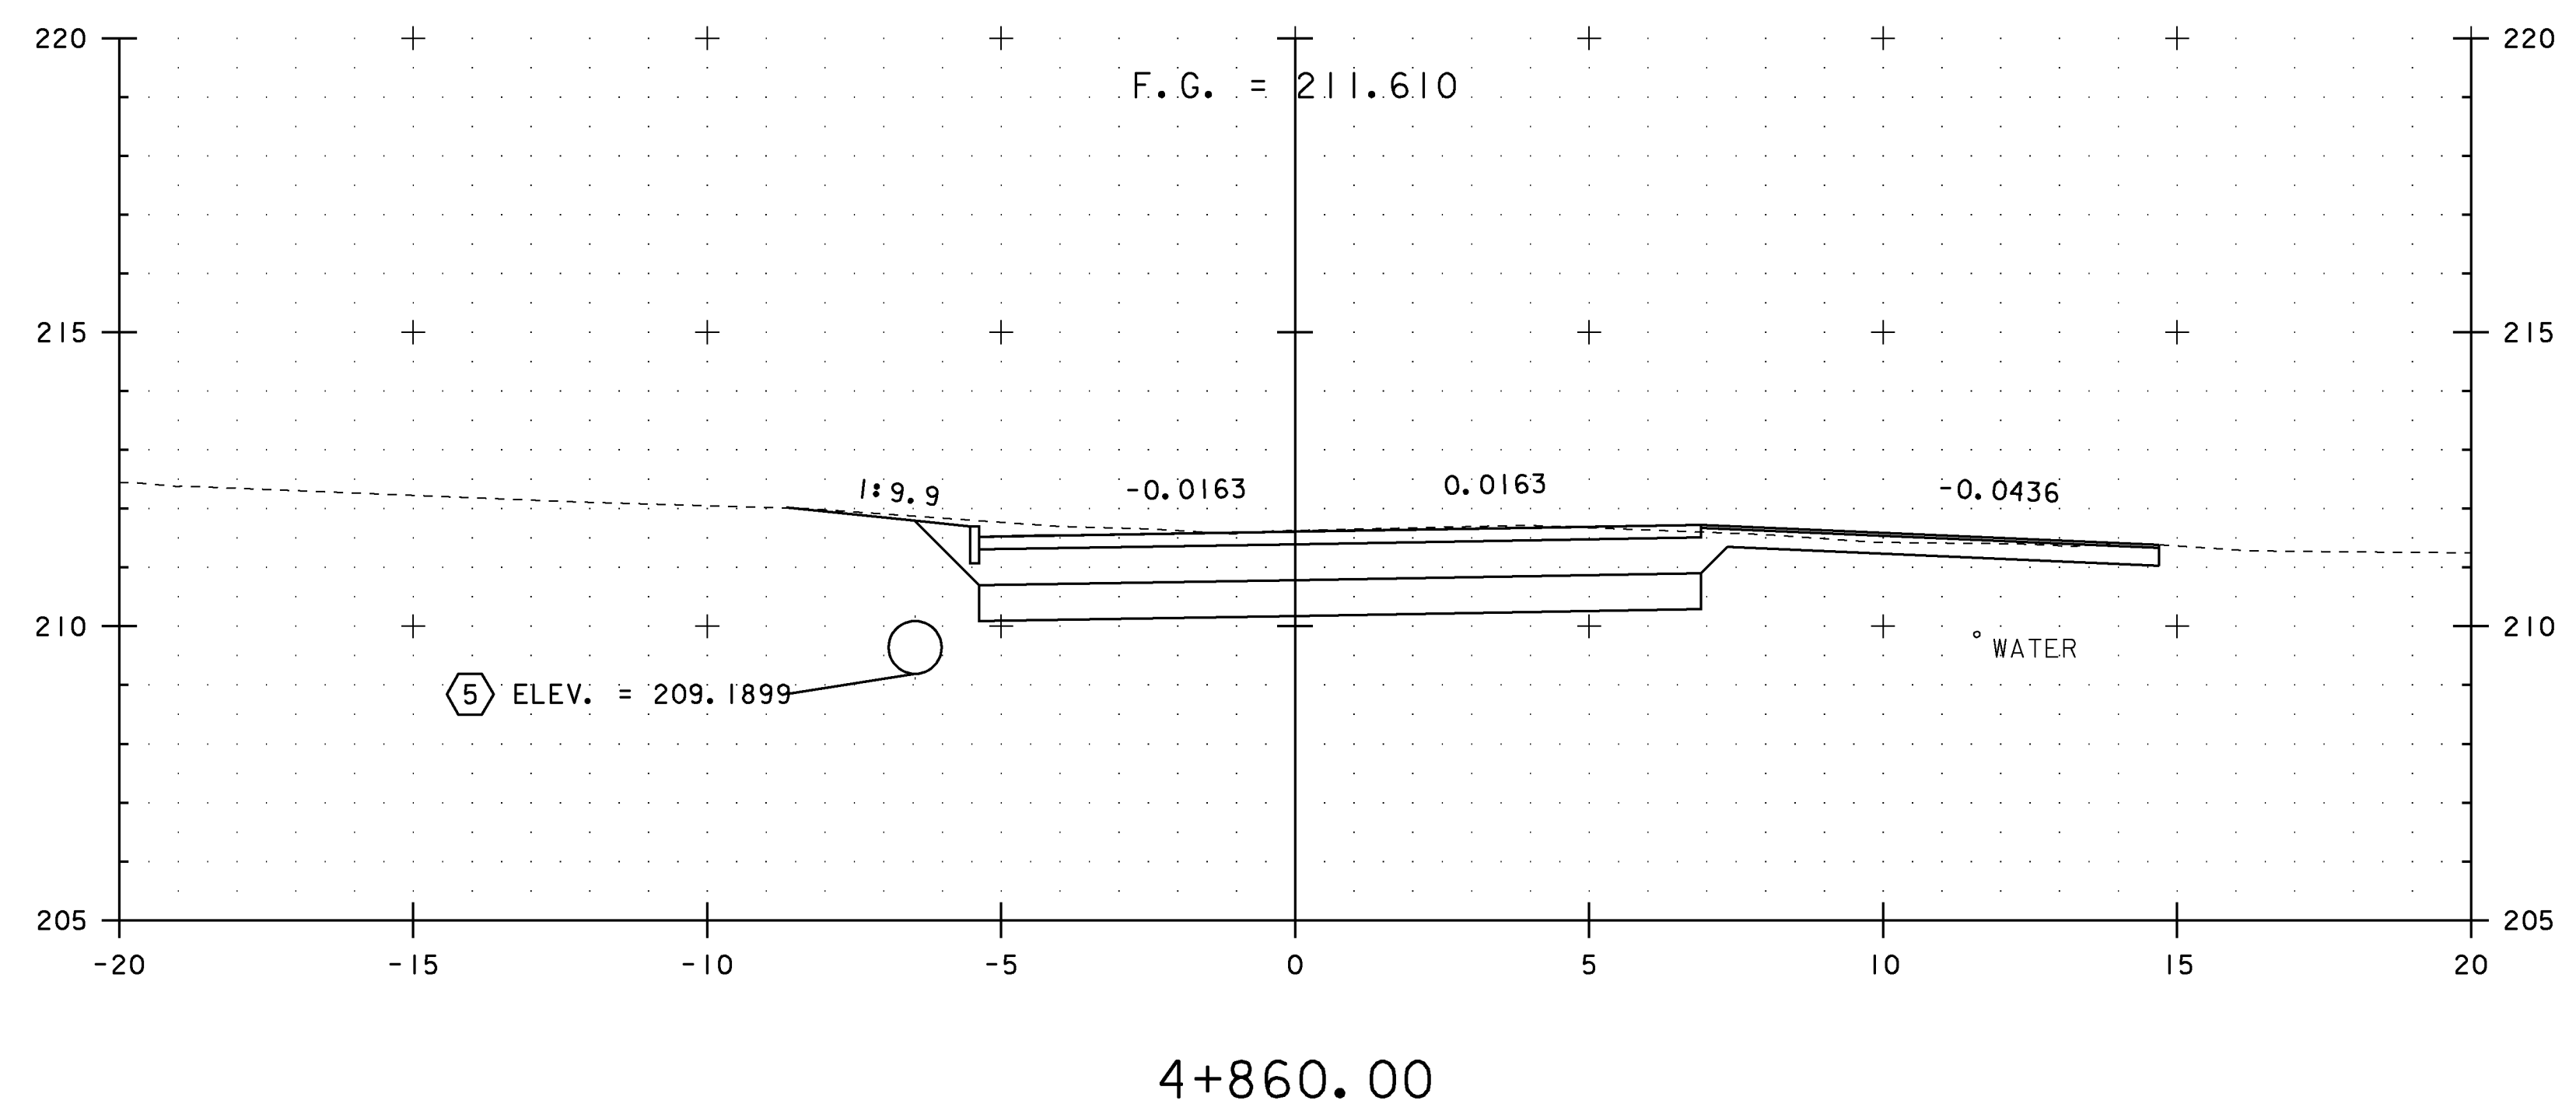





NOTES:

1. ALL BURIED UTILITIES ARE EXISTING, THE LOCATIONS ARE APPROXIMATE AND ARE TO REMAIN UNDISTURBED
2. DRAINAGE FEATURES DISPLAYED ON CROSS SECTIONS ARE PROJECTED. SEE DRAINAGE DETAIL SHEETS, LAYOUTS AND PROFILES FOR TRUE LOCATIONS

STA. 4+850 TO STA. 4+860

PROJECT NAME: EAST MONTPELIER
 PROJECT NUMBER: STPG 028 - 3(35)S

FILE NAME: +98b028xsl.dgn	PLOT DATE: 22-MAR-2010
PROJECT LEADER: J. SCHULTZ	DRAWN BY: D. LYMAN
DESIGNED BY: J. GRUCHACZ	CHECKED BY: J. DEVLIN
US ROUTE 2 CROSS SECTION SHEET II	SHEET 109 OF 142

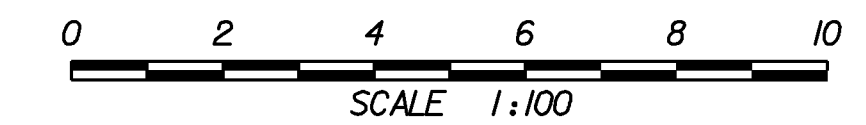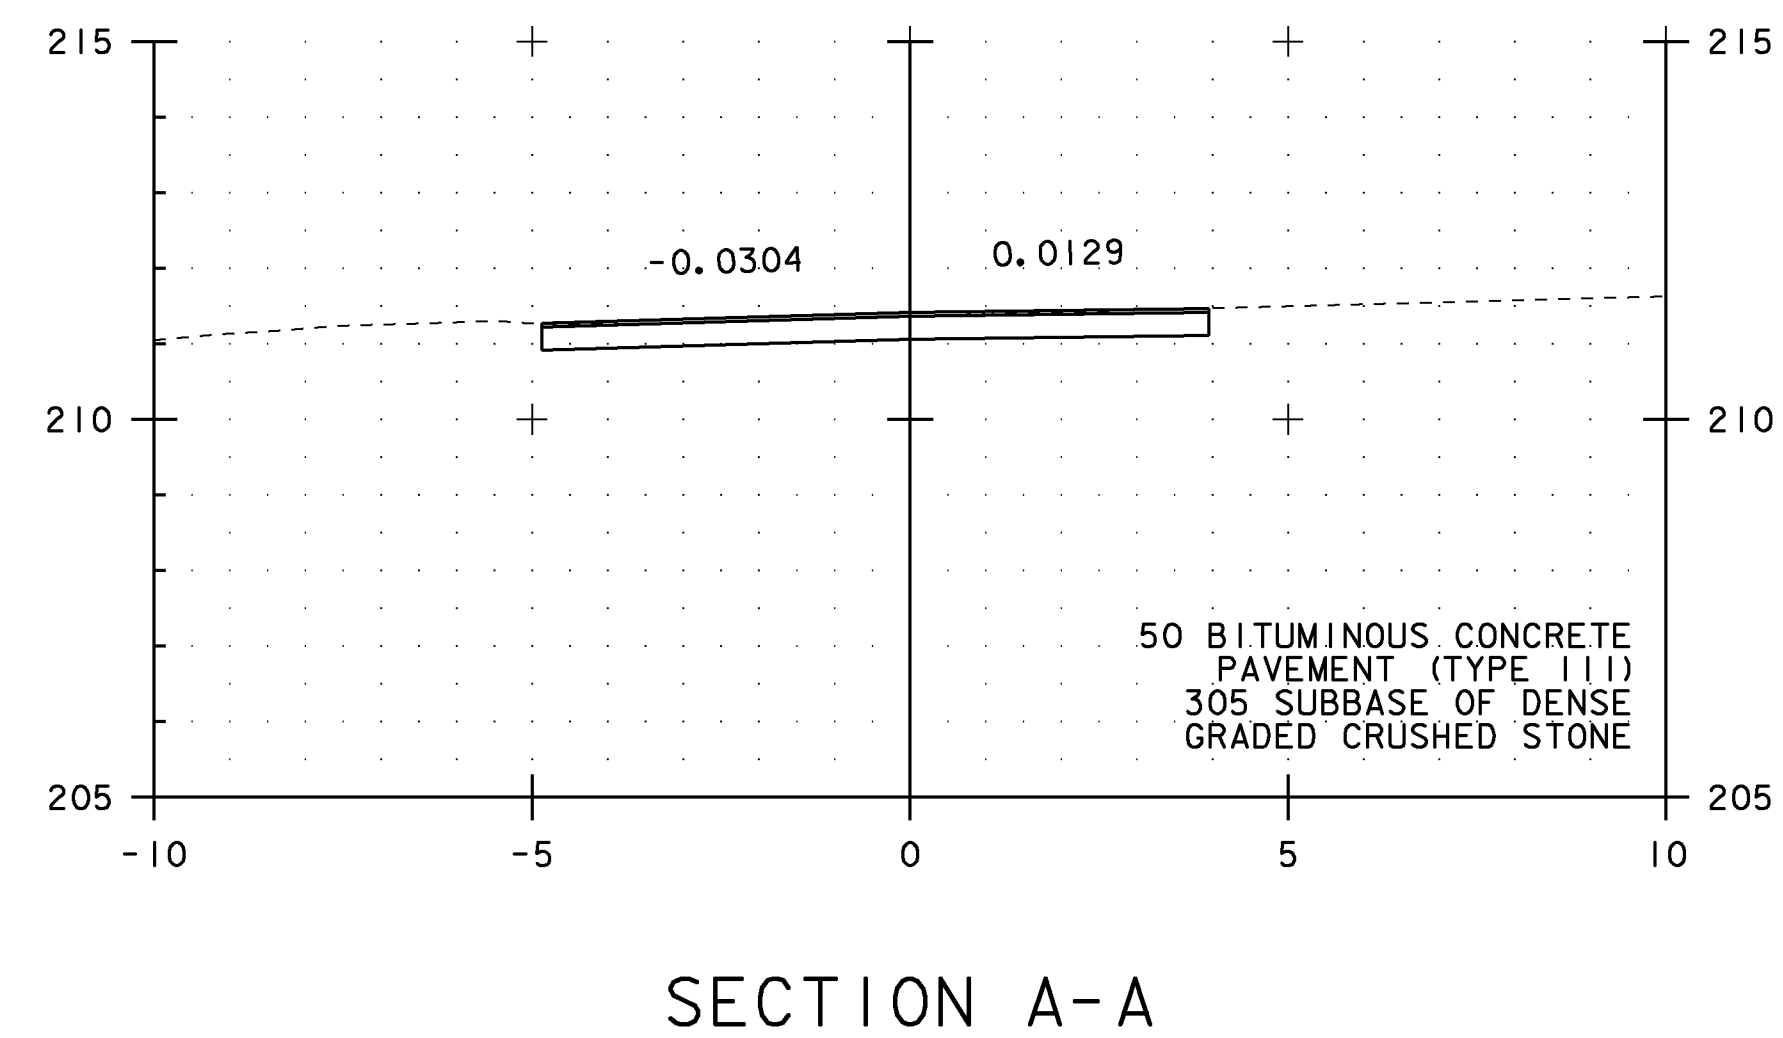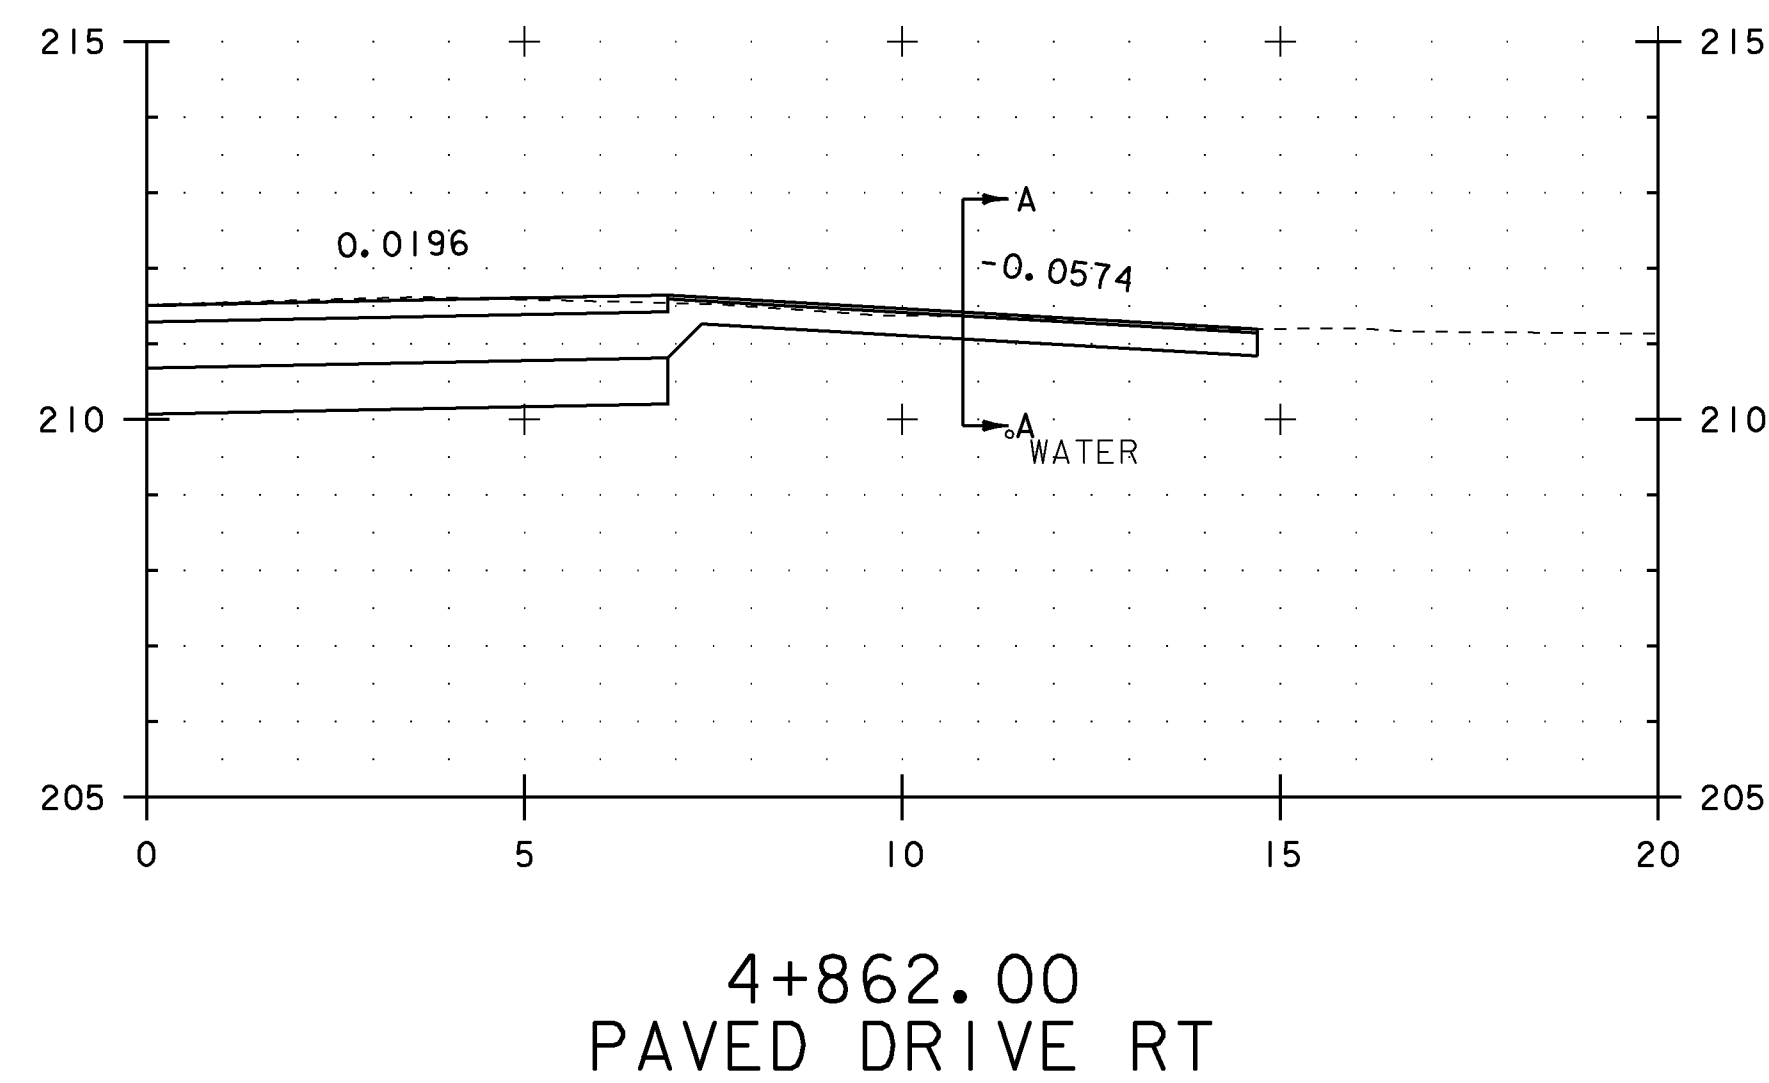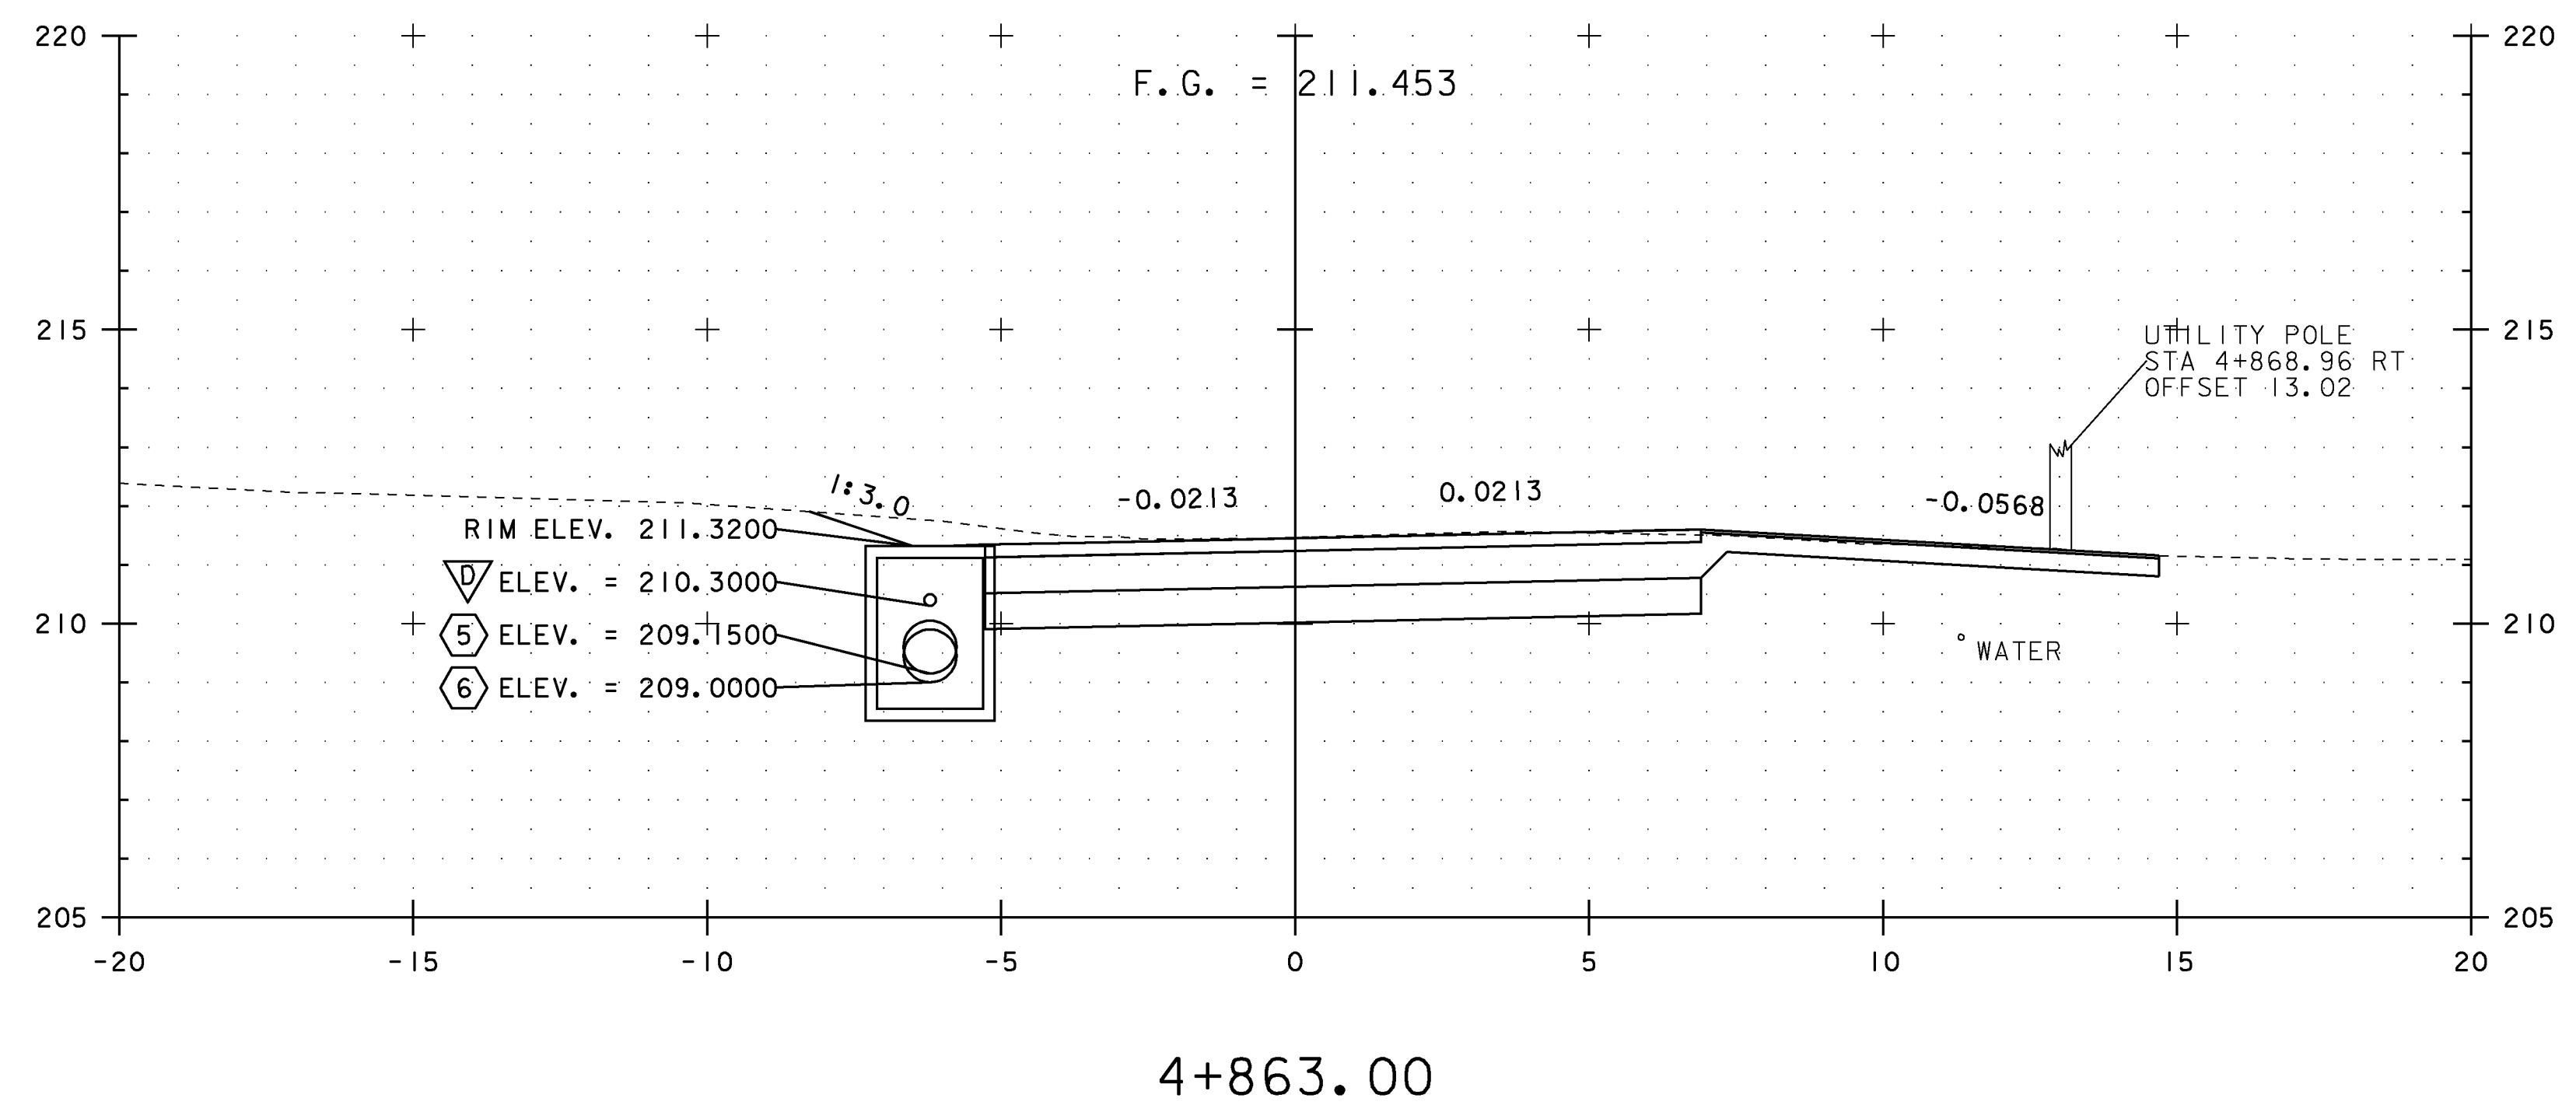

NOTES:


1. ALL BURIED UTILITIES ARE EXISTING, THE LOCATIONS ARE APPROXIMATE AND ARE TO REMAIN UNDISTURBED
2. DRAINAGE FEATURES DISPLAYED ON CROSS SECTIONS ARE PROJECTED. SEE DRAINAGE DETAIL SHEETS, LAYOUTS AND PROFILES FOR TRUE LOCATIONS

PROJECT NAME: EAST MONTPELIER
 PROJECT NUMBER: STPG 028 - 3(35)S


FILE NAME: +98b028xsl.dgn
 PROJECT LEADER: J. SCHULTZ
 DESIGNED BY: J. GRUCHACZ
 US ROUTE 2 CROSS SECTION SHEET 12

PLOT DATE: 22-MAR-2010
 DRAWN BY: D. LYMAN
 CHECKED BY: J. DEVLIN
 SHEET 110 OF 142


STA. 4+862 TO STA. 4+863

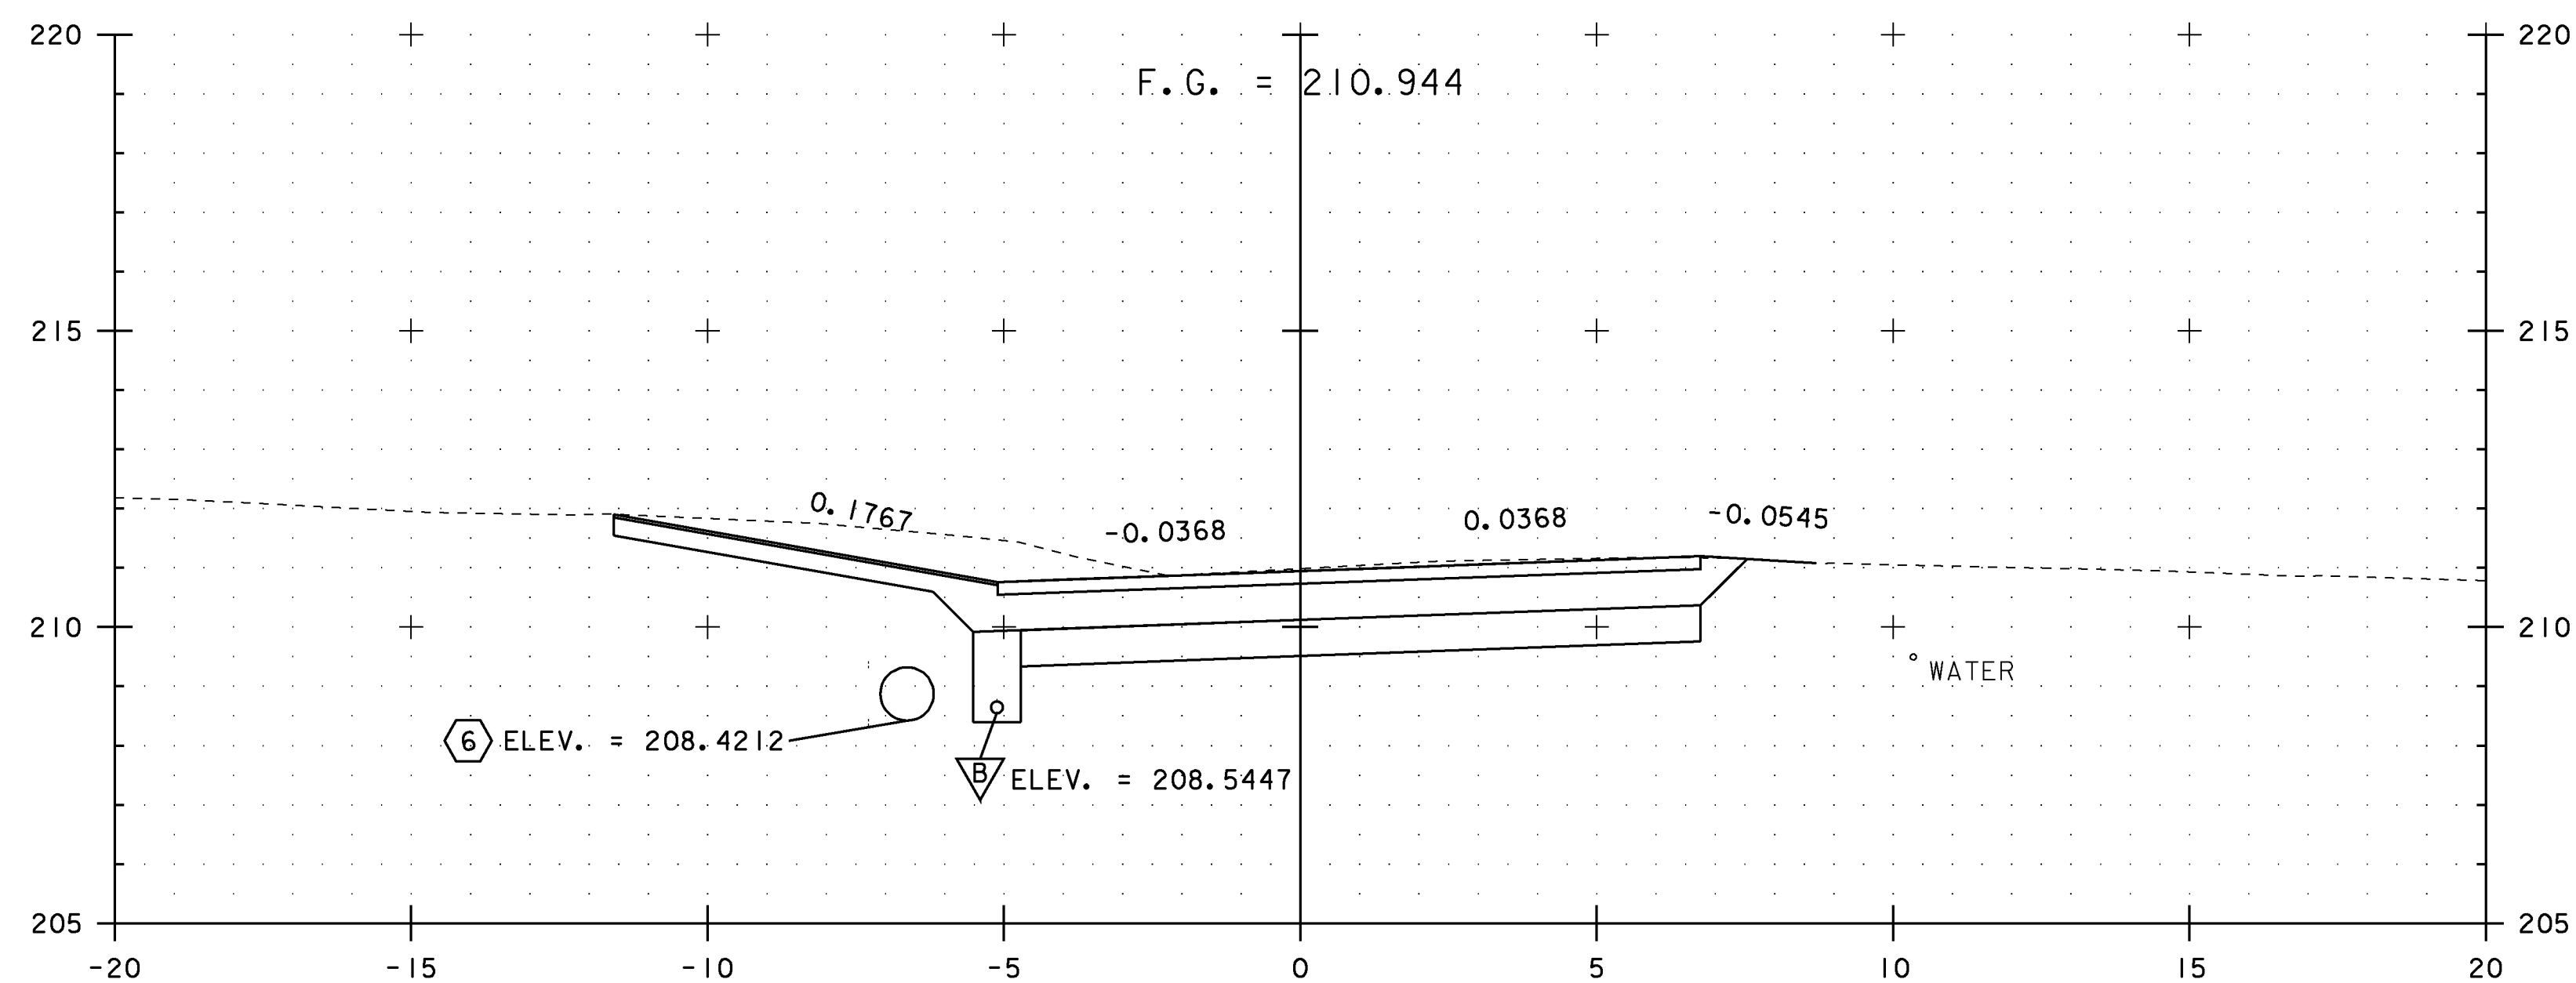


PC 4+872.25

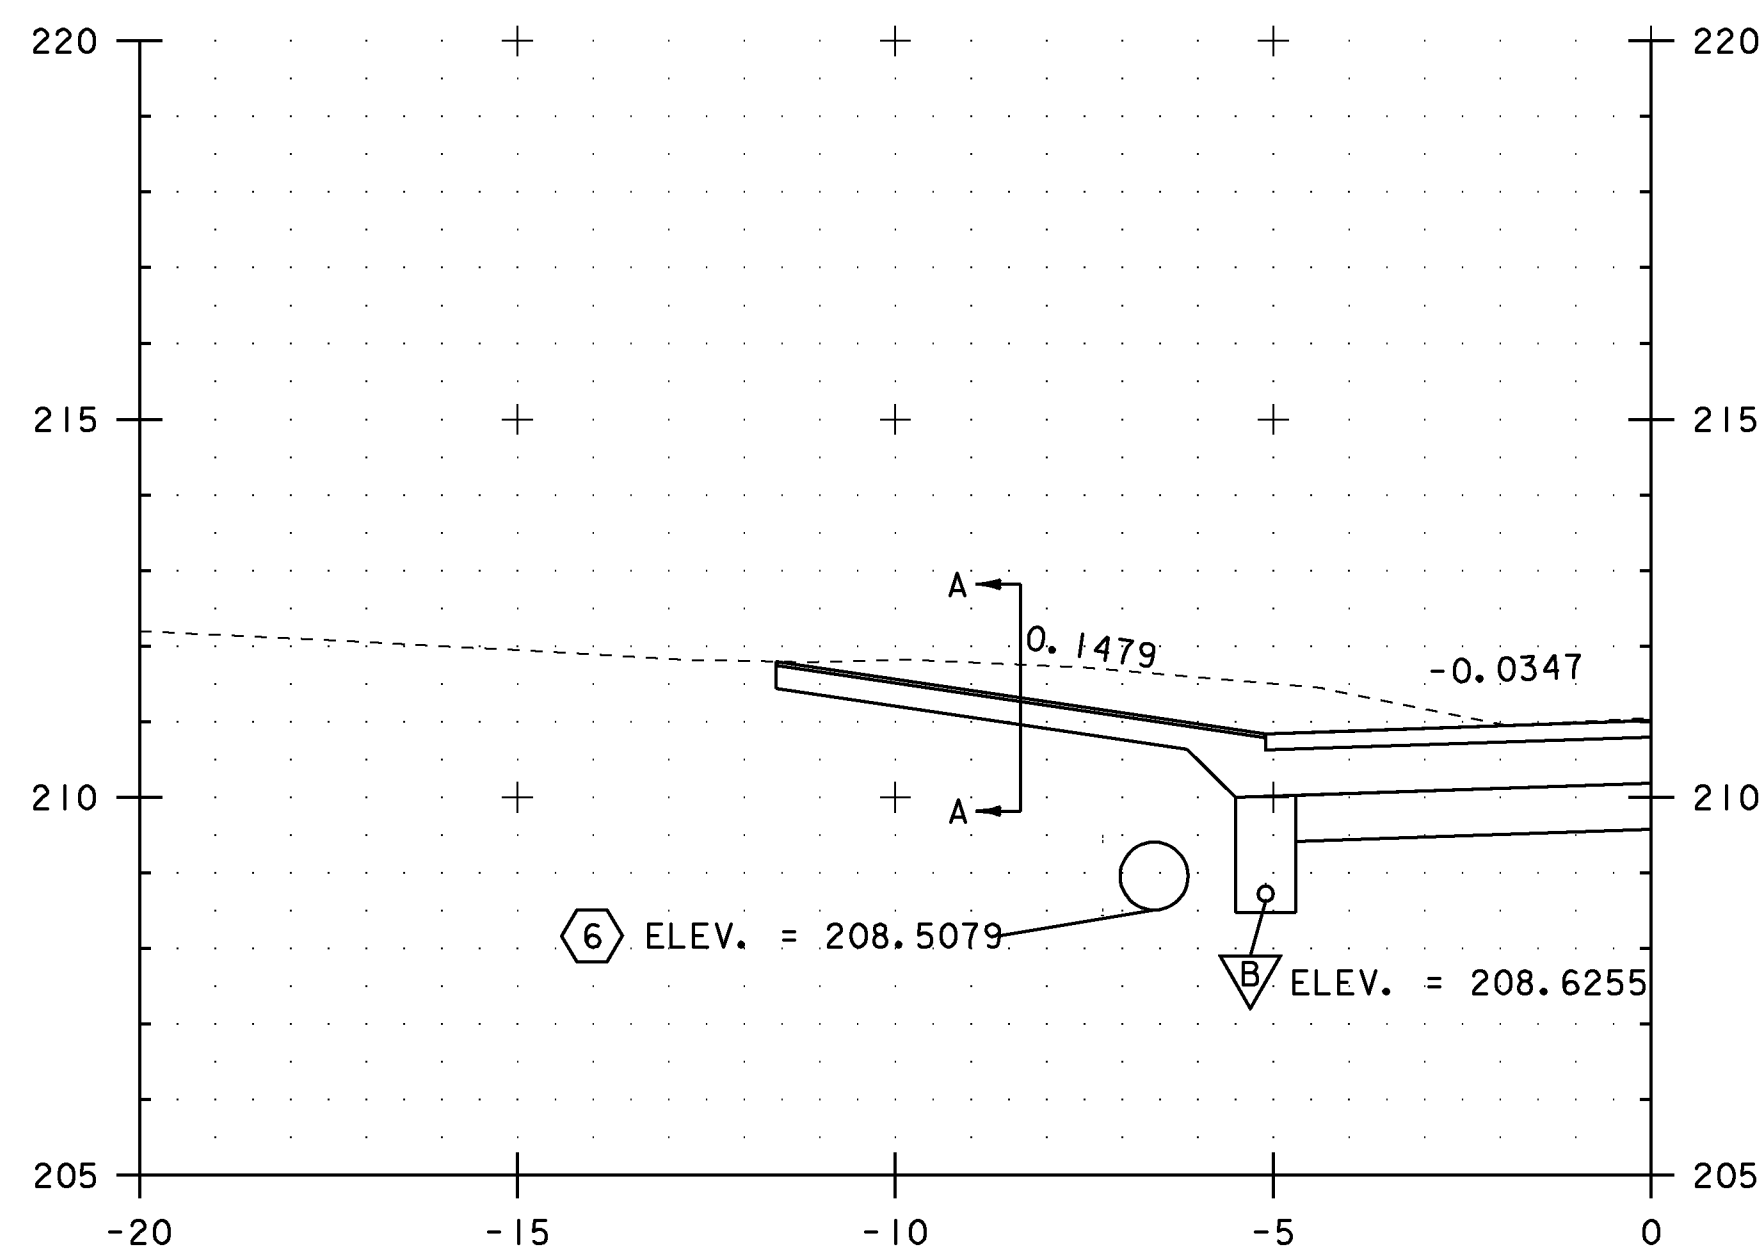

4+871.00
PAVED DRIVE LT

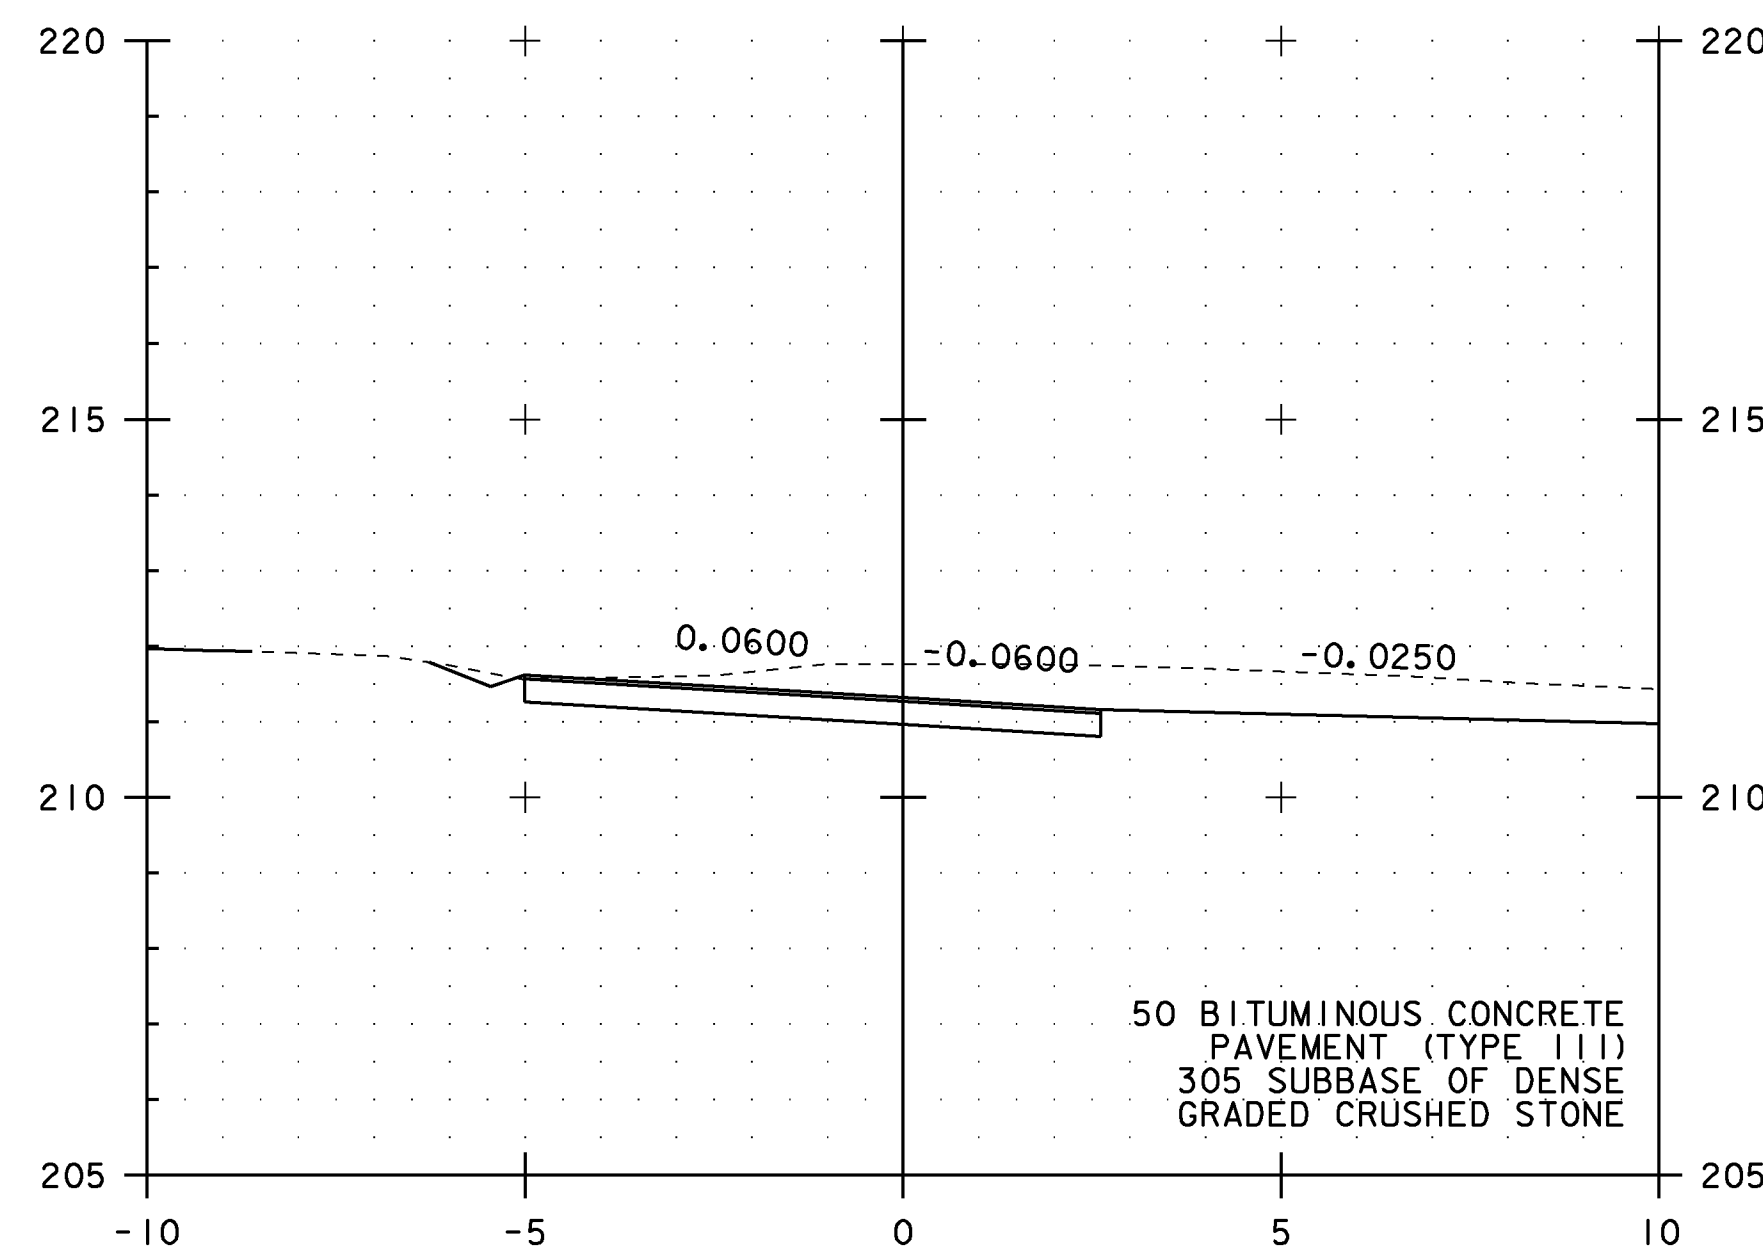

SECTION A-A

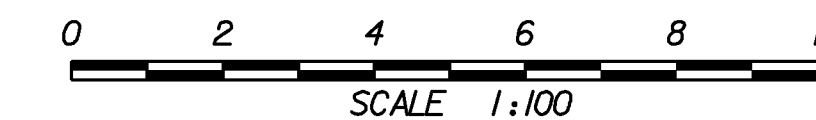

NOTES:




1. ALL BURIED UTILITIES ARE EXISTING, THE LOCATIONS ARE APPROXIMATE AND ARE TO REMAIN UNDISTURBED
2. DRAINAGE FEATURES DISPLAYED ON CROSS SECTIONS ARE PROJECTED. SEE DRAINAGE DETAIL SHEETS, LAYOUTS AND PROFILES FOR TRUE LOCATIONS

STA. 4+871 TO STA. 4+872.25

PROJECT NAME: EAST MONTEPELIER
PROJECT NUMBER: STPG 028 - 3(35)S

FILE NAME: +98b028xsl.dgn
PROJECT LEADER: J. SCHULTZ
DESIGNED BY: J. GRUCHACZ
US ROUTE 2 CROSS SECTION SHEET 13

PLOT DATE: 22-MAR-2010
DRAWN BY: D. LYMAN
CHECKED BY: J. DEVLIN
SHEET III OF 142

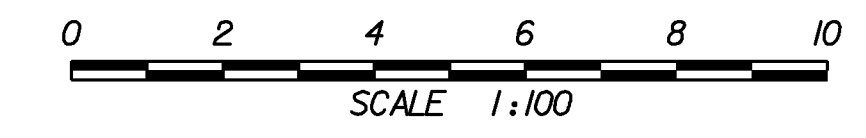
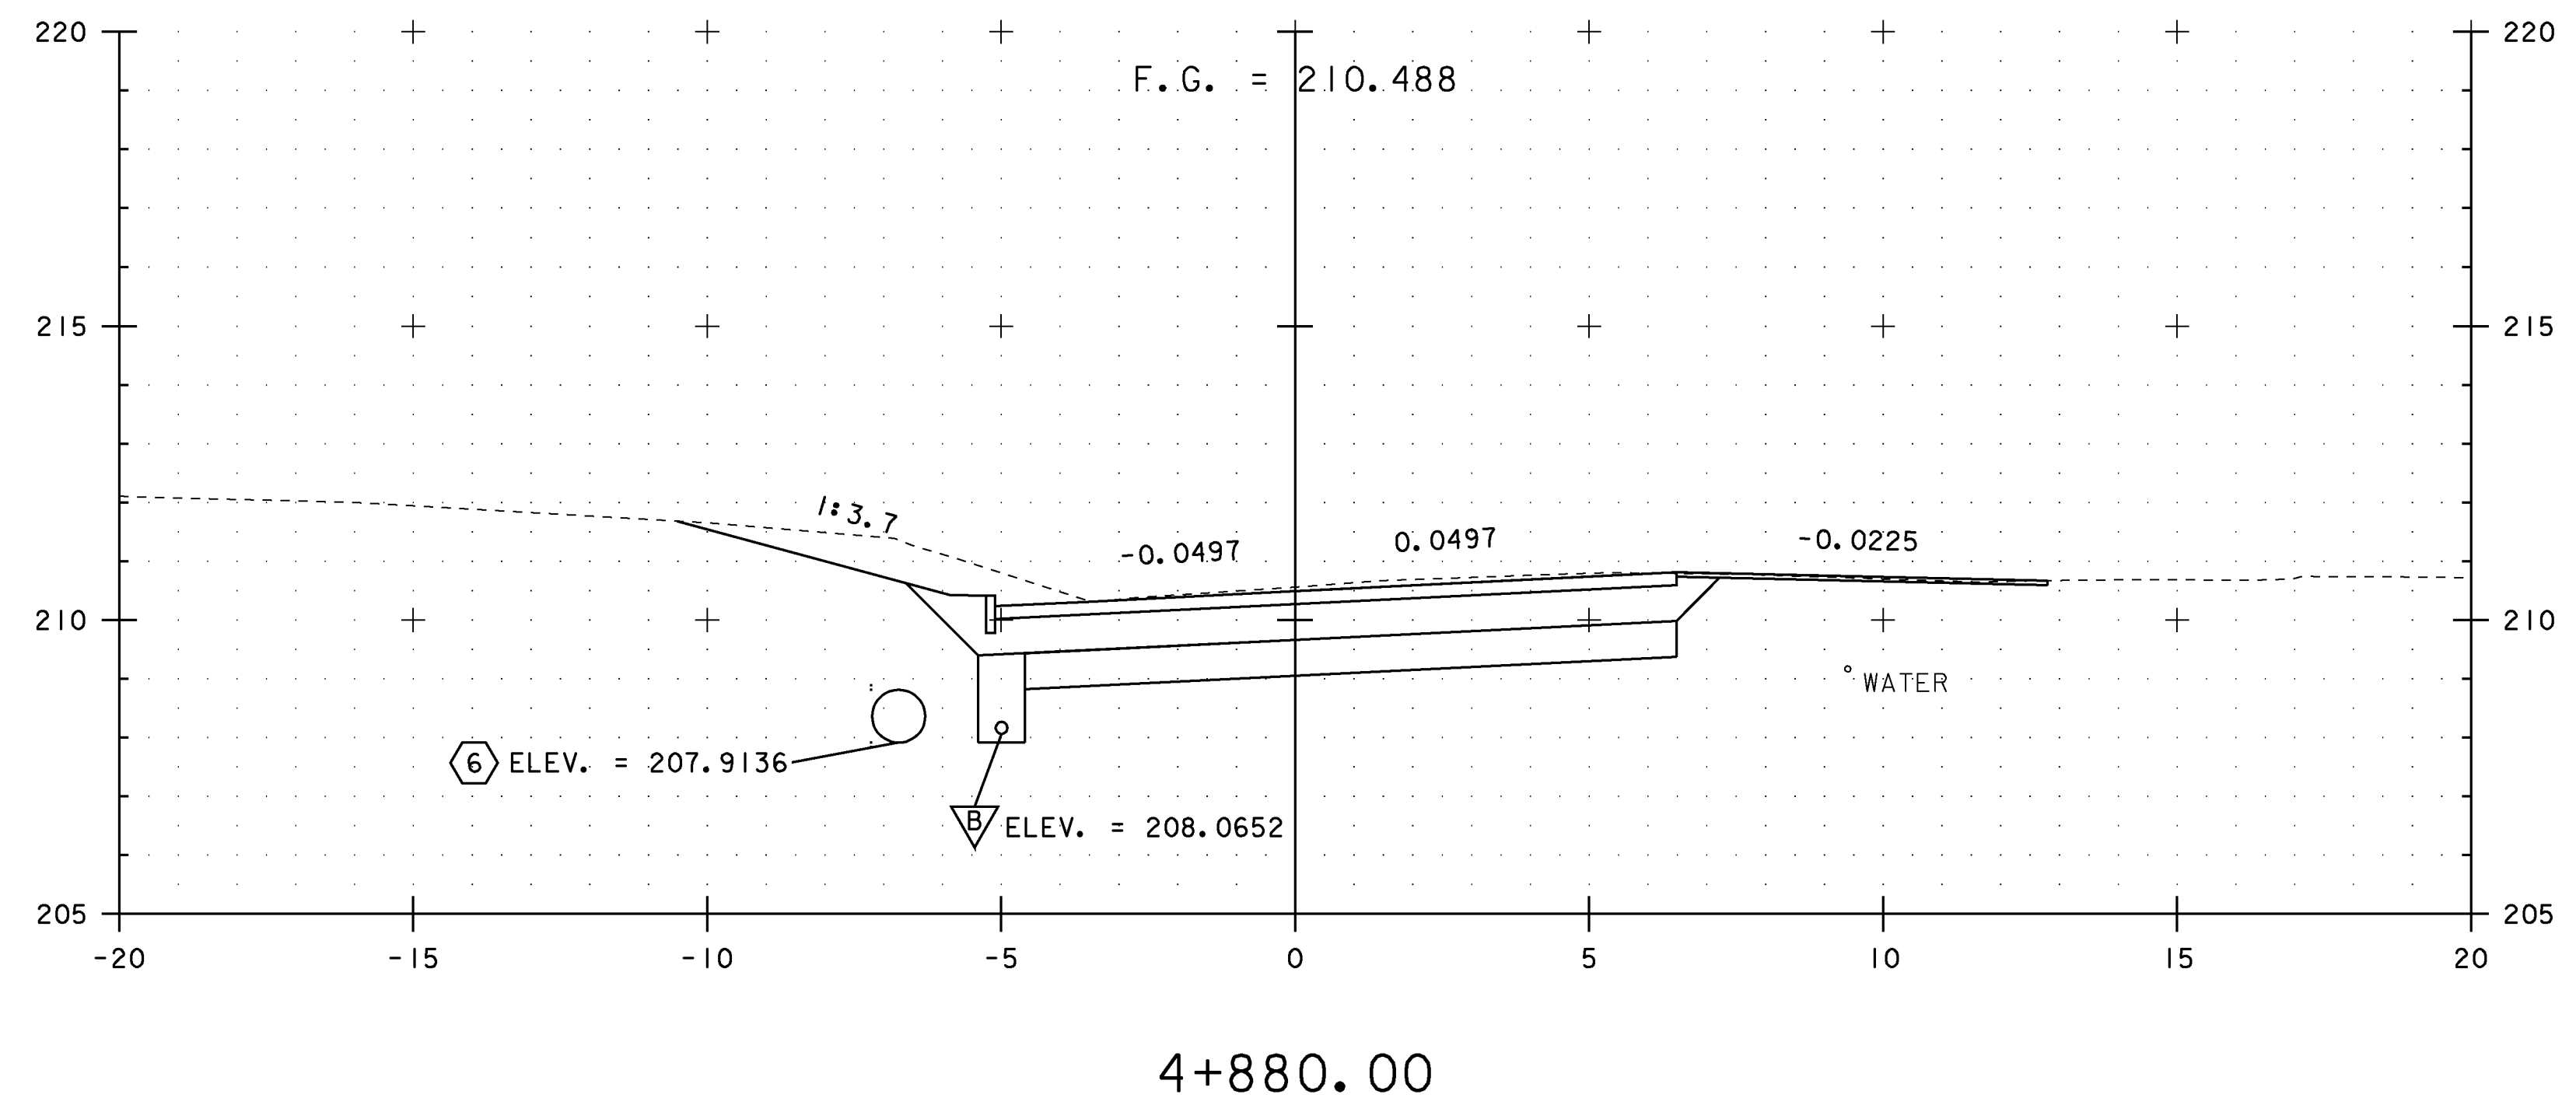
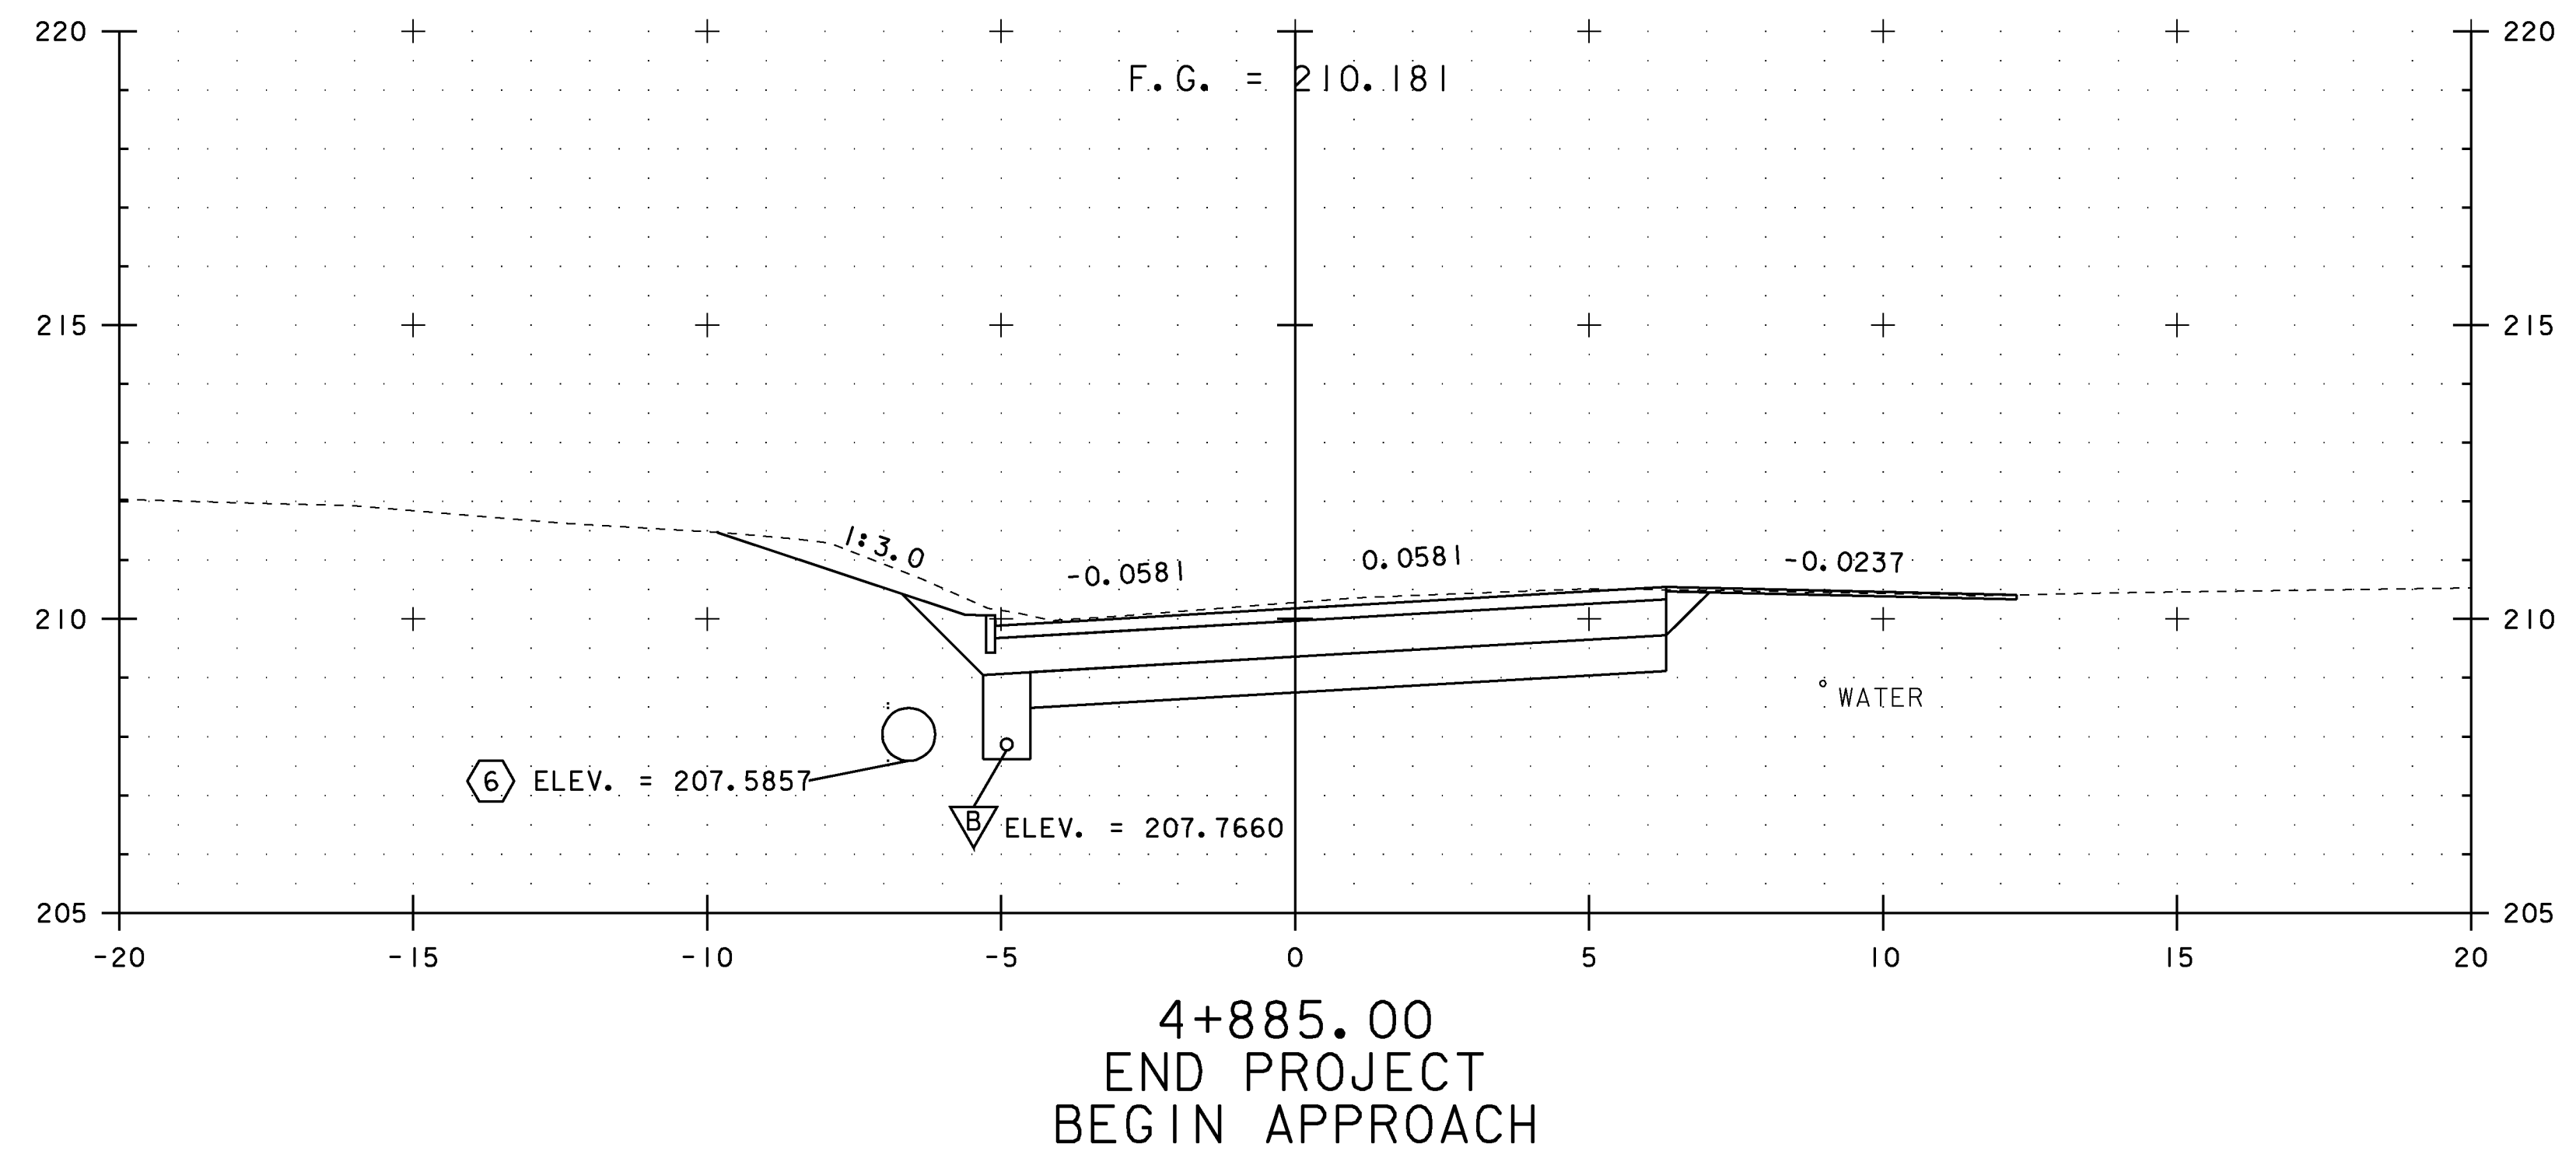


NOTES:

1. ALL BURIED UTILITIES ARE EXISTING, THE LOCATIONS ARE APPROXIMATE AND ARE TO REMAIN UNDISTURBED
2. DRAINAGE FEATURES DISPLAYED ON CROSS SECTIONS ARE PROJECTED. SEE DRAINAGE DETAIL SHEETS, LAYOUTS AND PROFILES FOR TRUE LOCATIONS

PROJECT NAME: EAST MONTPELIER	
PROJECT NUMBER: STPG 028 - 3(35)S	
FILE NAME: +98b028xsl.dgn	PLOT DATE: 22-MAR-2010
PROJECT LEADER: J. SCHULTZ	DRAWN BY: D. LYMAN
DESIGNED BY: J. GRUCHACZ	CHECKED BY: J. DEVLIN
US ROUTE 2 CROSS SECTION SHEET 14	SHEET 112 OF 142

STA. 4+880 TO STA. 4+885

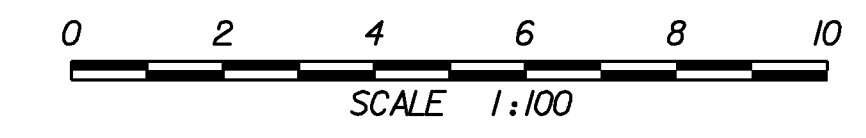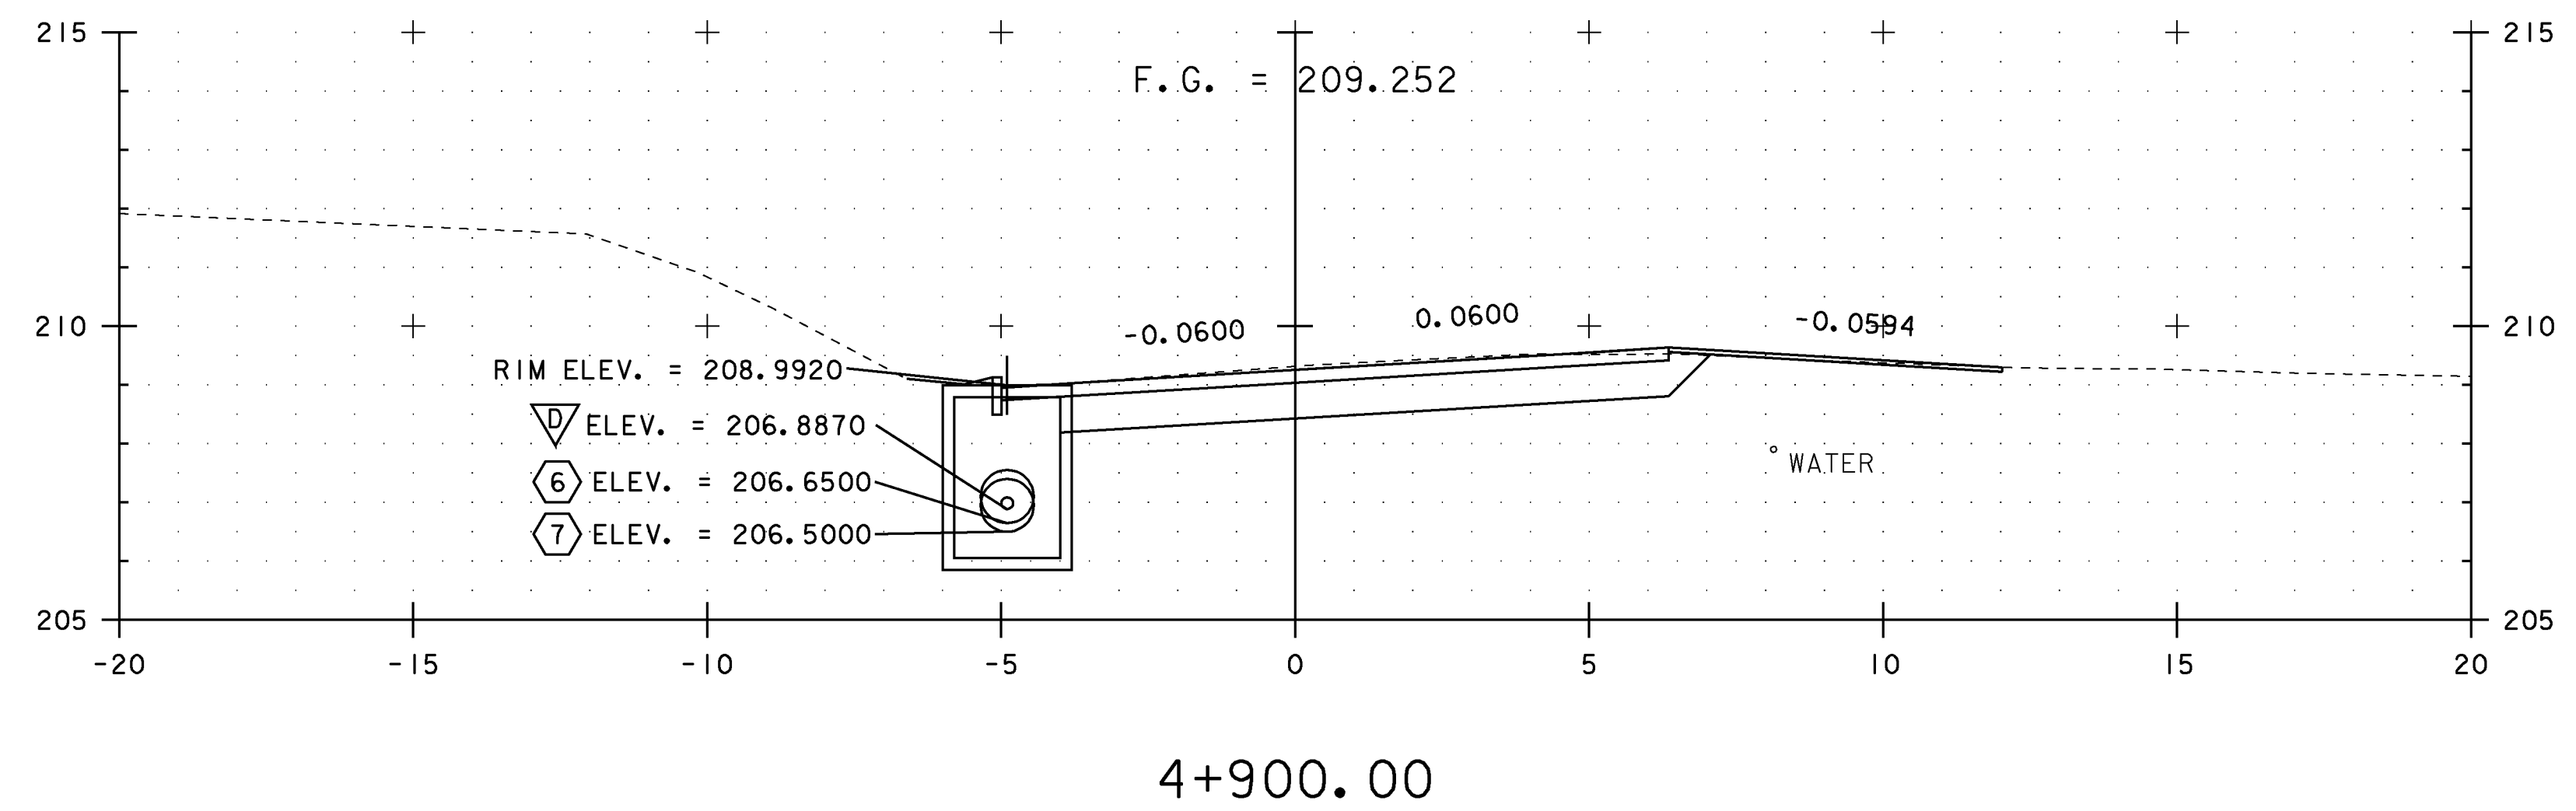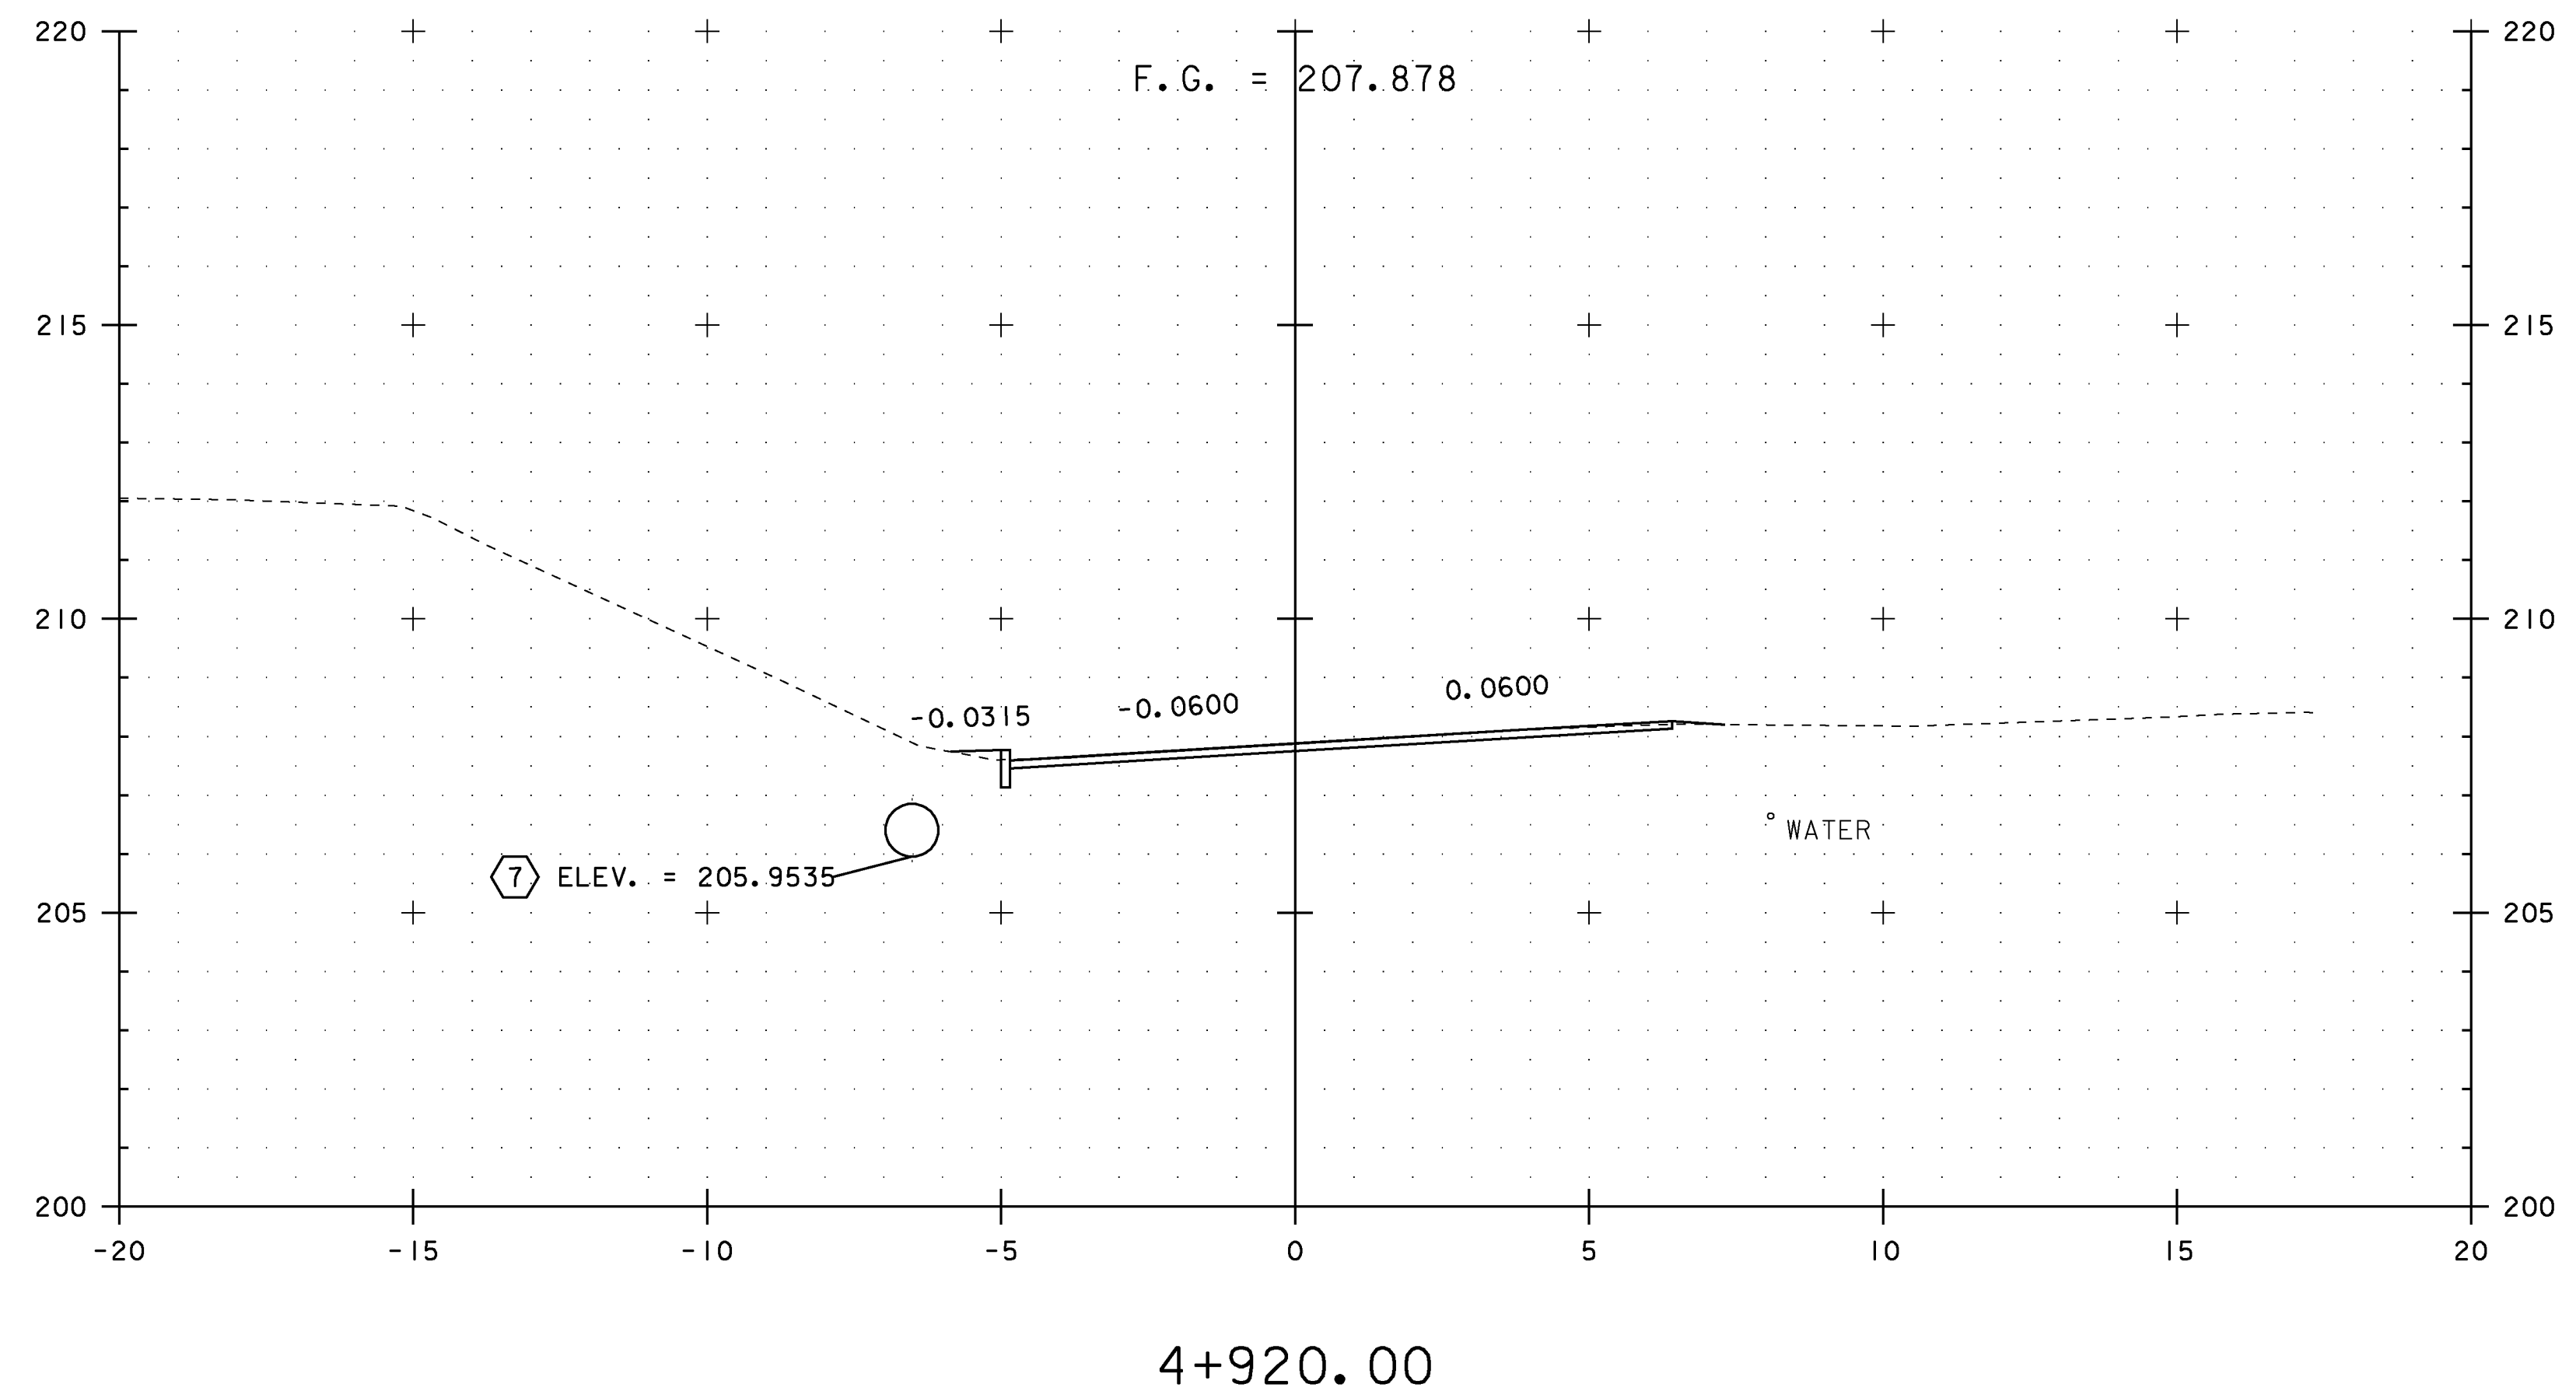


NOTES:

1. ALL BURIED UTILITIES ARE EXISTING, THE LOCATIONS ARE APPROXIMATE AND ARE TO REMAIN UNDISTURBED
2. DRAINAGE FEATURES DISPLAYED ON CROSS SECTIONS ARE PROJECTED. SEE DRAINAGE DETAIL SHEETS, LAYOUTS AND PROFILES FOR TRUE LOCATIONS


STA. 4+900 TO STA. 4+920

PROJECT NAME: EAST MONTPELIER
 PROJECT NUMBER: STPG 028 - 3(35)S


FILE NAME: +98b028xsl.dgn	PLOT DATE: 22-MAR-2010
PROJECT LEADER: J. SCHULTZ	DRAWN BY: D. LYMAN
DESIGNED BY: J. GRUCHACZ	CHECKED BY: J. DEVLIN
US ROUTE 2 CROSS SECTION SHEET 15	SHEET 113 OF 142

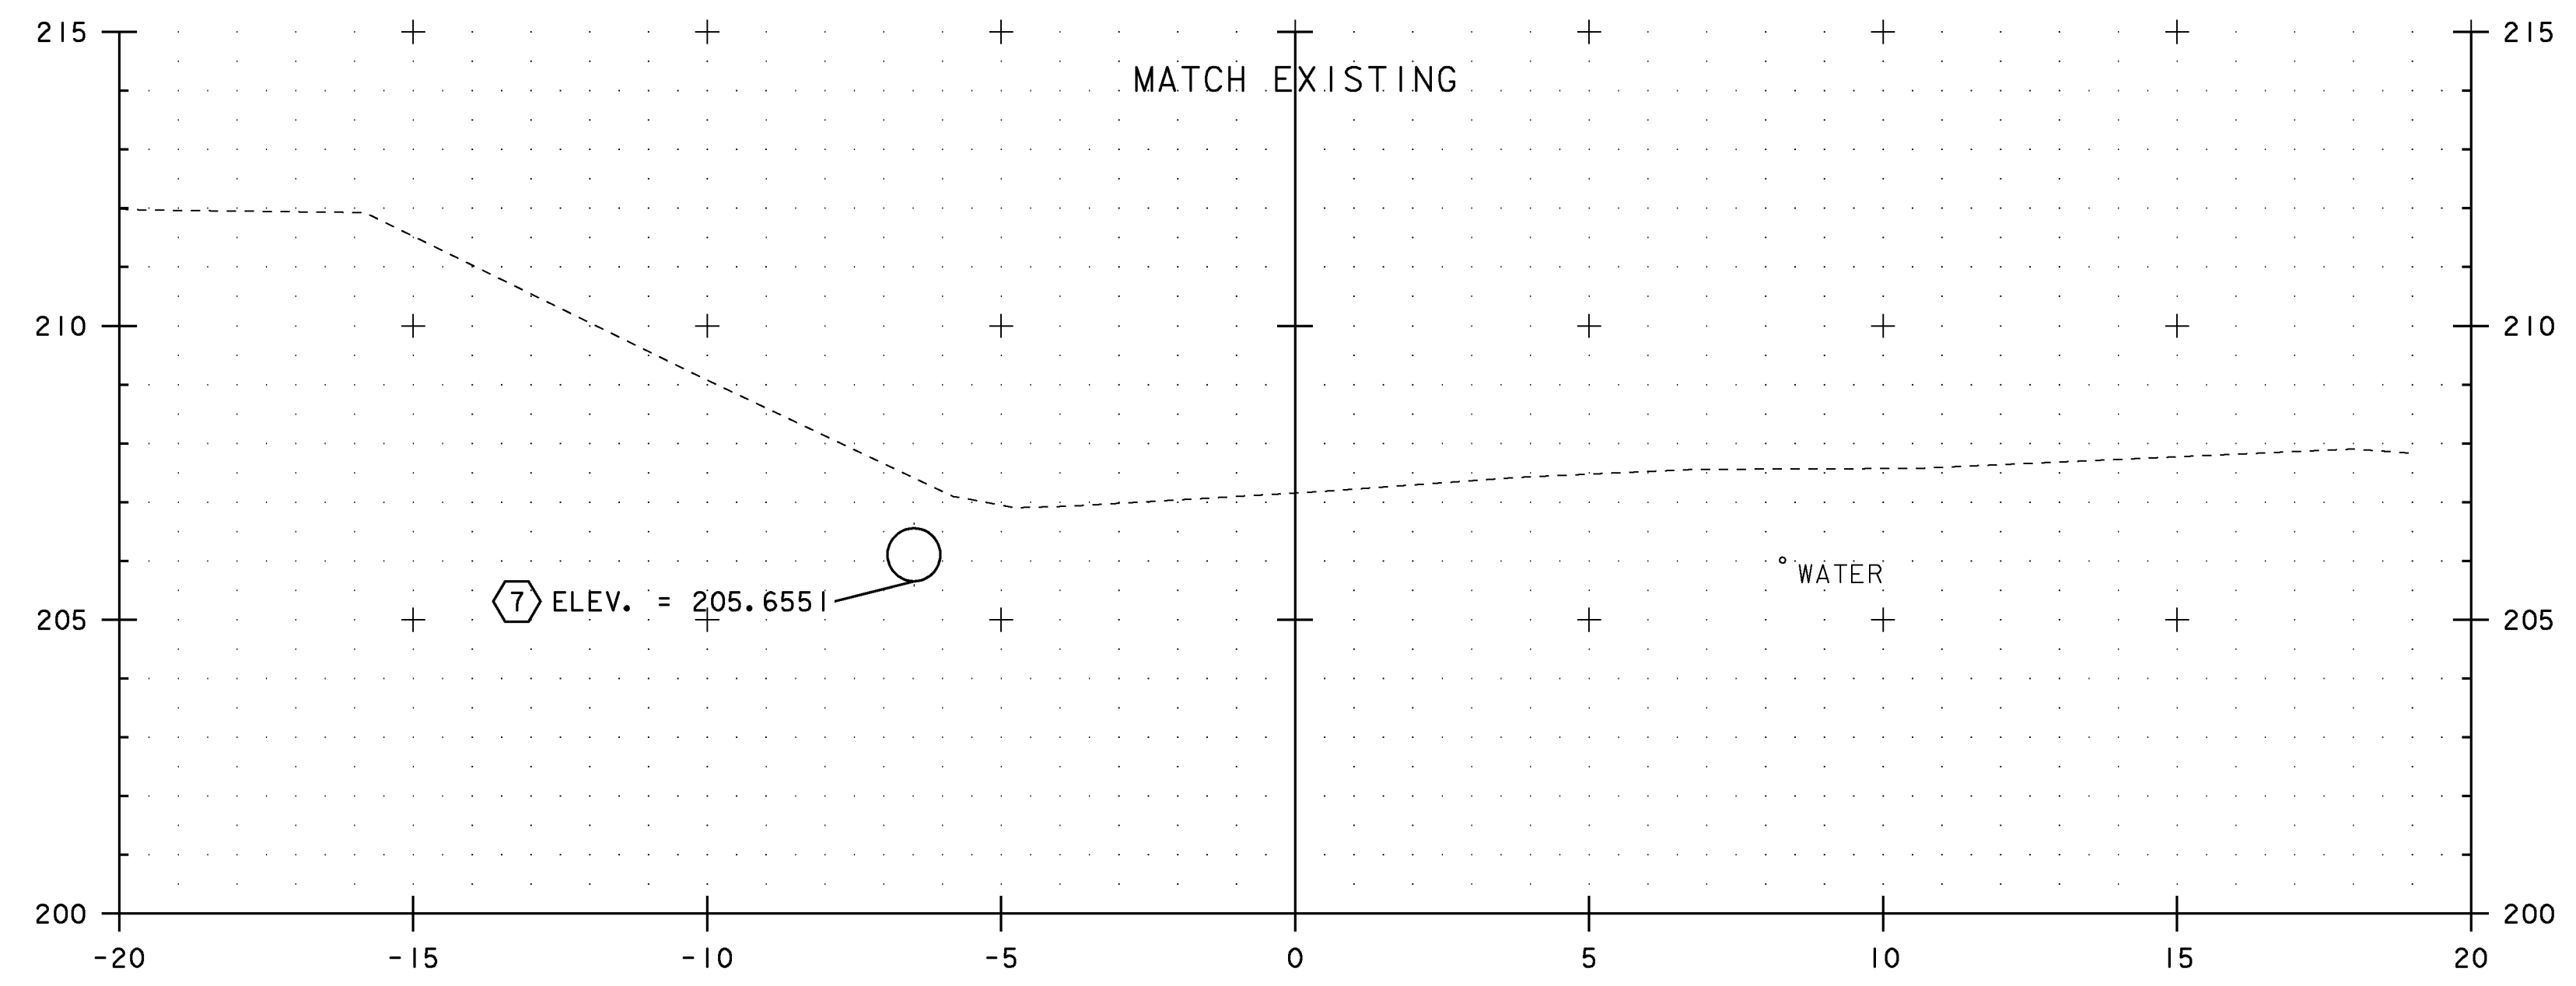

4+930.00
END APPROACH

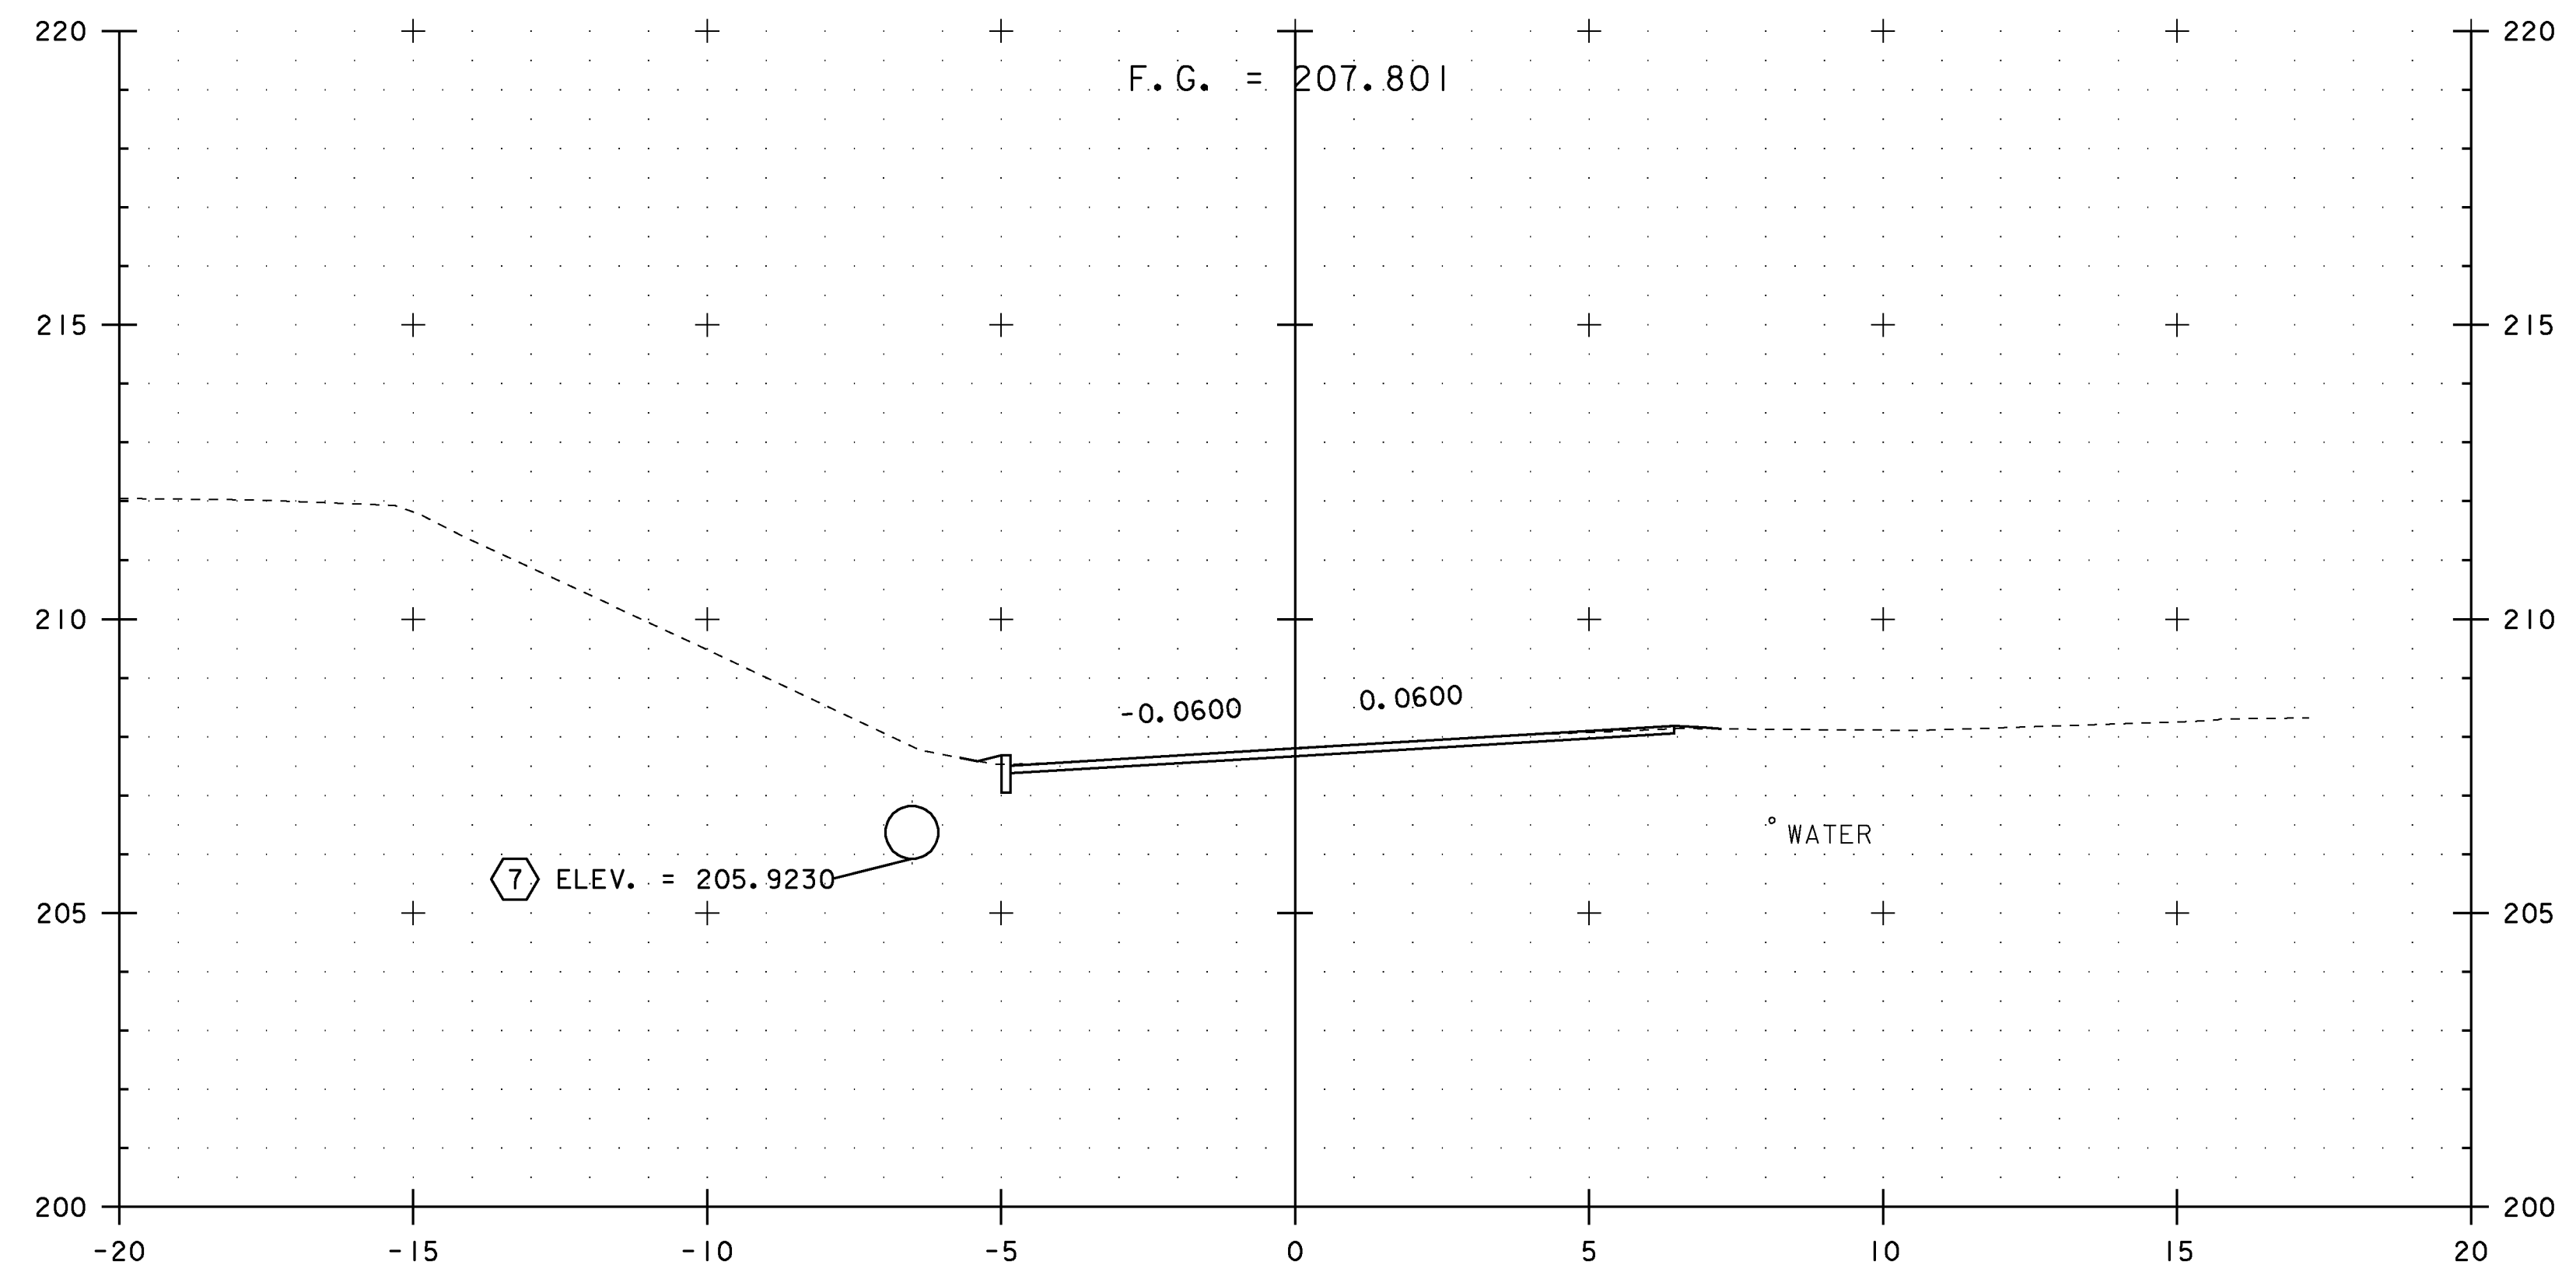

PT 4+921.07

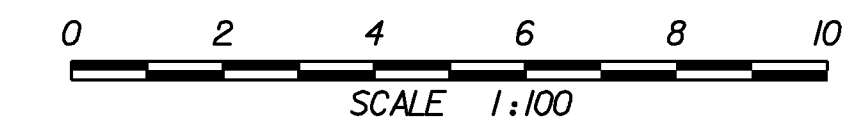


NOTES:

1. ALL BURIED UTILITIES ARE EXISTING, THE LOCATIONS ARE APPROXIMATE AND ARE TO REMAIN UNDISTURBED
2. DRAINAGE FEATURES DISPLAYED ON CROSS SECTIONS ARE PROJECTED. SEE DRAINAGE DETAIL SHEETS, LAYOUTS AND PROFILES FOR TRUE LOCATIONS


PROJECT NAME: EAST MONTPELIER
PROJECT NUMBER: STPG 028 - 3(35)S

FILE NAME: +98b028xsl.dgn	PLOT DATE: 22-MAR-2010
PROJECT LEADER: J. SCHULTZ	DRAWN BY: D. LYMAN
DESIGNED BY: J. GRUCHACZ	CHECKED BY: J. DEVLIN
US ROUTE 2 CROSS SECTION SHEET 16	SHEET 114 OF 142


STA. 4+921.07 TO STA. 4+930

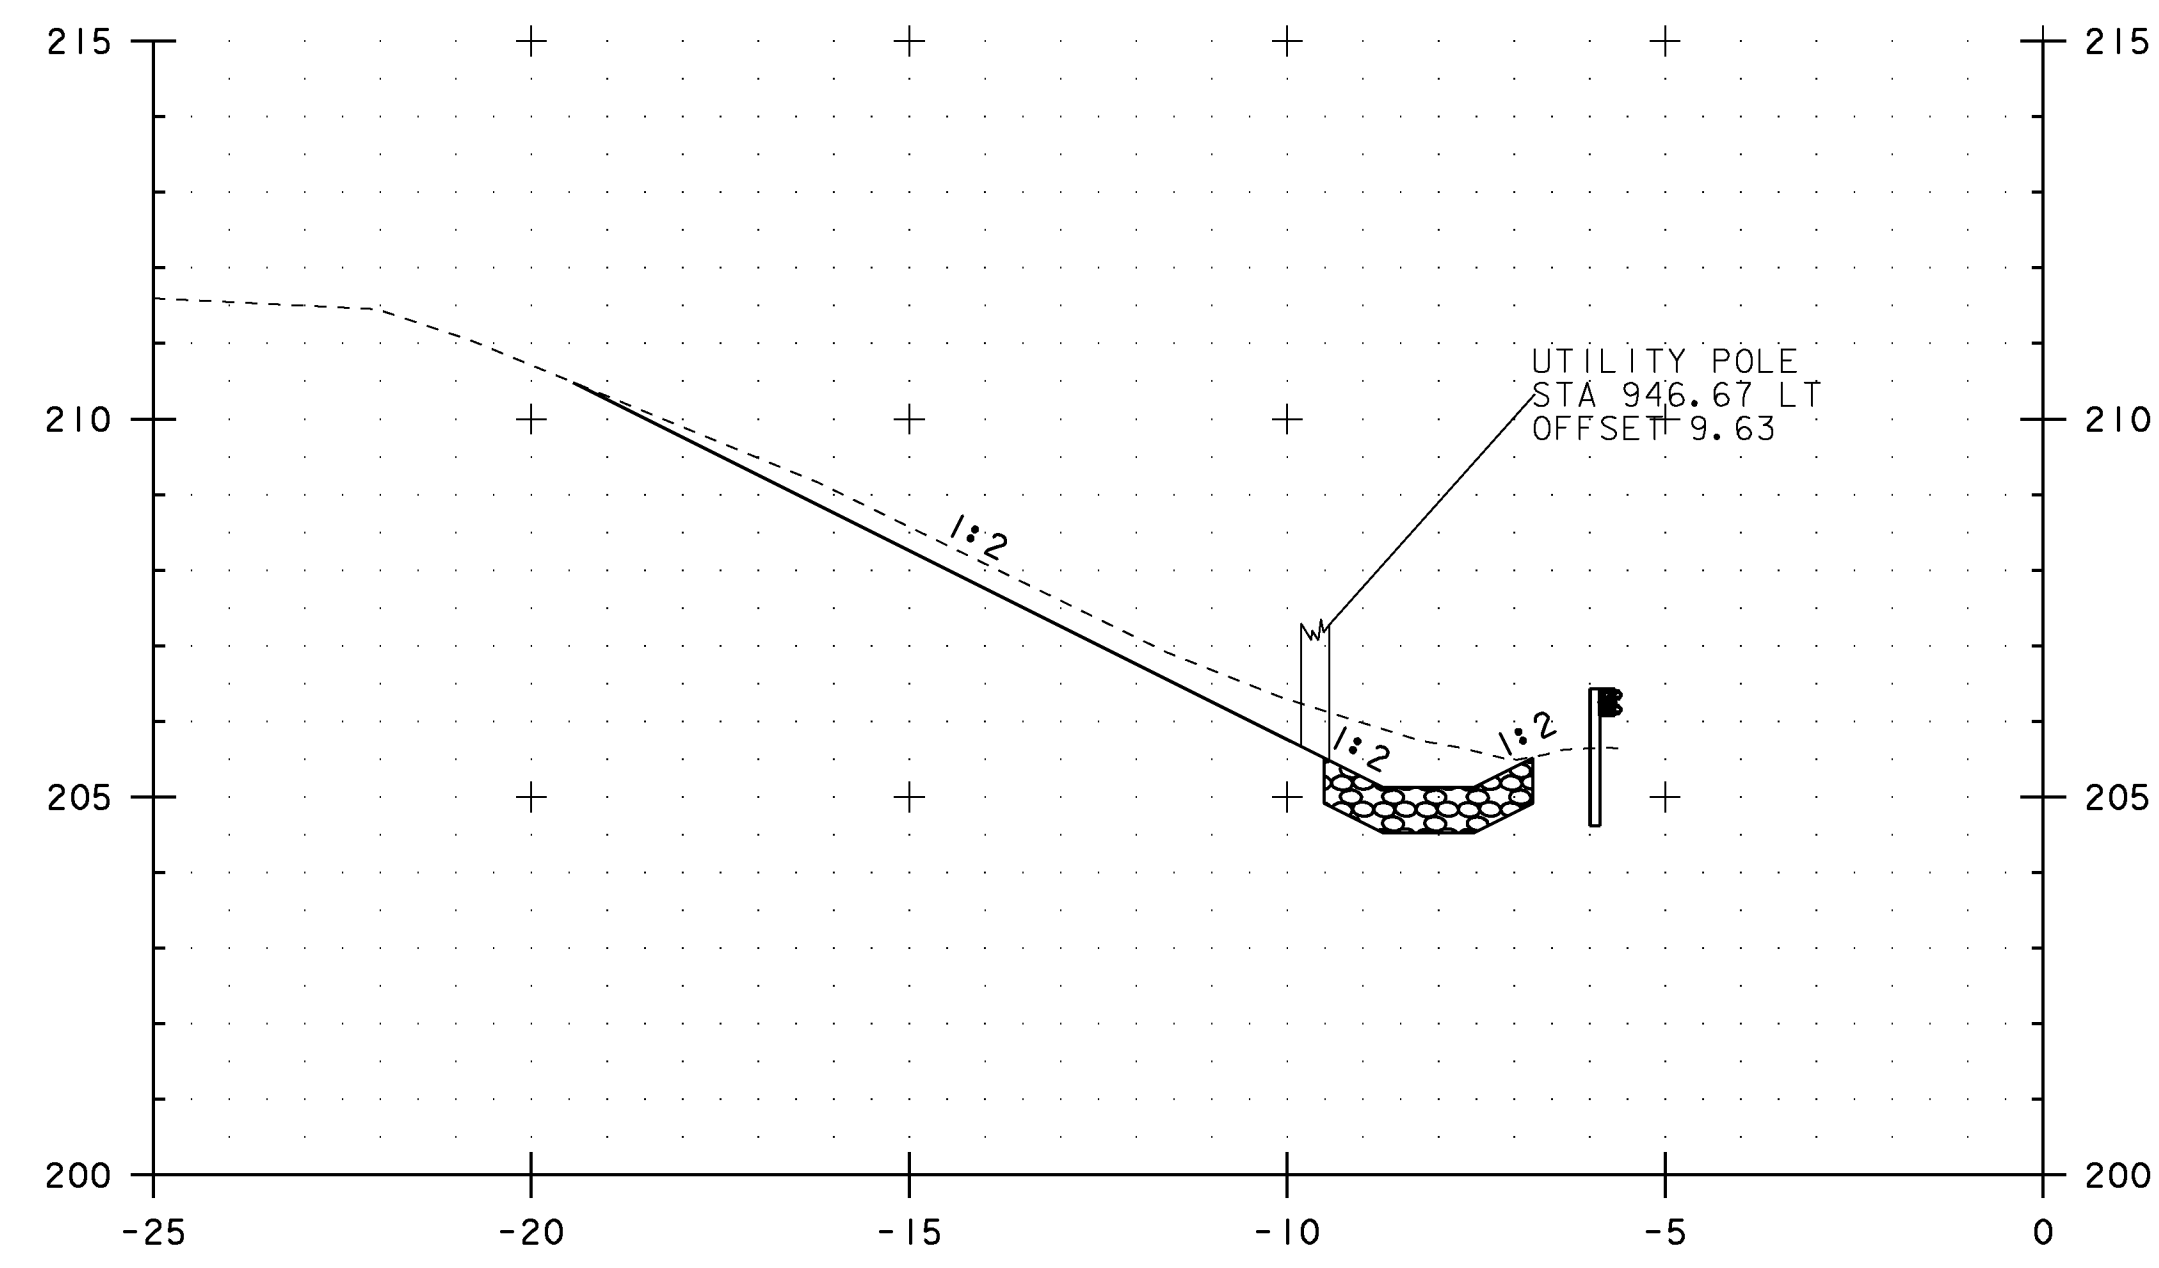


4+950.00

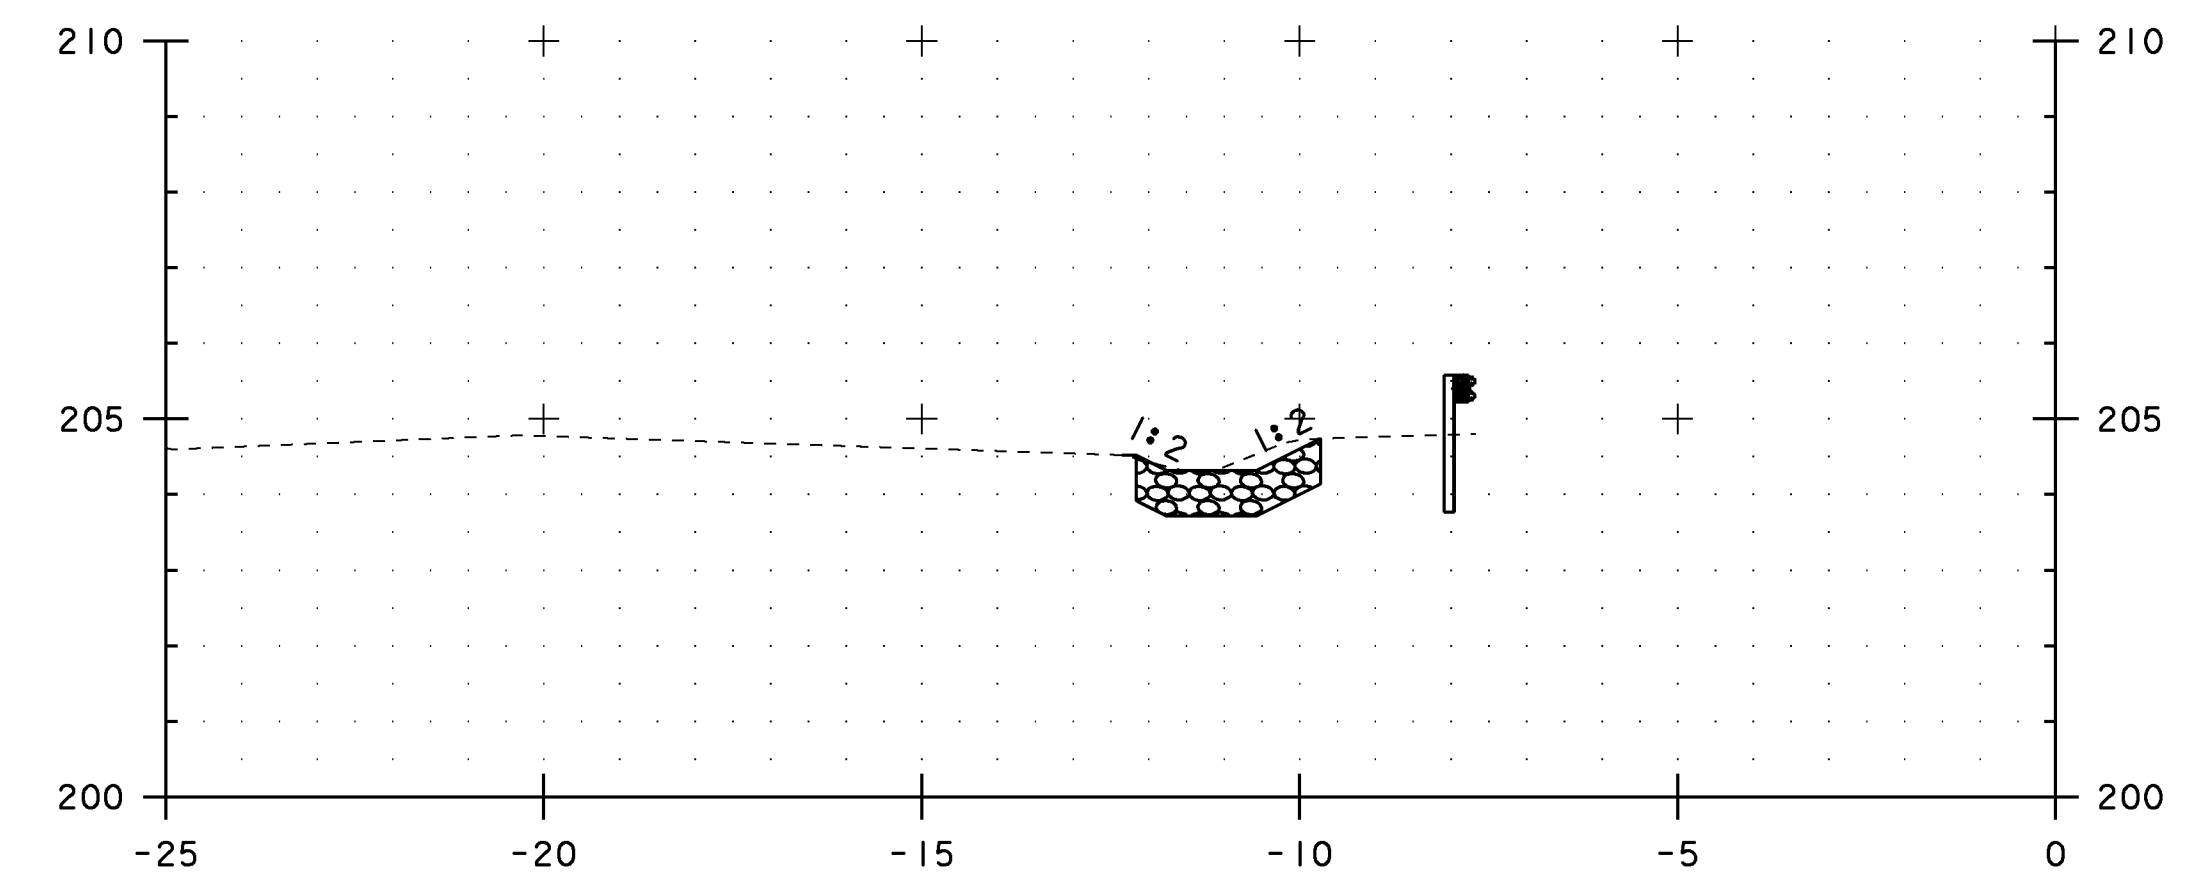


4+975.00

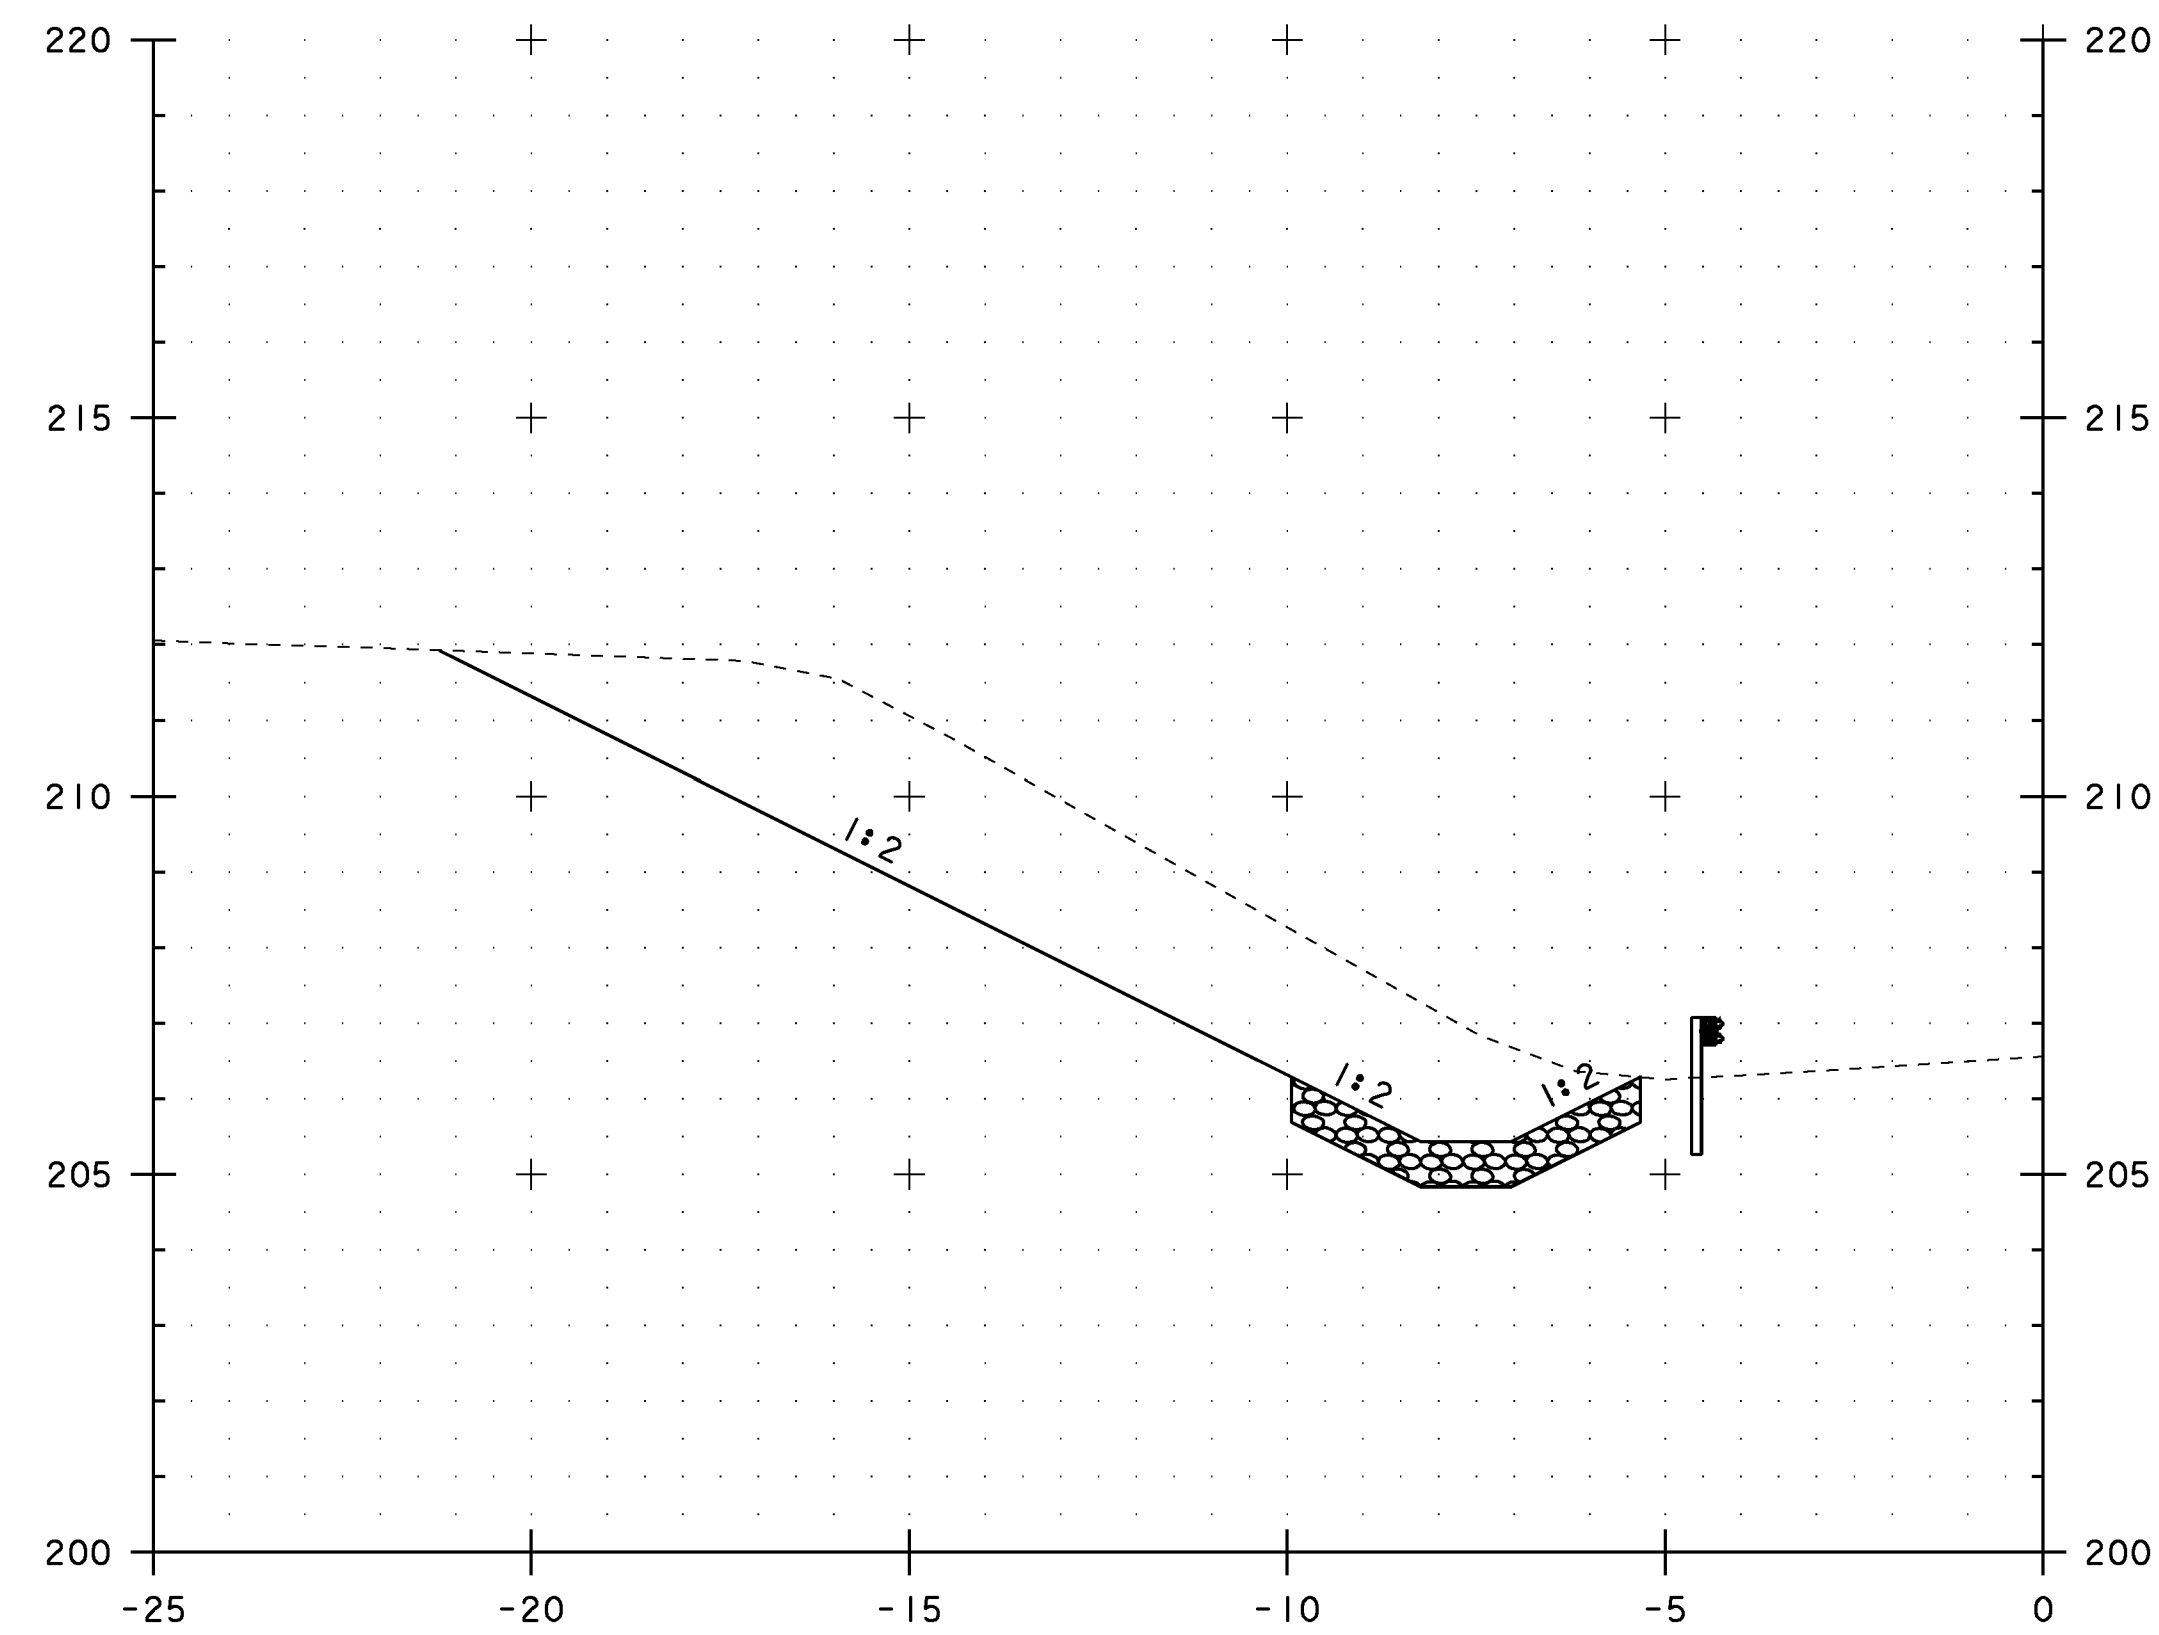

4+940.00

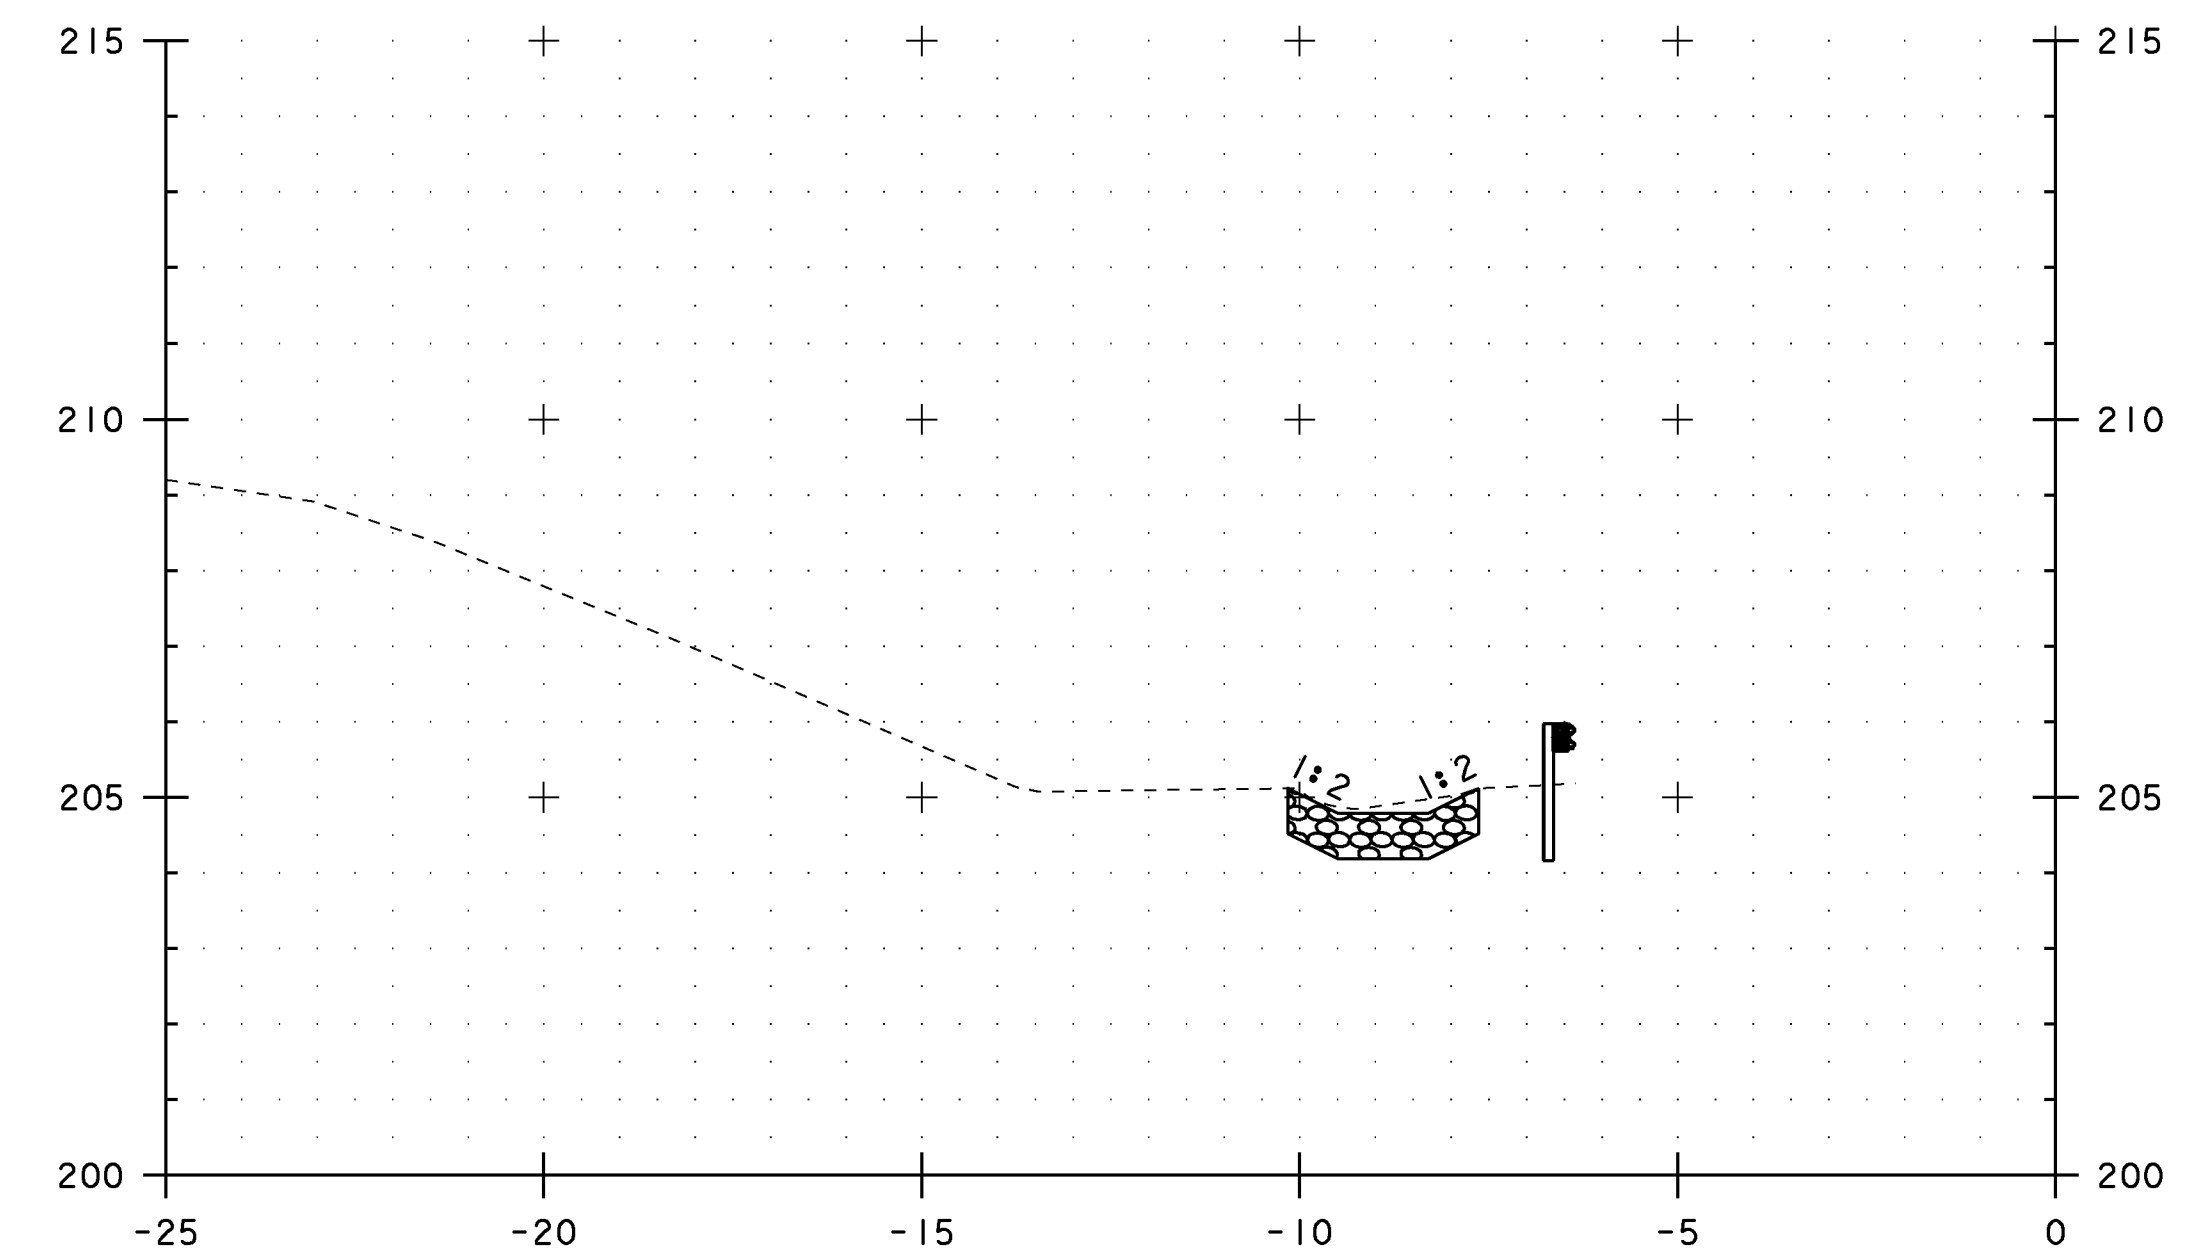

4+960.00

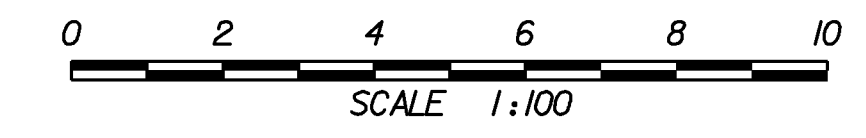


NOTES:

1. ALL BURIED UTILITIES ARE EXISTING, THE LOCATIONS ARE APPROXIMATE AND ARE TO REMAIN UNDISTURBED
2. DRAINAGE FEATURES DISPLAYED ON CROSS SECTIONS ARE PROJECTED. SEE DRAINAGE DETAIL SHEETS, LAYOUTS AND PROFILES FOR TRUE LOCATIONS


STA. 4+940 TO STA. 4+975

PROJECT NAME: EAST MONTPELIER
 PROJECT NUMBER: STPG 028 - 3(35)S

FILE NAME: +98b028xsl.dgn	PLOT DATE: 22-MAR-2010
PROJECT LEADER: J. SCHULTZ	DRAWN BY: D. LYMAN
DESIGNED BY: J. GRUCHACZ	CHECKED BY: J. DEVLIN
US ROUTE 2 CROSS SECTION SHEET 17	SHEET 115 OF 142

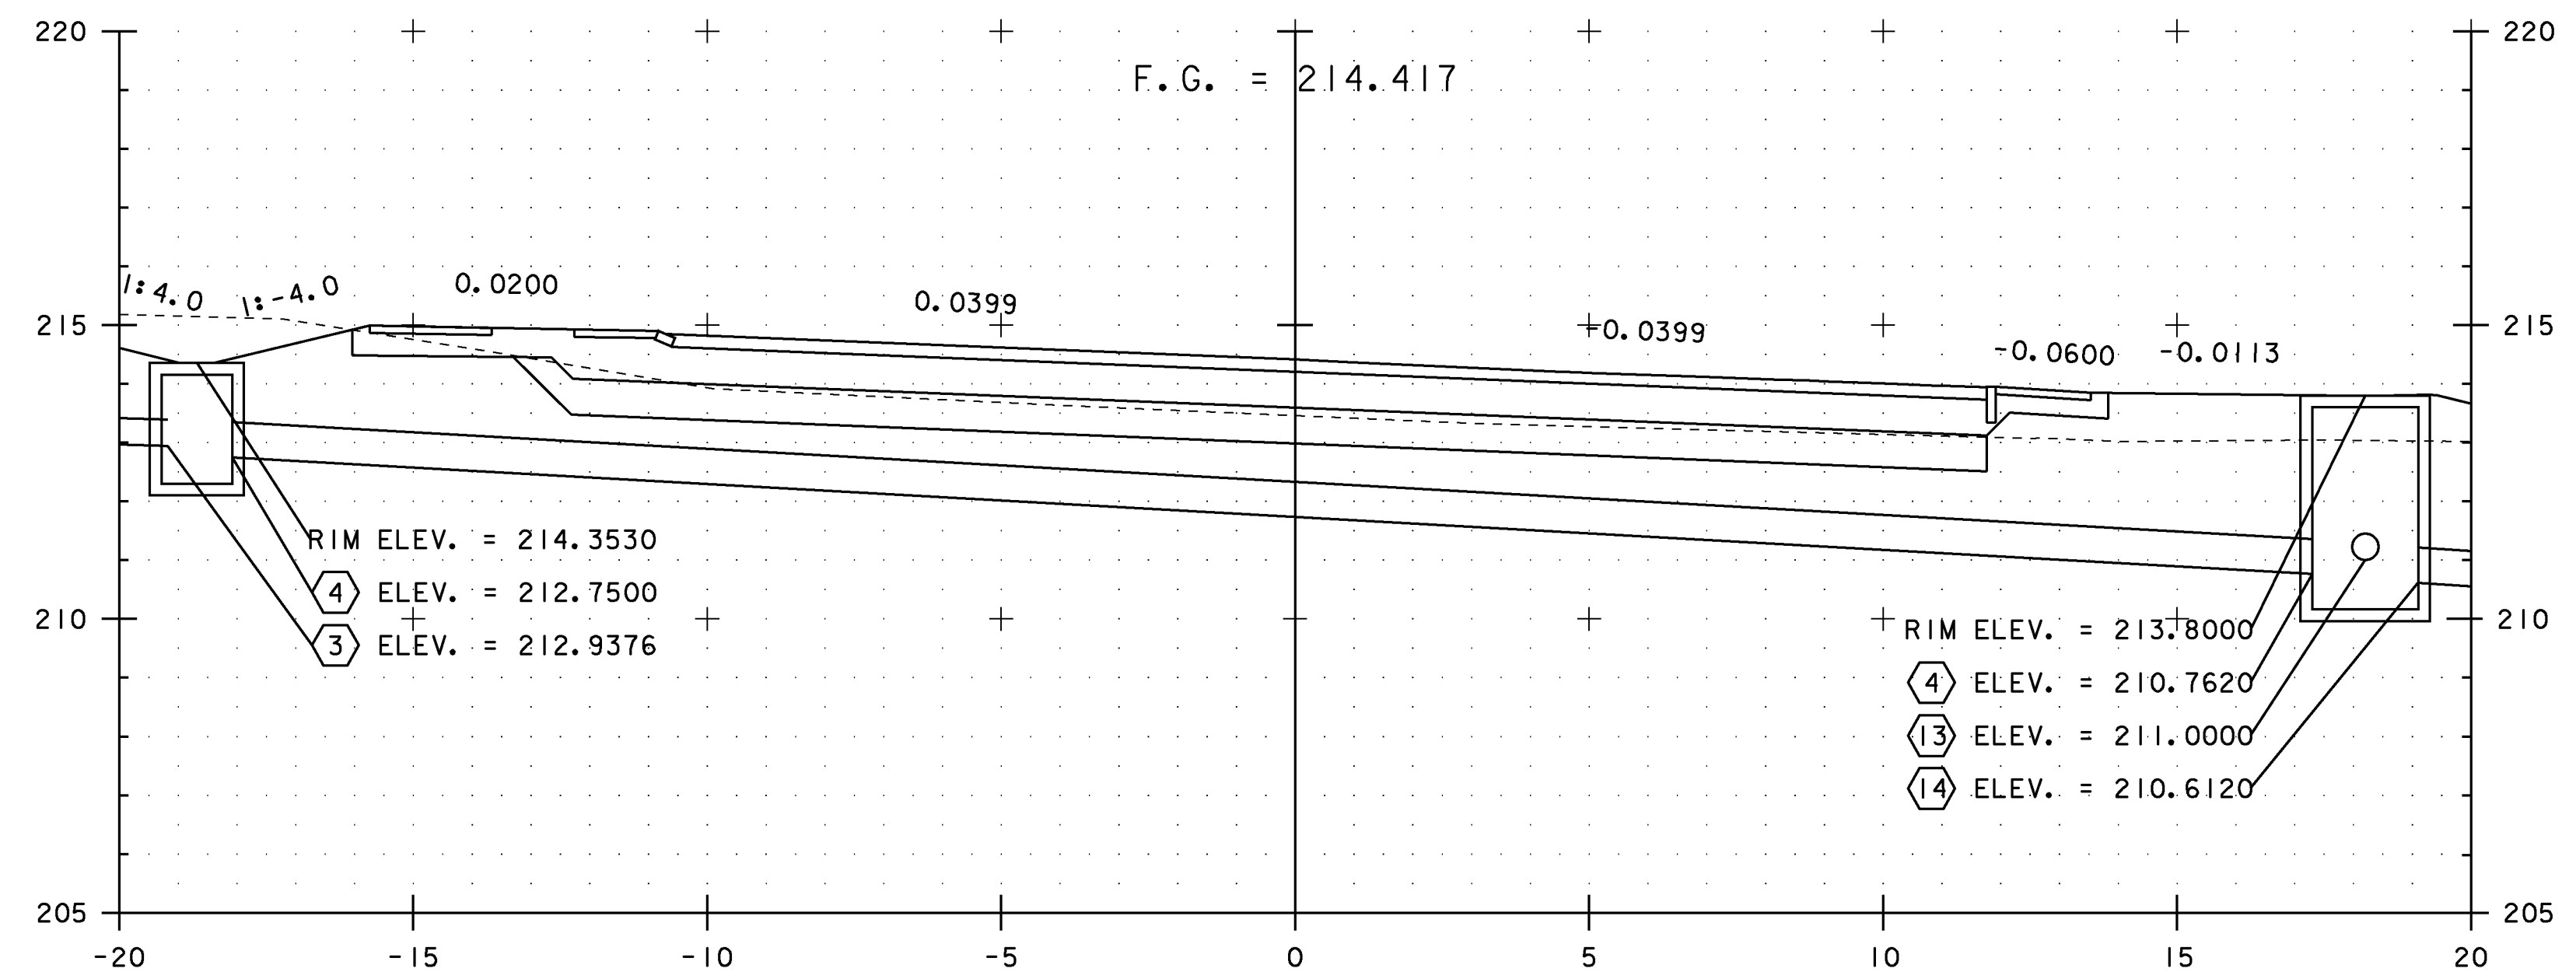

14+035.00

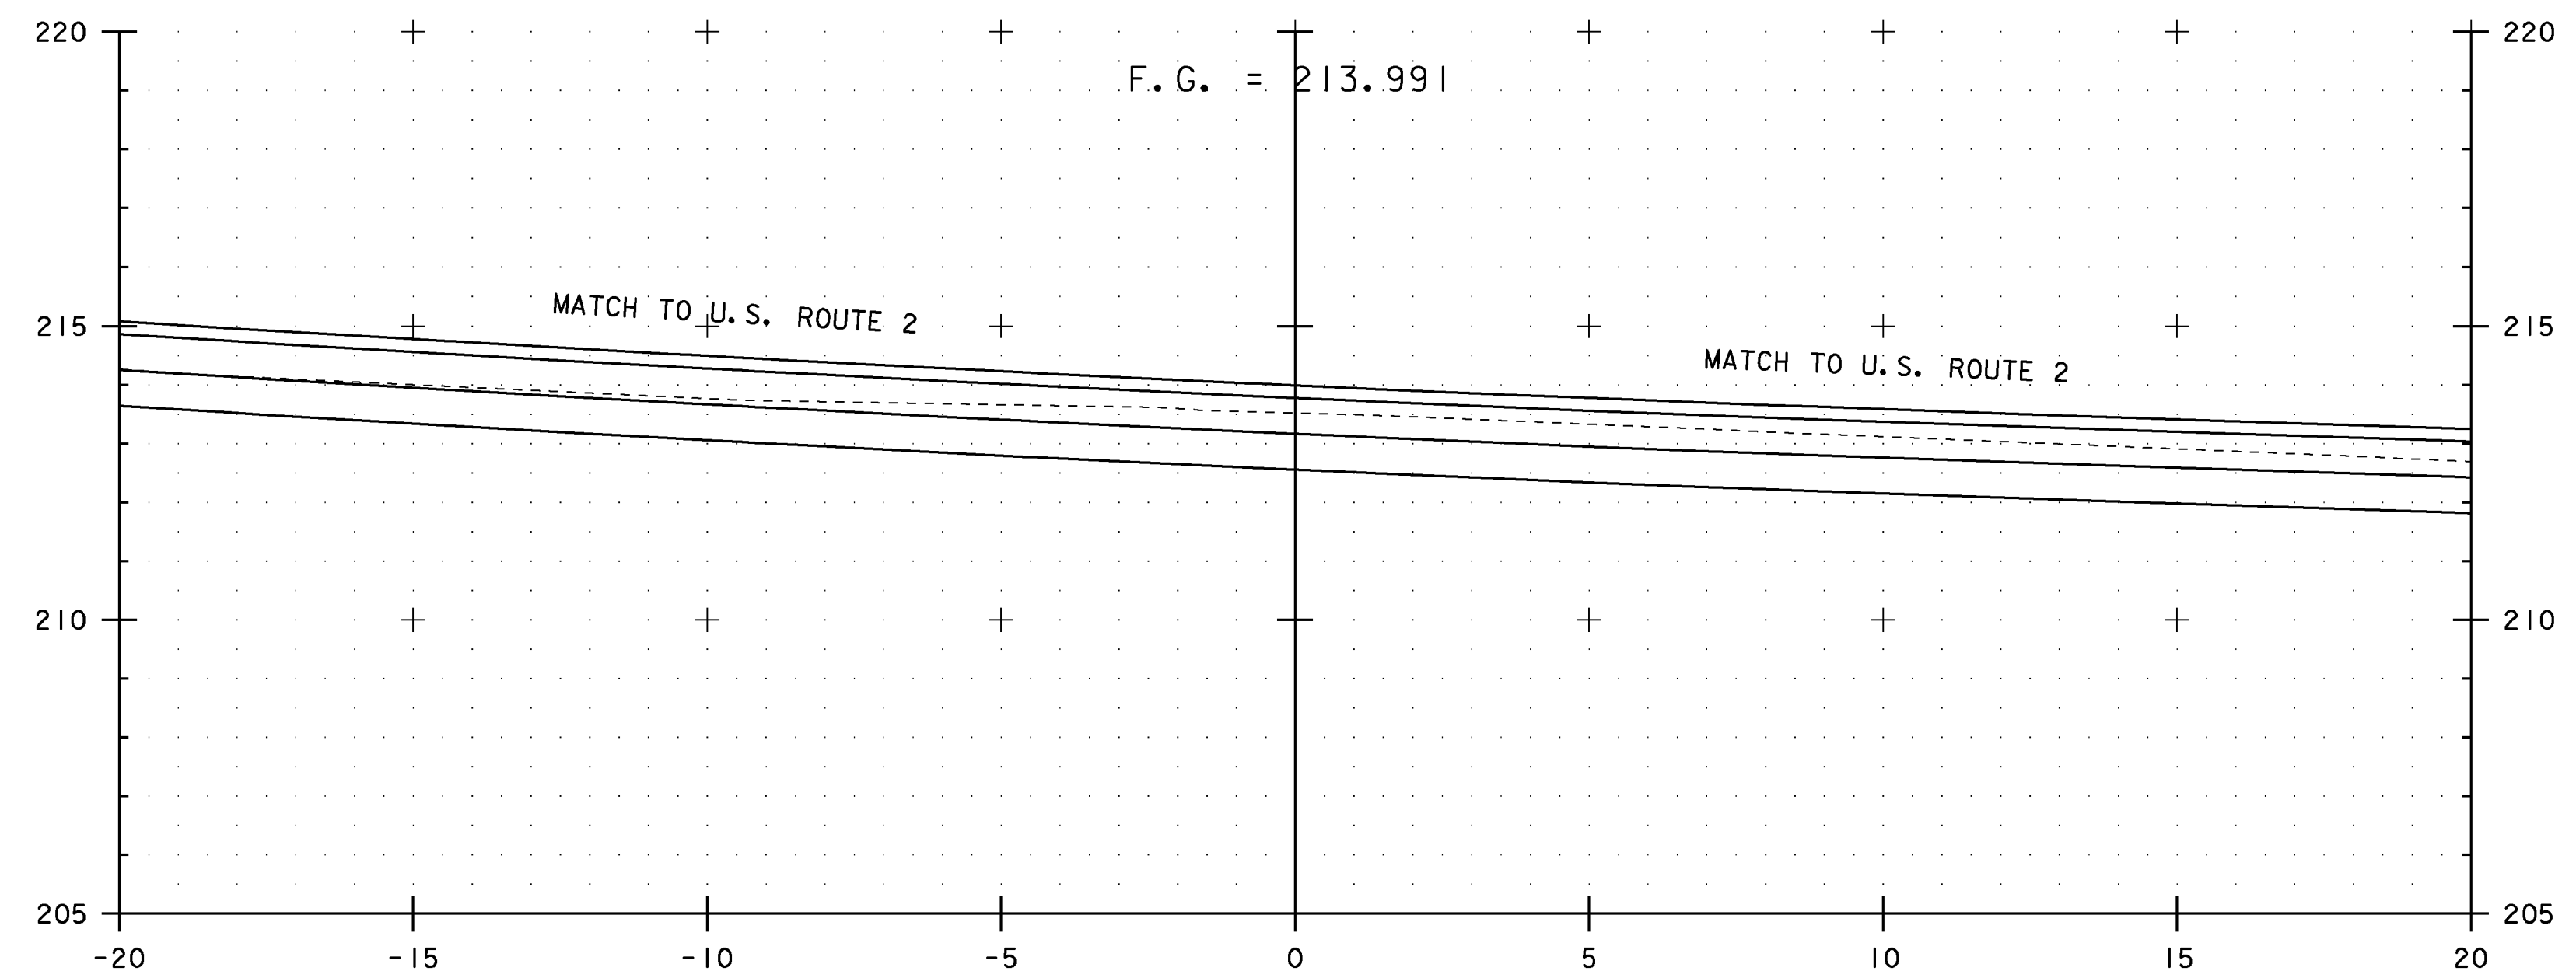

14+026.00 =
U.S. ROUTE 2 STA 4+800.00




NOTES:


- ALL BURIED UTILITIES ARE EXISTING, THE LOCATIONS ARE APPROXIMATE AND ARE TO REMAIN UNDISTURBED
- DRAINAGE FEATURES DISPLAYED ON CROSS SECTIONS ARE PROJECTED. SEE DRAINAGE DETAIL SHEETS, LAYOUTS AND PROFILES FOR TRUE LOCATIONS

STA. 14+026 TO STA. 14+035


PROJECT NAME: EAST MONTPELIER	PLOT DATE: 22-MAR-2010
PROJECT NUMBER: STPG 028 - 3(35)S	DRAWN BY: D. LYMAN
FILE NAME: +98b028xsl.dgn	CHECKED BY: J. DEVLIN
PROJECT LEADER: J. SCHULTZ	SHEET 116 OF 142
DESIGNED BY: J. GRUCHACZ	
VT ROUTE 14 CROSS SECTION SHEET 1	

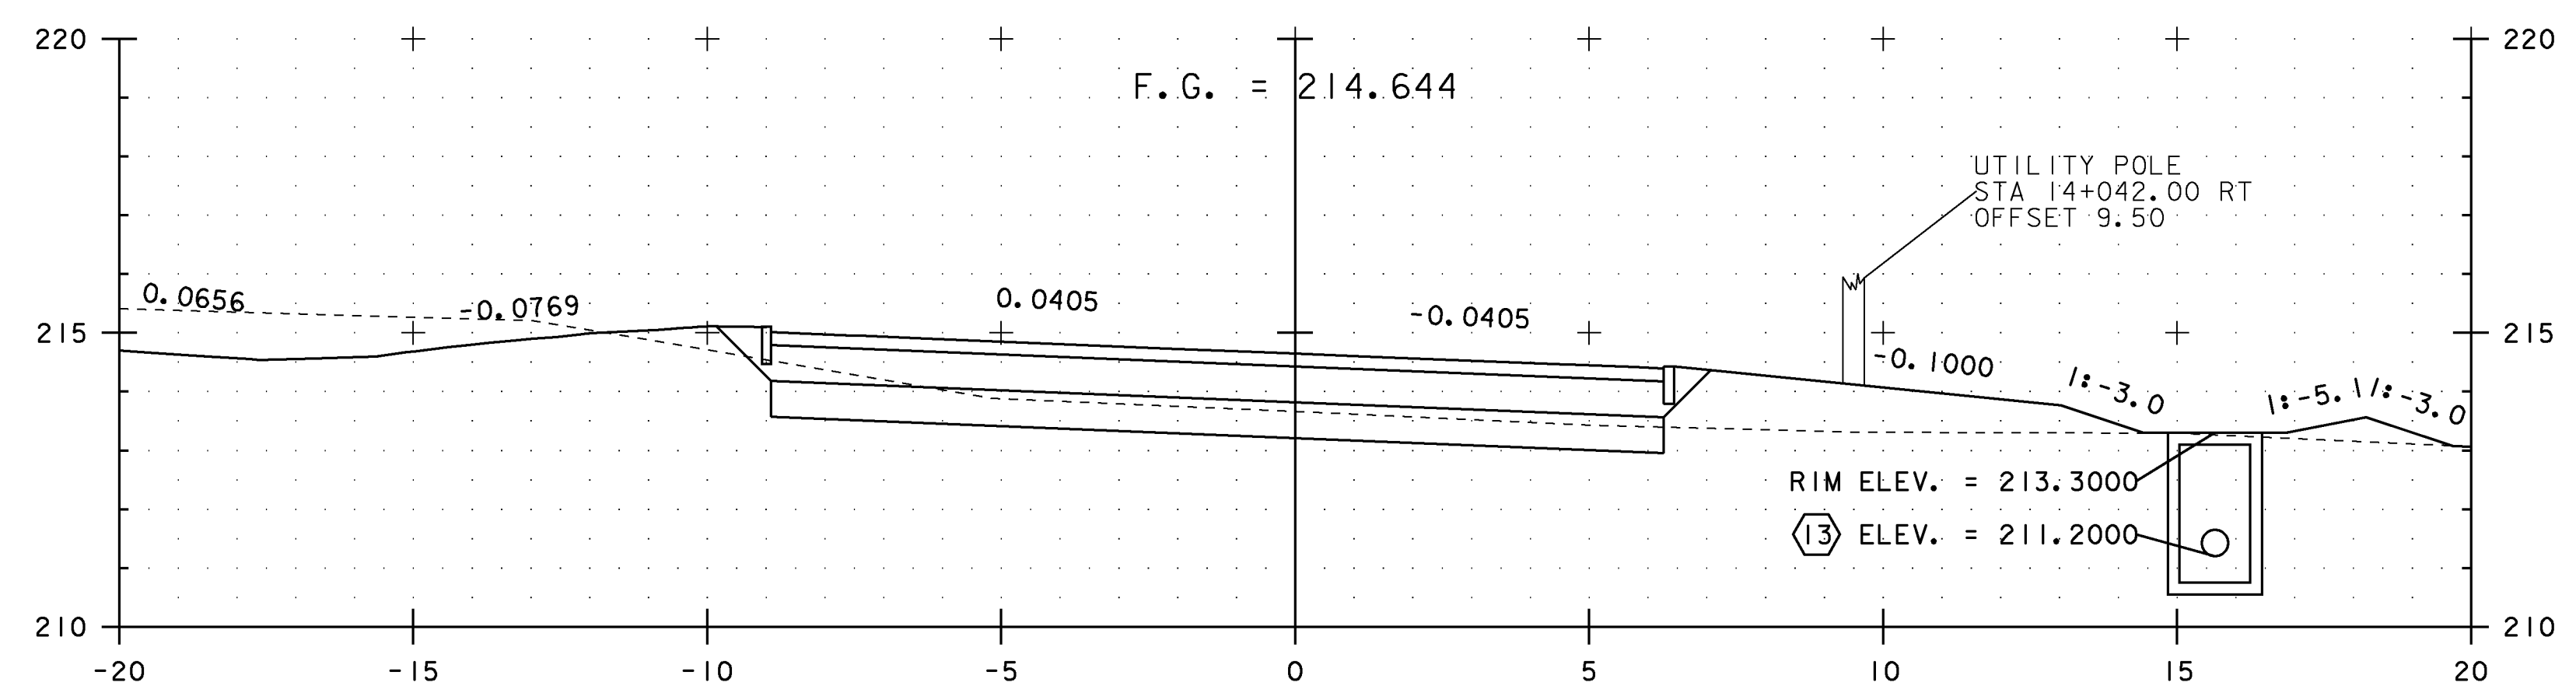

14+040.00

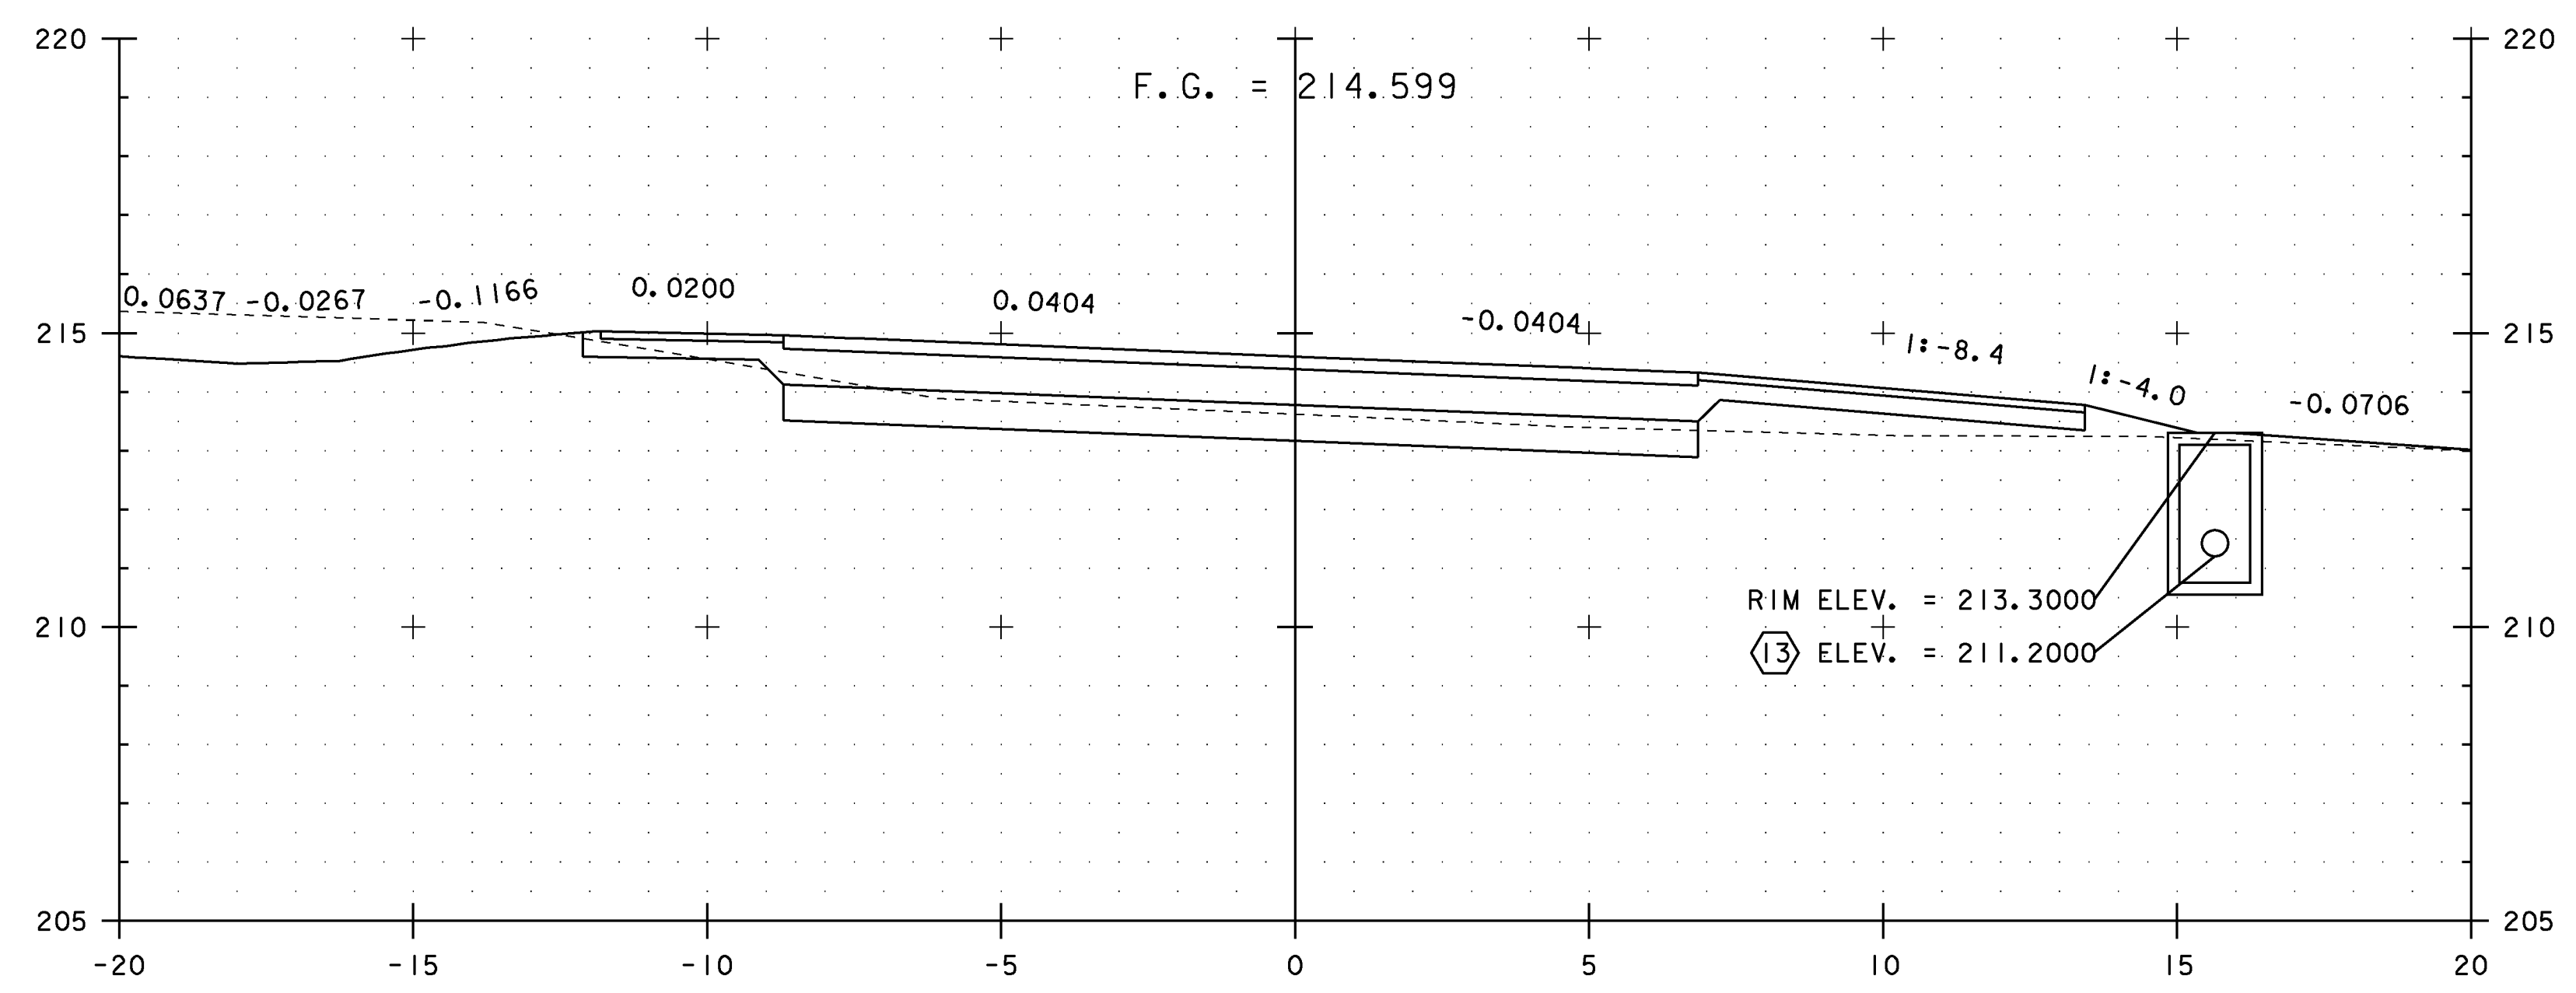





14+039.00

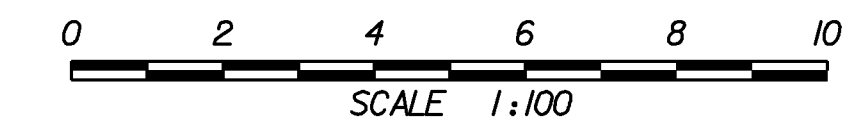

- NOTES:
1. ALL BURIED UTILITIES ARE EXISTING, THE LOCATIONS ARE APPROXIMATE AND ARE TO REMAIN UNDISTURBED
 2. DRAINAGE FEATURES DISPLAYED ON CROSS SECTIONS ARE PROJECTED. SEE DRAINAGE DETAIL SHEETS, LAYOUTS AND PROFILES FOR TRUE LOCATIONS

STA. 14+039 TO STA. 14+040

PROJECT NAME: EAST MONTPELIER	PLOT DATE: 22-MAR-2010
PROJECT NUMBER: STPG 028 - 3(35)S	DRAWN BY: D. LYMAN
FILE NAME: +98b028xsl.dgn	CHECKED BY: J. DEVLIN
PROJECT LEADER: J. SCHULTZ	SHEET 117 OF 142
DESIGNED BY: J. GRUCHACZ	
VT ROUTE 14 CROSS SECTION SHEET 2	

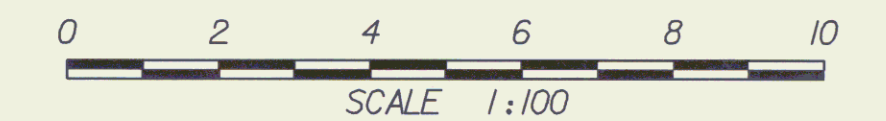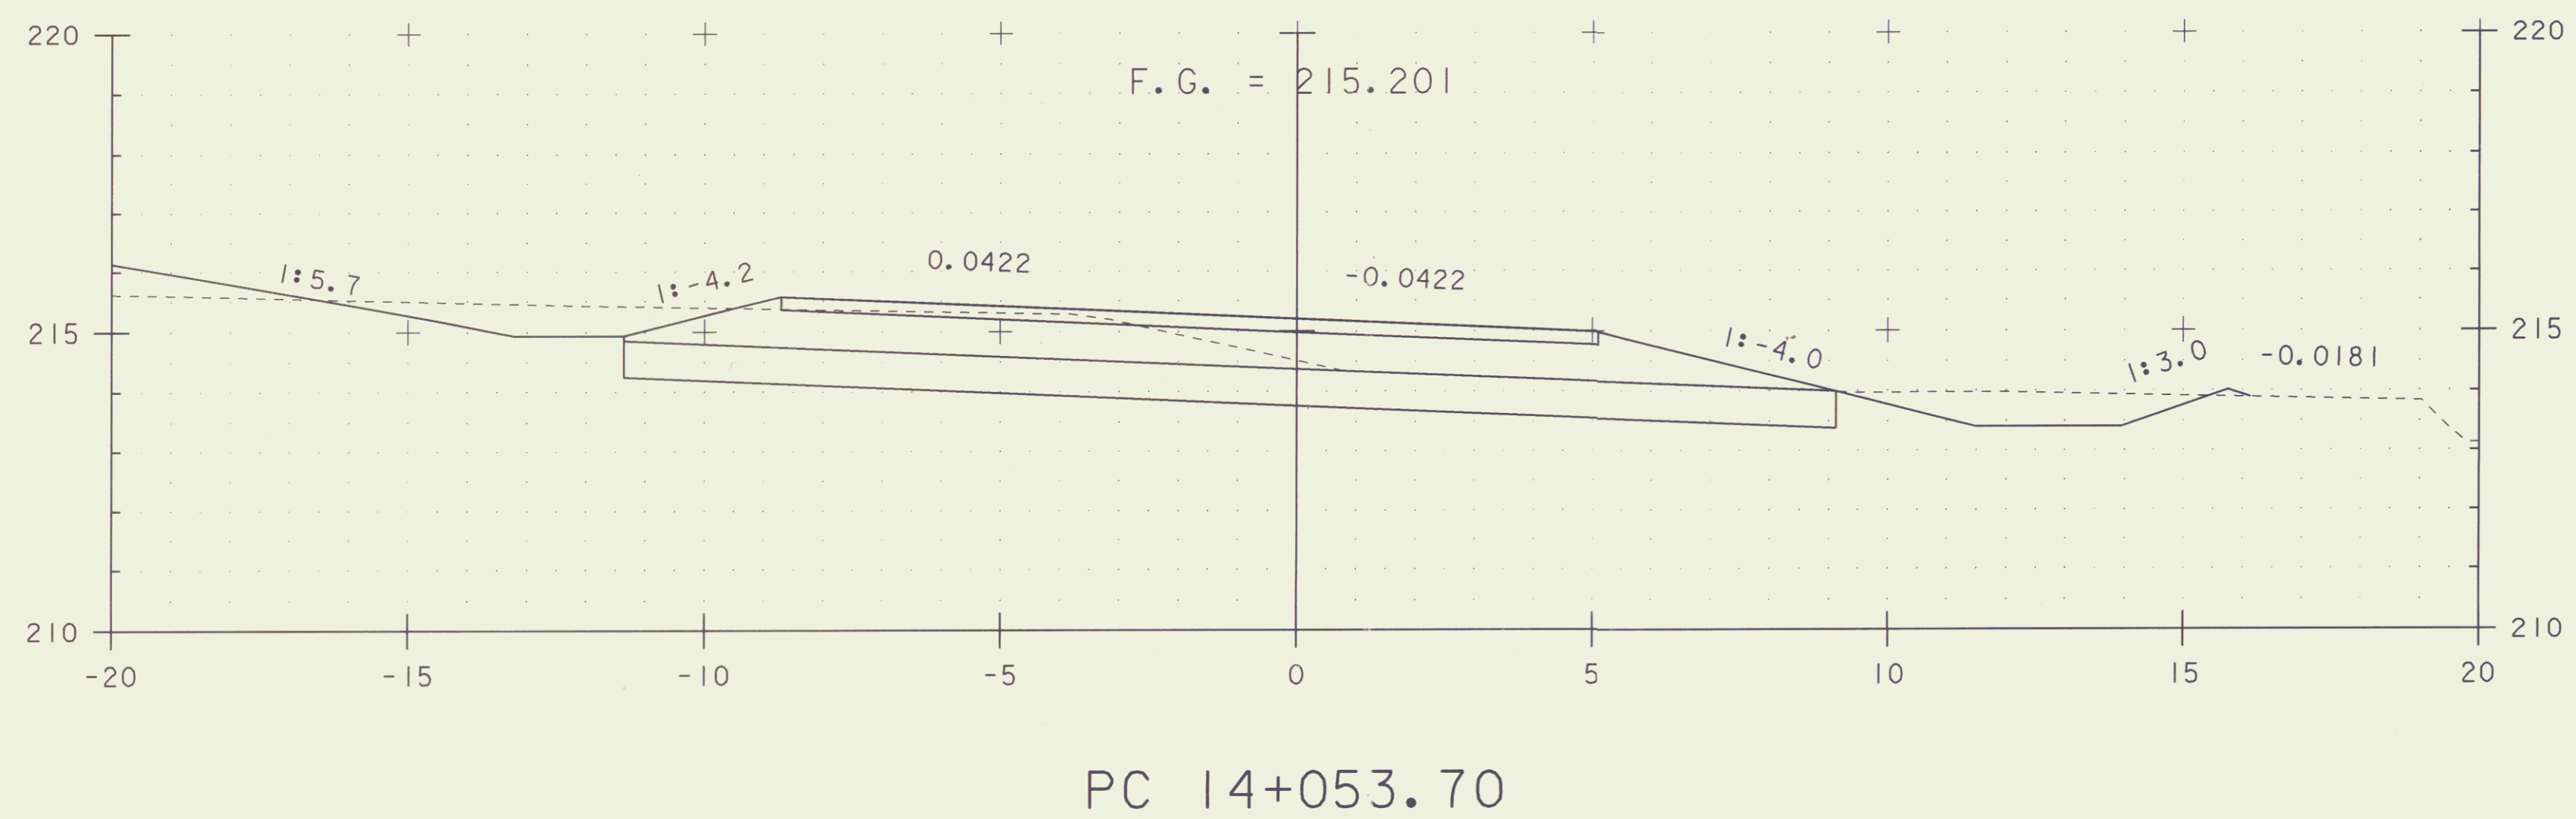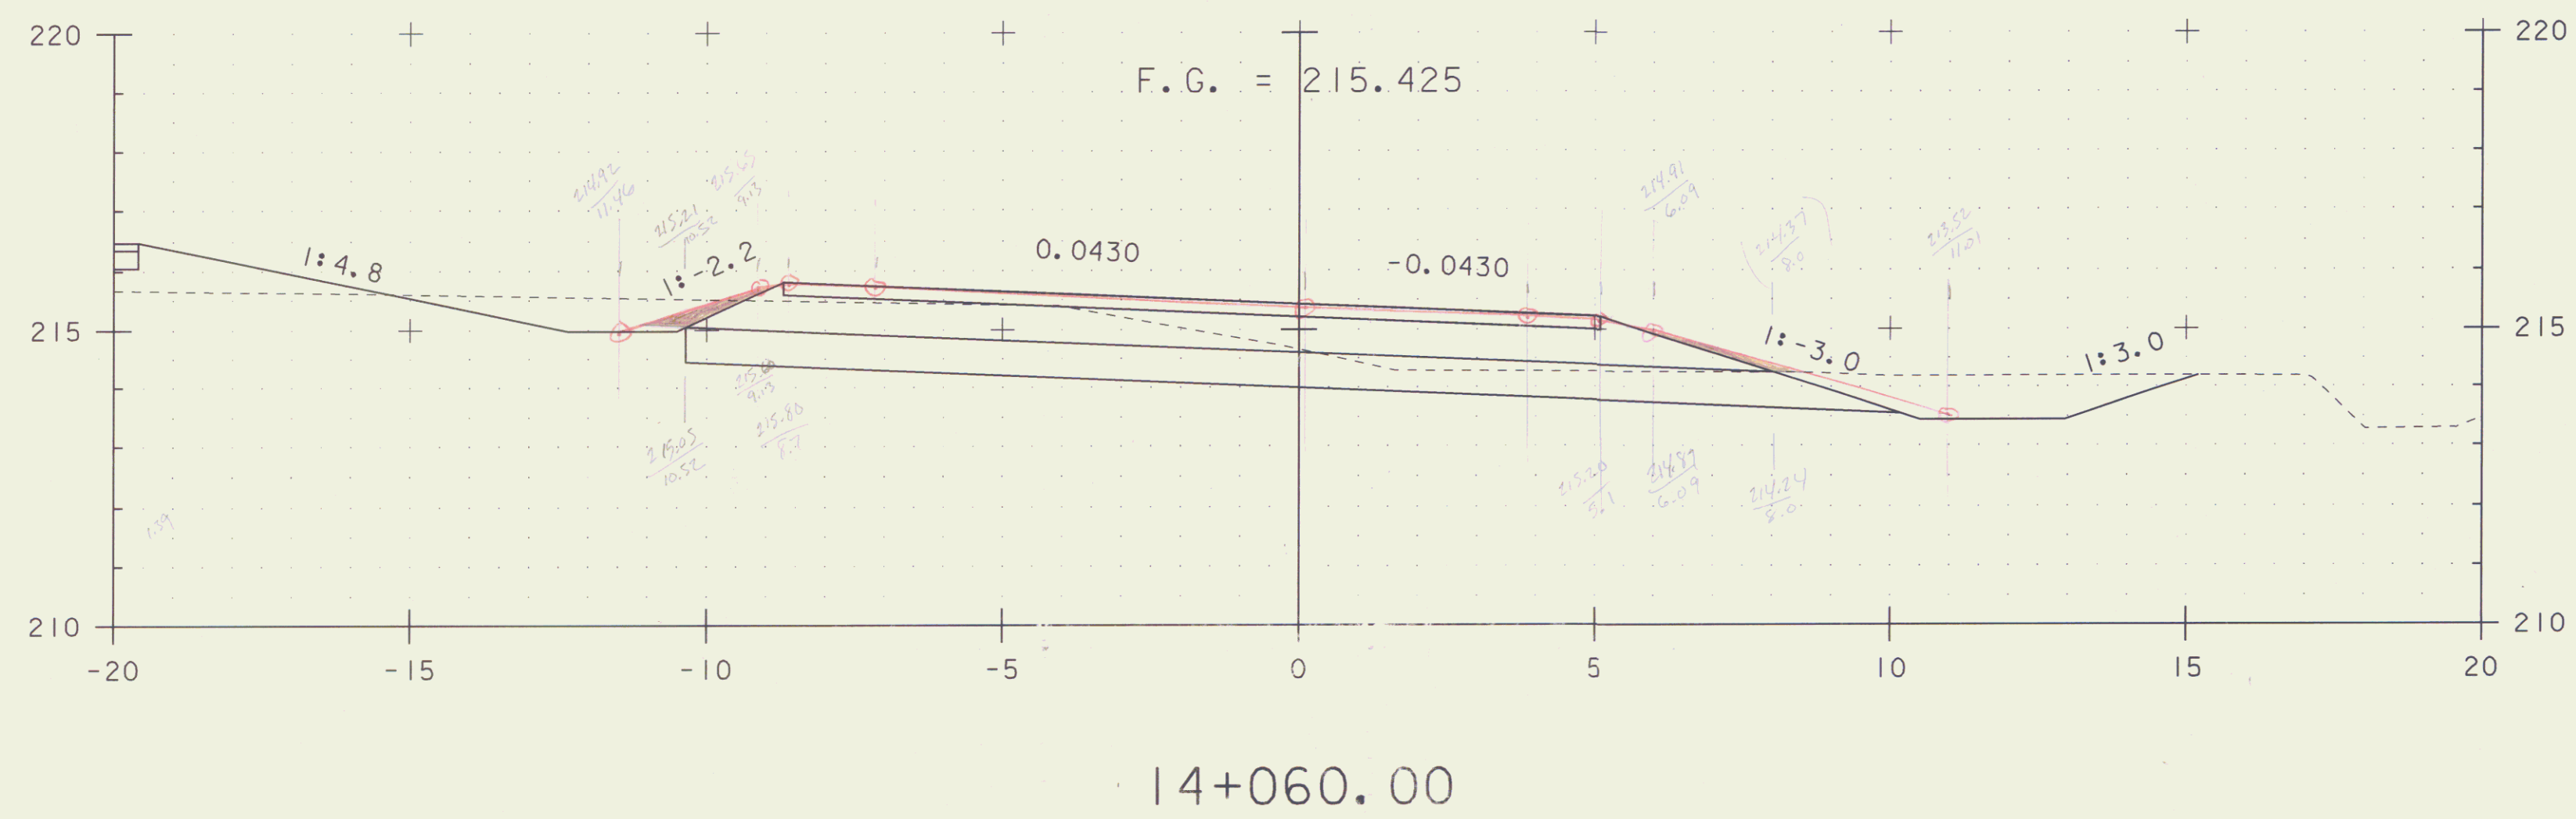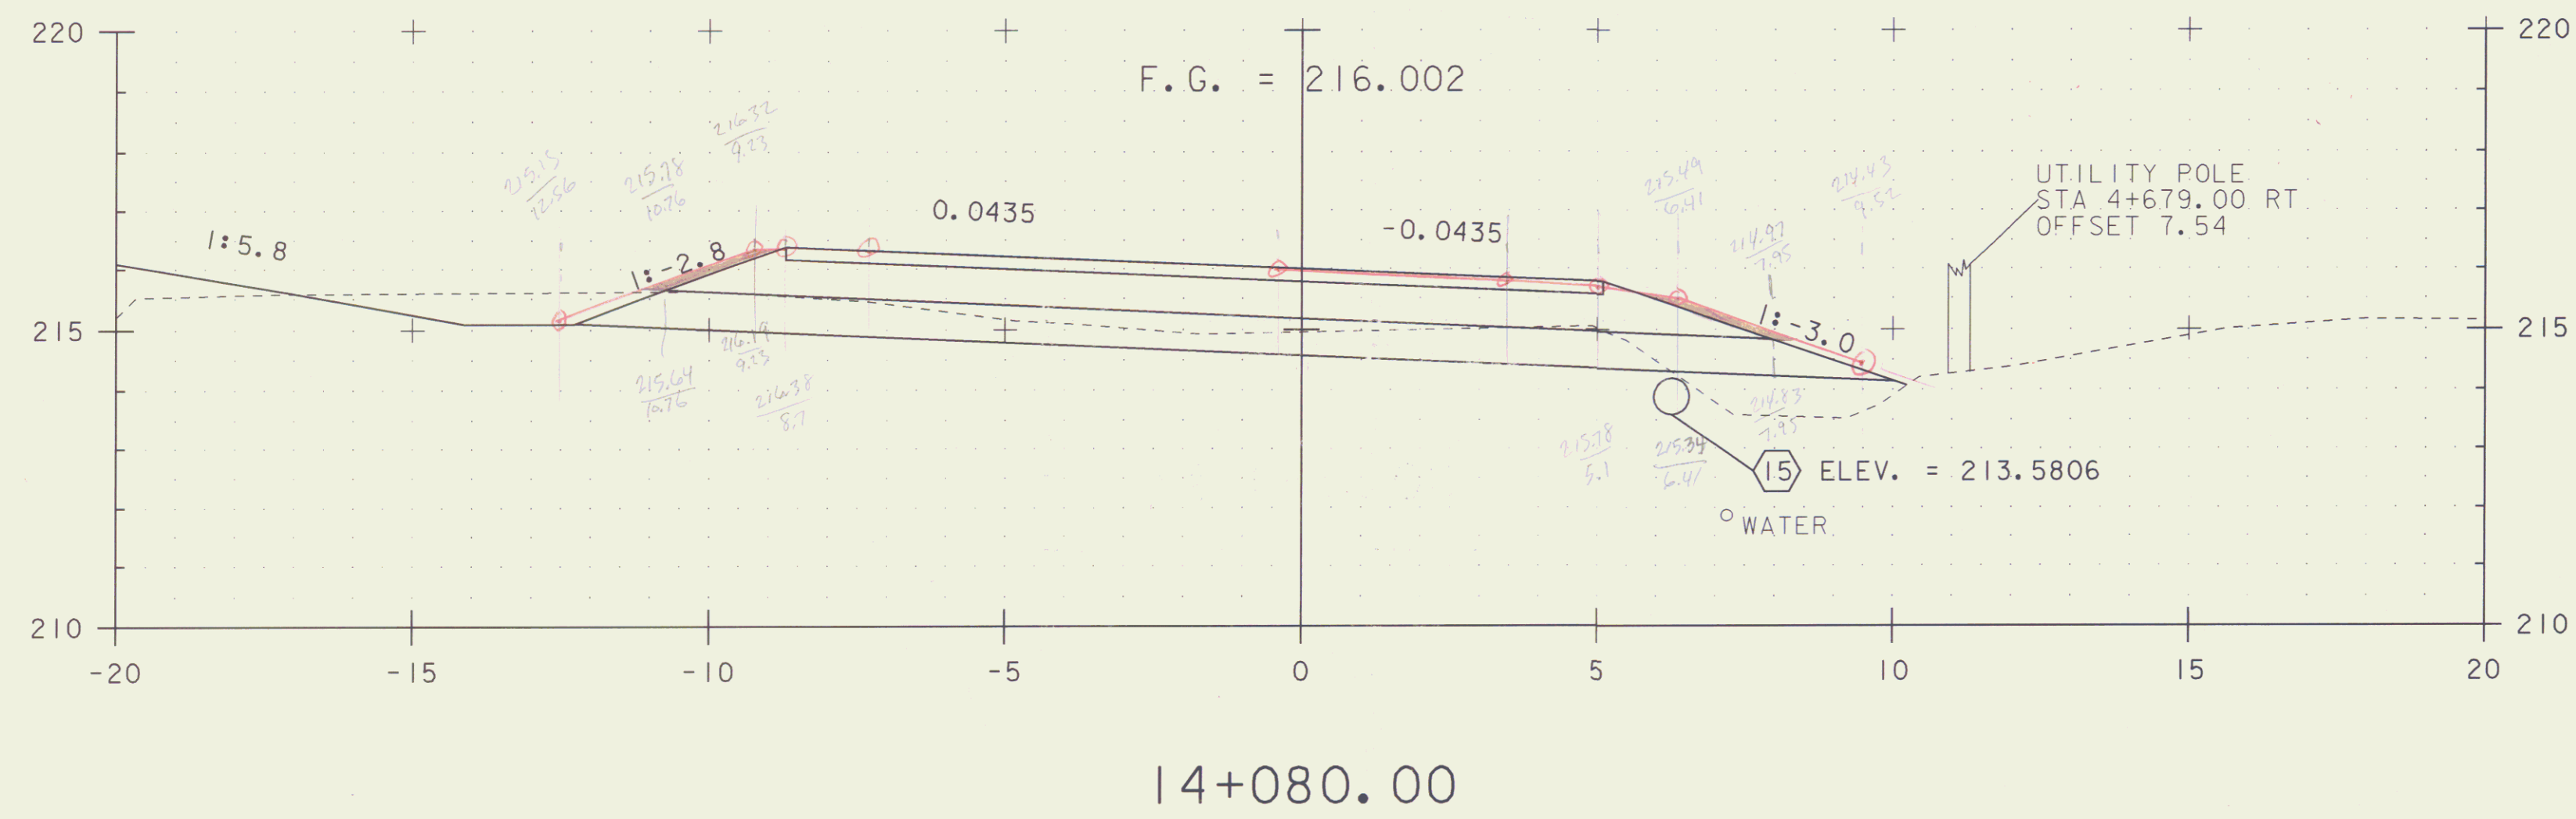





NOTES:

1. ALL BURIED UTILITIES ARE EXISTING, THE LOCATIONS ARE APPROXIMATE AND ARE TO REMAIN UNDISTURBED
2. DRAINAGE FEATURES DISPLAYED ON CROSS SECTIONS ARE PROJECTED. SEE DRAINAGE DETAIL SHEETS, LAYOUTS AND PROFILES FOR TRUE LOCATIONS

PROJECT NAME: EAST MONTPELIER
 PROJECT NUMBER: STPG 028 - 3(35)S

FILE NAME: +98b028xsl.dgn PLOT DATE: 22-MAR-2010
 PROJECT LEADER: J. SCHULTZ DRAWN BY: D. LYMAN
 DESIGNED BY: J. GRUCHACZ CHECKED BY: J. DEVLIN
 VT ROUTE 14 CROSS SECTION SHEET 3 SHEET 118 OF 142


STA. 14+053.70 TO STA. 14+080

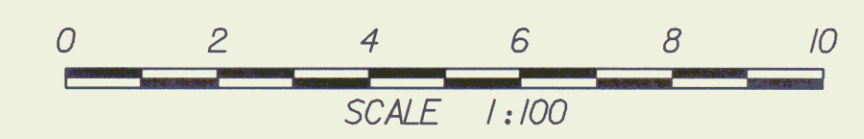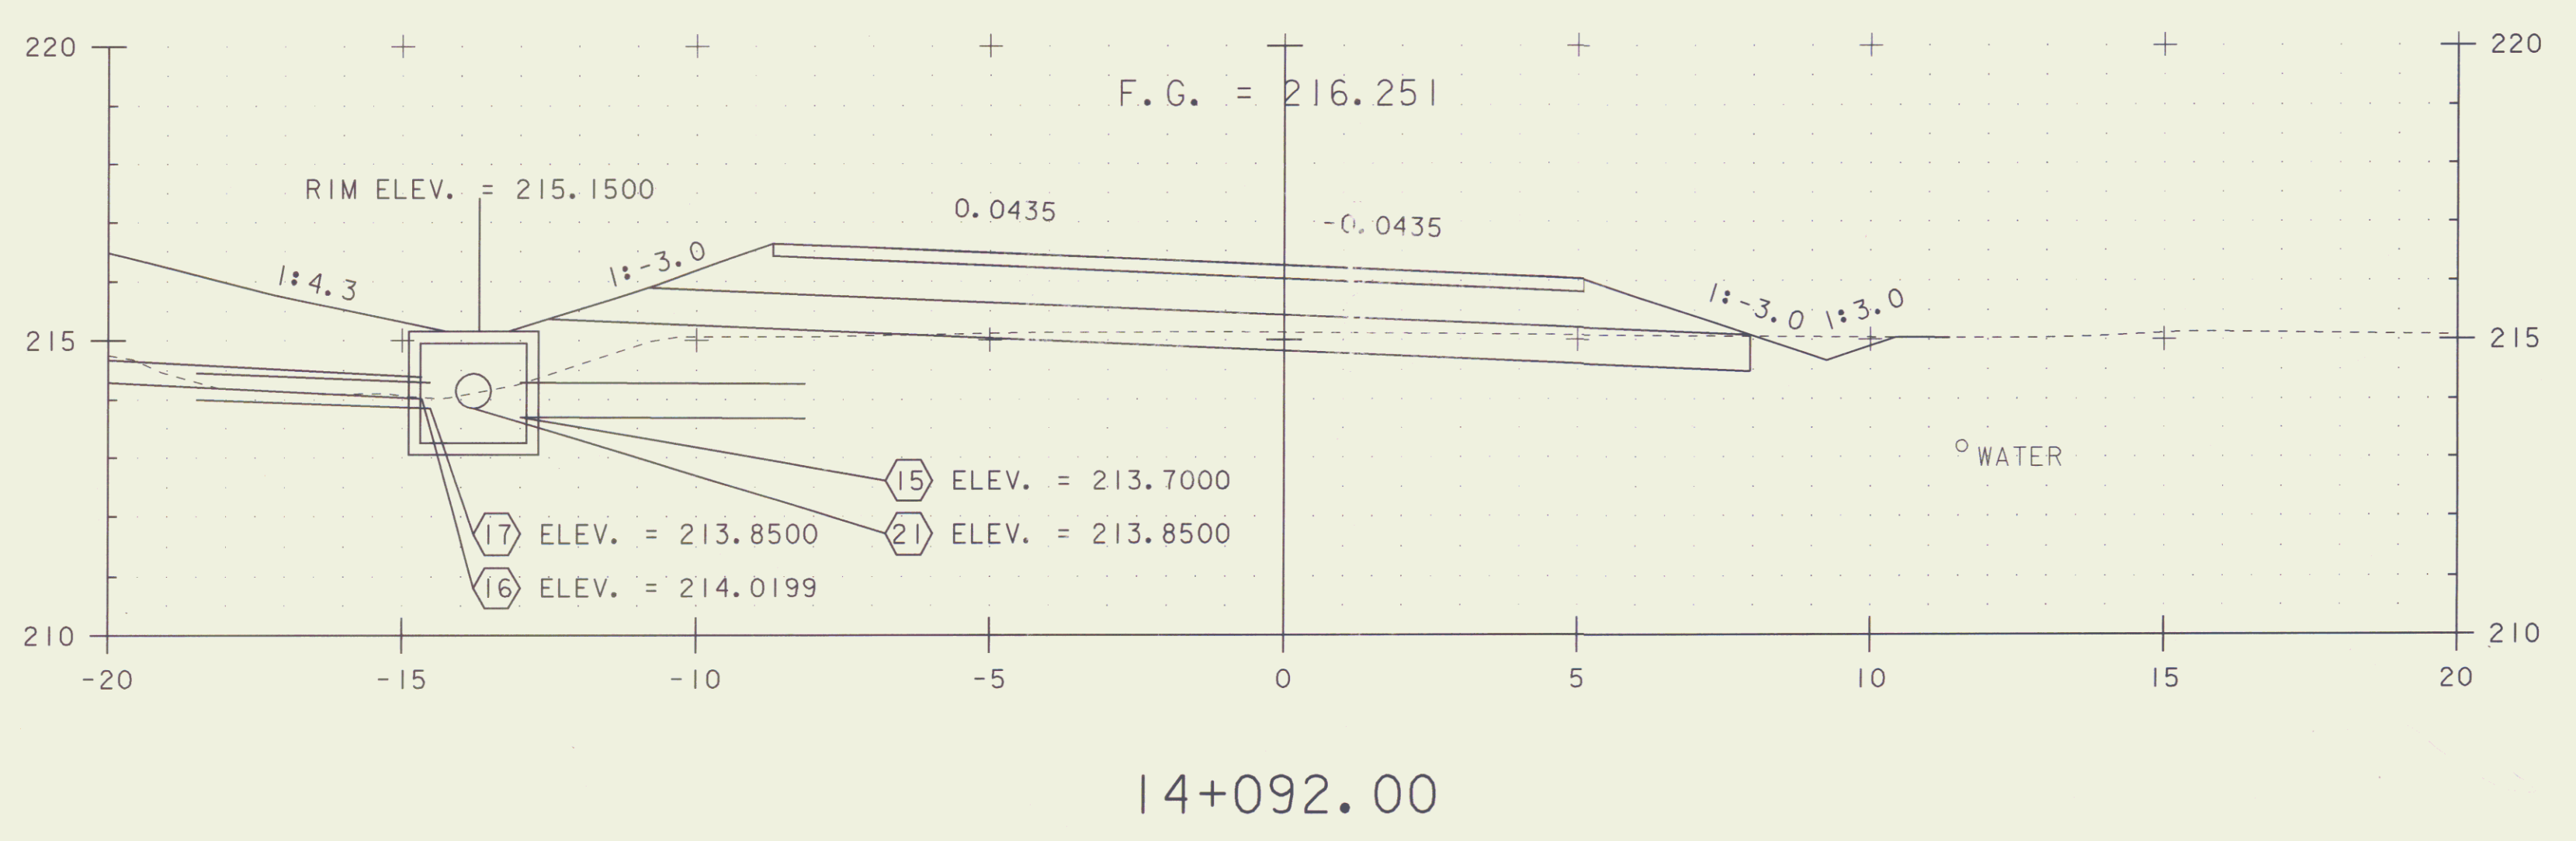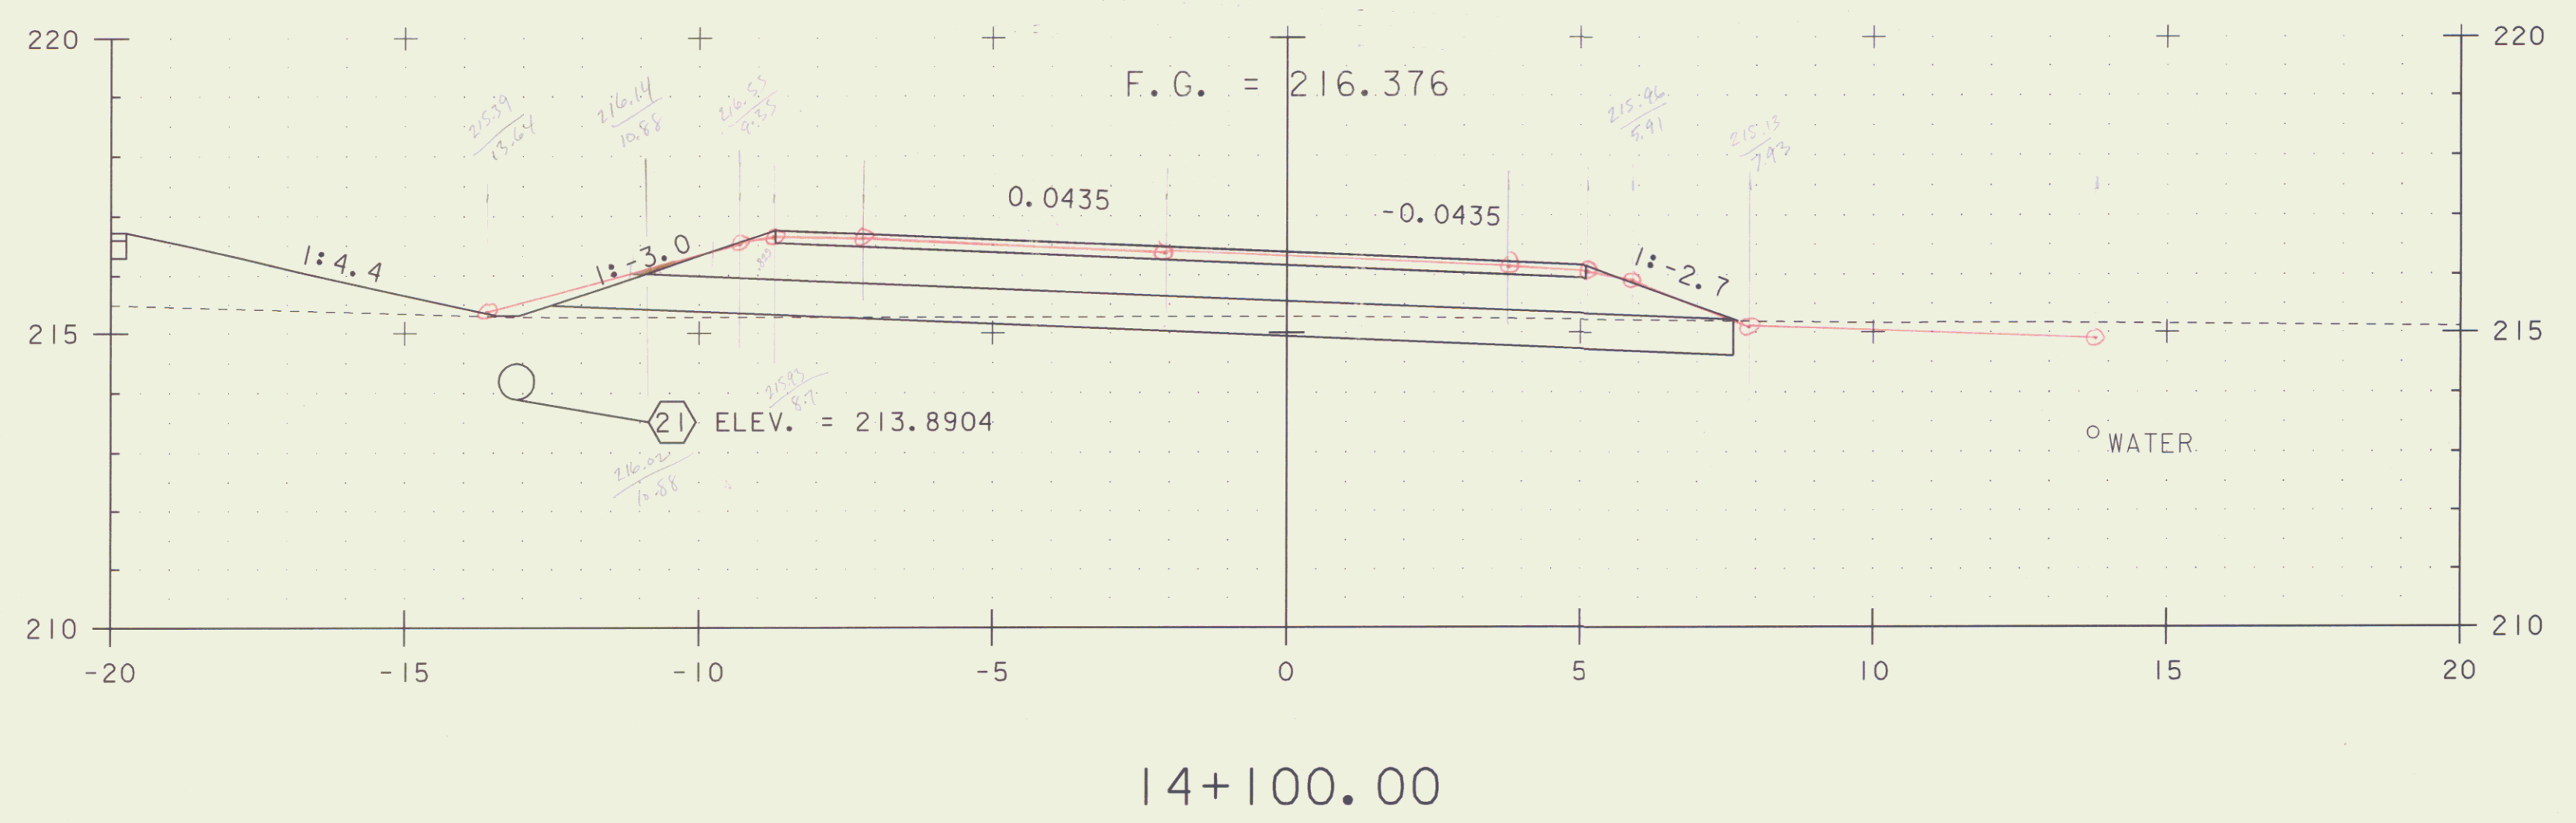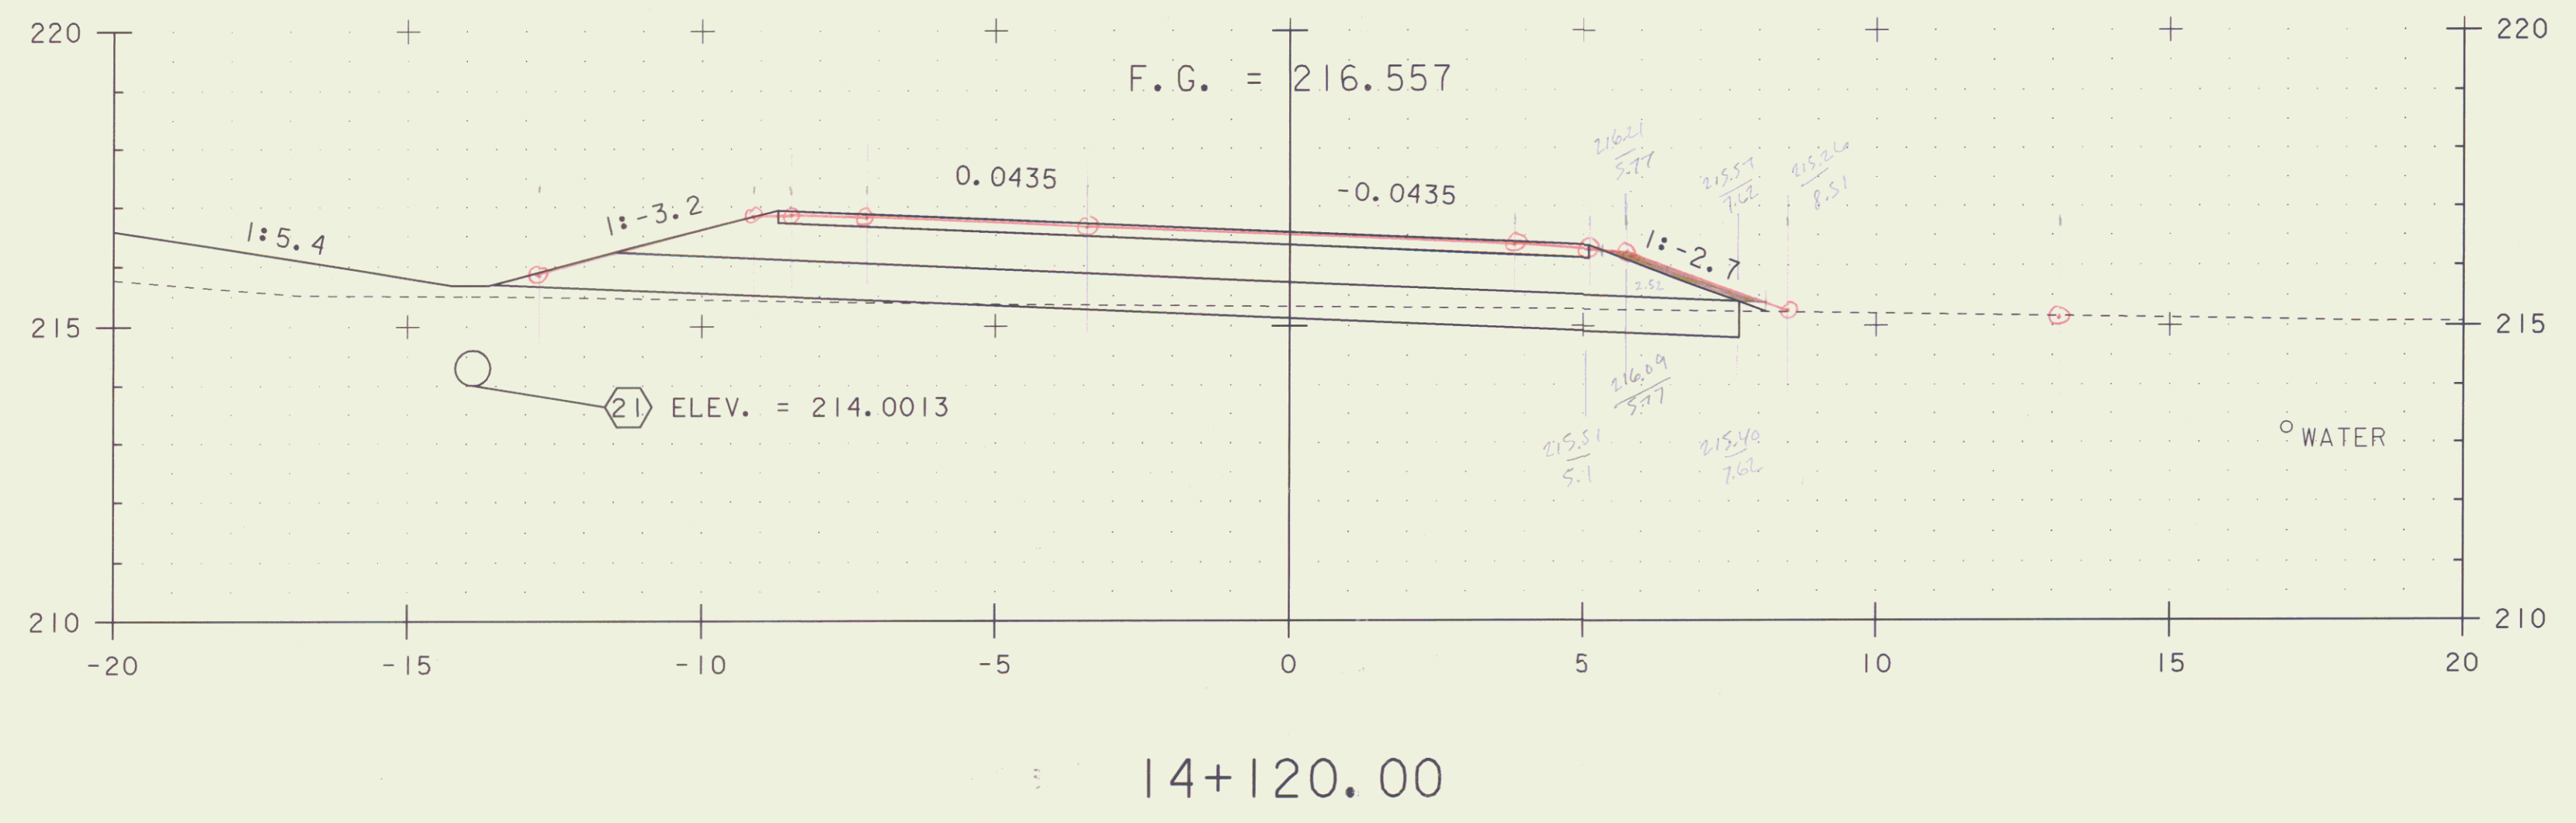


- NOTES:
1. ALL BURIED UTILITIES ARE EXISTING, THE LOCATIONS ARE APPROXIMATE AND ARE TO REMAIN UNDISTURBED
 2. DRAINAGE FEATURES DISPLAYED ON CROSS SECTIONS ARE PROJECTED. SEE DRAINAGE DETAIL SHEETS, LAYOUTS AND PROFILES FOR TRUE LOCATIONS

PROJECT NAME:	EAST MONTPELIER
PROJECT NUMBER:	STPG 028 - 3(35)S
FILE NAME:	+98b028xsl.dgn
PROJECT LEADER:	J. SCHULTZ
DESIGNED BY:	J. GRUCHACZ
VT ROUTE 14 CROSS SECTION SHEET 4	
PLOT DATE:	22-MAR-2010
DRAWN BY:	D. LYMAN
CHECKED BY:	J. DEVLIN
SHEET	119 OF 142


STA. 14+092 TO STA. 14+120

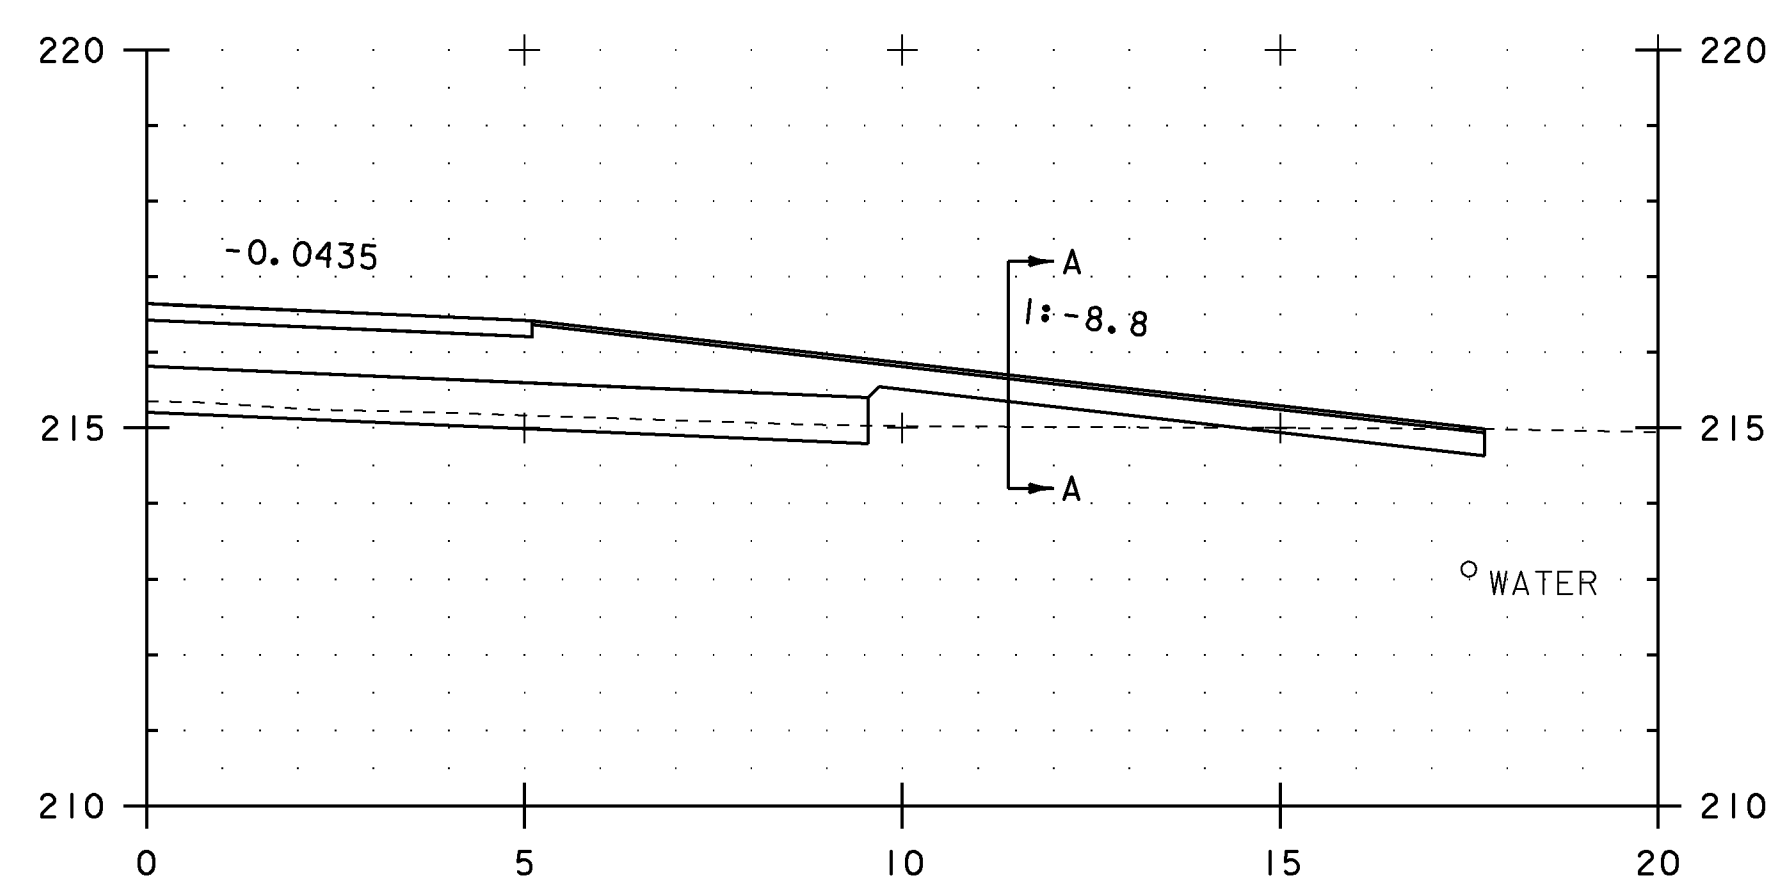


14+137.00
PAVED DRIVE RT

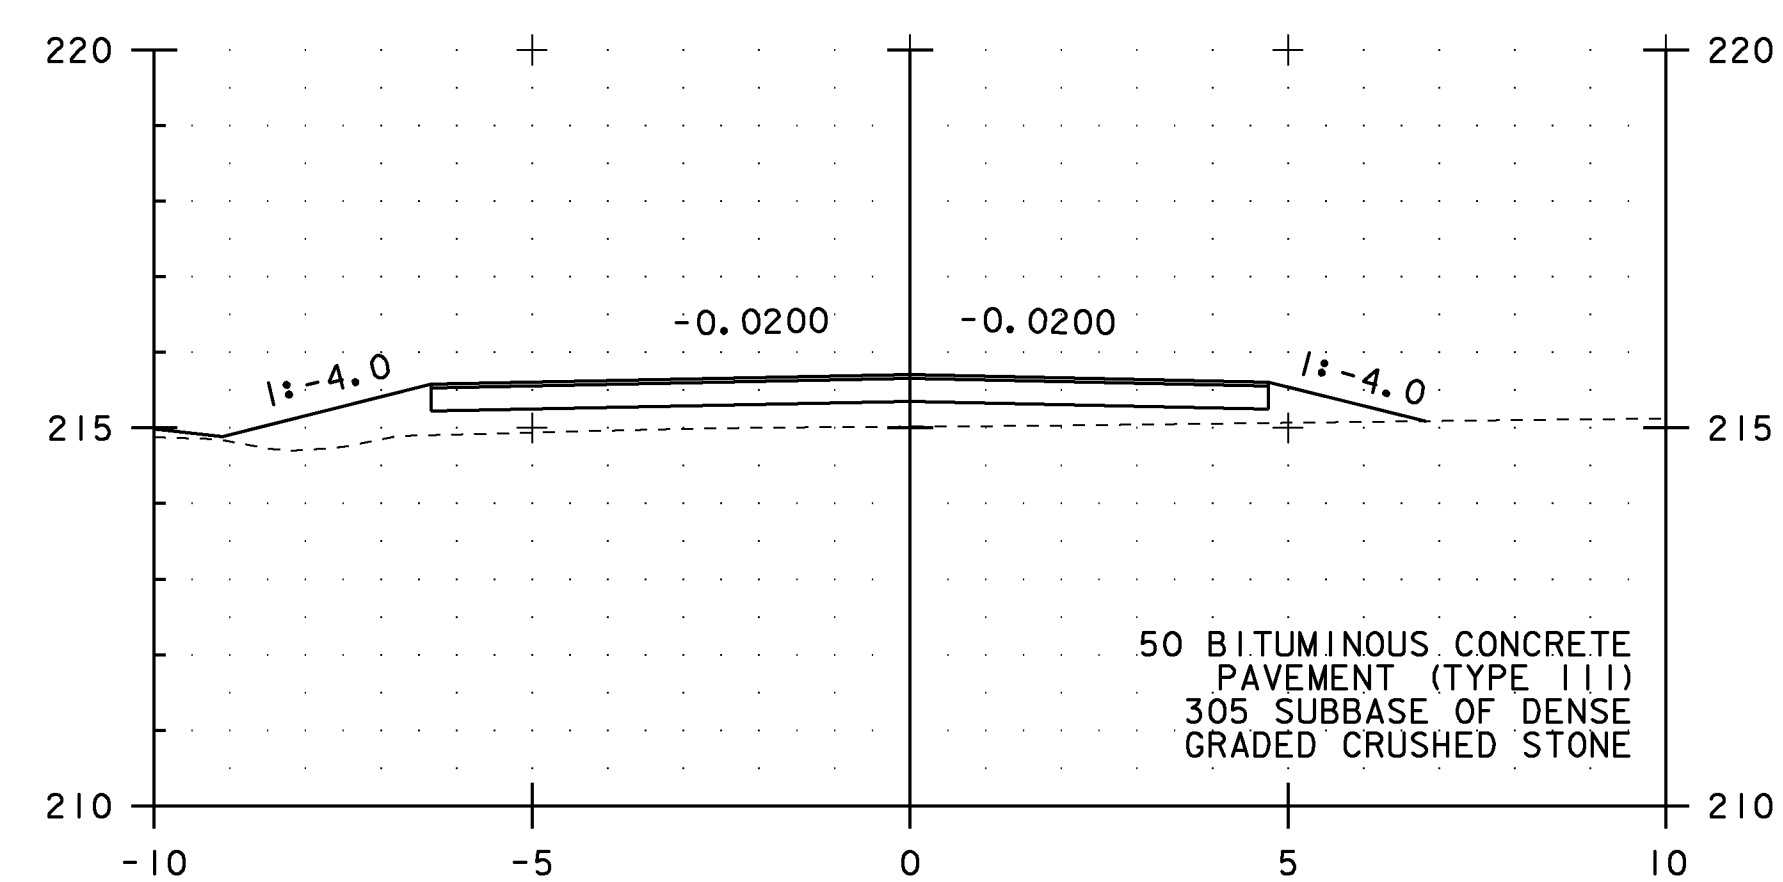

SECTION A-A

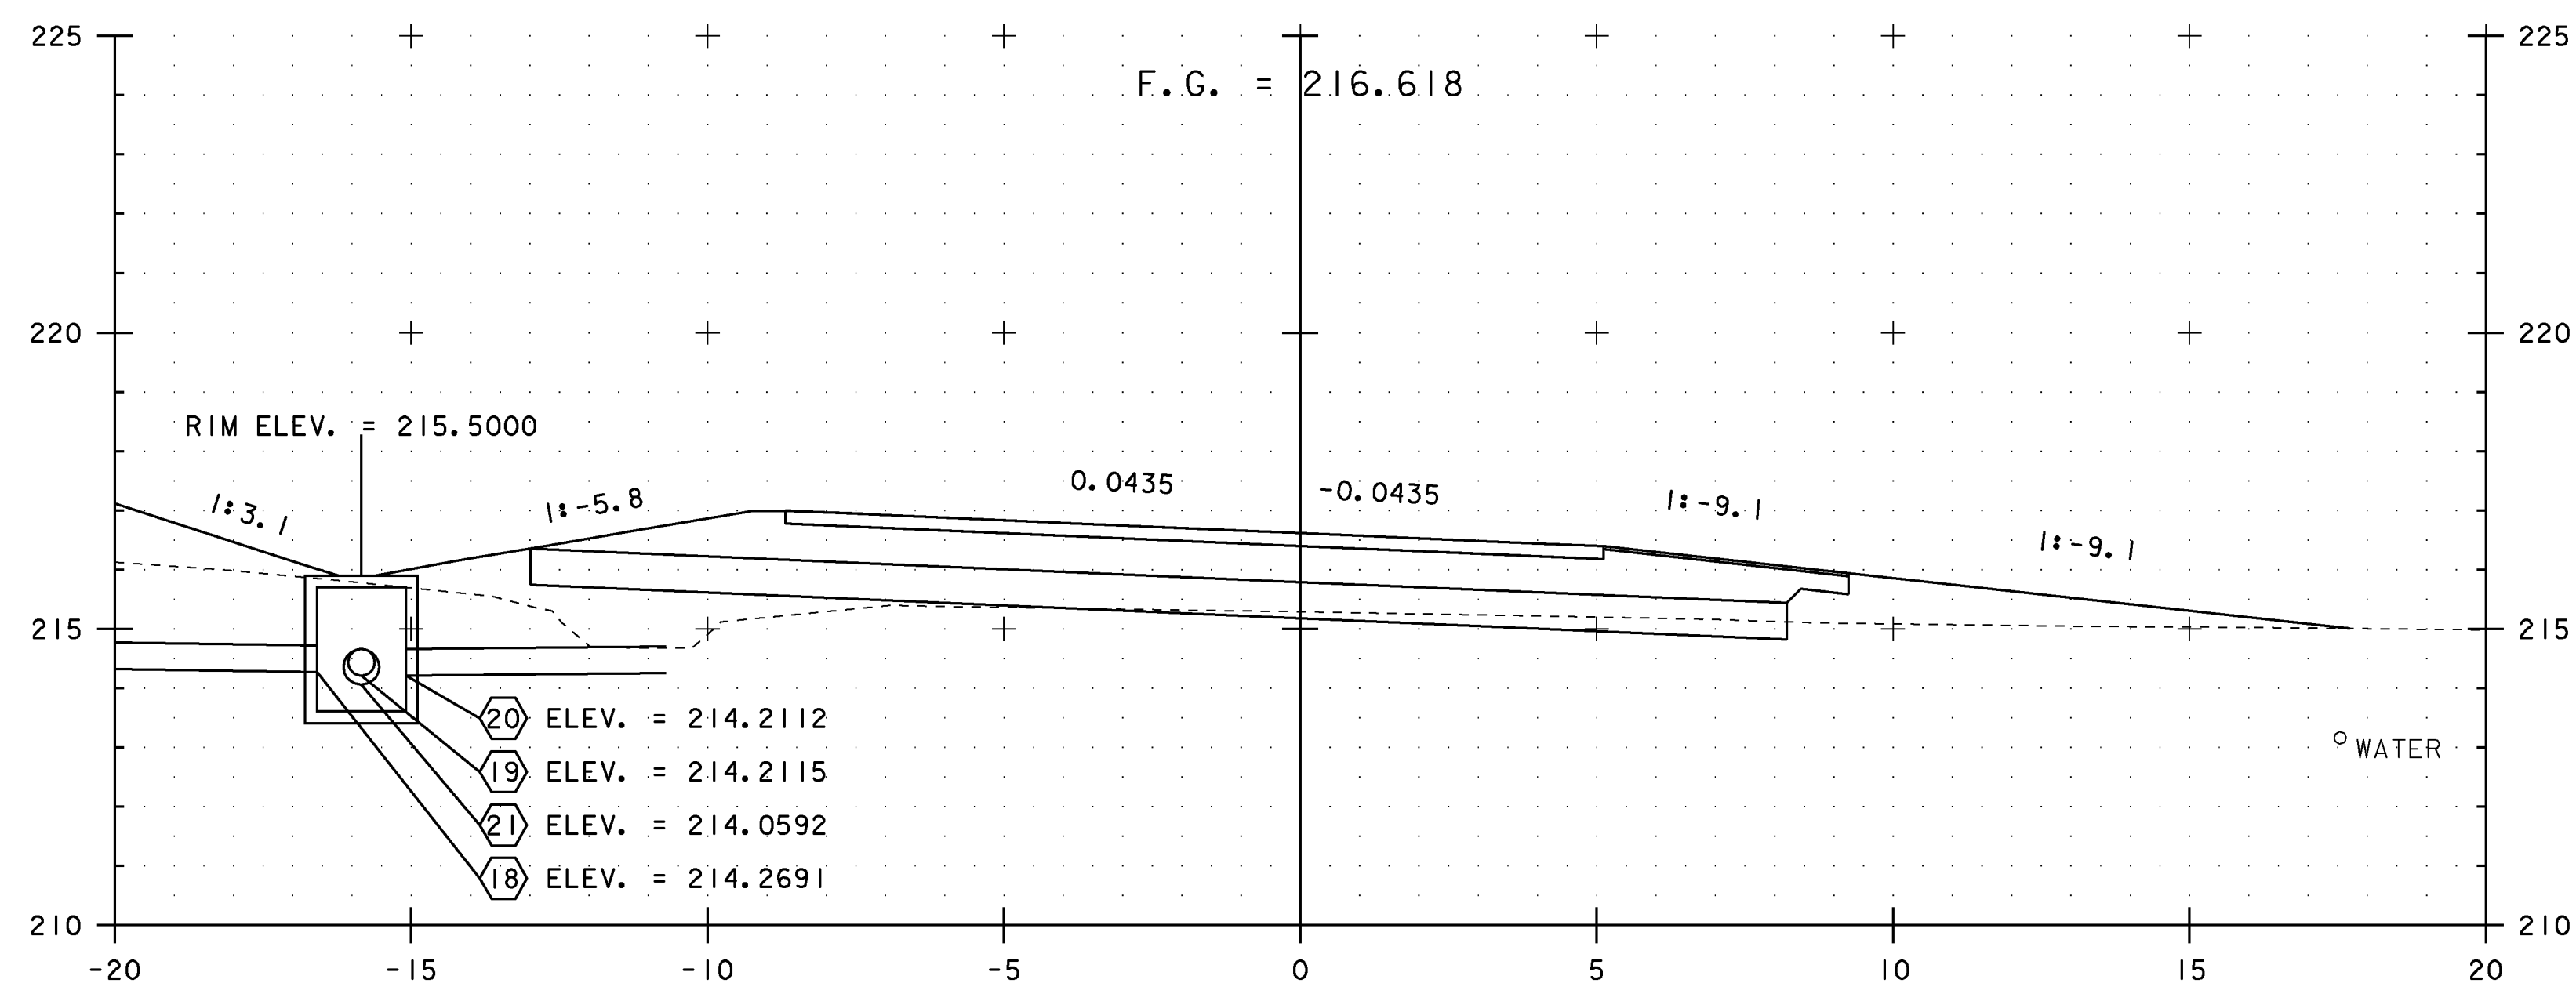

14+131.00

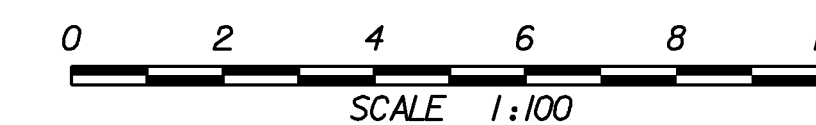

NOTES:


1. ALL BURIED UTILITIES ARE EXISTING, THE LOCATIONS ARE APPROXIMATE AND ARE TO REMAIN UNDISTURBED
2. DRAINAGE FEATURES DISPLAYED ON CROSS SECTIONS ARE PROJECTED. SEE DRAINAGE DETAIL SHEETS, LAYOUTS AND PROFILES FOR TRUE LOCATIONS

PROJECT NAME: EAST MONTPELIER
PROJECT NUMBER: STPG 028 - 3(35)S


FILE NAME: +98b028xsl.dgn
PROJECT LEADER: J. SCHULTZ
DESIGNED BY: J. GRUCHACZ
VT ROUTE 14 CROSS SECTION SHEET 5

PLOT DATE: 22-MAR-2010
DRAWN BY: D. LYMAN
CHECKED BY: J. DEVLIN
SHEET 120 OF 142


STA. 14+131 TO STA. 14+137

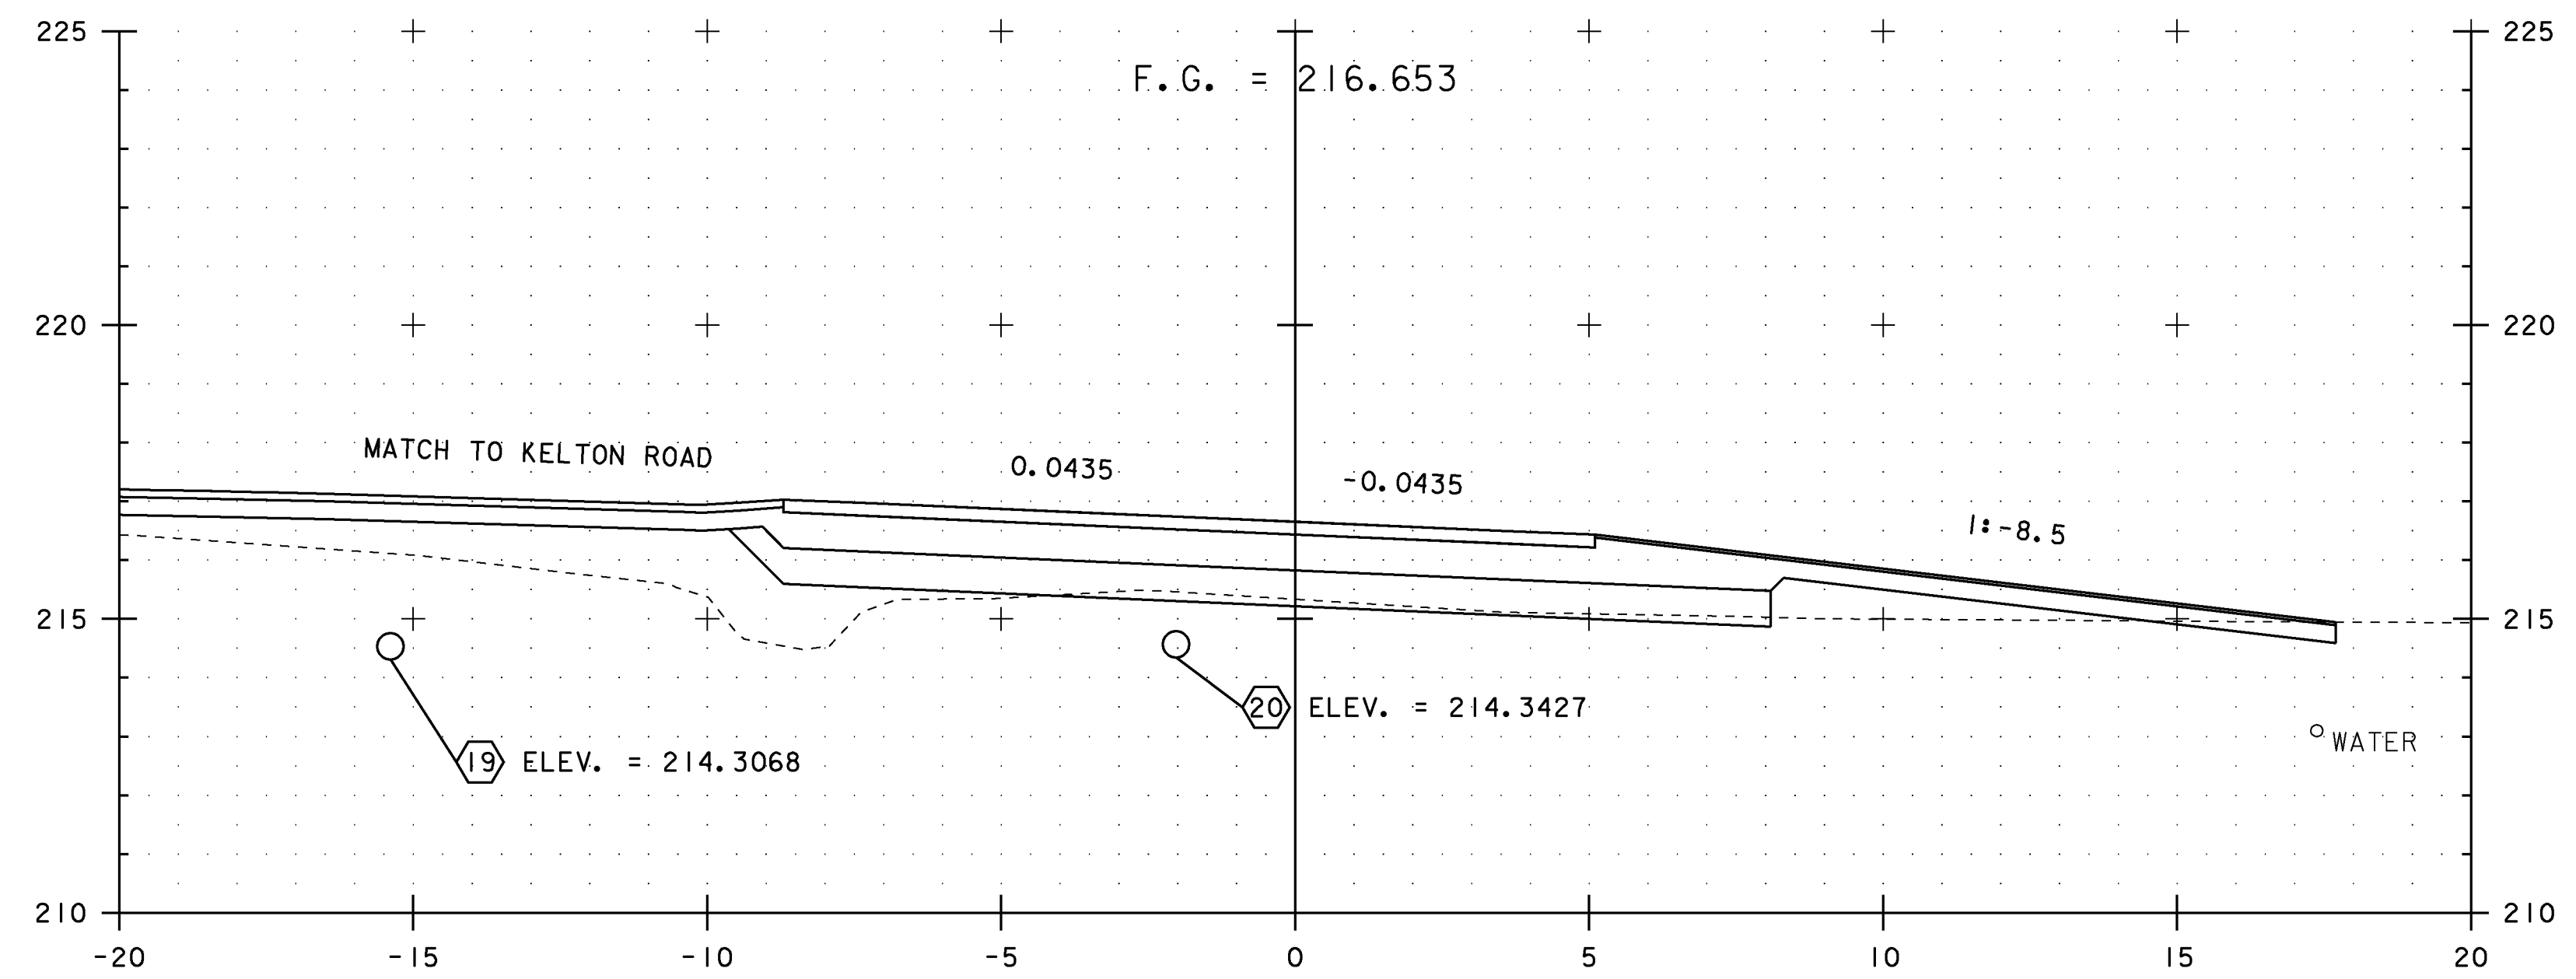

14+140.00

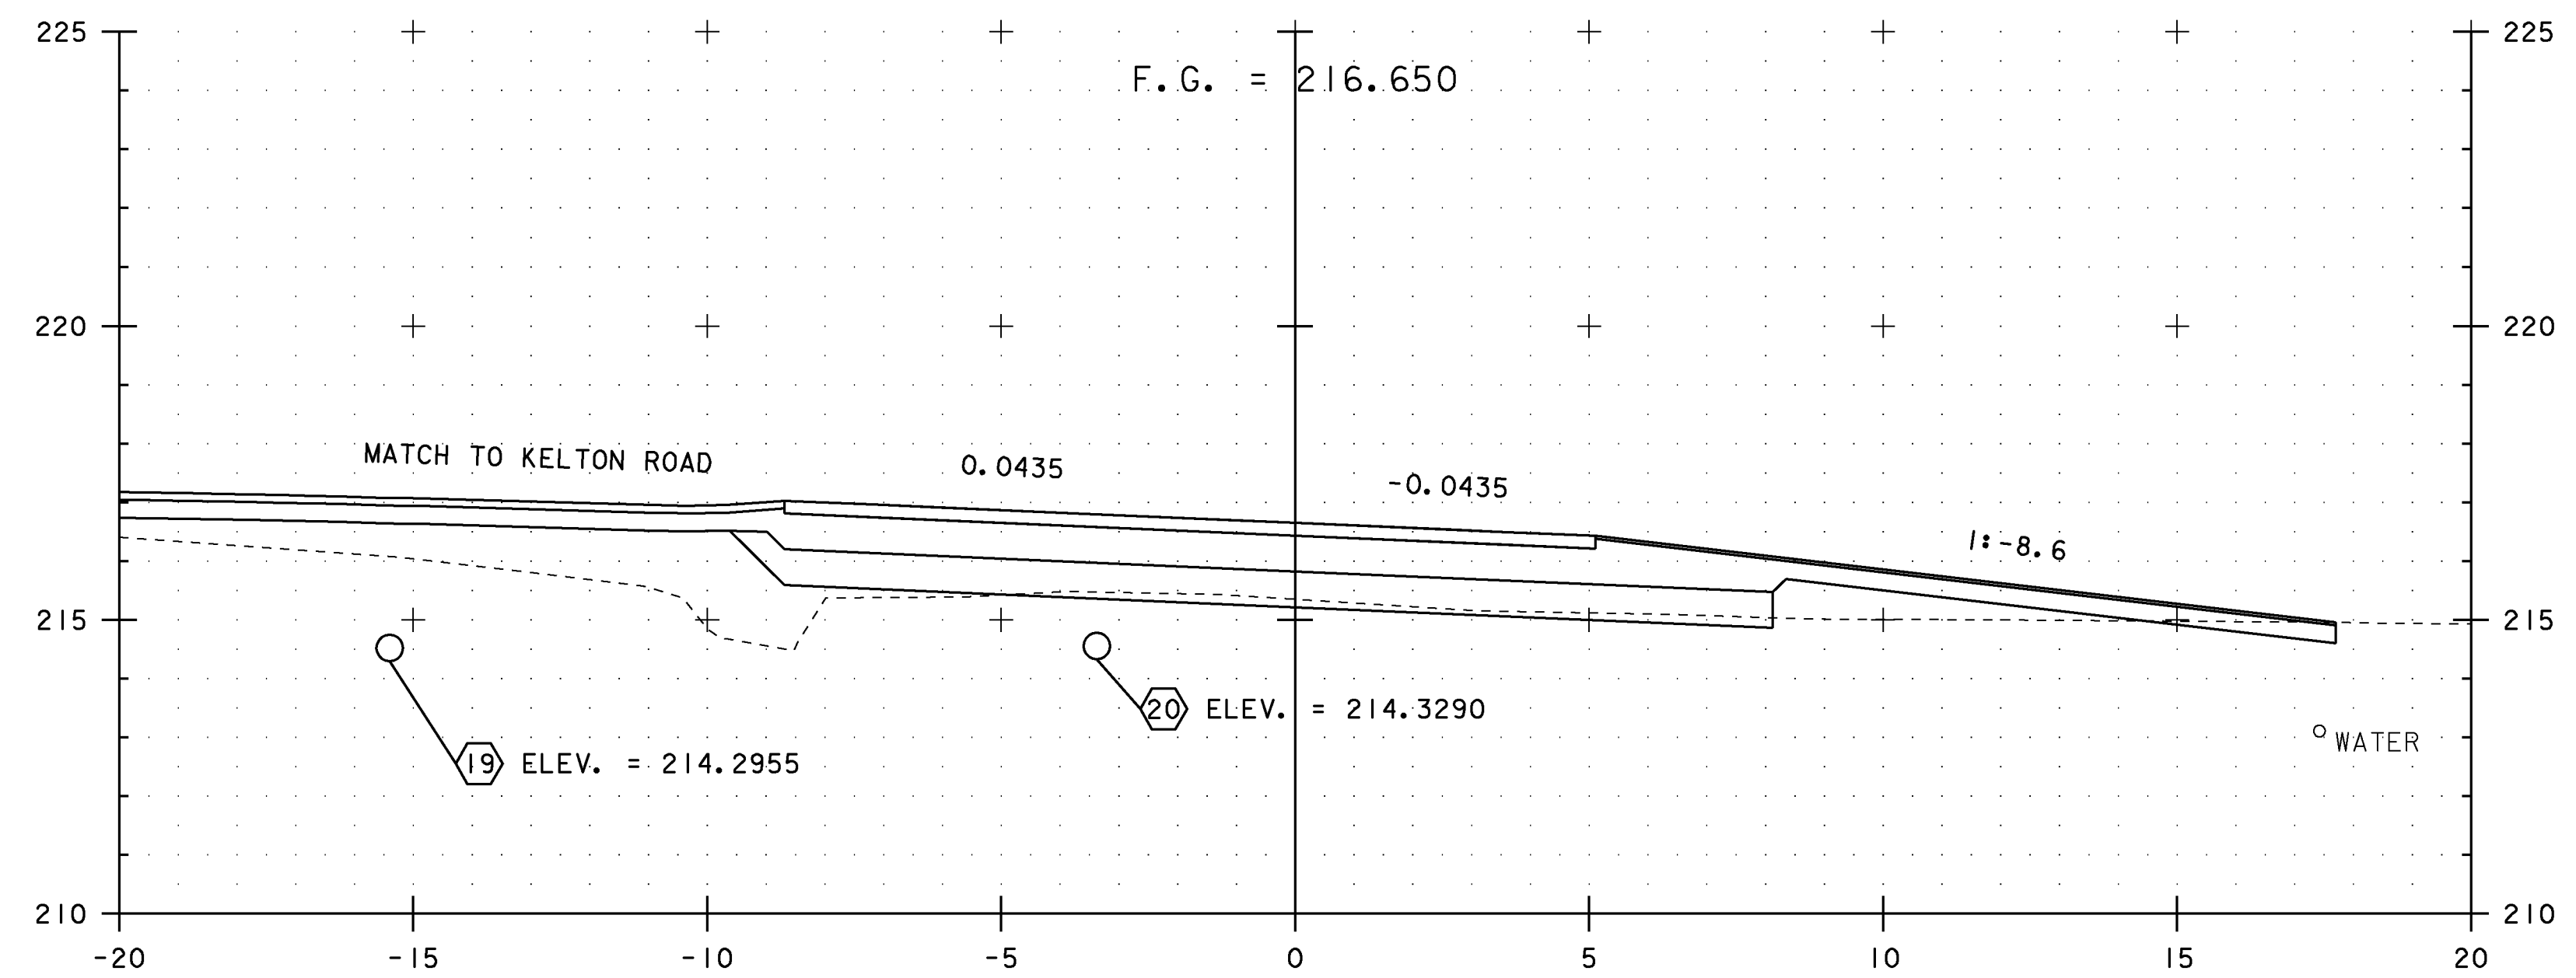

14+139.00

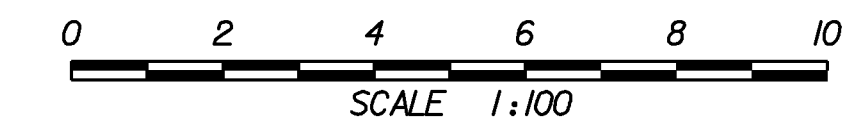


NOTES:

1. ALL BURIED UTILITIES ARE EXISTING, THE LOCATIONS ARE APPROXIMATE AND ARE TO REMAIN UNDISTURBED
2. DRAINAGE FEATURES DISPLAYED ON CROSS SECTIONS ARE PROJECTED. SEE DRAINAGE DETAIL SHEETS, LAYOUTS AND PROFILES FOR TRUE LOCATIONS


STA. 14+139 TO STA. 14+140

PROJECT NAME: EAST MONTEPELIER
 PROJECT NUMBER: STPG 028 - 3(35)S


FILE NAME: +98b028xsl.dgn	PLOT DATE: 22-MAR-2010
PROJECT LEADER: J. SCHULTZ	DRAWN BY: D. LYMAN
DESIGNED BY: J. GRUCHACZ	CHECKED BY: J. DEVLIN
VT ROUTE 14 CROSS SECTION SHEET 6	SHEET 121 OF 142

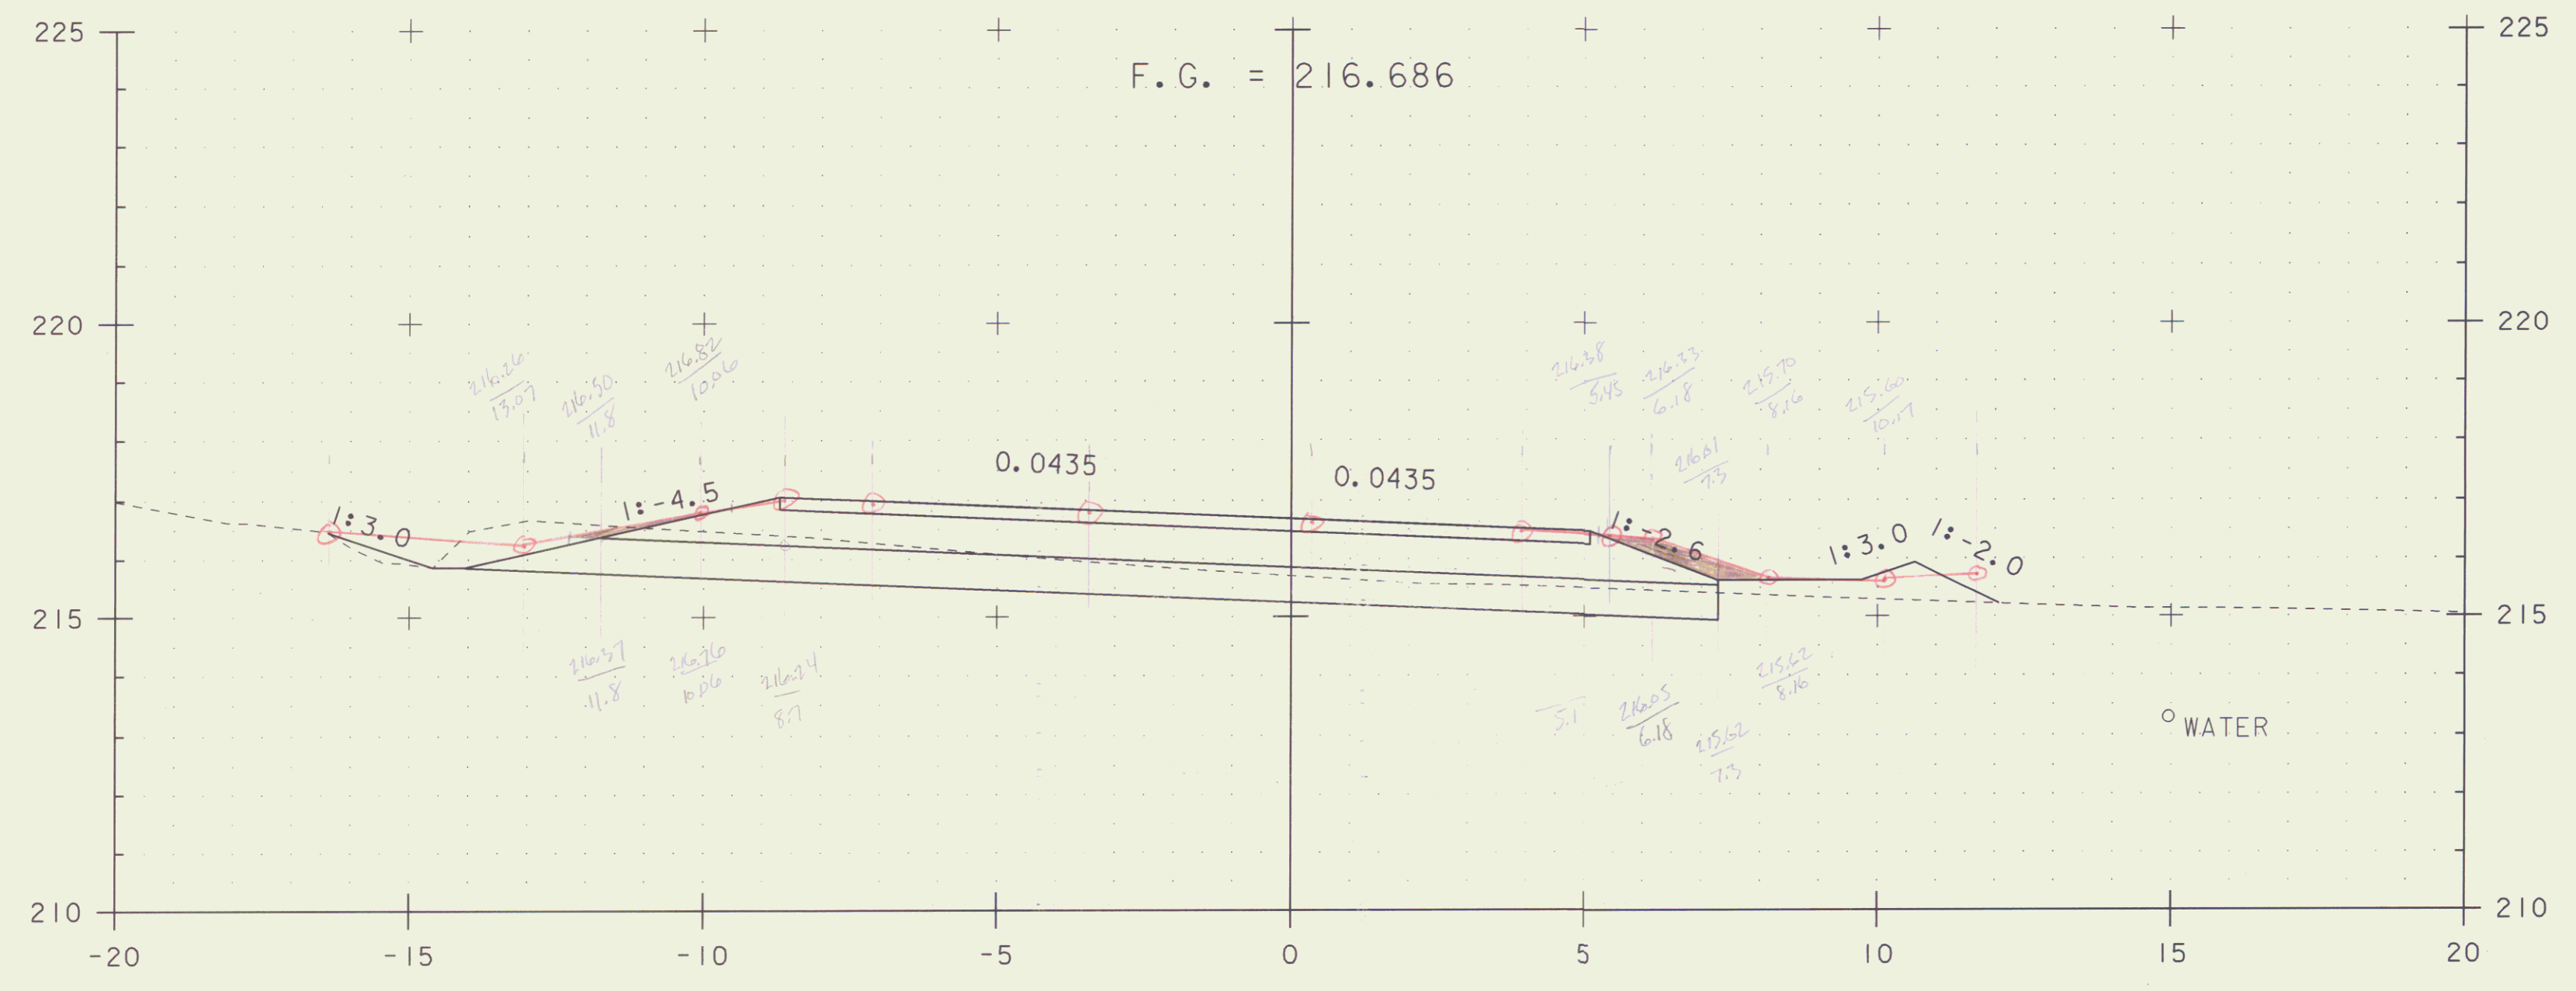

14+160.00

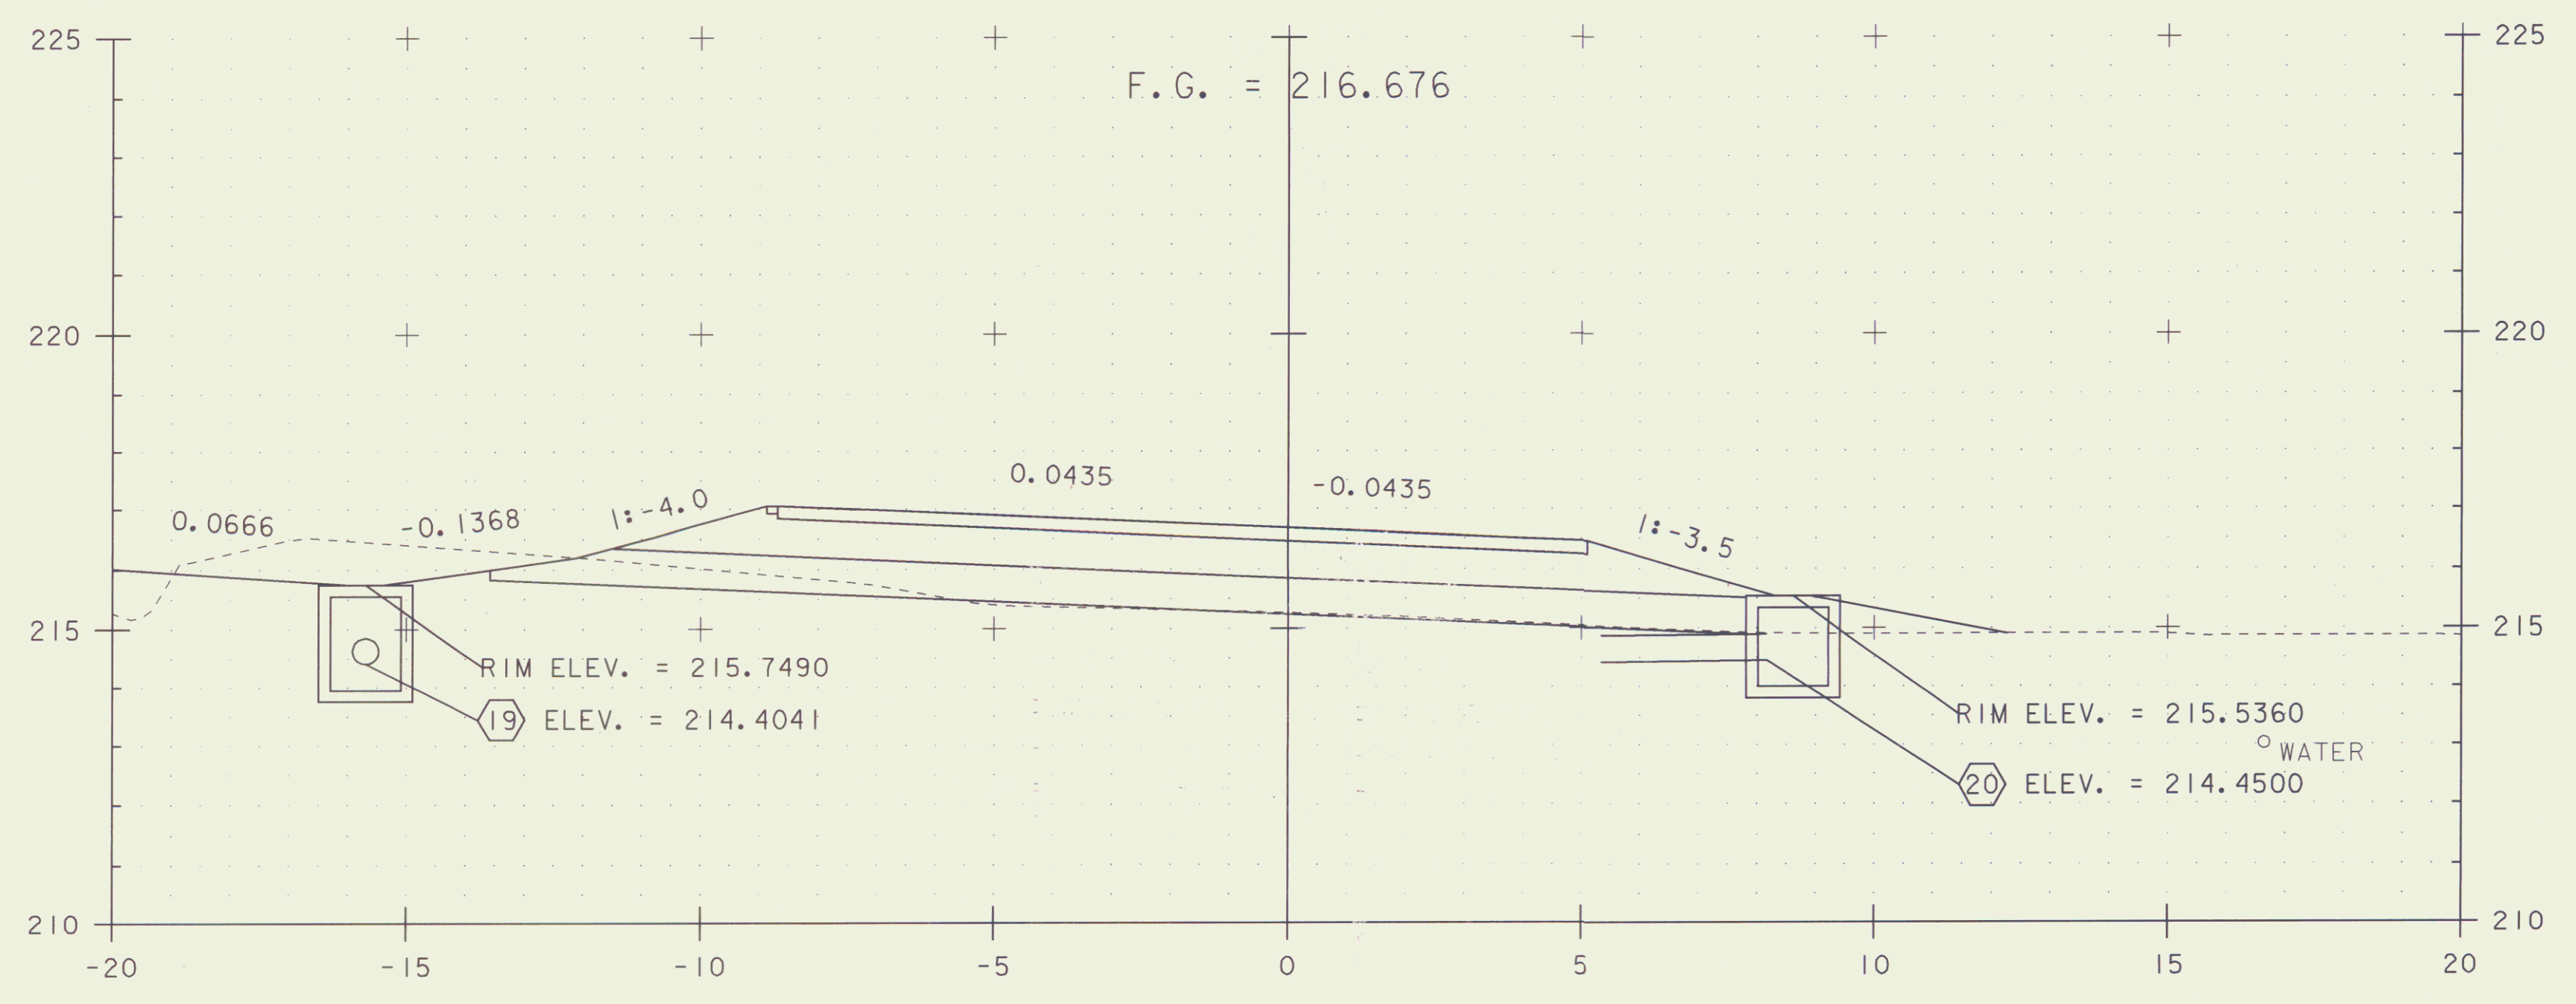





14+149.00

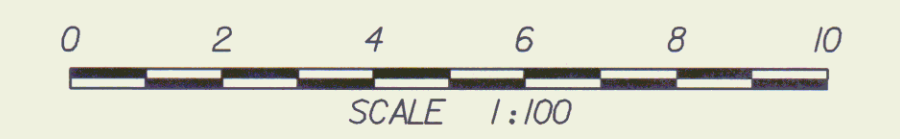

- NOTES:
1. ALL BURIED UTILITIES ARE EXISTING, THE LOCATIONS ARE APPROXIMATE AND ARE TO REMAIN UNDISTURBED
 2. DRAINAGE FEATURES DISPLAYED ON CROSS SECTIONS ARE PROJECTED. SEE DRAINAGE DETAIL SHEETS, LAYOUTS AND PROFILES FOR TRUE LOCATIONS

PROJECT NAME: EAST MONTPELIER	
PROJECT NUMBER: STPG 028 - 3(35)S	
FILE NAME: +98b028xsl.dgn	PLOT DATE: 22-MAR-2010
PROJECT LEADER: J. SCHULTZ	DRAWN BY: D. LYMAN
DESIGNED BY: J. GRUCHACZ	CHECKED BY: J. DEVLIN
VT ROUTE 14 CROSS SECTION SHEET 7	SHEET 122 OF 142


STA. 14+149 TO STA. 14+160

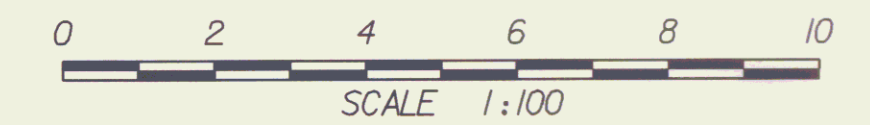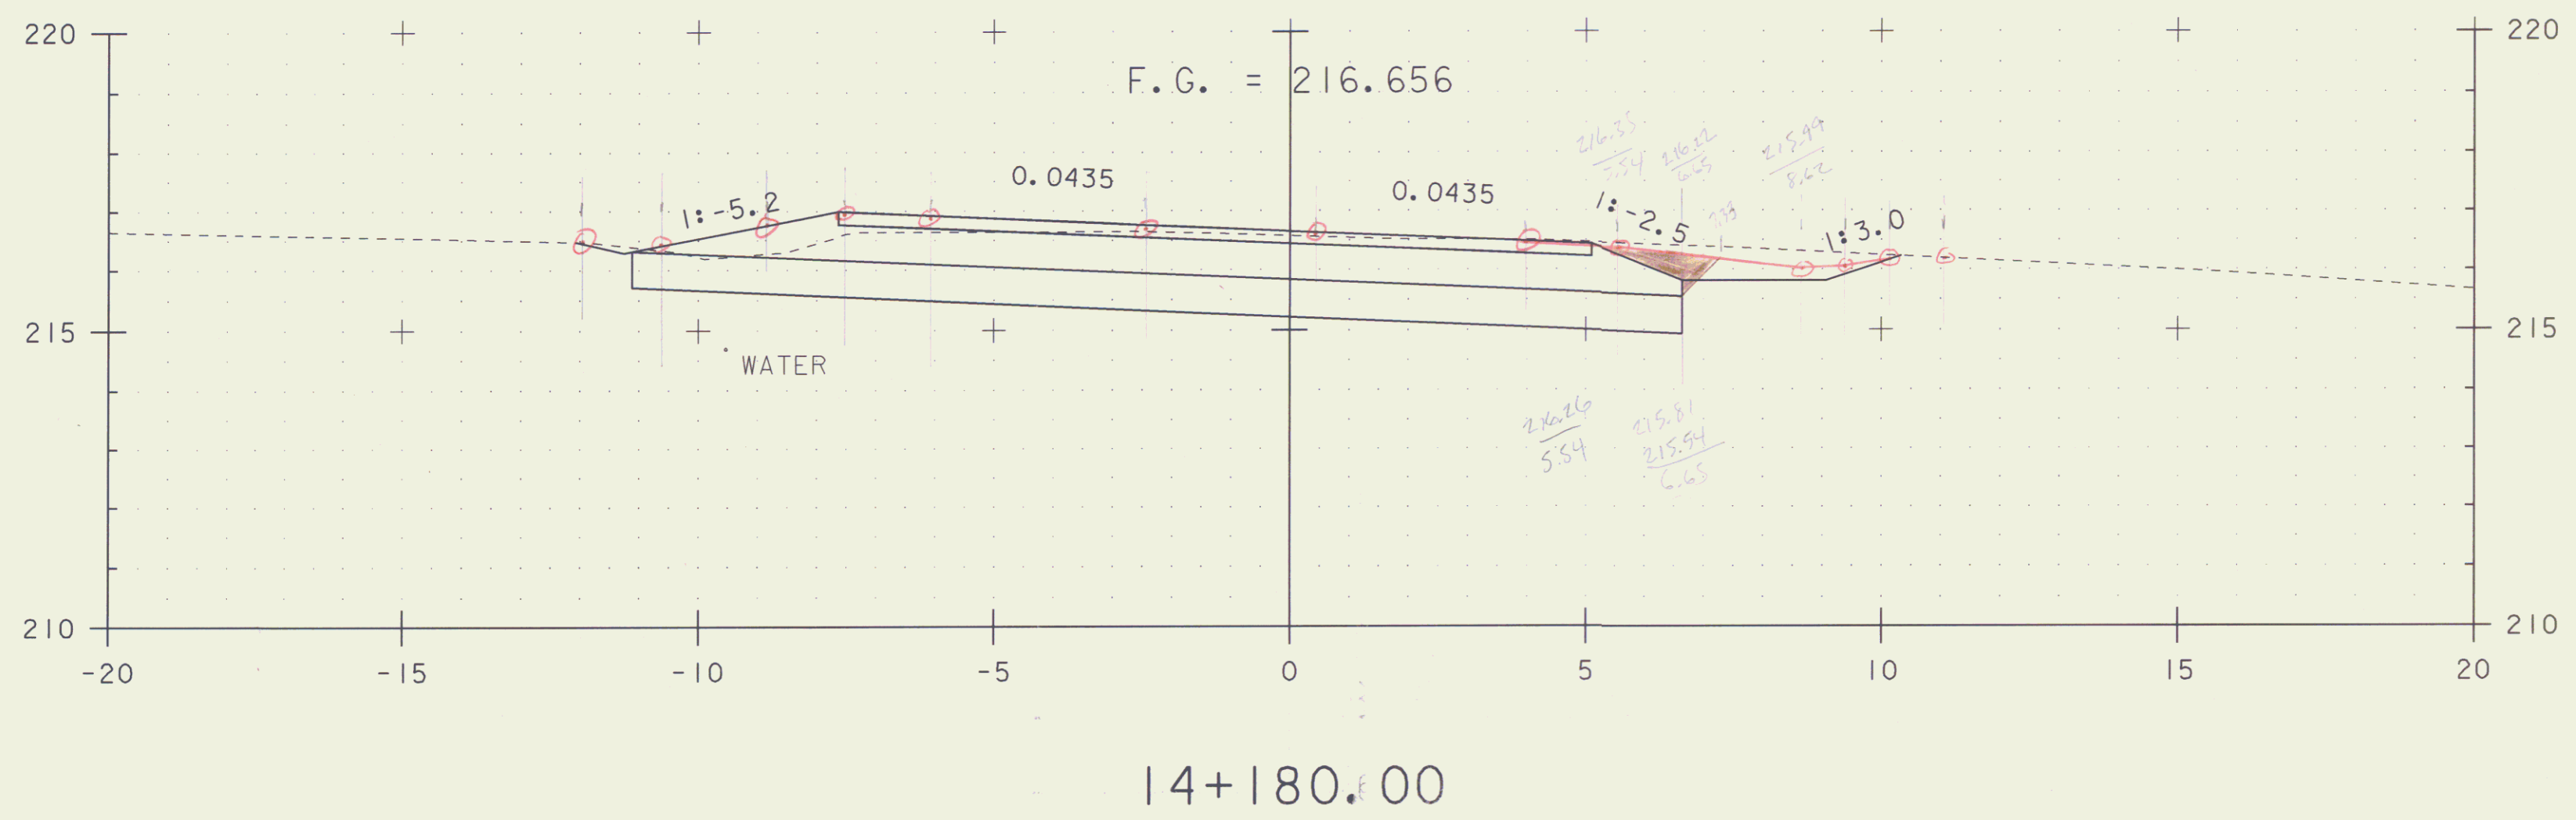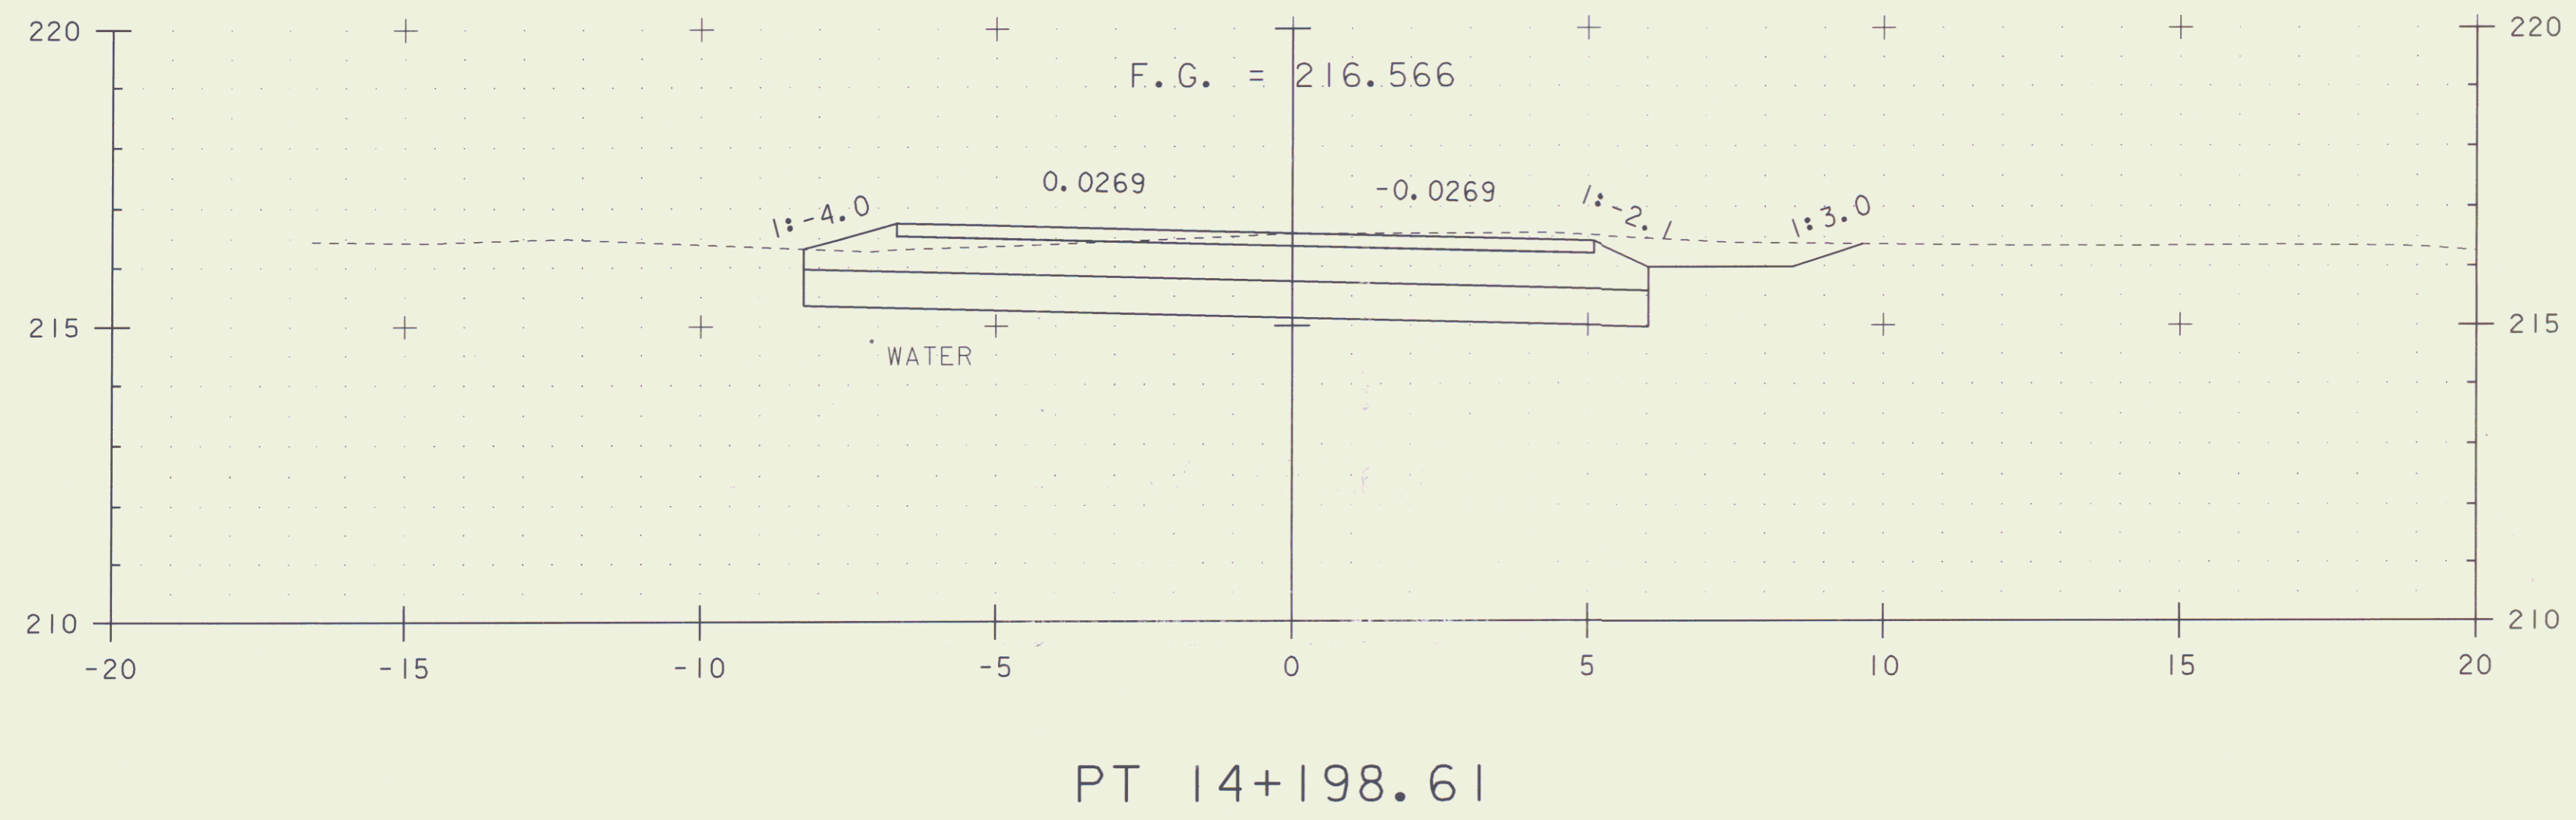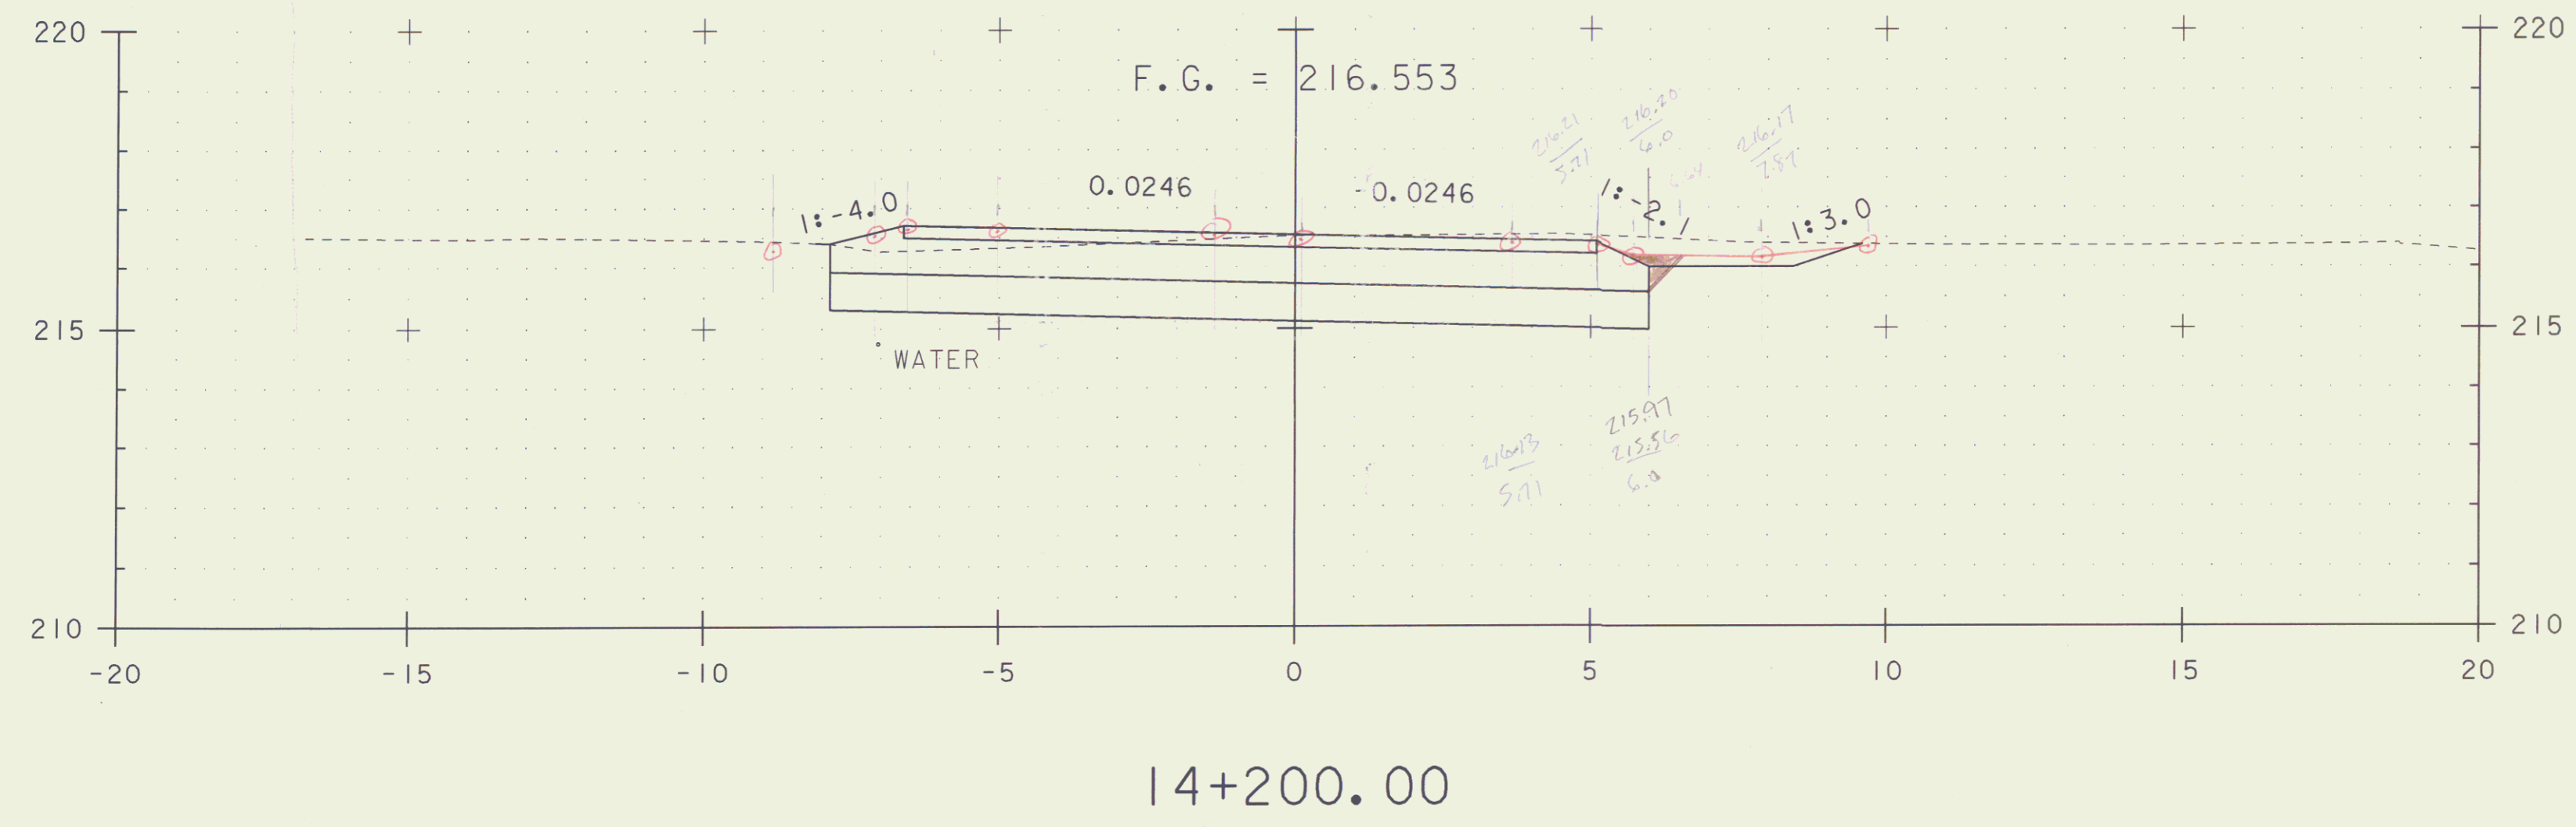


- NOTES:
1. ALL BURIED UTILITIES ARE EXISTING, THE LOCATIONS ARE APPROXIMATE AND ARE TO REMAIN UNDISTURBED
 2. DRAINAGE FEATURES DISPLAYED ON CROSS SECTIONS ARE PROJECTED. SEE DRAINAGE DETAIL SHEETS, LAYOUTS AND PROFILES FOR TRUE LOCATIONS

STA. 14+180 TO STA. 14+200


PROJECT NAME: EAST MONTPELIER	
PROJECT NUMBER: STPG 028 - 3(35)S	
FILE NAME: +98b028xsl.dgn	PLOT DATE: 22-MAR-2010
PROJECT LEADER: J. SCHULTZ	DRAWN BY: D. LYMAN
DESIGNED BY: J. GRUCHACZ	CHECKED BY: J. DEVLIN
VT ROUTE 14 CROSS SECTION SHEET 8	SHEET 123 OF 142

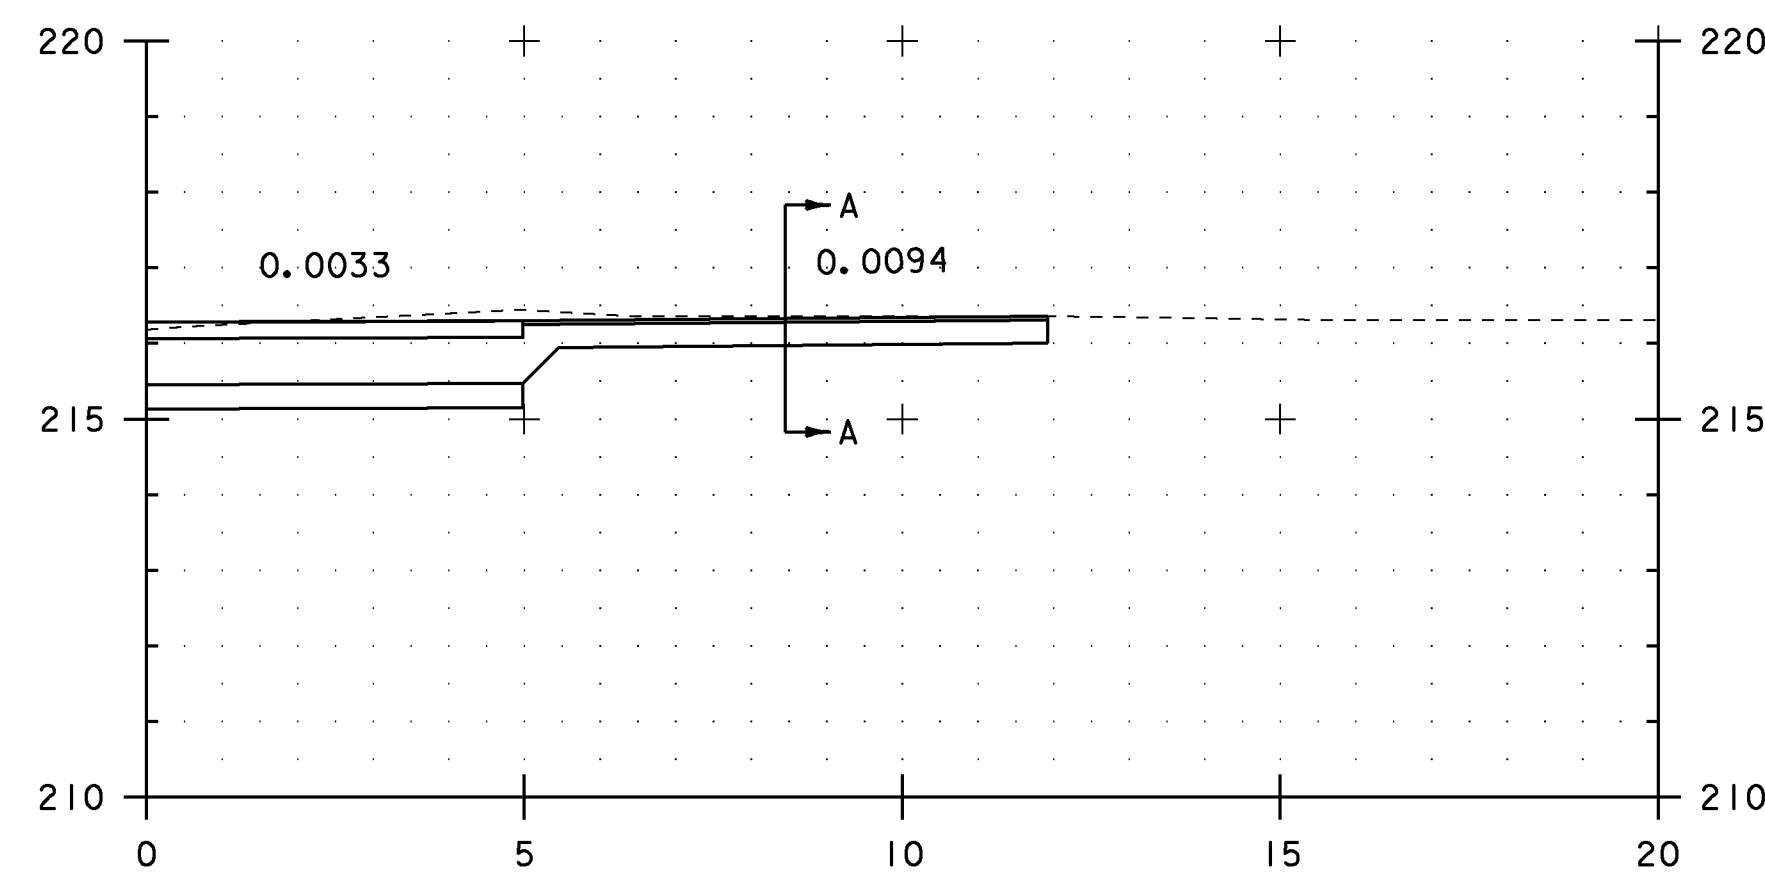


14+217.00
PAVED DRIVE RT

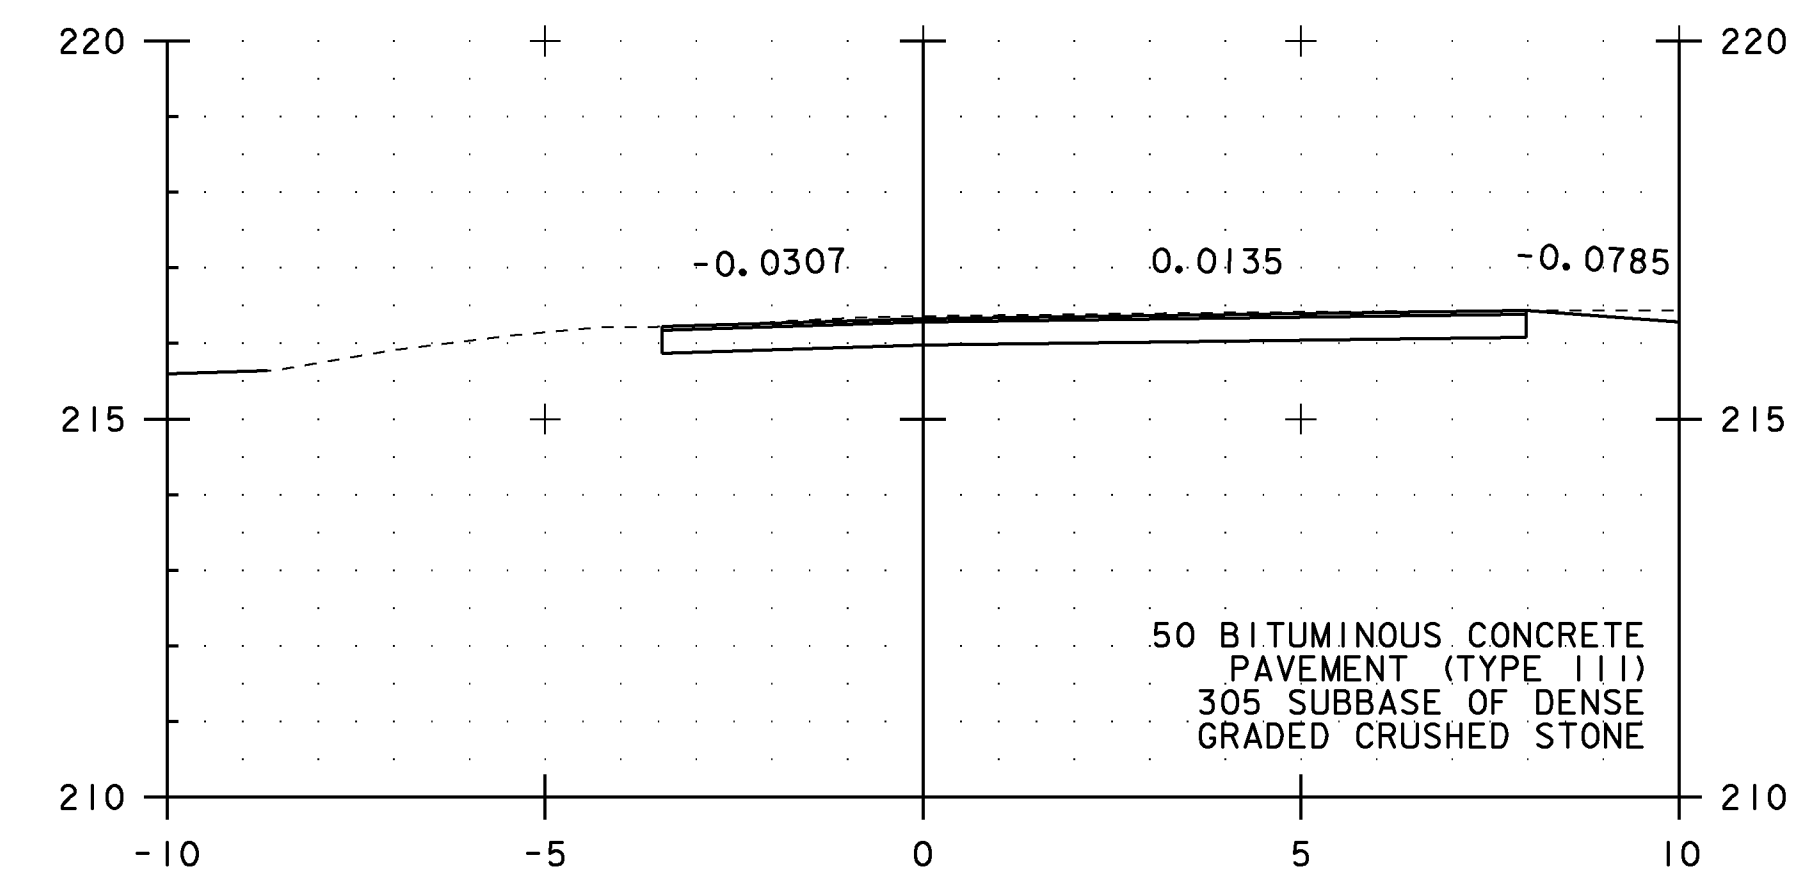


SECTION A-A

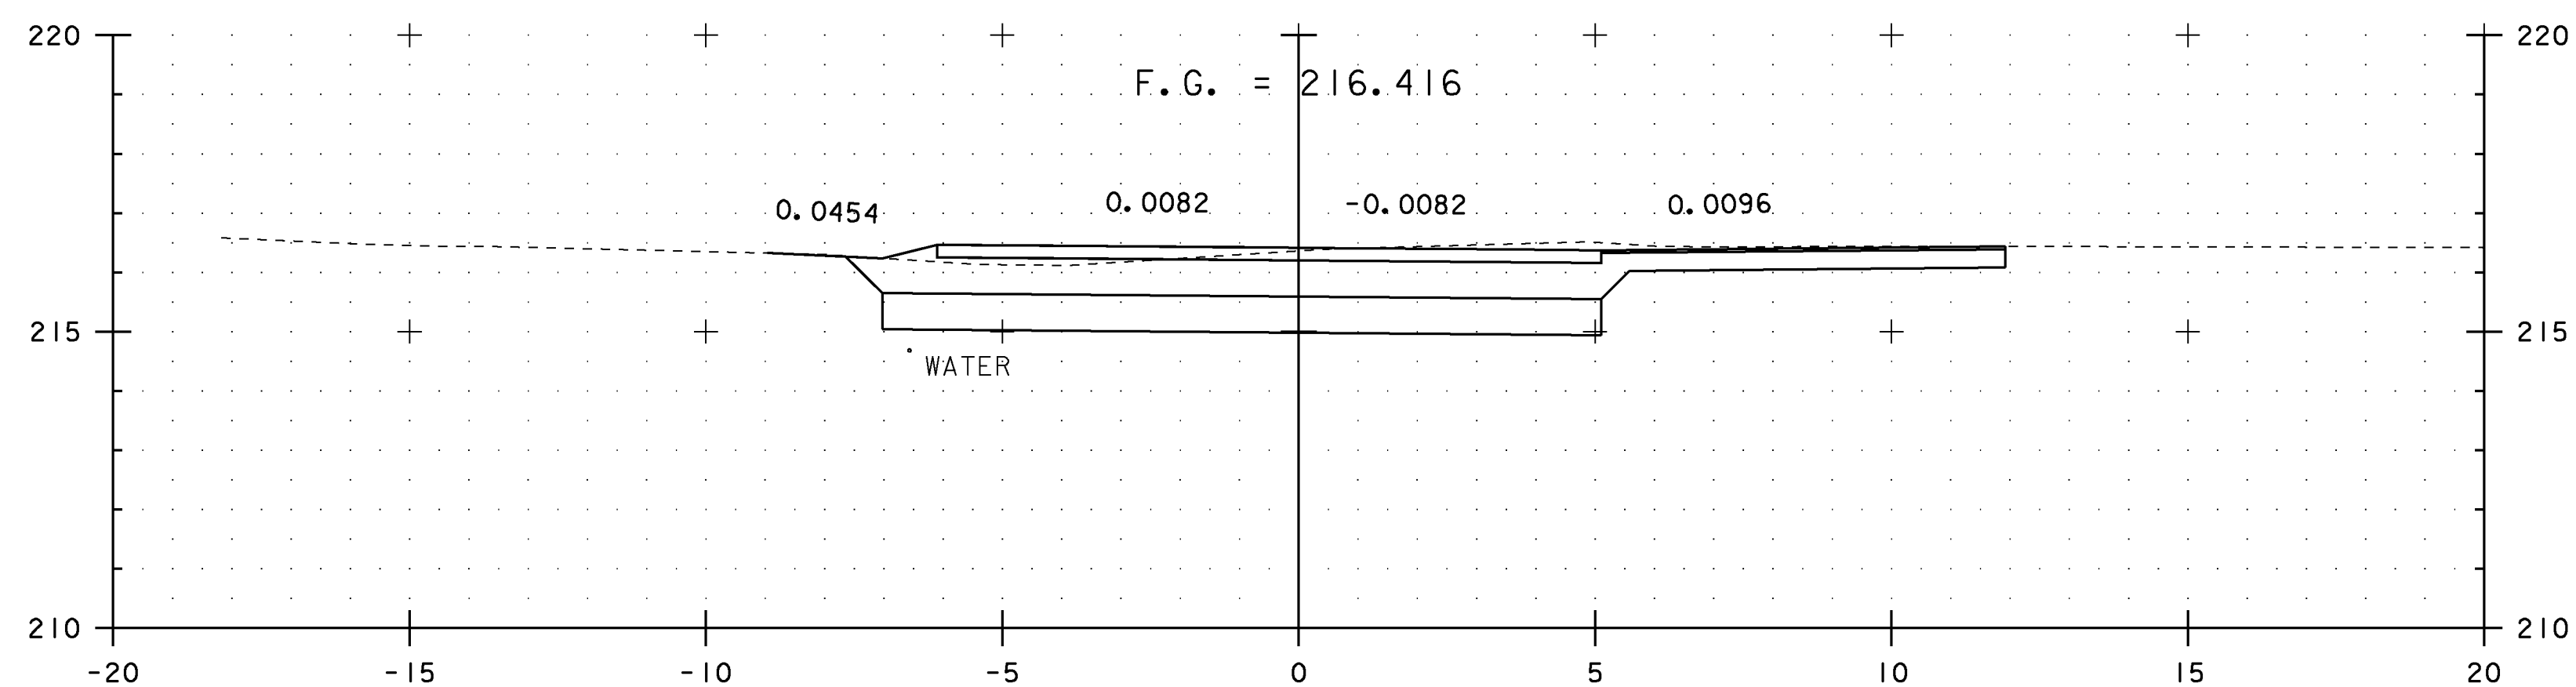


14+210.00
END PROJECT
BEGIN APPROACH

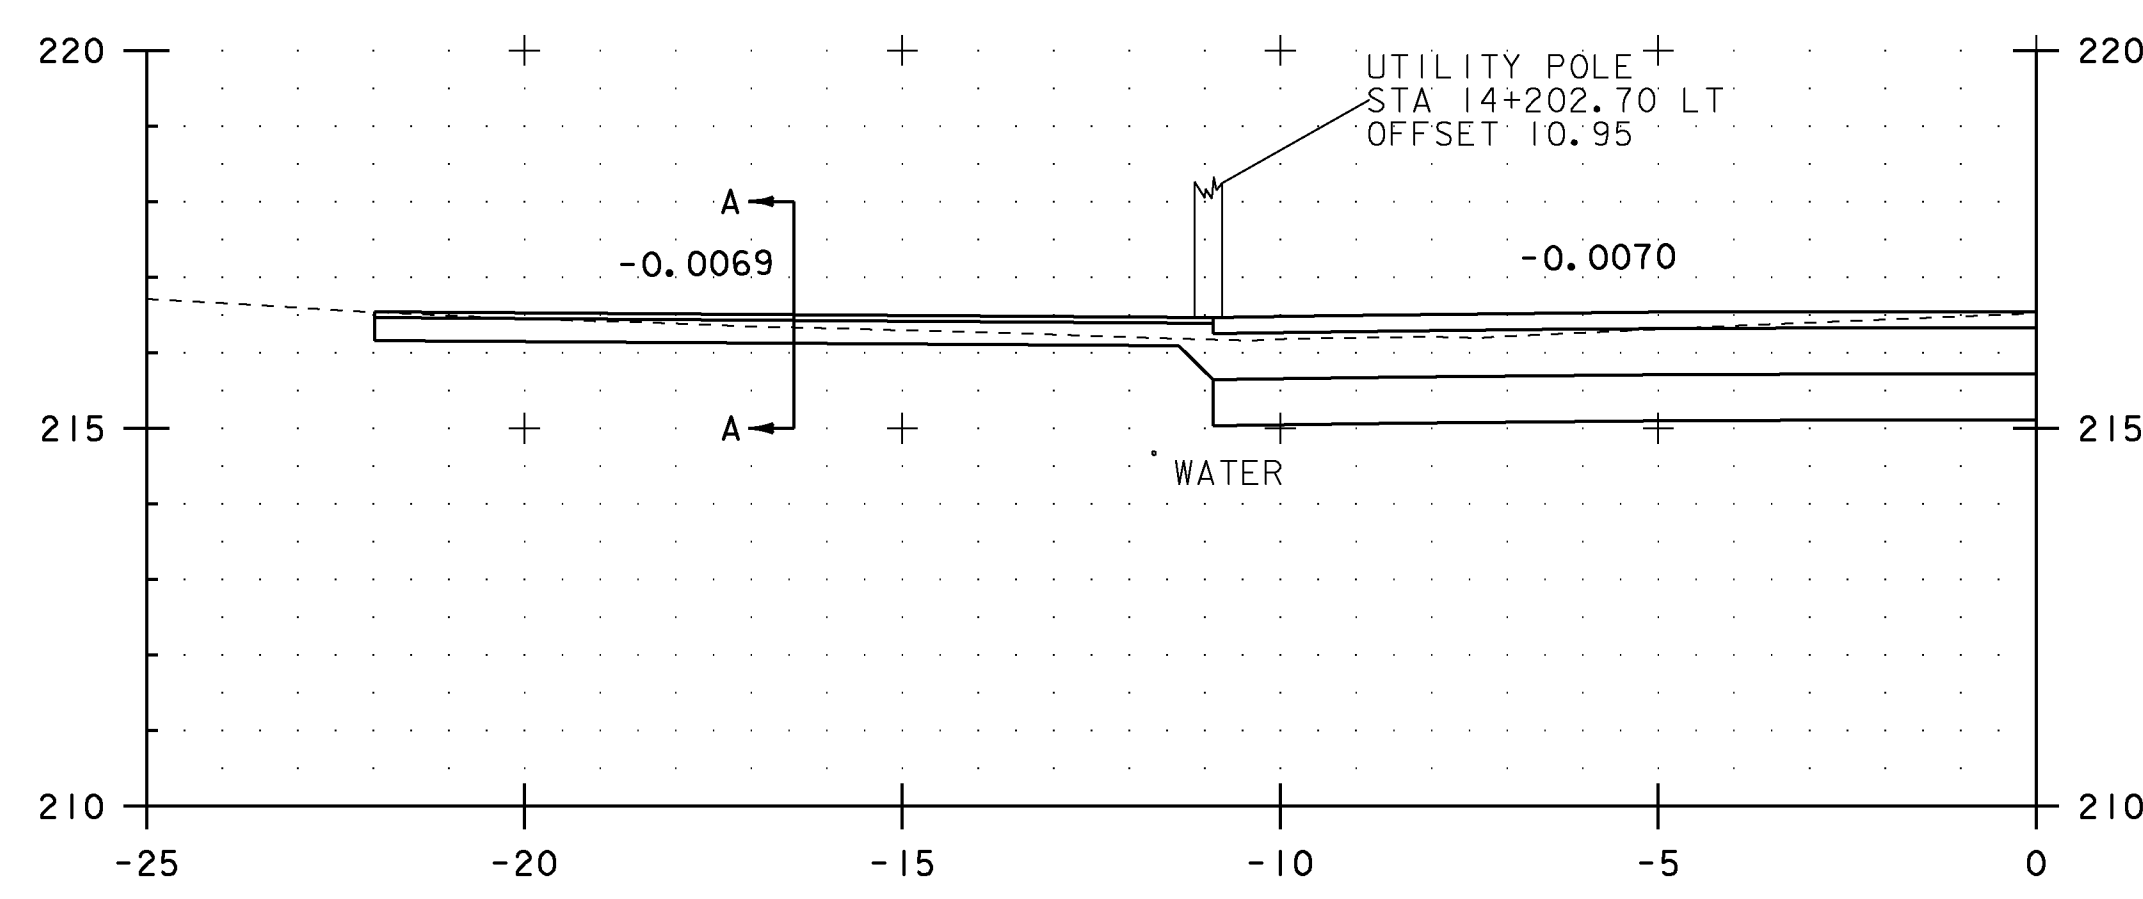

14+201.00
SKEWED 55° 56' 43.44"
GRAVEL DRIVE LT

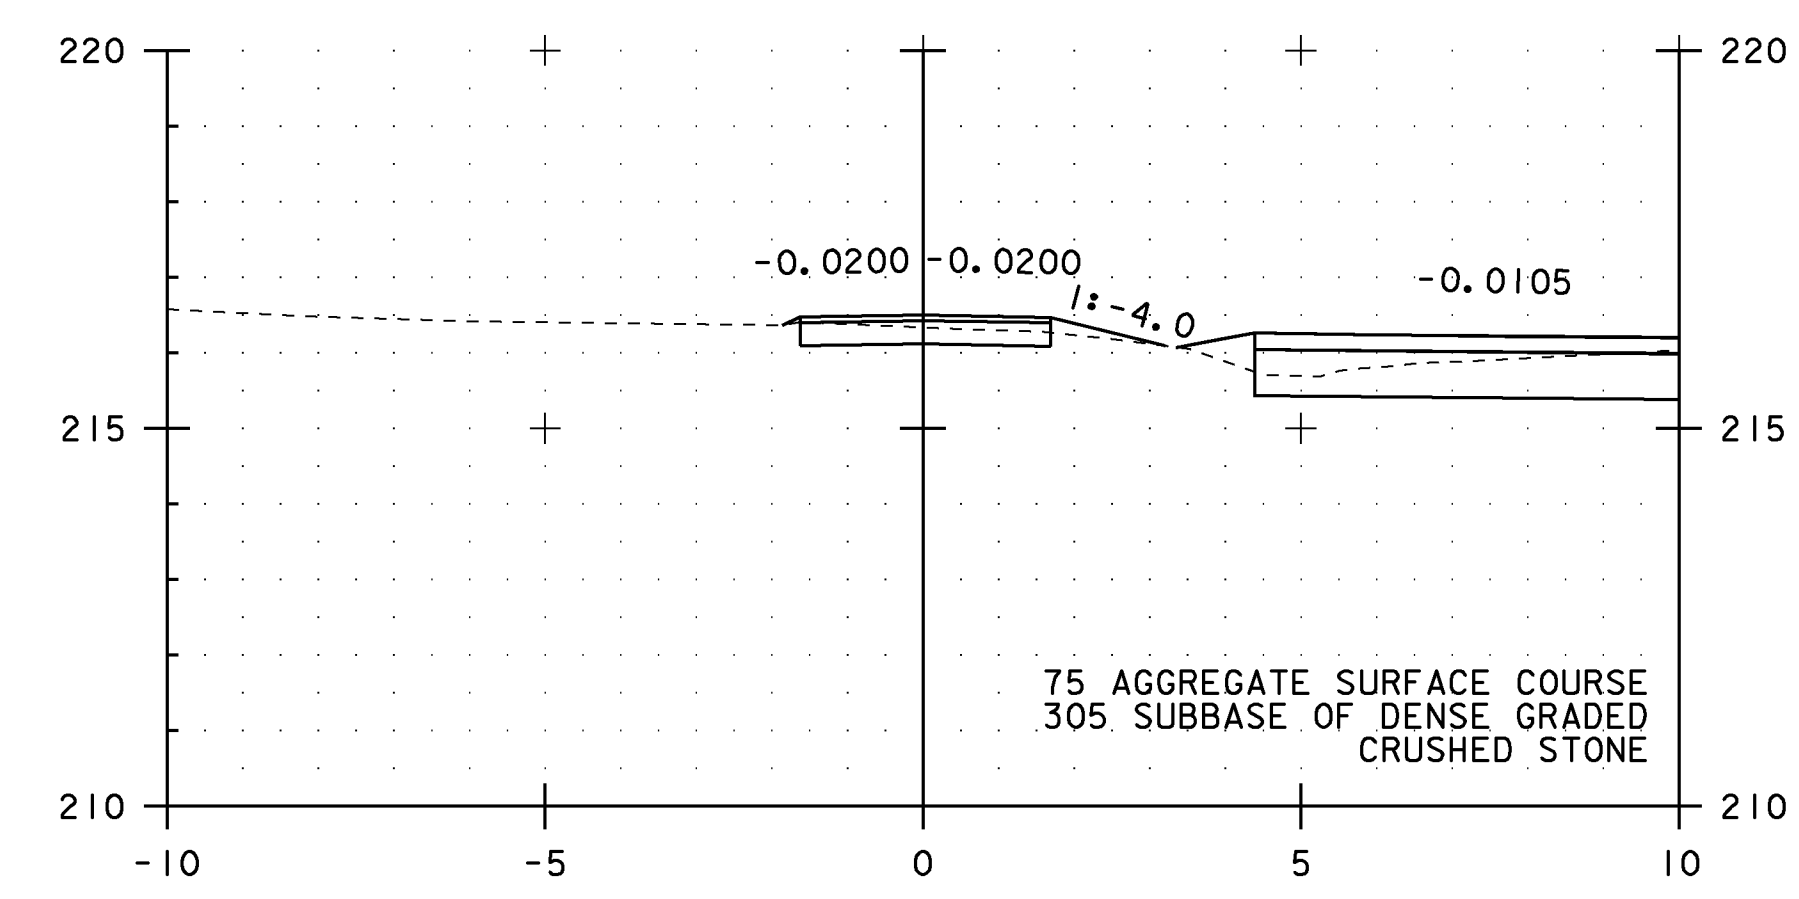

SECTION A-A

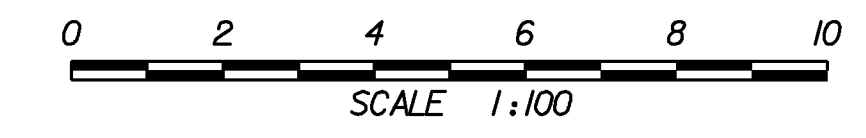




NOTES:

1. ALL BURIED UTILITIES ARE EXISTING, THE LOCATIONS ARE APPROXIMATE AND ARE TO REMAIN UNDISTURBED
2. DRAINAGE FEATURES DISPLAYED ON CROSS SECTIONS ARE PROJECTED. SEE DRAINAGE DETAIL SHEETS, LAYOUTS AND PROFILES FOR TRUE LOCATIONS

PROJECT NAME: EAST MONTPELIER
PROJECT NUMBER: STPG 028 - 3(35)S

FILE NAME: +98b028xsl.dgn
PROJECT LEADER: J. SCHULTZ
DESIGNED BY: J. GRUCHACZ
VT ROUTE 14 CROSS SECTION SHEET 9

PLOT DATE: 22-MAR-2010
DRAWN BY: D. LYMAN
CHECKED BY: J. DEVLIN
SHEET 124 OF 142

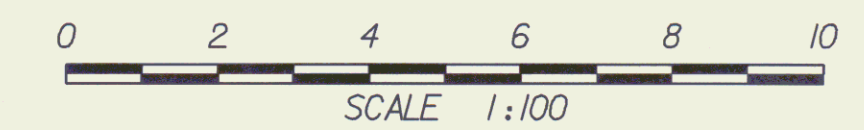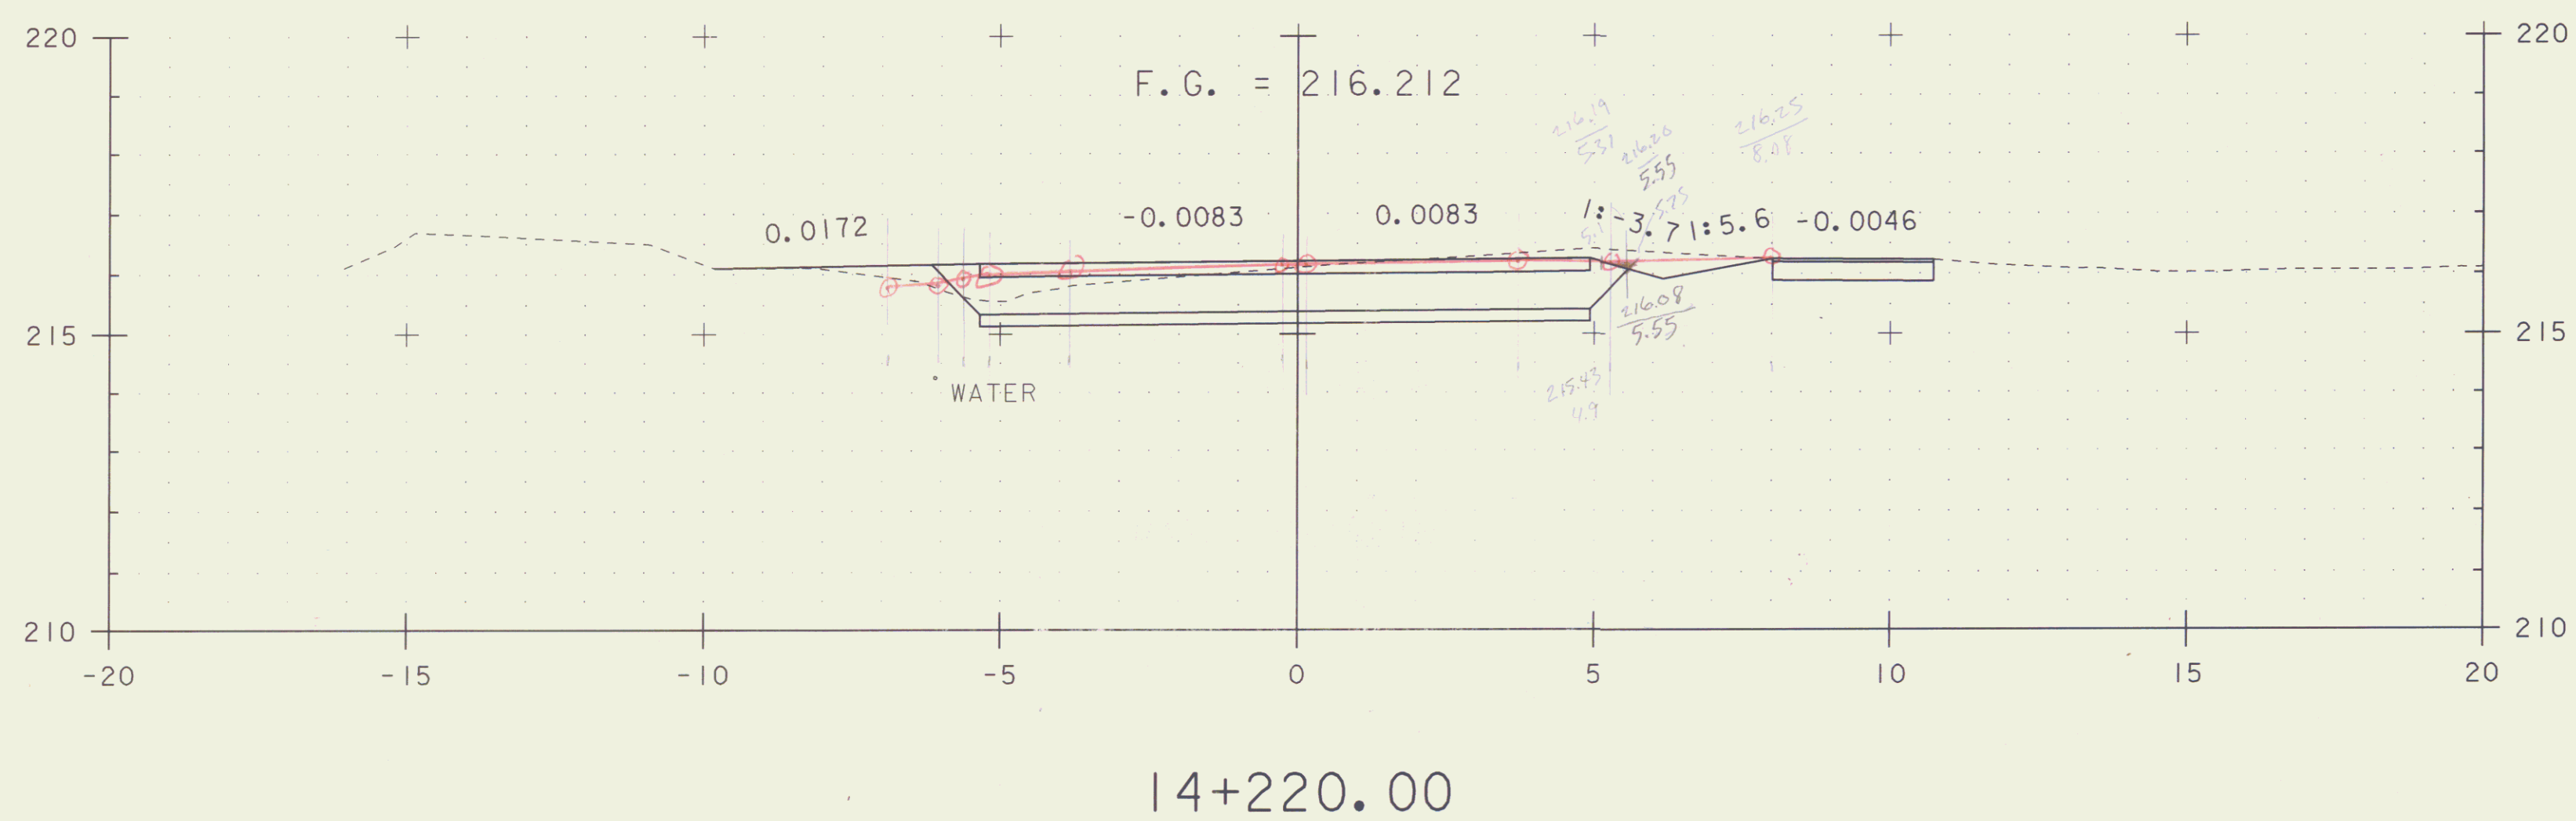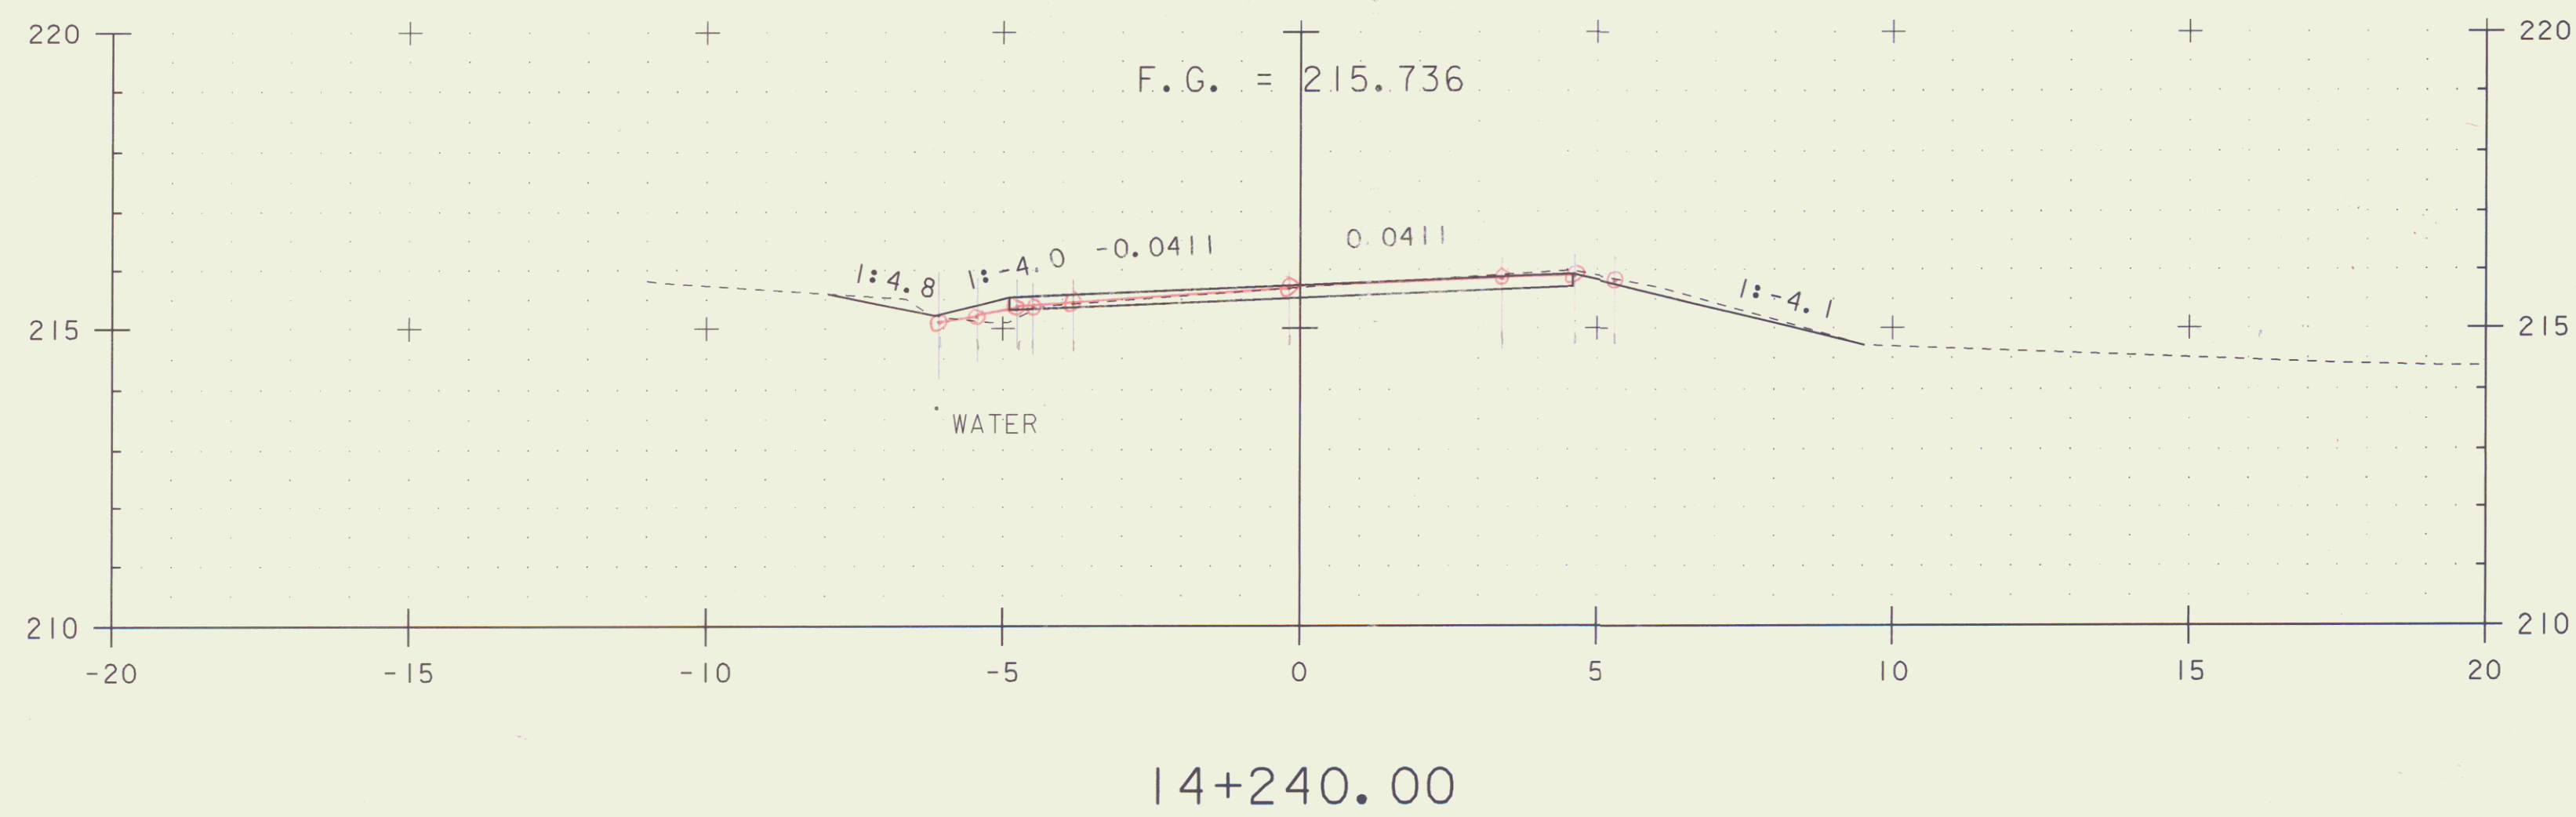


NOTES:

1. ALL BURIED UTILITIES ARE EXISTING, THE LOCATIONS ARE APPROXIMATE AND ARE TO REMAIN UNDISTURBED
2. DRAINAGE FEATURES DISPLAYED ON CROSS SECTIONS ARE PROJECTED. SEE DRAINAGE DETAIL SHEETS, LAYOUTS AND PROFILES FOR TRUE LOCATIONS


STA. 14+220 TO STA. 14+240

PROJECT NAME: EAST MONTPELIER
 PROJECT NUMBER: STPG 028 - 3(35)S


FILE NAME: +98b028xsl.dgn PLOT DATE: 22-MAR-2010
 PROJECT LEADER: J. SCHULTZ DRAWN BY: D. LYMAN
 DESIGNED BY: J. GRUCHACZ CHECKED BY: J. DEVLIN
 VT ROUTE 14 CROSS SECTION SHEET 10 SHEET 125 OF 142

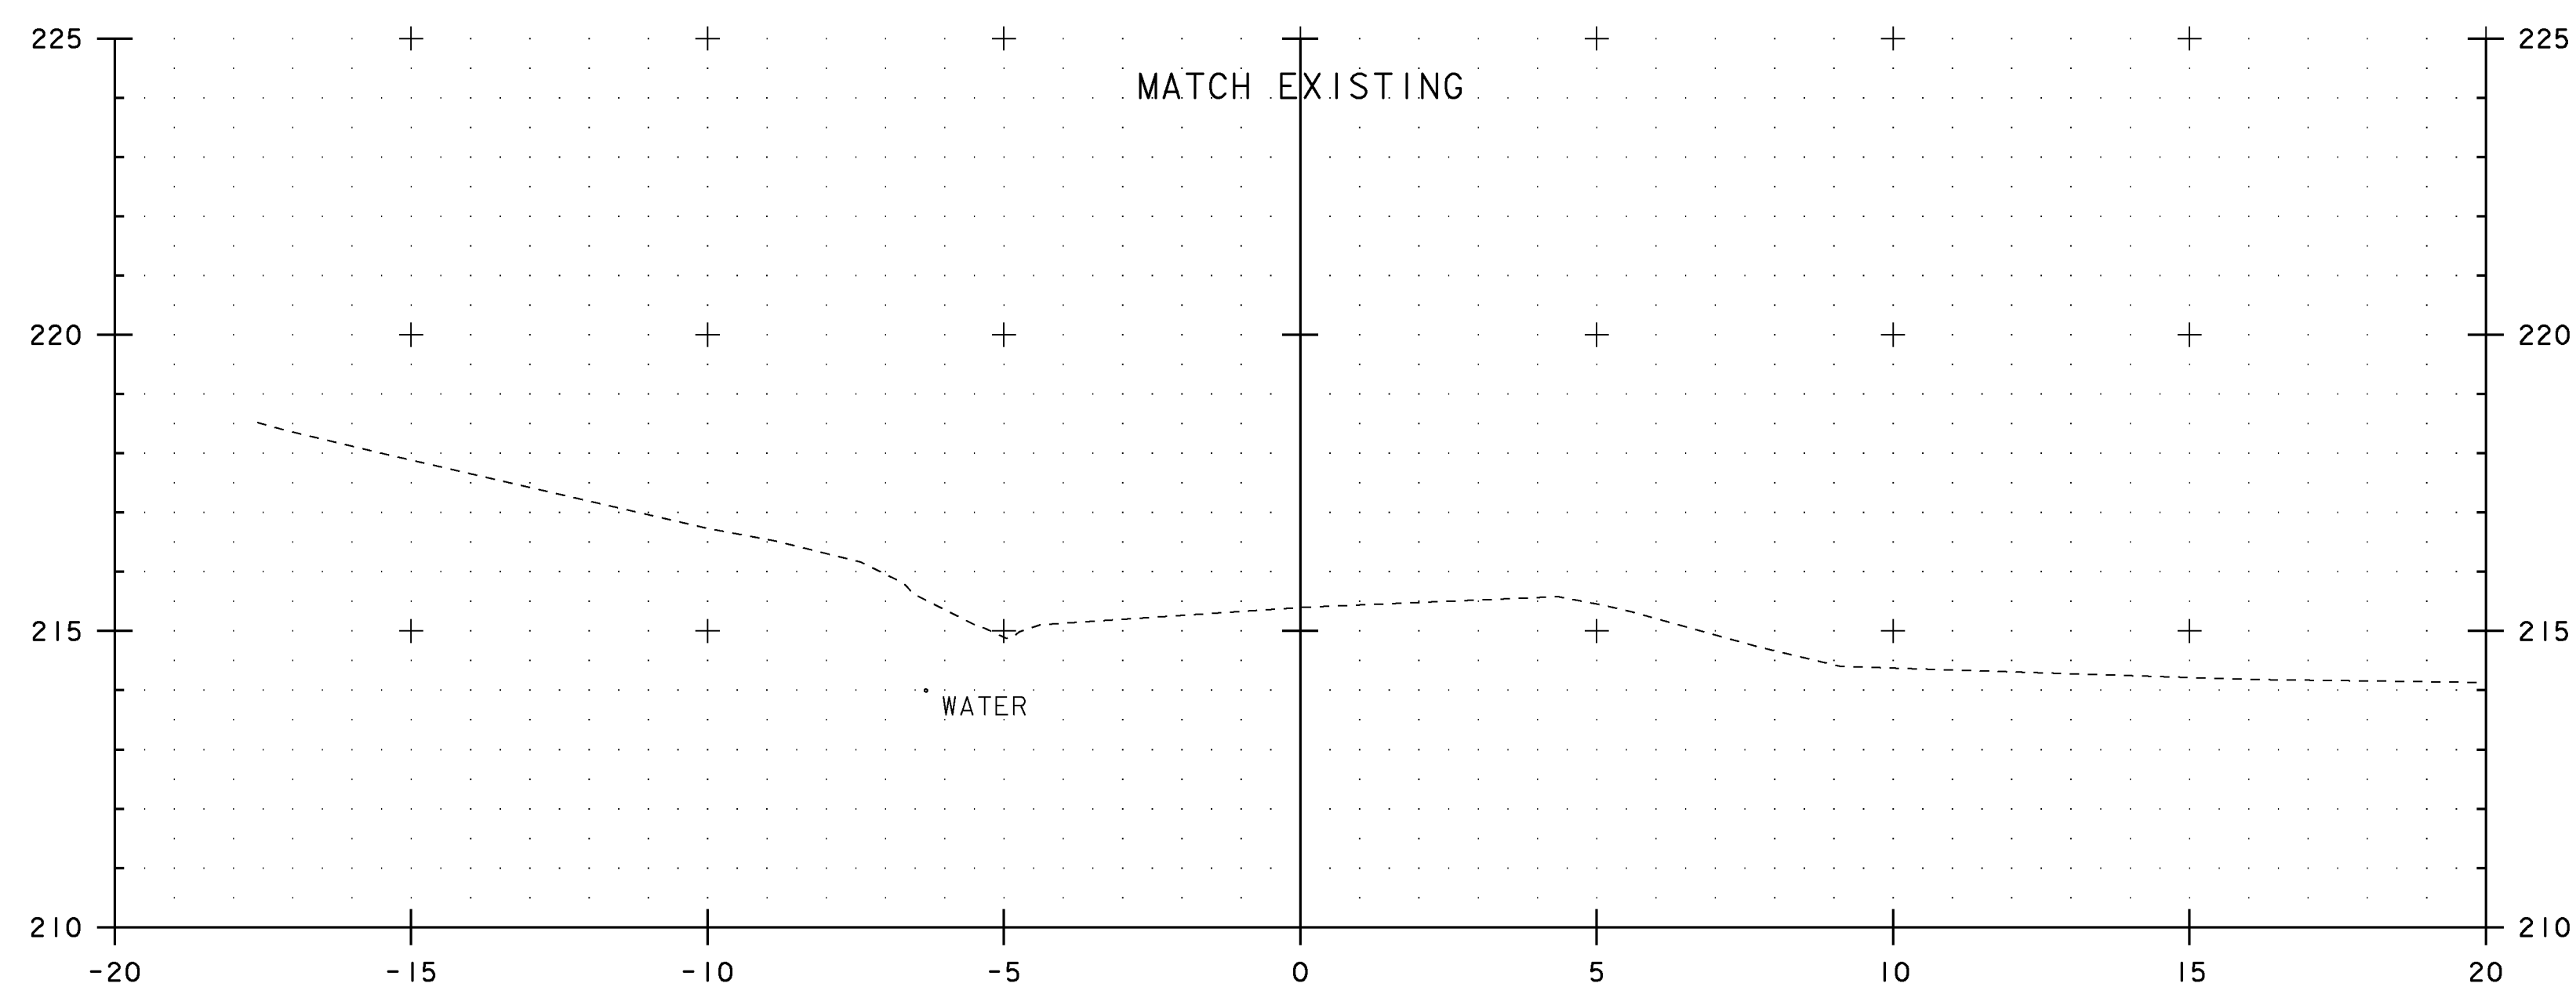

14+255.00
END APPROACH

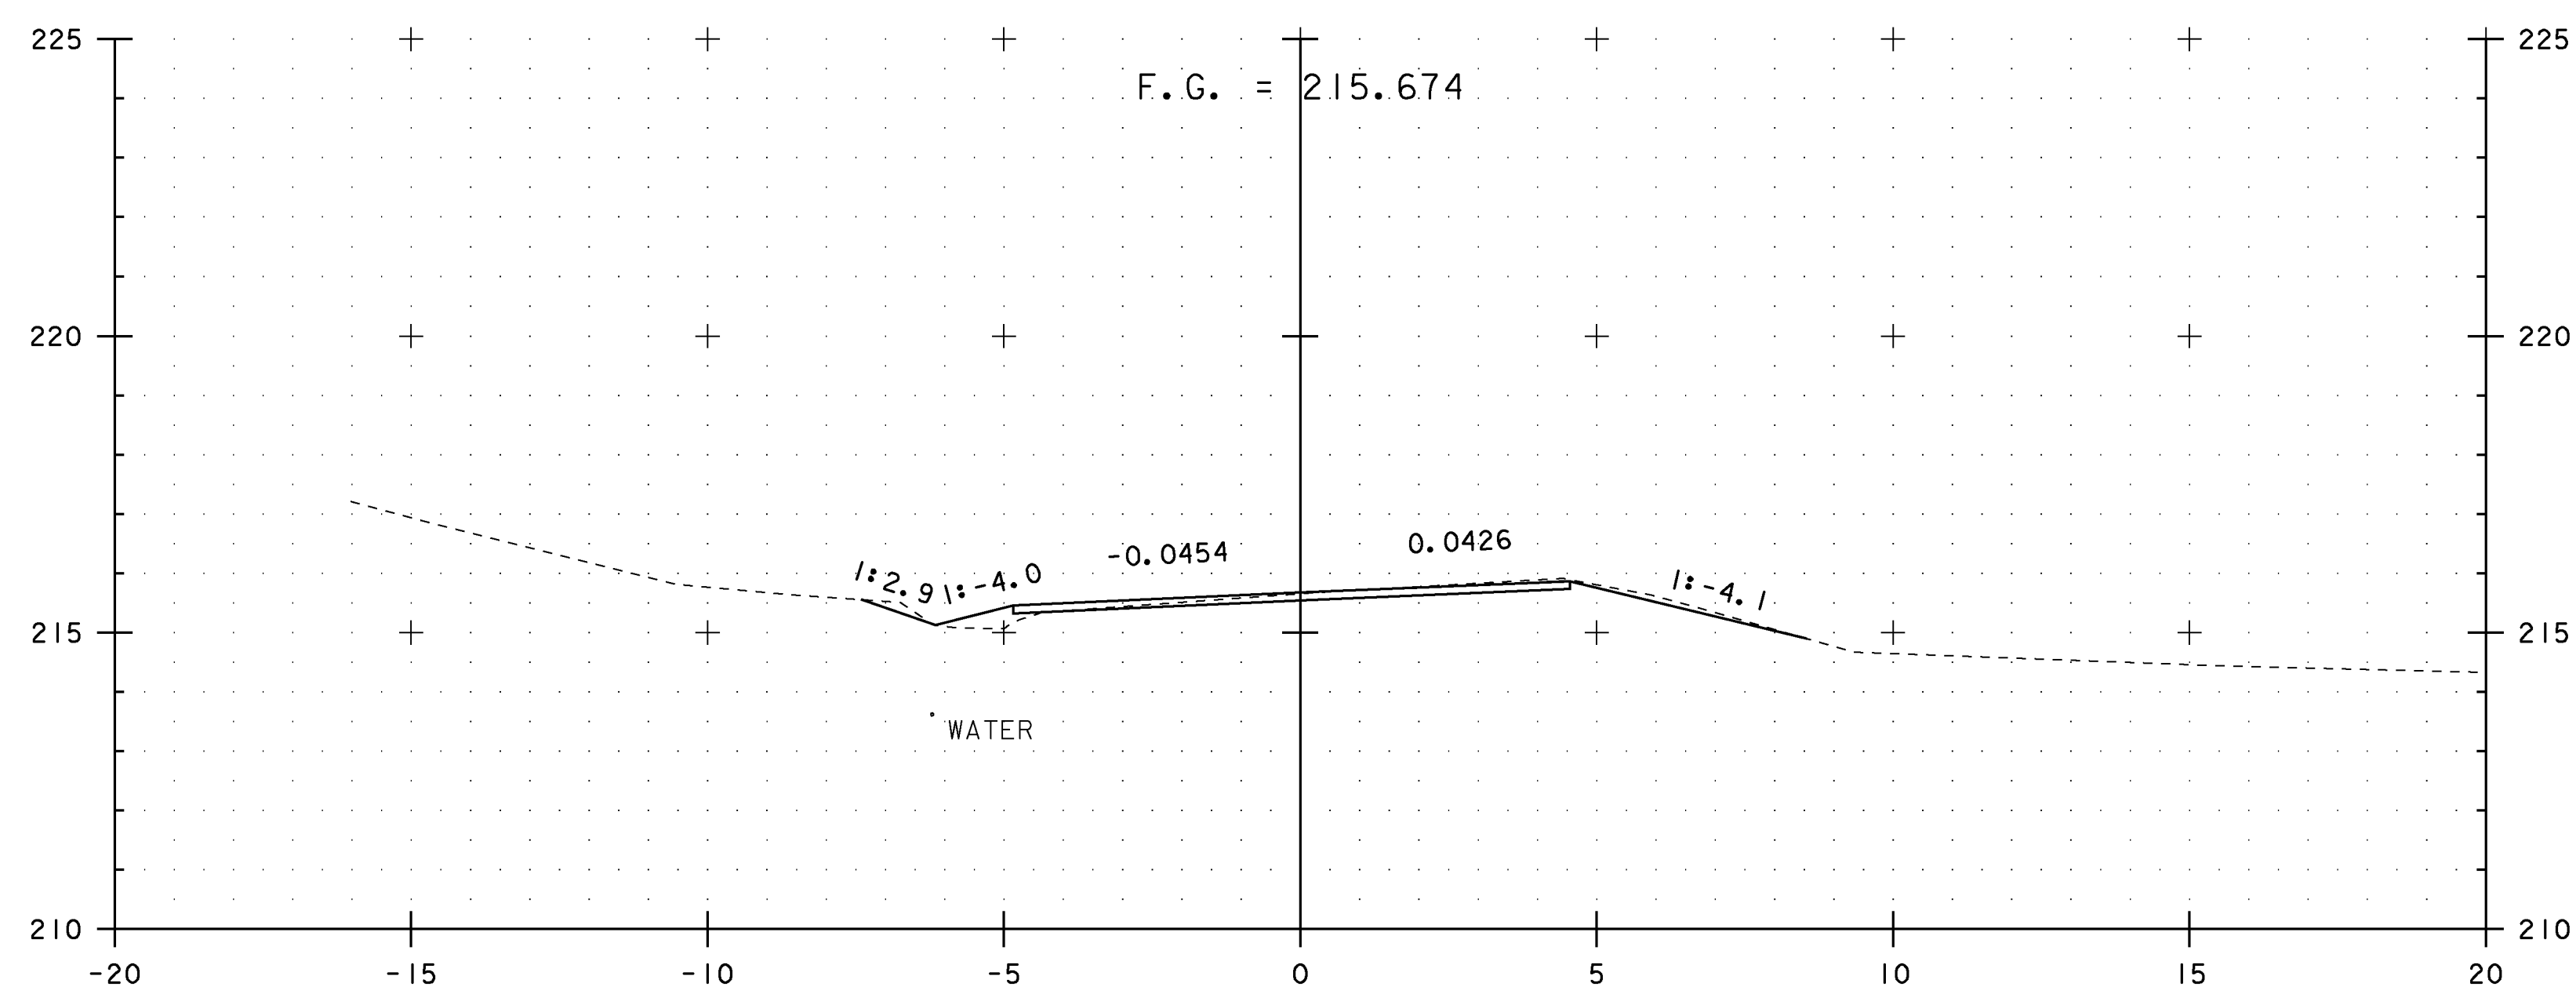

PC 14+242.60

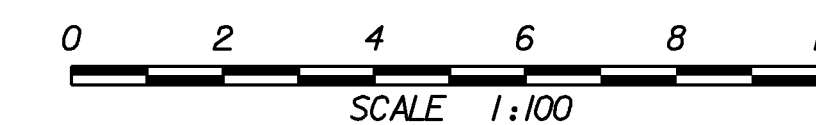




NOTES:

1. ALL BURIED UTILITIES ARE EXISTING, THE LOCATIONS ARE APPROXIMATE AND ARE TO REMAIN UNDISTURBED
2. DRAINAGE FEATURES DISPLAYED ON CROSS SECTIONS ARE PROJECTED. SEE DRAINAGE DETAIL SHEETS, LAYOUTS AND PROFILES FOR TRUE LOCATIONS

PROJECT NAME: EAST MONTPELIER
PROJECT NUMBER: STPG 028 - 3(35)S

FILE NAME: +98b028xsl.dgn	PLOT DATE: 22-MAR-2010
PROJECT LEADER: J. SCHULTZ	DRAWN BY: D. LYMAN
DESIGNED BY: J. GRUCHACZ	CHECKED BY: J. DEVLIN
VT ROUTE 14 CROSS SECTION SHEET II	SHEET 126 OF 142

STA. 14+242.60 TO STA. 14+255

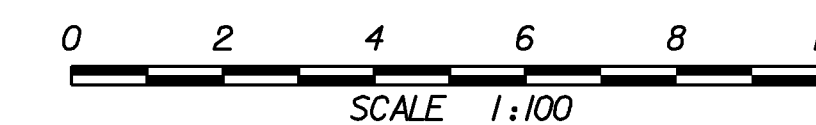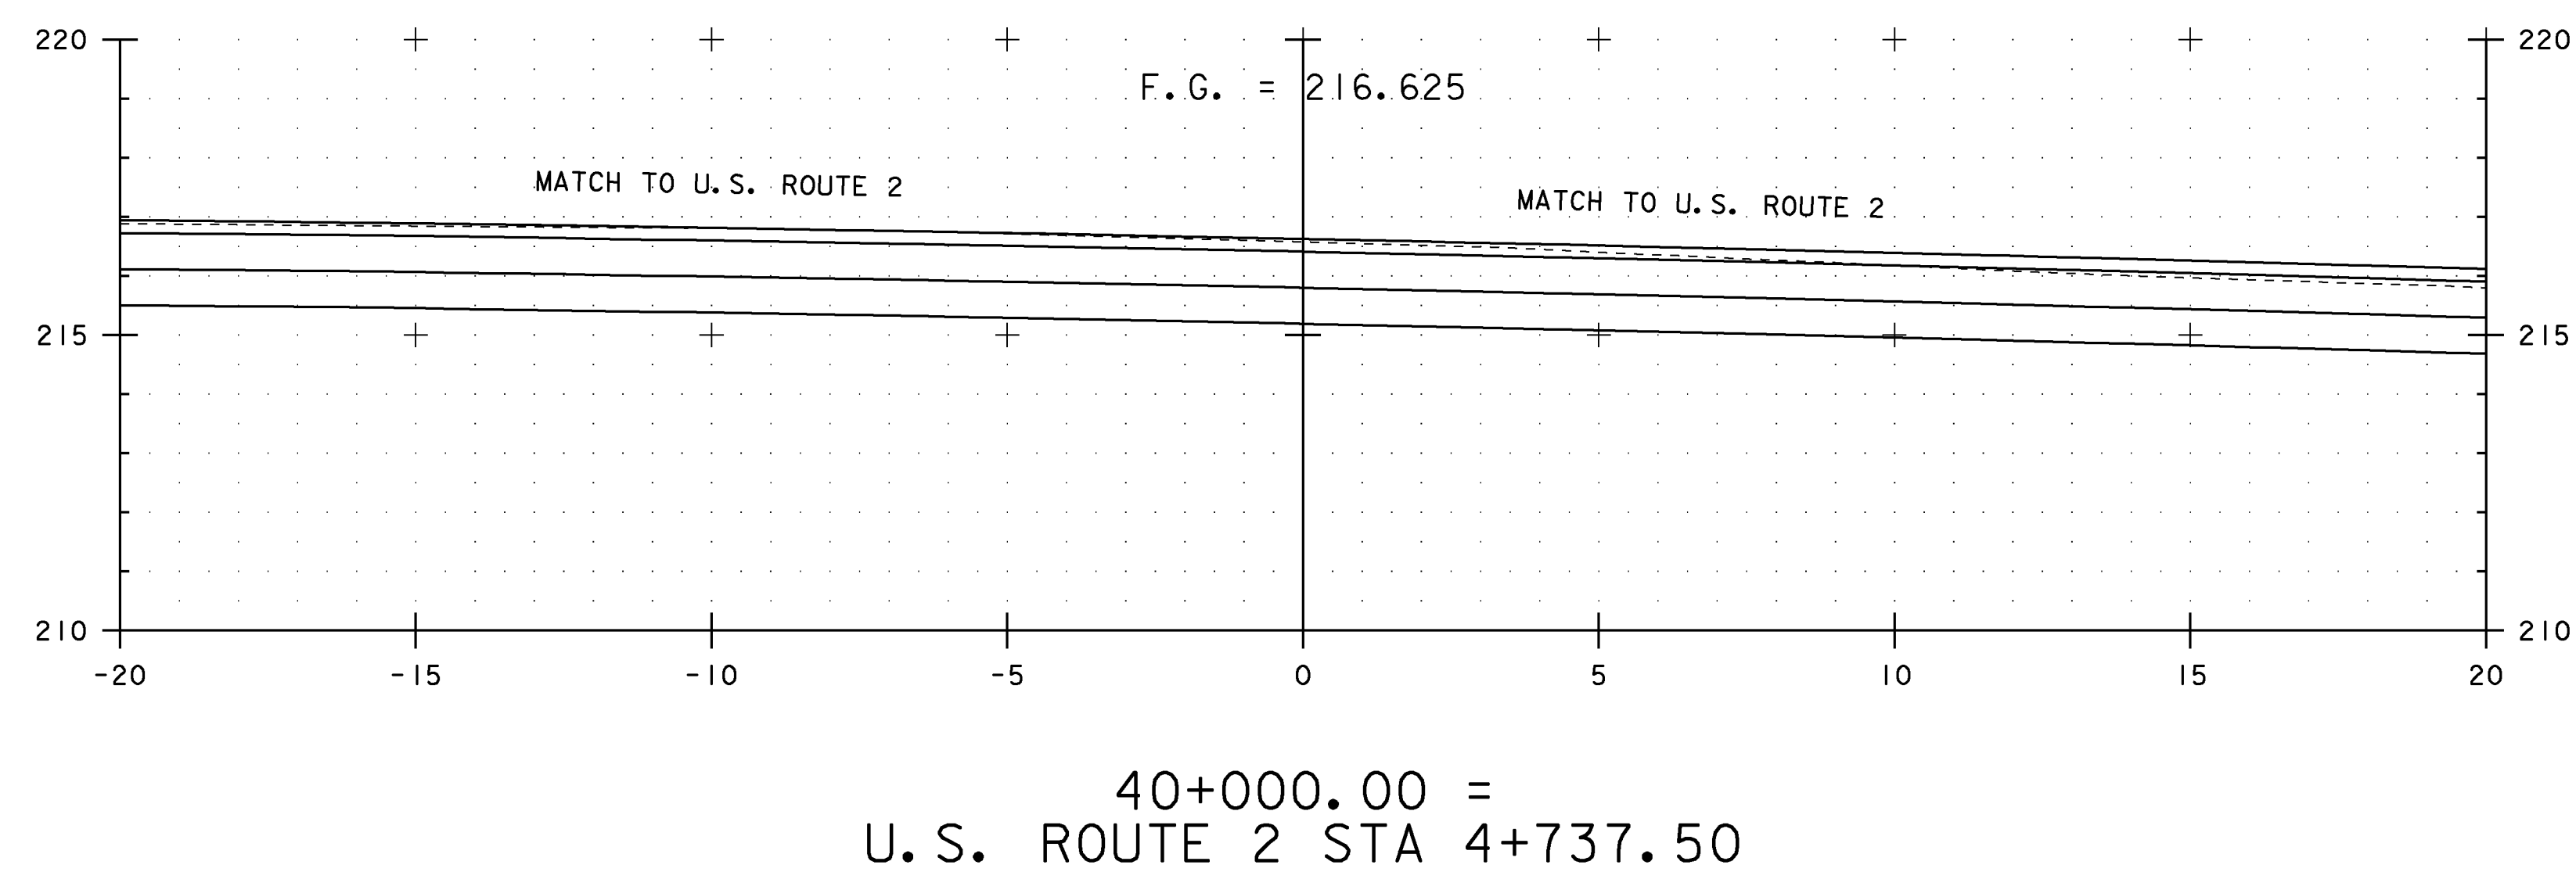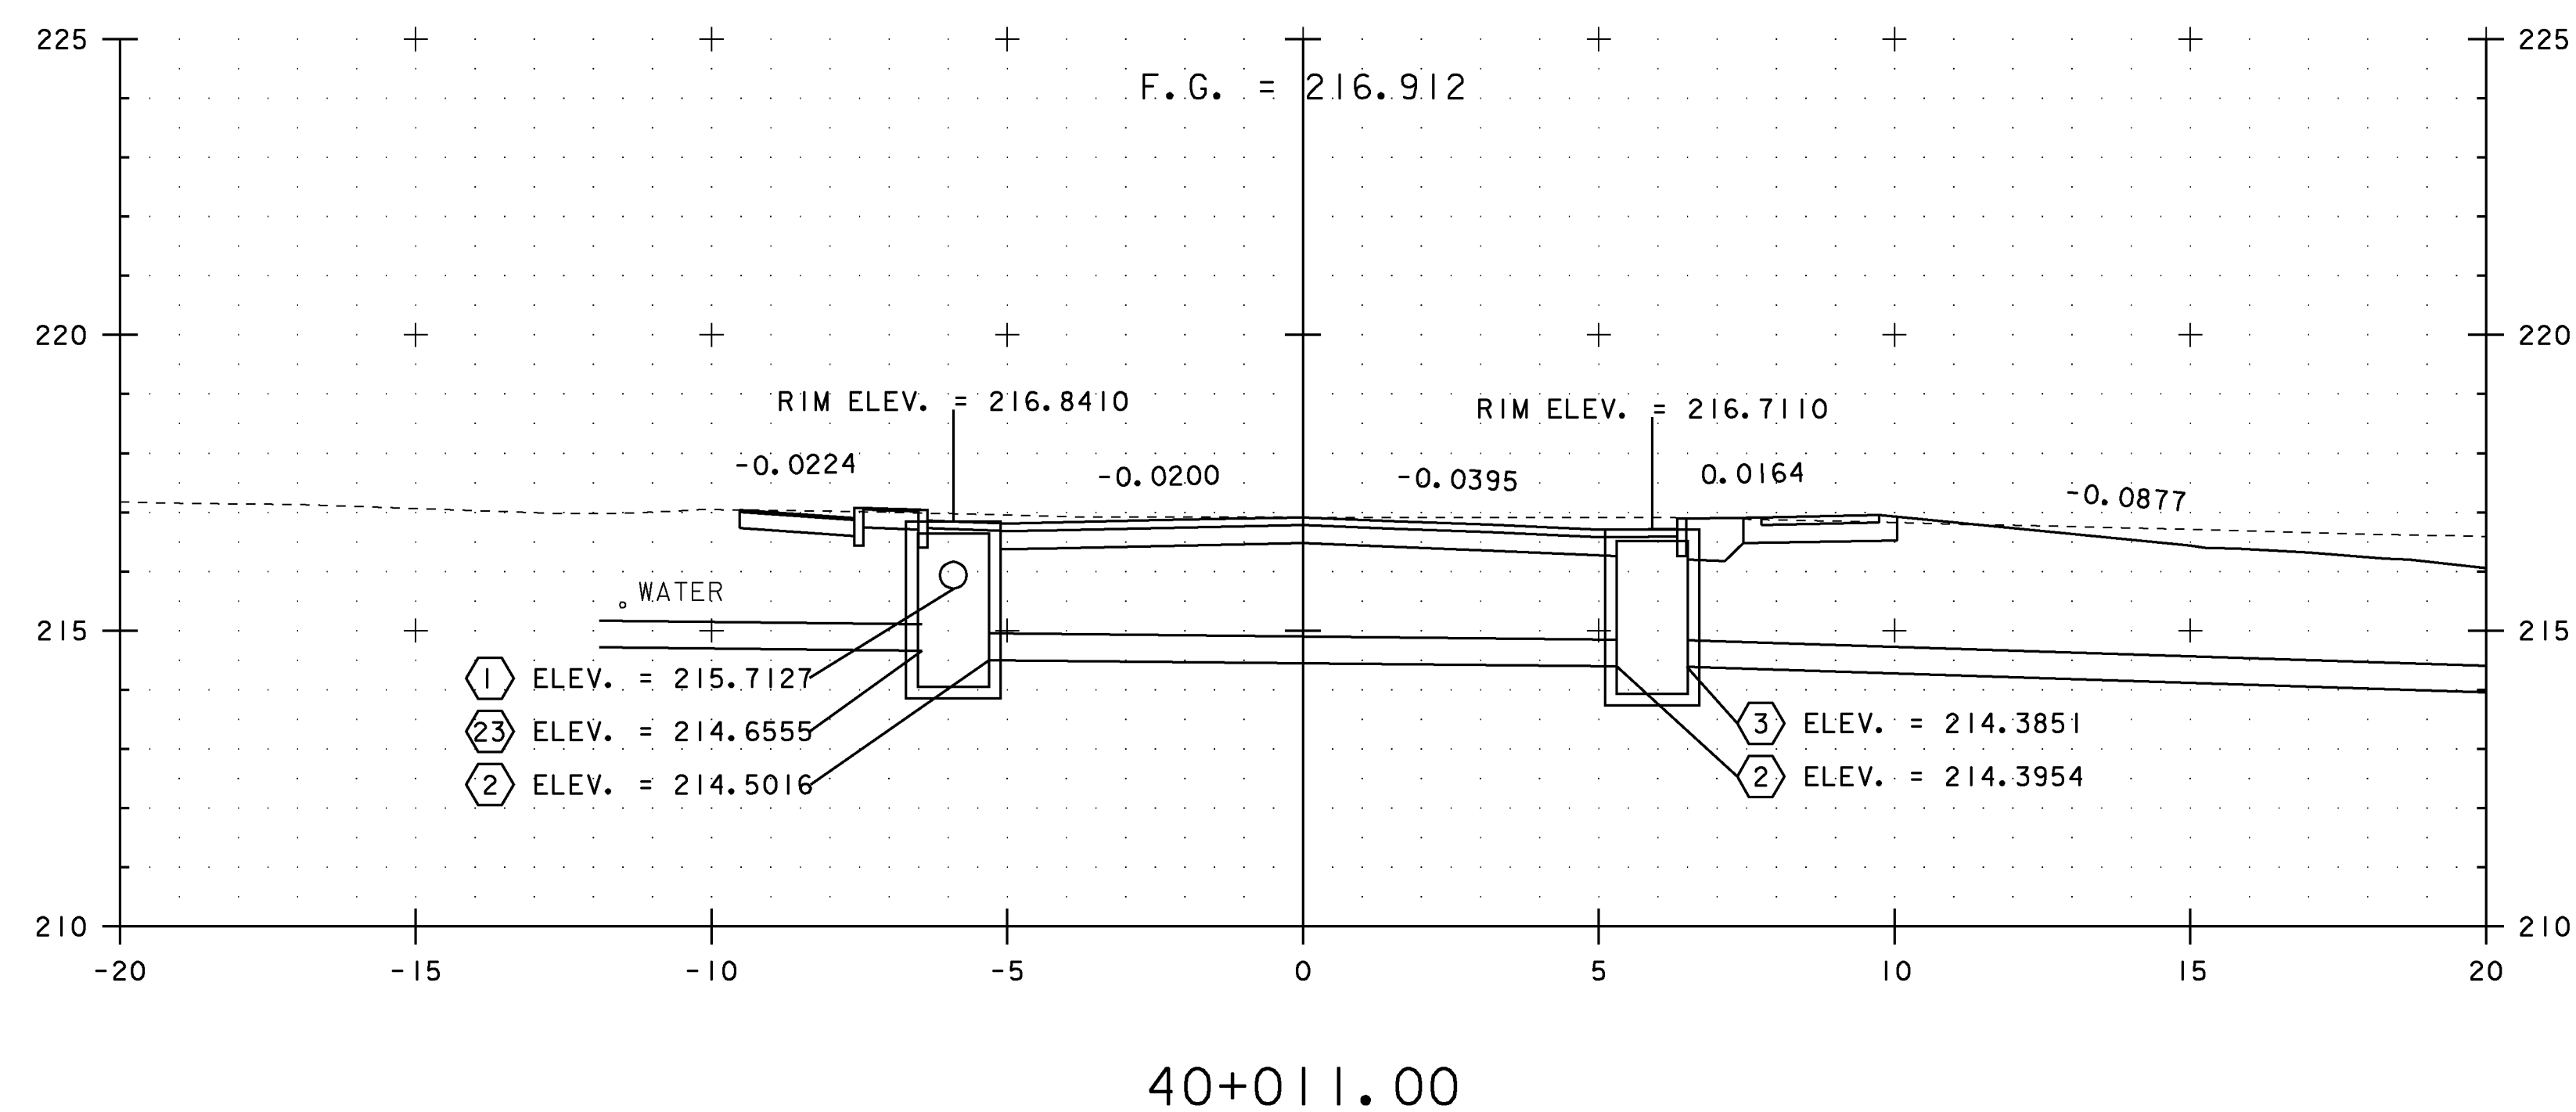


NOTES:

1. ALL BURIED UTILITIES ARE EXISTING, THE LOCATIONS ARE APPROXIMATE AND ARE TO REMAIN UNDISTURBED
2. DRAINAGE FEATURES DISPLAYED ON CROSS SECTIONS ARE PROJECTED. SEE DRAINAGE DETAIL SHEETS, LAYOUTS AND PROFILES FOR TRUE LOCATIONS


STA. 40+000 TO STA. 40+011

PROJECT NAME: EAST MONTPELIER
 PROJECT NUMBER: STPG 028 - 3(35)S


FILE NAME: +98b028xsl.dgn PLOT DATE: 22-MAR-2010
 PROJECT LEADER: J. SCHULTZ DRAWN BY: D. LYMAN
 DESIGNED BY: J. GRUCHACZ CHECKED BY: J. DEVLIN
 QUAKER HILL ROAD CROSS SECTION SHEET 1 SHEET 127 OF 142

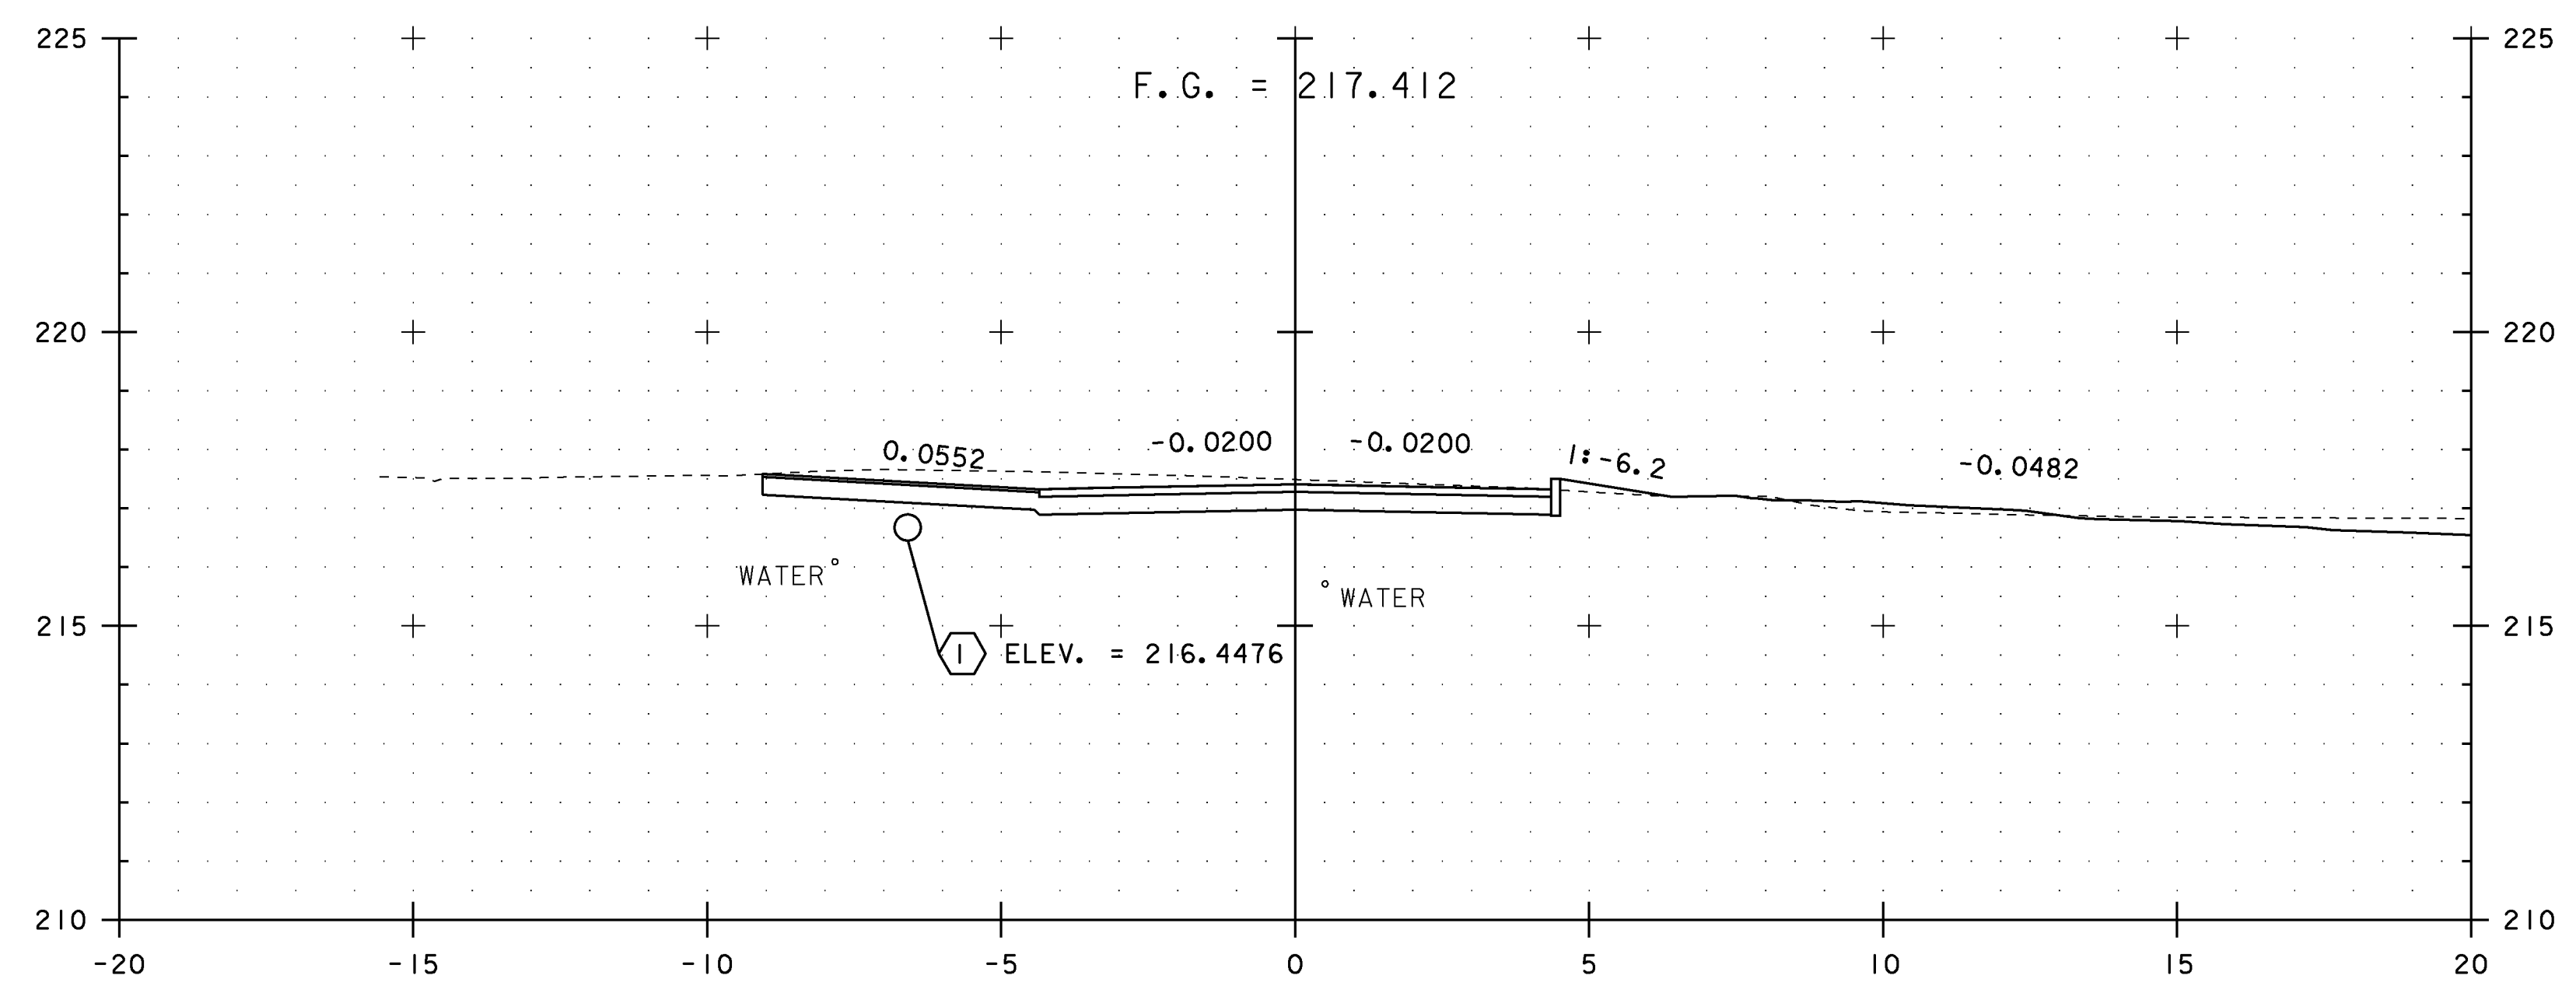

40+019.00

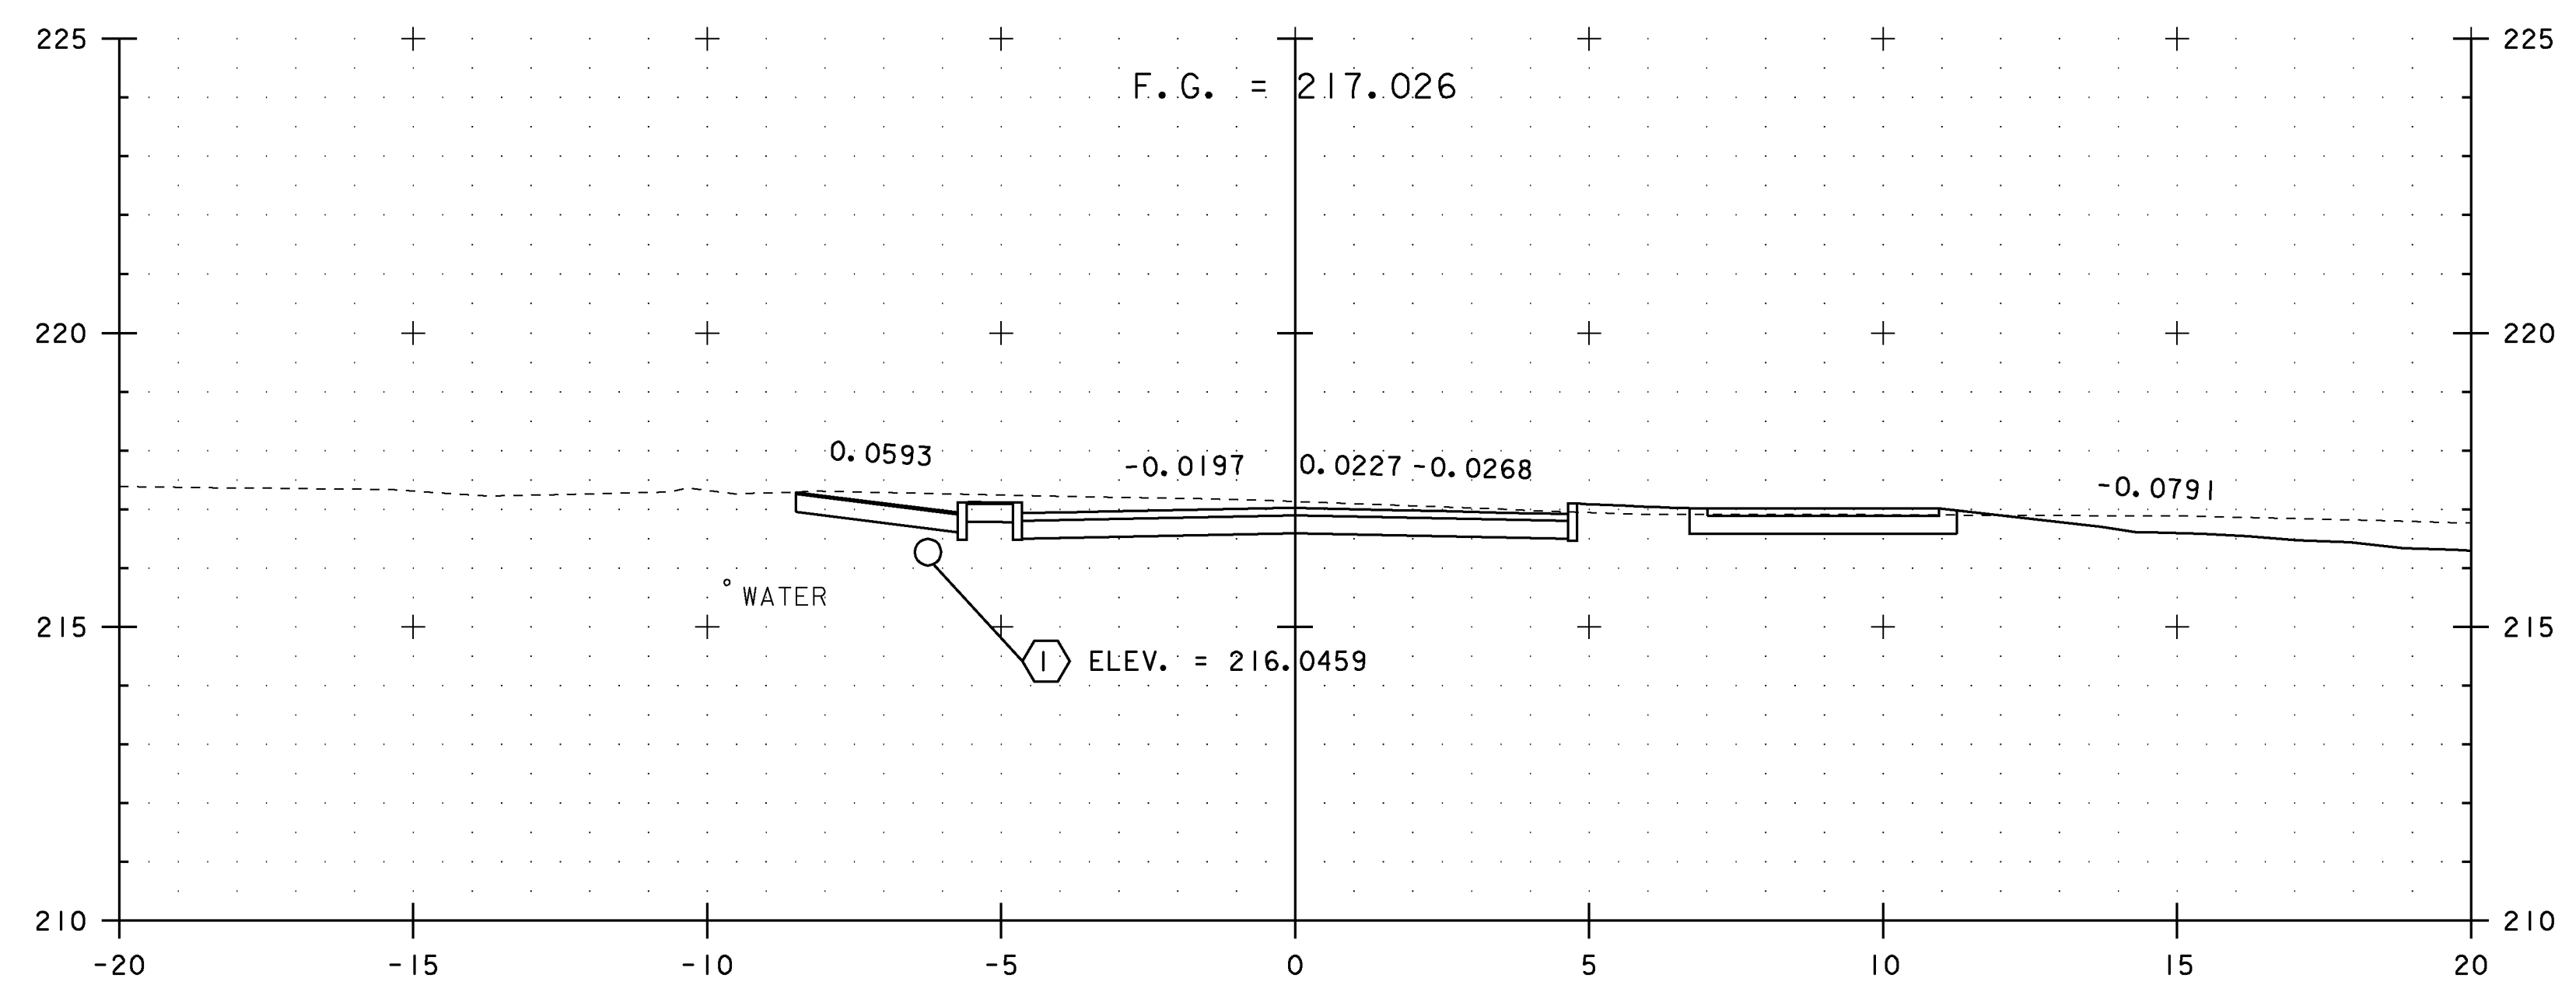

40+015.00

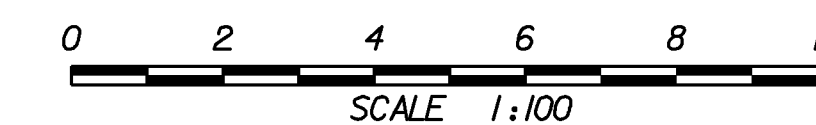


NOTES:

1. ALL BURIED UTILITIES ARE EXISTING, THE LOCATIONS ARE APPROXIMATE AND ARE TO REMAIN UNDISTURBED
2. DRAINAGE FEATURES DISPLAYED ON CROSS SECTIONS ARE PROJECTED. SEE DRAINAGE DETAIL SHEETS, LAYOUTS AND PROFILES FOR TRUE LOCATIONS


PROJECT NAME: EAST MONTEPELIER
 PROJECT NUMBER: STPG 028 - 3(35)S

FILE NAME: +98b028xsl.dgn PLOT DATE: 22-MAR-2010
 PROJECT LEADER: J. SCHULTZ DRAWN BY: D. LYMAN
 DESIGNED BY: J. GRUCHACZ CHECKED BY: J. DEVLIN
 QUAKER HILL ROAD CROSS SECTION SHEET 2 SHEET 128 OF 142


STA. 40+015 TO STA. 40+019

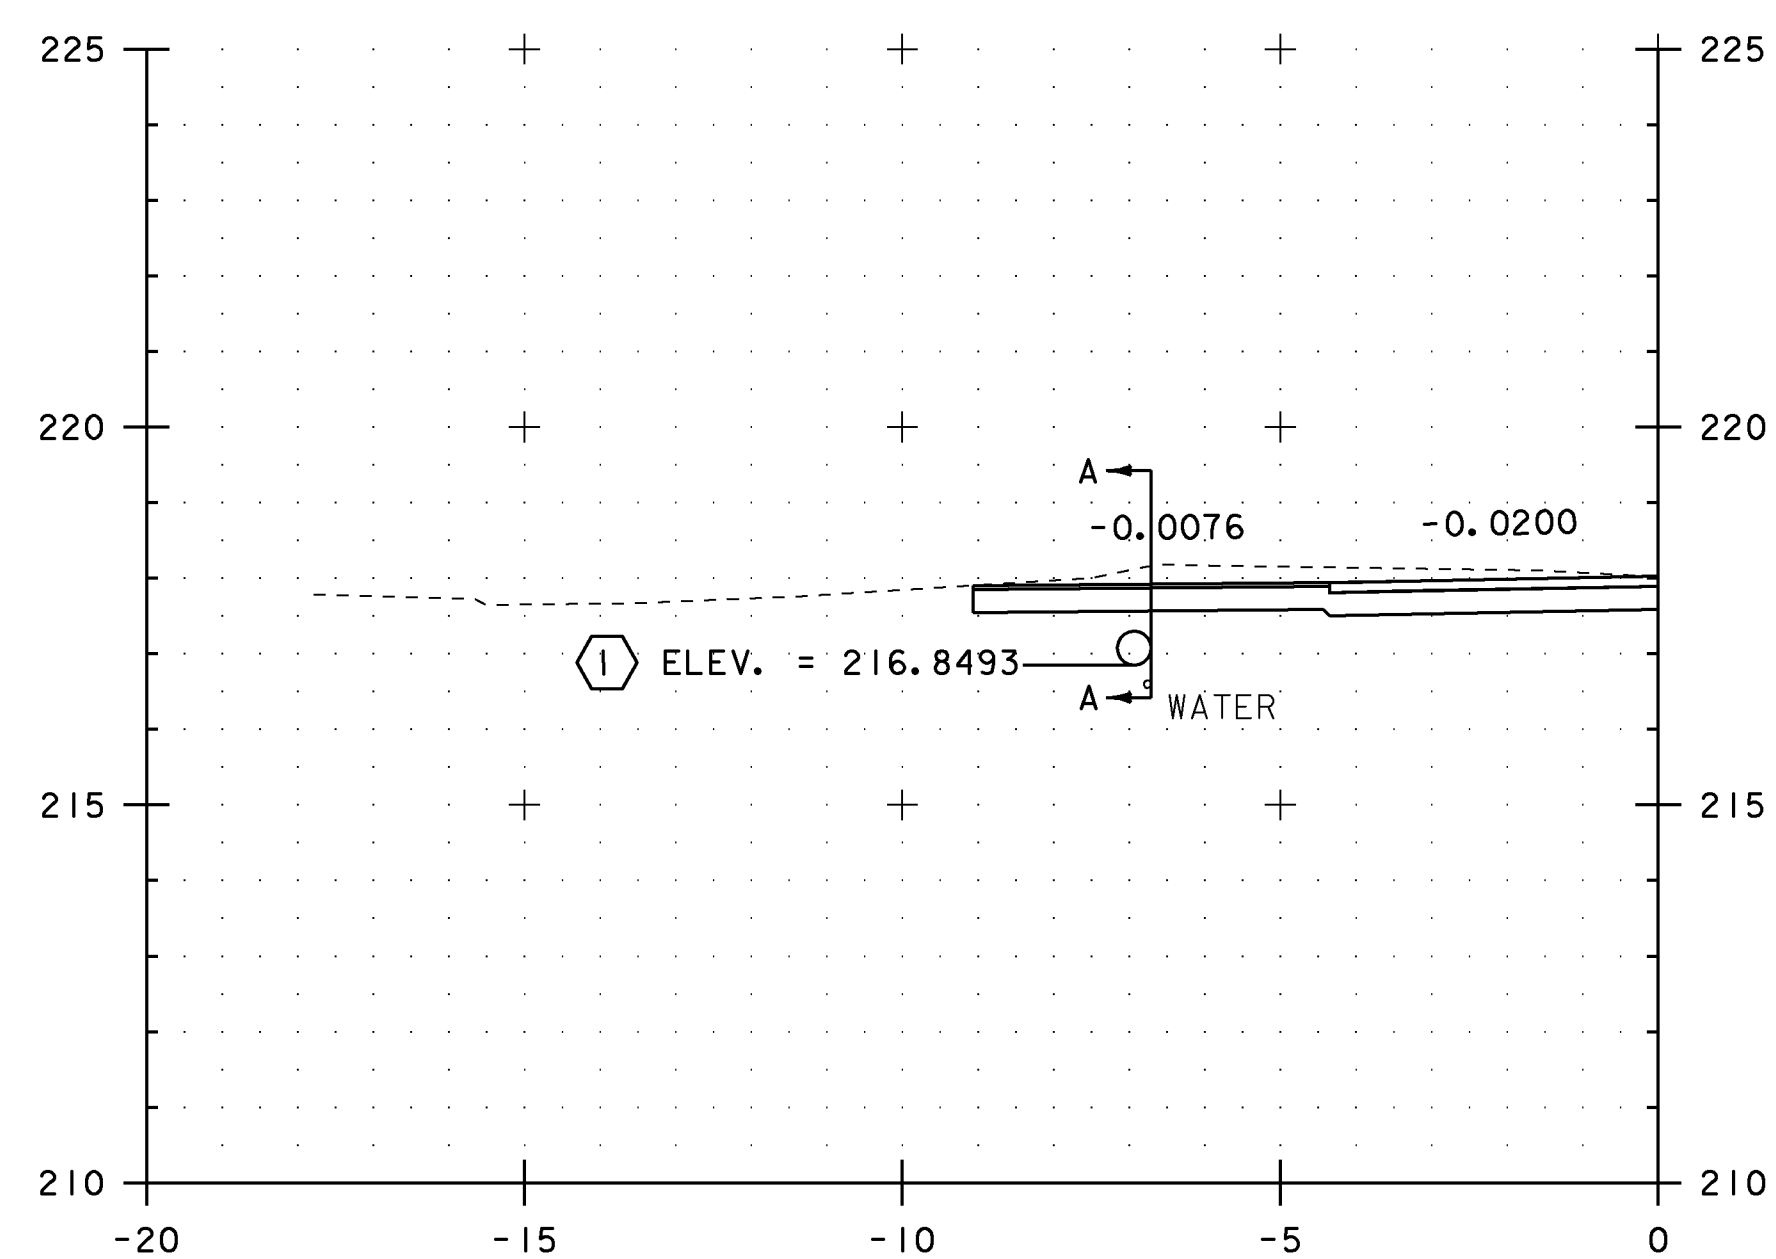


40+023.00
PAVED DRIVE LT

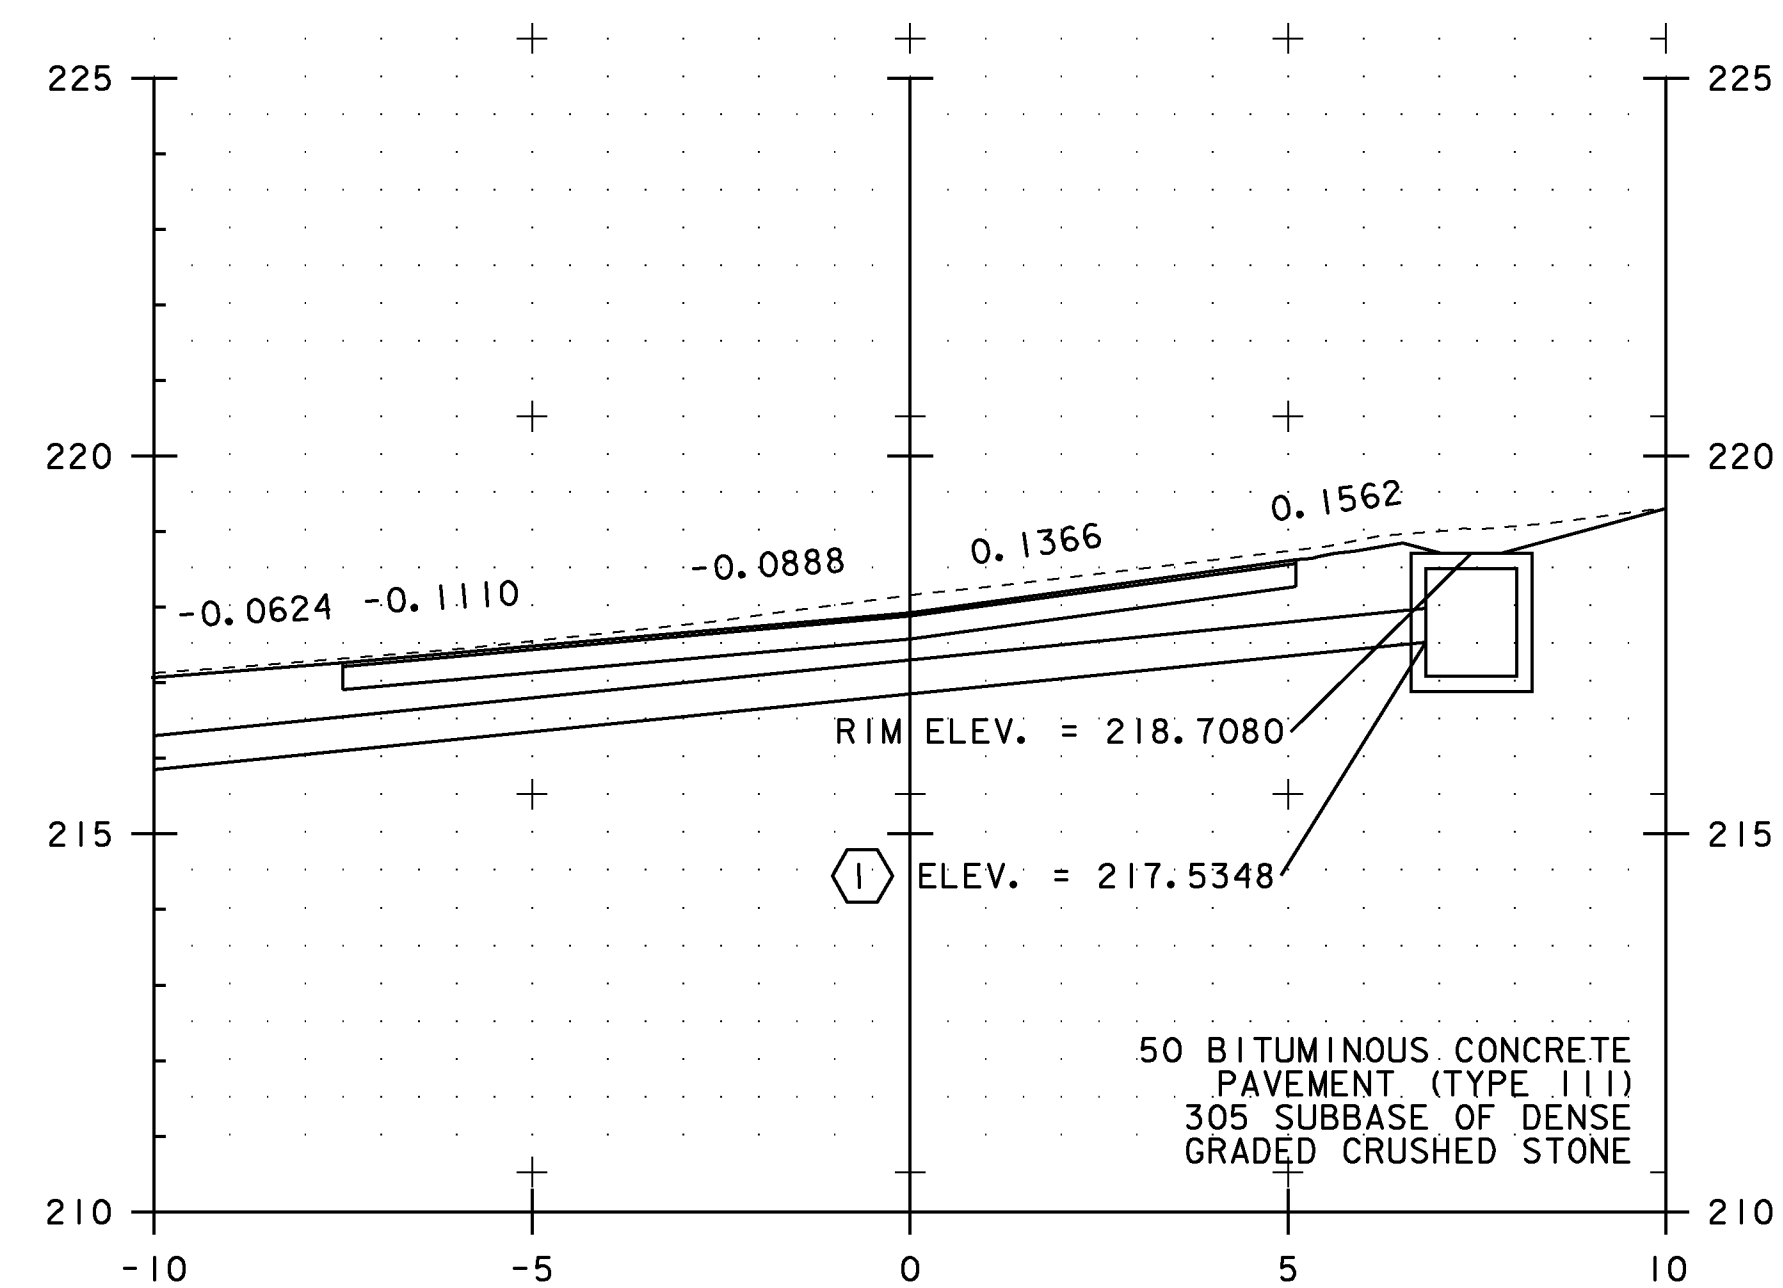

SECTION A-A

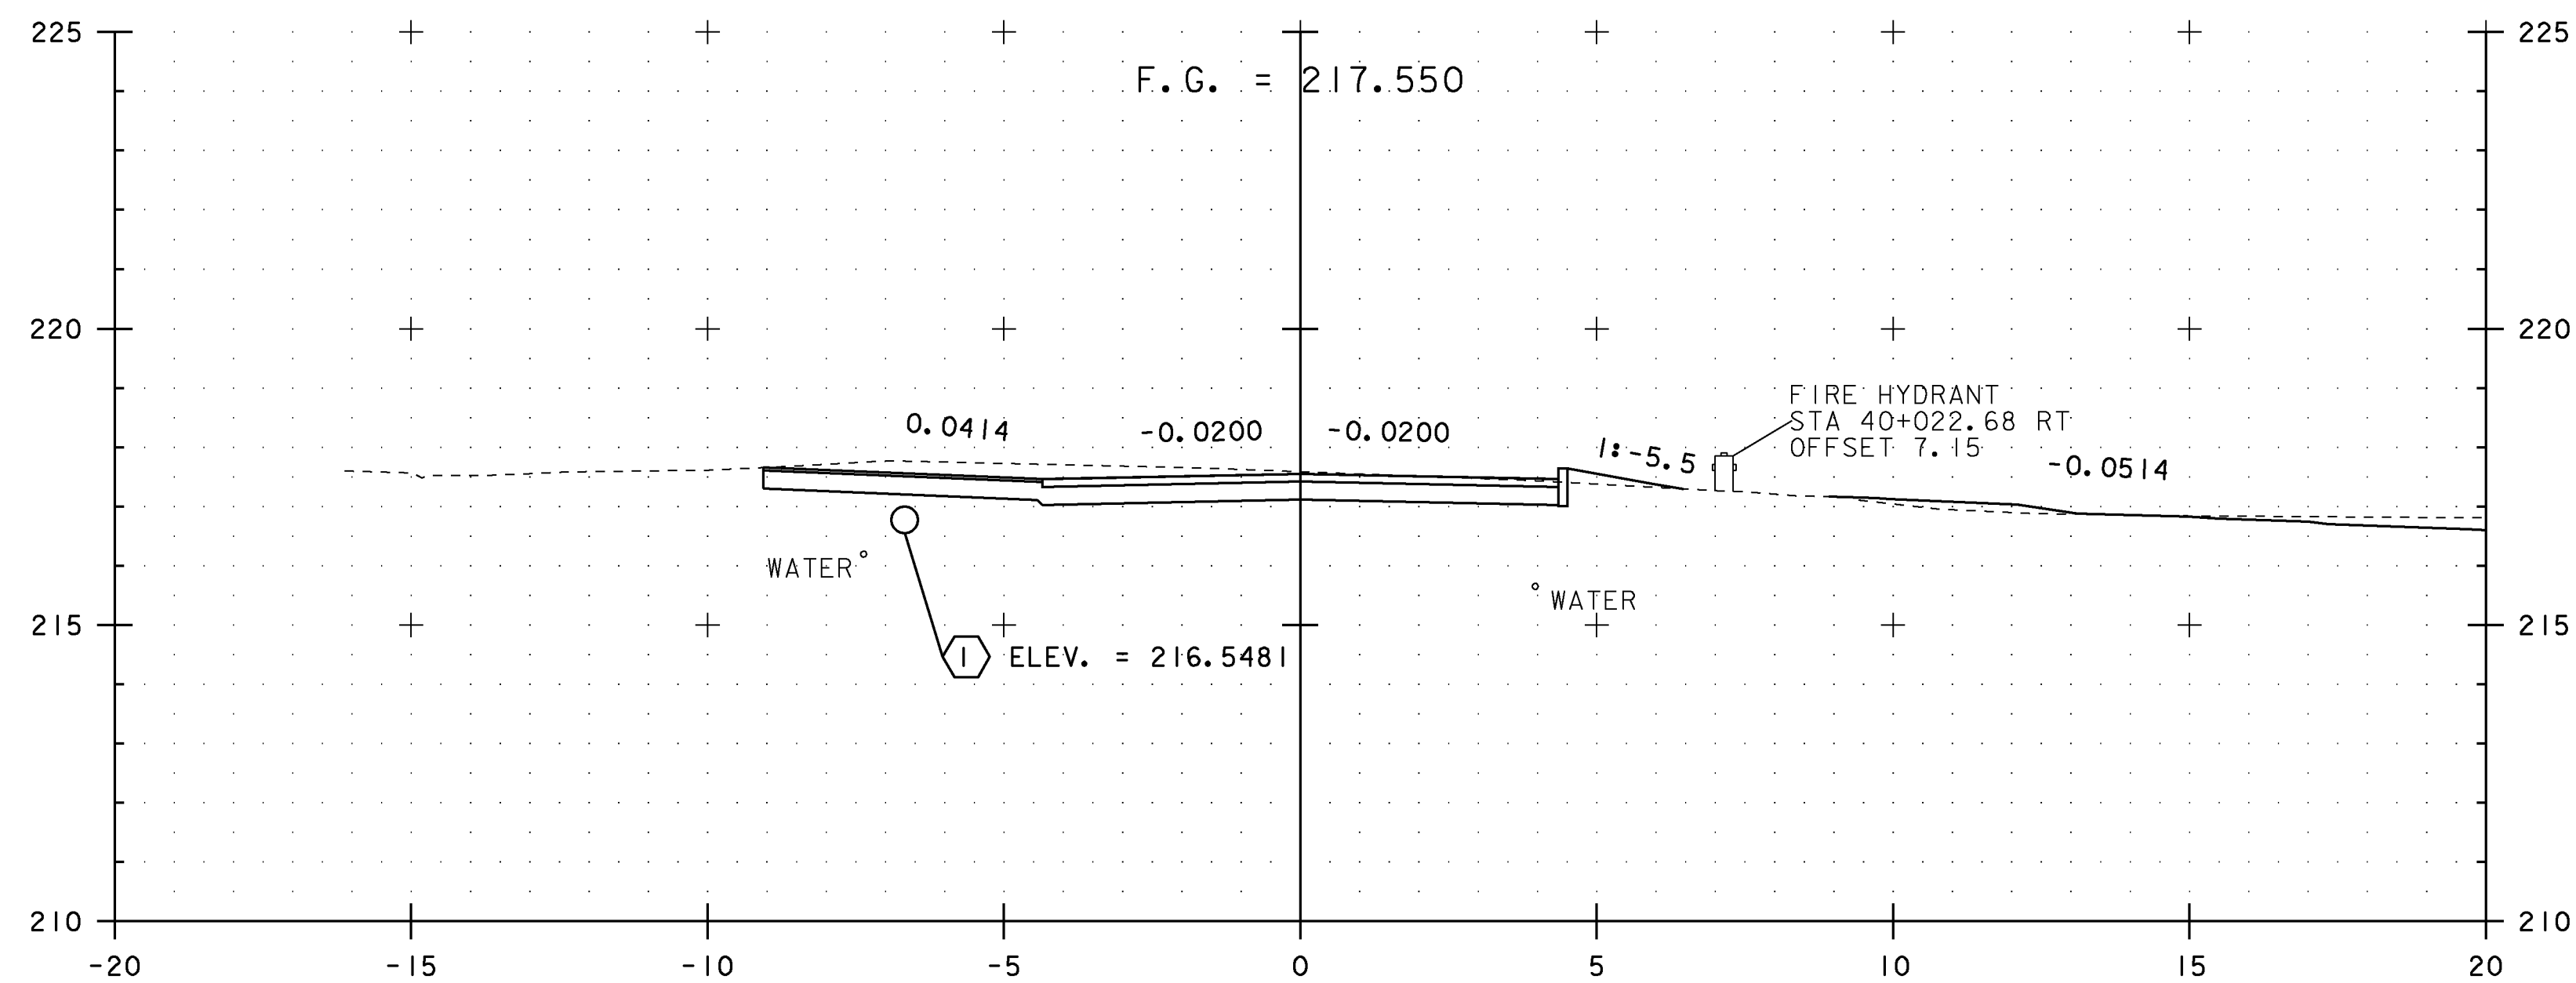

40+020.00

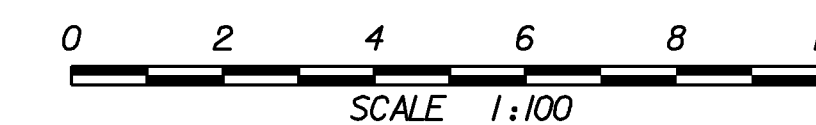


NOTES:

1. ALL BURIED UTILITIES ARE EXISTING, THE LOCATIONS ARE APPROXIMATE AND ARE TO REMAIN UNDISTURBED
2. DRAINAGE FEATURES DISPLAYED ON CROSS SECTIONS ARE PROJECTED. SEE DRAINAGE DETAIL SHEETS, LAYOUTS AND PROFILES FOR TRUE LOCATIONS


PROJECT NAME: EAST MONTPELIER
PROJECT NUMBER: STPG 028 - 3(35)S

FILE NAME: +98b028xsl.dgn
PROJECT LEADER: J. SCHULTZ
DESIGNED BY: J. GRUCHACZ
PLOT DATE: 22-MAR-2010
DRAWN BY: D. LYMAN
CHECKED BY: J. DEVLIN
QUAKER HILL ROAD CROSS SECTION SHEET 3 SHEET 129 OF 142


STA. 40+020 TO STA. 40+023

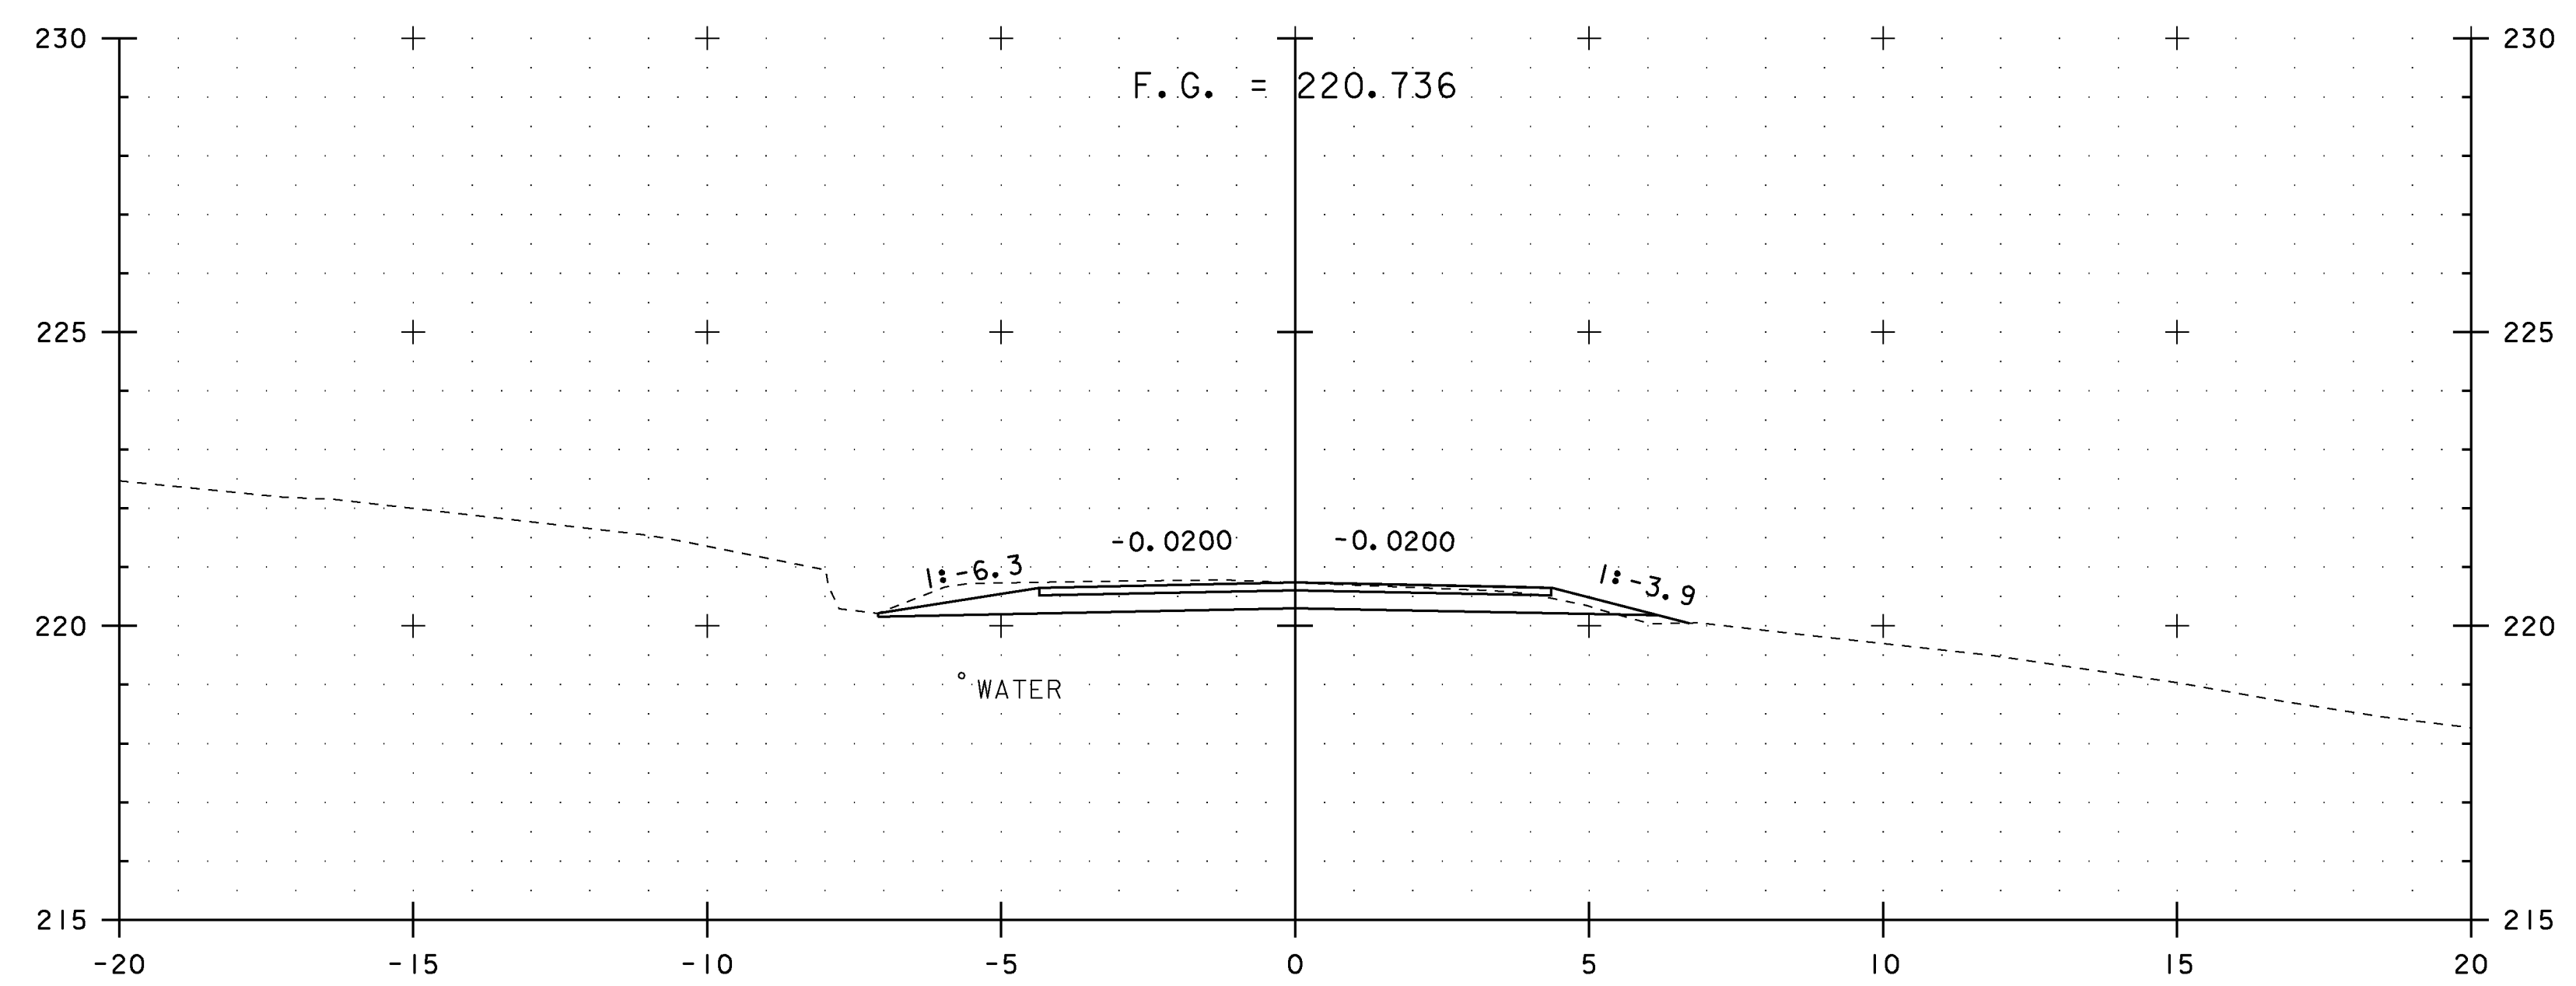

40+040.00

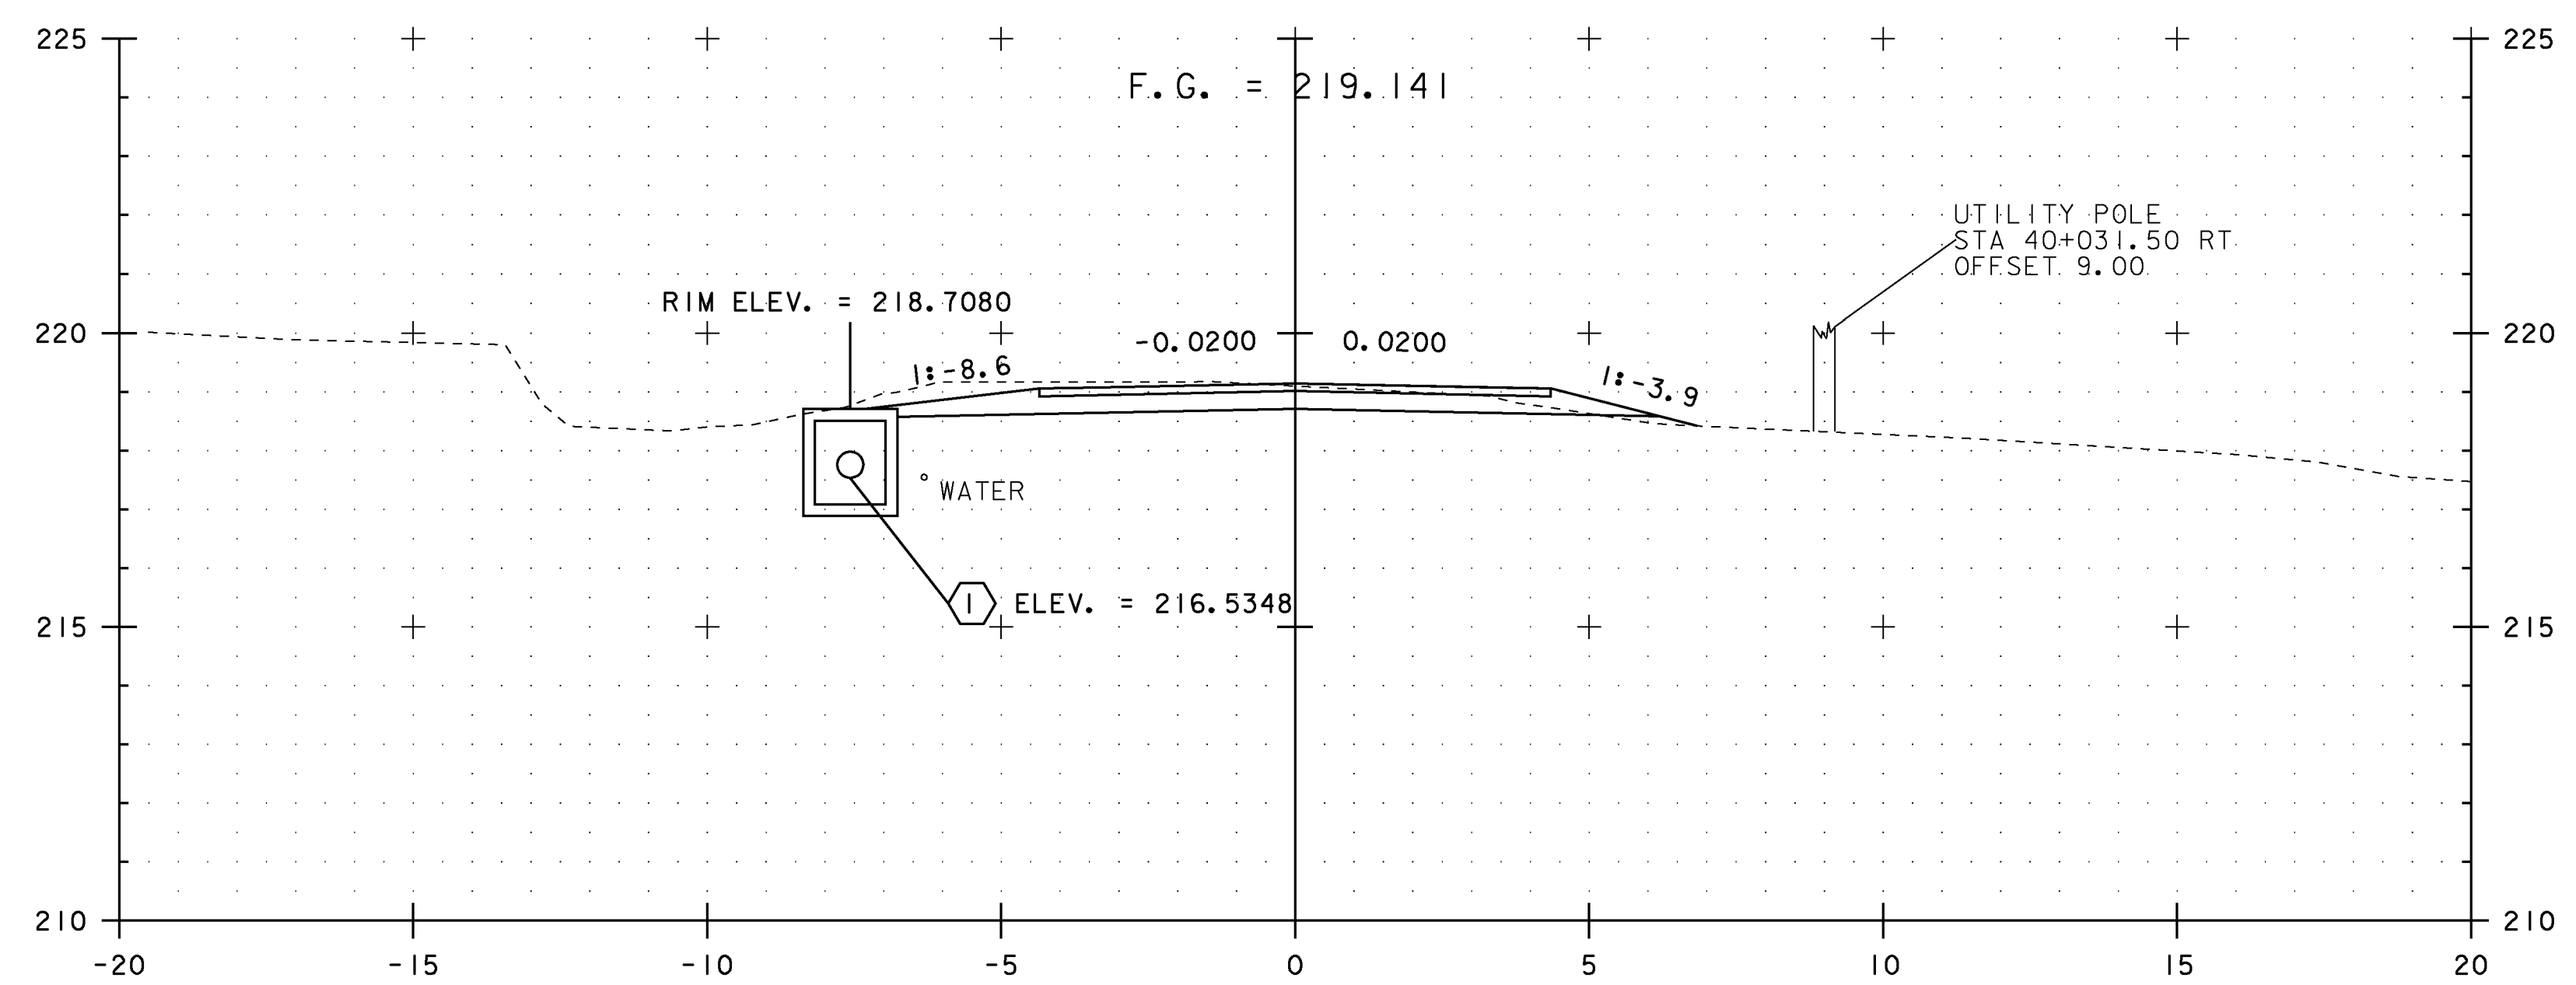

40+030.00

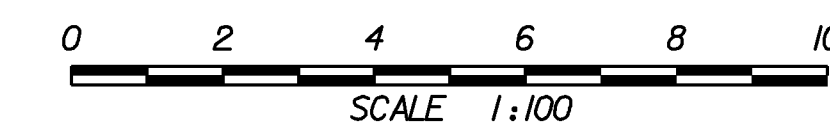



NOTES:

1. ALL BURIED UTILITIES ARE EXISTING, THE LOCATIONS ARE APPROXIMATE AND ARE TO REMAIN UNDISTURBED
2. DRAINAGE FEATURES DISPLAYED ON CROSS SECTIONS ARE PROJECTED. SEE DRAINAGE DETAIL SHEETS, LAYOUTS AND PROFILES FOR TRUE LOCATIONS

STA. 40+030 TO STA. 40+040

PROJECT NAME: EAST MONTEPELIER
 PROJECT NUMBER: STPG 028 - 3(35)S

FILE NAME: +98b028xsl.dgn PLOT DATE: 22-MAR-2010
 PROJECT LEADER: J. SCHULTZ DRAWN BY: D. LYMAN
 DESIGNED BY: J. GRUCHACZ CHECKED BY: J. DEVLIN
 QUAKER HILL ROAD CROSS SECTION SHEET 4 SHEET 130 OF 142

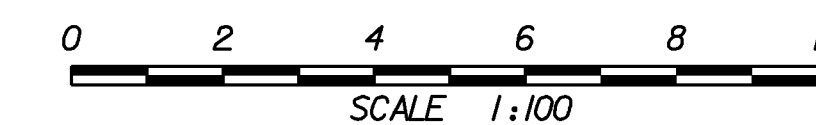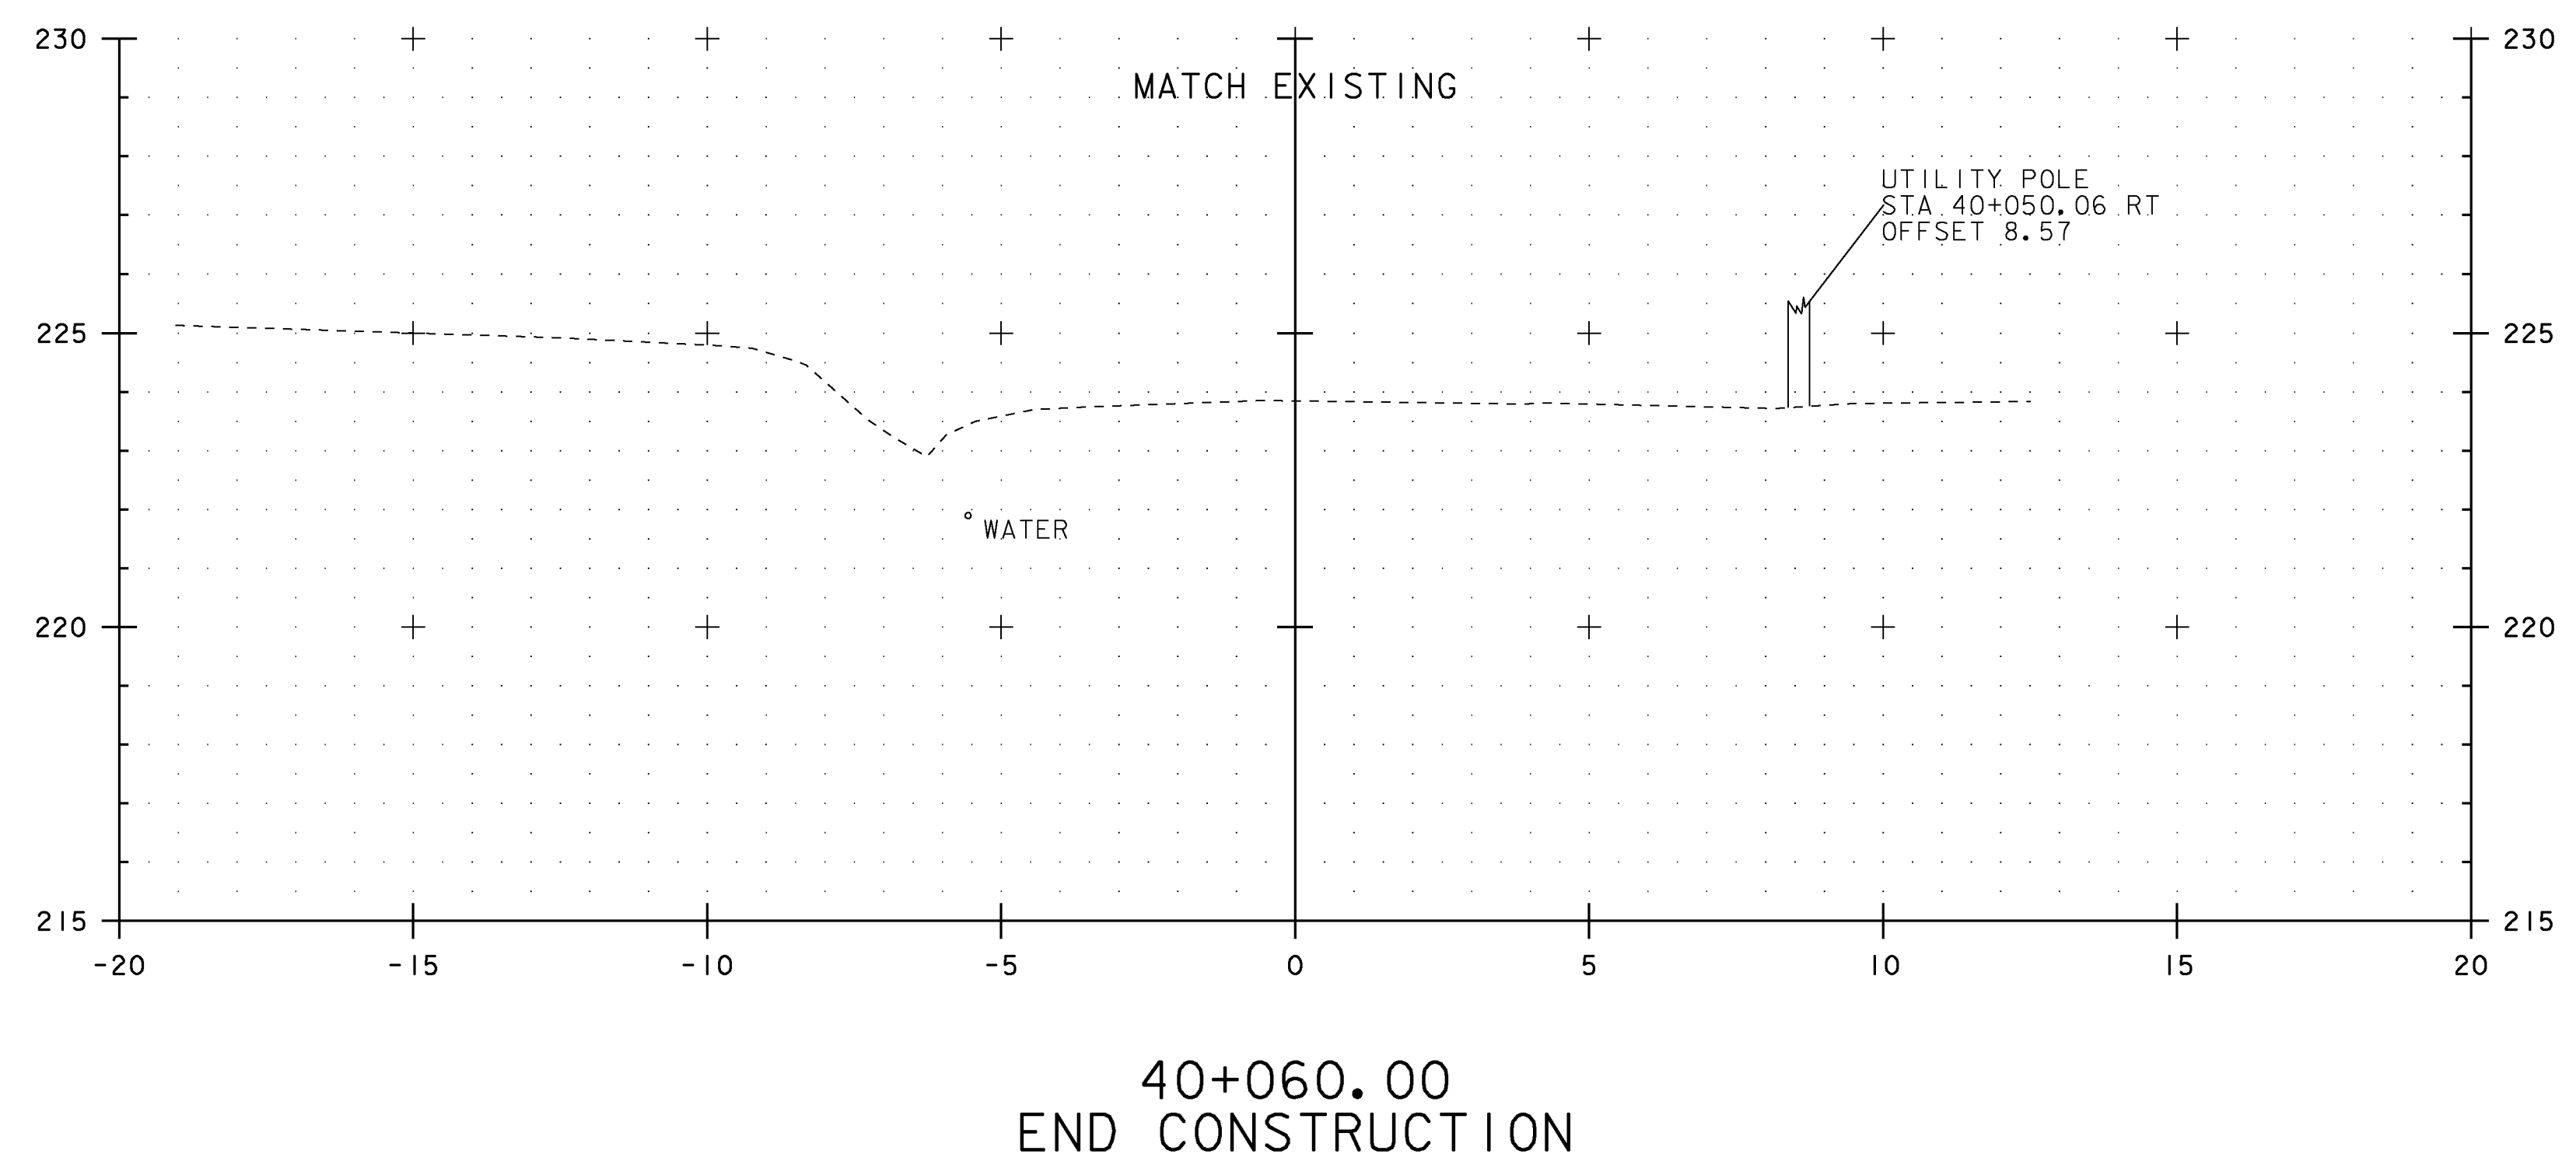


NOTES:

1. ALL BURIED UTILITIES ARE EXISTING, THE LOCATIONS ARE APPROXIMATE AND ARE TO REMAIN UNDISTURBED
2. DRAINAGE FEATURES DISPLAYED ON CROSS SECTIONS ARE PROJECTED. SEE DRAINAGE DETAIL SHEETS, LAYOUTS AND PROFILES FOR TRUE LOCATIONS


STA. 40+060

PROJECT NAME: EAST MONTPELIER
PROJECT NUMBER: STPG 028 - 3(35)S


FILE NAME: +98b028xsl.dgn	PLOT DATE: 22-MAR-2010
PROJECT LEADER: J. SCHULTZ	DRAWN BY: D. LYMAN
DESIGNED BY: J. GRUCHACZ	CHECKED BY: J. DEVLIN
QUAKER HILL ROAD CROSS SECTION SHEET 5 SHEET 131 OF 142	

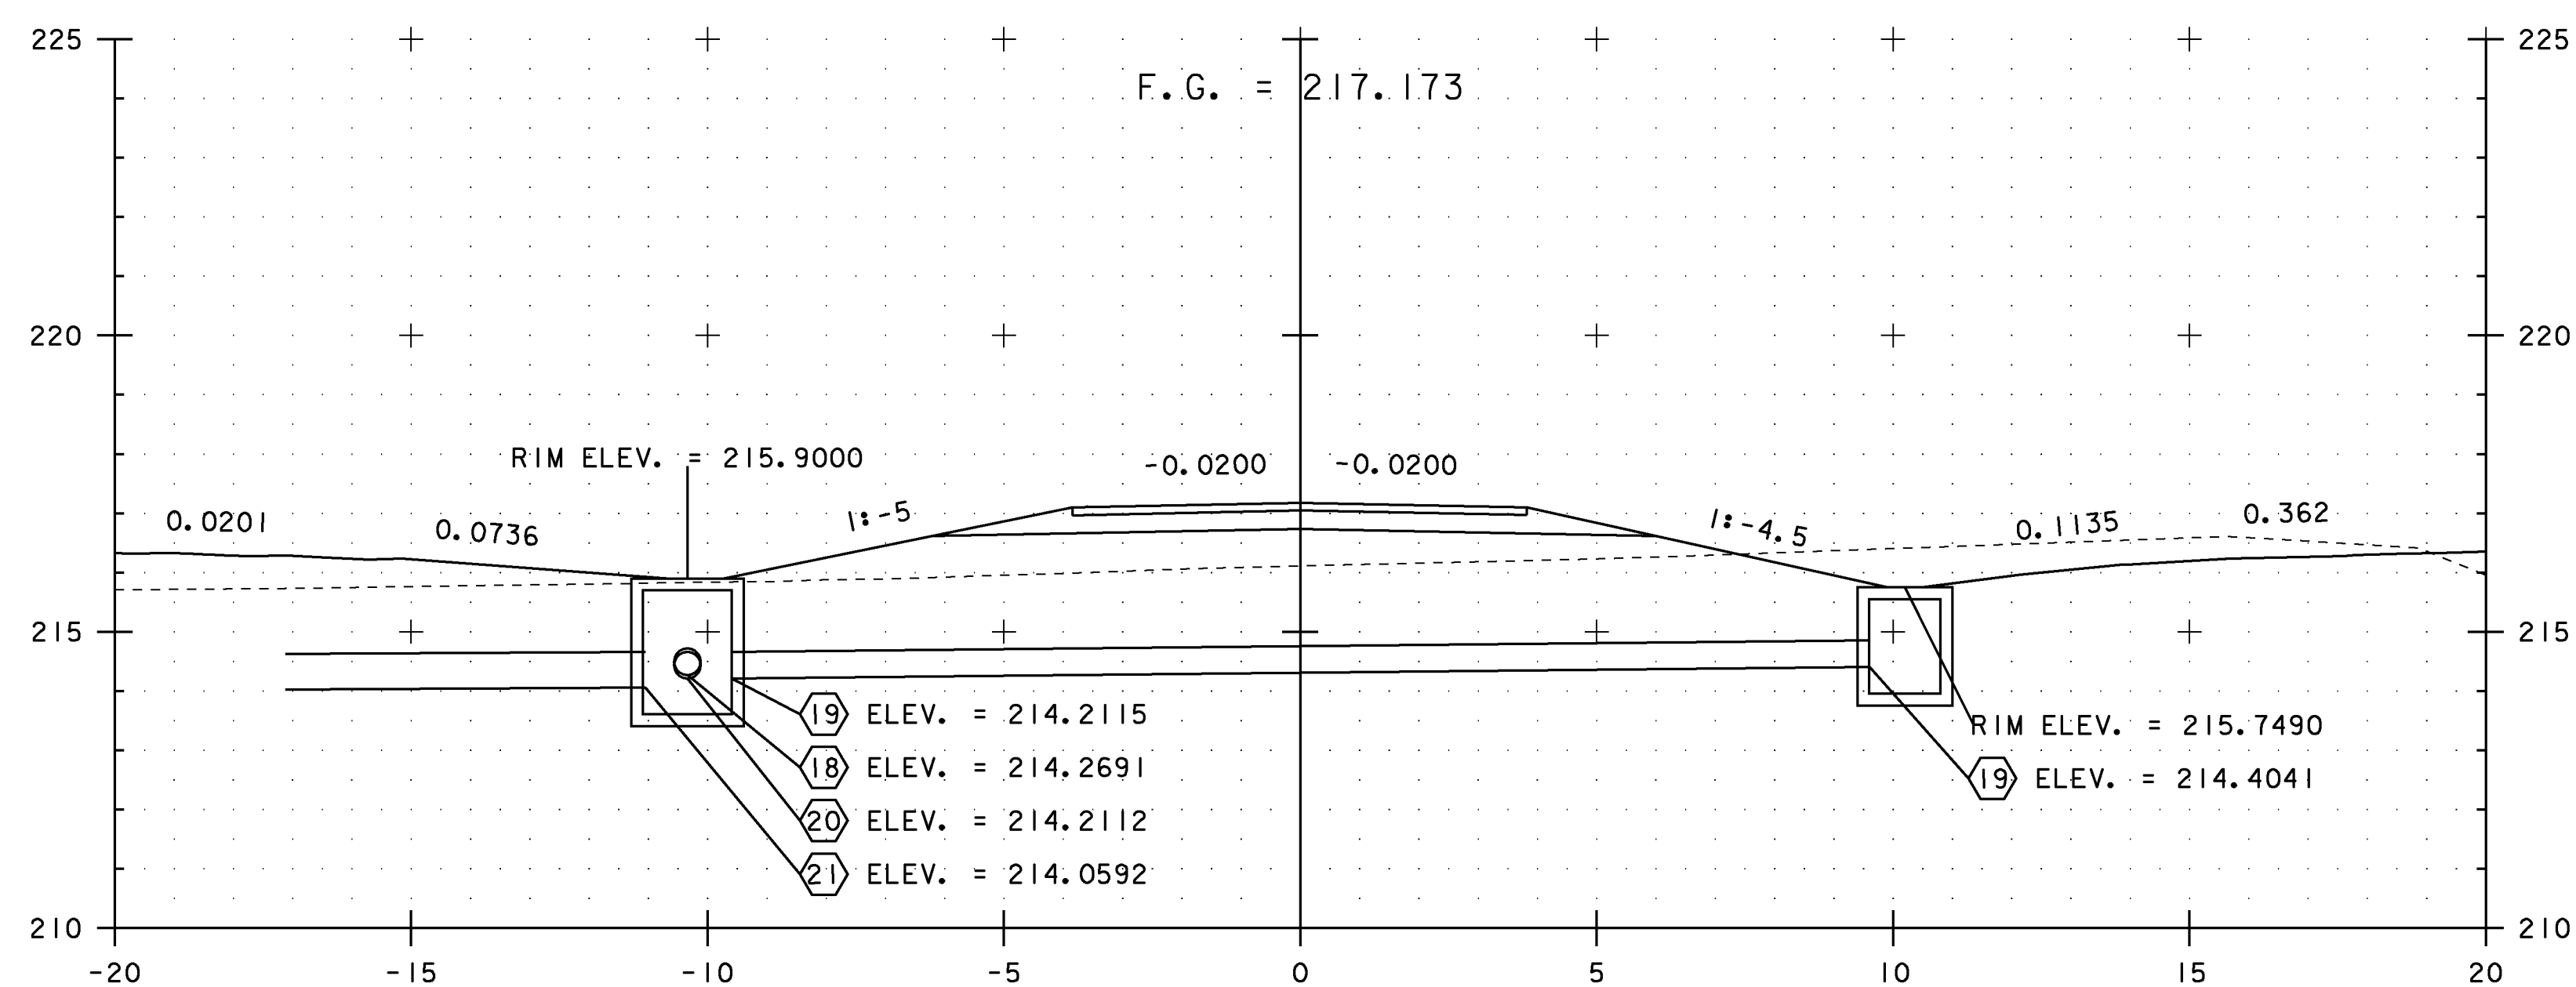

PC 30+015.34

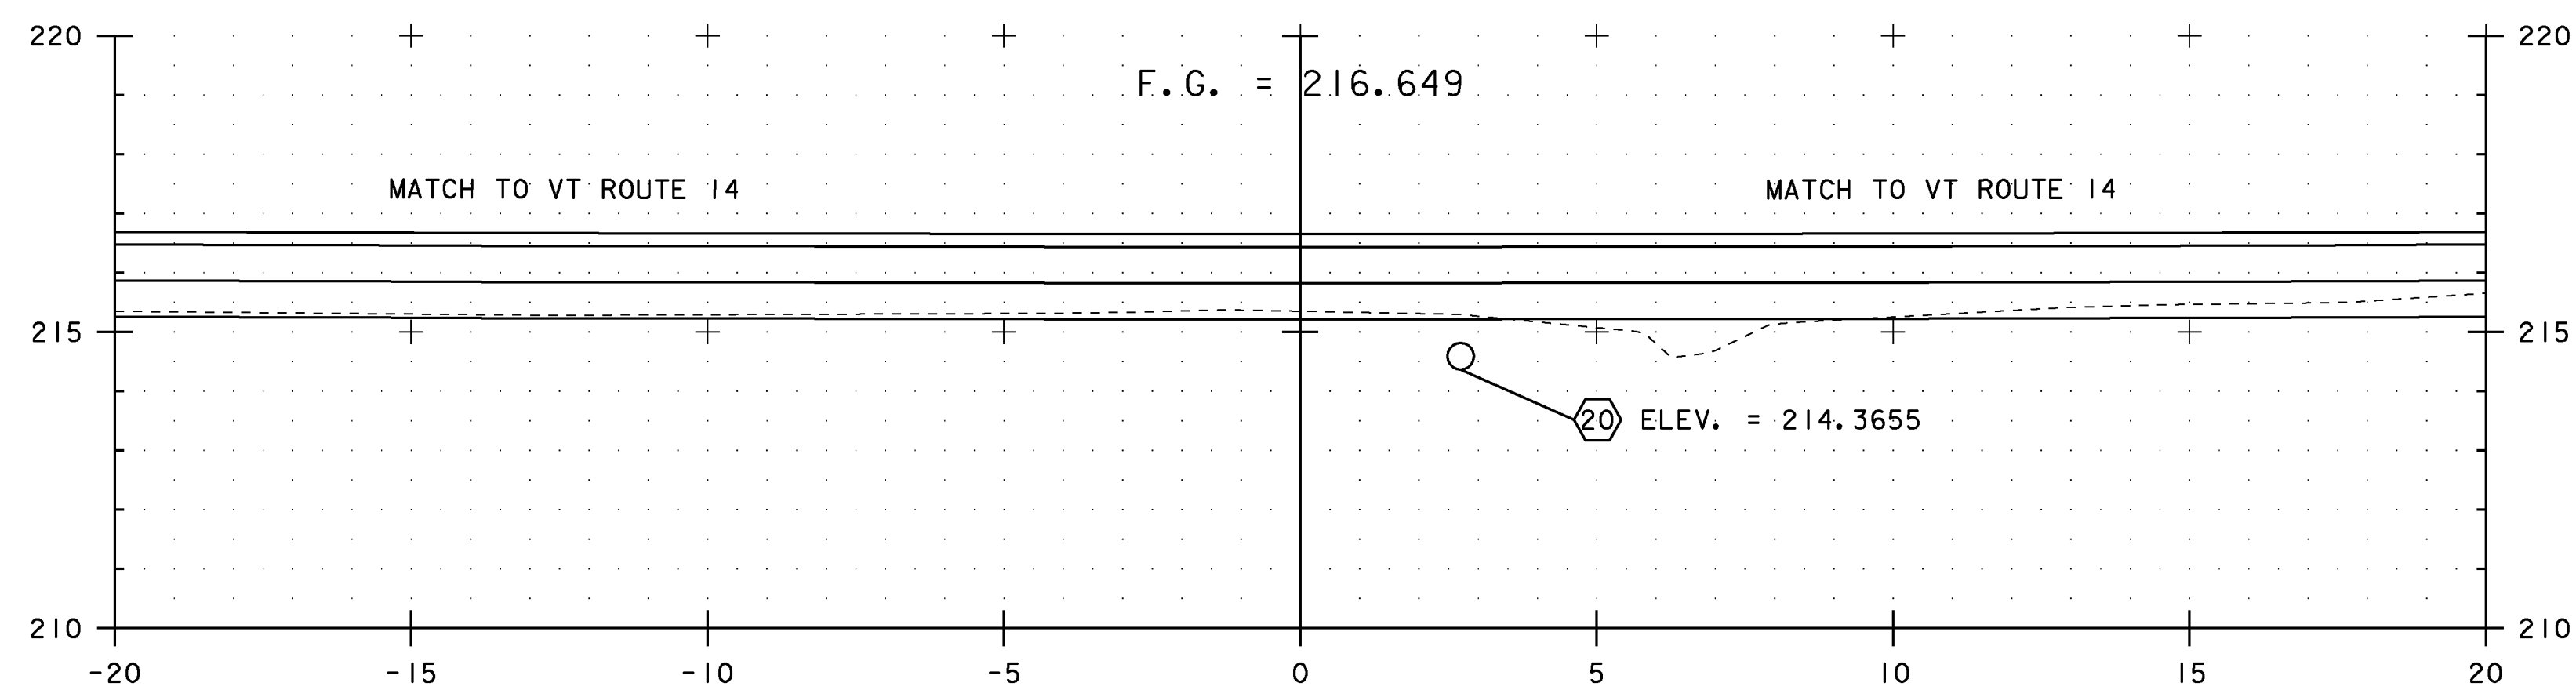

30+000.00 =
VT ROUTE 14 STA 14+139.00

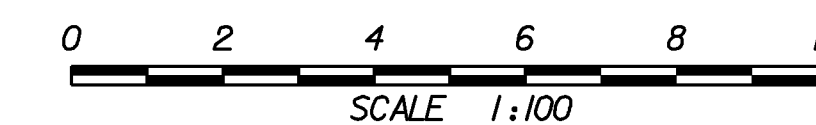


NOTES:

1. ALL BURIED UTILITIES ARE EXISTING, THE LOCATIONS ARE APPROXIMATE AND ARE TO REMAIN UNDISTURBED
2. DRAINAGE FEATURES DISPLAYED ON CROSS SECTIONS ARE PROJECTED. SEE DRAINAGE DETAIL SHEETS, LAYOUTS AND PROFILES FOR TRUE LOCATIONS


PROJECT NAME: EAST MONTPELIER
PROJECT NUMBER: STPG 028 - 3(35)S

FILE NAME: +98b028xsl.dgn	PLOT DATE: 22-MAR-2010
PROJECT LEADER: J. SCHULTZ	DRAWN BY: D. LYMAN
DESIGNED BY: J. GRUCHACZ	CHECKED BY: J. DEVLIN
KELTON ROAD CROSS SECTION SHEET I	SHEET 132 OF 142


STA. 30+000 TO STA. 30+015.34

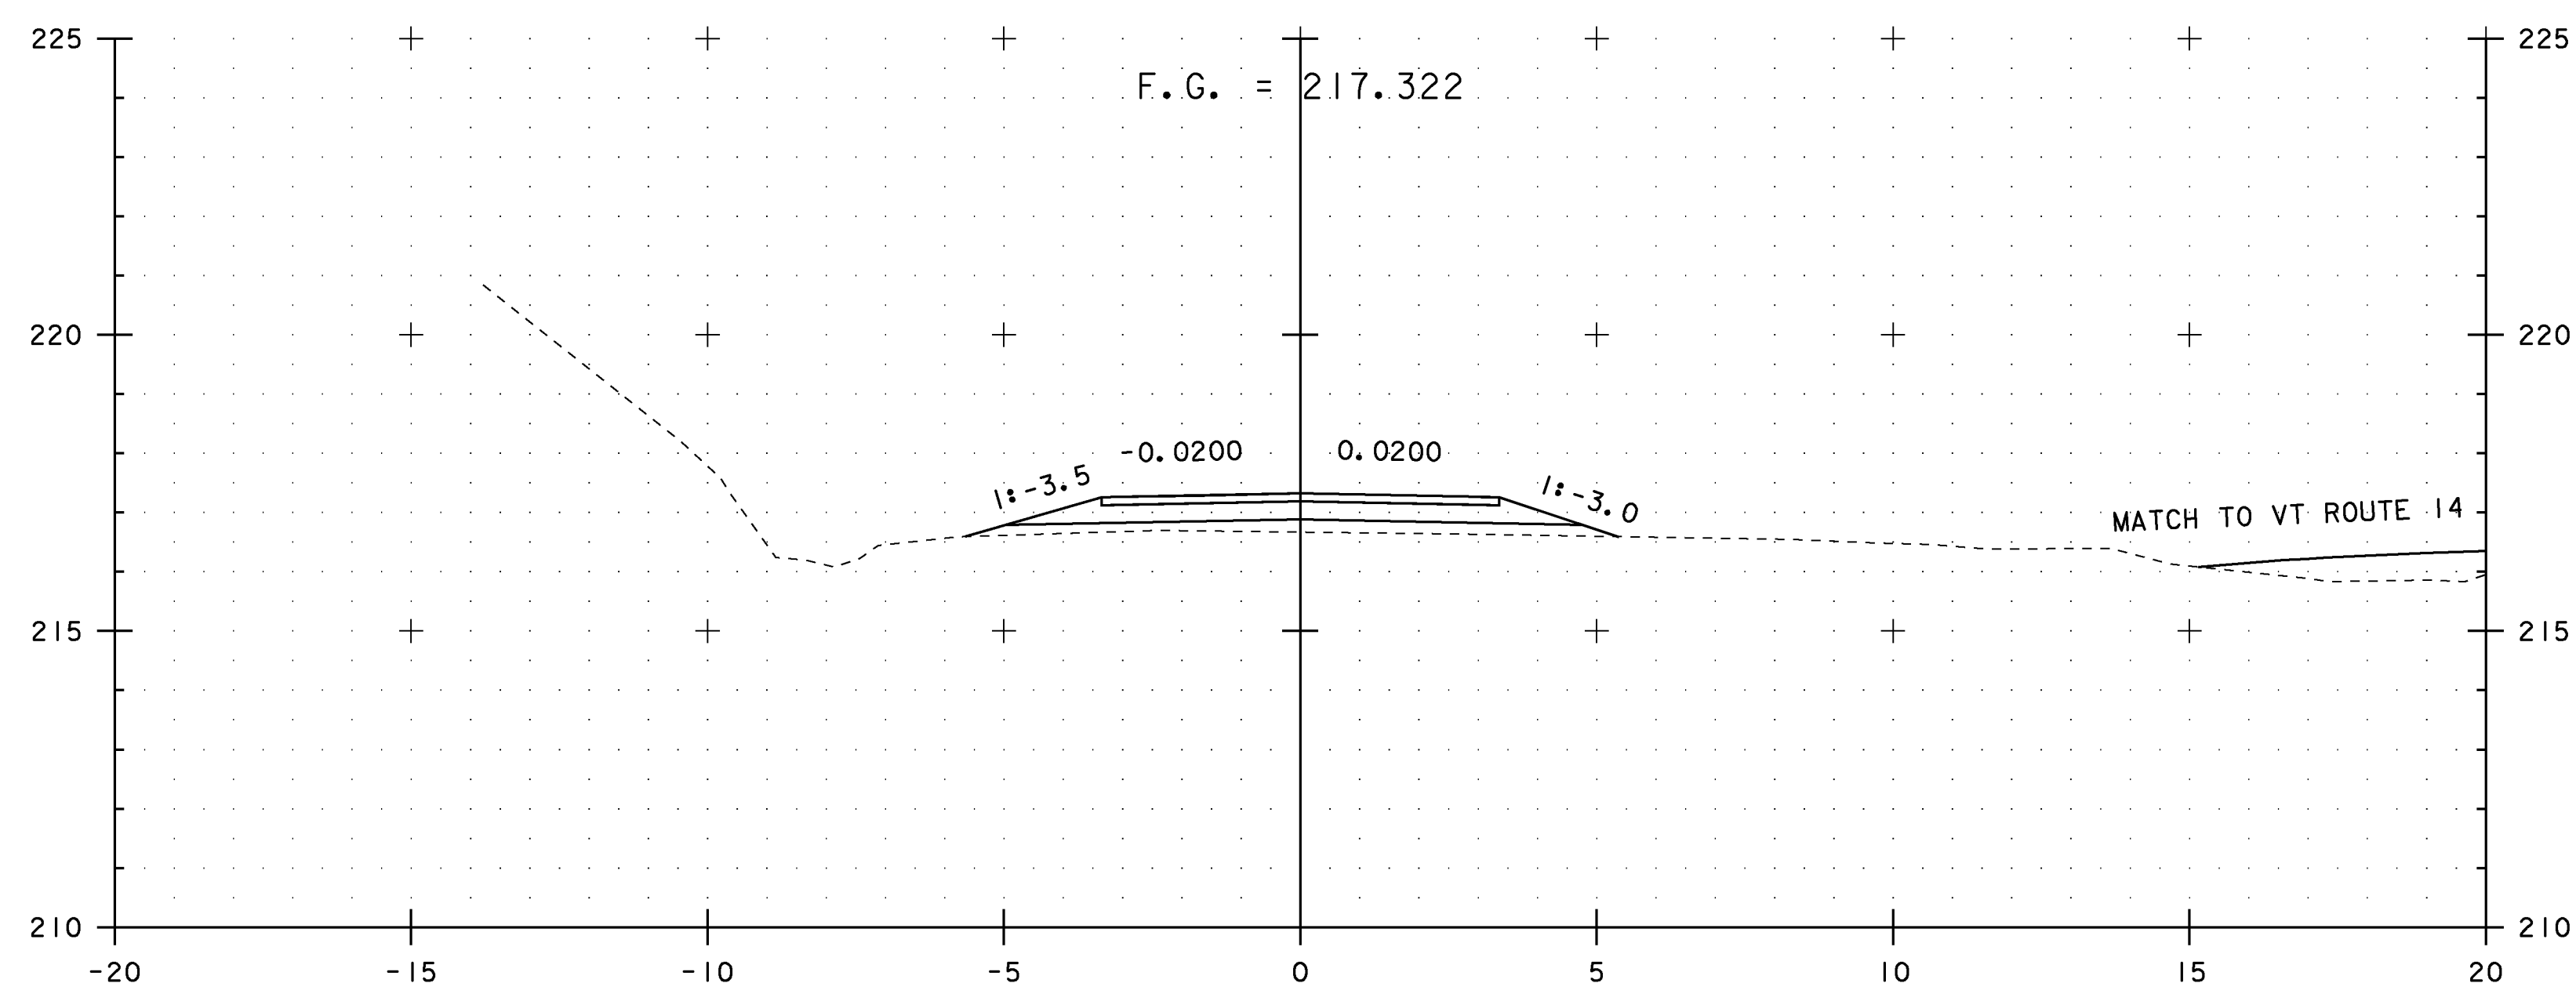

30+030.00

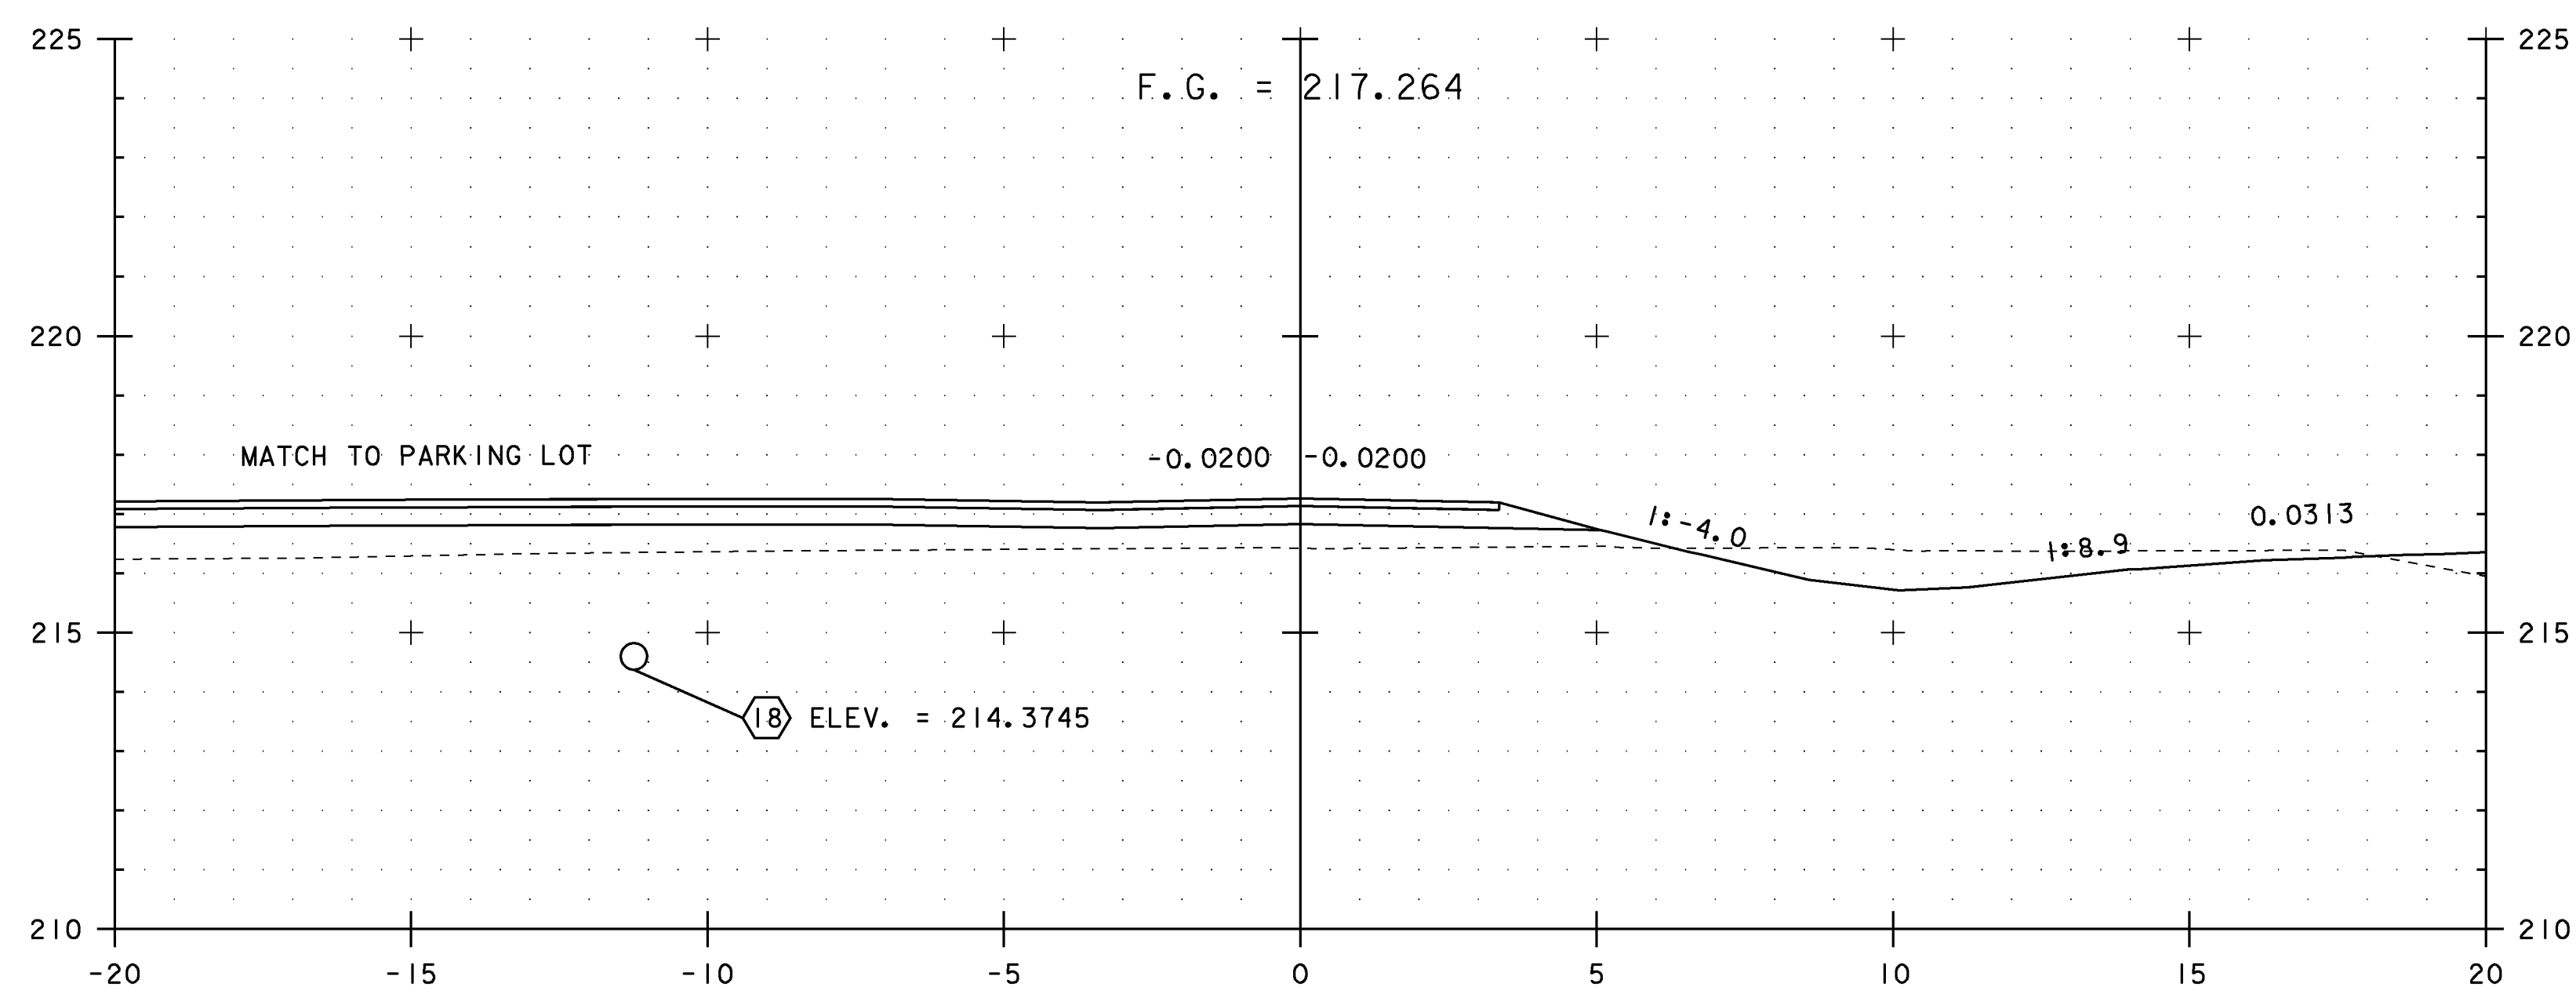

30+020.00

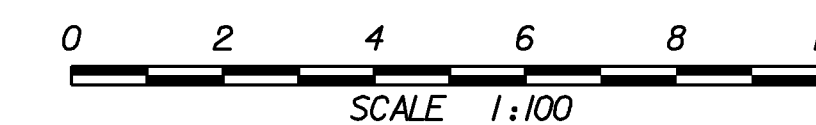


NOTES:

1. ALL BURIED UTILITIES ARE EXISTING, THE LOCATIONS ARE APPROXIMATE AND ARE TO REMAIN UNDISTURBED
2. DRAINAGE FEATURES DISPLAYED ON CROSS SECTIONS ARE PROJECTED. SEE DRAINAGE DETAIL SHEETS, LAYOUTS AND PROFILES FOR TRUE LOCATIONS


PROJECT NAME: EAST MONTPELIER
 PROJECT NUMBER: STPG 028 - 3(35)S

FILE NAME: +98b028xsl.dgn PLOT DATE: 22-MAR-2010
 PROJECT LEADER: J. SCHULTZ DRAWN BY: D. LYMAN
 DESIGNED BY: J. GRUCHACZ CHECKED BY: J. DEVLIN
 KELTON ROAD CROSS SECTION SHEET 2 SHEET 133 OF 142


STA. 30+020 TO STA. 30+030

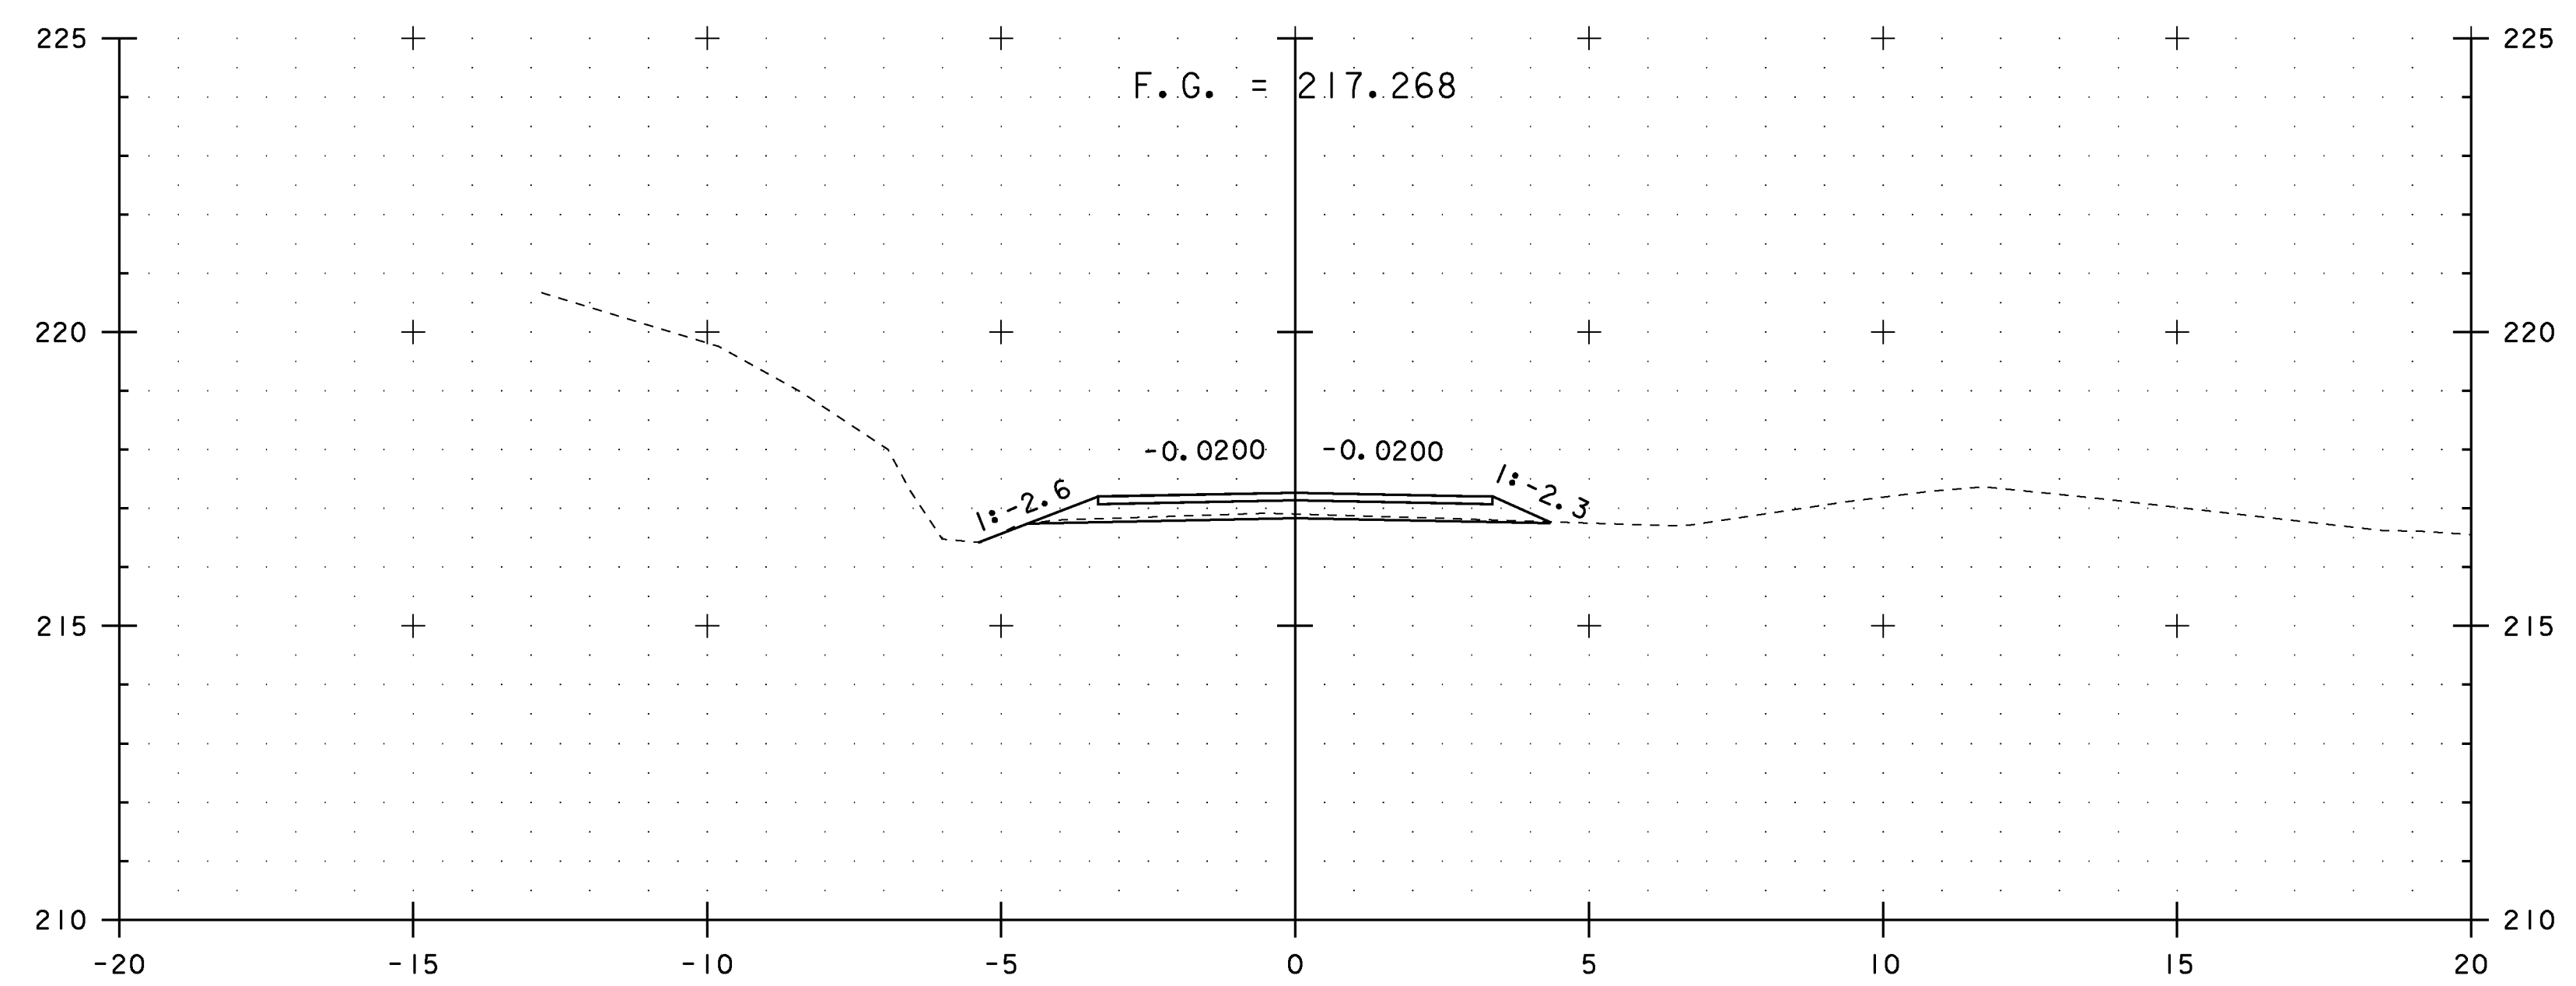

30+040.00

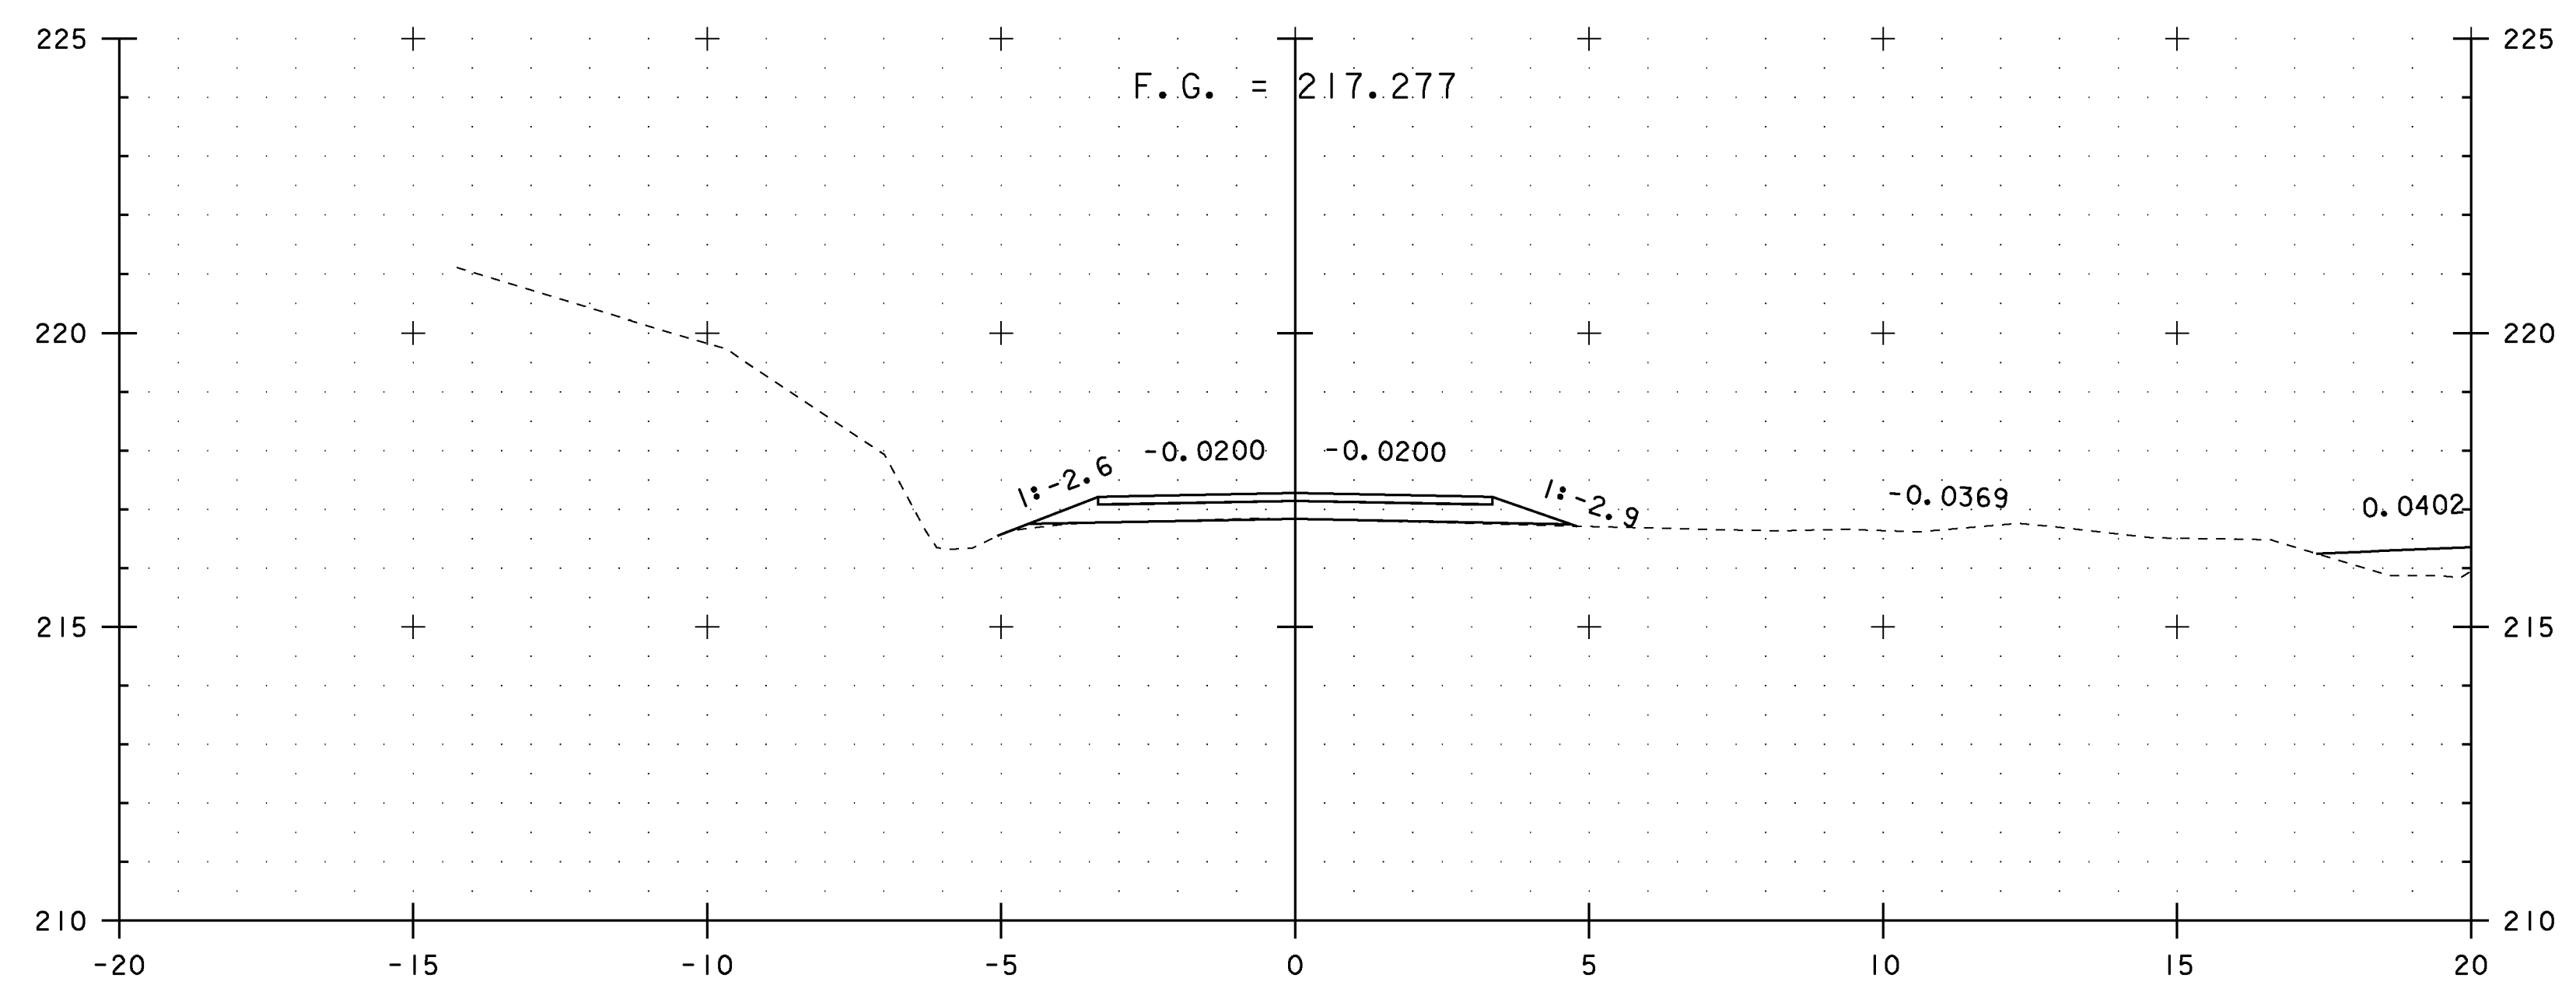

PT 30+036.85

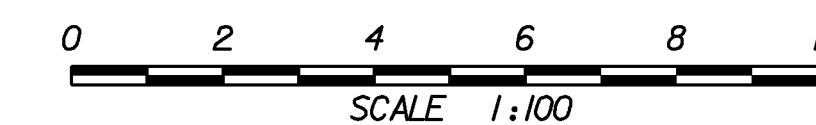


NOTES:

1. ALL BURIED UTILITIES ARE EXISTING, THE LOCATIONS ARE APPROXIMATE AND ARE TO REMAIN UNDISTURBED
2. DRAINAGE FEATURES DISPLAYED ON CROSS SECTIONS ARE PROJECTED. SEE DRAINAGE DETAIL SHEETS, LAYOUTS AND PROFILES FOR TRUE LOCATIONS


STA. 30+036.85 TO STA. 30+040

PROJECT NAME: EAST MONTEPELIER
 PROJECT NUMBER: STPG 028 - 3(35)S


FILE NAME: +98b028xsl.dgn	PLOT DATE: 22-MAR-2010
PROJECT LEADER: J. SCHULTZ	DRAWN BY: D. LYMAN
DESIGNED BY: J. GRUCHACZ	CHECKED BY: J. DEVLIN
KELTON ROAD CROSS SECTION SHEET 3	SHEET 134 OF 142

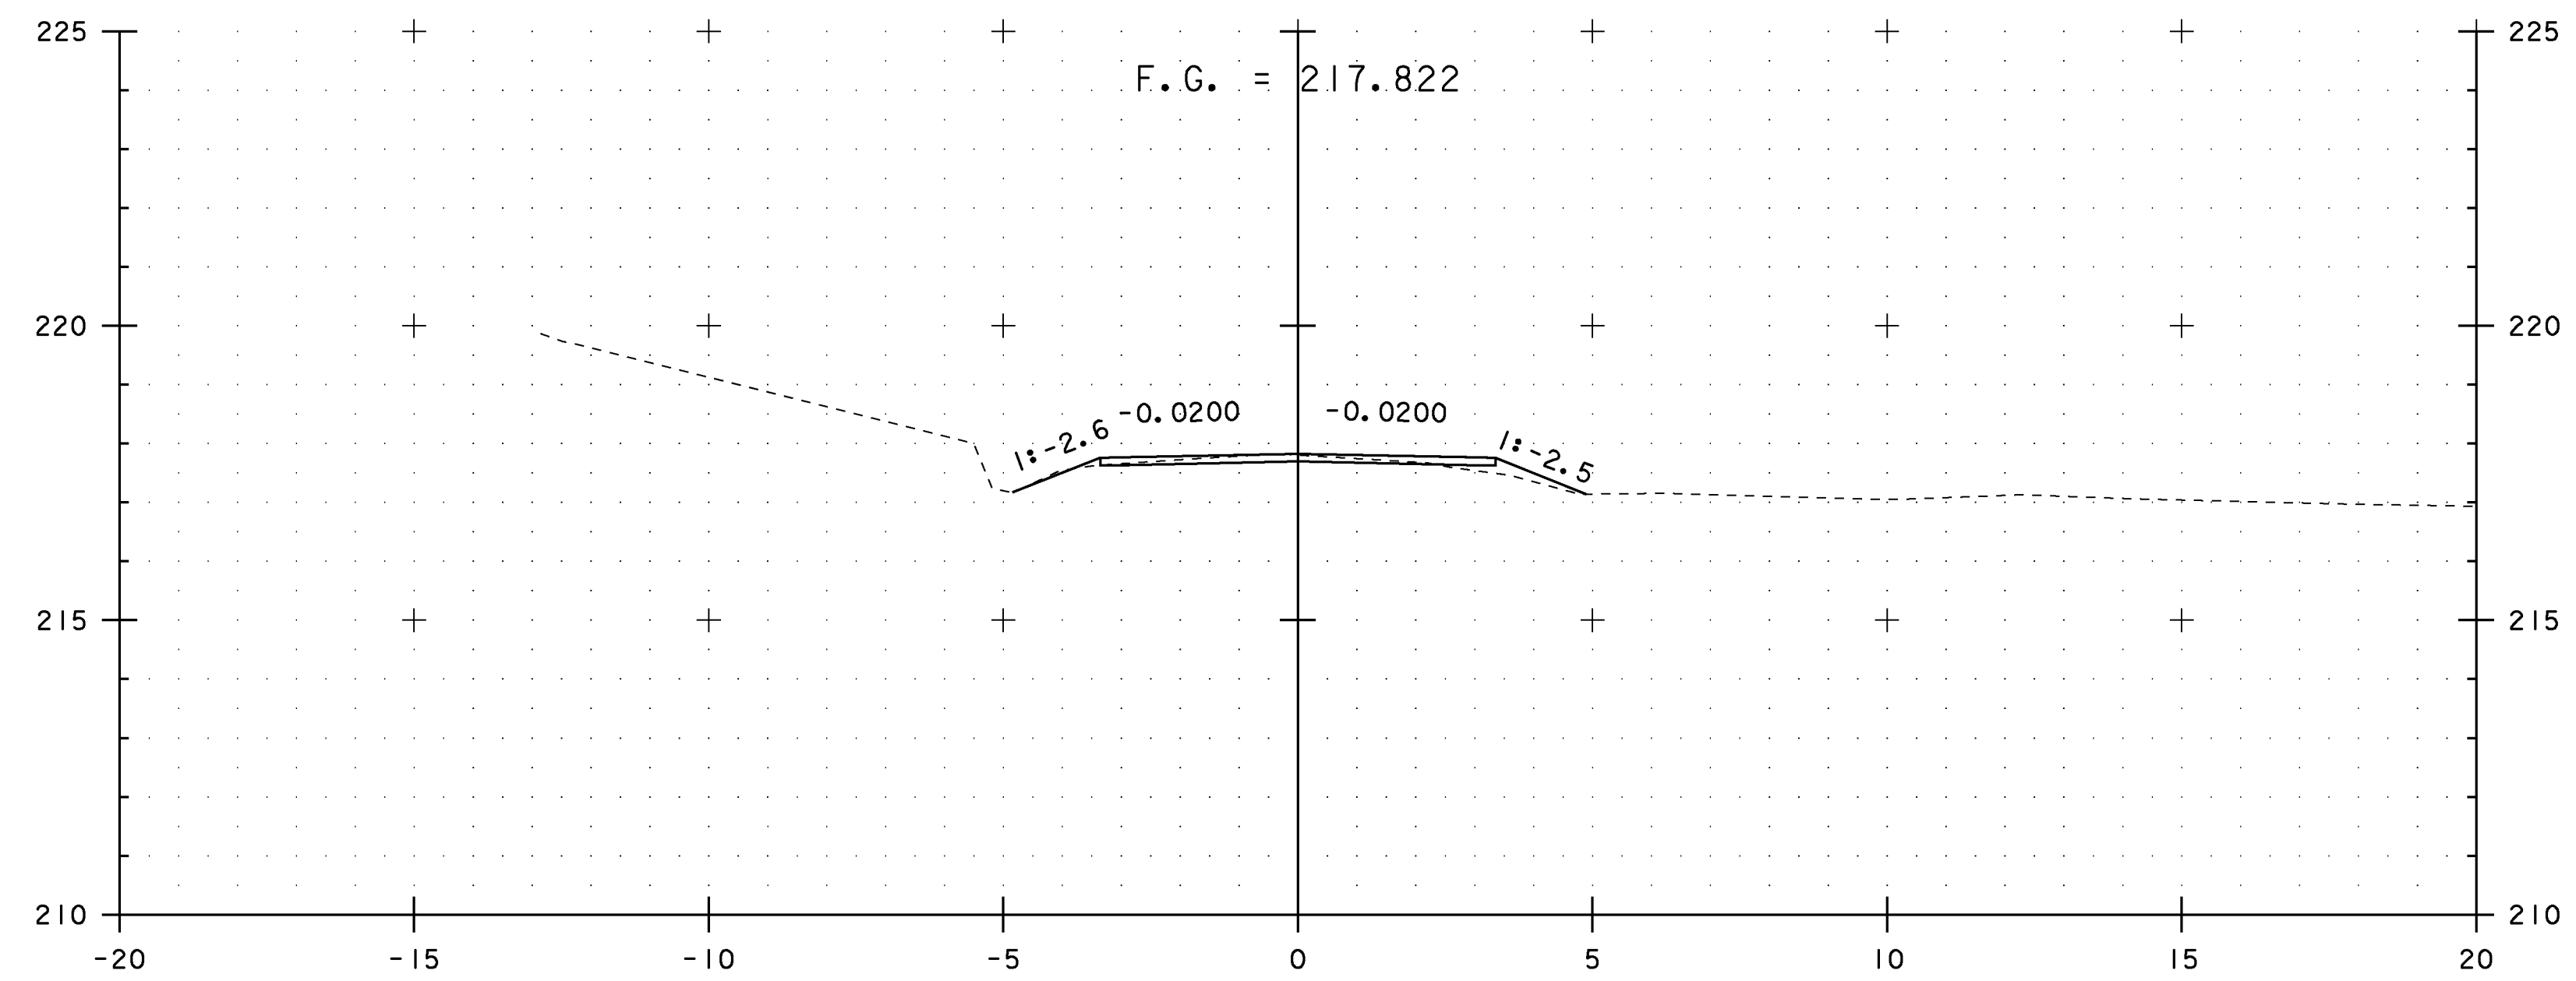


30+060.00

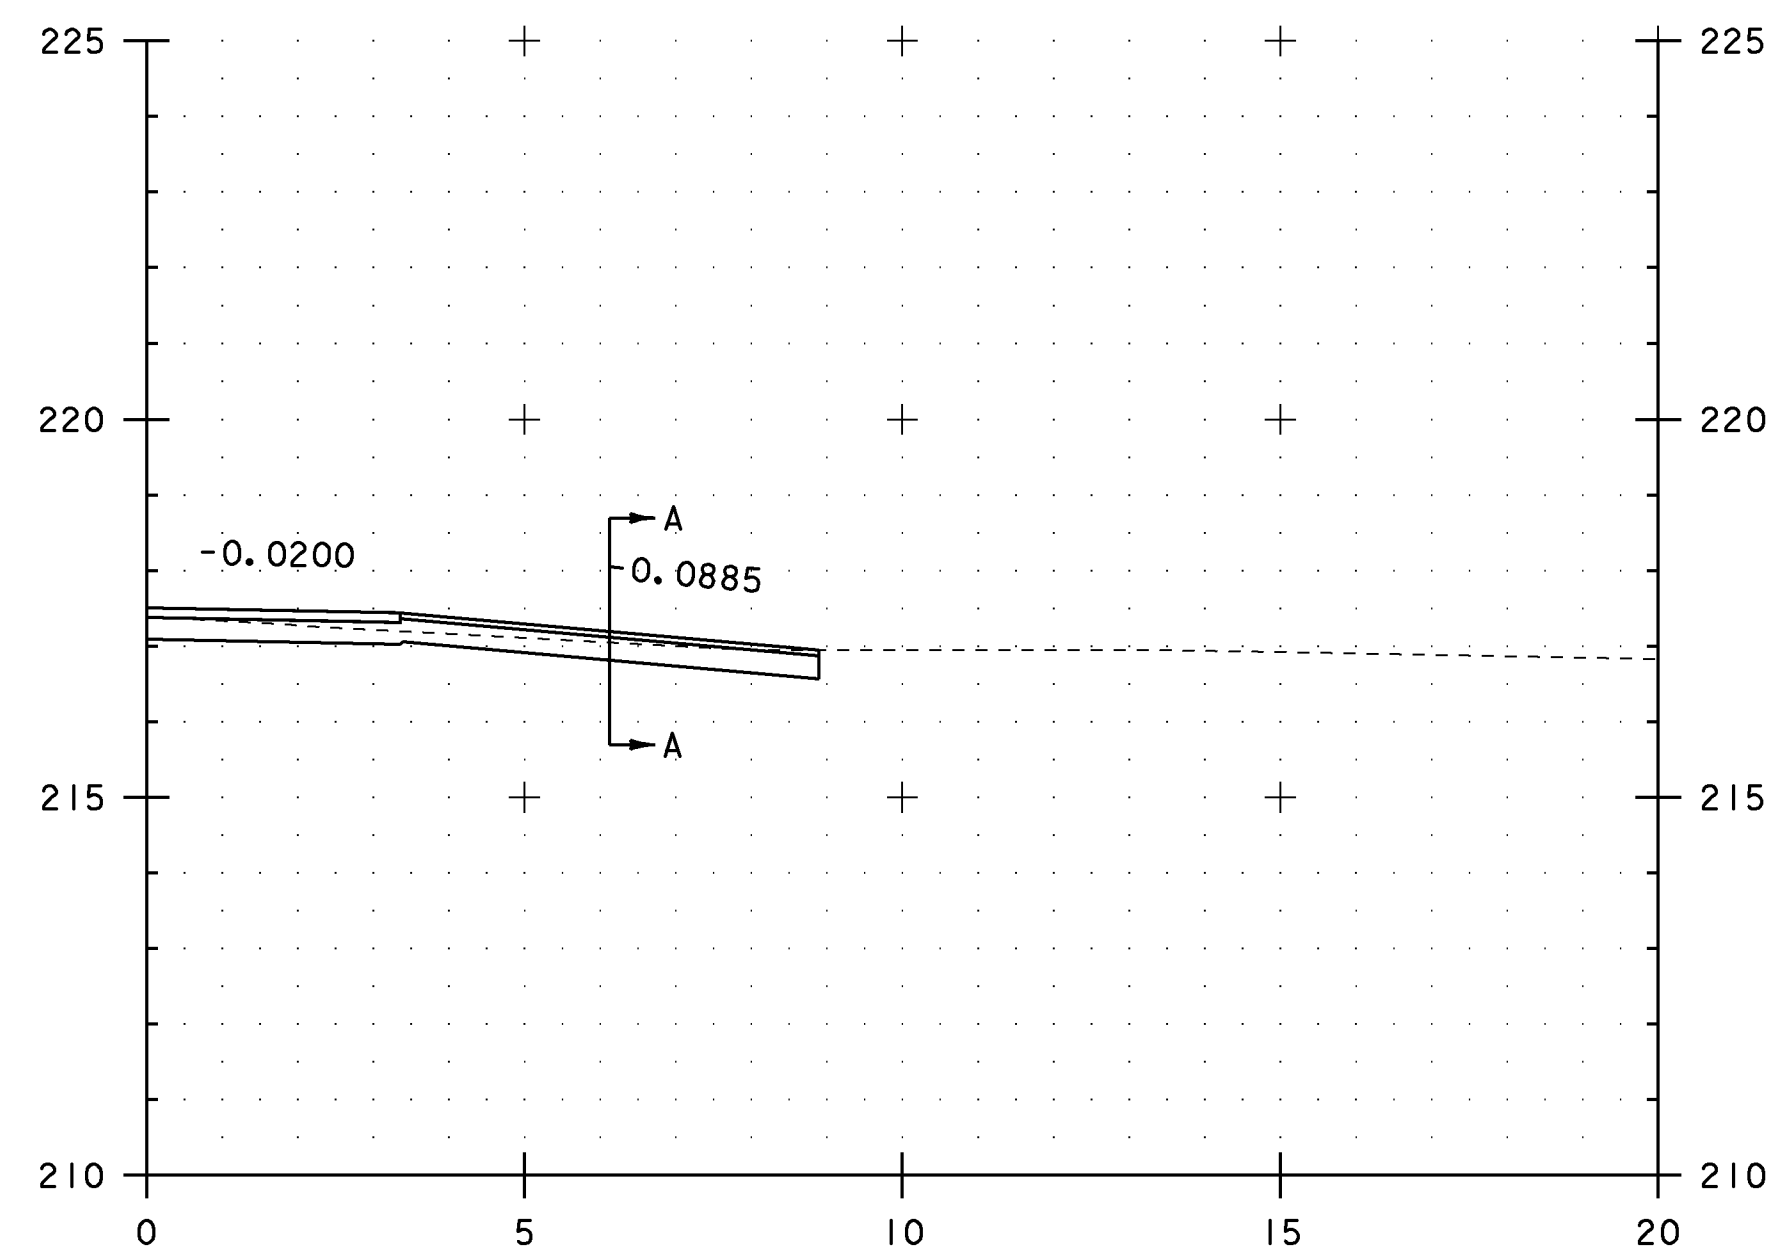

30+053.00
GRAVEL DRIVE RT

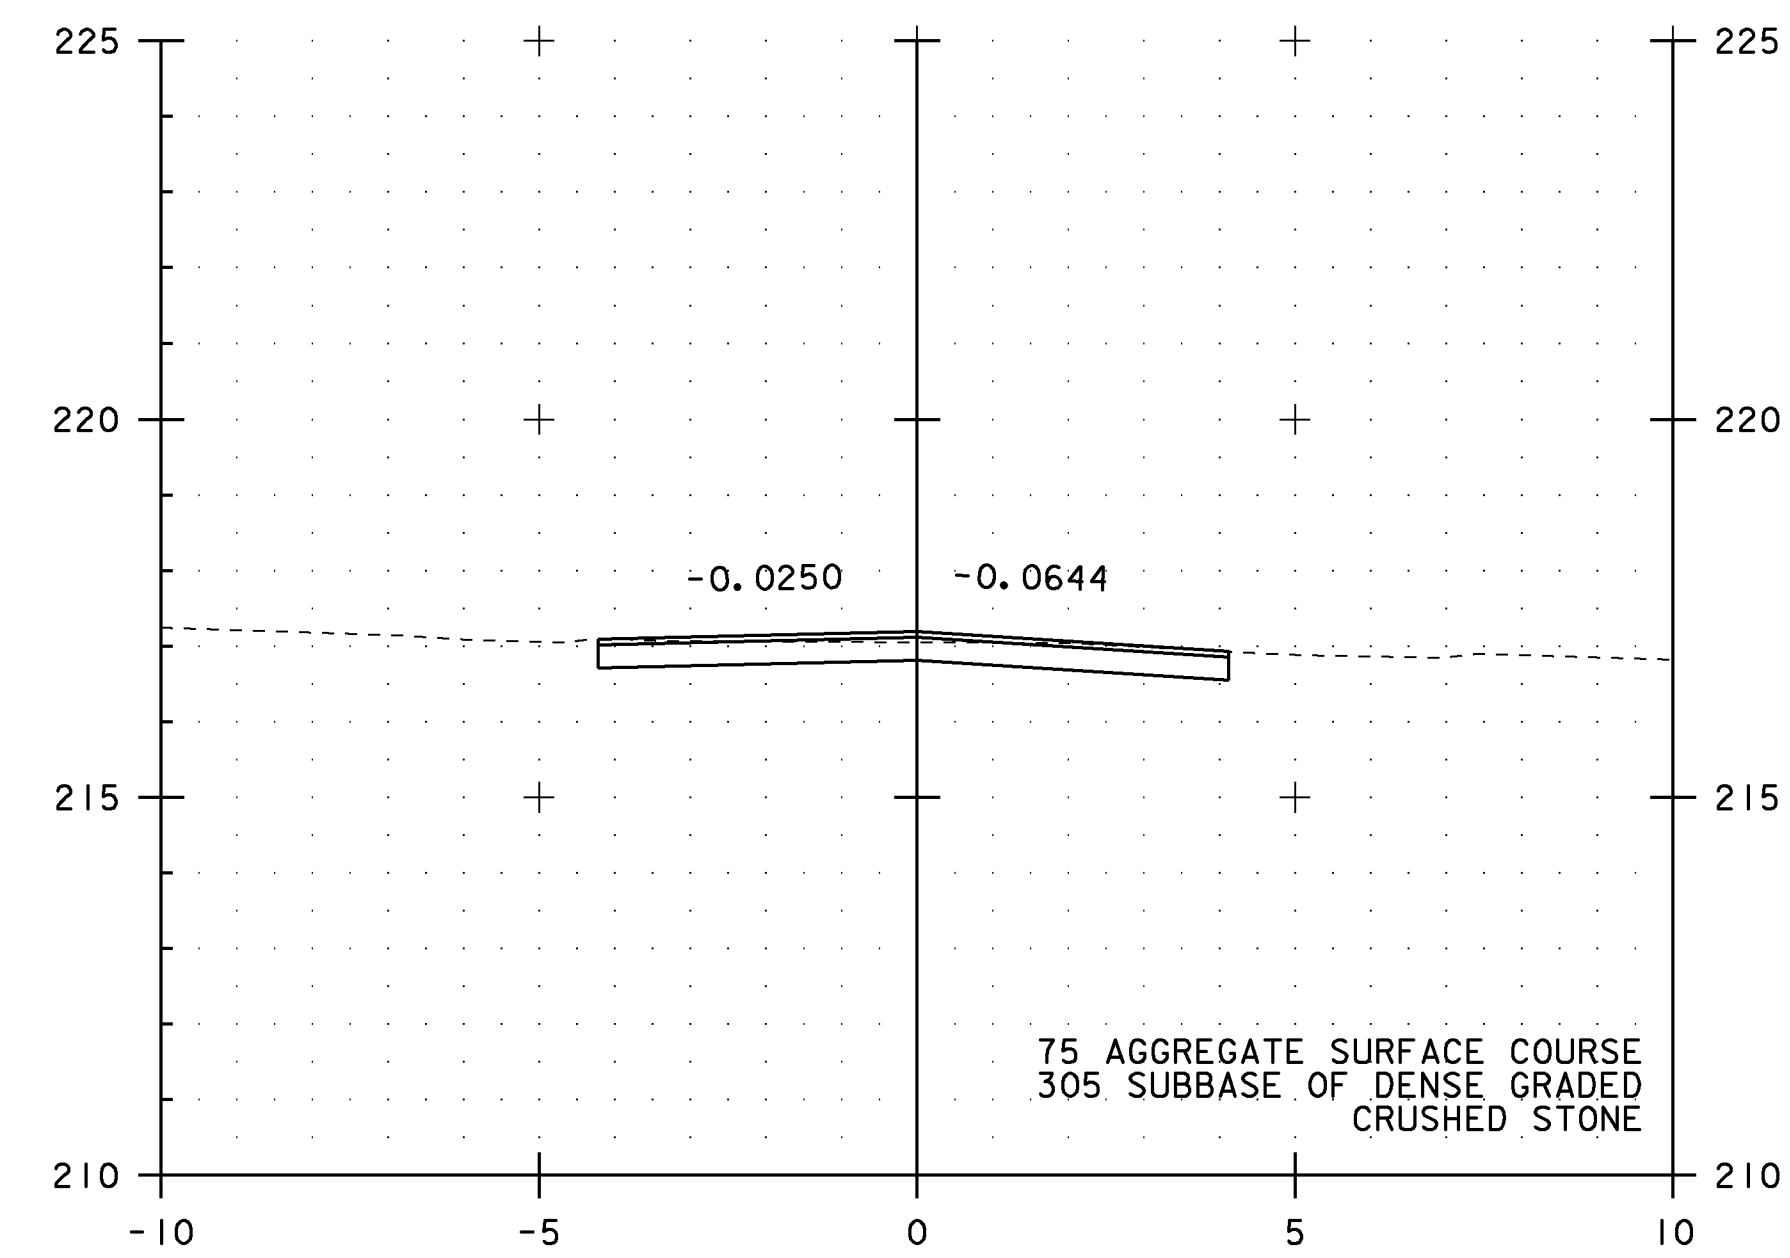

SECTION A-A

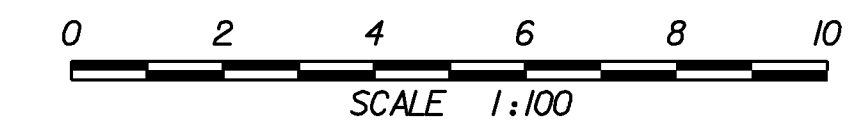

NOTES:


1. ALL BURIED UTILITIES ARE EXISTING, THE LOCATIONS ARE APPROXIMATE AND ARE TO REMAIN UNDISTURBED
2. DRAINAGE FEATURES DISPLAYED ON CROSS SECTIONS ARE PROJECTED. SEE DRAINAGE DETAIL SHEETS, LAYOUTS AND PROFILES FOR TRUE LOCATIONS

PROJECT NAME: EAST MONTEPELIER
PROJECT NUMBER: STPG 028 - 3(35)S

FILE NAME: +98b028xsl.dgn
PROJECT LEADER: J. SCHULTZ
DESIGNED BY: J. GRUCHACZ
KELTON ROAD CROSS SECTION SHEET 4

PLOT DATE: 22-MAR-2010
DRAWN BY: D. LYMAN
CHECKED BY: J. DEVLIN
SHEET 135 OF 142

STA. 30+053 TO STA. 30+060

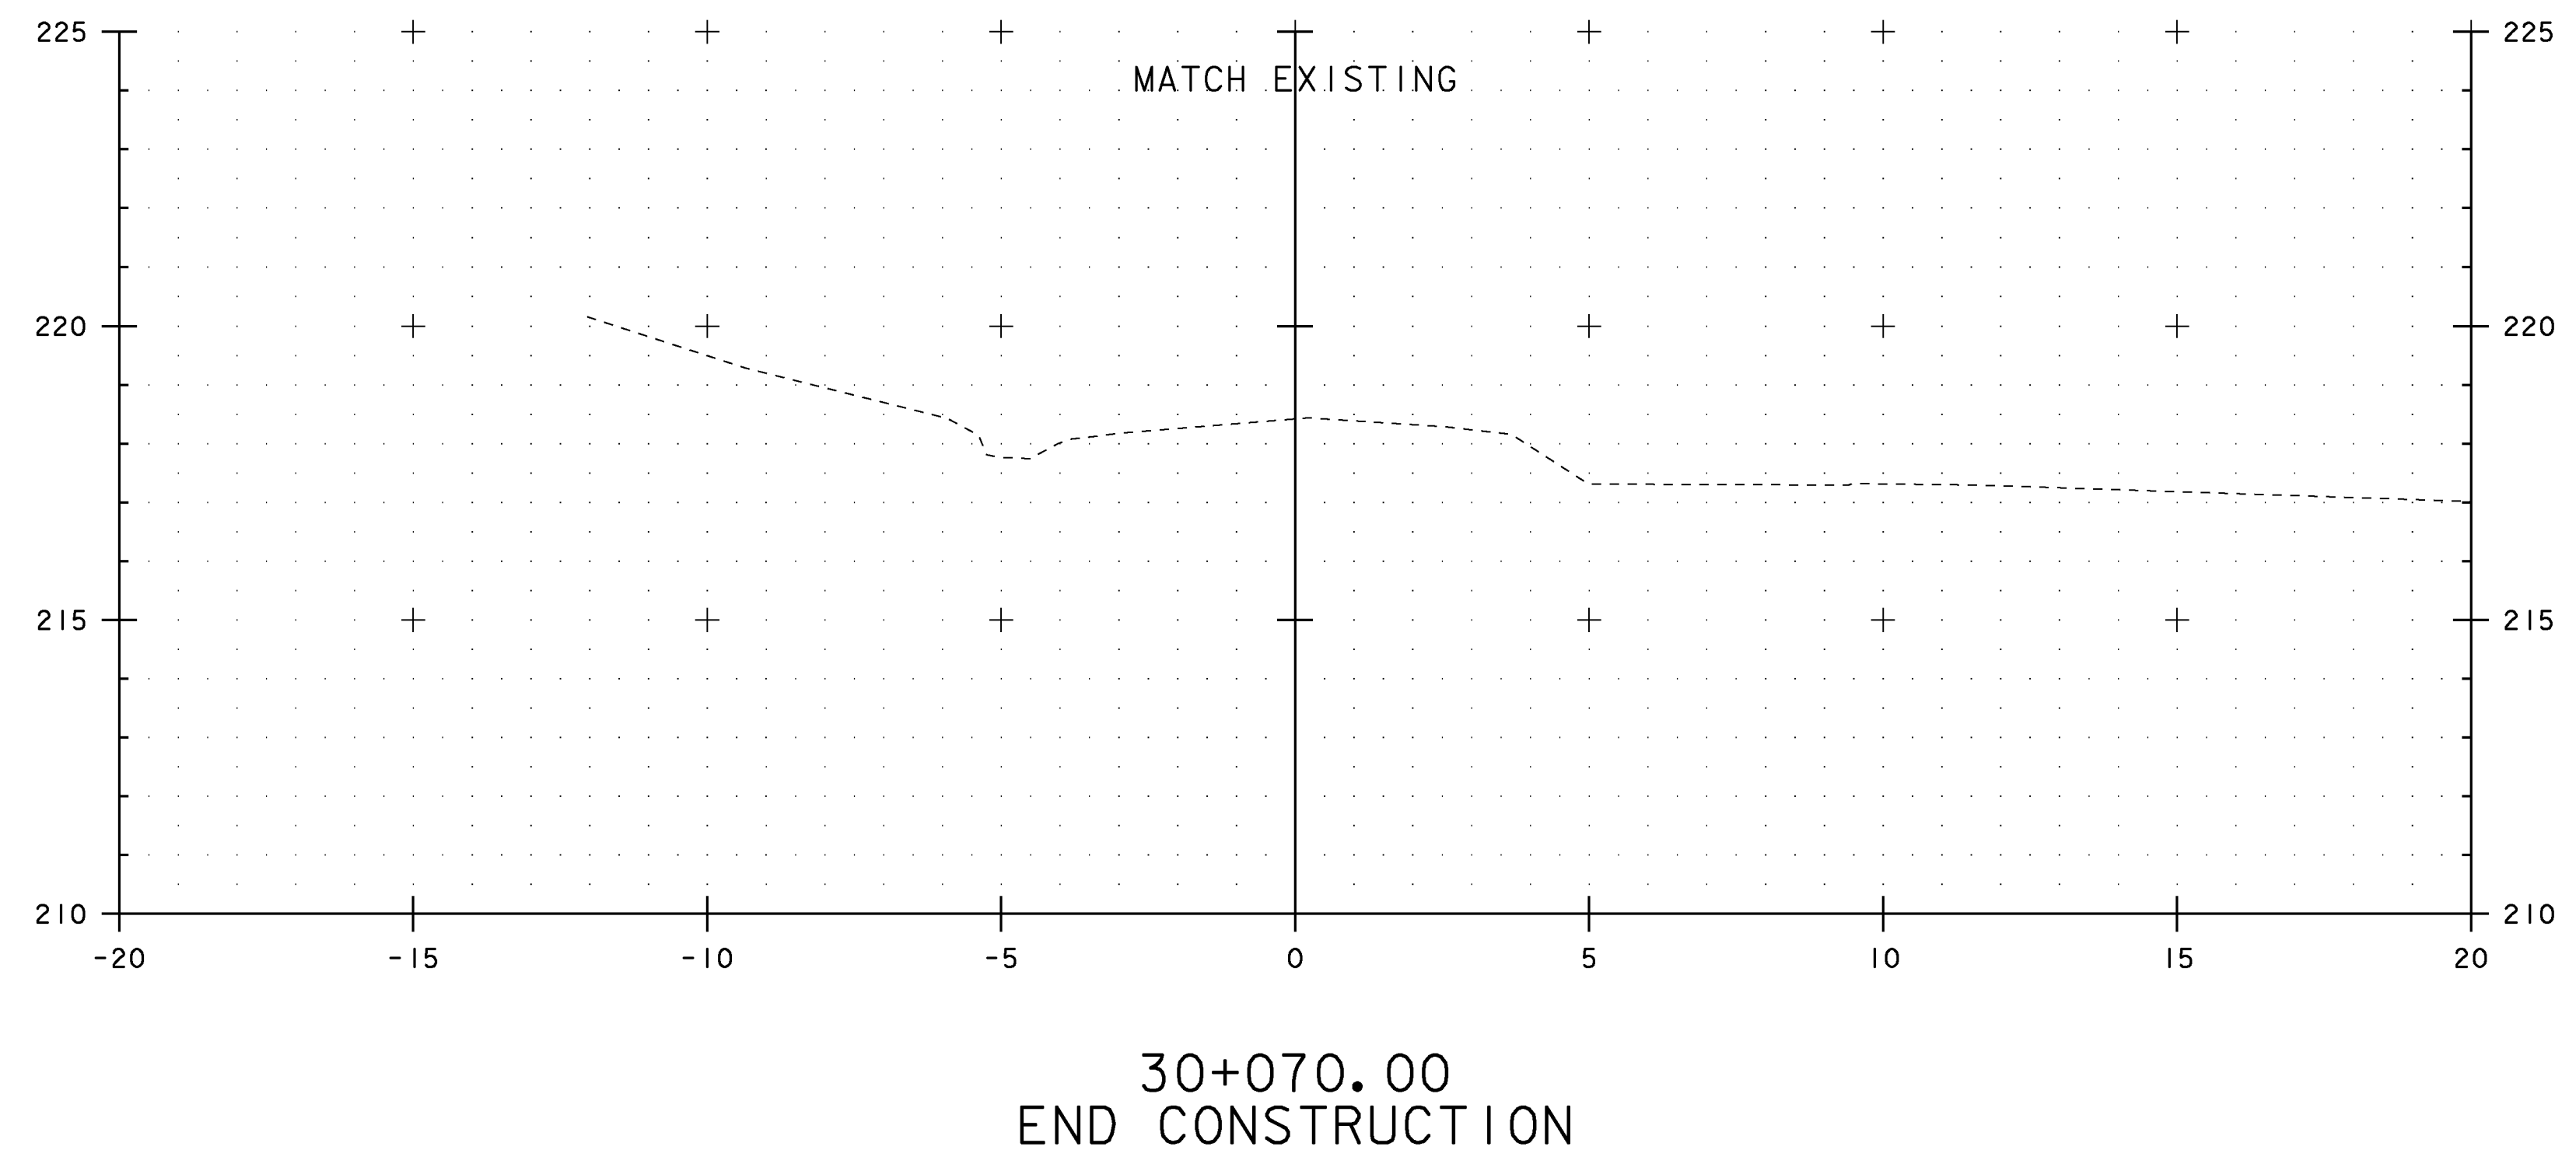


NOTES:


1. ALL BURIED UTILITIES ARE EXISTING, THE LOCATIONS ARE APPROXIMATE AND ARE TO REMAIN UNDISTURBED
2. DRAINAGE FEATURES DISPLAYED ON CROSS SECTIONS ARE PROJECTED. SEE DRAINAGE DETAIL SHEETS, LAYOUTS AND PROFILES FOR TRUE LOCATIONS

PROJECT NAME: EAST MONTPELIER	
PROJECT NUMBER: STPG 028 - 3(35)S	
FILE NAME: +98b028xsl.dgn	PLOT DATE: 22-MAR-2010
PROJECT LEADER: J. SCHULTZ	DRAWN BY: D. LYMAN
DESIGNED BY: J. GRUCHACZ	CHECKED BY: J. DEVLIN
KELTON ROAD CROSS SECTION SHEET 5	SHEET 136 OF 142


STA. 30+070

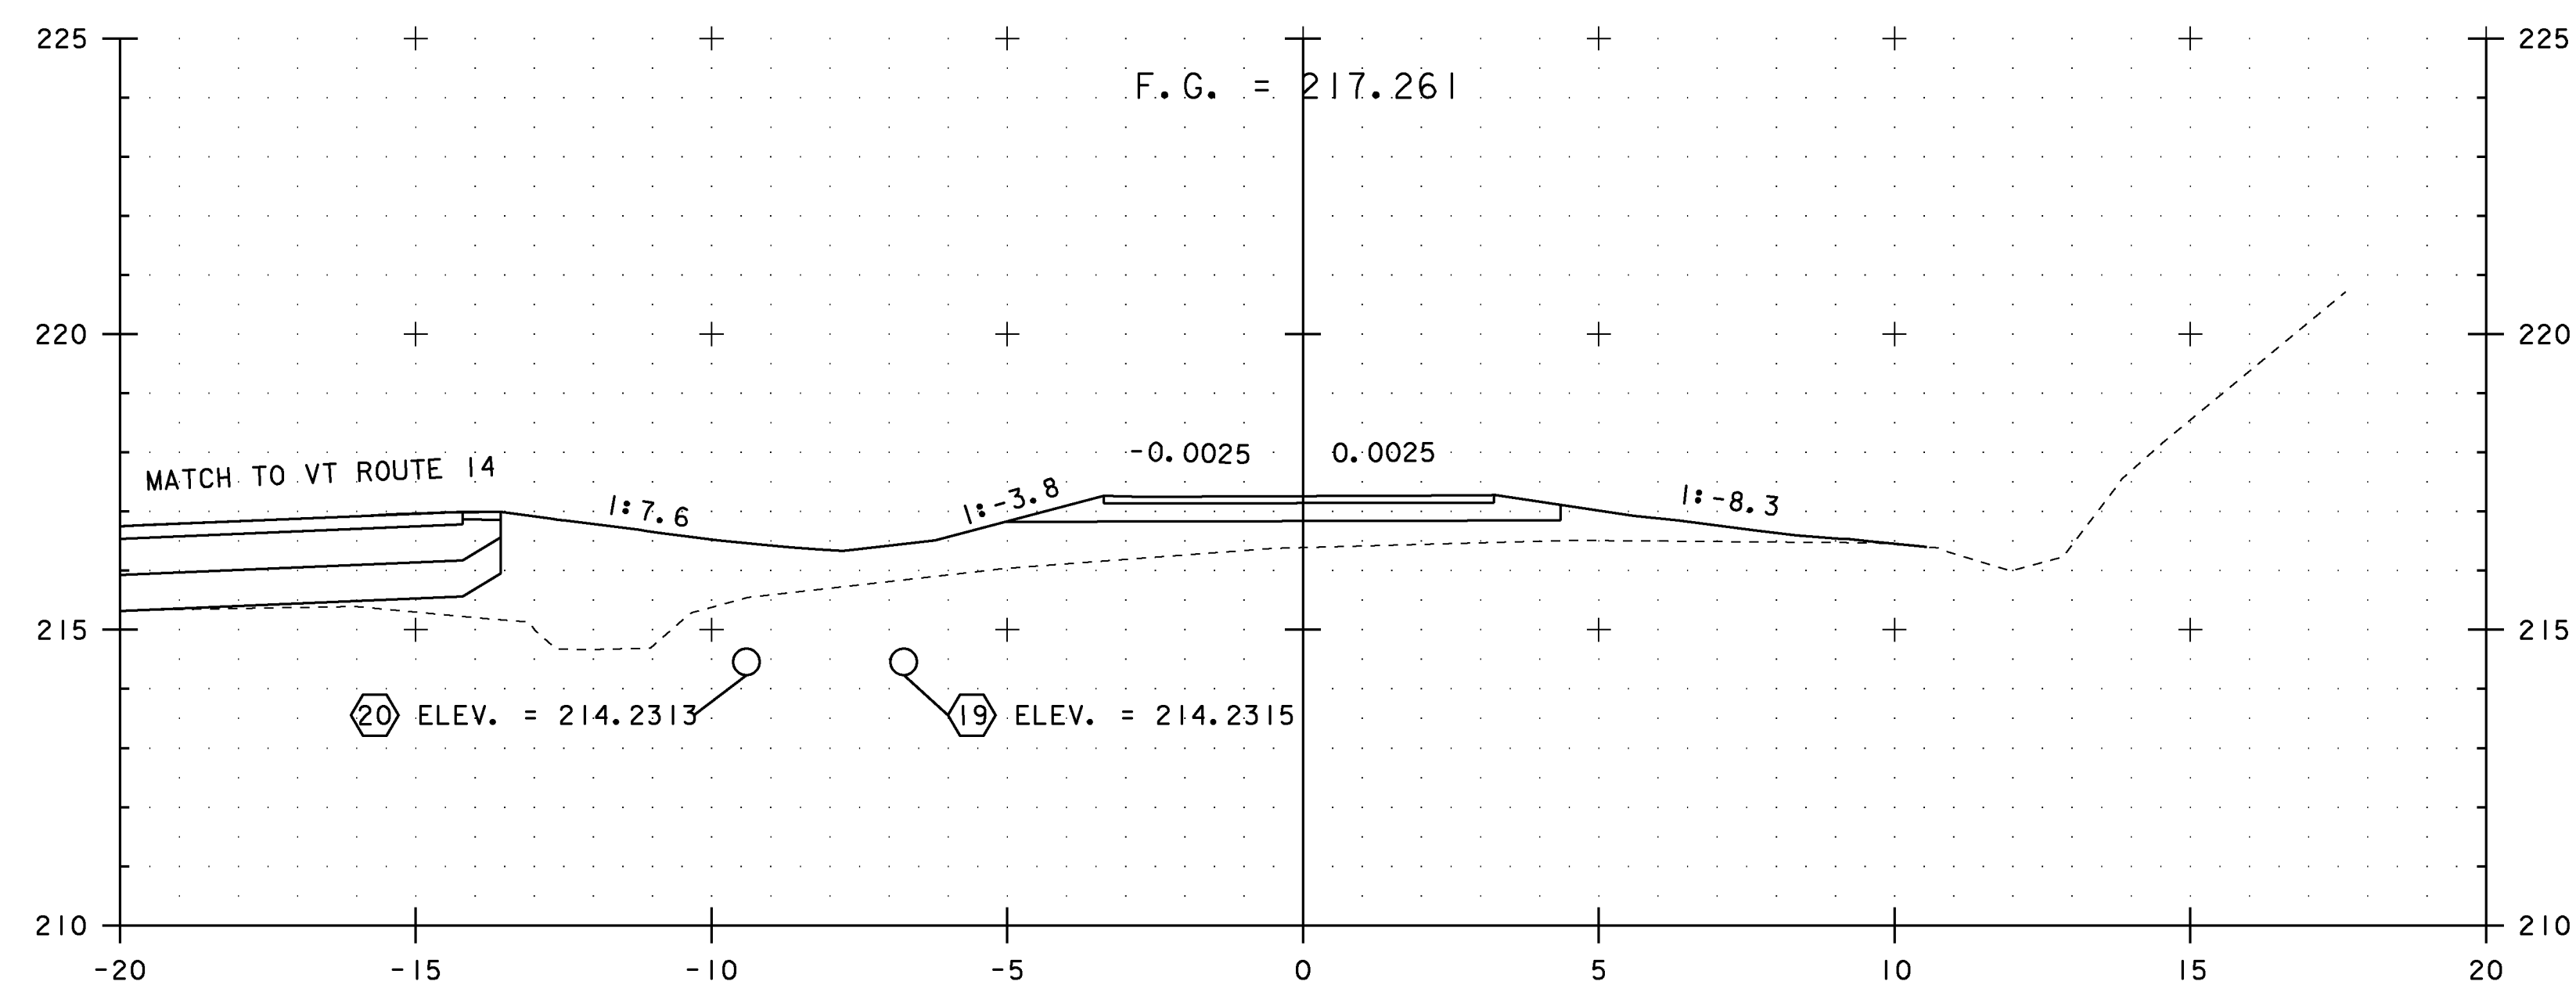

PC 100+006.76

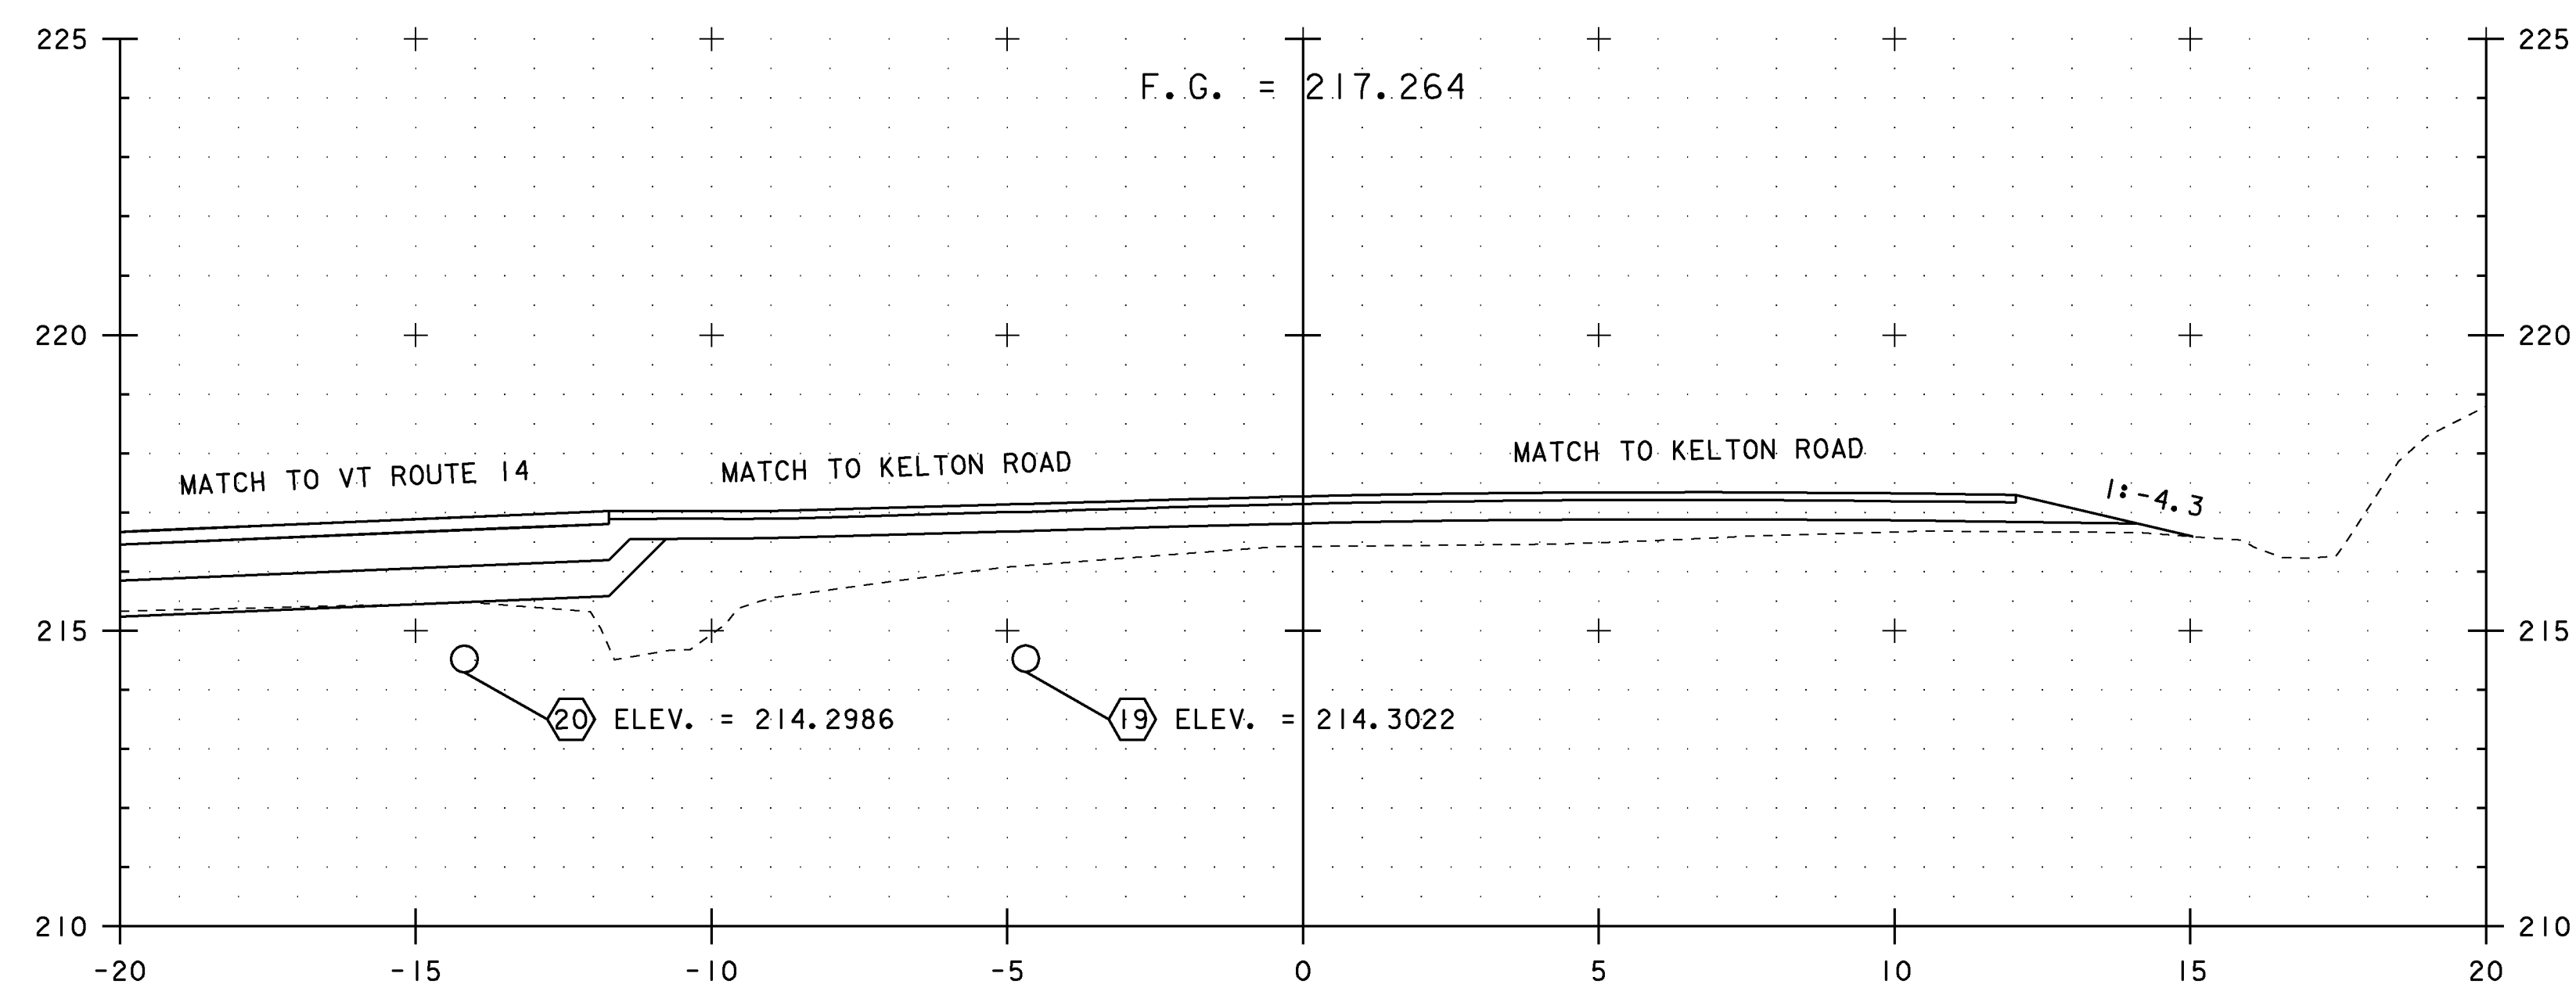

100+000.00 =
KELTON ROAD STA 30+020.00

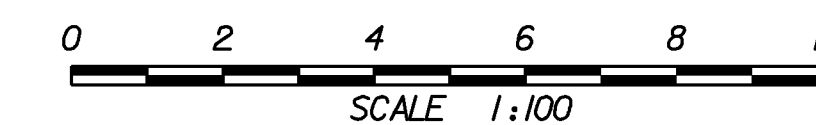


NOTES:

1. ALL BURIED UTILITIES ARE EXISTING, THE LOCATIONS ARE APPROXIMATE AND ARE TO REMAIN UNDISTURBED
2. DRAINAGE FEATURES DISPLAYED ON CROSS SECTIONS ARE PROJECTED. SEE DRAINAGE DETAIL SHEETS, LAYOUTS AND PROFILES FOR TRUE LOCATIONS


STA. 100+000 TO STA. 100+006.76

PROJECT NAME: EAST MONTPELIER
PROJECT NUMBER: STPG 028 - 3(35)S


FILE NAME: +98b028xsl.dgn	PLOT DATE: 22-MAR-2010
PROJECT LEADER: J. SCHULTZ	DRAWN BY: D. LYMAN
DESIGNED BY: J. GRUCHACZ	CHECKED BY: J. DEVLIN
PARKING LOT CROSS SECTION SHEET 1	SHEET 137 OF 142

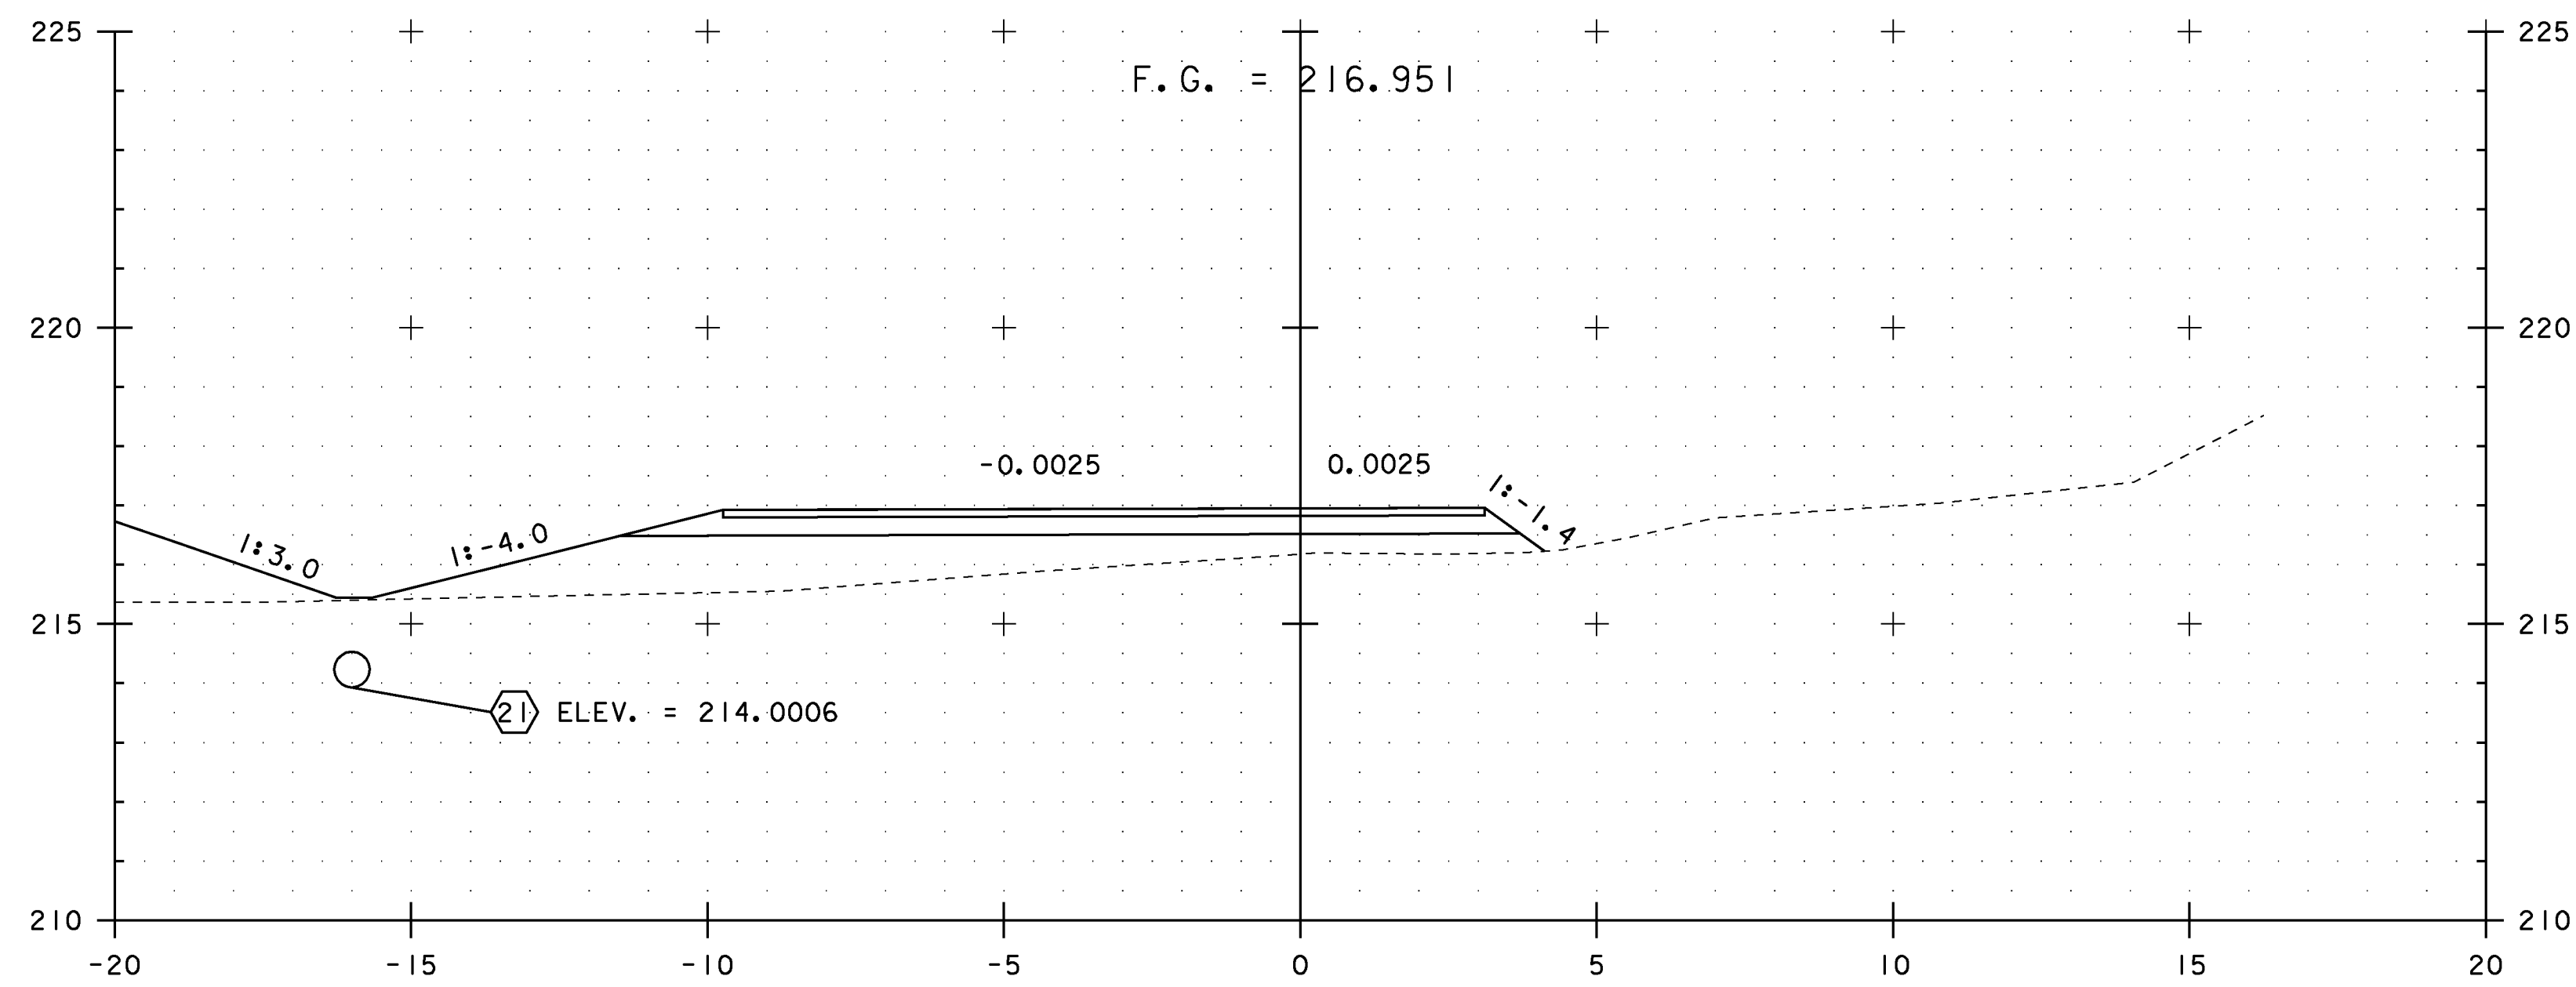

100+040.00

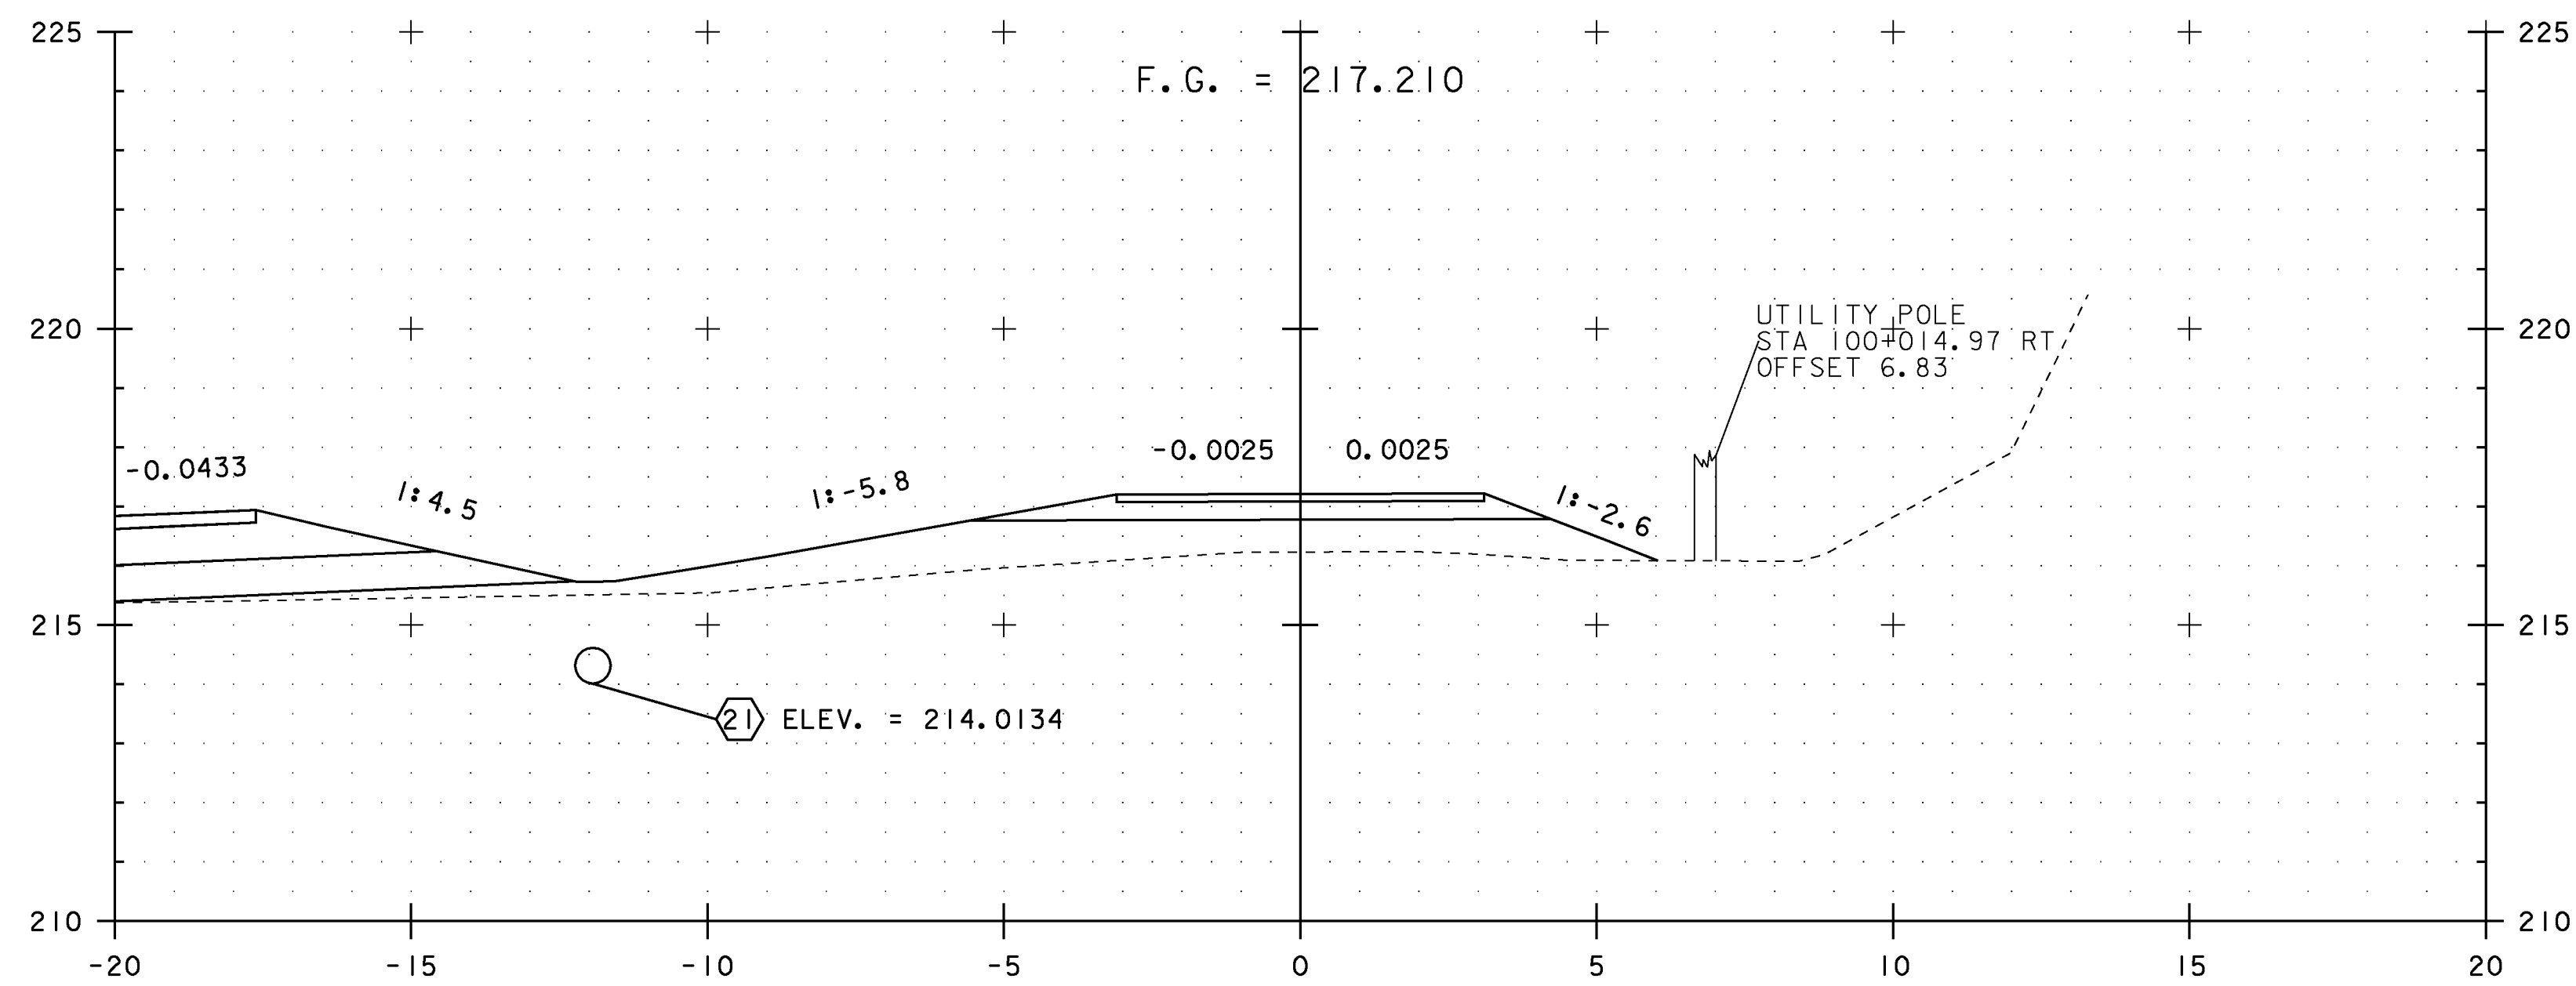

100+020.00

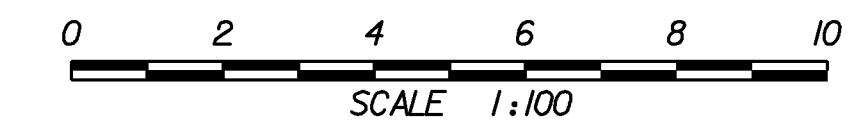


NOTES:


1. ALL BURIED UTILITIES ARE EXISTING, THE LOCATIONS ARE APPROXIMATE AND ARE TO REMAIN UNDISTURBED
2. DRAINAGE FEATURES DISPLAYED ON CROSS SECTIONS ARE PROJECTED. SEE DRAINAGE DETAIL SHEETS, LAYOUTS AND PROFILES FOR TRUE LOCATIONS

STA. 100+020 TO STA. 100+040


PROJECT NAME: EAST MONTPELIER	PLOT DATE: 22-MAR-2010
PROJECT NUMBER: STPG 028 - 3(35)S	DRAWN BY: D. LYMAN
FILE NAME: +98b028xsl.dgn	CHECKED BY: J. DEVLIN
PROJECT LEADER: J. SCHULTZ	SHEET 138 OF 142
DESIGNED BY: J. GRUCHACZ	
PARKING LOT CROSS SECTION SHEET 2	

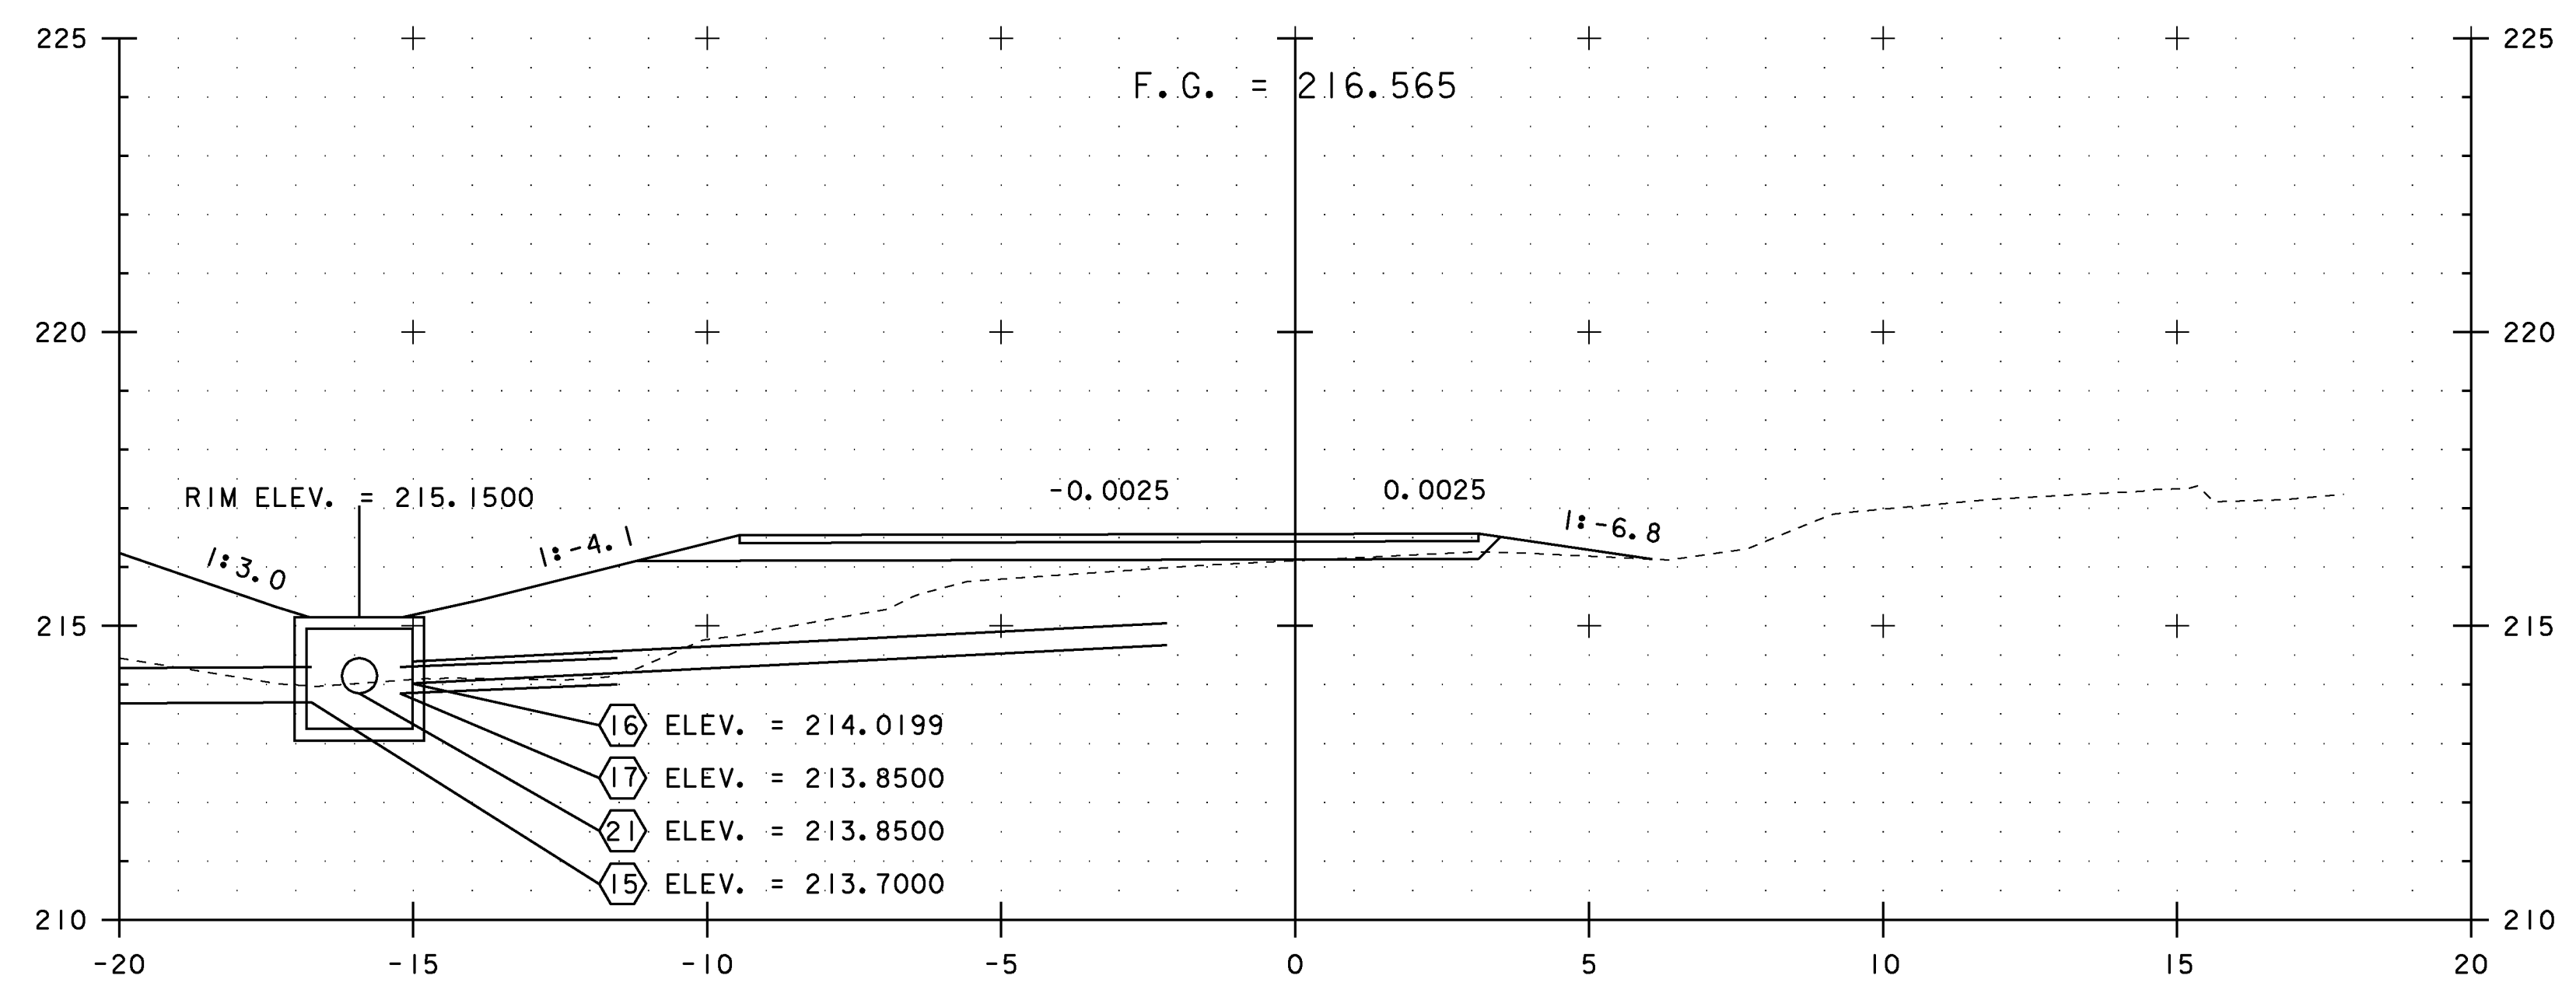

100+060.00

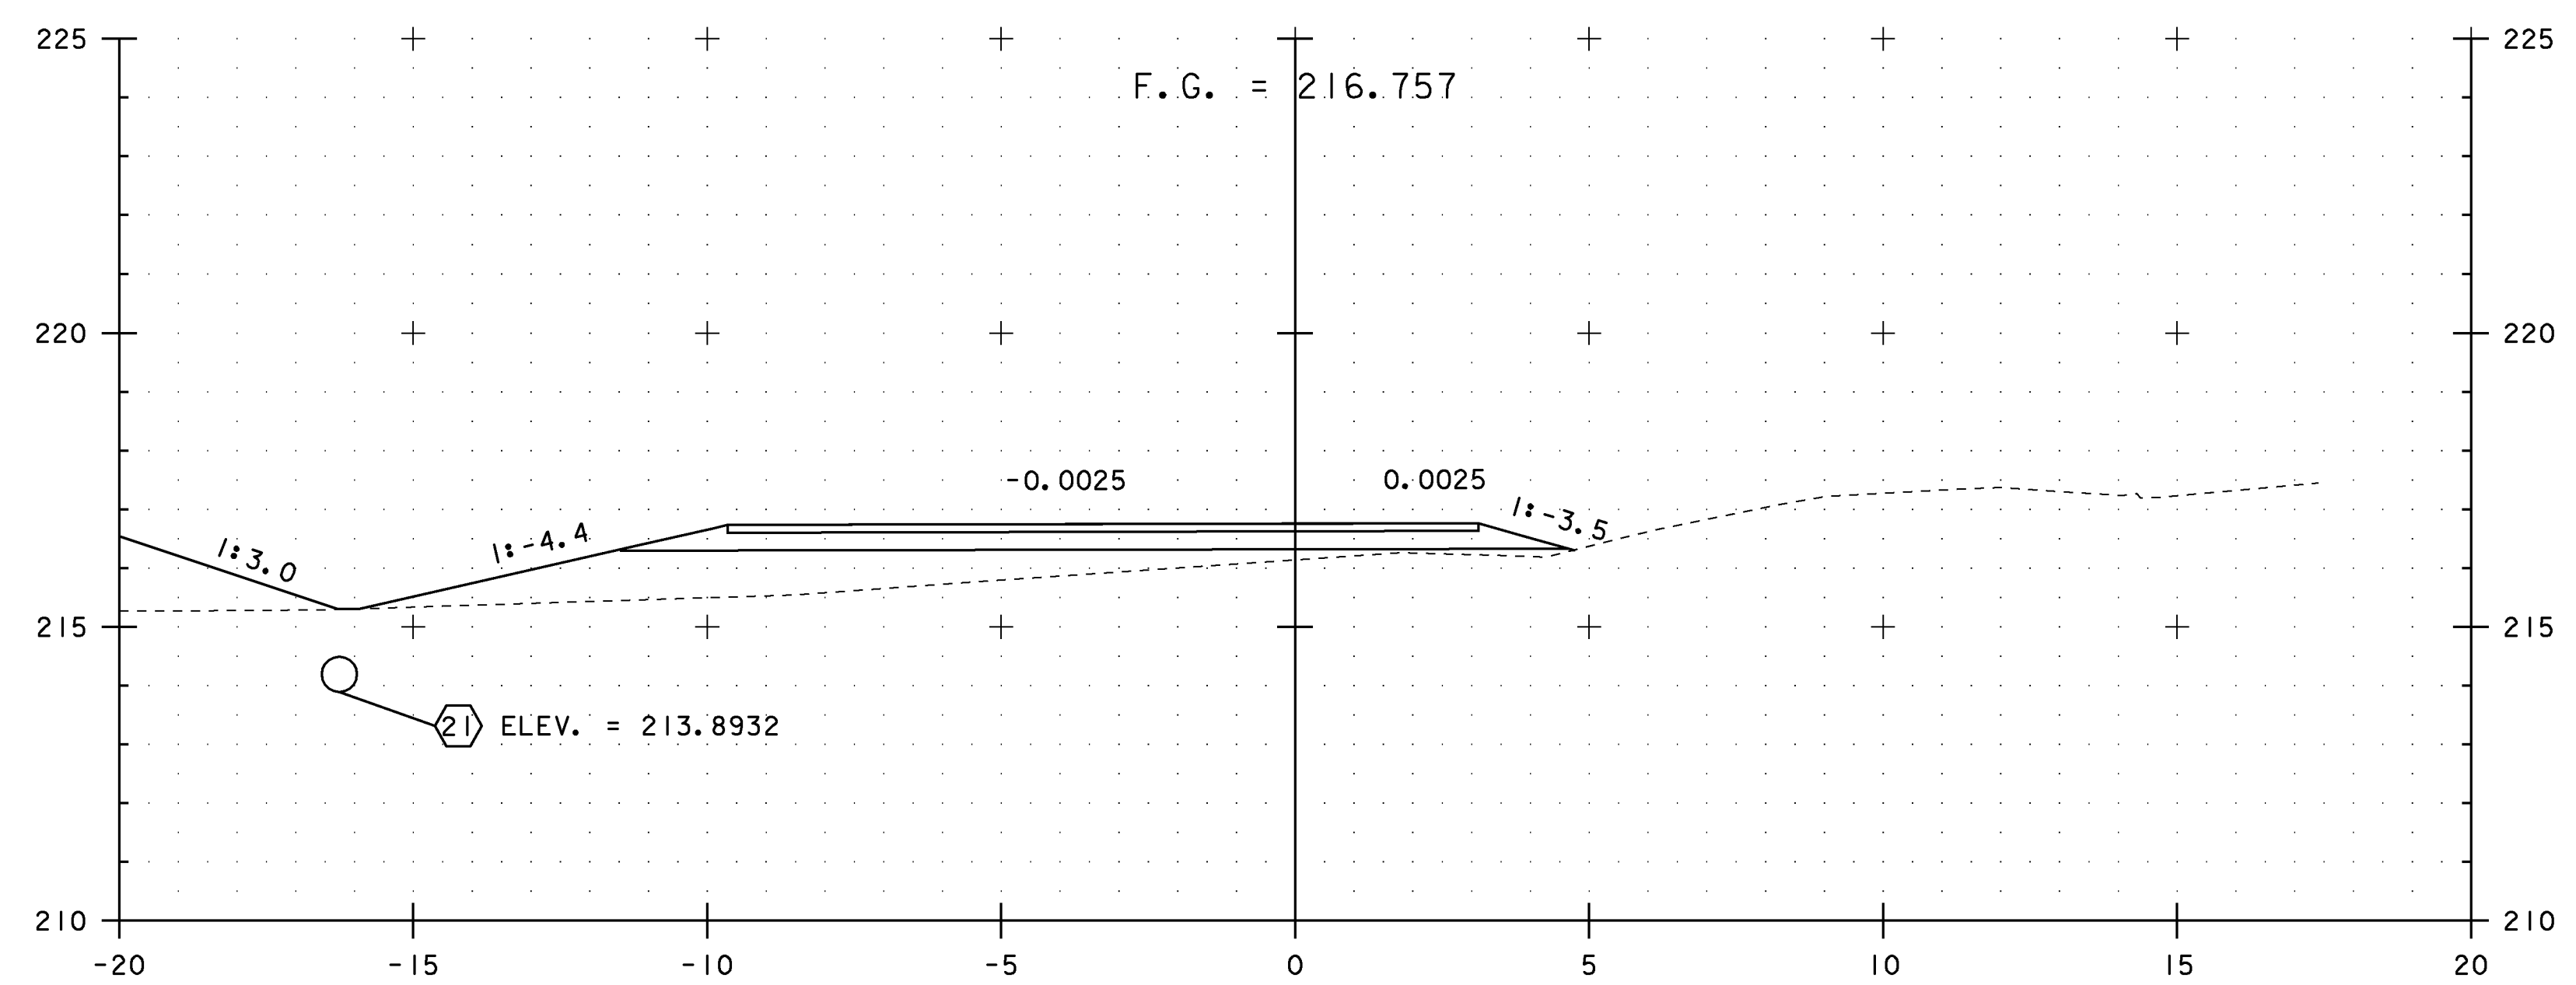

PT 100+049.80

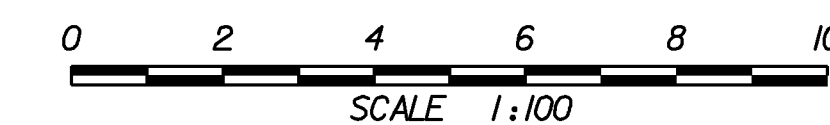


NOTES:

1. ALL BURIED UTILITIES ARE EXISTING, THE LOCATIONS ARE APPROXIMATE AND ARE TO REMAIN UNDISTURBED
2. DRAINAGE FEATURES DISPLAYED ON CROSS SECTIONS ARE PROJECTED. SEE DRAINAGE DETAIL SHEETS, LAYOUTS AND PROFILES FOR TRUE LOCATIONS


STA. 100+049.80 TO STA. 100+060

PROJECT NAME: EAST MONTPELIER
PROJECT NUMBER: STPG 028 - 3(35)S

FILE NAME: +98b028xsl.dgn	PLOT DATE: 22-MAR-2010
PROJECT LEADER: J. SCHULTZ	DRAWN BY: D. LYMAN
DESIGNED BY: J. GRUCHACZ	CHECKED BY: J. DEVLIN
PARKING LOT CROSS SECTION SHEET 3	SHEET 139 OF 142

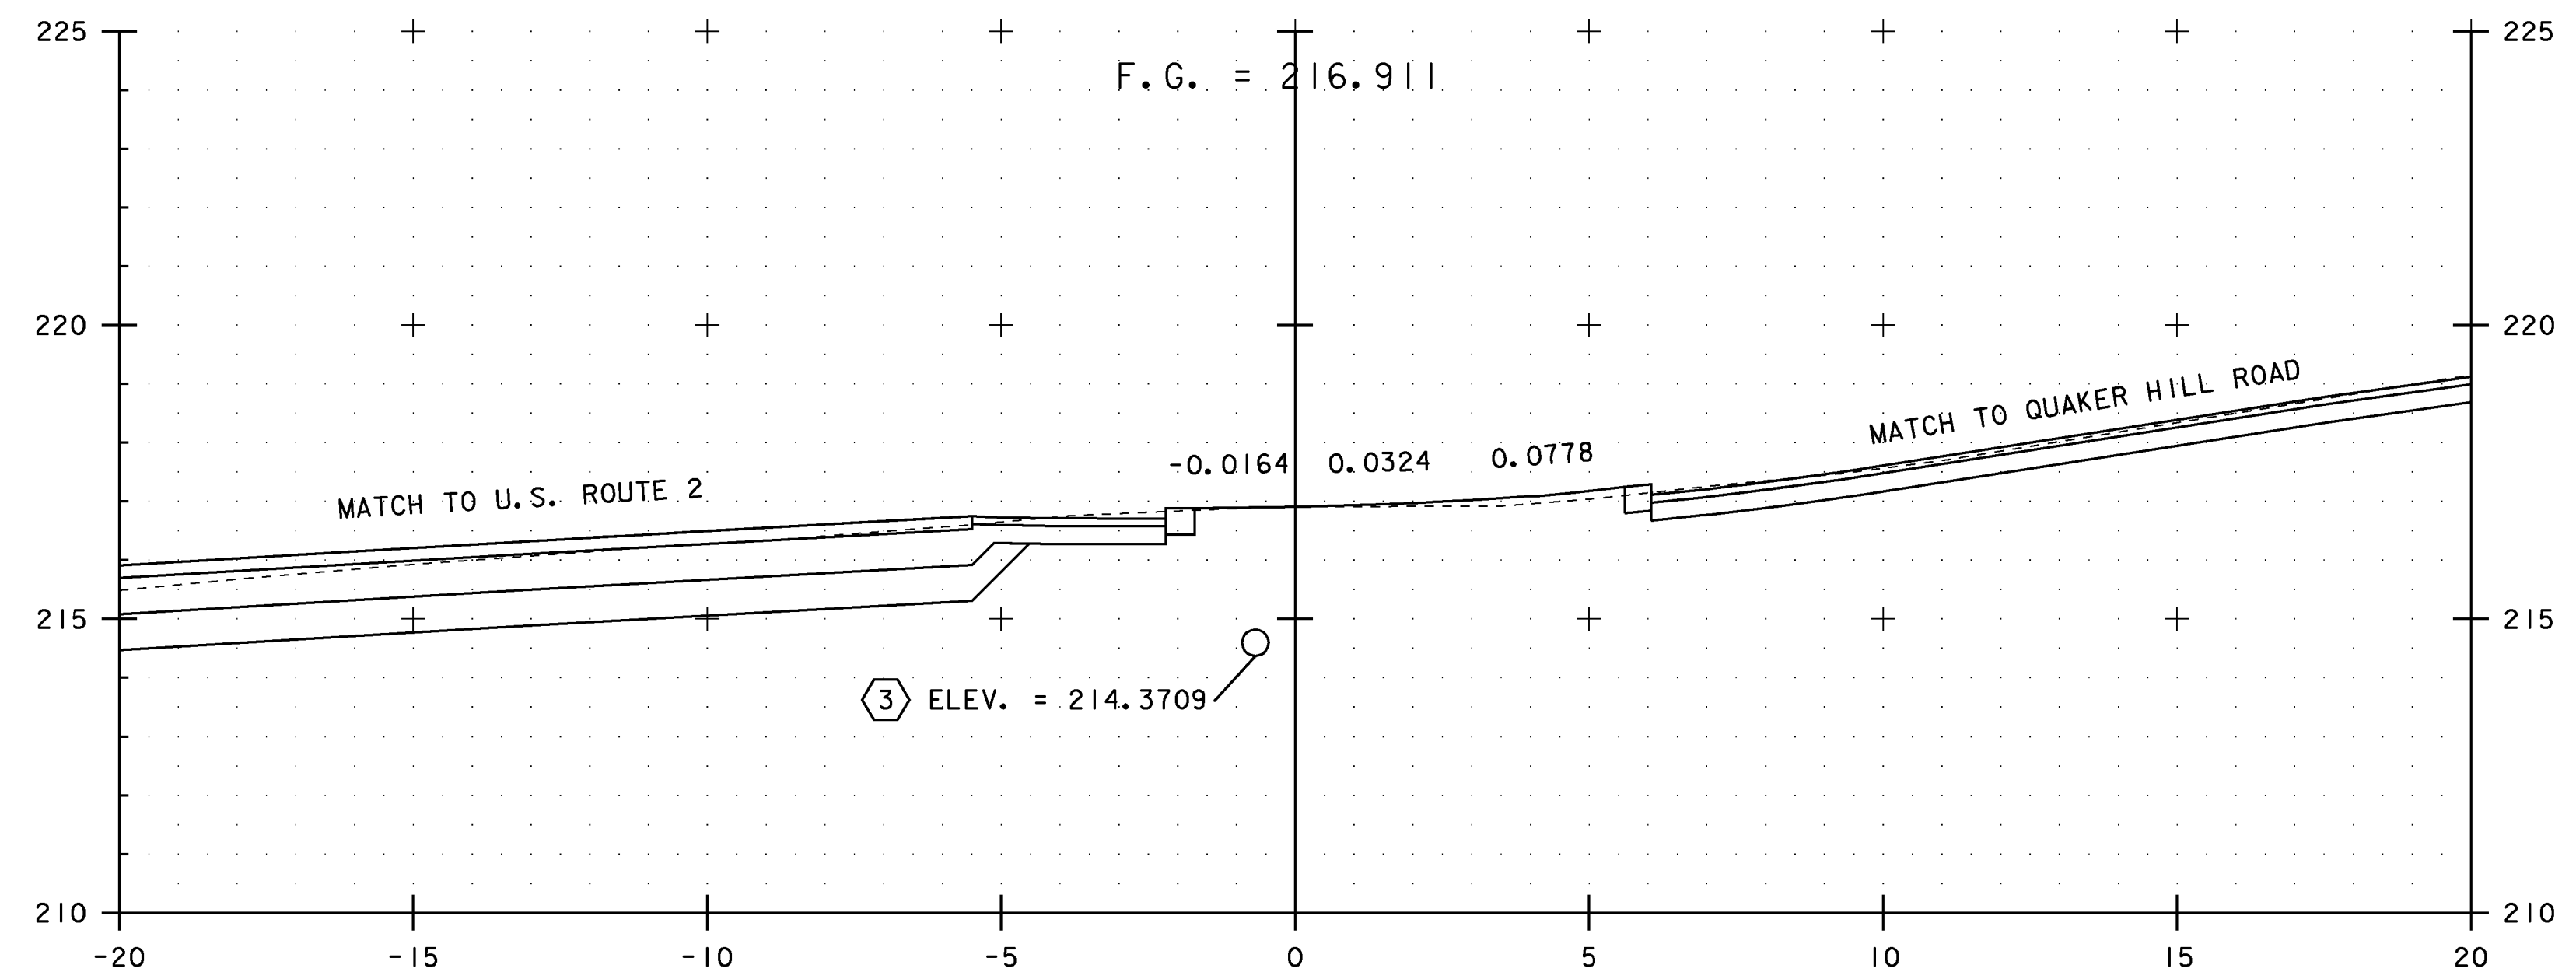

100+157.00

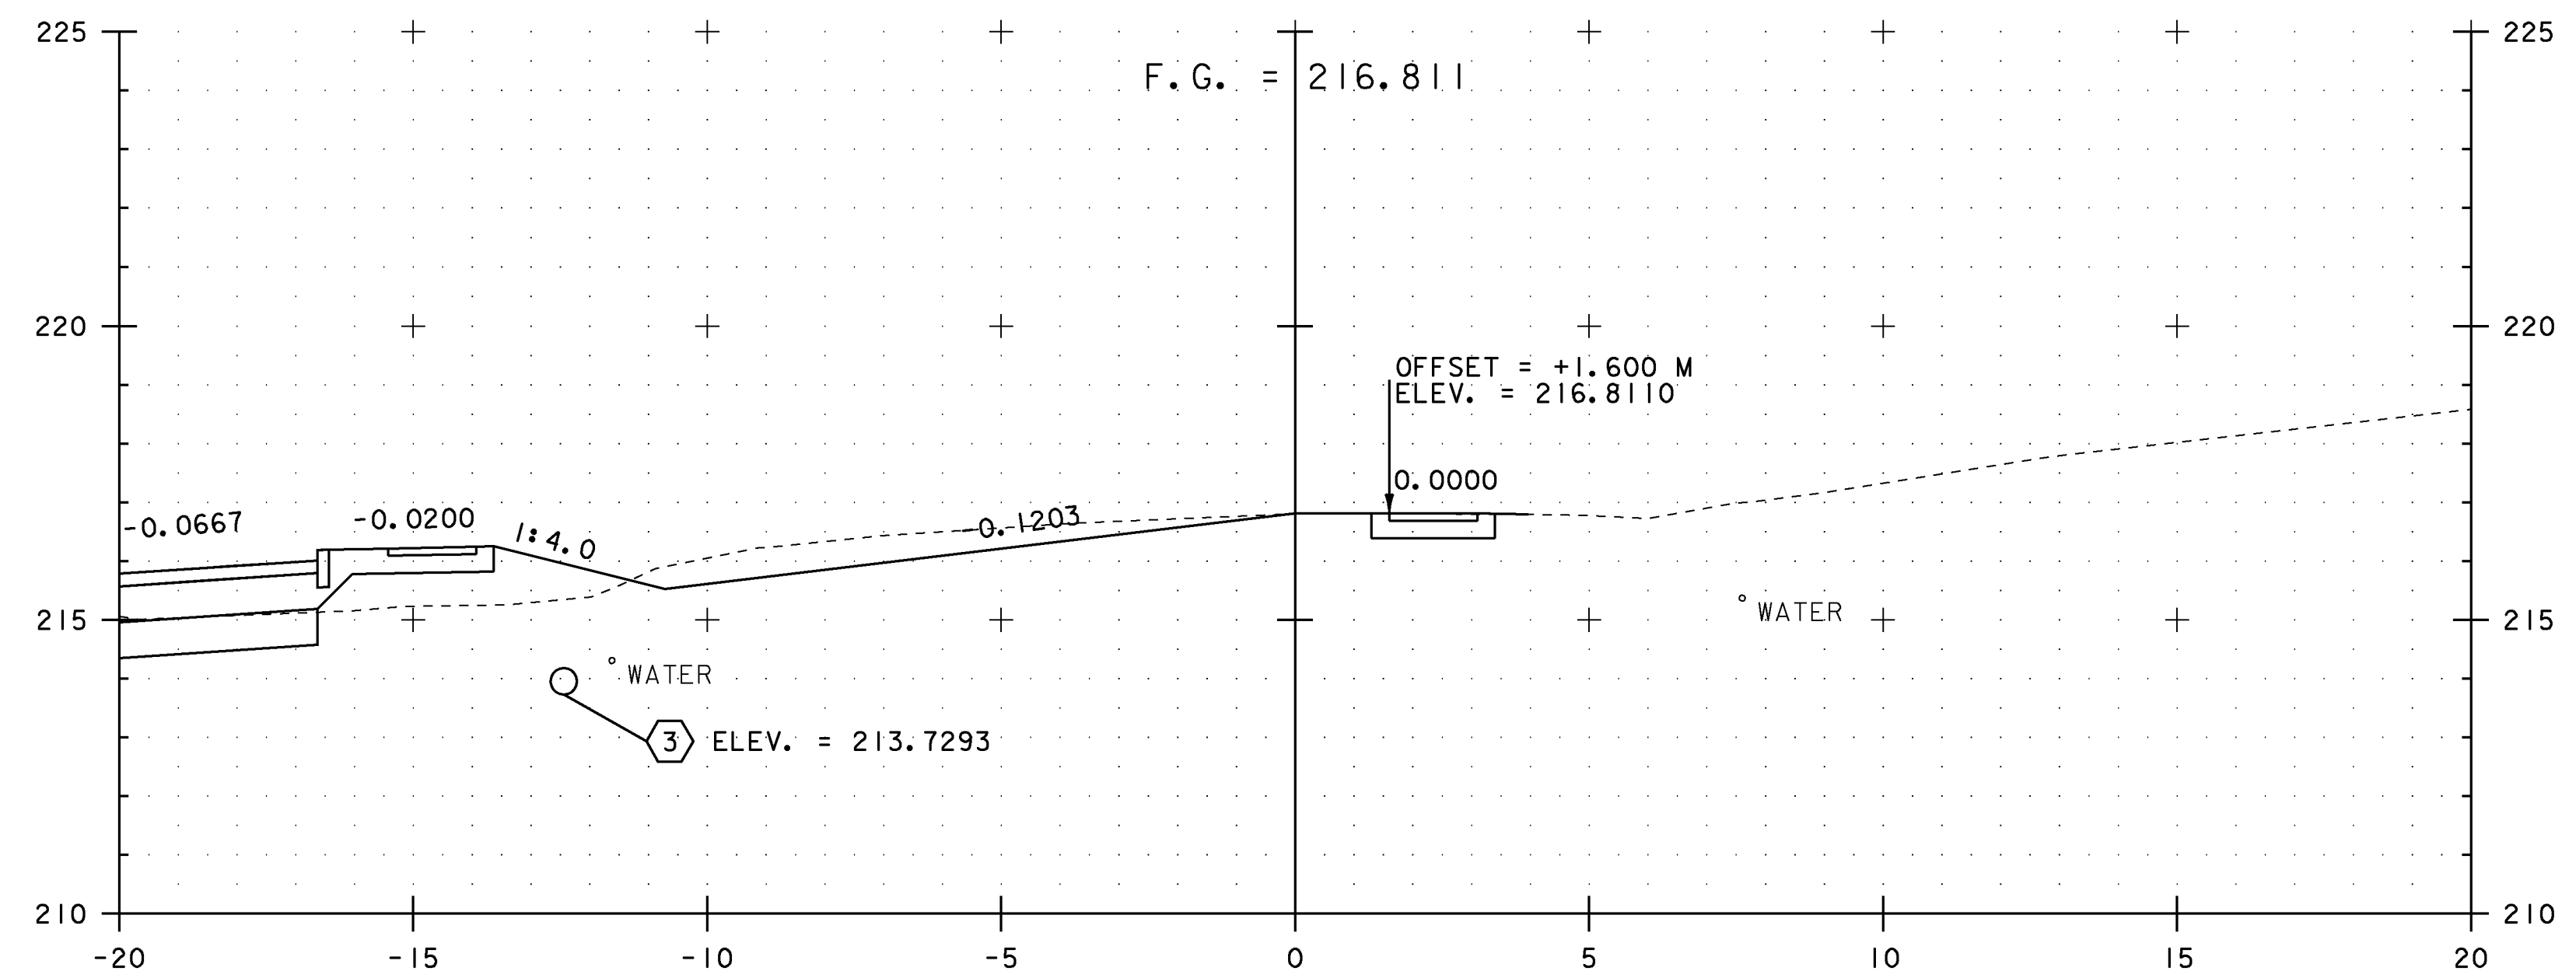

100+140.00



NOTES:

1. ALL BURIED UTILITIES ARE EXISTING, THE LOCATIONS ARE APPROXIMATE AND ARE TO REMAIN UNDISTURBED
2. DRAINAGE FEATURES DISPLAYED ON CROSS SECTIONS ARE PROJECTED. SEE DRAINAGE DETAIL SHEETS, LAYOUTS AND PROFILES FOR TRUE LOCATIONS

STA. 100+140 TO STA. 100+157

PROJECT NAME: EAST MONTPELIER
 PROJECT NUMBER: STPG 028 - 3(35)S

FILE NAME: +98b028xsl.dgn	PLOT DATE: 22-MAR-2010
PROJECT LEADER: J. SCHULTZ	DRAWN BY: D. LYMAN
DESIGNED BY: J. GRUCHACZ	CHECKED BY: J. DEVLIN
PARKING LOT CROSS SECTION SHEET 6	SHEET 142 OF 142