


- TEMPORARY AND DURABLE 100m YELLOW LINE
 STA 0+598.5 TO I+800 SOLID LT&RT
 STA 0+849 DOUBLE SOLID RT
 (WITH CENTERLINE BREAKS FOR TOWN HIGHWAYS)
 TEMPORARY AND DURABLE 100m WHITE LINE
 STA 0+598.5 TO I+800 SOLID LT&RT
 (WITH EDGELINE BREAKS FOR TOWN HIGHWAYS)
 TEMPORARY AND DURABLE 600m STOP BAR
 STA 0+849 RT JOHN FOWLER RD
 TEMPORARY AND DURABLE LETTER OR SYMBOL
 STA 0+849 RT "STOP"
 REMOVING SIGNS
 II

- REHABILITATION OF D.I.'S, C.B.'S OR M.H.'S
 STA 0+765 LT
 STA 0+861 LT
 STA 0+907 LT
 STA I+115 LT

- YIELDING MARKER POST
 STA 0+765 LT
 STA 0+999 LT
 STA 0+159 LT
 STA I+501 LT & RT
 STA I+750 RT

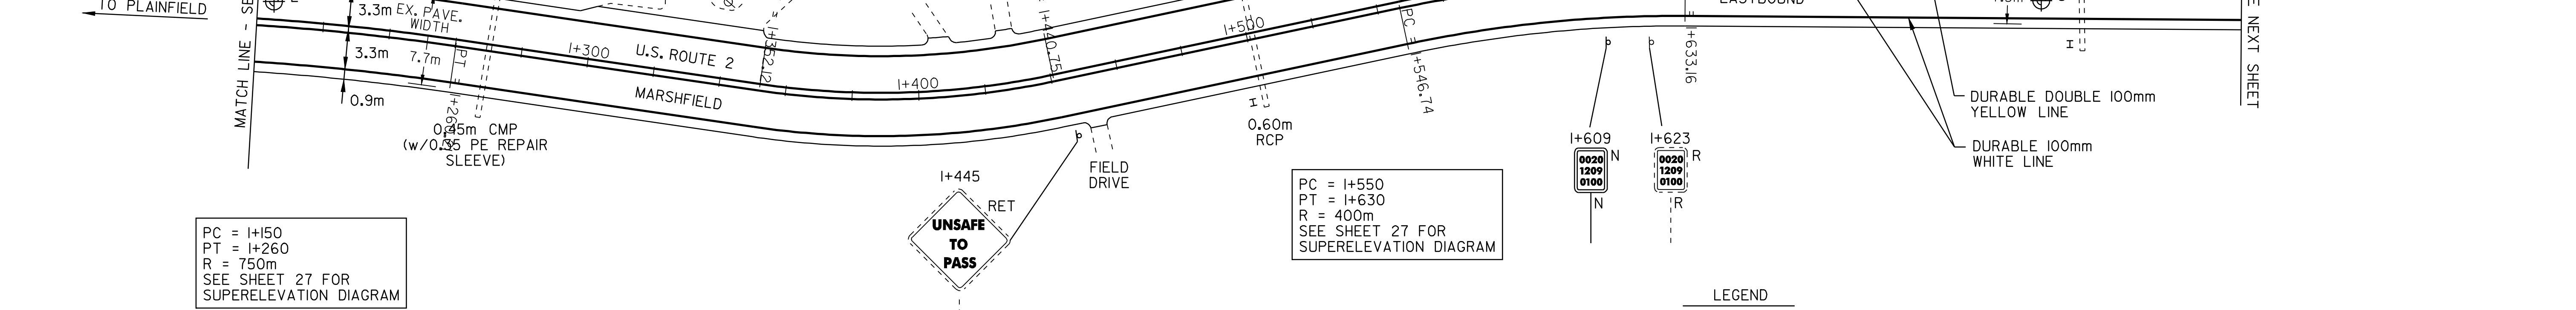

PAVEMENT CORES -

#	TOTAL DEPTH (mm)	SOLID CORE	COMMENTS
1	215	YES	DRAINABLE BASE
2	280	NO	POOR QUALITY CORE
3	255	NO	RUTTING, POOR QUALITY CORE

NOTE:
 - NO PCC UNDER ANY CORES
 - NO CORES OVER ASPHALTED (UNLESS NOTED)
 - NO SHOULDER CORES

- REMOVAL AND DISPOSAL OF GUARD RAIL
 STA 0+657 TO 0+686 RT
 STA 0+671 TO 0+688 LT
 STA 0+692 TO 0+730 RT
 STA 0+694 TO 0+705 LT
 STA 0+827 TO 0+846 RT
 STA 0+853 TO I+155 RT
 MANUFACTURED TERMINAL SECTION (FLARED)
 STA 0+657 TO 0+668 RT
 STA 0+667 TO 0+678 LT
 STA 0+694 TO 0+705 LT
 STA 0+719 TO 0+730 RT
 STA 0+827 TO 0+838 RT
 STA I+144 TO I+155 RT
 STEEL BEAM GUARD RAIL
 STA 0+668 TO 0+676 RT
 STA 0+700 TO 0+719 RT

- BRIDGE RAILING - HEAVY DUTY S.B. FASCIA MOUNTED (MOD 3)
 STA 0+686 TO 0+692 RT
 STA 0+688 TO 0+694 LT
 HEAVY DUTY STEEL BEAM GUARD RAIL
 STA 0+676 TO 0+686 RT
 STA 0+678 TO 0+688 LT
 STA 0+692 TO 0+700 RT
 STA 0+838 TO 0+845 RT (TH #60)
 STA 0+853 TO 0+861 RT (TH #60)
 STEEL BEAM GUARD RAIL W/2.4m POSTS (MOD.)
 STA 0+861 TO I+144 RT
 RELOCATED MAILBOX, SINGLE SUPPORT
 STA I+557 LT

- LEGEND
- N = NEW
 - R = REMOVE
 - R&S = REMOVE & SALVAGE
 - RET = RETAIN
 - S = SALVAGE
 - B-TO-B = BACK TO BACK
 - ⊕ = CATCH BASIN/DI/MANHOLE
 - ⊙ = EXISTING THROAT DI SEWER MANHOLE
 - N.W. = NO WORK REQUIRED
 - I = MARKER POST
 - ⊕/I = UTIL. POLE
 - ⊕/I = UTIL. POLE W/UNDERGROUND UTIL.
 - ⊕ = VALVE/CURB STOP
 - ⊕ = DRIVE

PAVING PROJECT LAYOUT #1



DESIGNED BY BCE/PJM DATE 7-02
 DRAWN BY C.E.A., INC. DATE 7-02
 DESIGN FILE NO. /pave/98b090/pb090.dgn
 PRF FILE pb090p01.i DATE PLOTTED 09-MAY-2008 10
 PROJ. NAME MARSHFIELD - CABOT
 PROJ. NO. NH 2104(1)S
 SHEET 11 OF 60 SHEETS