


TEMPORARY AND DURABLE 100m YELLOW LINE  
STA 4+200 TO 5+400  
SOLID LT&RT

TEMPORARY AND DURABLE 100m WHITE LINE  
STA 4+200 TO 5+400  
SOLID LT&RT

REMOVING SIGNS  
4

YIELDING MARKER POST  
STA 4+570 LT  
STA 4+945 RT  
STA 5+087 LT

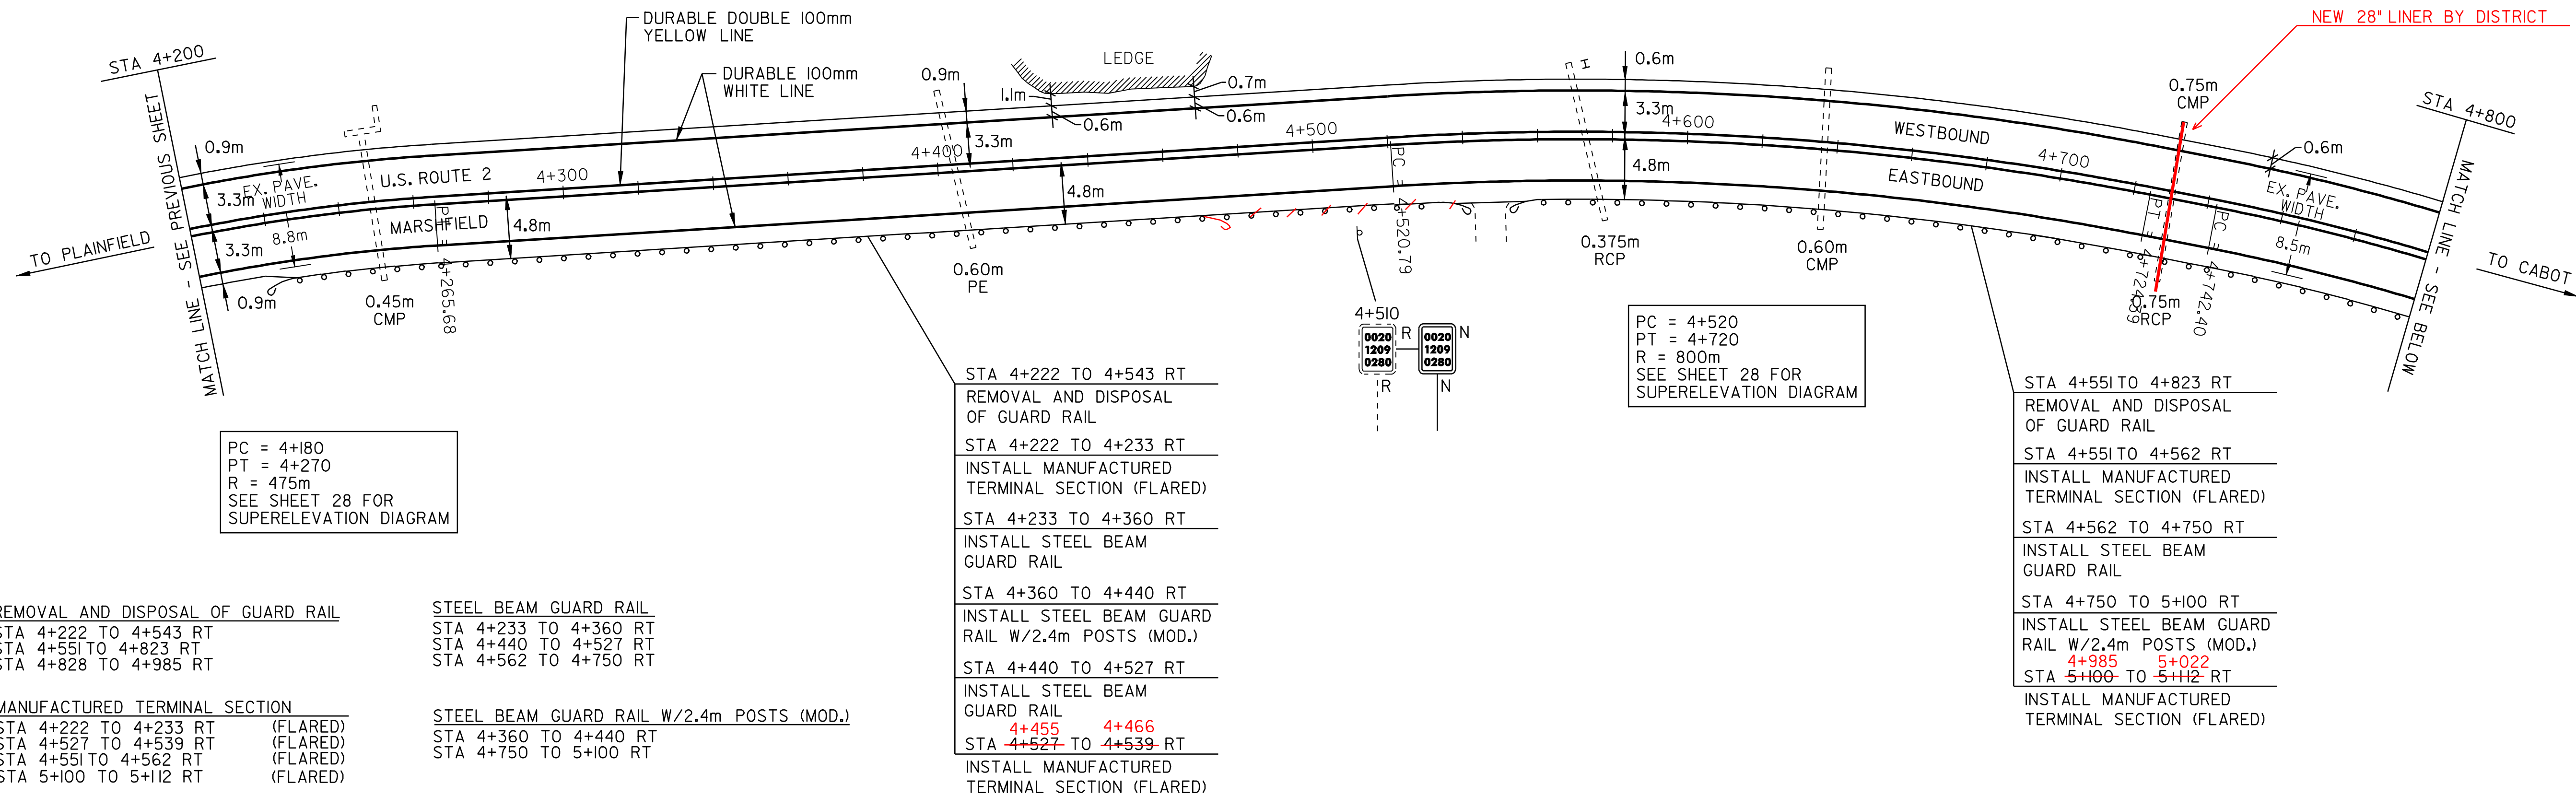

PC = 4+180  
PT = 4+270  
R = 475m  
SEE SHEET 28 FOR SUPERELEVATION DIAGRAM

STA 4+222 TO 4+543 RT  
REMOVAL AND DISPOSAL OF GUARD RAIL  
STA 4+222 TO 4+233 RT  
INSTALL MANUFACTURED TERMINAL SECTION (FLARED)  
STA 4+233 TO 4+360 RT  
INSTALL STEEL BEAM GUARD RAIL  
STA 4+360 TO 4+440 RT  
INSTALL STEEL BEAM GUARD RAIL W/2.4m POSTS (MOD.)  
STA 4+440 TO 4+527 RT  
INSTALL STEEL BEAM GUARD RAIL  
4+455 4+466  
STA 4+527 TO 4+539 RT  
INSTALL MANUFACTURED TERMINAL SECTION (FLARED)


STA 4+551 TO 4+823 RT  
REMOVAL AND DISPOSAL OF GUARD RAIL  
STA 4+551 TO 4+562 RT  
INSTALL MANUFACTURED TERMINAL SECTION (FLARED)  
STA 4+562 TO 4+750 RT  
INSTALL STEEL BEAM GUARD RAIL  
STA 4+750 TO 5+100 RT  
INSTALL STEEL BEAM GUARD RAIL W/2.4m POSTS (MOD.)  
4+985 5+022  
STA 5+100 TO 5+112 RT  
INSTALL MANUFACTURED TERMINAL SECTION (FLARED)

REMOVAL AND DISPOSAL OF GUARD RAIL  
STA 4+222 TO 4+543 RT  
STA 4+551 TO 4+823 RT  
STA 4+828 TO 4+985 RT

STEEL BEAM GUARD RAIL  
STA 4+233 TO 4+360 RT  
STA 4+440 TO 4+527 RT  
STA 4+562 TO 4+750 RT

MANUFACTURED TERMINAL SECTION (FLARED)  
STA 4+222 TO 4+233 RT (FLARED)  
STA 4+527 TO 4+539 RT (FLARED)  
STA 4+551 TO 4+562 RT (FLARED)  
STA 5+100 TO 5+112 RT (FLARED)

STEEL BEAM GUARD RAIL W/2.4m POSTS (MOD.)  
STA 4+360 TO 4+440 RT  
STA 4+750 TO 5+100 RT

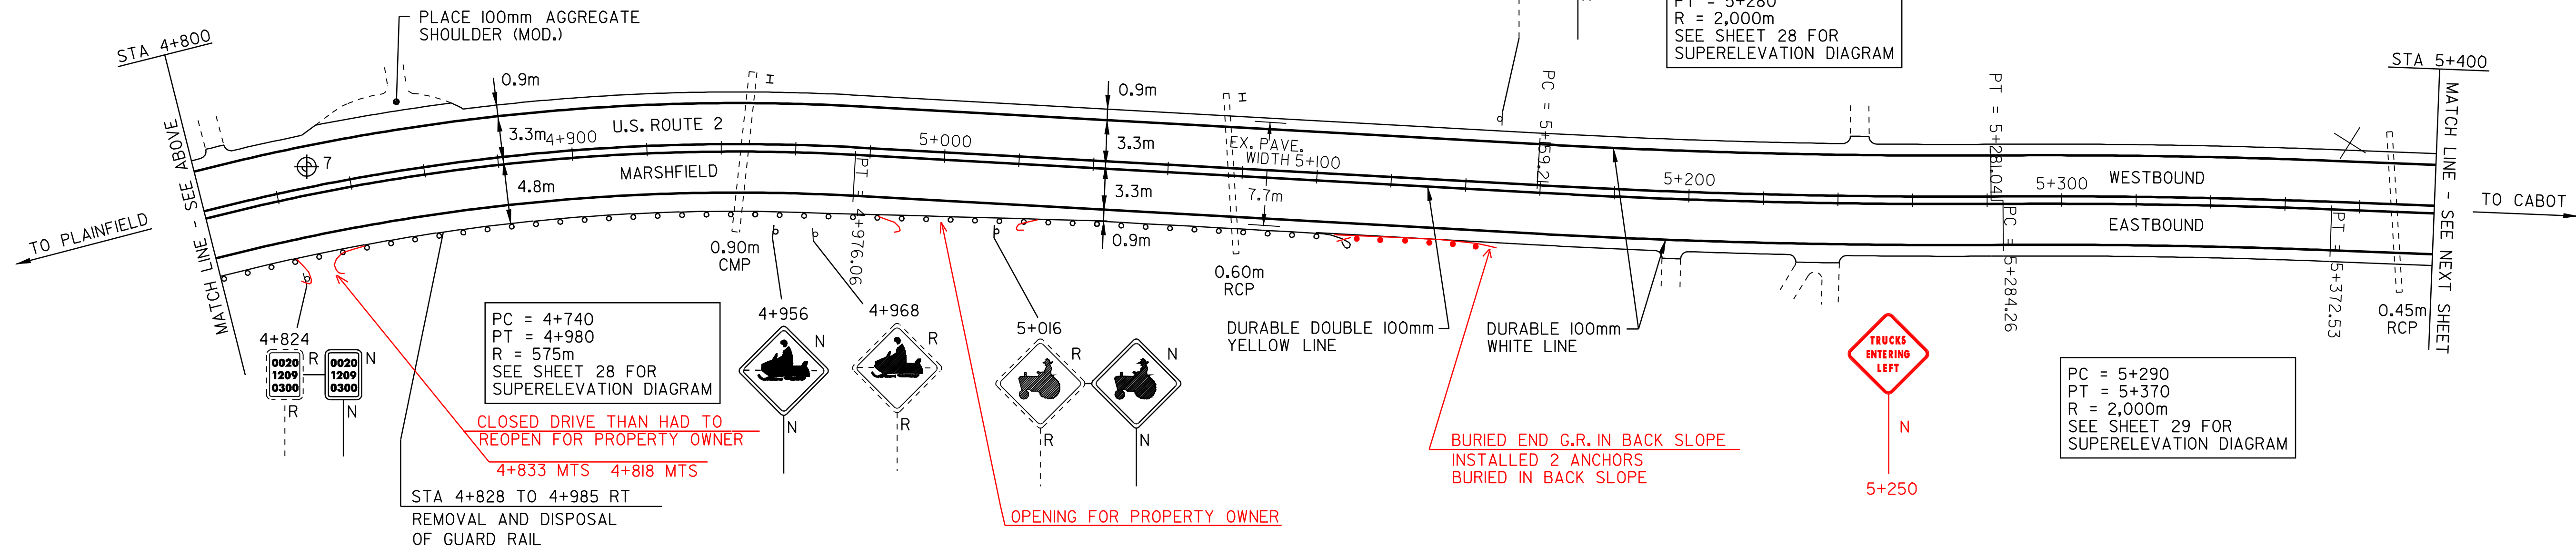

PC = 4+740  
PT = 4+980  
R = 575m  
SEE SHEET 28 FOR SUPERELEVATION DIAGRAM

PC = 5+160  
PT = 5+280  
R = 2,000m  
SEE SHEET 28 FOR SUPERELEVATION DIAGRAM

PC = 5+290  
PT = 5+370  
R = 2,000m  
SEE SHEET 29 FOR SUPERELEVATION DIAGRAM

STA 4+828 TO 4+985 RT  
REMOVAL AND DISPOSAL OF GUARD RAIL

BURIED END G.R. IN BACK SLOPE  
INSTALLED 2 ANCHORS  
BURIED IN BACK SLOPE

PAVEMENT CORES - ⊕

#	TOTAL DEPTH (mm)	SOLID CORE	COMMENTS
7	265	NO	BROKE UP

NOTE:  
- NO PCC UNDER ANY CORES  
- NO CORES OVER ASPHALTED (UNLESS NOTED)  
- NO SHOULDER CORES

**Metric**

**PAVING PROJECT LAYOUT #4**

DESIGNED BY BCE/PJM DATE 7-02  
 DRAWN BY C.E.A., INC. DATE 7-02  
 DESIGN FILE NO. /pave/98b090/pb090.dgn  
 PRF FILE pb090p04.i DATE PLOTTED 09-MAY-2008 10  
 PROJ. NAME **MARSHFIELD - CABOT**  
 PROJ. NO. **NH 2104(1)S**  
 SHEET **14** OF **60** SHEETS